




FED. ROAD DIST. NO.	STATE	FED. AID PROJ. NO.	FISCAL YEAR	SHEET NO.	TOTAL SHEETS
HAWAII	HAW.	IR-HI-1(196)	1986	3	22

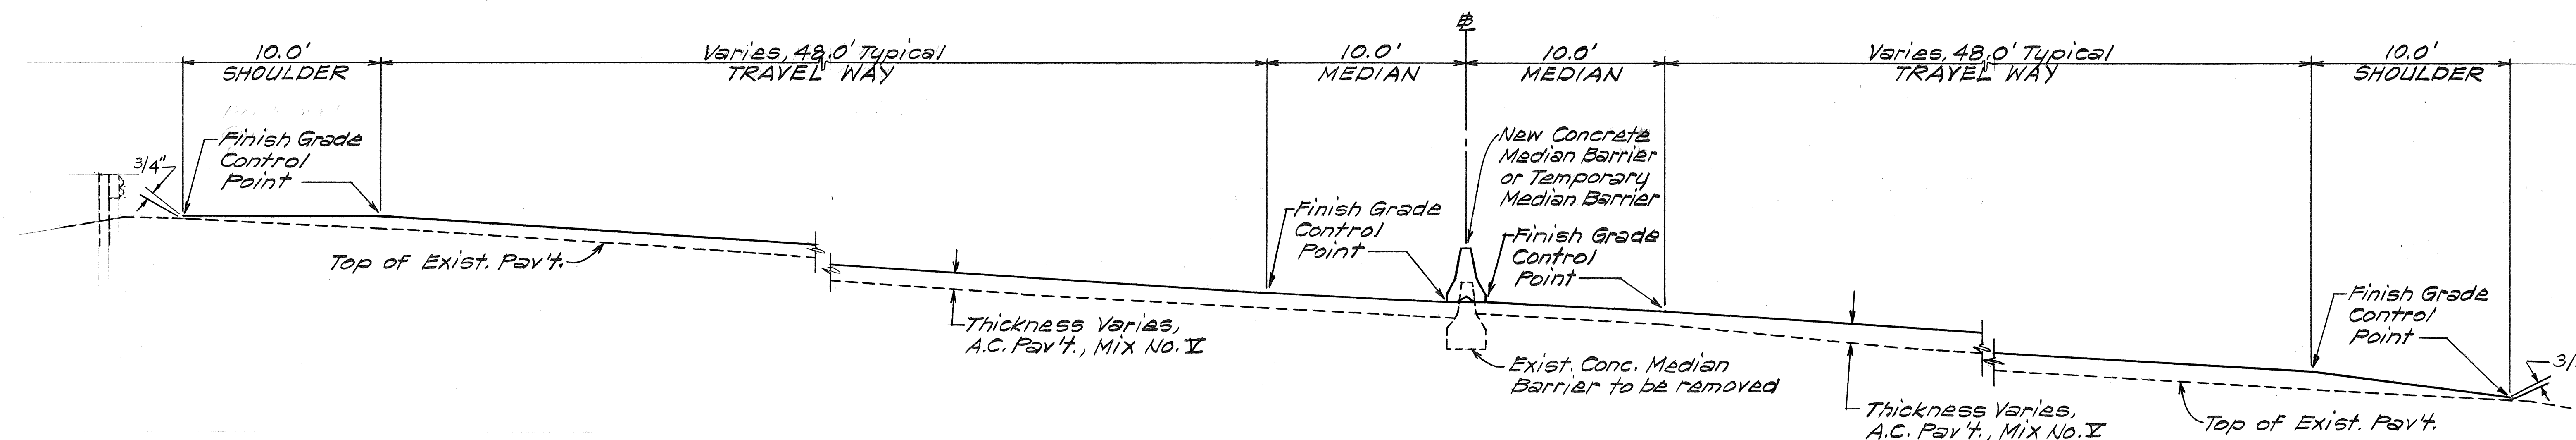

TYPICAL SECTION
Scale: 1/4" = 1'-0"

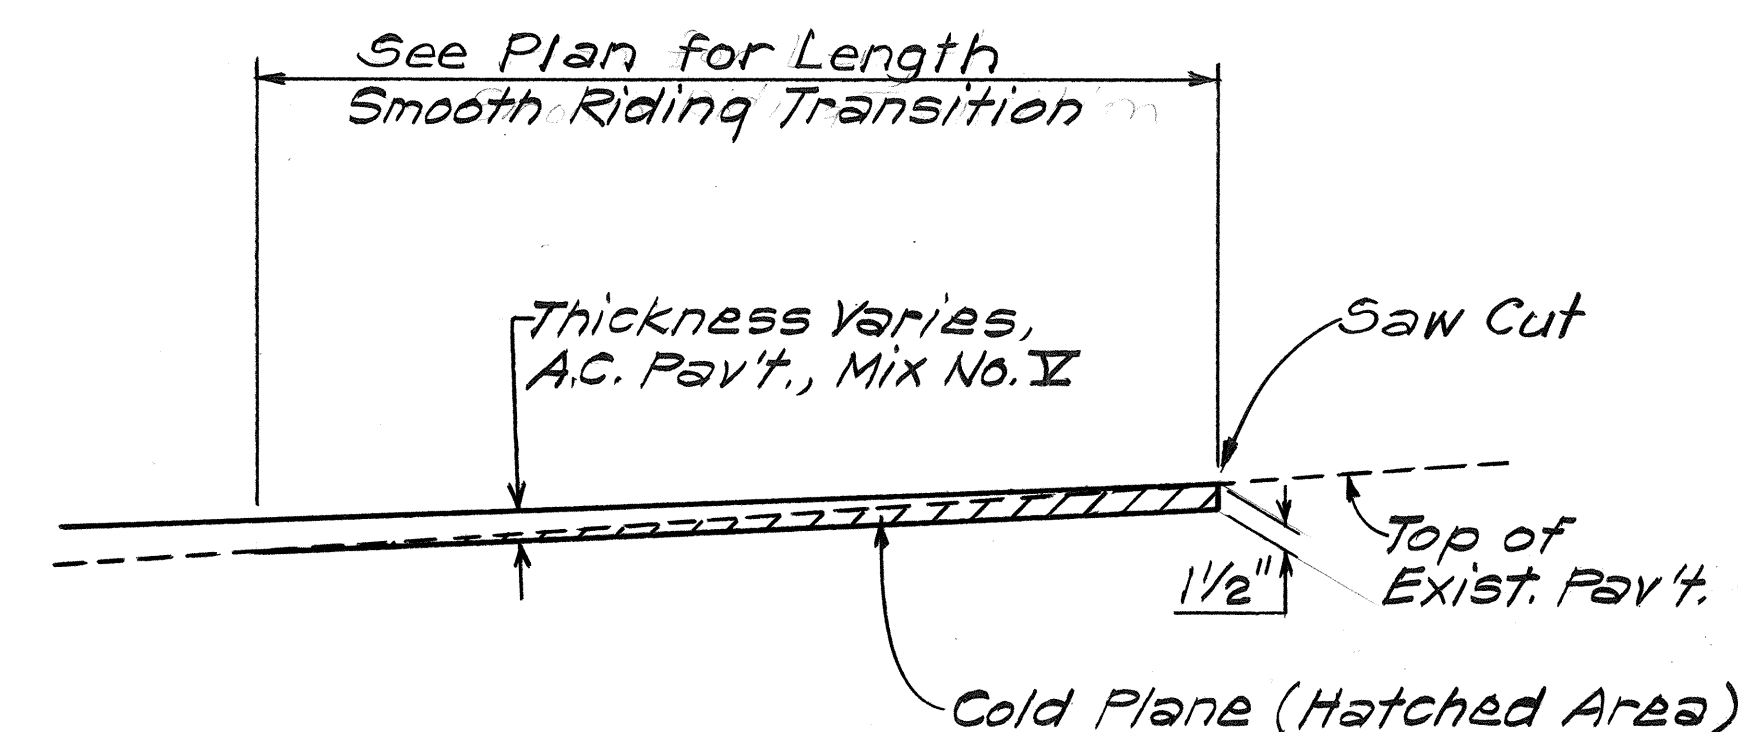

**TRANSITION DETAIL AT
BEGINNING & END OF RESURFACING**
Not to Scale

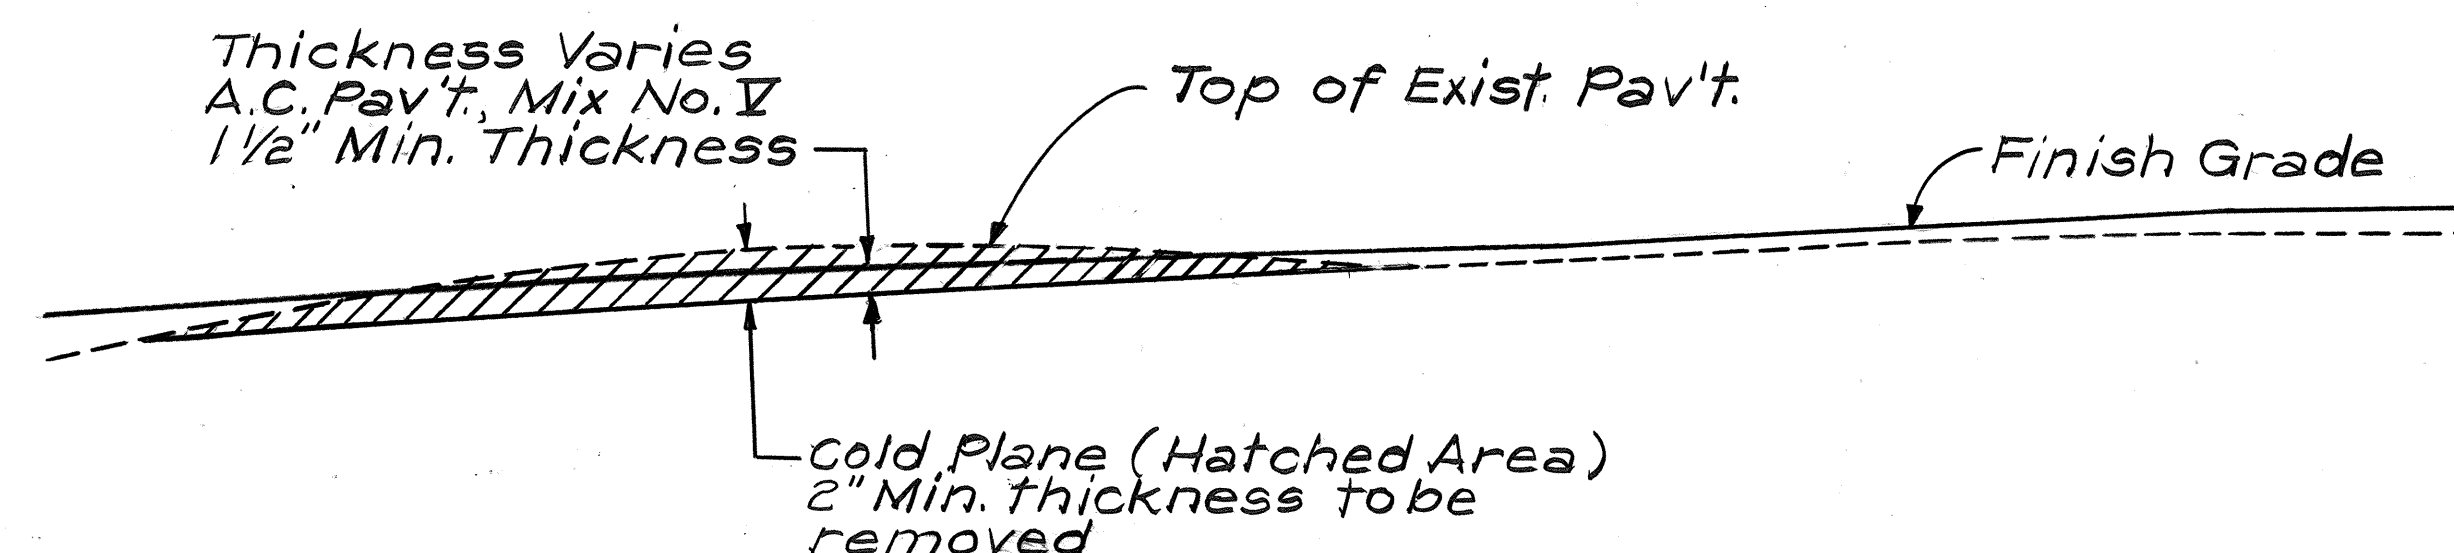

COLD PLANE AREA DETAIL
± Sta. 224+50± to ± Sta. 226+00± Lt.
Not to Scale

STATE OF HAWAII
DEPARTMENT OF TRANSPORTATION
HIGHWAYS DIVISION

TYPICAL SECTIONS

**INTERSTATE ROUTE H-1
HALAWA INTERCHANGE
F.A.I. Proj. No. IR-HI-1(196)**

Scale: As Shown Date: July, 1985

SHEET No. 1 OF 1 SHEETS

ORIGINAL PLAN	DATE
SURVEY PLOTTED BY	
DRAWN BY	
DESIGNED BY	
QUANTITIES BY	
CHECKED BY	
NO.	