



CONSTRUCTION NOTES

1. The existing Metal Guardrails and Posts in the Medians shall be removed and disposed of in accordance with Section 600~ GUARDRAILS, of the Special Provisions. This work shall be incidental to Type 50CM~Concrete Median Barrier and will not be paid for separately.
2. The Contractor shall implement the Construction Zone Traffic Control as shown on Sheet No. 6 prior to commencing work in the median area.
3. For Concrete Barrier and P.C.C. Pavement Joint Details see Sheet No. 10.
4. For details modifying Drainage Structures, removing 18" Slotted Drain and other Drainage details, See Drainage Plans. See sheets 23 to 31.
5. For Median edge striping and pavement markers, see details on sheet no. 32.

FED. ROAD DIST. NO.	STATE	FED. AID PROJ. NO.	FISCAL YEAR	SHEET NO.	TOTAL SHEETS
HAWAII	HAW.	1R-HI-1(197)	1986	4	38

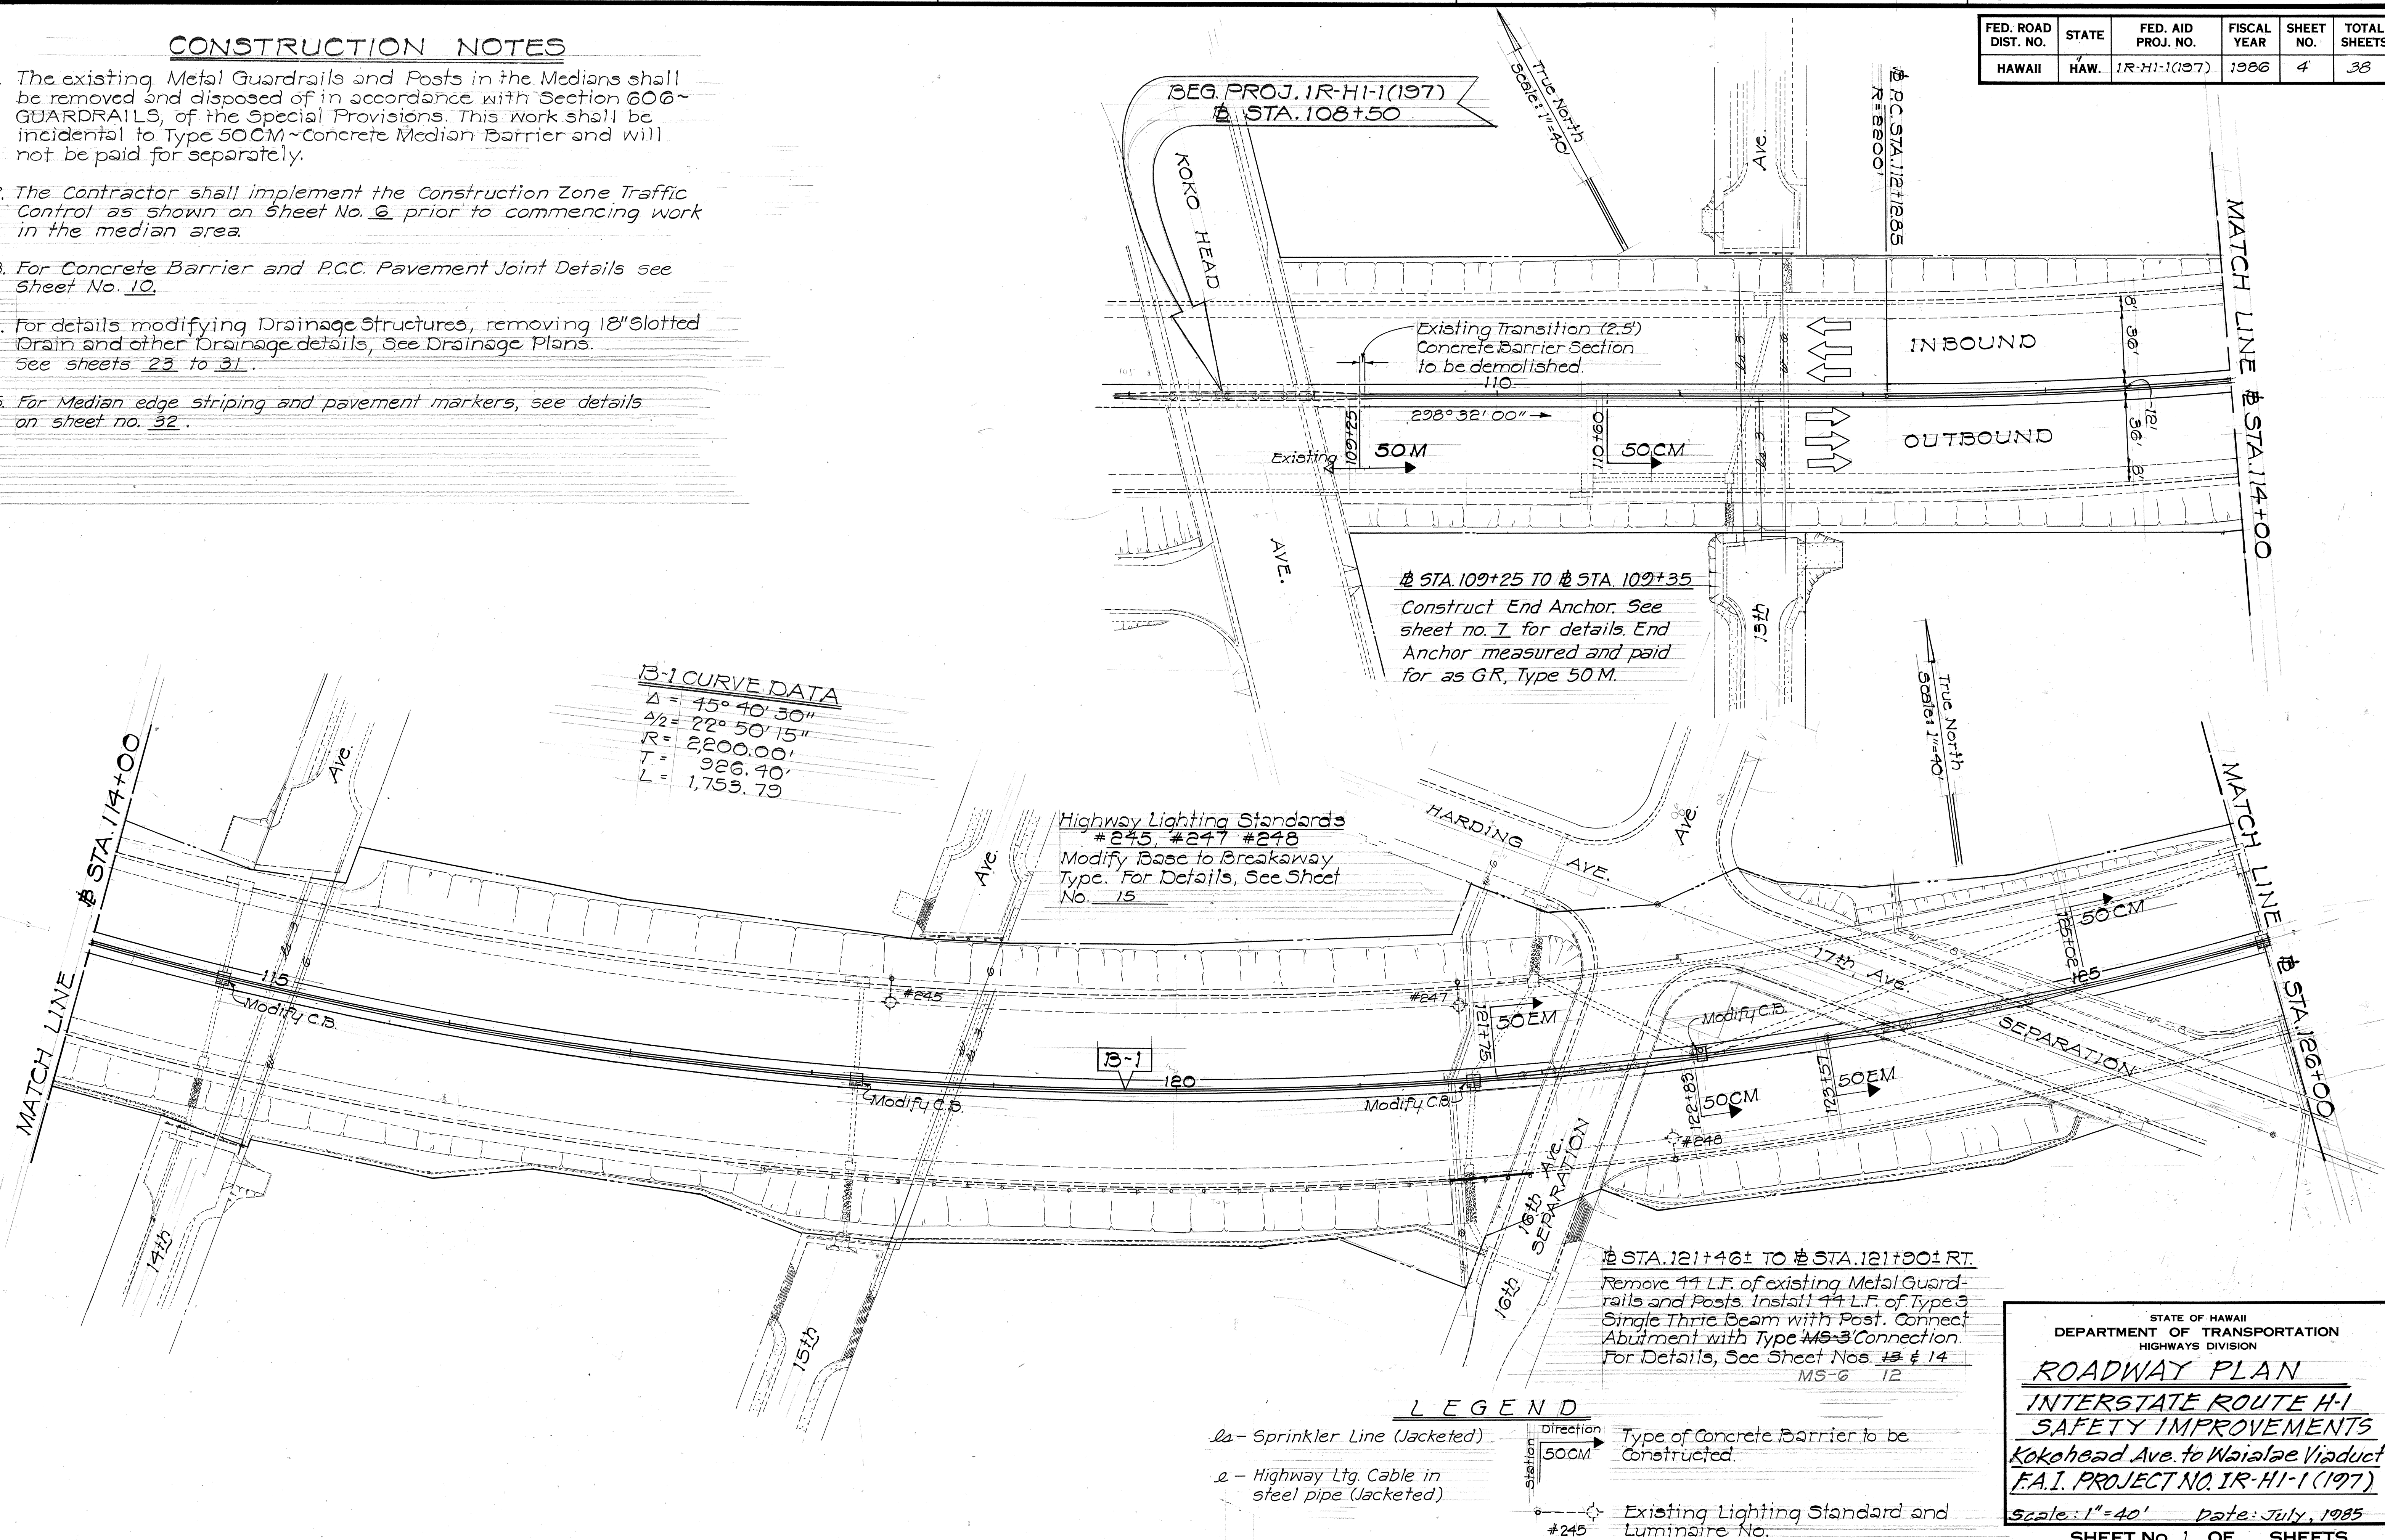

FED. ROAD DIST. NO.	STATE	FED. AID PROJ. NO.	FISCAL YEAR	SHEET NO.	TOTAL SHEETS
HAWAII	HAW.	1R-HI-1(197)	1986	5	38

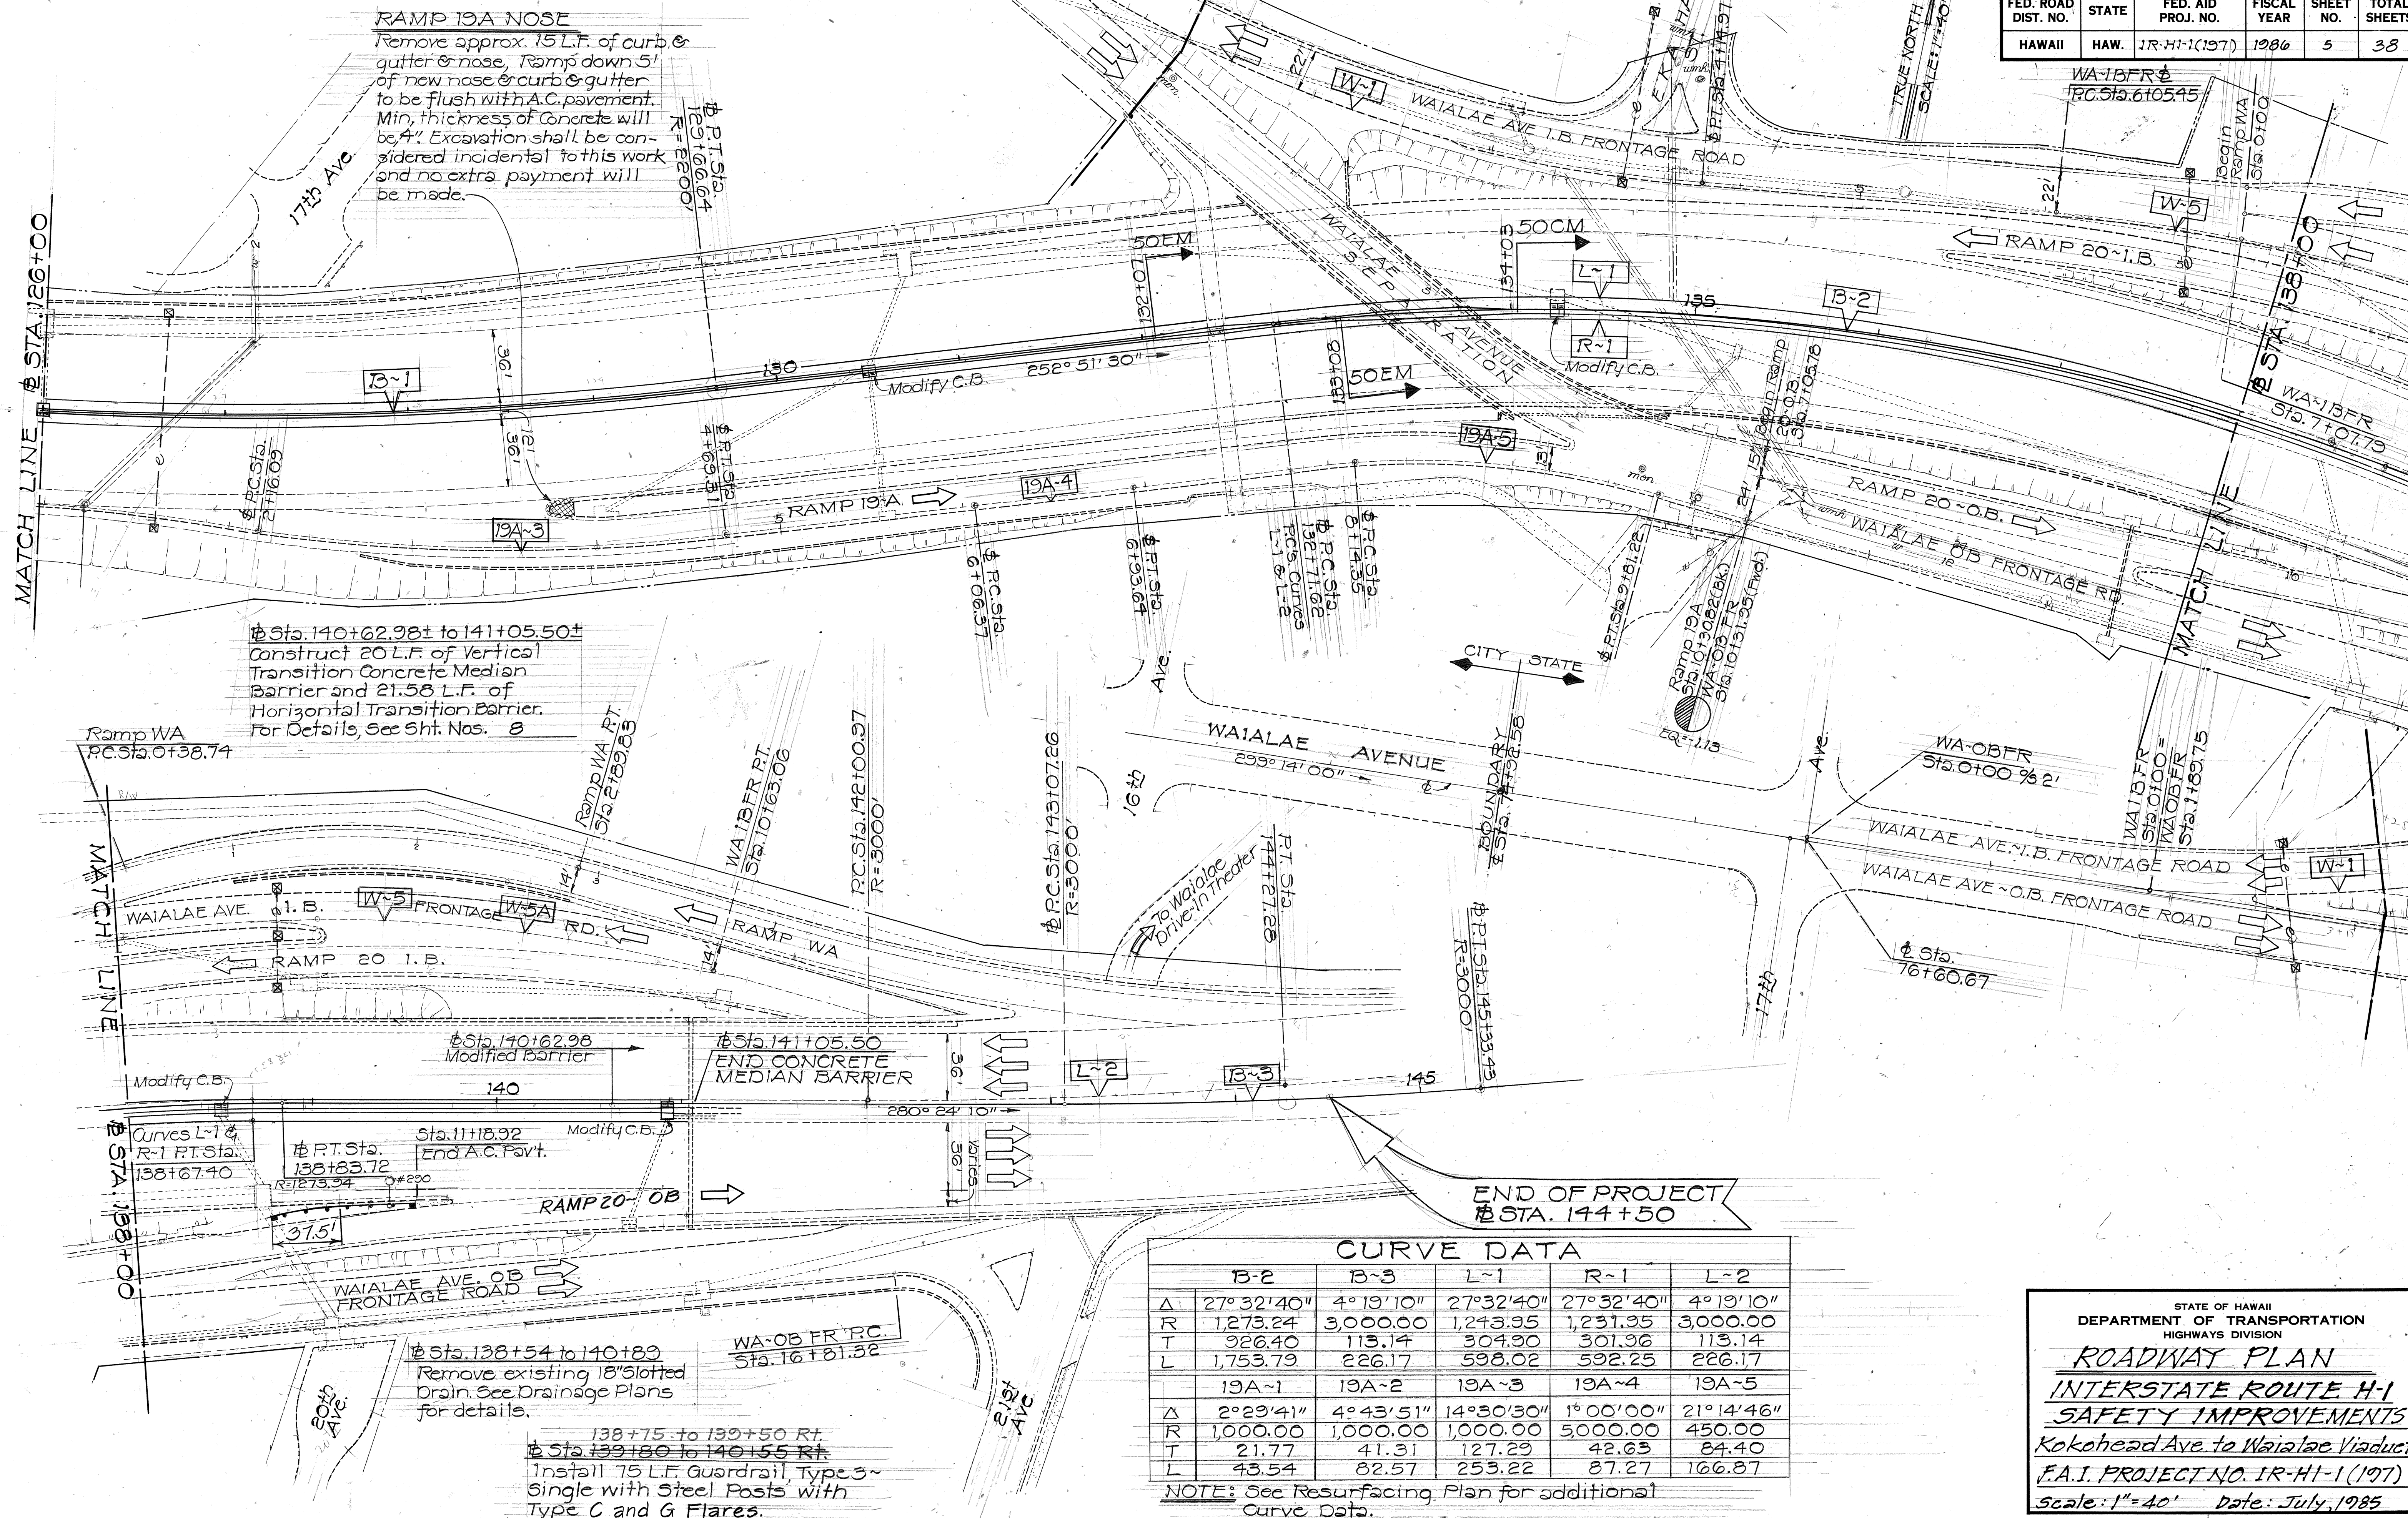

	B-2	B-3	L-1	R-1	L-2
Δ	27° 32' 40"	4° 19' 10"	27° 32' 40"	27° 32' 40"	4° 19' 10"
R	1,273.24	3,000.00	1,243.95	1,231.95	3,000.00
T	326.40	113.14	304.30	301.36	113.14
L	1,753.79	226.17	598.02	592.25	226.17
Δ	2° 29' 41"	4° 43' 51"	14° 30' 30"	1° 00' 00"	21° 14' 46"
R	1,000.00	1,000.00	1,000.00	5,000.00	450.00
T	21.77	41.31	127.29	42.63	84.40
L	43.54	82.57	253.22	87.27	166.87

NOTE: See Resurfacing Plan for additional Curve Data.

STATE OF HAWAII
DEPARTMENT OF TRANSPORTATION
HIGHWAYS DIVISION

ROADWAY PLAN
INTERSTATE ROUTE HI-1
SAFETY IMPROVEMENTS
Kokohead Ave. to Waialae Viaduct
F.A.I. PROJECT NO. 1R-HI-1(197)
Scale: 1" = 40' Date: July, 1985
SHEET No. 5 OF SHEETS