	INDEX TO DRAWINGS					
SHEET NO.	DESCRIPTION					
	TITLE SHEET					
2-3	TYPICAL SECTION & NOTES					
4-5	ROADWAY PLAN					
6	CONSTRUCTION ZONE TRAFFIC					
	CONTROL					
7-9	CONCRETE BARRIER DETAILS					
10	JOINT DETAILS					
11-19,	MISC. ROADWAY & STANDARD					
19A, 20	DETAILS					
21-22	RESURFACING PLAN					
23-31	DRAINAGE PLAN & DETAILS					
32-37	PAV'T. MARKING & STRIPING					
PLAN, AND DETAILS ,						

		1				



STATE OF HAWAII

HAWAII

DEPARTMENT OF TRANSPORTATION HIGHWAYS DIVISION

HONOLULU, HAWAII

"AS-BUILT"


PLANS OF


INTERSTATE ROUTE H-I SAFETY IMPROVEMENT

KOKO HEAD AVENUE TO WAIALAE VIADUCT

FEDERAL AID INTERSTATE PROJ. NO. IR-HI-I(197)

DISTRICT OF HONOLULU ISLAND OF OAHU

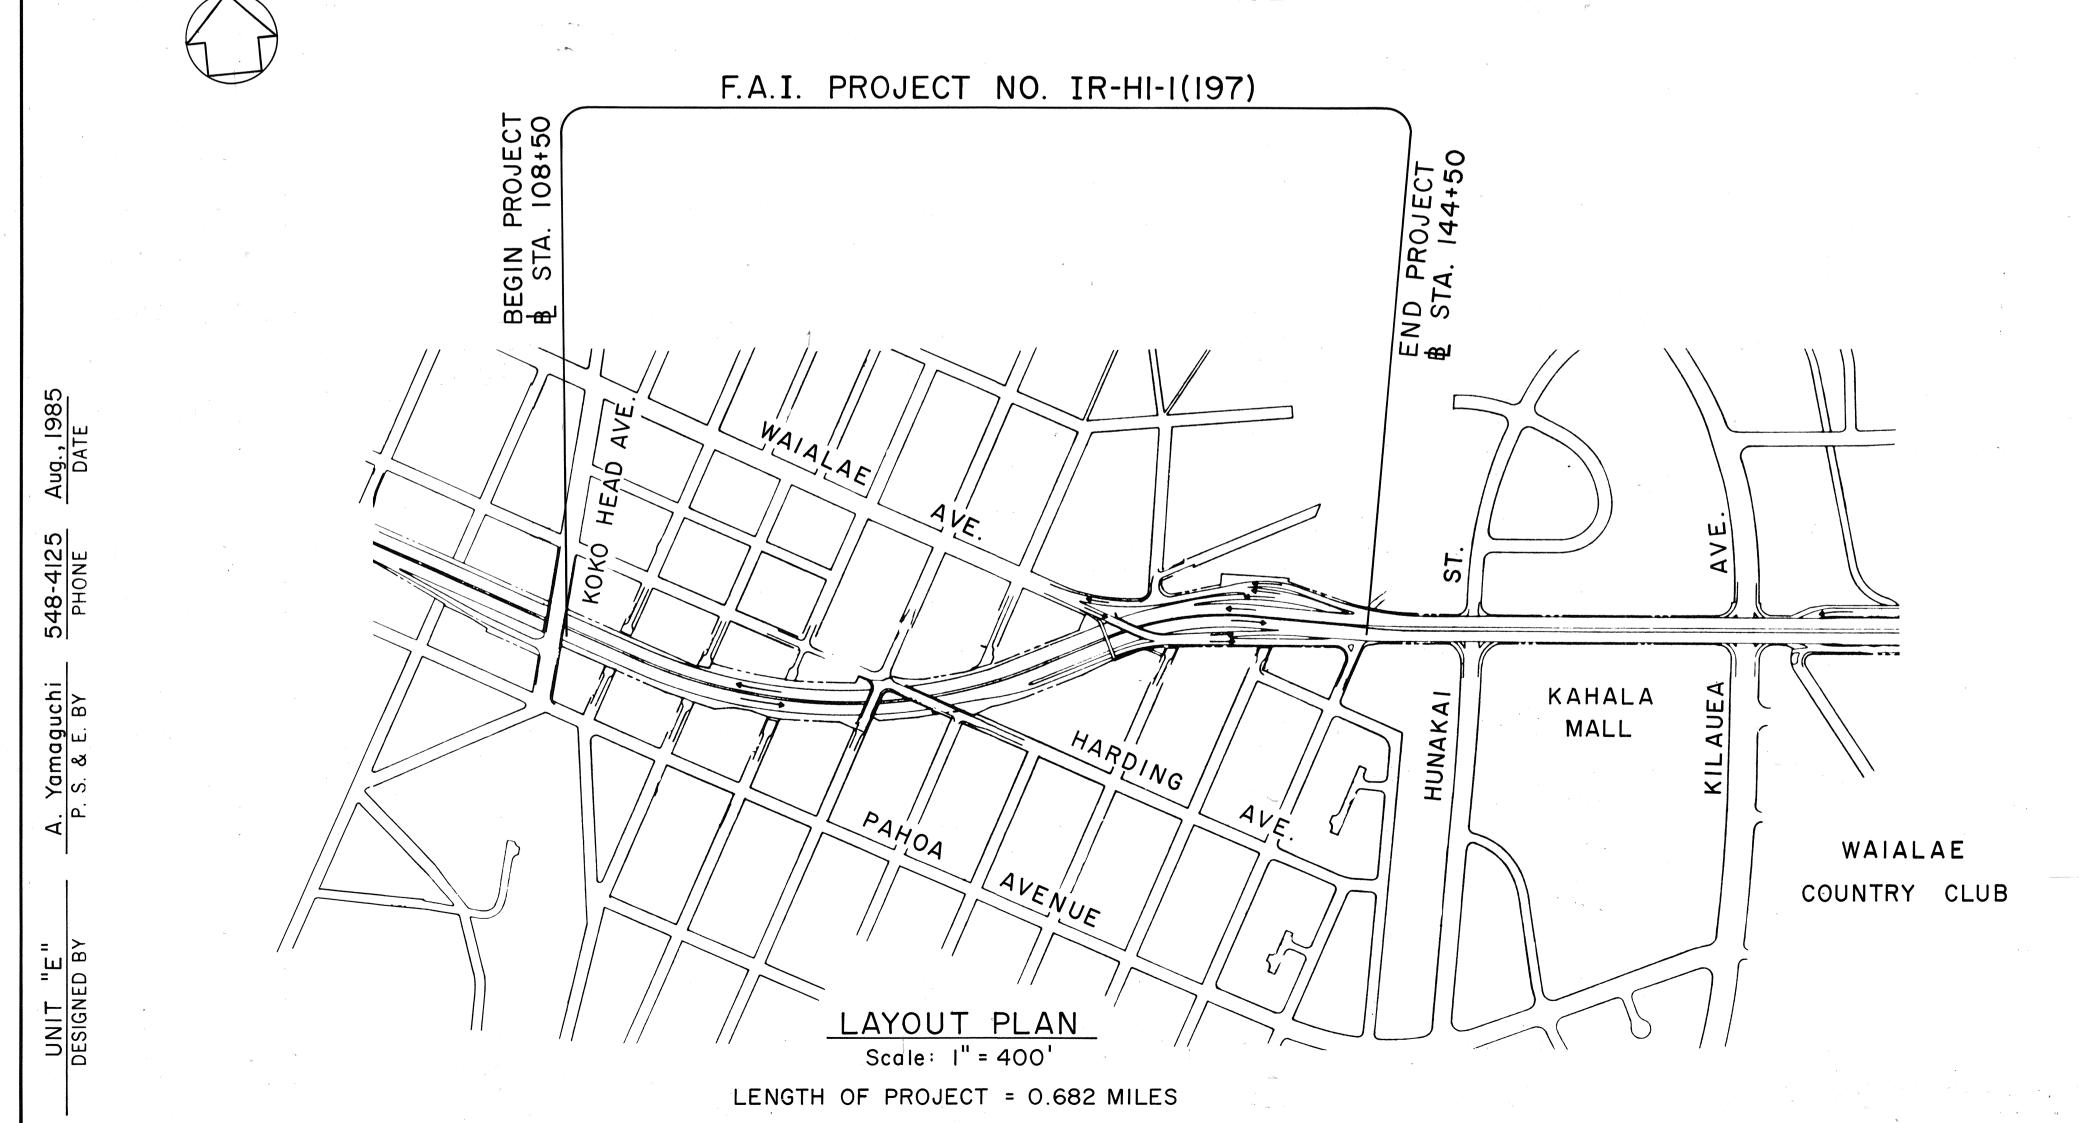

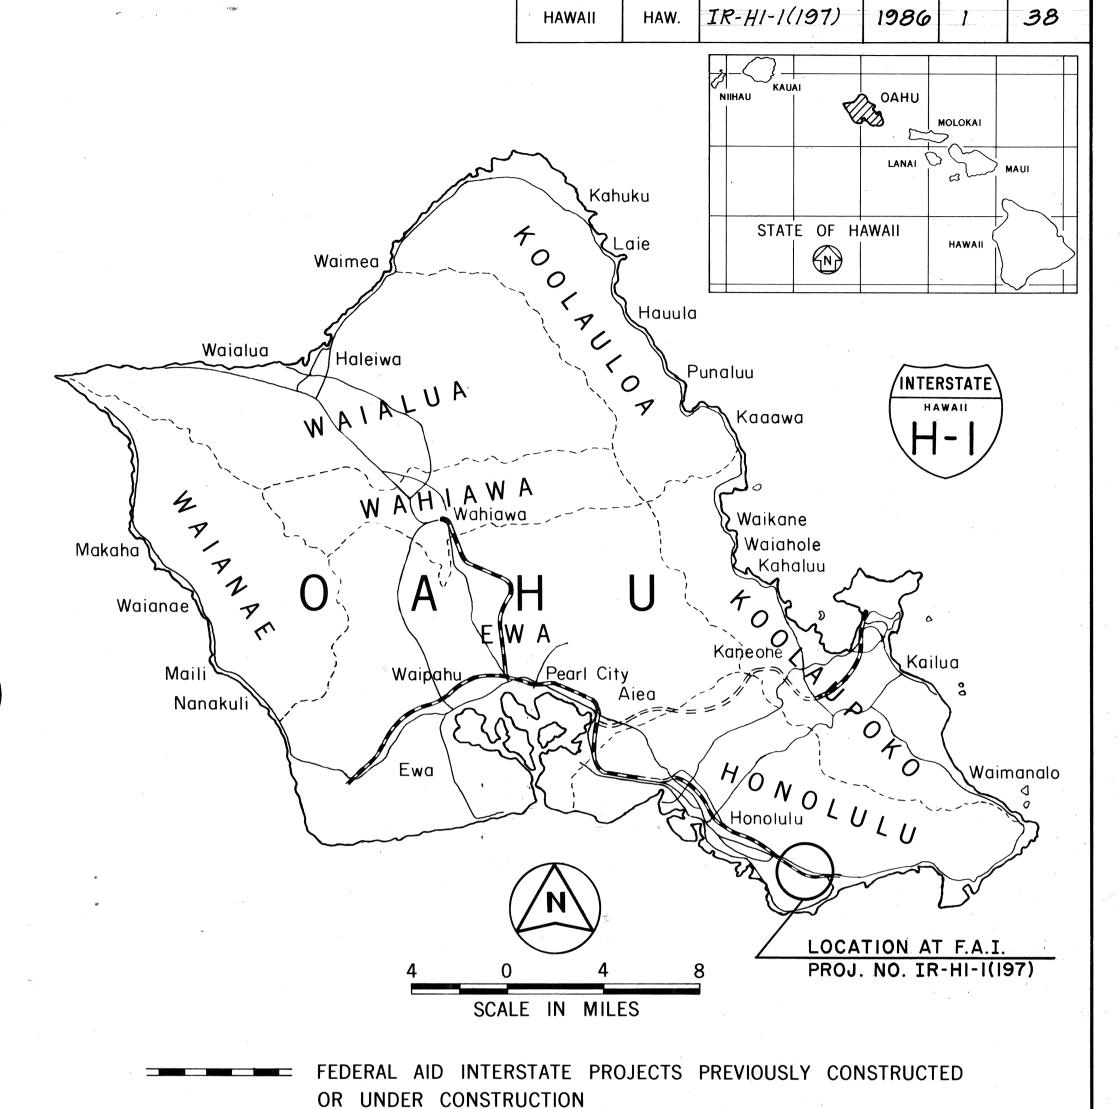

DIST. NO.

FED. AID PROJ. NO. FISCAL YEAR SHEET TOTAL NO. SHEETS

DESIG	and the second s	DESI	<u>GNA</u>	IION
ADT ADT DESIGN A	(198 (199 (200 DT)	35) 95) 95)		64,400 74,200 87,900
)HV				7,900 80/20
				2.5 %

CHANGES MADE DURING CONSTRUCTION HAVE
BEEN INCORPORATED ON THESE PLANS EXCEPT
CHANGES IN THE ORIGINAL THEORETICAL
QUANTITIES. FOR ACTUAL QUANTITIES, REFER TO
PROJECT LEDGER AND/OR COMPUTATION BOOK.

Virgino P. Honzales 11-19-86

RESIDENT ENGINEER DATE

DEPARTMENT OF TRANSPORTATION
FEDERAL HIGHWAY ADMINISTRATION
APPROVED:

Machine 10/2/85

DIVISION ADMINISTRATOR DATE

DEPARTMENT OF TRANSPORTATION
STATE OF HAWAII

APPROVED:

Approved:

DIR. OF TRANSPORTATION

DATE