

ORIGINAL PLAN
DATE: _____
DRAWN BY: _____
DESIGNED BY: _____
CHECKED BY: _____
NO. _____

GUARDRAIL SCHEDULE

FED. ROAD DIST. NO.	STATE	FED. AID PROJ. NO.	FISCAL YEAR	SHEET NO.	TOTAL SHEETS
HAWAII	HAW.	IR-HI-1 (1993)	1986	16	62

APPROXIMATE QUANTITIES

LIMITS ~ STA. TO STA.	DESCRIPTION OF GUARDRAIL WORK	Reference Plan Sheet No. For Details	Remove Exist. Metal Guardrail	Reinstall Metal Guardrail Element, Rubrail & Spacer Blocks	Furnish & Install Steel Post & Spacer Block	Terminal Section Type "G" Flare	Reset Exist. Metal Guard-rail Post	Remove & Reinstall Exist. Metal Guardrail	Type 6 Bituminous Curb	Concrete Barrier Transition	Type 50C Concrete Barrier	Type 50 Concrete Barrier	Renovate Pier Barrier	Transition Section ~ Pearl City Viaduct Concrete Barrier	Median Concrete Barrier Glare Screen on Pearl City Viaduct	Concrete Glare Screen on Exist. Median Barrier	Transition Section - Perm. Port. Conc. Barrier to Exist. Conc. Barrier	Permanent Portable Concrete Barrier-Type 50 P1	Permanent Portable Concrete Barrier-Type 50 P2	Remove Exist. Concrete Median Barrier	Furnish & Install Rubrail Element	Terminal Section Type "C" Flare
			L.F.	L.F.	Ea.	Ea.	Ea.	L.F.	L.F.	L.F.	L.F.	L.F.	L.F.	L.F.	L.F.	Ea.	L.F.	L.F.	L.F.	L.F.	L.F.	Ea.
I.B. 514+00± - I.B. 518+87±	Remove Exist. Type 3-Single Metal Guard-rail w/Metal Posts & Rubrail		487																			
O.B. 515+50± - O.B. 519+50± (I.B. 518+87±)	Reinstall Metal Guardrail Element, Rub-rail & Spacer Blocks on I.B. Side of Exist. O.B. Median Guardrail	19		400	4																	
I.B. 518+87± - I.B. 519+20±	Construct Concrete Barrier Transition	19								33												
I.B. 518+87± - 527+81±	Remove Exist. Type 3-Double Face Metal Guardrail w/Metal Posts & Rubrail		894																			
I.B. 519+20± - I.B. 520+37±	Install Type 50C Concrete Barrier including Modification Over Drop Inlet	20									117											
I.B. 520+37± - 527+81±	Install Type 50 Concrete Barrier	20										744										
527+81± - 528+93±	Renovate Pier Barriers & Install Concrete Glare Screen (Struct. No. 1)	21											74			16						
528+93± - 532+90±	Remove Exist. Type 3-Double Face Metal Guardrail w/Metal Posts & Rubrail Install Type 50 Concrete Barrier	20	397								397											
532+90± - 533+04± (3+79±)	Replace Transition Barrier at Pearl City Viaduct	21												14								
532+98± R+ - 533+22± R+	Stiffen 25' Exist. Guardrail Connection to the Approach End at Concrete Bridge. Install Rubrail	2 (Note 7)			4																25	
3+79± - 63+00±	Install Median Concrete Barrier Glare Screen on Pearl City Viaduct	20													5,920							
63+00± - 94+67±	Install Concrete Glare Screen on Exist. Median Barrier	20														3,167						
94+67± - 95+63±	Renovate Pier Barrier & Install Concrete Glare Screen (Kaahumanu St. Separation)	21											30			51						
95+63± - 102+41±	Install Concrete Glare Screen on Exist. Median Barrier	20														678						
102+41± - 102+44±	Construct Transition to Exist. Concrete Median Barrier	22															1					
102+44± - 110+84±	Remove Exist. Concrete Median Barrier. Install Permanent Portable Concrete Barrier	22																840		840		
H-2 Inbound 482+60± - 483+10± Lt.	Remove Exist. Type 3-Single Metal Guard-rail w/Metal Posts & Rubrail. Install Type "C" Flare Terminal Section w/Rubrail.	CO 20 9-1	50																		50	1
H-1 Inbound 507+63± - 508+13± R+	Remove Exist. Type 3-Single Metal Guard-rail w/Metal Posts & Rubrail. Install Type "C" Flare Terminal Section w/Rubrail.	CO 20 9-1	50																		50	1
Sub-total 1			1,878	400	8	-	-	-	-	33	117	1,141	104	14	5,920	3,912	1	840	-	840	125	2

9/3/86 Added work, item, and quantities; Totals revised.
DATE REVISION

STATE OF HAWAII
DEPARTMENT OF TRANSPORTATION
HIGHWAYS DIVISION

GUARDRAIL SCHEDULE

INTERSTATE ROUTE H-1
ADDITIONAL LANES
F.A.I. Proj. No. IR-HI-1(1993)

Date: Aug, 1985

SHEET NO. 16 OF 14 SHEETS

ORIGINAL PLAN

NO.

SURVEY PLOTTED BY

DATE

DRAWN BY

DESIGNED BY

CHECKED BY

GUARDRAIL SCHEDULE																					
LIMITS~ STA. TO STA.	DESCRIPTION OF GUARDRAIL WORK	Reference Plan Sheet No. For Details	APPROXIMATE QUANTITIES																		
			Remove Exist Metal Guardrail	Reinstall Metal Guardrail Element, Rubrail & Spacer Blocks	Furnish & Install Steel Post & Spacer Block	Terminal Section Type "G" Flare	Reset Exist Metal Guardrail Post	Remove & Reinstall Exist Metal Guardrail	Type G Bituminous Curb	Concrete Barrier Transition	Type 50C Concrete Barrier	Type 50 Concrete Barrier	Renovate Pier Barrier	Transition Section ~ Pearl City Viaduct Concrete Barrier	Median Concrete Barrier Glare Screen on Pearl City Viaduct	Concrete Glare Screen on Exist Median Barrier	Transition Section-Perm. Port. Conc. Barrier to Exist. Conc. Barrier	Permanent Portable Concrete Barrier-Type 50 P1	Permanent Portable Concrete Barrier-Type 50 P2	Remove Exist Concrete Median Barrier	Furnish & Install Rubrail Element
			L.F.	L.F.	Ea.	Ea.	Ea.	L.F.	L.F.	L.F.	L.F.	L.F.	L.F.	L.F.	L.F.	L.F.	Ea.	L.F.	L.F.	L.F.	L.F.
110+84± - 110+87±	Construct Transition to Exist Concrete Median Guardrail	22														1					
102+00±Rt. - 110+50±Rt.	Remove & Reinstall Exist Metal Guardrail w/Bituminous Curb	7						850	850												
102+00±Lt. - 110+50±Lt.	Reset Exist Metal Guardrail Posts	24					142														
110+50±Rt. - 110+75±Rt.	Stiffen 25' Exist Guardrail Connection to the Approach End at Concrete Bridge. Install Rubrail	2(Notes 7)			4	4														25	
110+87± - 138+54±	Install Concrete Glare Screen on Exist Median Barrier	20													2,767	2,767					
123+80±Lt. - 124+05±Lt.	Stiffen 25' Exist Guardrail Connection to the Approach End at Concrete Bridge. Install Rubrail	2(Notes 7)			4	4														25	
138+54± - 139+77±	Install Concrete Glare Screen on Exist Median Barrier (Kaonohi Street Separation)	21													109	109					
139+77± - 144+81±	Install Concrete Glare Screen on Exist Median Barrier	20													504	504					
144+81± - 144+84±	Construct Transition to Exist Concrete Median Barrier	22														1					
144+84± - 149+64±	Remove Exist Concrete Median Barrier. Install Permanent Portable Concrete Barrier	22															480		480		
145+00±Rt. - 149+20±Rt.	Remove & Reinstall Exist Metal Guardrail w/Bituminous Curb	7						420	420												
145+00±Lt. - 149+20±Lt.	Reset Exist Metal Guardrail Posts	24					70														
149+64± - 149+67±	Construct Transition to Exist Concrete Median Barrier	22														1					
149+67± - 162+67±	Install Concrete Glare Screen on Exist Median Barrier	20													1,300	1,300					
162+67± - 162+70±	Construct Transition to Exist Concrete Median Barrier	22														1					
162+70± - 168+70±	Remove Exist Concrete Median Barrier. Install Permanent Portable Concrete Barrier	22																600	600		
Sub-total 2			-	-	8	-	212	1,270	1,270	-	-	-	-	-	-	4,680	4	480	600	1,080	50

FED. ROAD DIST. NO.	STATE	FED. AID PROJ. NO.	FISCAL YEAR	SHEET NO.	TOTAL SHEETS
HAWAII	HAW.	IR-HI-1(193)	1986	17	62

STATE OF HAWAII
DEPARTMENT OF TRANSPORTATION
HIGHWAYS DIVISION

GUARDRAIL SCHEDULE

INTERSTATE ROUTE H-1
ADDITIONAL LANES
F.A.I. Proj. No. IR-HI-1(193)

Date: Aug. 1985

SHEET No. 2B OF 14 SHEETS

ORIGINAL PLAN
DATE
DRAWN BY
DESIGNED BY
CHECKED BY
NO.

GUARDRAIL SCHEDULE

FED. ROAD DIST. NO.	STATE	FED. AID PROJ. NO.	FISCAL YEAR	SHEET NO.	TOTAL SHEETS
HAWAII	HAW.	IR-HI-1(193)	1986	18	62

LIMITS - STA. TO STA.	DESCRIPTION OF GUARDRAIL WORK	Reference Plan Sheet No. For Details	APPROXIMATE QUANTITIES																			
			Remove Exist. Metal Guardrail	Reinstall Metal Guardrail Element, Rubrail & Spacer Blocks	Furnish & Install Steel Post & Spacer Block	Terminal Section Type "G" Flare	Reset Exist Metal Guard-rail Post	Remove & Reinstall Exist. Metal Guardrail	Type G Bituminous Curb	Concrete Barrier Transition	Type 50C Concrete Barrier	Type 50 Concrete Barrier	Renovate Pier Barrier	Transition Section ~ Pearl City Viaduct Concrete Barrier	Median Concrete Barrier Glare Screen on Pearl City Viaduct	Concrete Glare Screen on Exist Median Barrier	Transition Section - Perm. Port. Concrete Barrier to Exist Concrete Barrier	Permanent Portable Concrete Barrier-Type 50 P1	Permanent Portable Concrete Barrier-Type 50 P2	Remove Exist Concrete Median Barrier	Furnish & Install Rubrail Element	Terminal Section Type "C" Flare
			L.F.	L.F.	Ea.	Ea.	Ea.	L.F.	L.F.	L.F.	L.F.	L.F.	L.F.	L.F.	L.F.	Ea.	L.F.	L.F.	L.F.	L.F.	Ea.	
163+50± Rt. - 168+70± Rt.	Remove & Reinstall Exist. Metal Guardrail w/ Bituminous Curb	7						520	520													
162+60± Lt. - 163+10± Lt.	Remove Exist. Type 3-Single Metal Guard-rail w/ Metal Posts. Install Type "G" Flare Terminal Section	27	50			1																
163+10± Lt. - 163+70± Lt.	Reset Exist. Metal Guardrail Posts	24					94															
168+70± - 168+73±	Construct Transition to Exist. Concrete Median Barrier	22														1						
168+73± - 172+14±	Install Concrete Glare Screen on Exist. Median Barrier	20														341						
172+14± - 173+20±	Install Concrete Glare Screen on Exist. Median Barrier (Kaamilo Street Separation)	21														97						
173+20± - 180+25±	Install Concrete Glare Screen on Exist. Median Barrier	20														705						
180+25± - 180+32±	Renovate Pier Barriers & Install Concrete Glare Screen (Mahiko Street Pedestrian Overpass)	21											50			3						
180+32± - 191+71±	Install Concrete Glare Screen on Exist. Median Barrier	20														1,089						
181+00± Rt. - 189+00± Rt.	Reset Exist. Metal Guardrail Posts	24					134															
191+71± - 192+00±	Renovate Pier Barrier (Aiea Heights Drive Separation)	21											29									
Sub-total 3			50	-	-	1	228	520	520	-	-	-	79	-	-	2,235	1	-	-	-	-	
Sub-total 2			-	-	8	-	212	1,270	1,270	-	-	-	-	-	-	4,680	4	480	600	1,080	50	
Sub-total 1			1,878	400	8	-	-	-	-	33	117	1,141	104	14	5,920	3,912	1	840	-	840	125	
TOTAL			1,928	400	16	1	440	1,790	1,790	33	117	1,141	183	14	5,920	10,827	6	1,320	600	1,920	175	

9/3/86 Added item, Totals revised.
DATE REVISION

STATE OF HAWAII
DEPARTMENT OF TRANSPORTATION
HIGHWAYS DIVISION






GUARDRAIL SCHEDULE

INTERSTATE ROUTE H-1
ADDITIONAL LANES
F.A.I. Proj. No. IR-HI-1(193)

Date: Aug, 1985

SHEET No. 38 OF 14 SHEETS


FED. ROAD DIST. NO.	STATE	FED. AID PROJ. NO.	FISCAL YEAR	SHEET NO.	TOTAL SHEETS
HAWAII	HAW.	IR-HI-1(193)	1986	19	62

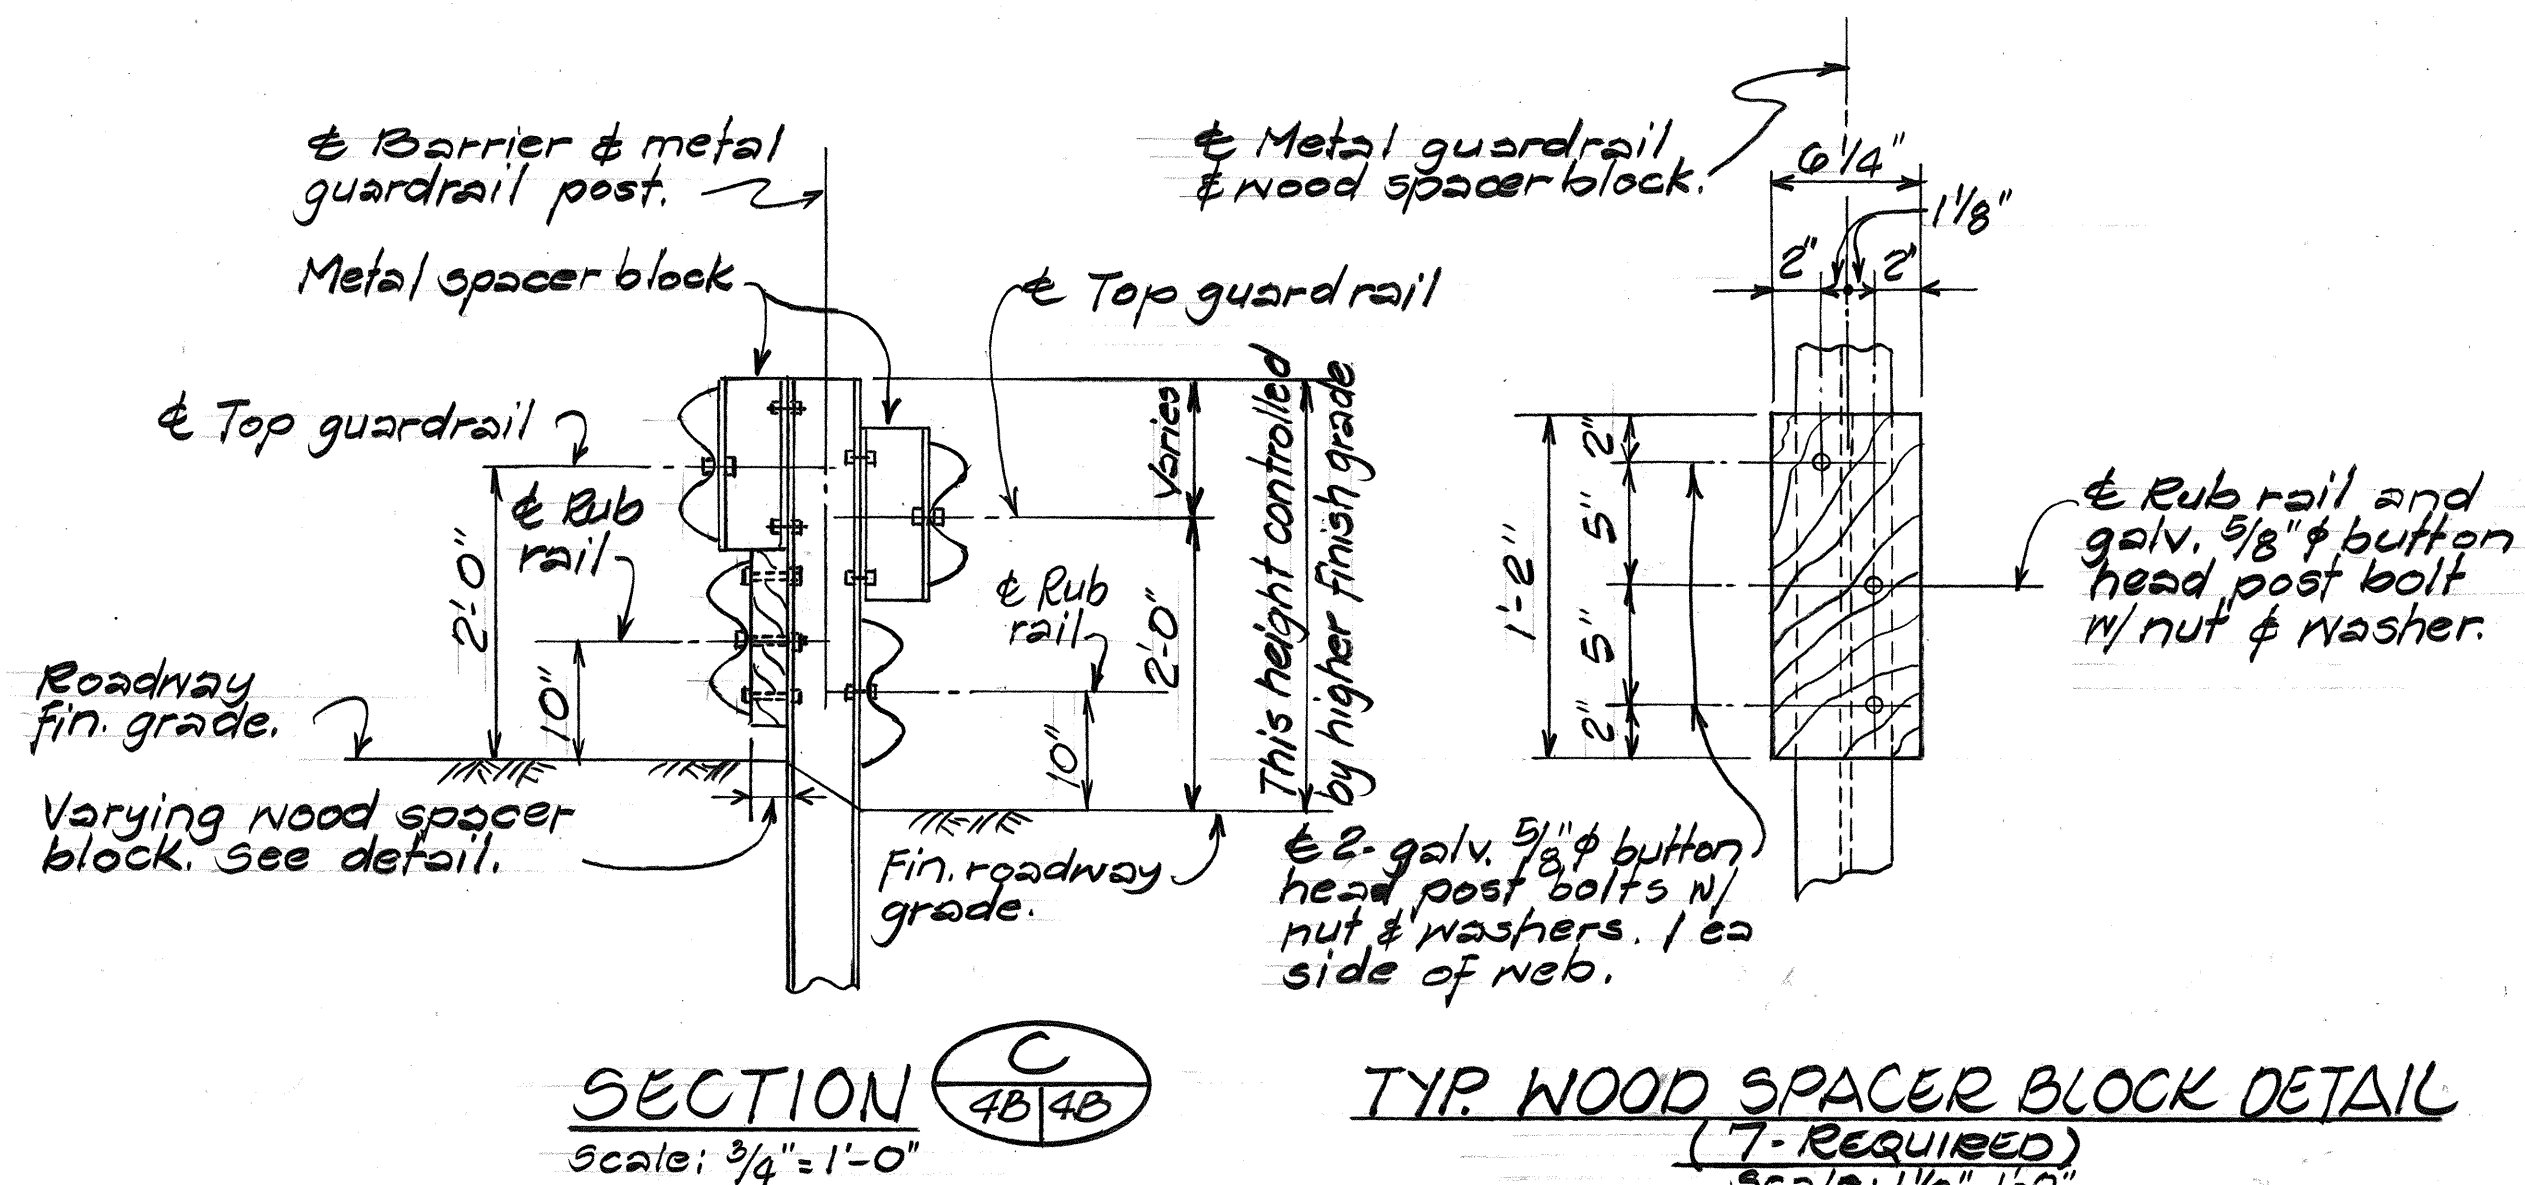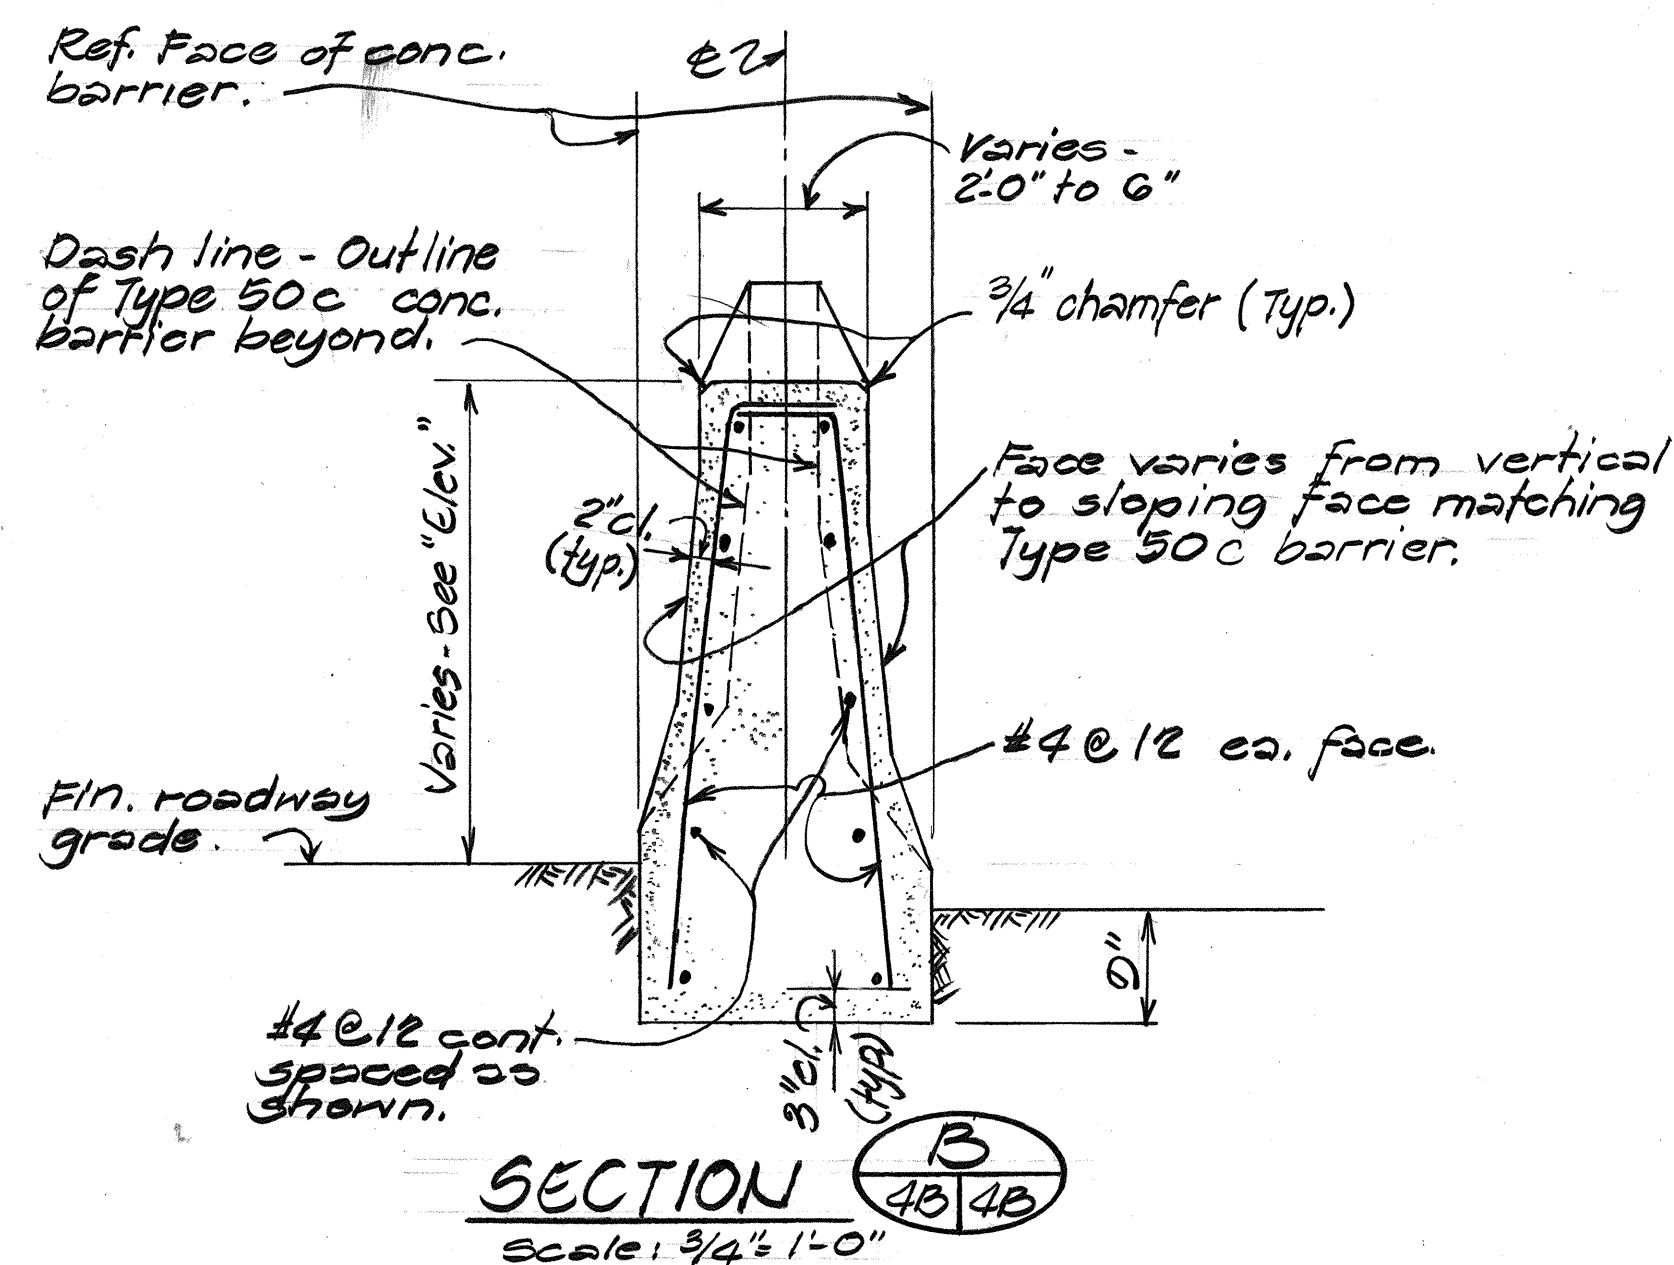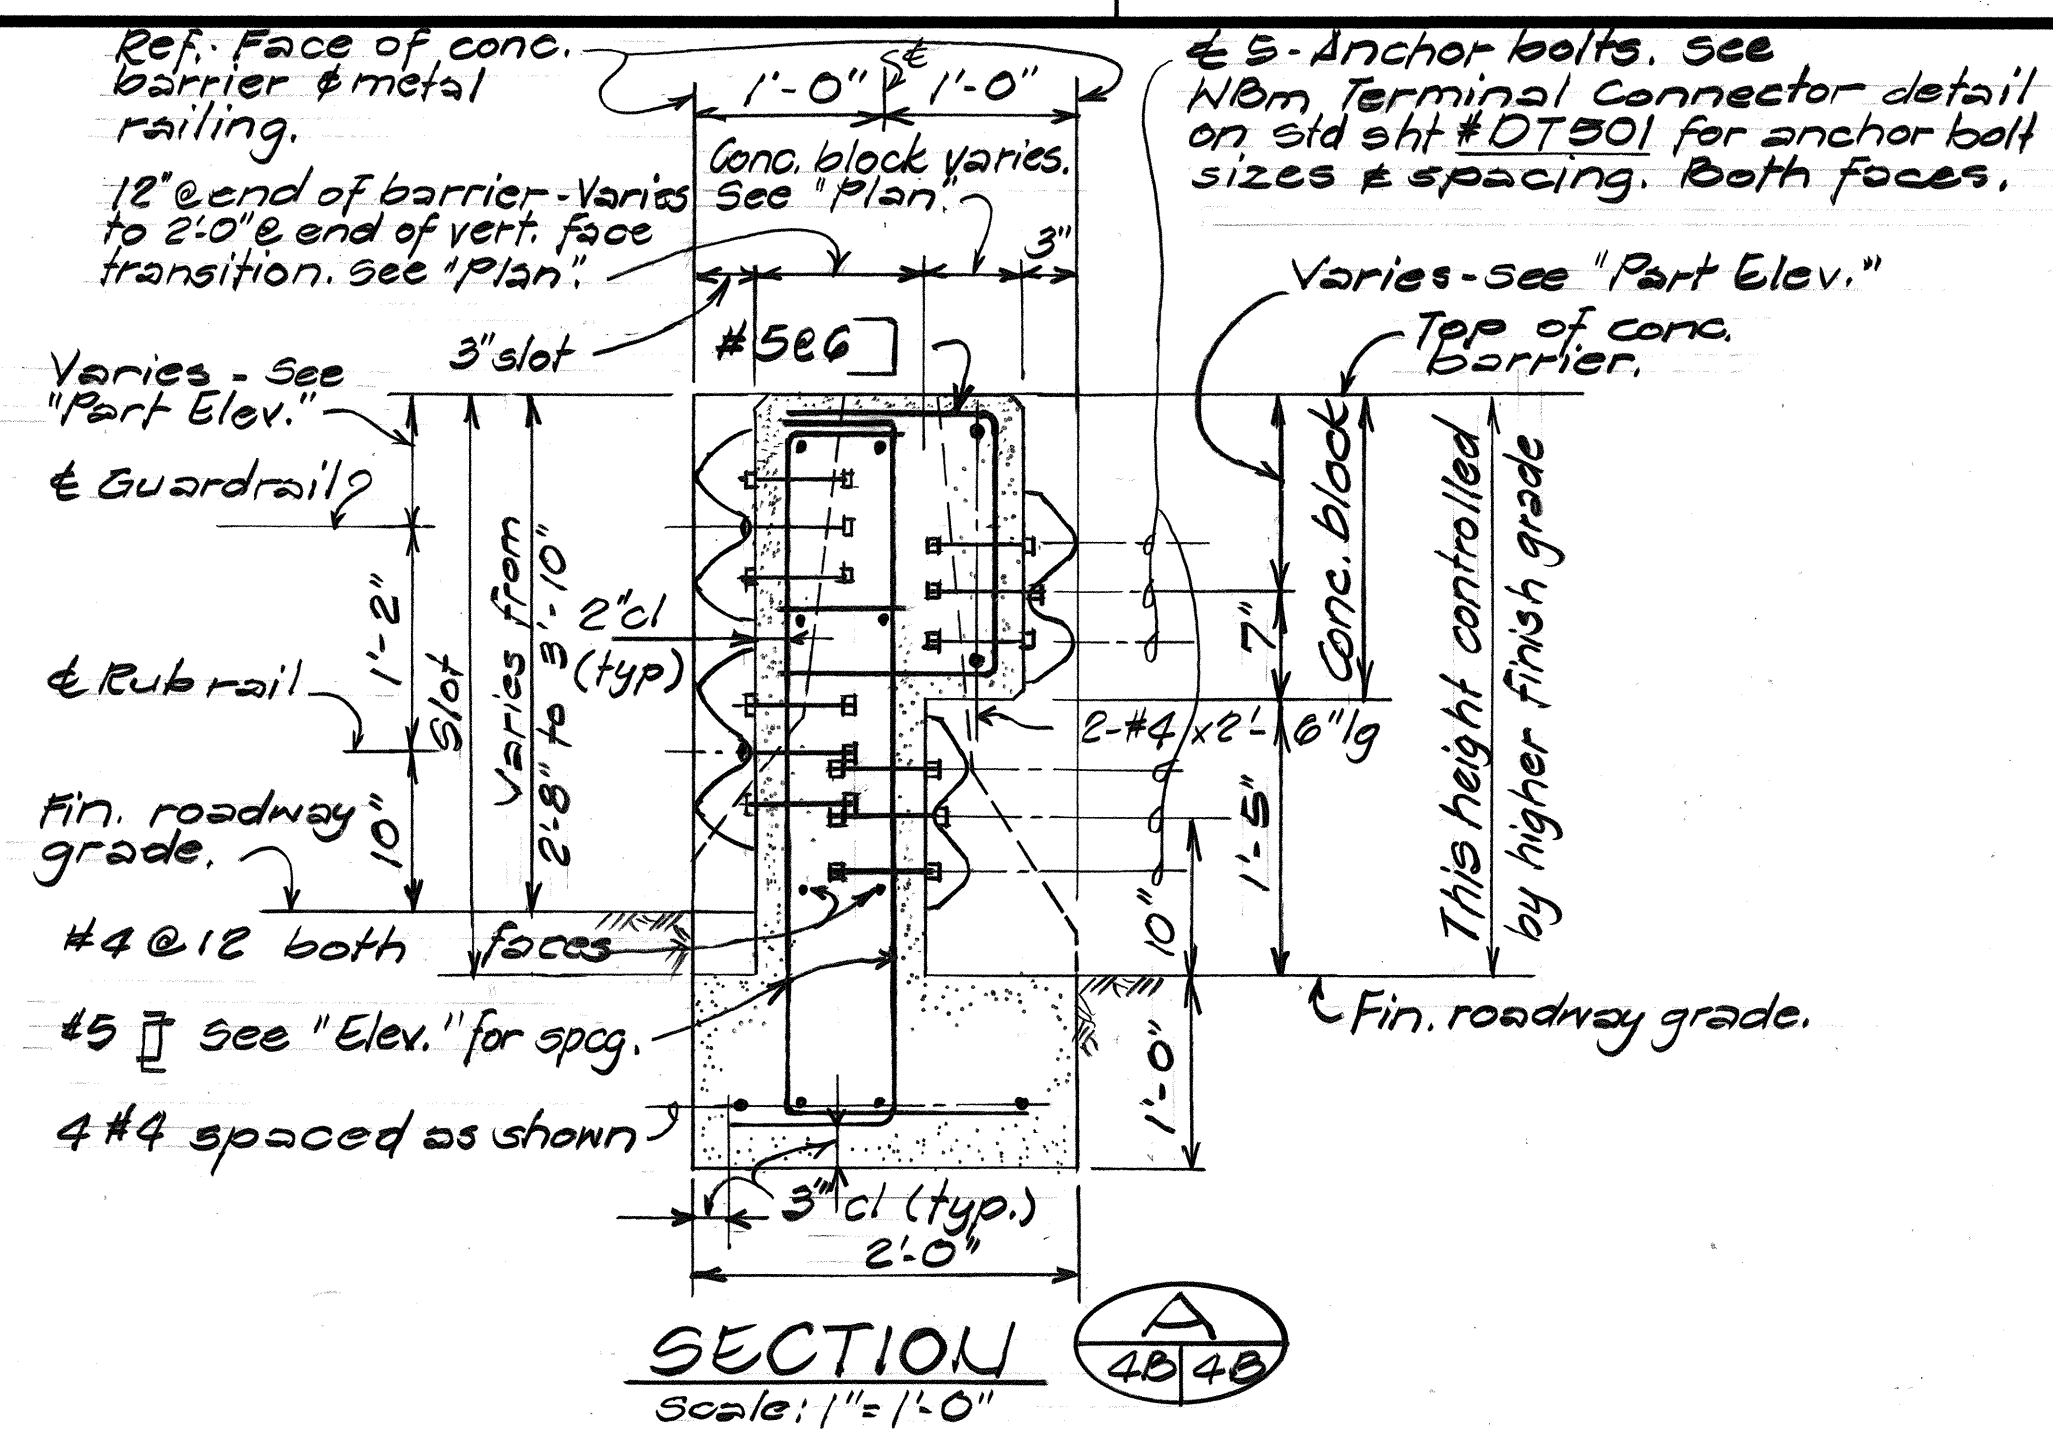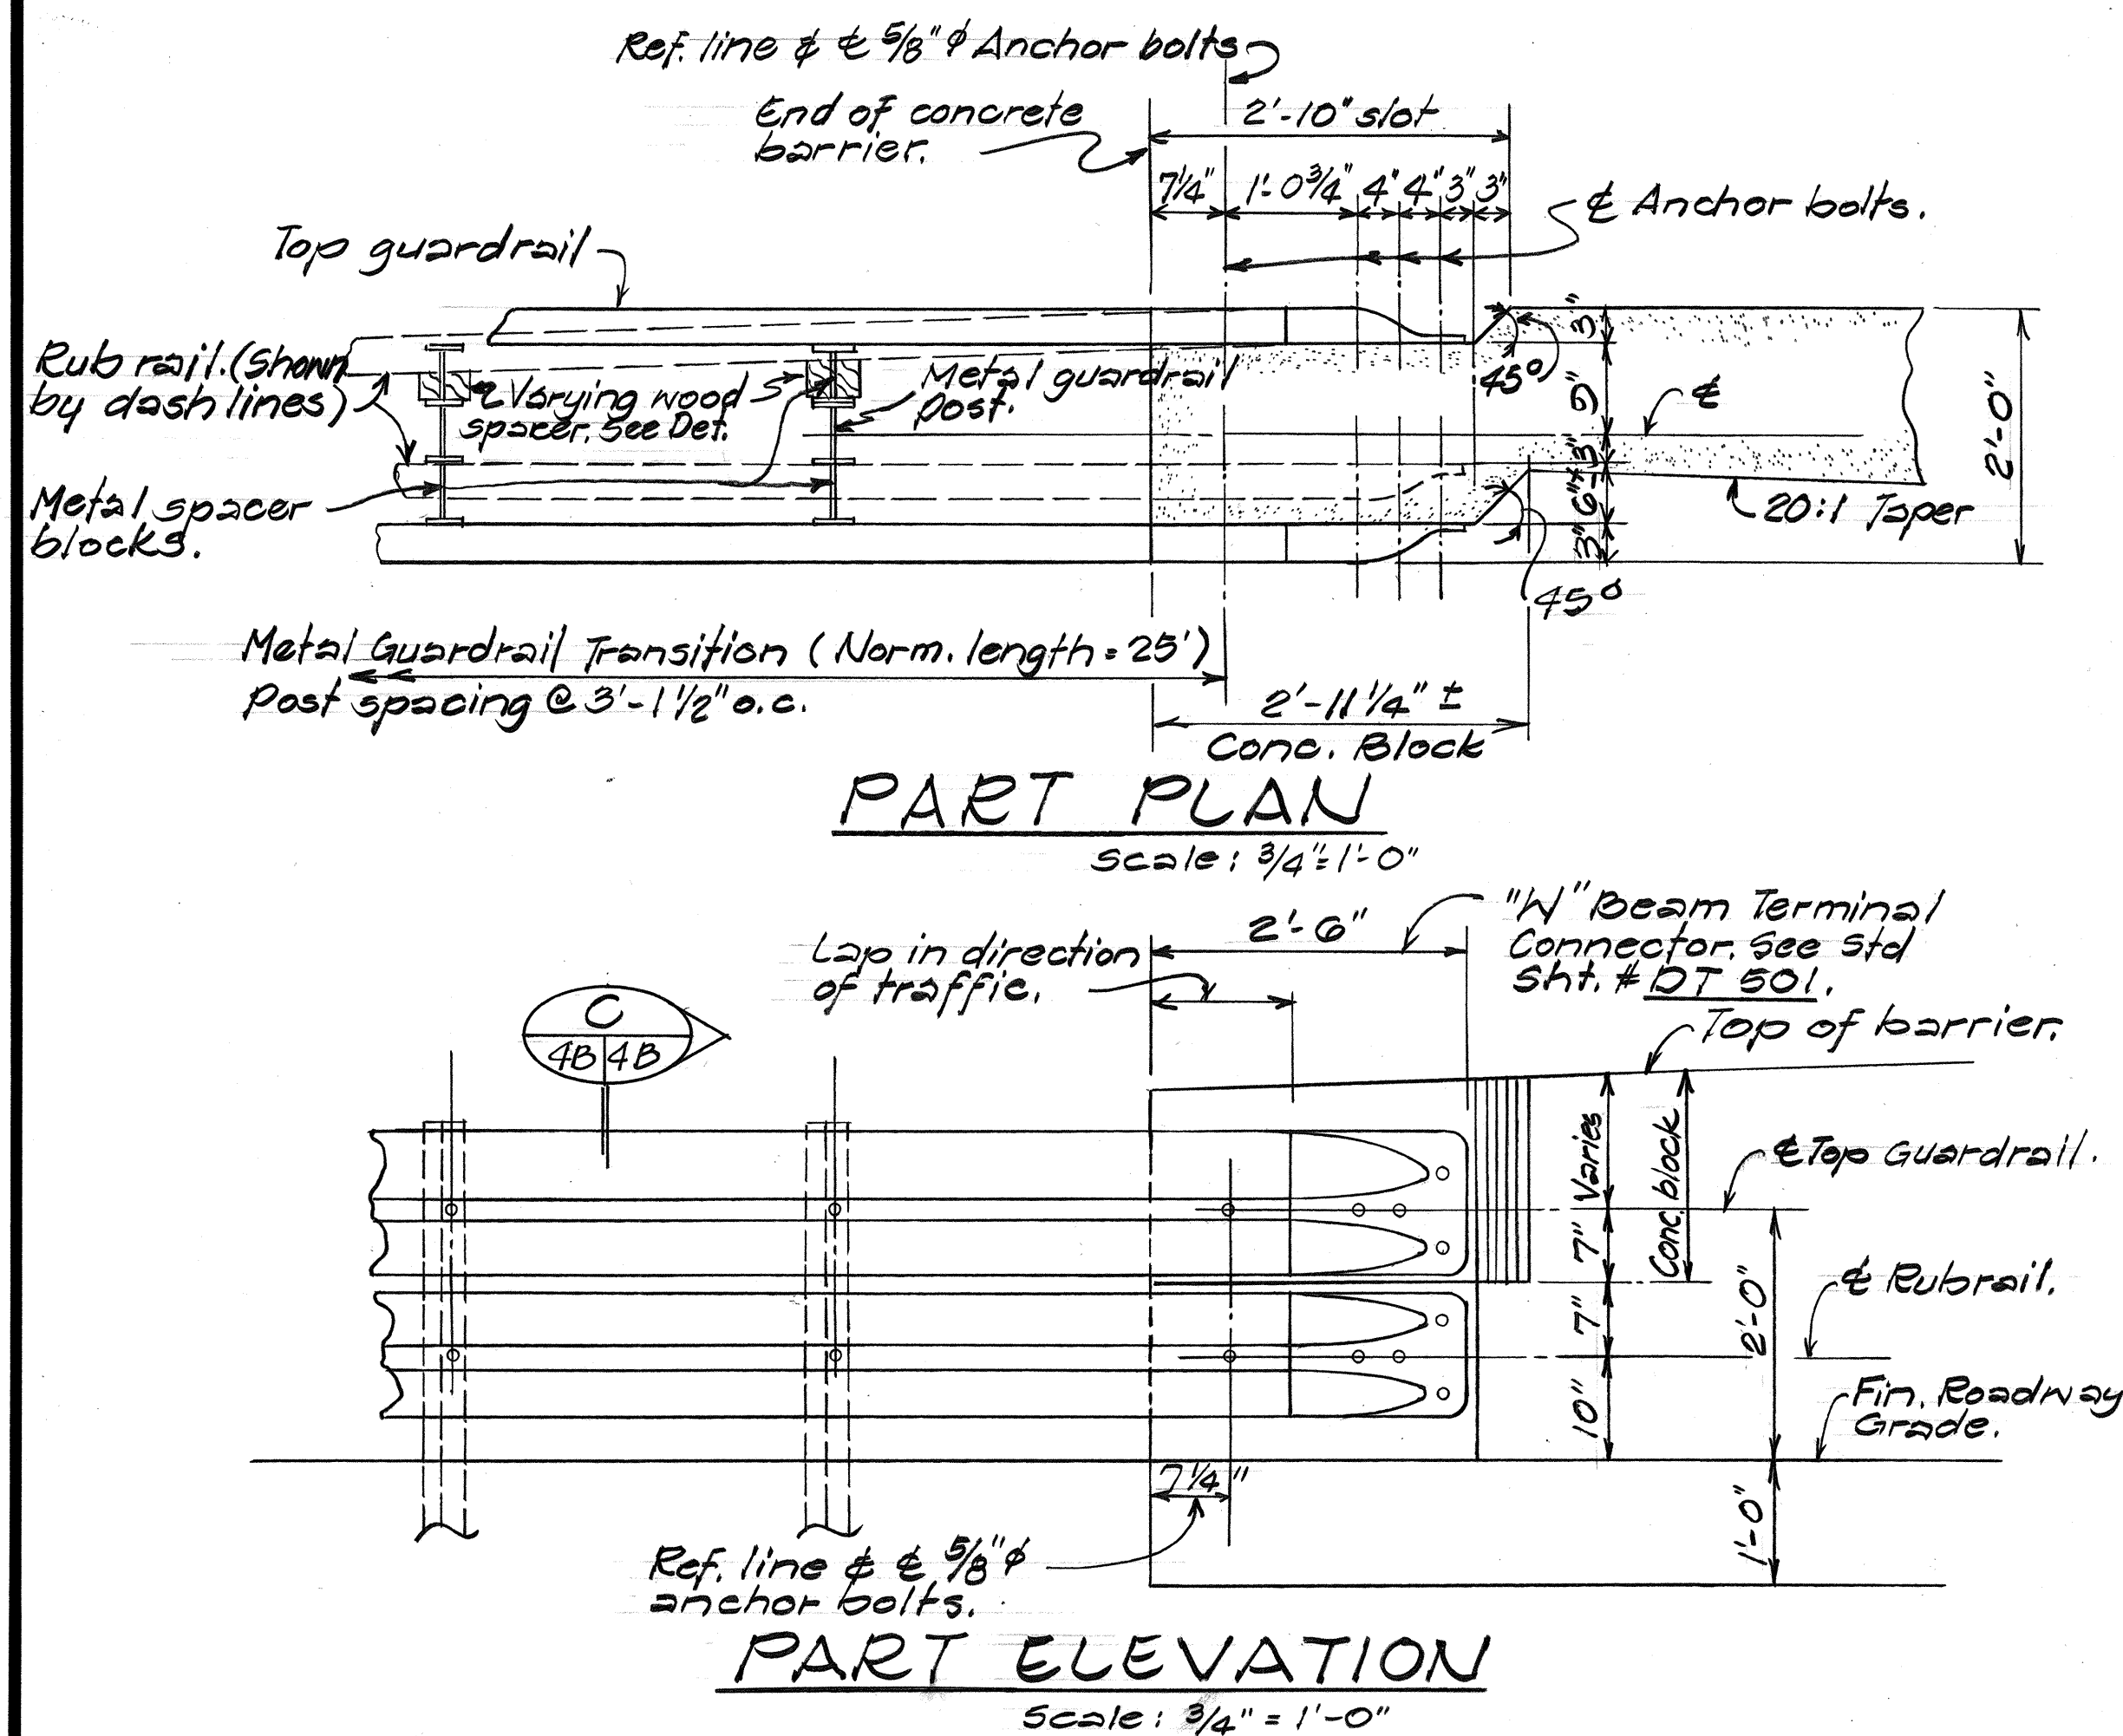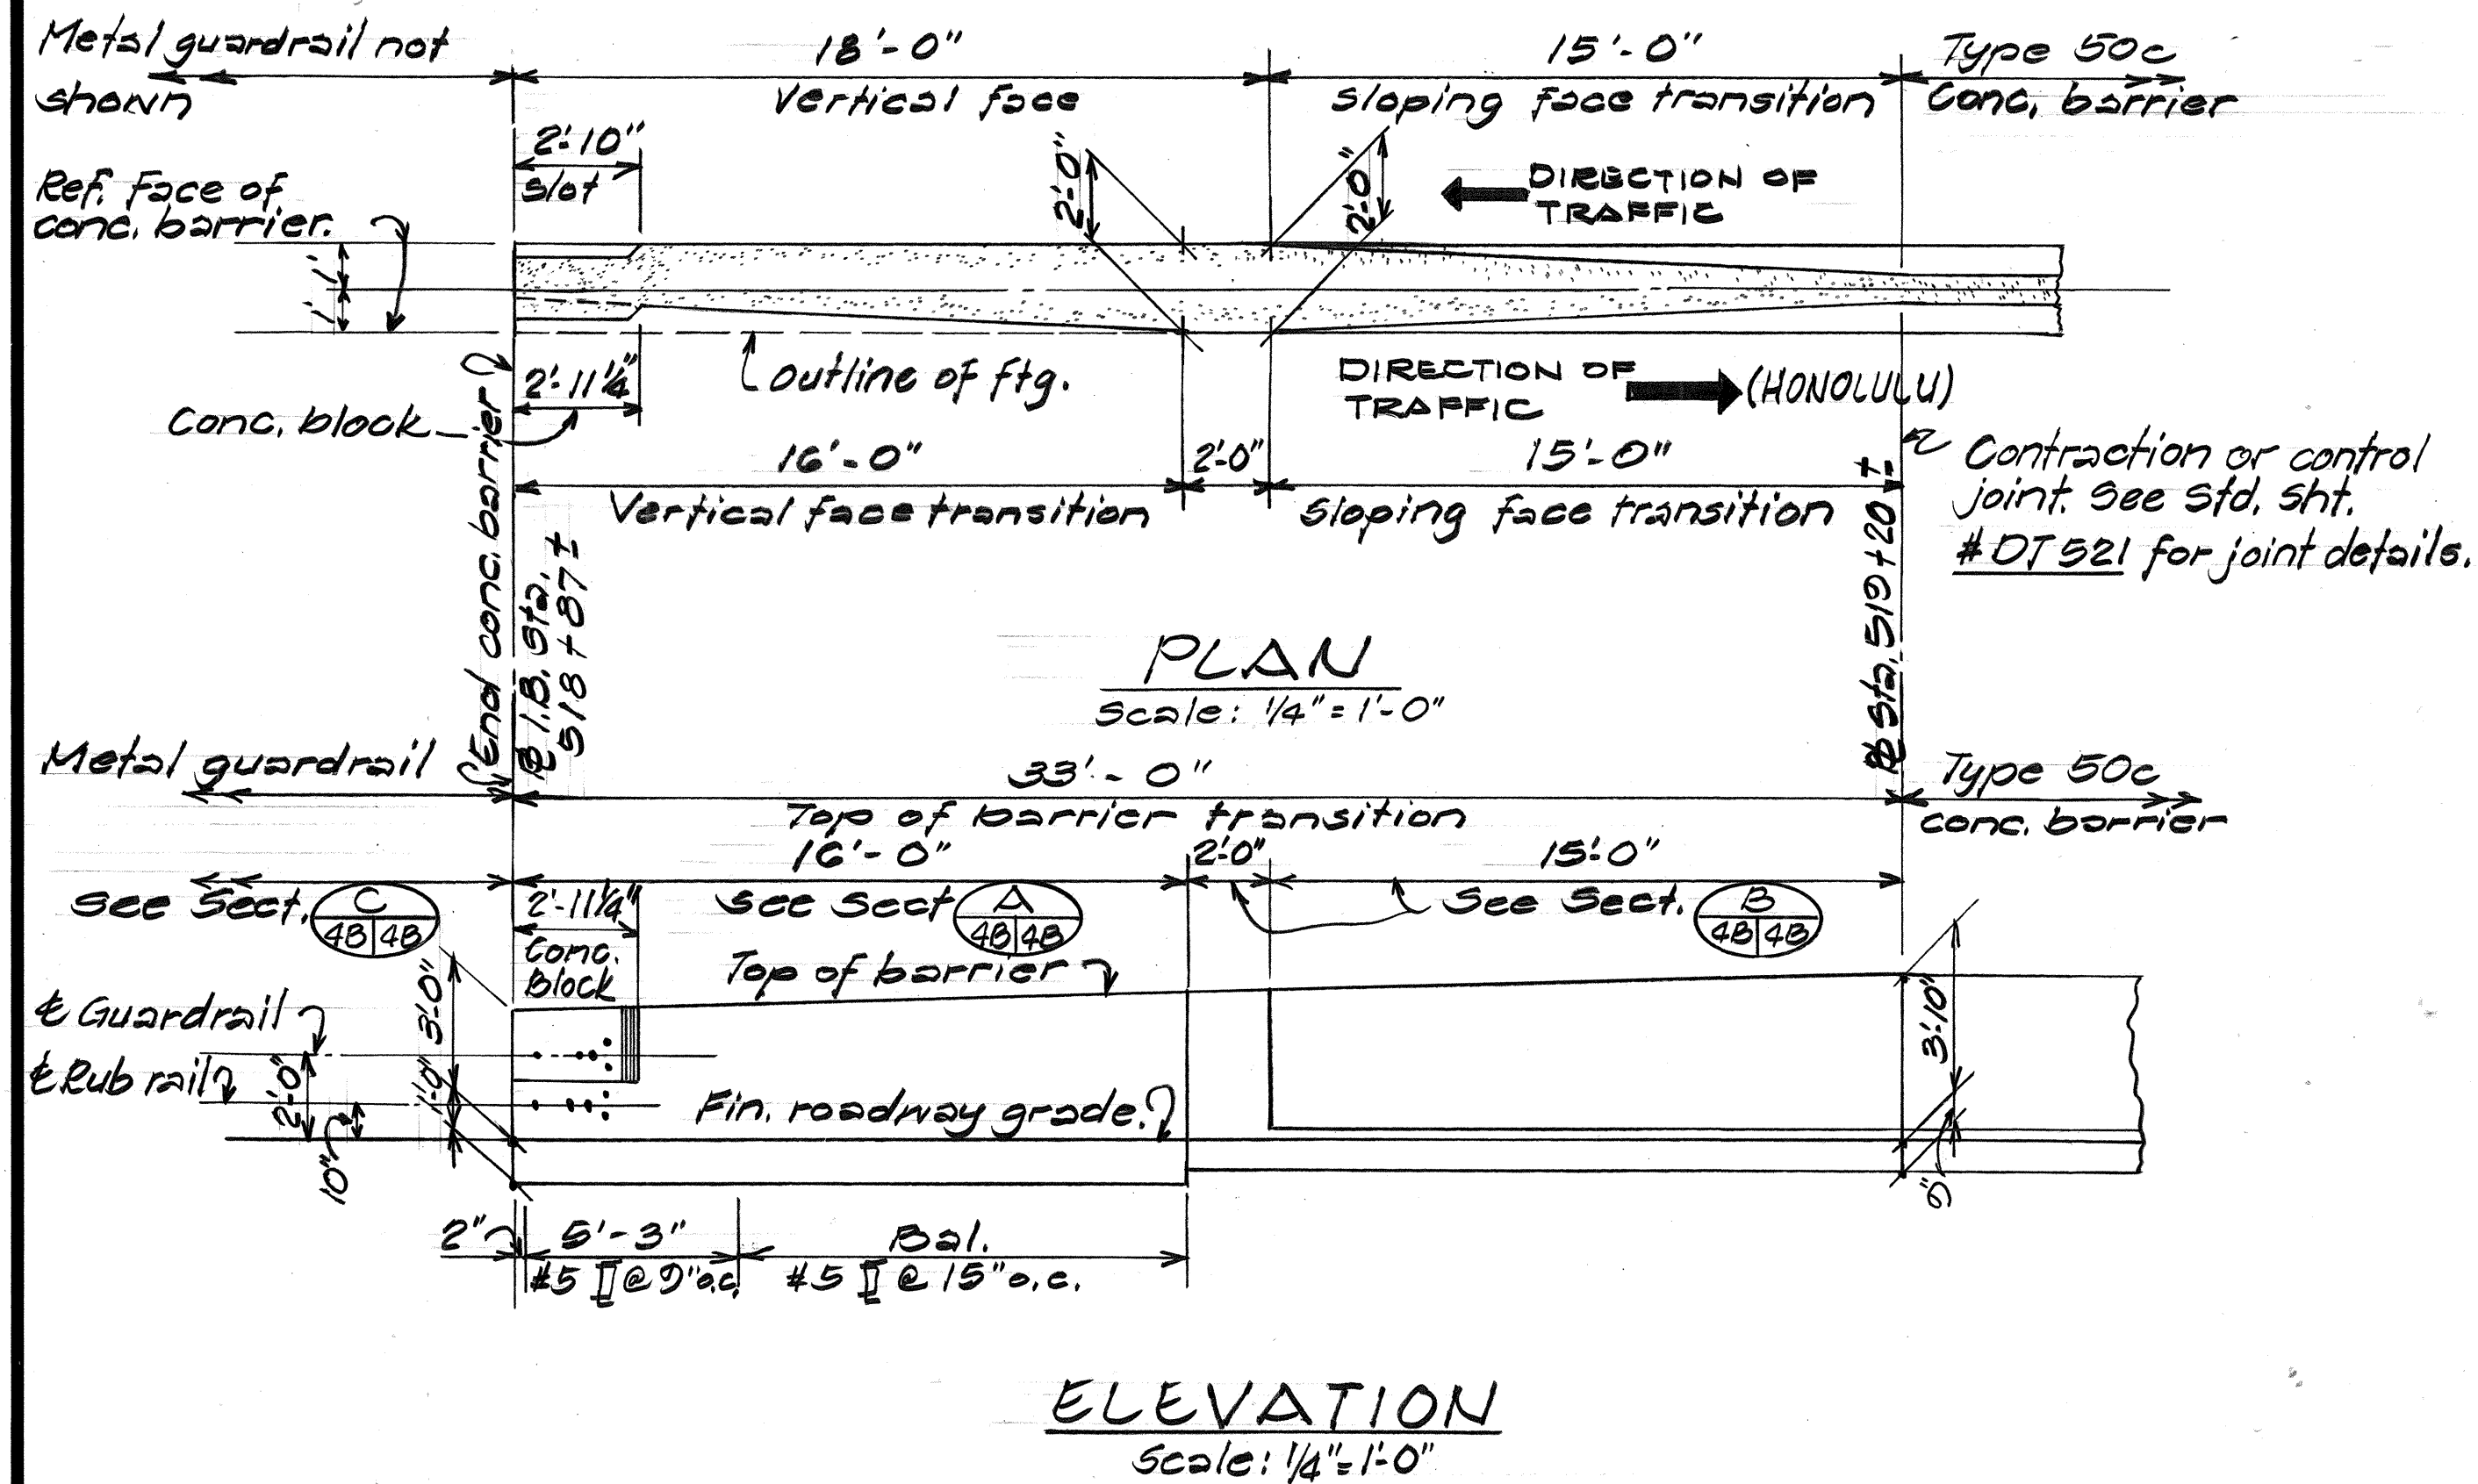


METAL GUARDRAIL TO CONCRETE BARRIER TRANSITION CONNECTION DETAILS

STATE OF HAWAII DEPARTMENT OF TRANSPORTATION HIGHWAYS DIVISION	
METAL GUARDRAIL TO BARRIER TRANSITION DETAILS	
INTERSTATE ROUTE H-1, ADDITIONAL LANES WAIANA I.C. TO HALAWA I.C.	
F.A.I.P. NO. IR-HI-1(193)	
Scale: As Shown	Date: Sept. 1985
SHEET No. 4B OF 14 SHEETS	

FED. ROAD DIST. NO.	STATE	FED. AID PROJ. NO.	FISCAL YEAR	SHEET NO.	TOTAL SHEETS
HAWAII	HAW.	1E-HI-1(103)	1986	20	62

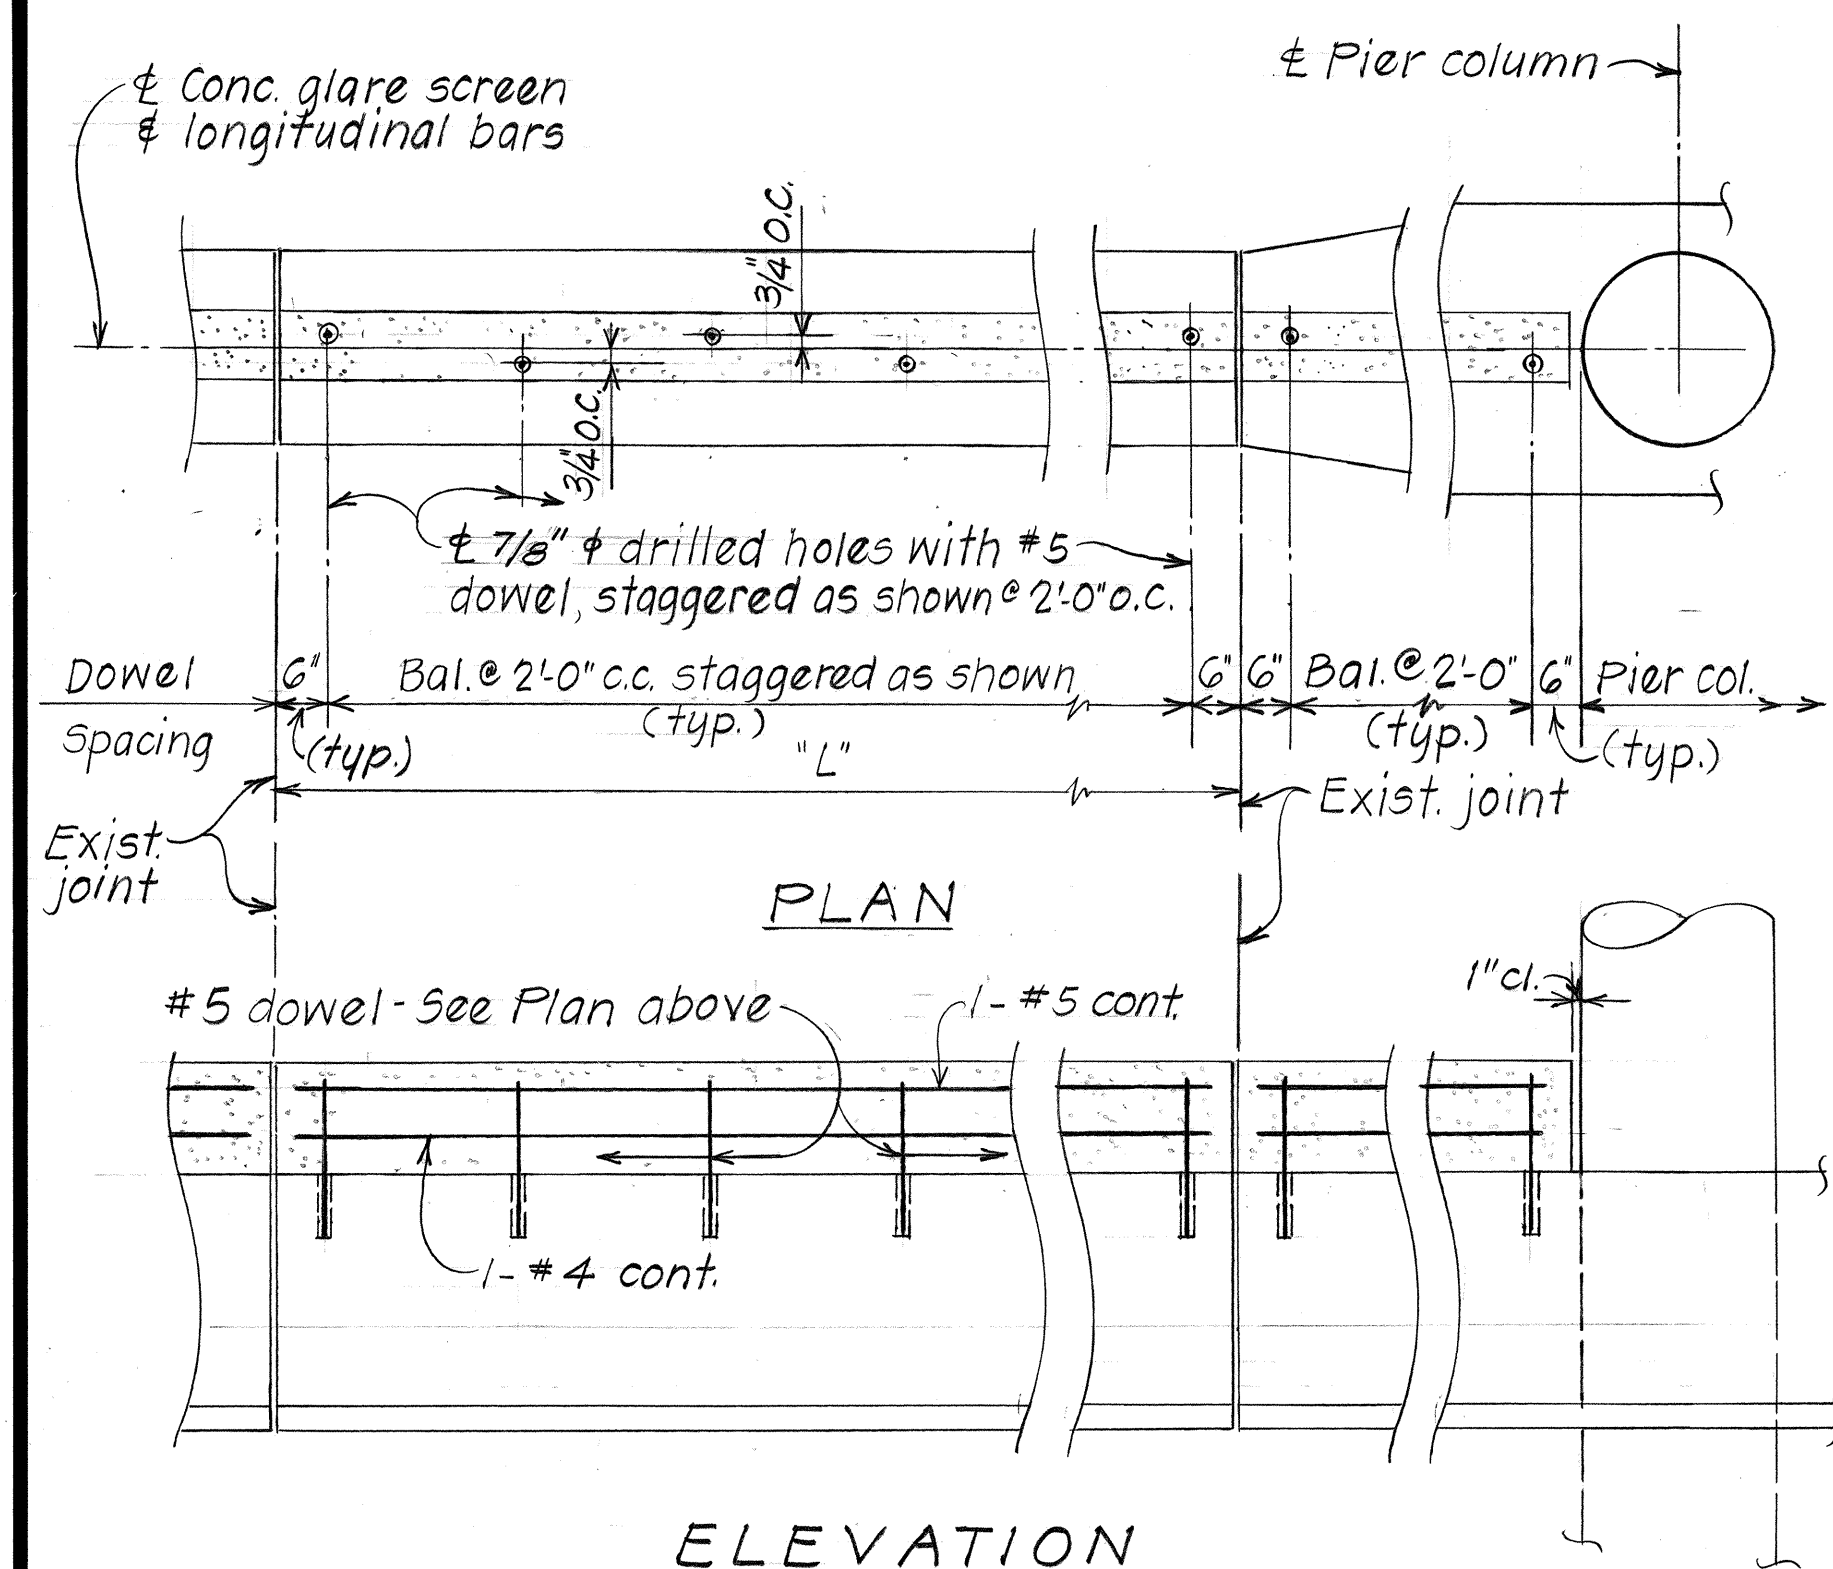


**HOLE SPACING DETAILS
FOR CONCRETE GLARE SCREEN
ON EXIST. CONCRETE BARRIER**
Not to scale

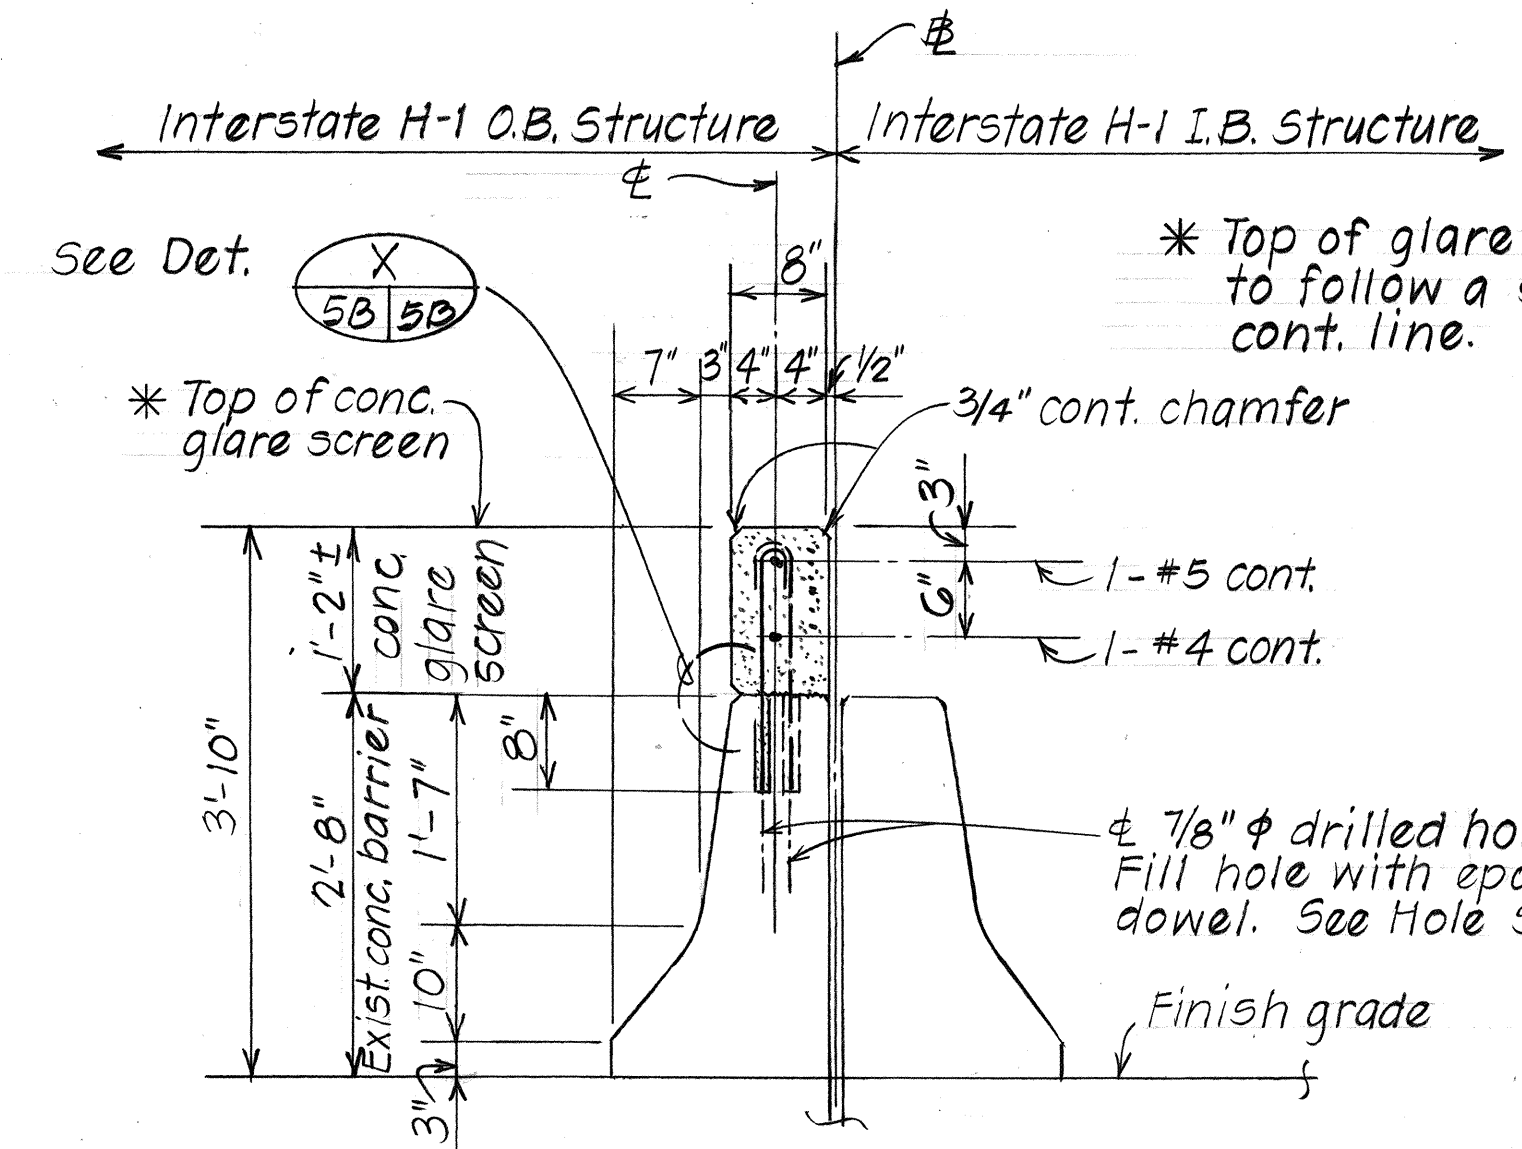


**ON PEARL CITY VIADUCT
(Sta. 3+79± TO Sta. 63+00)**
CONCRETE GLARE SCREEN ON EXISTING MEDIAN BARRIER
Scale: 3/4" = 1'-0"



- NOTE:**
- The Contractor shall be responsible for the location of existing reinforcement by whatever means, including the use of scanning devices in his drilling operations.
 - Joints on glare screen to match existing barrier joints.
 - For additional details & information for concrete barrier Type 50 & 50c, see Standard Details Sht. #29.

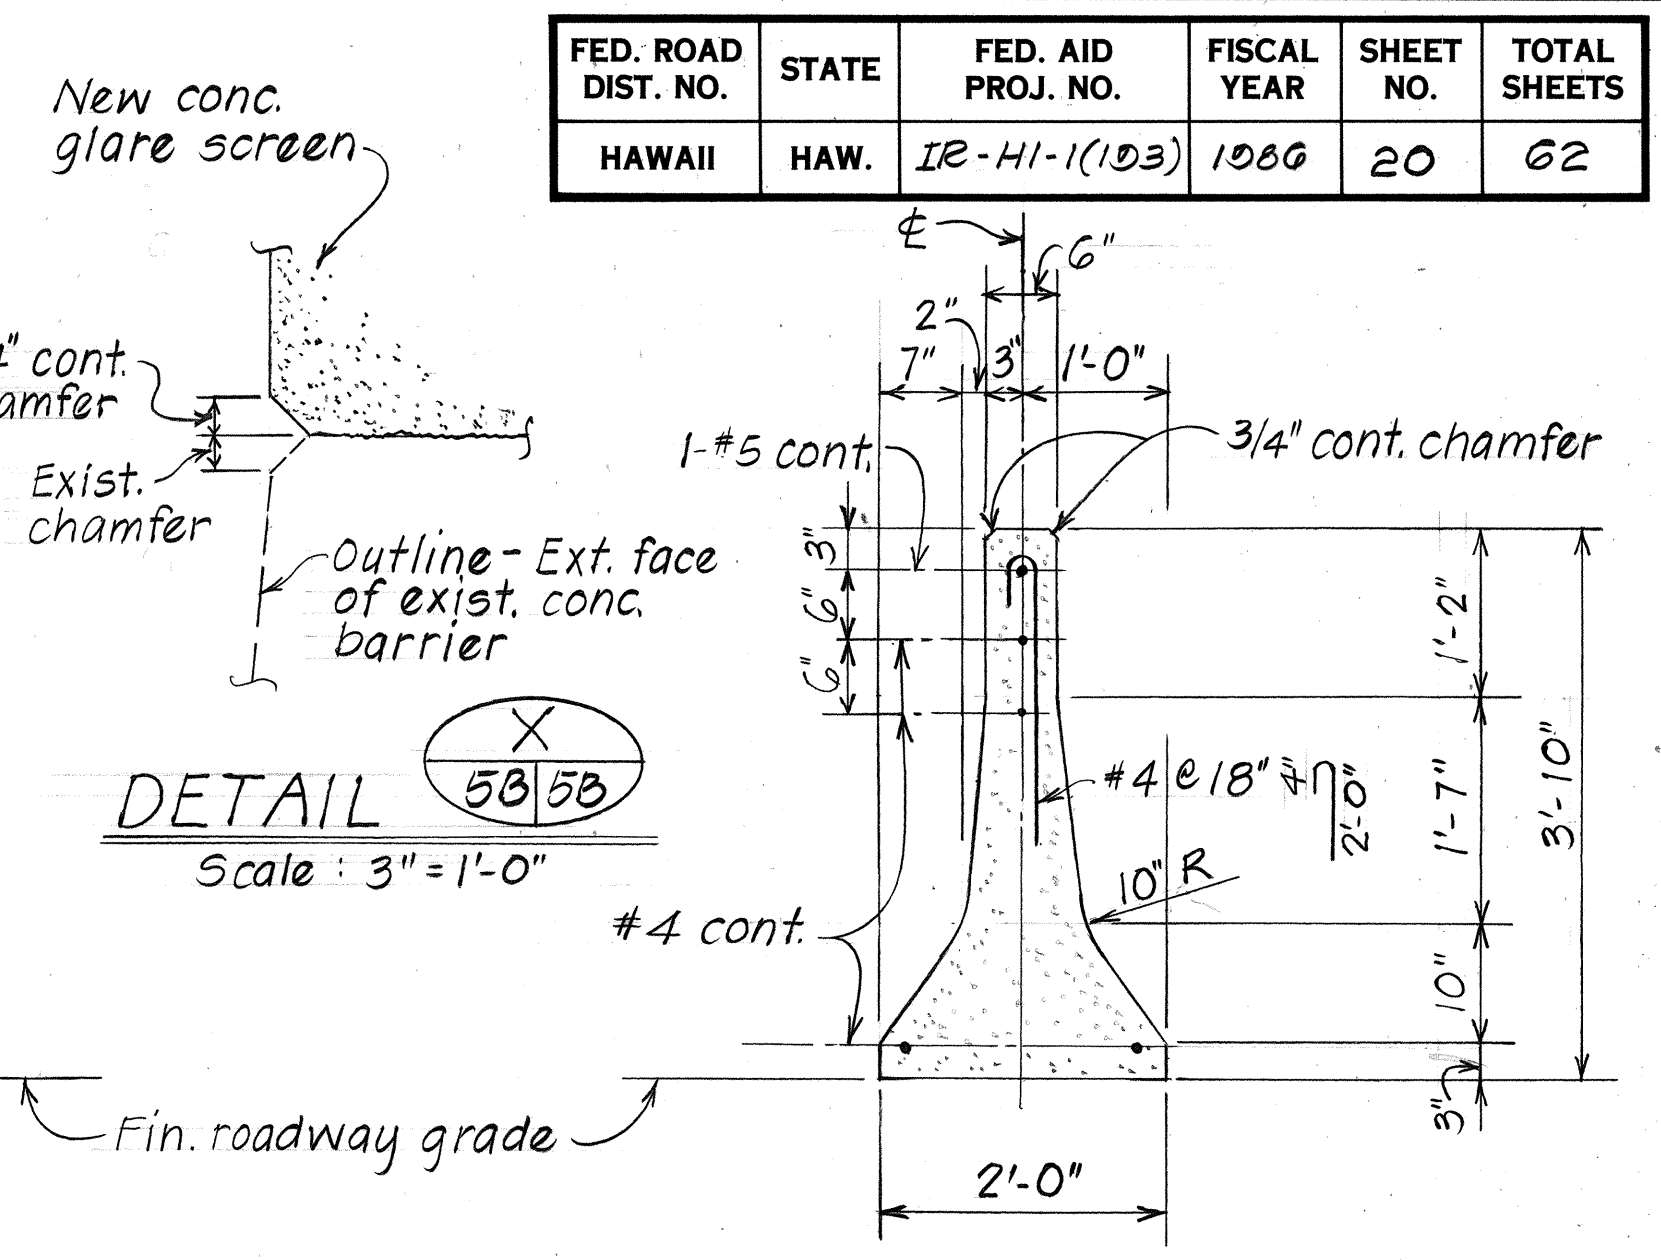

TYPE 50
Scale: 3/4" = 1'-0"

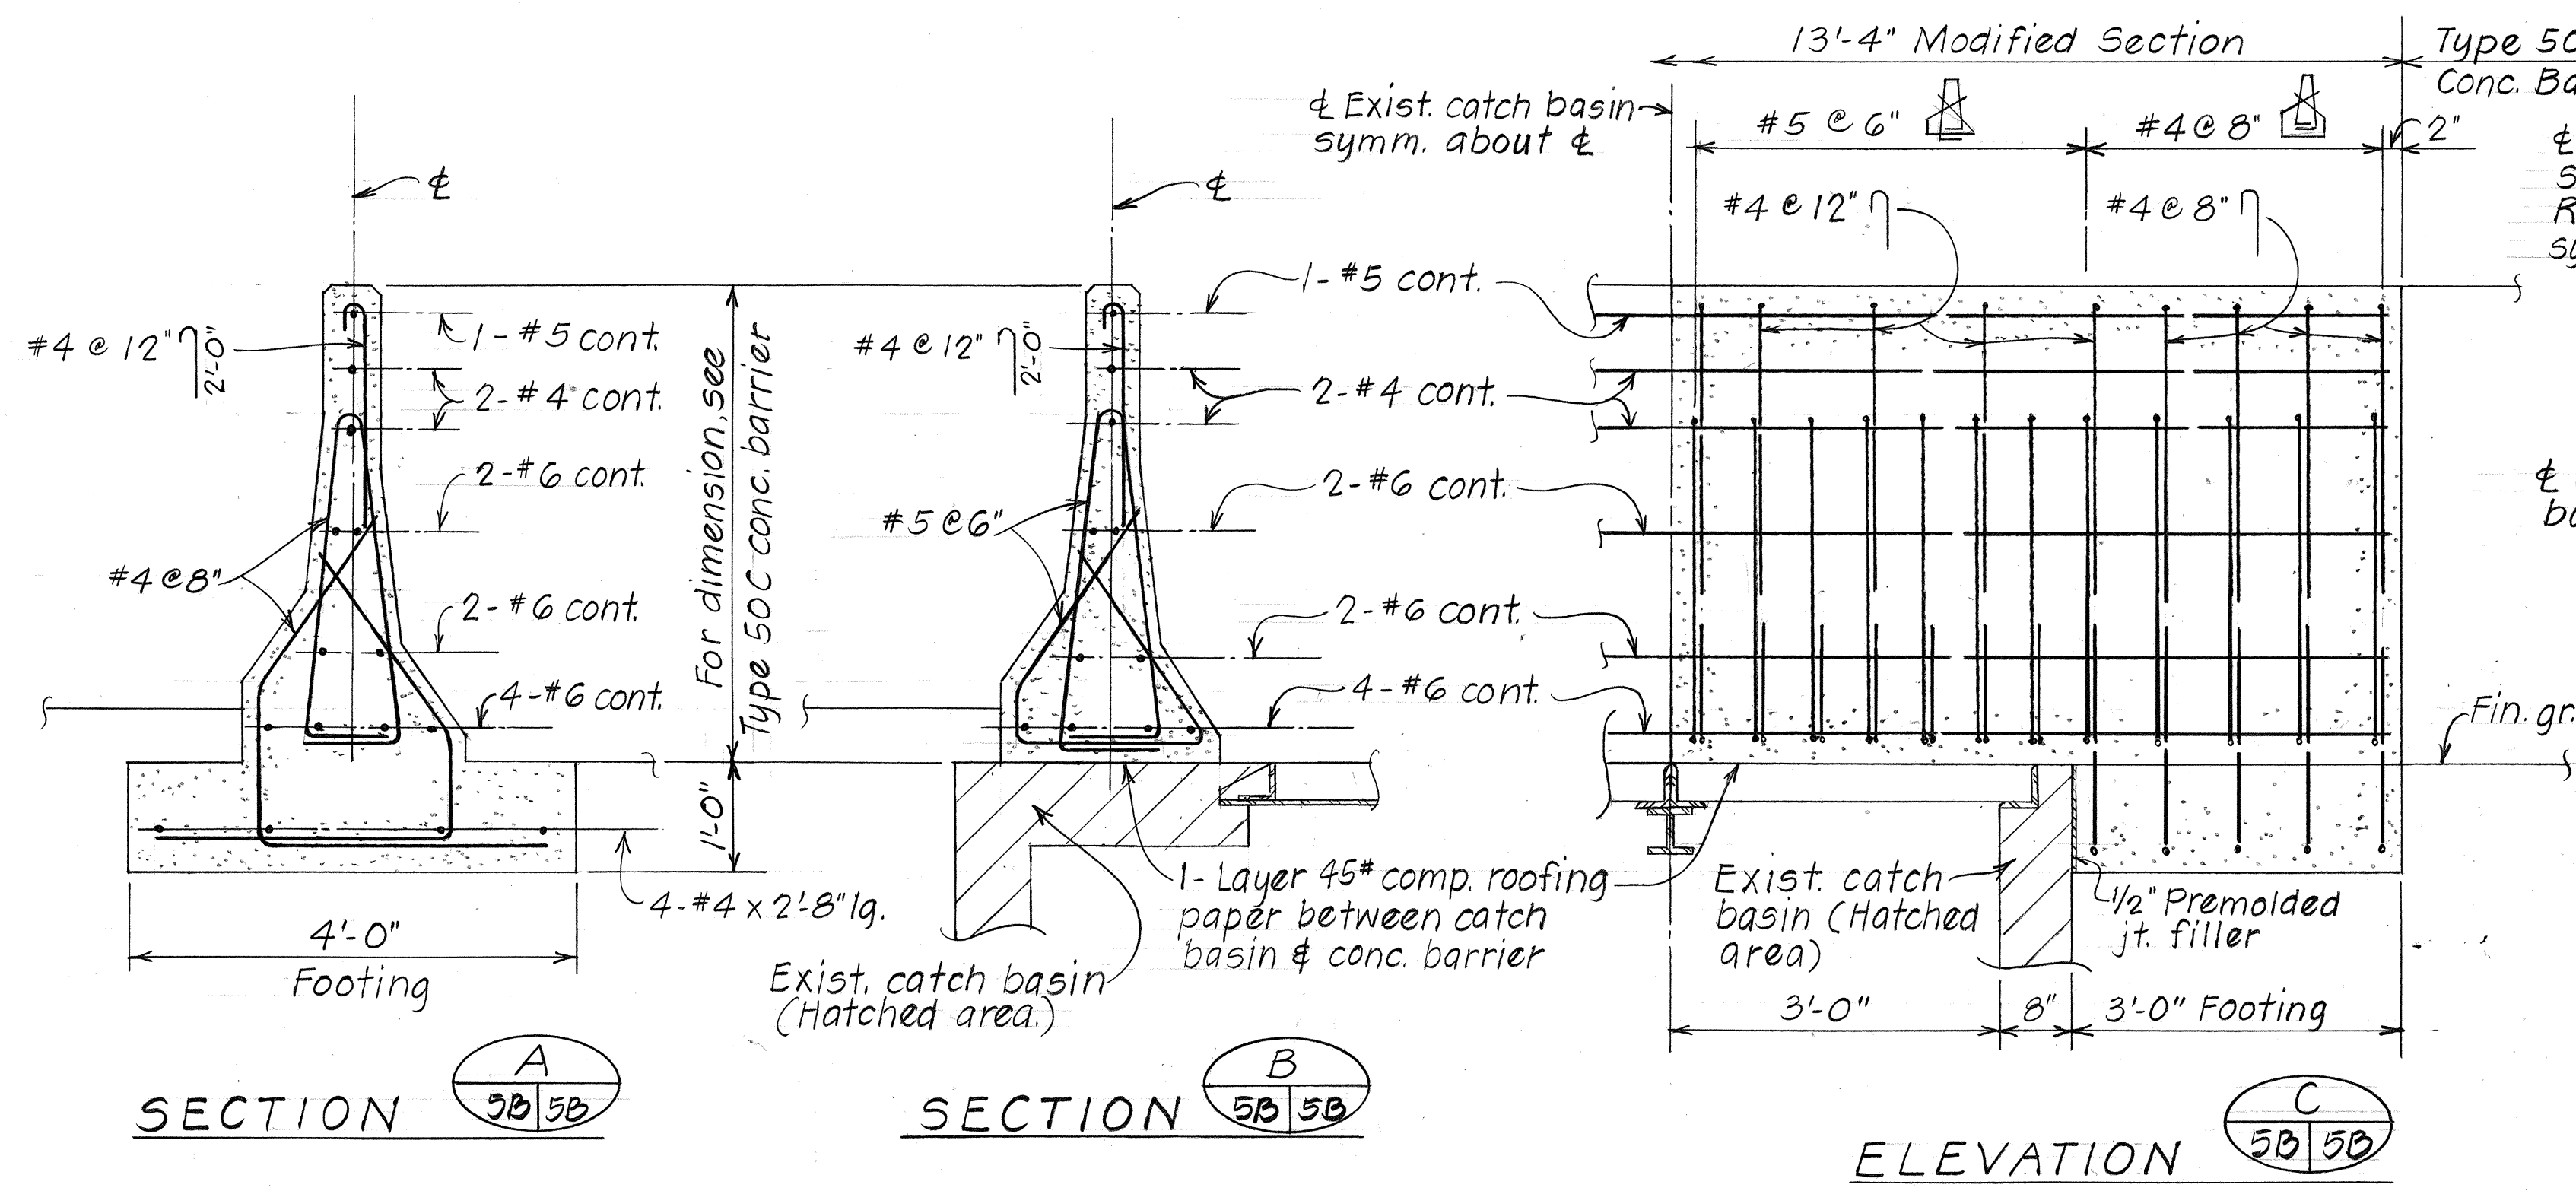

**CONCRETE MEDIAN BARRIER AT CATCH BASIN
(I.B. Sta. 519+34±)**
Scale: 3/4" = 1'-0"

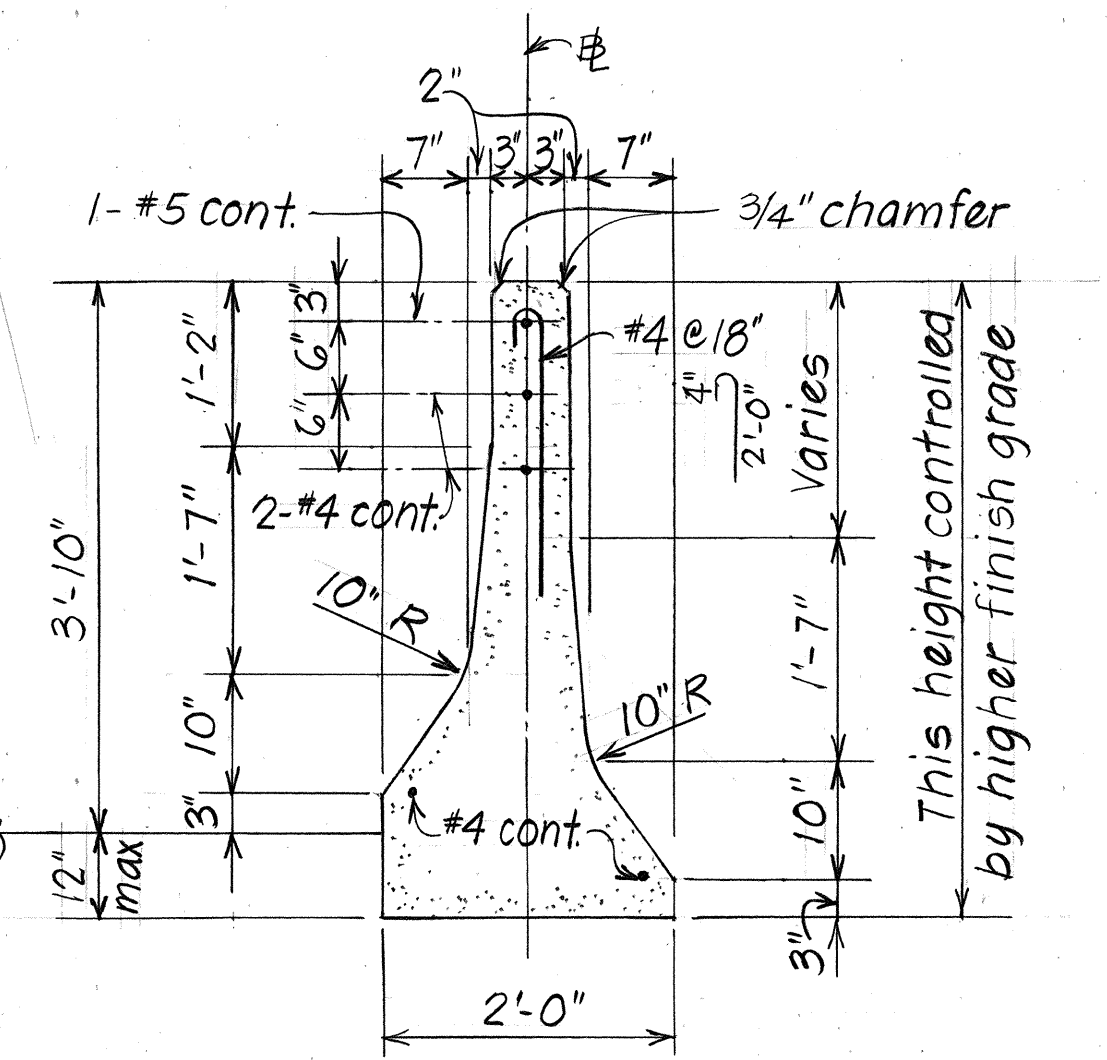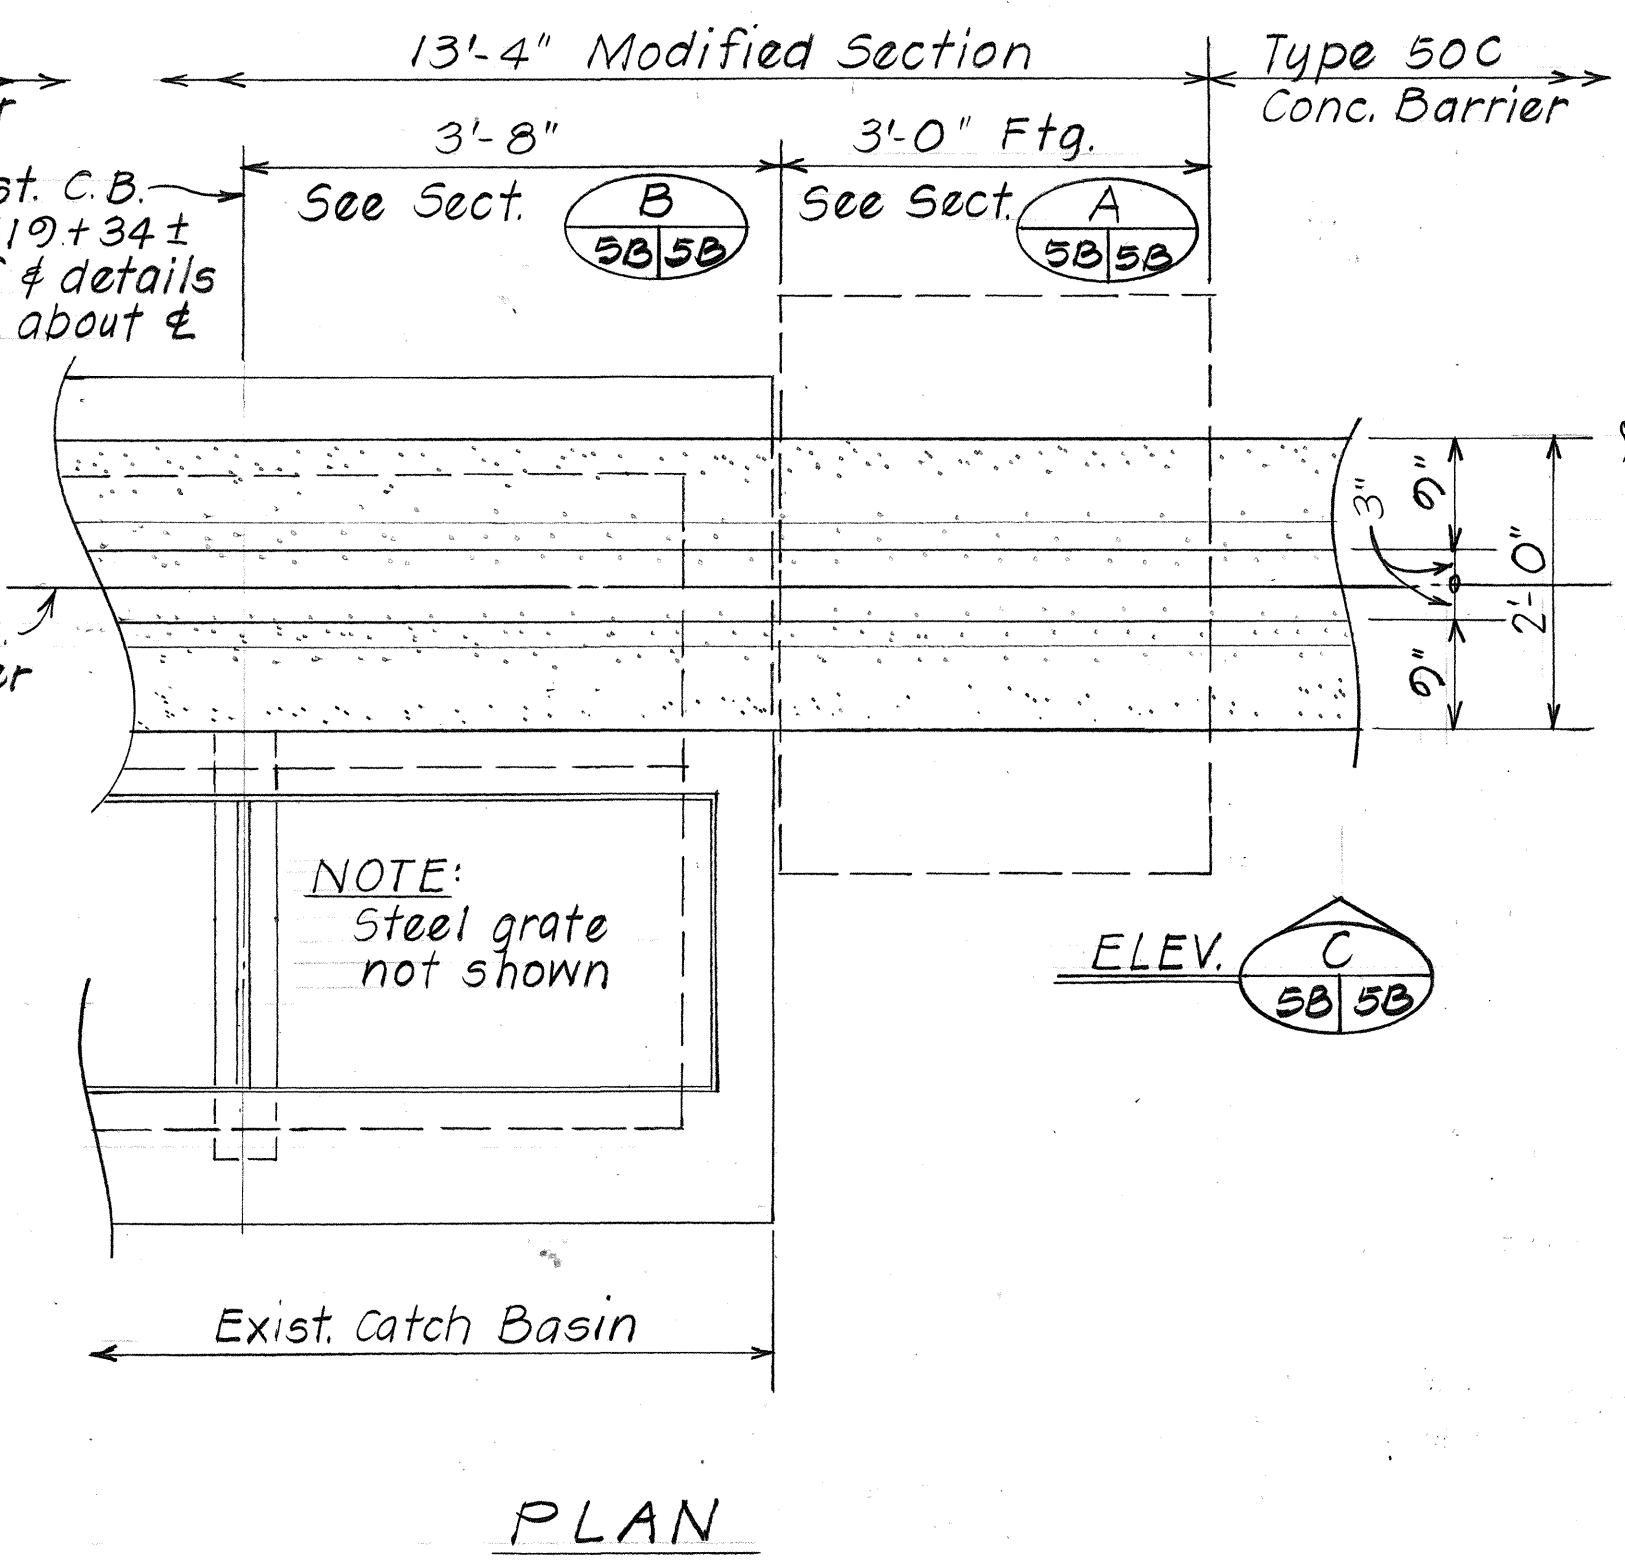

TYPE 50C
Scale: 3/4" = 1'-0"





DATE	8/85
SURVEY PLOTTED BY	L.M.A.
DRAWN BY	T.S.
DESIGNED BY	T.S.
CHECKED BY	A.J.G.
ORIGINAL PLAN	
NOTE BOOK	
NO.	

1/27/86	Revised diameter of drilled hole from 1 1/4" to 1 3/8" on plan view of detail titled "HOLE SPACING DETAILS FOR CONCRETE GLARE SCREEN ON EXIST. CONCRETE BARRIER" per Addendum No. 1.
DATE	REVISION

STATE OF HAWAII DEPARTMENT OF TRANSPORTATION HIGHWAYS DIVISION TYPE 50 & 50C CONC. BARRIER & CONC. GLARE SCREEN DETAIL INTERSTATE ROUTE H-1, ADDITIONAL LANES WAIANA I.C. TO HALAWA I.C. F.A.I.P. NO. IR-HI-1(193) Scale: As Shown Date: Sept. 1985 SHEET No. 58 OF 14 SHEETS
--


FED. ROAD DIST. NO.	STATE	FED. AID PROJ. NO.	FISCAL YEAR	SHEET NO.	TOTAL SHEETS
HAWAII	HAW.	IR-HI-1(193)	1986	21	62

TABLE "A"					
LOCATION	"W"	NO. OF COLS., SIZE & SPACING	"L"	BARRIER REMOVAL LOCATION (AS DIRECTED BY THE ENGINEER)	
Structure No 1	5'-8"	3-4'-0" & Cols. @ 14'-8" o.c.	36'-8"	Waialua End & Hon. End	
Kaahumanu St. Separation	5'-0"	4-3'-0" & Cols. @ 21'-0" 15'-6" 23'-9"	30'-0"	Waialua End Only	
Kaonohi St. Separation	5'-6"	4-3'-6" & Cols. @ 18'-10" o.c.		Barrier to Remain	
Kaamilo St. Separation	5'-0"	3-3'-0" & Cols. @ 20'-3" o.c.		Barrier to Remain	
Mahiko St. Ped. Overpass	4'-6"	1-2'-6" x 7'-8" Col.	25'-0"	Waialua End & Hon. End	
Aiea Heights Dr. Separation	4'-10"	No Glare Screens between Cols.	28'-4"	Waialua End Only	

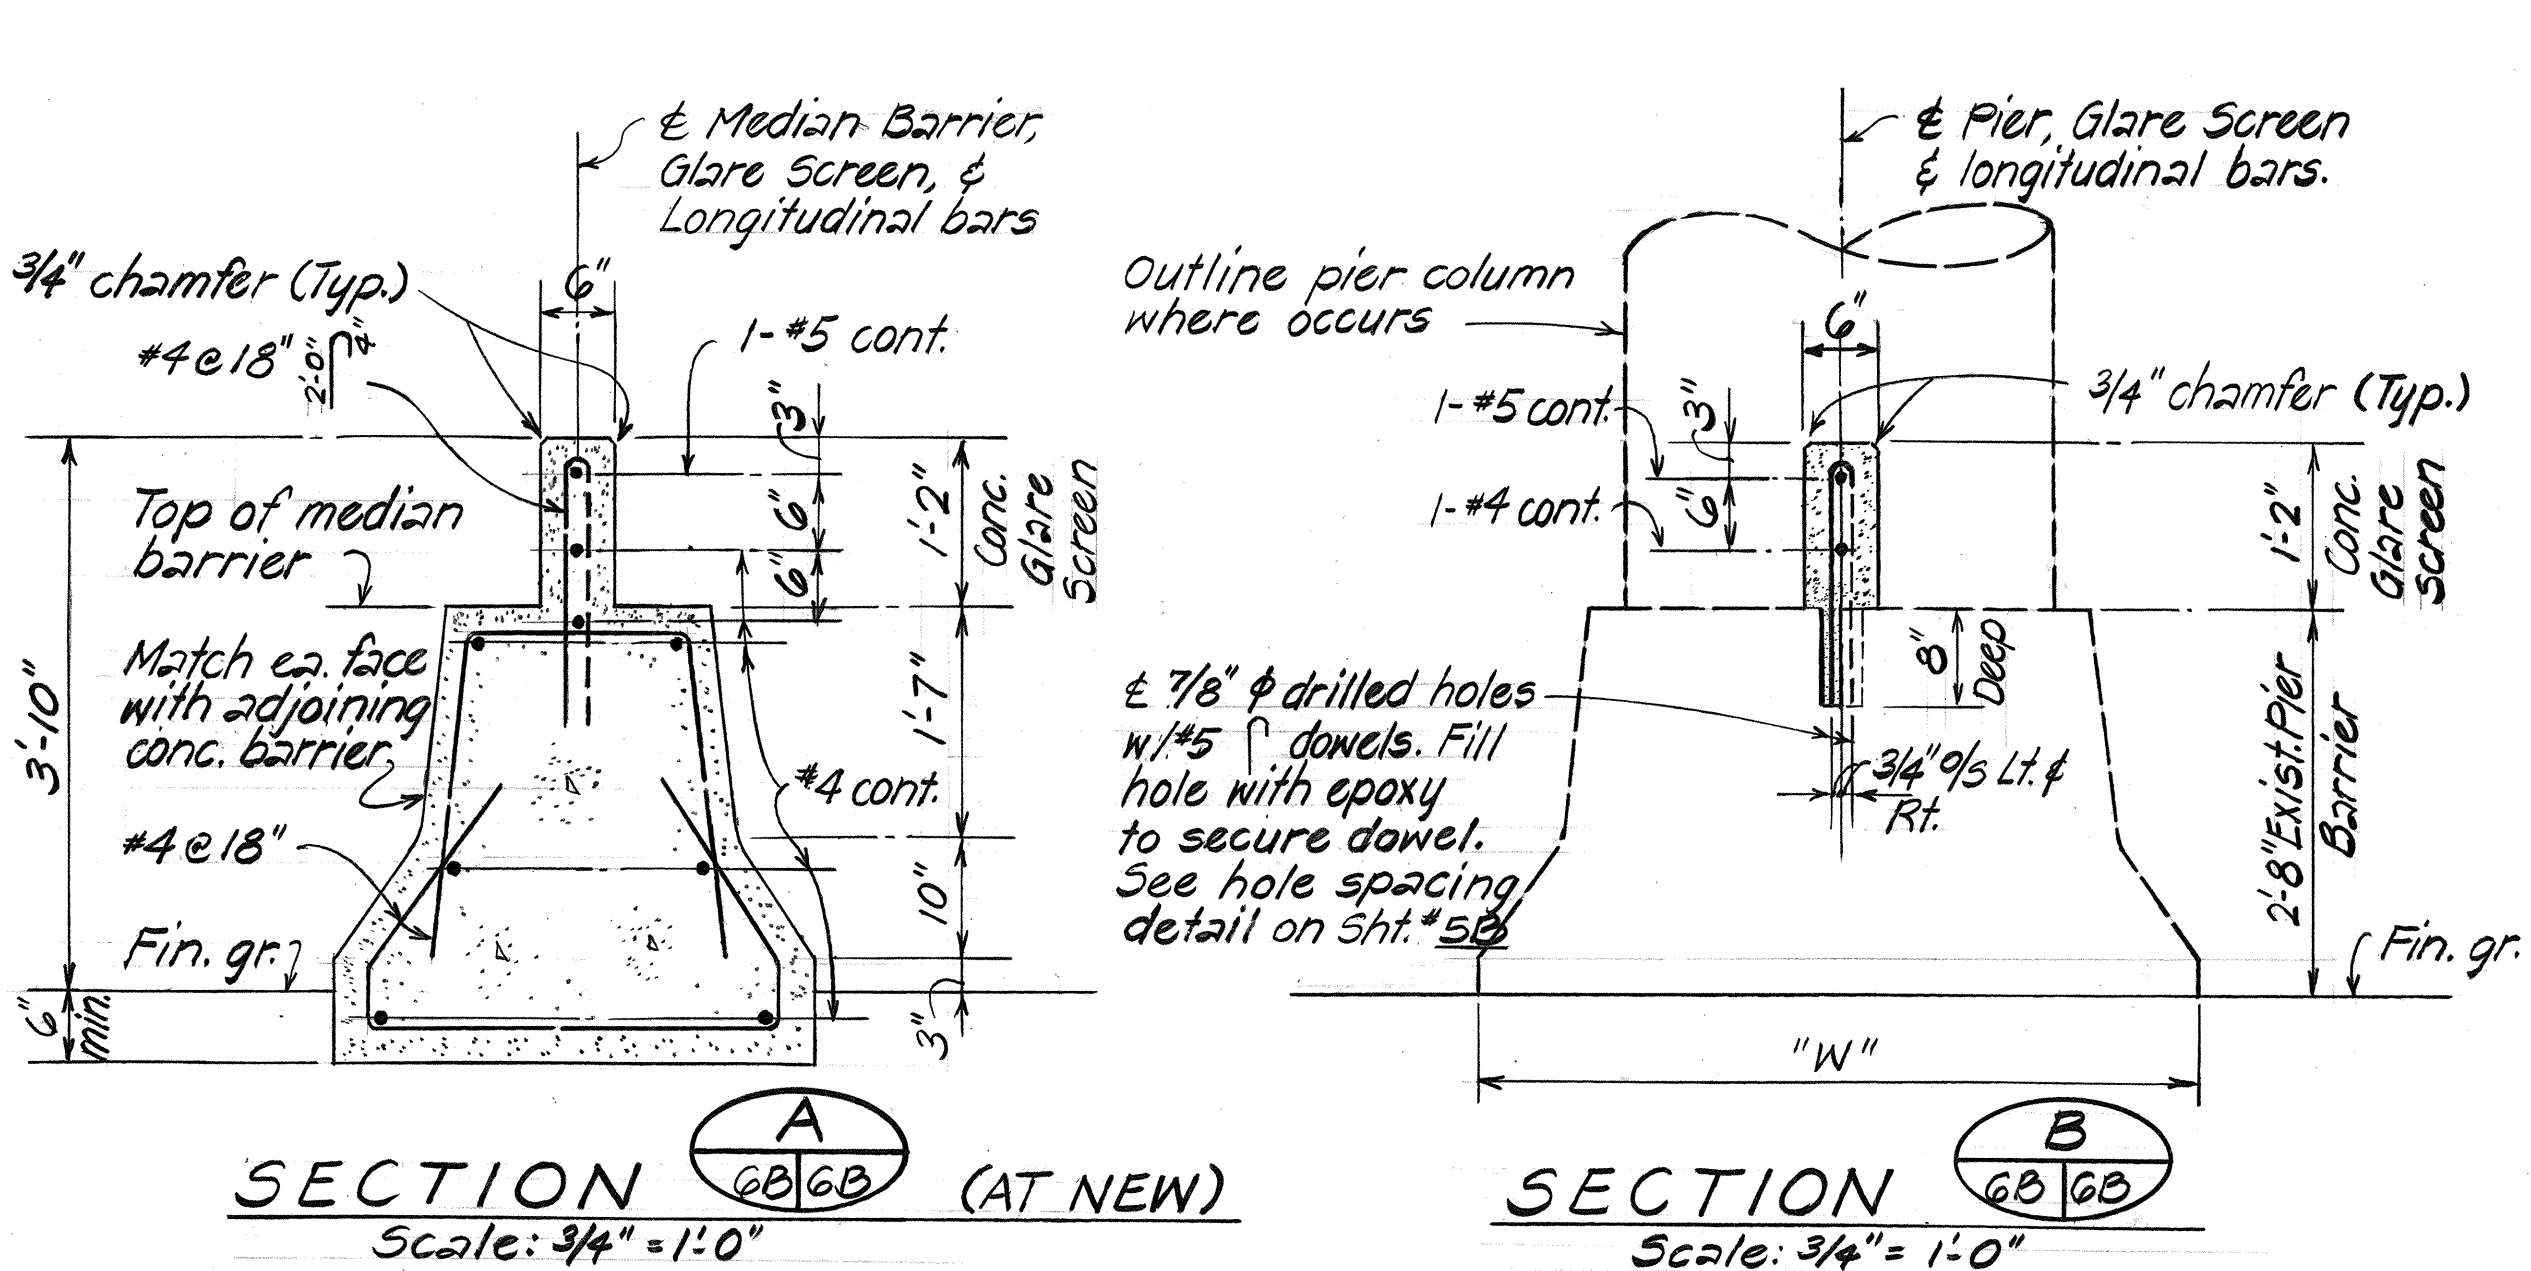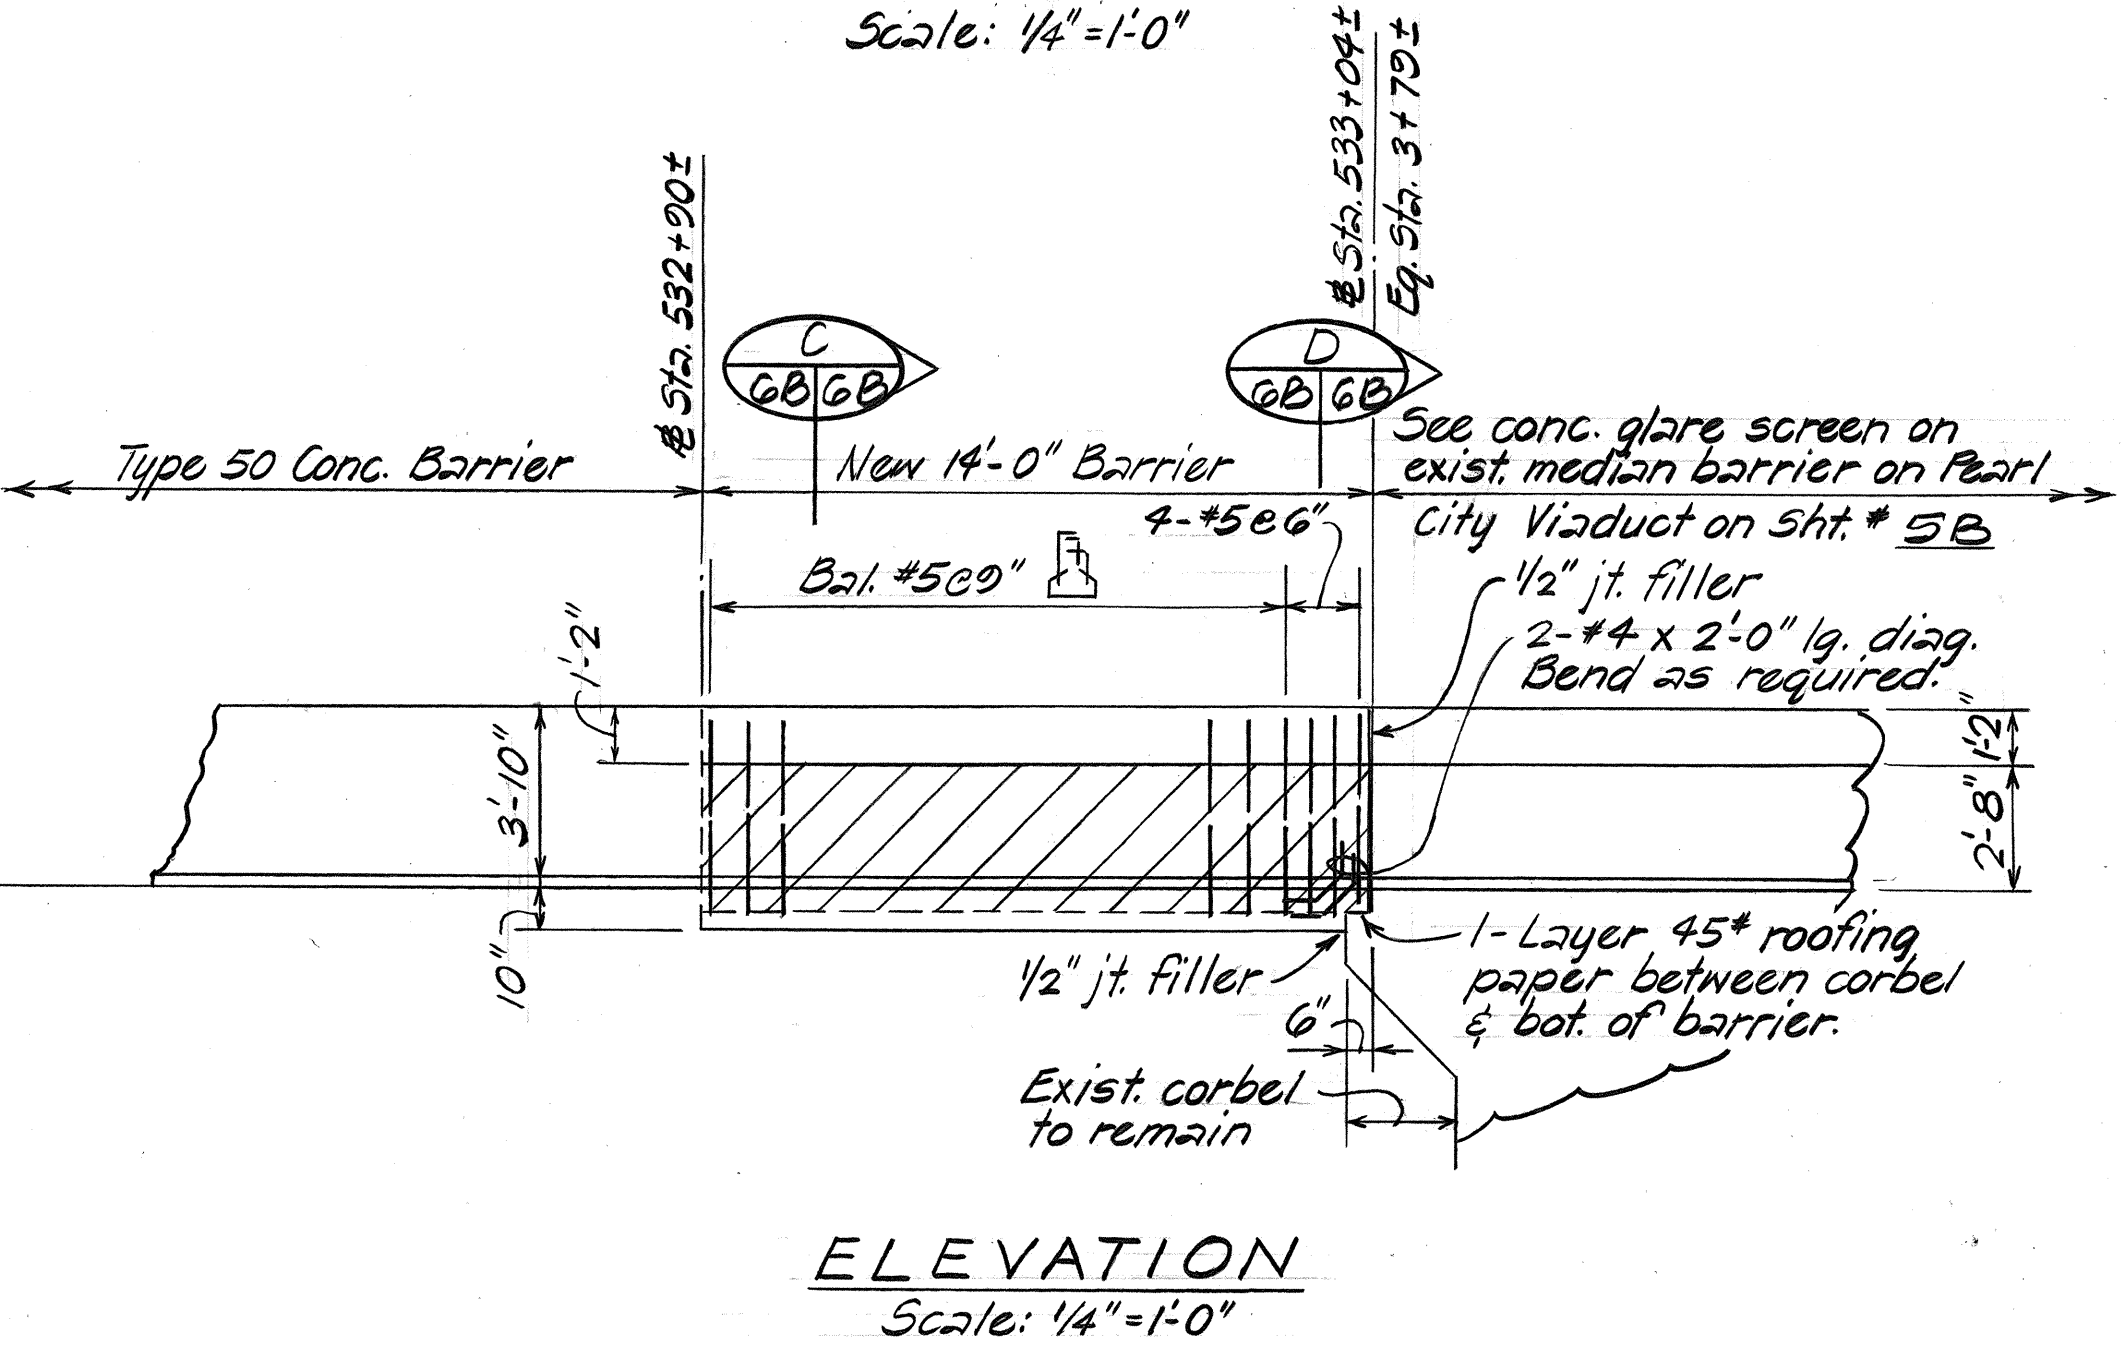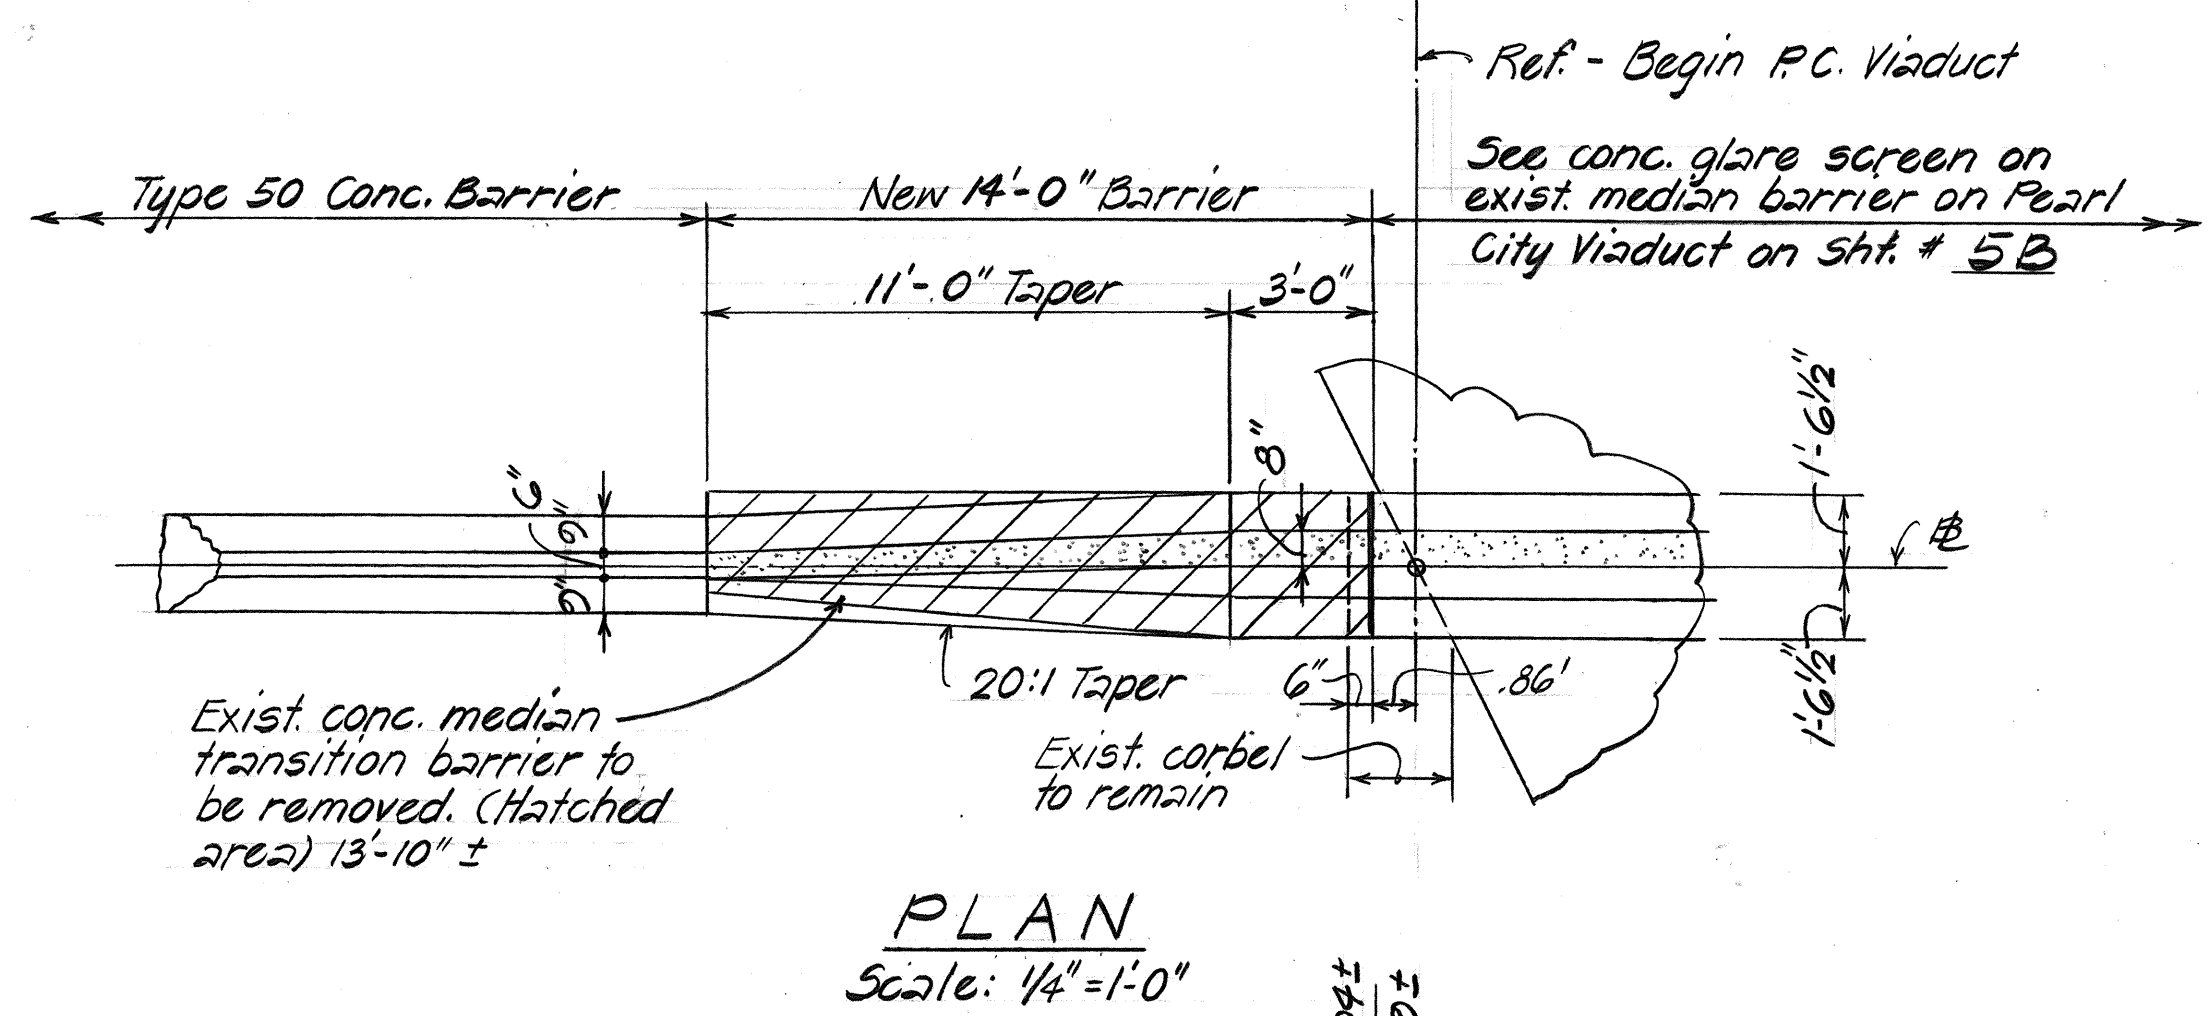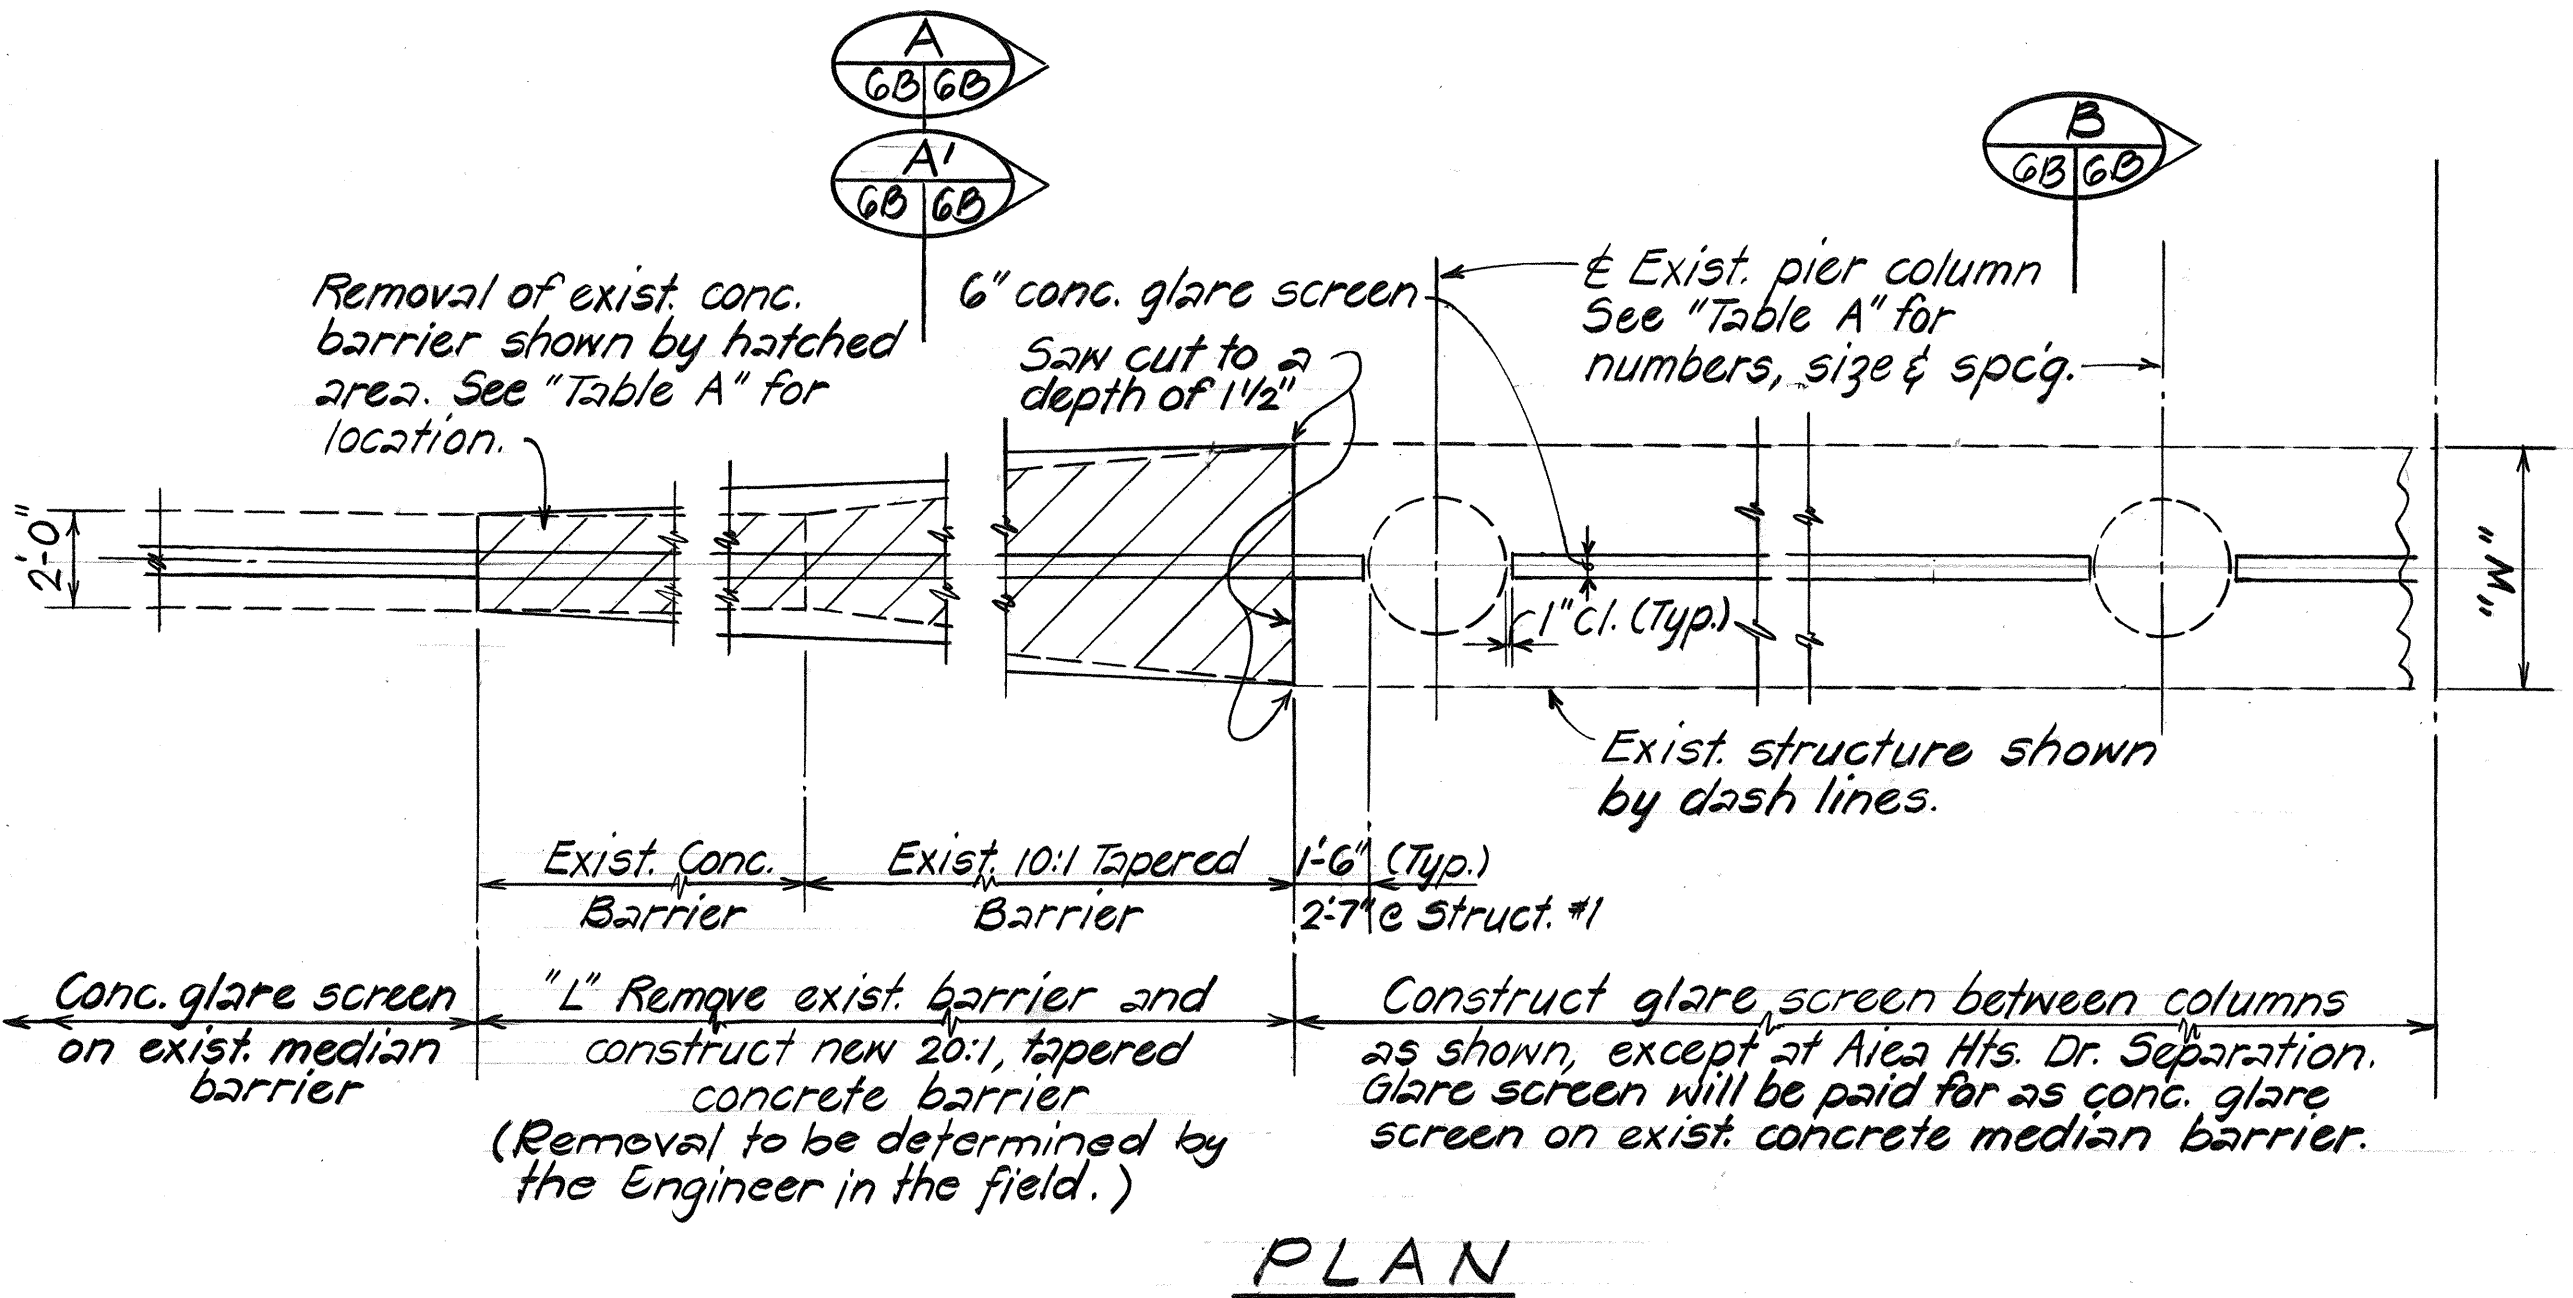

SECTION A (AT NEW) SIMILAR, EXCEPT TAKEN AT EXIST. PIER BARRIER TRANSITION, SEE SECTION B FOR GLARE SCREEN DETAIL

TYPICAL DETAILS - RENOVATION OF PIER BARRIER

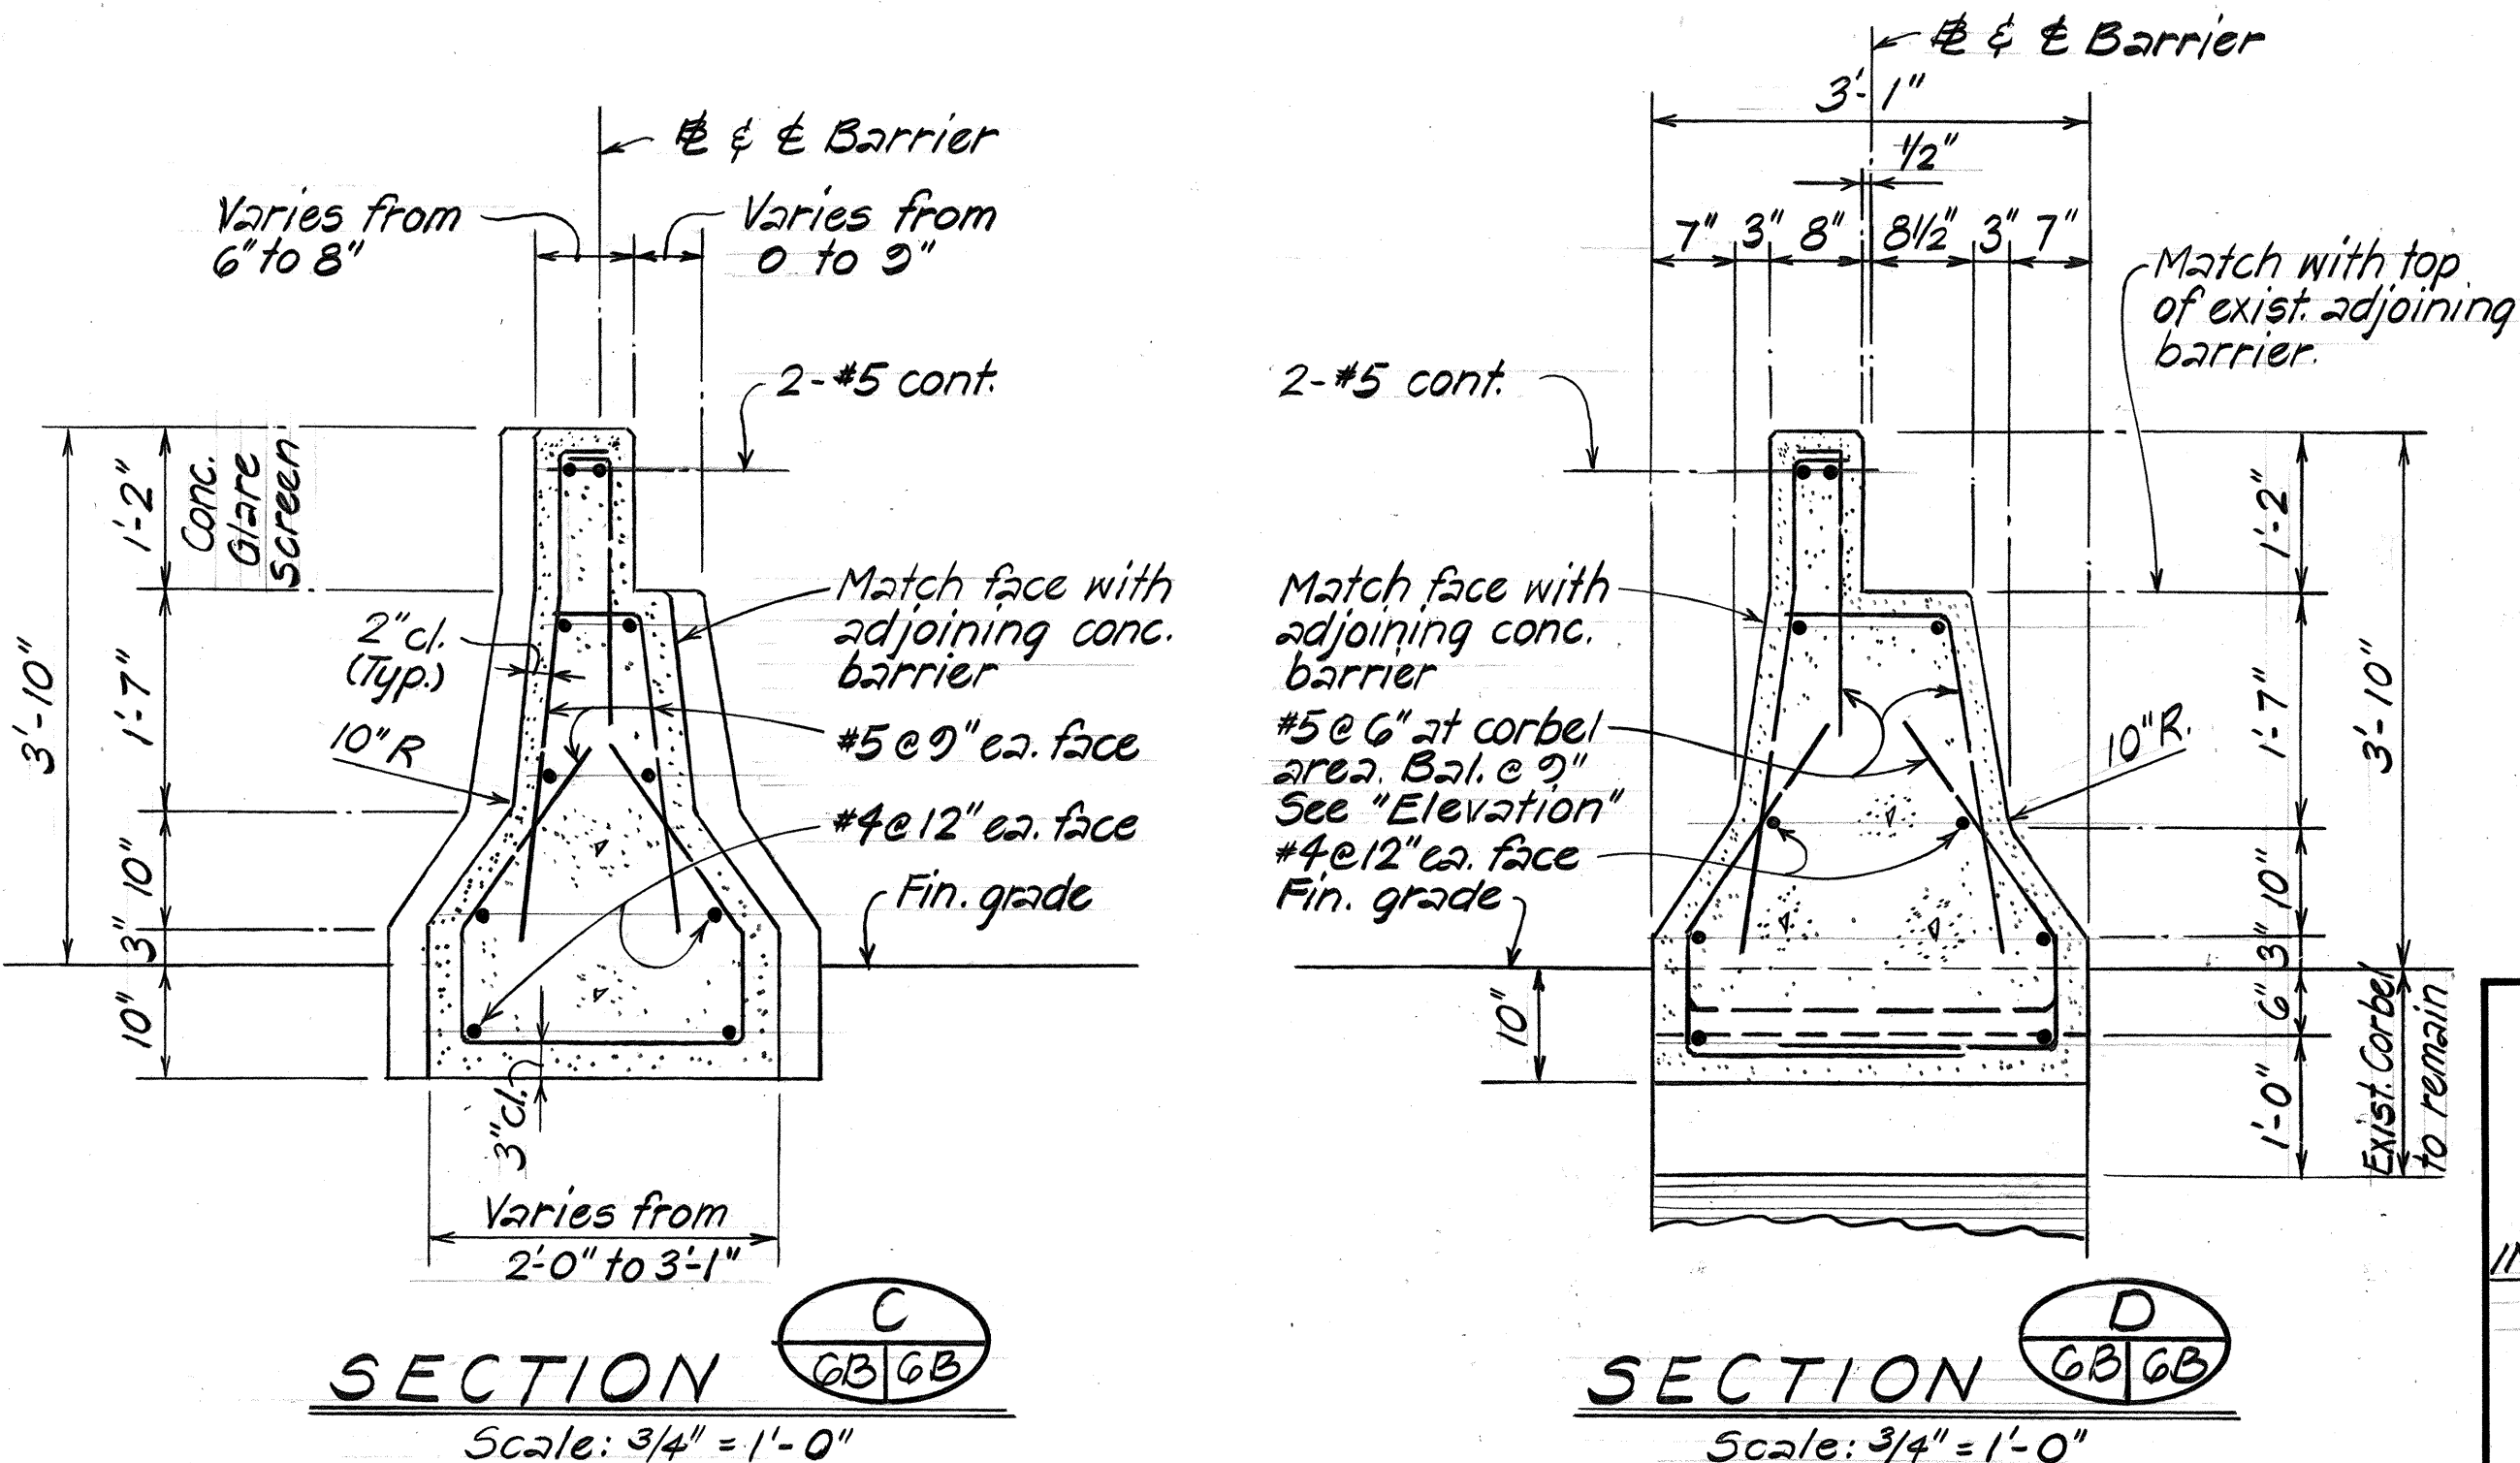

DETAILS - REPLACEMENT OF TRANSITION BARRIER ON PEARL CITY VIADUCT


STATE OF HAWAII
DEPARTMENT OF TRANSPORTATION
HIGHWAYS DIVISION

BARRIER TRANSITION DETAILS
INTERSTATE ROUTE H-1, ADDITIONAL LANES
WAIANA I.C. TO HALAWA I.C.
F.A.I.P. NO. IR-HI-1(193)
Scale: As Shown Date: Sept. 1985


SHEET No. 68 OF 14 SHEETS

DATE: 8/85
DRAWN BY: T.E.M.
DESIGNED BY: T.S.
QUANTITIES BY: L.A. G.T.
CHECKED BY: B.B.E.


FED. ROAD DIST. NO.	STATE	FED. AID PROJ. NO.	FISCAL YEAR	SHEET NO.	TOTAL SHEETS
HAWAII	HAW.	IR-HI-1(193)	1986	22	62

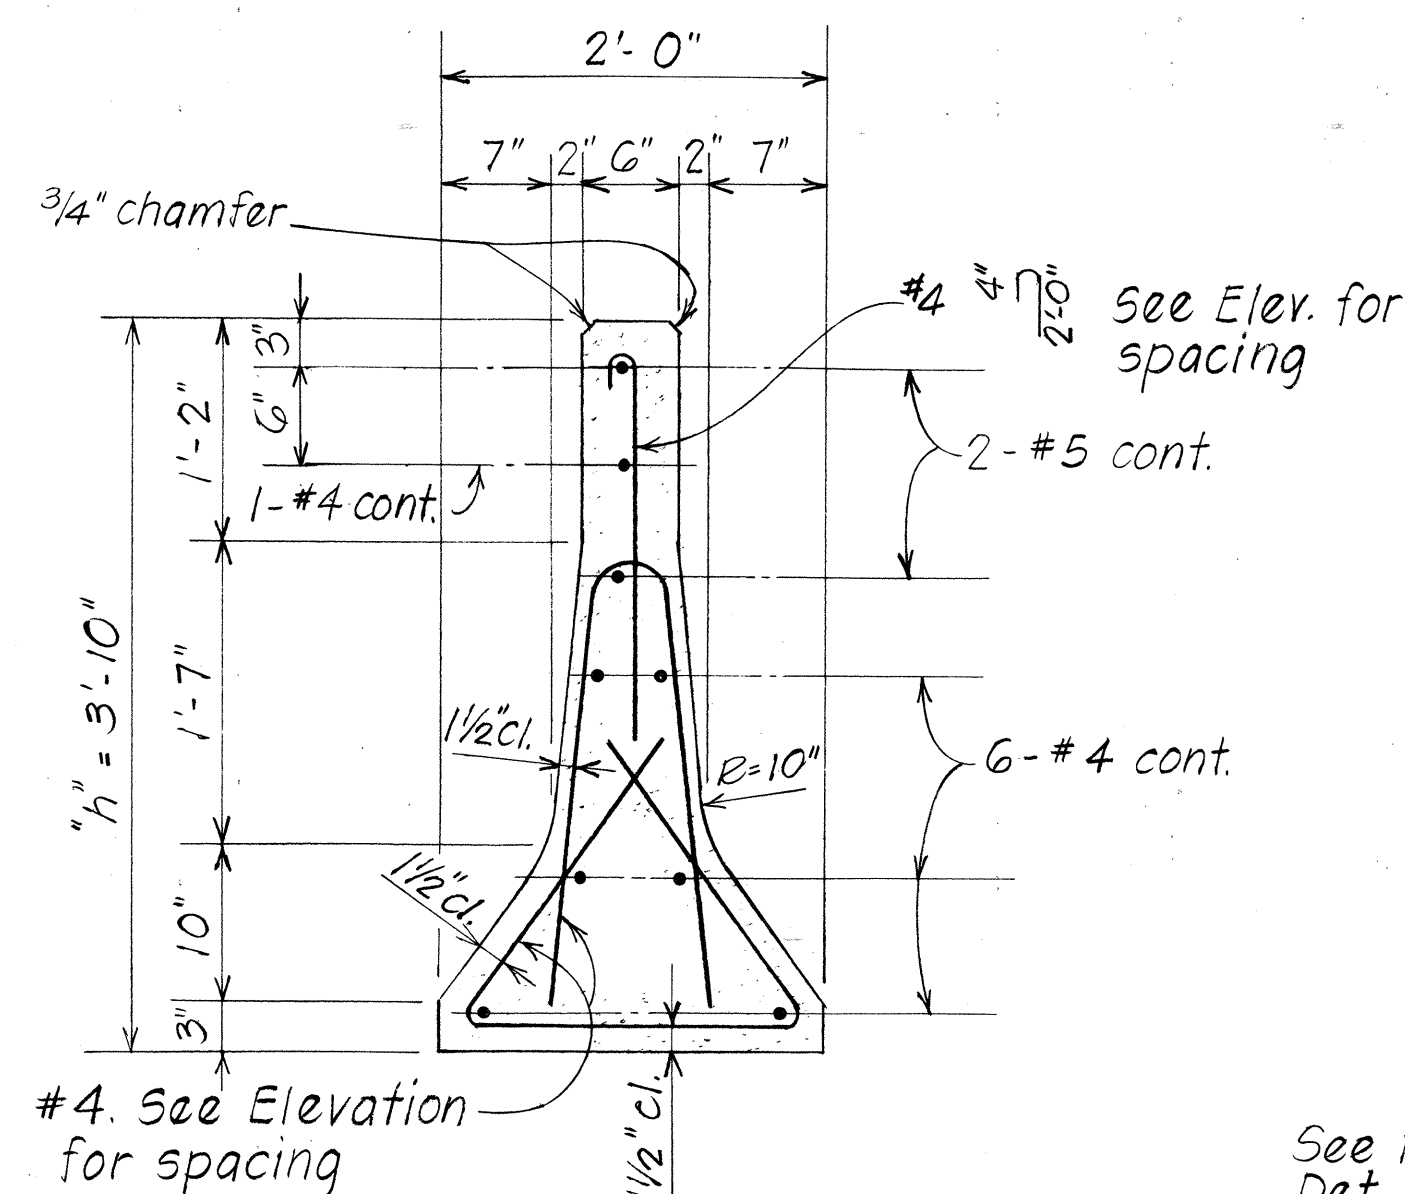

TYPE 50 P1

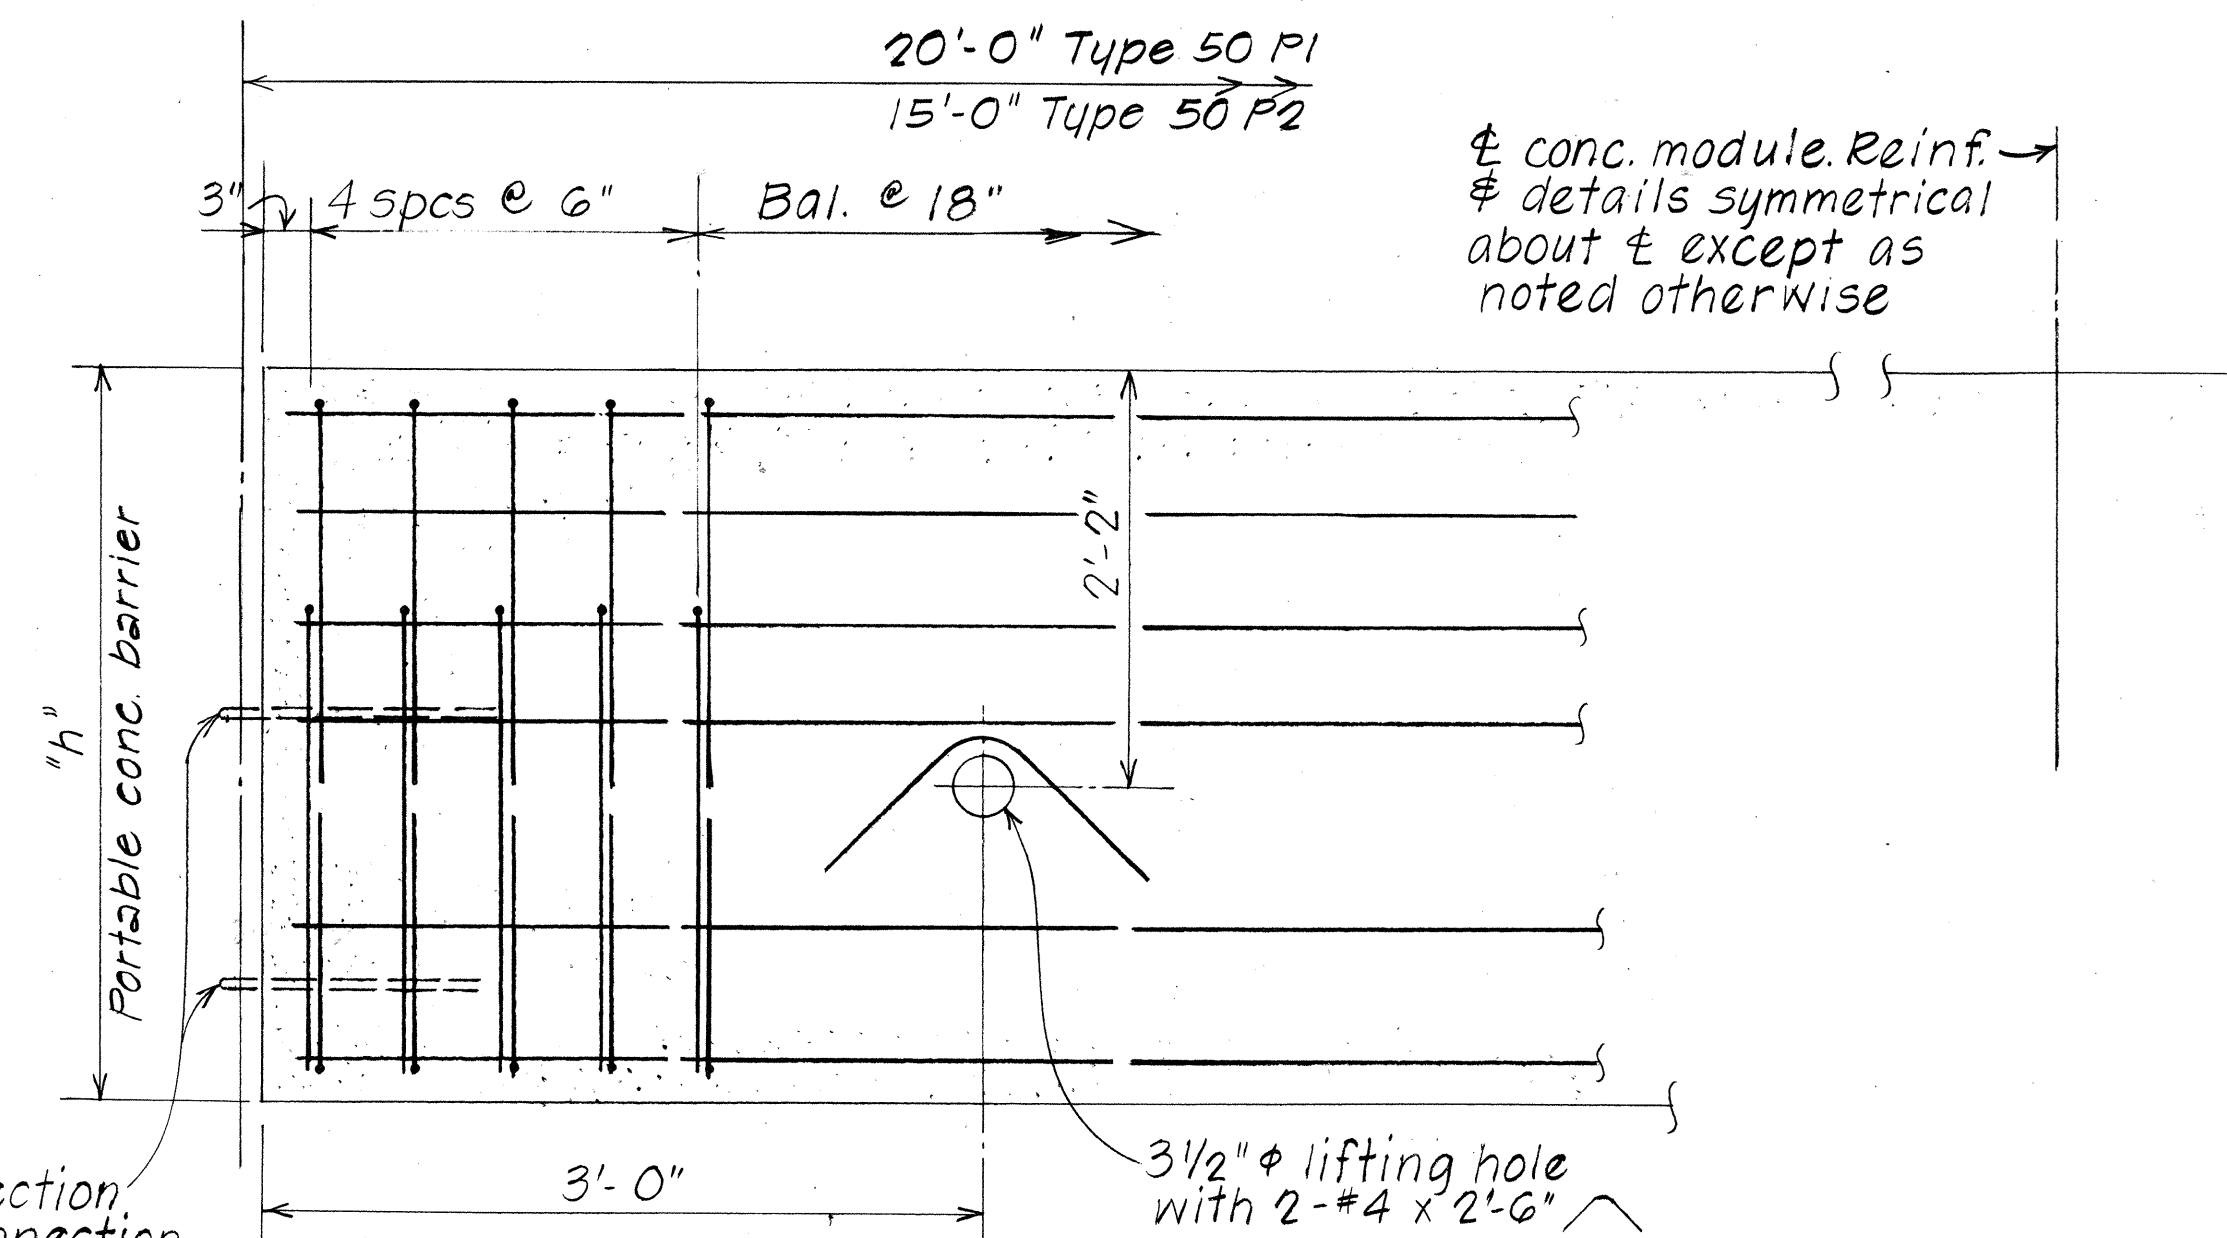


PART ELEVATION - PRECAST CONC. MODULE

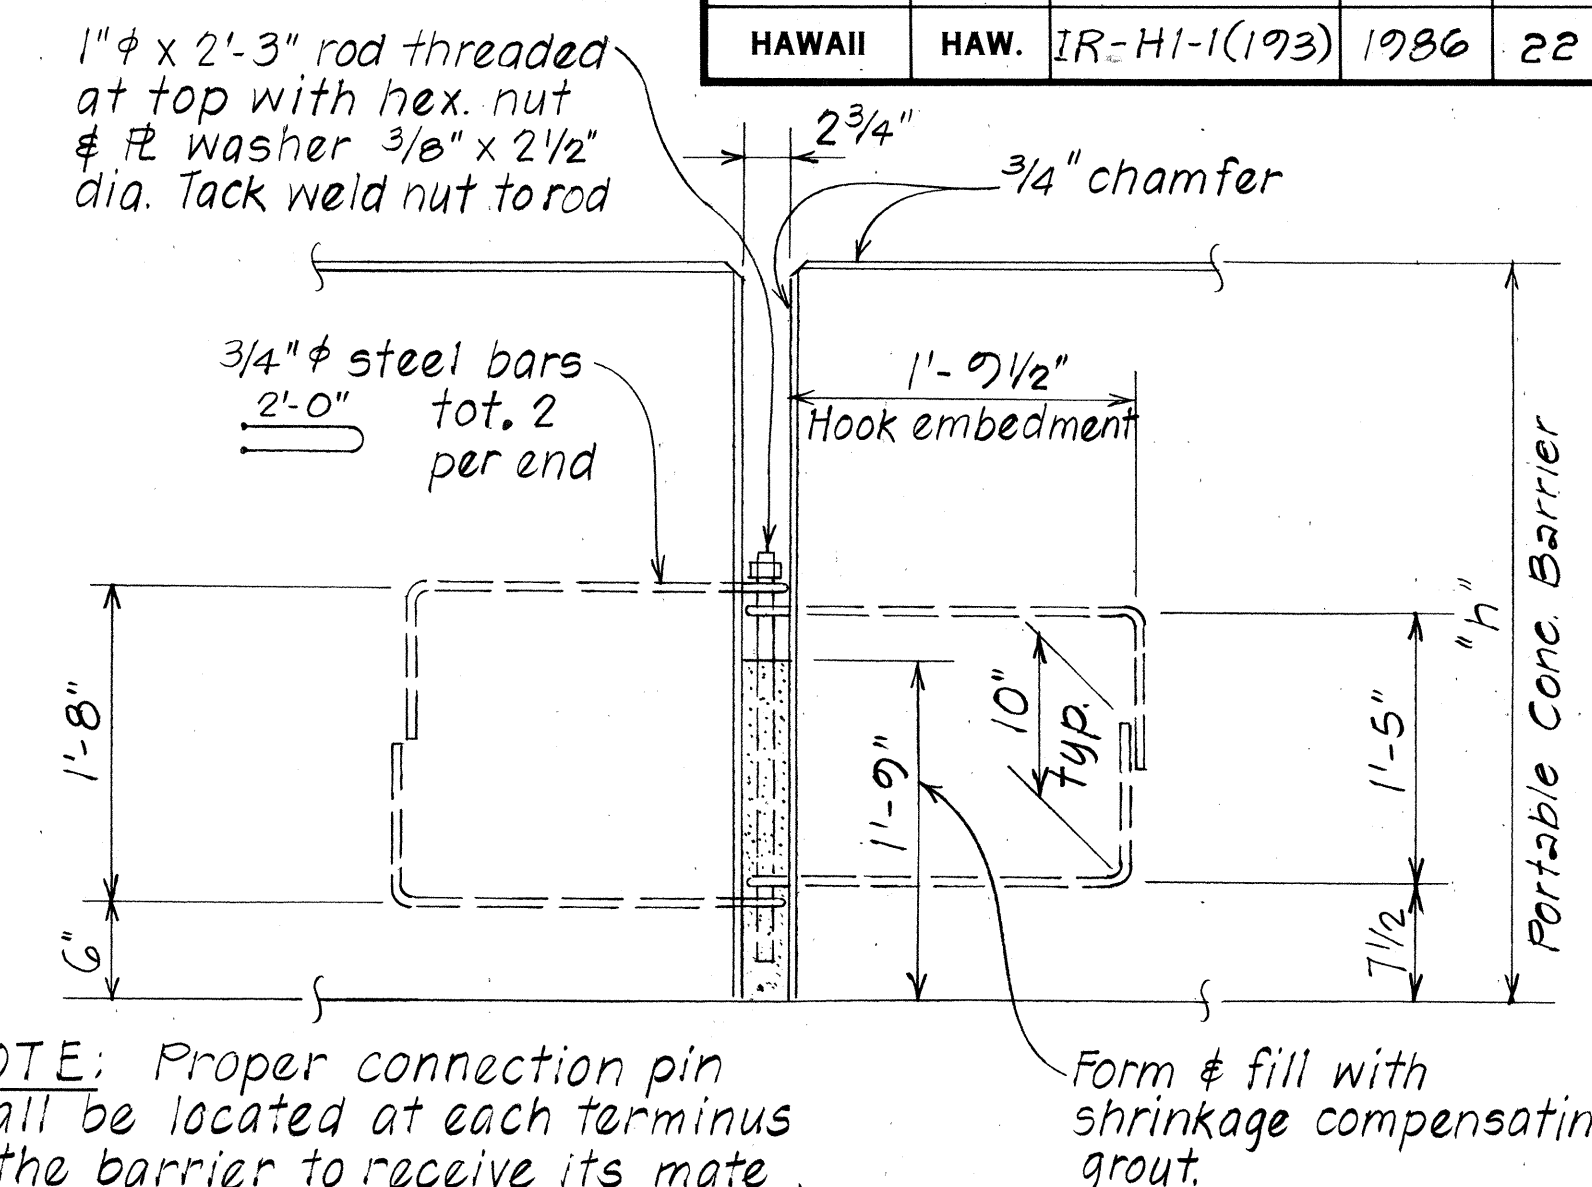

NOTE: Proper connection pin shall be located at each terminus of the barrier to receive its mate. Payment shall be incidental to its respective module.


PIN CONNECTION DETAILS

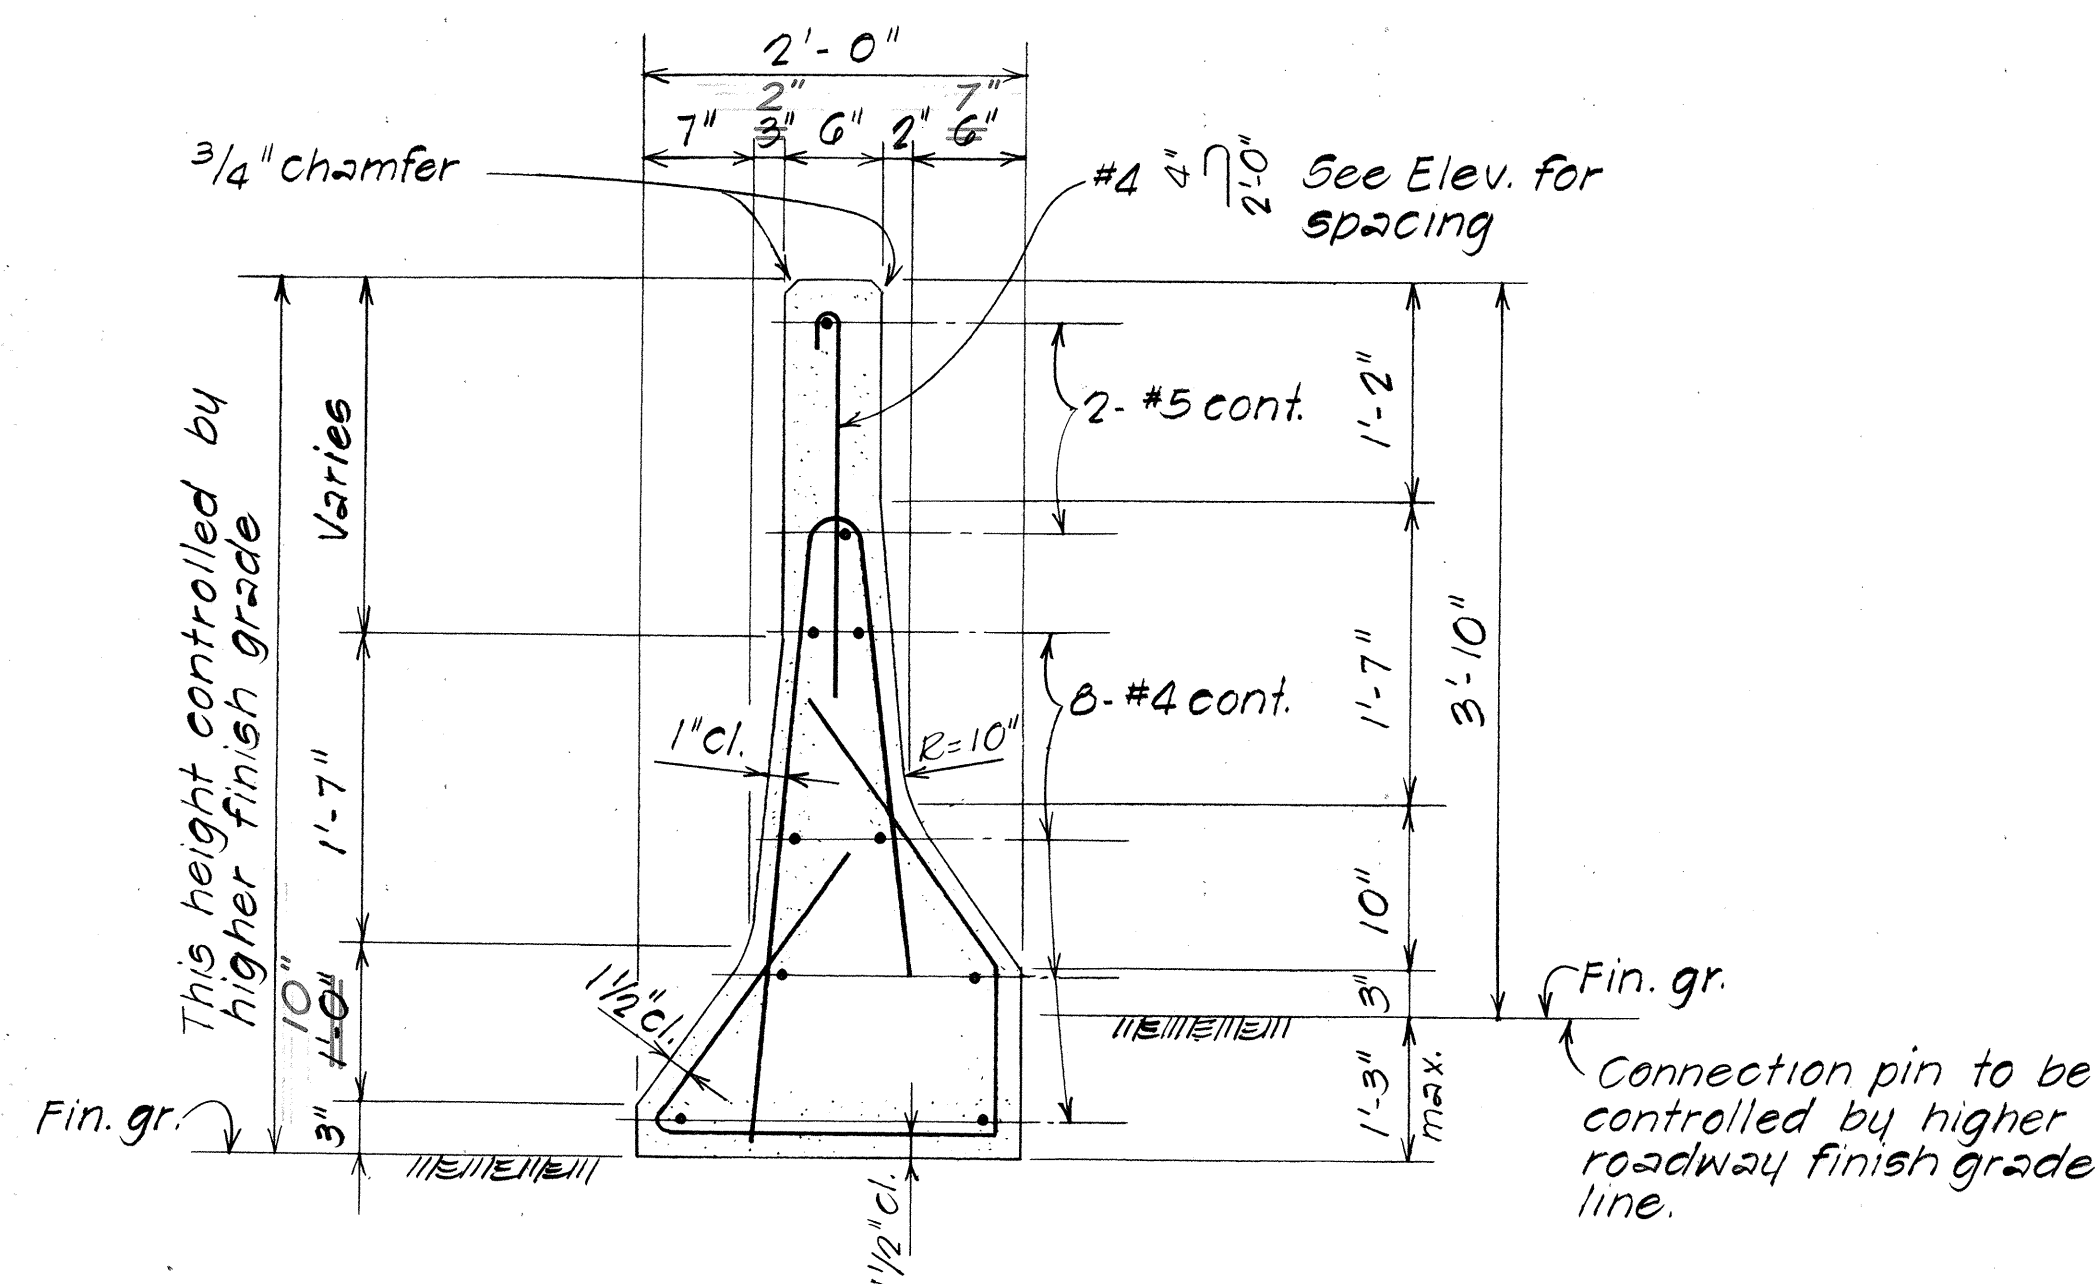

TYPE 50 P2

NOTE:

1. Remove 3' of median barrier (hatched area) beyond the theoretical end limits of the permanent portable barrier and rebuild as shown and noted to match adjacent sections.
2. Where a portion of barrier is to be removed, or saw cut is called for the line of separation between the portions that is to remain and be removed, shall be saw cut to a minimum depth of 1 1/2 inches.
3. Existing horizontal reinforcement in the section to be rebuilt shall be cut, cleaned and incorporated in the new pour.
4. Reinf. and pin shall be incidental to concrete.

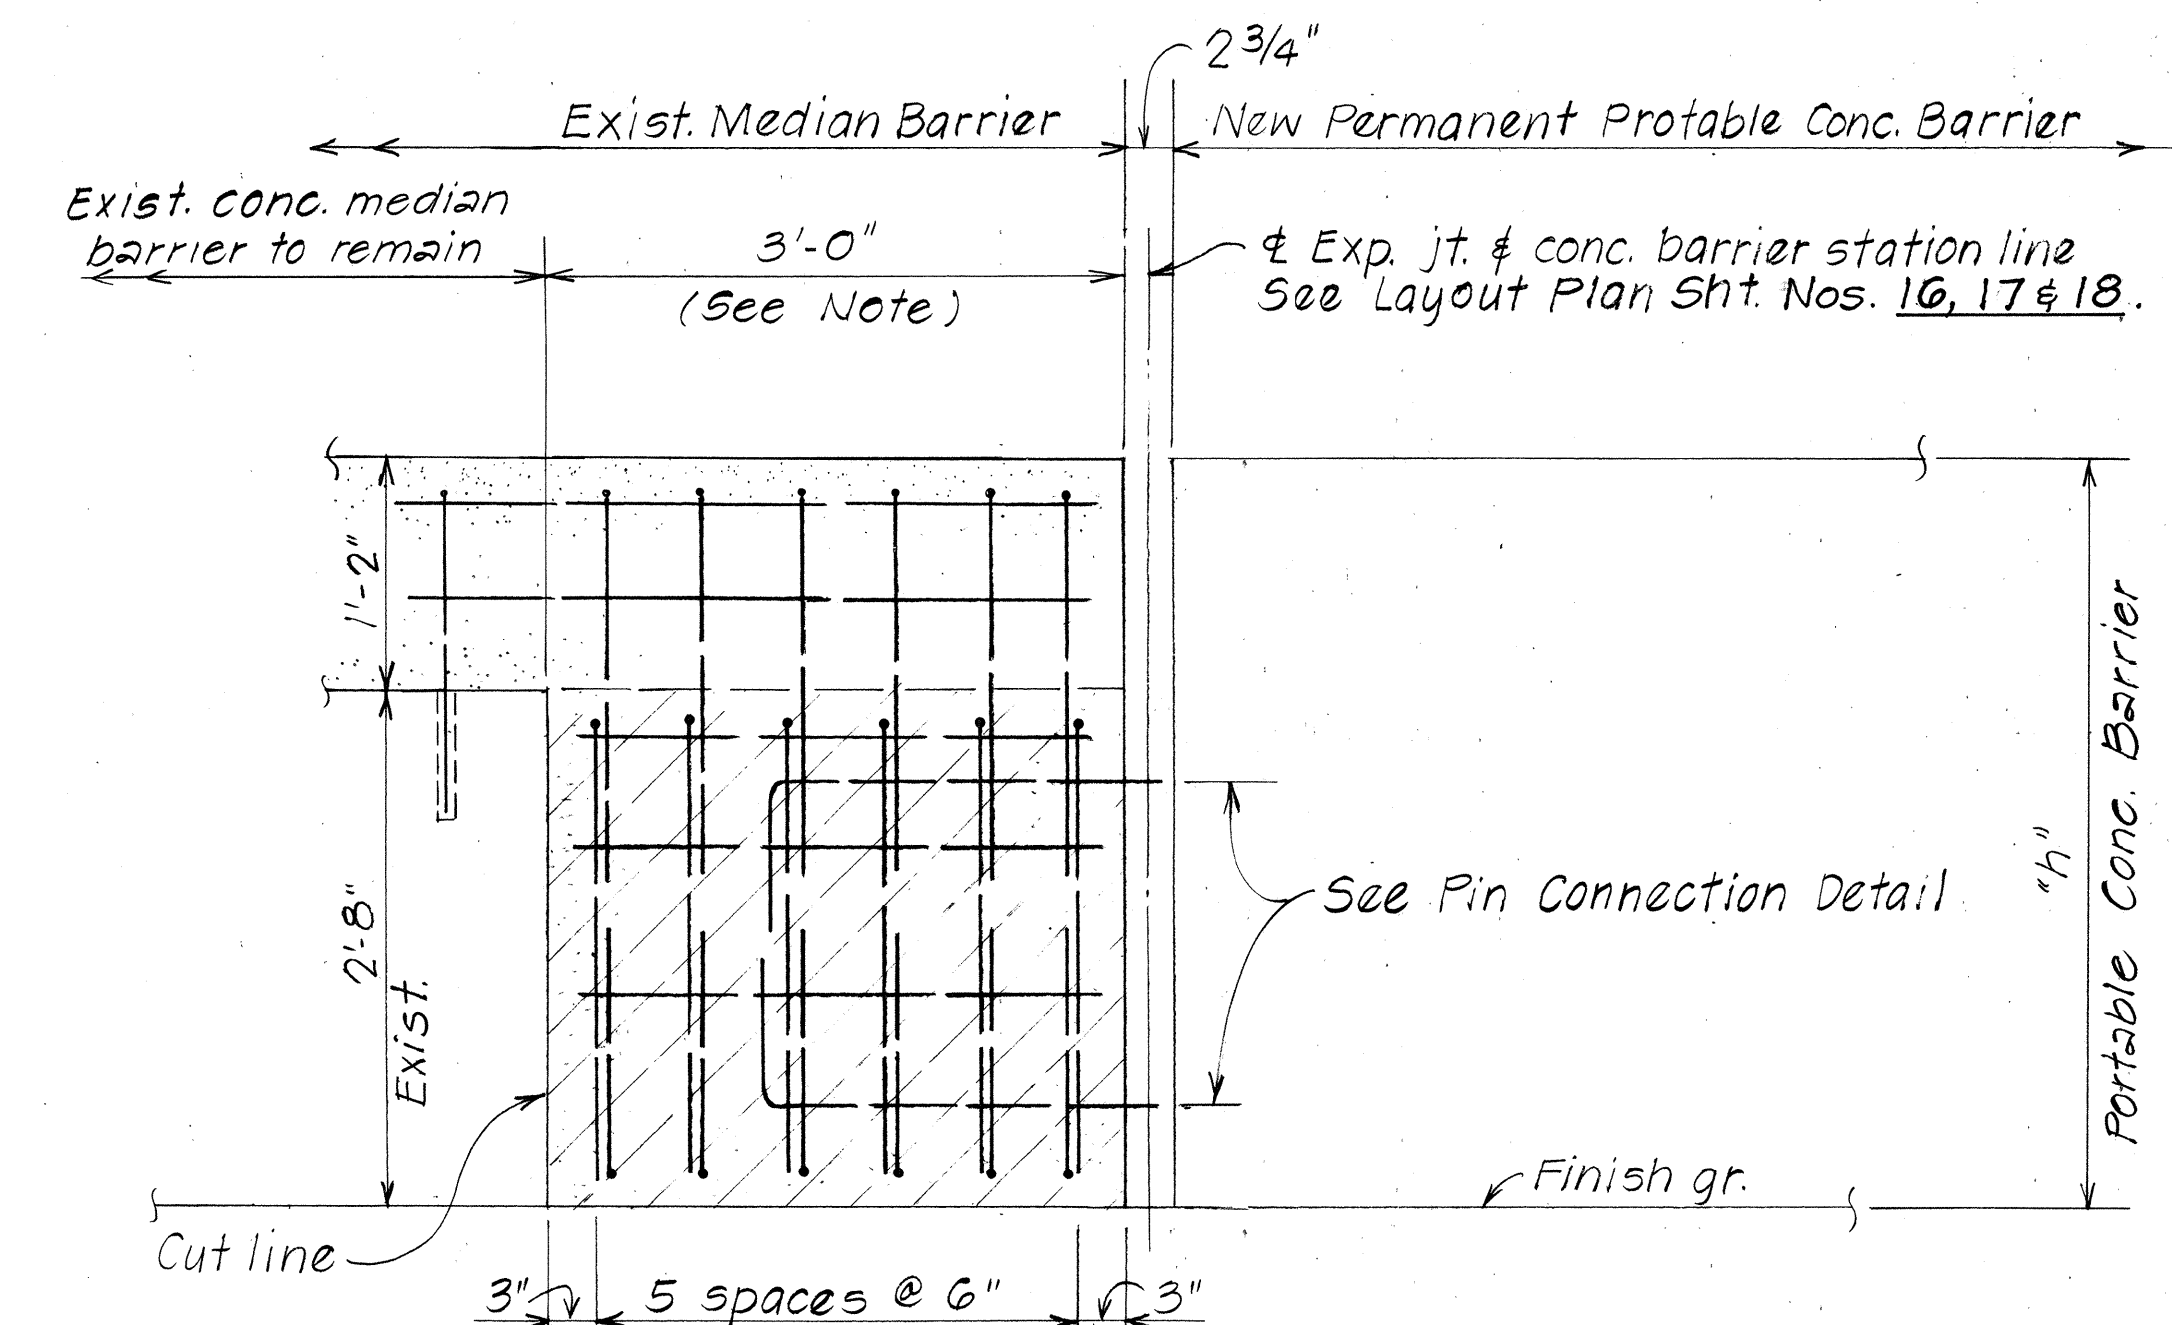

TRANSITION SECTION -
PERMANENT PORTABLE CONC. BARRIER
TO EXISTING CONC. BARRIER

Scale: 1" = 1'-0"






NOTE:
The revised Type 50 P2 Barrier is shown with dimension changes for H-1 Sta. 162+70± to 168+70±.

TYPICAL PERMANENT PORTABLE CONCRETE BARRIER DETAILS

Scale: 1" = 1'-0"




STATE OF HAWAII DEPARTMENT OF TRANSPORTATION HIGHWAYS DIVISION
PERMANENT PORTABLE CONCRETE BARRIER
INTERSTATE ROUTE H-1, ADDITIONAL LANES WAIANA I.C. TO HALAWA I.C.
F.A.I. Proj. No. IR-HI-1(193)
Scale: As shown Date: Sept. 1985
SHEET No. 78 OF 14 SHEETS

FED. ROAD DIST. NO.	STATE	FED. AID PROJ. NO.	FISCAL YEAR	SHEET NO.	TOTAL SHEETS
HAWAII	HAW.	IR-HI-1(193)	1986	23	62

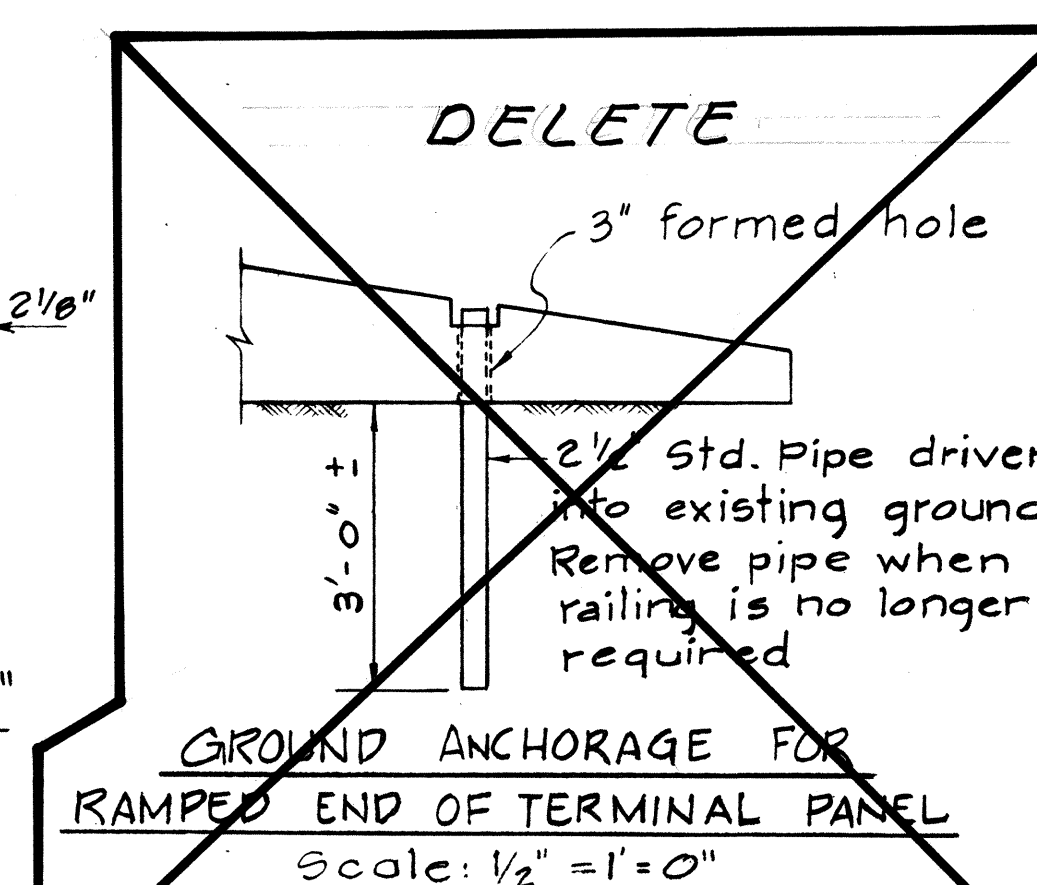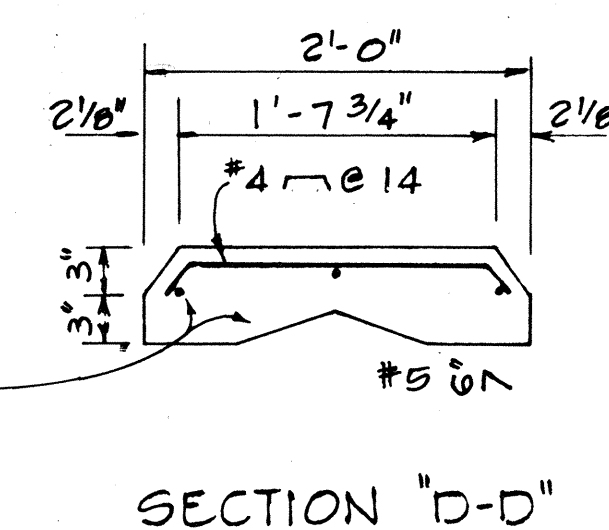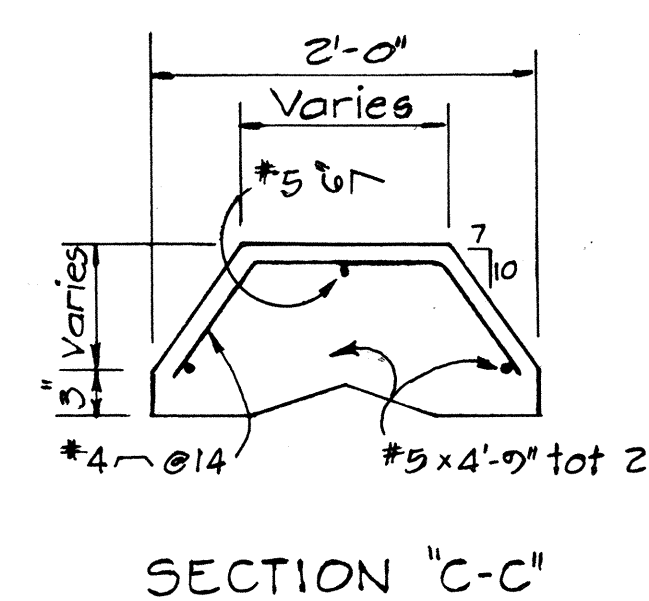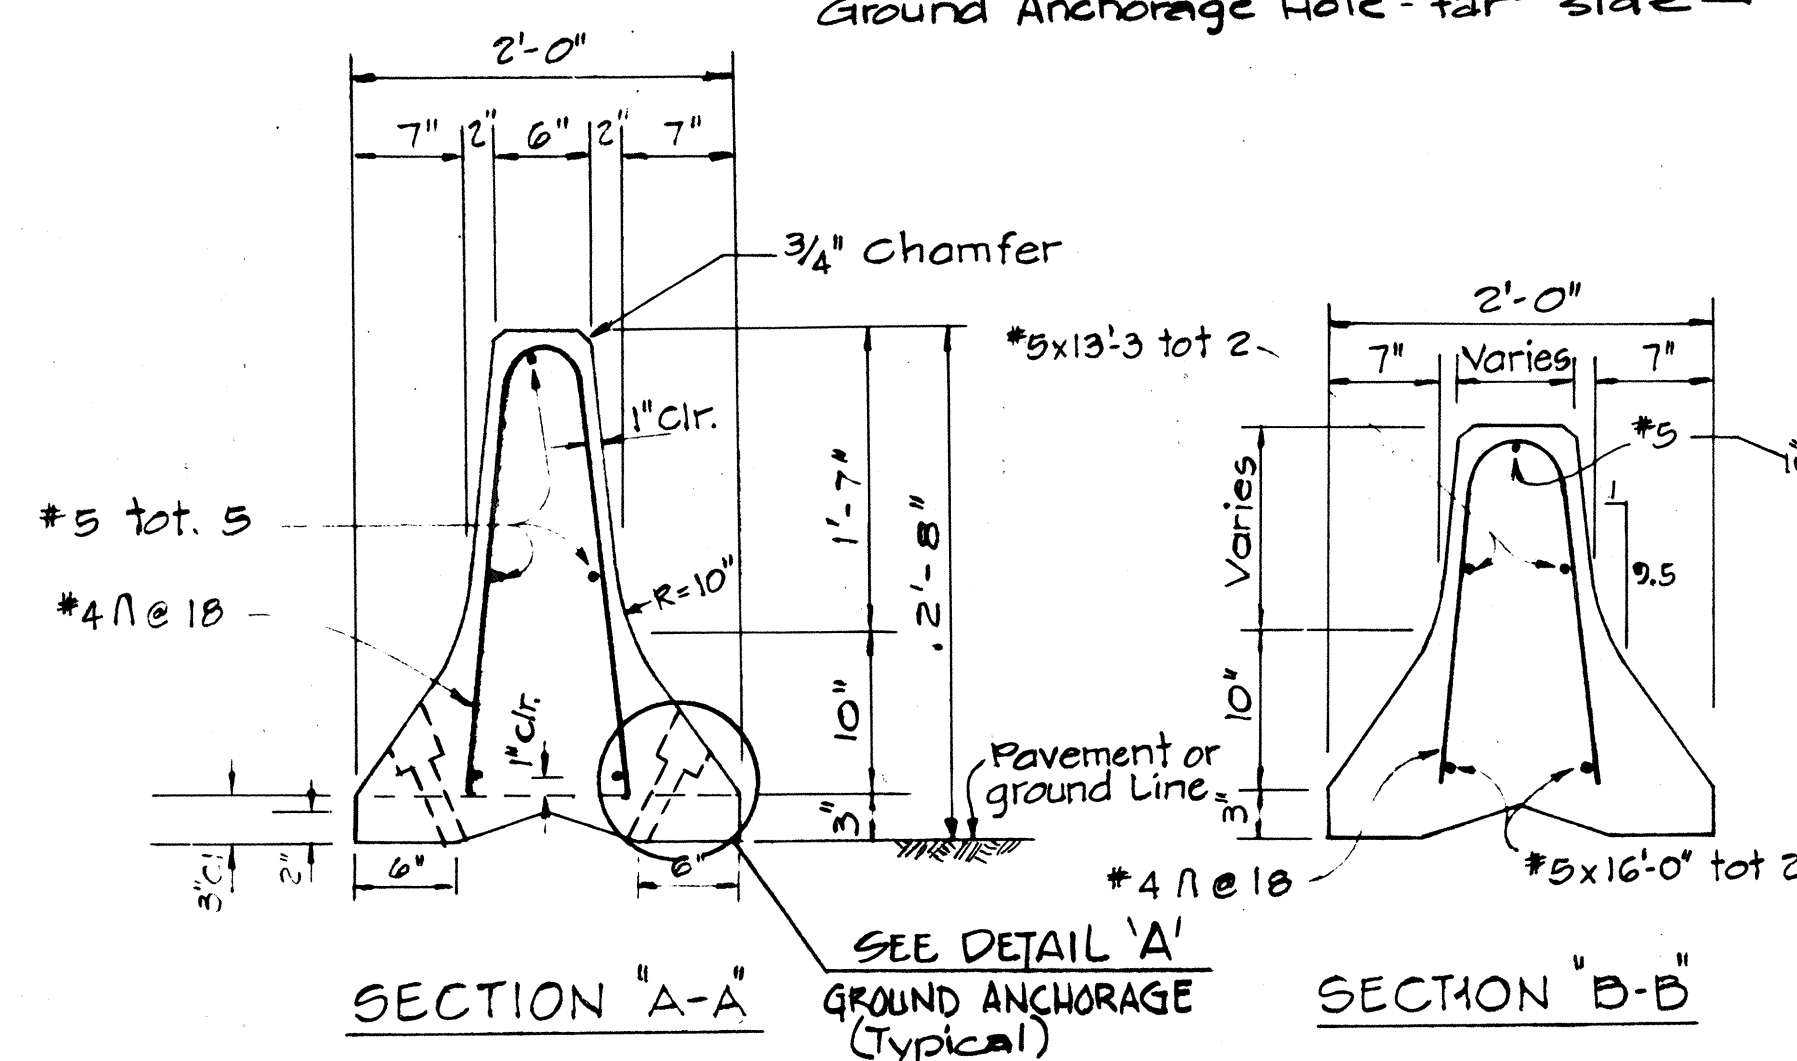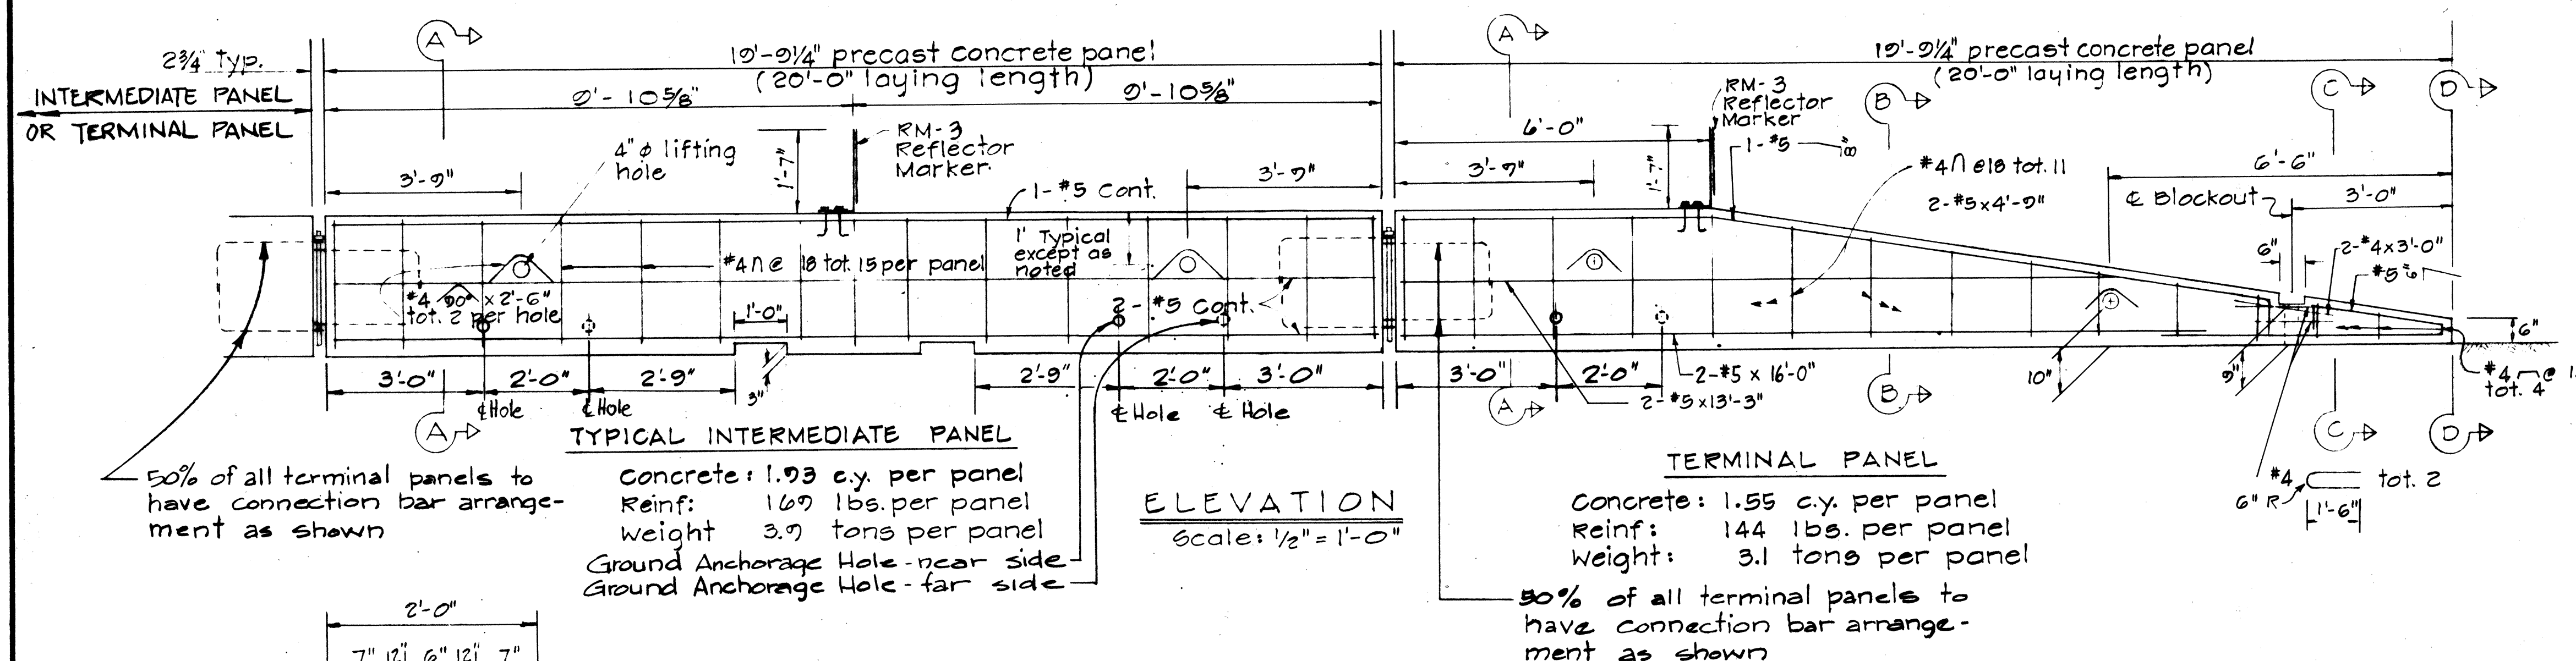

- NOTES

1. For details not shown in Sections BB, C-C, & D-D, see Section A-A
2. Reflector Marker shall not be paid for separately but shall be considered incidental to "Portable Concrete Guard Rail."
3. Concrete shall be Class "A".
4. All bolts to have cut washers unless otherwise noted.

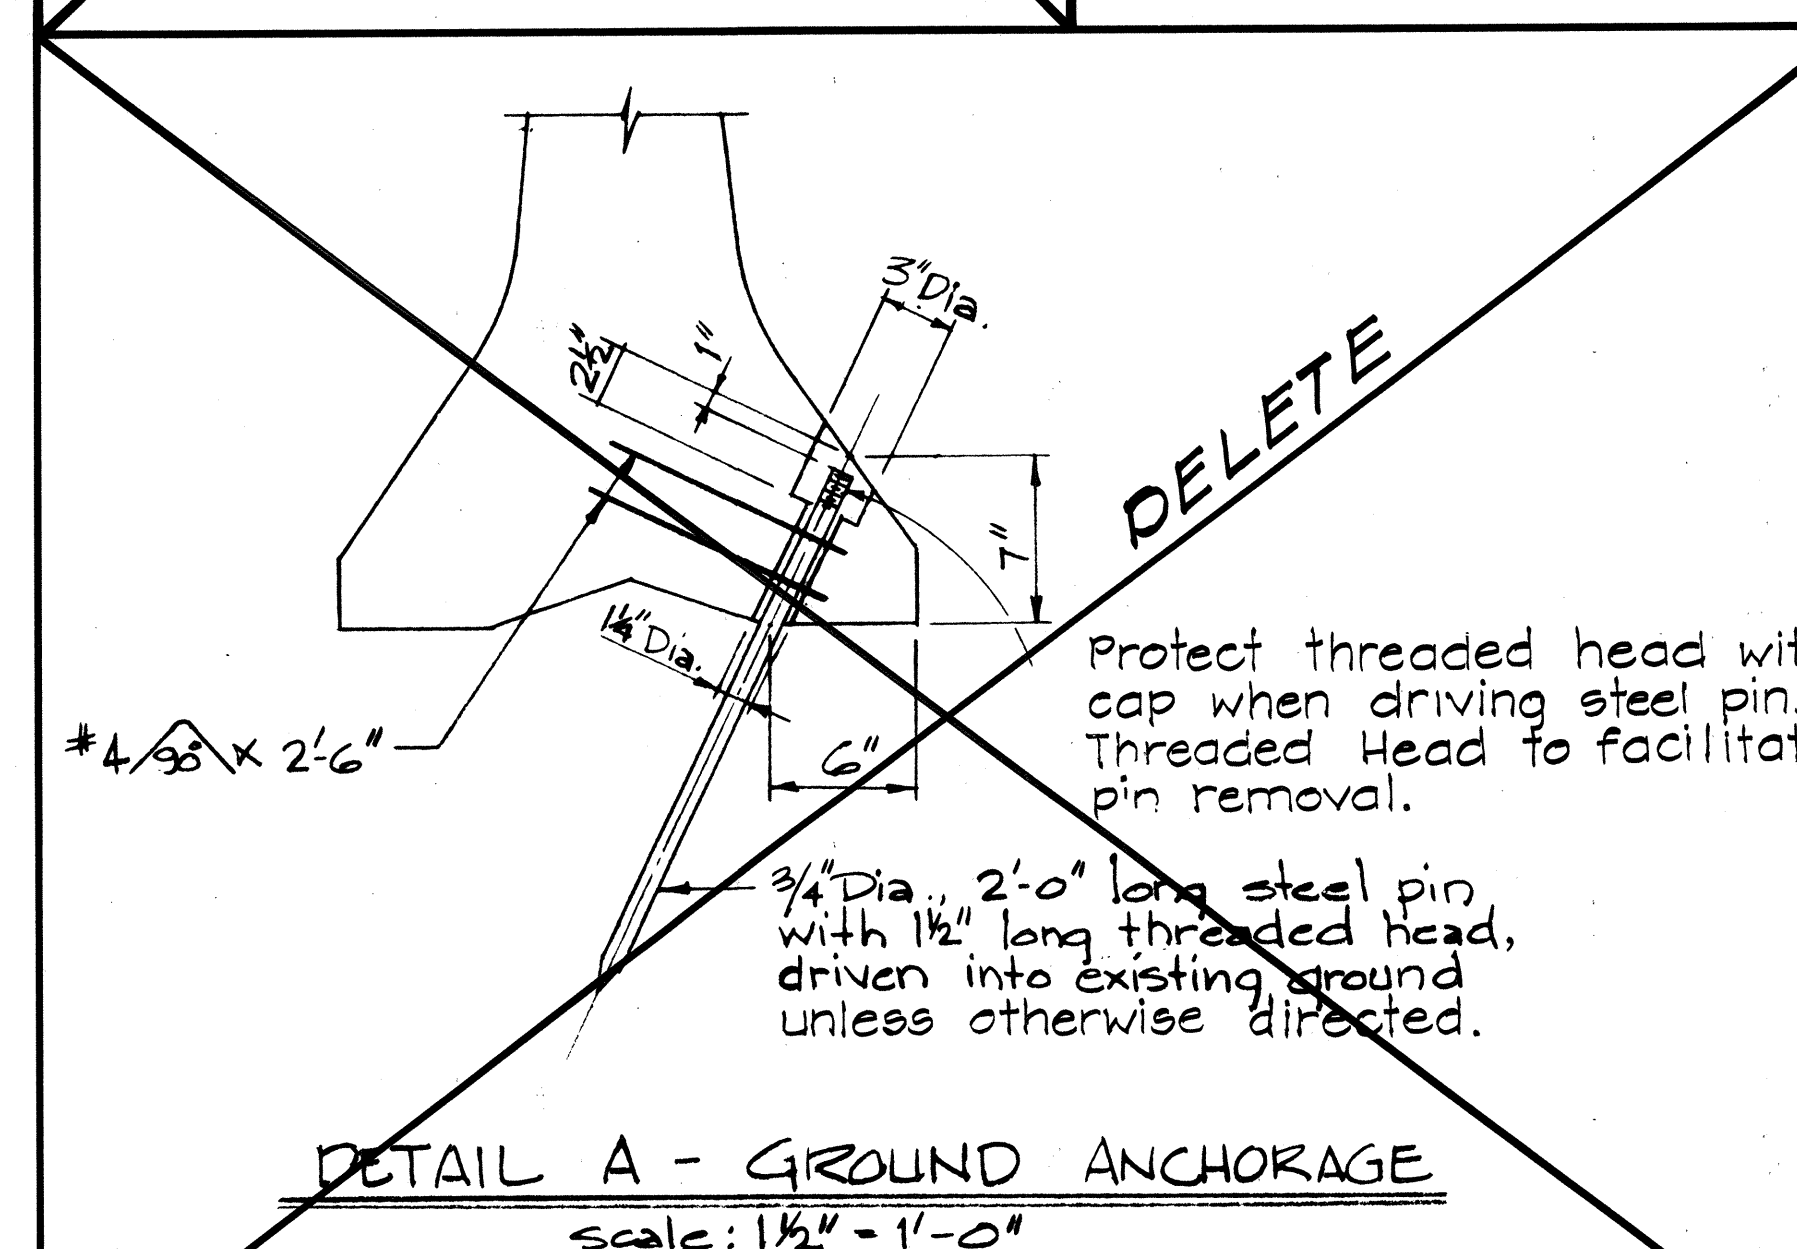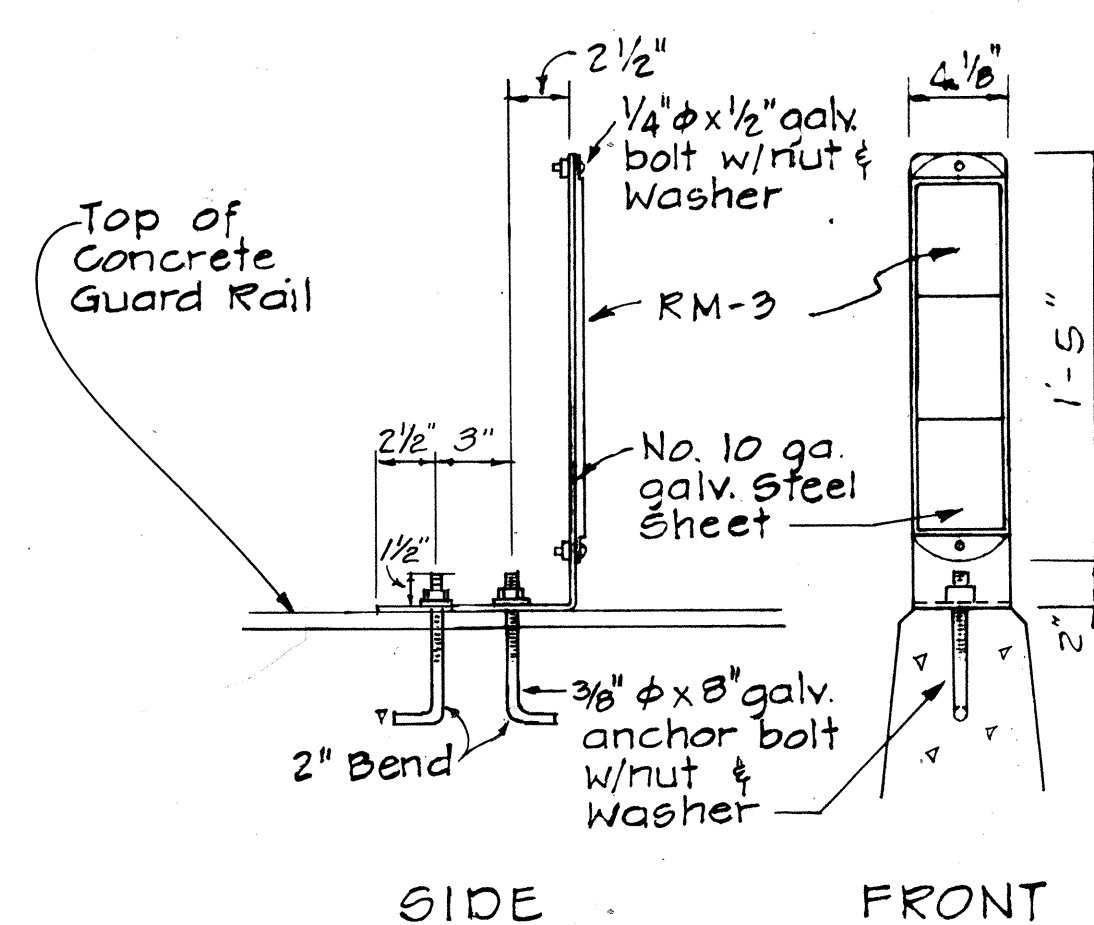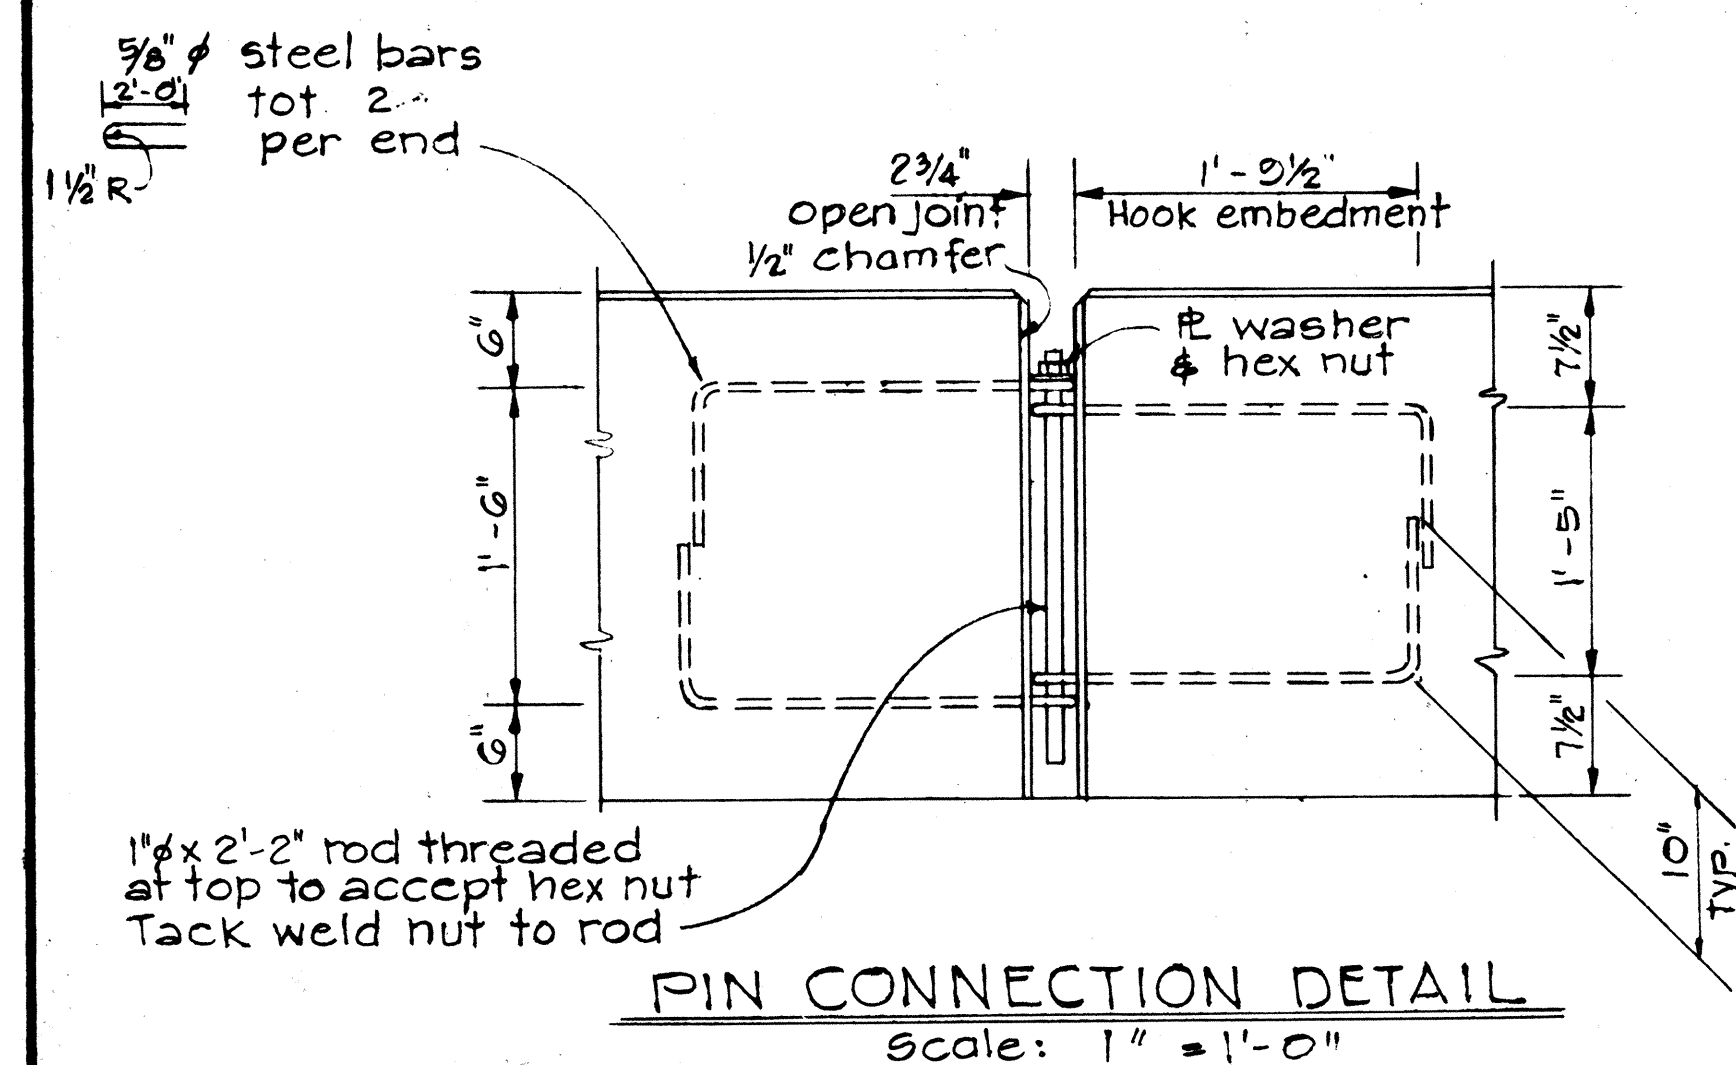

- Protect threaded head with cap when driving steel pin.
- Threaded Head to facilitate pin removal.
- 6" long steel pin.
- ~~ing threaded head,~~
- existing ground
- otherwise directed.

STATE OF HAWAII
DEPARTMENT OF TRANSPORTATION
HIGHWAYS DIVISION



PORTABLE CONCRETE GUARD
RAIL TYPICAL DETAILS
INTERSTATE ROUTE H-1
ADDITIONAL LANES
F.A.I. Proj. No. IR-HI-1(193)
Scale: As Noted Date: Sept. 1985

SHEET NO. 83 OF 14 SHEETS

FED. ROAD DIST. NO.	STATE	FED. AID PROJ. NO.	FISCAL YEAR	SHEET NO.	TOTAL SHEETS
HAWAII	HAW.	IR-HI-1(193)	1986	24	62


GENERAL NOTES

- Both of the alternate type posts may be used on any one project however, only one type of post shall be used in any single run of guardrail.
- All hardware, posts and blocks shall be galvanized. No punching, drilling or cutting will be permitted after galvanizing.
- Connection details for bent plate post and block shall be similar to the details shown for structural shape post, and block.
- Where conditions require, special post lengths in increments of 6 inches may be specified.
- For details of rail elements, bolts and nuts, see sheet DT 501.
- All fasteners, posts, blocks and rail elements shall conform to the latest edition and amendments of "A Guide to Standardized Highway Barrier Rail Hardware", a report prepared and approved by the AASHTO-AGC-ARTBA Joint Cooperative Committee.

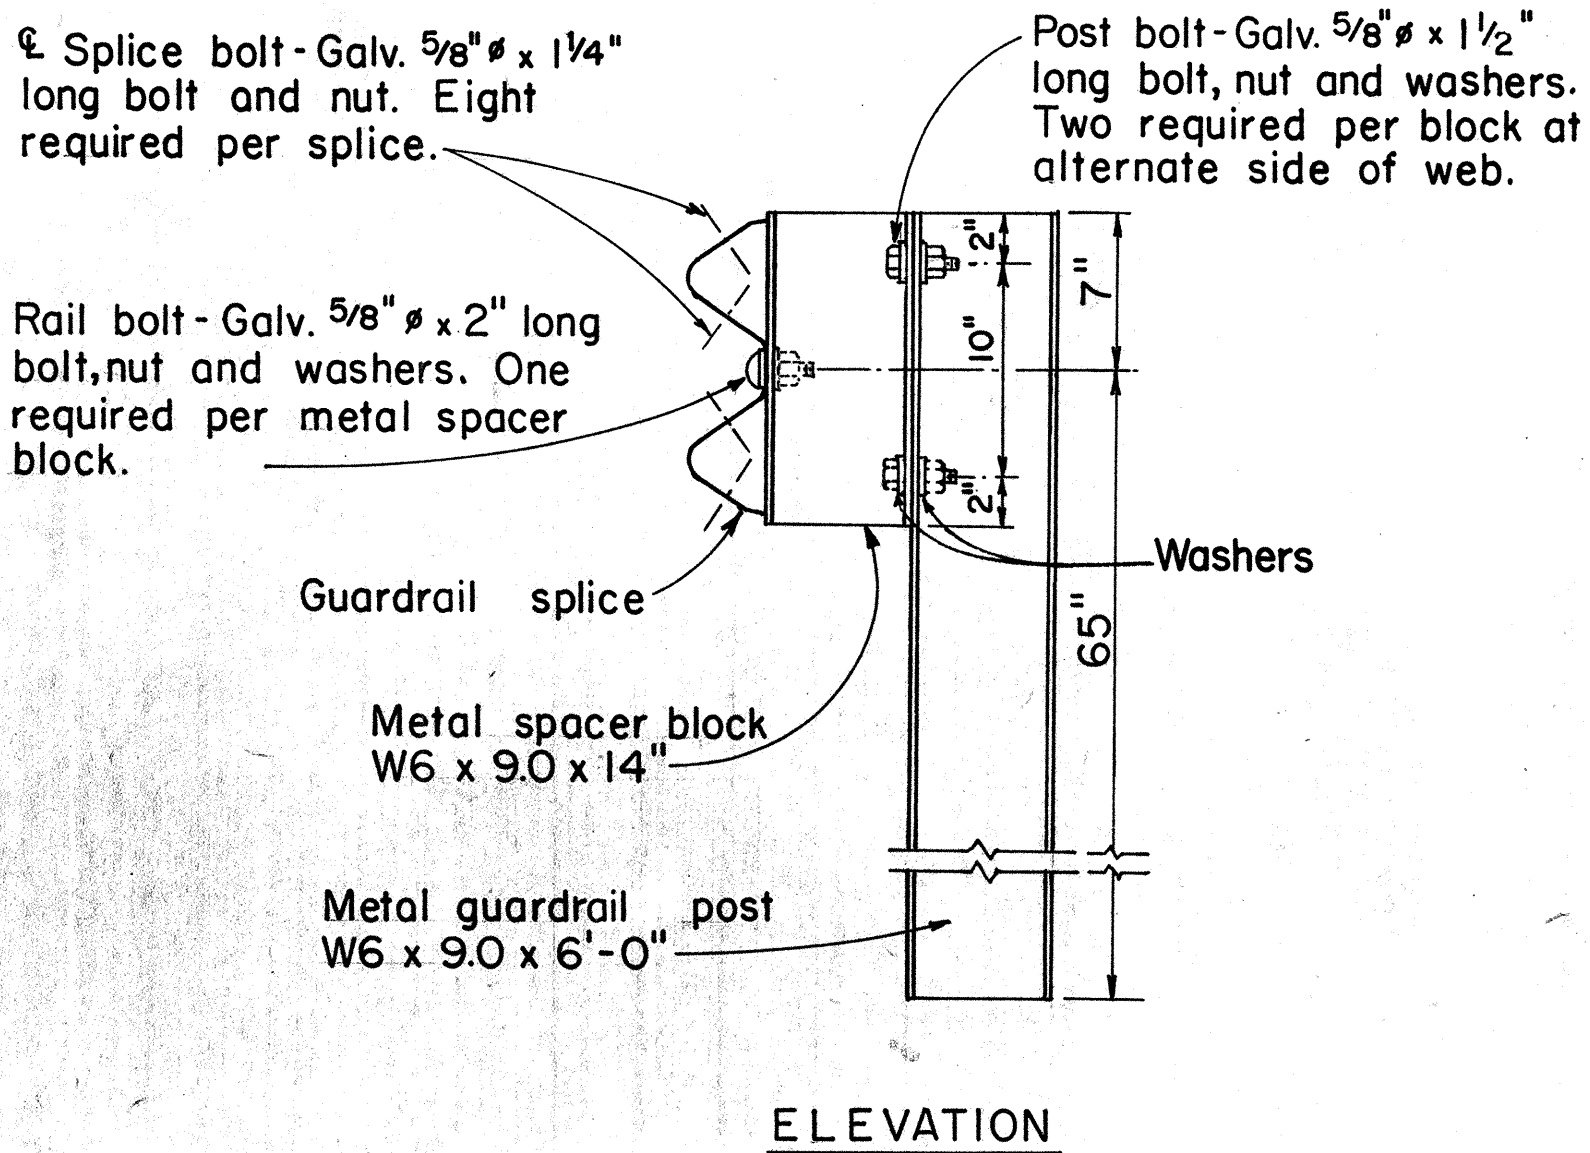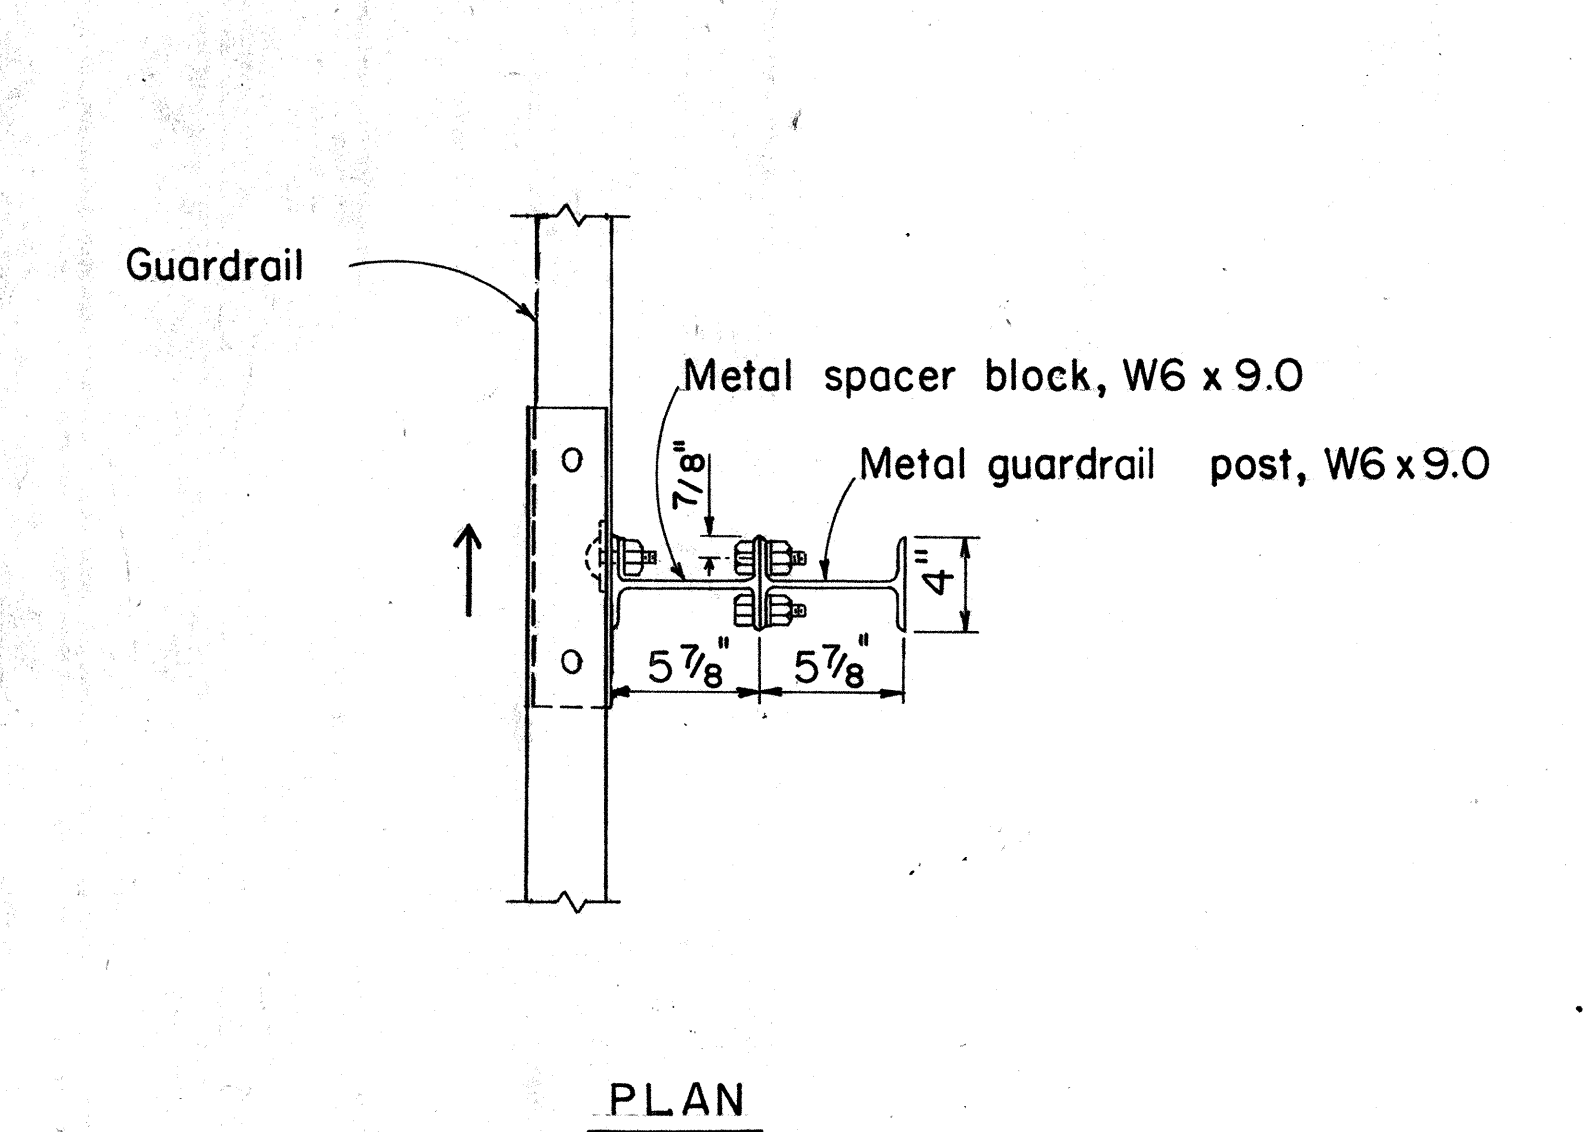


SINGLE METAL GUARDRAIL ON METAL POST WITH METAL SPACER BLOCK

SCALE: $1\frac{1}{2}$ " = 1'-0"

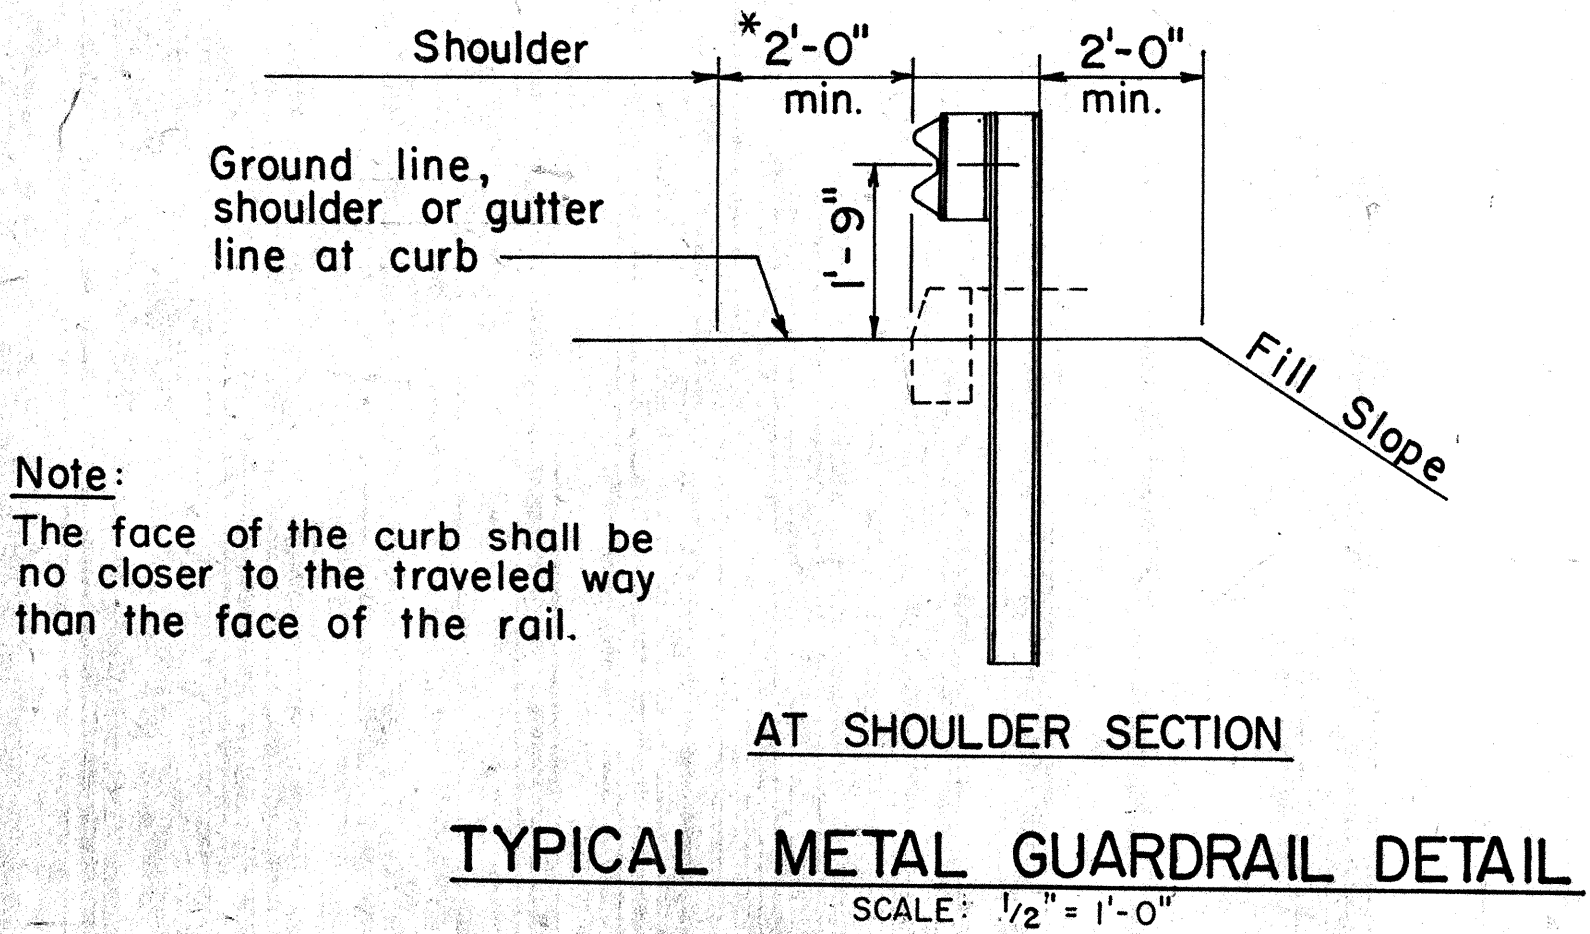


Note:
The face of the curb shall be no closer to the traveled way than the face of the rail.

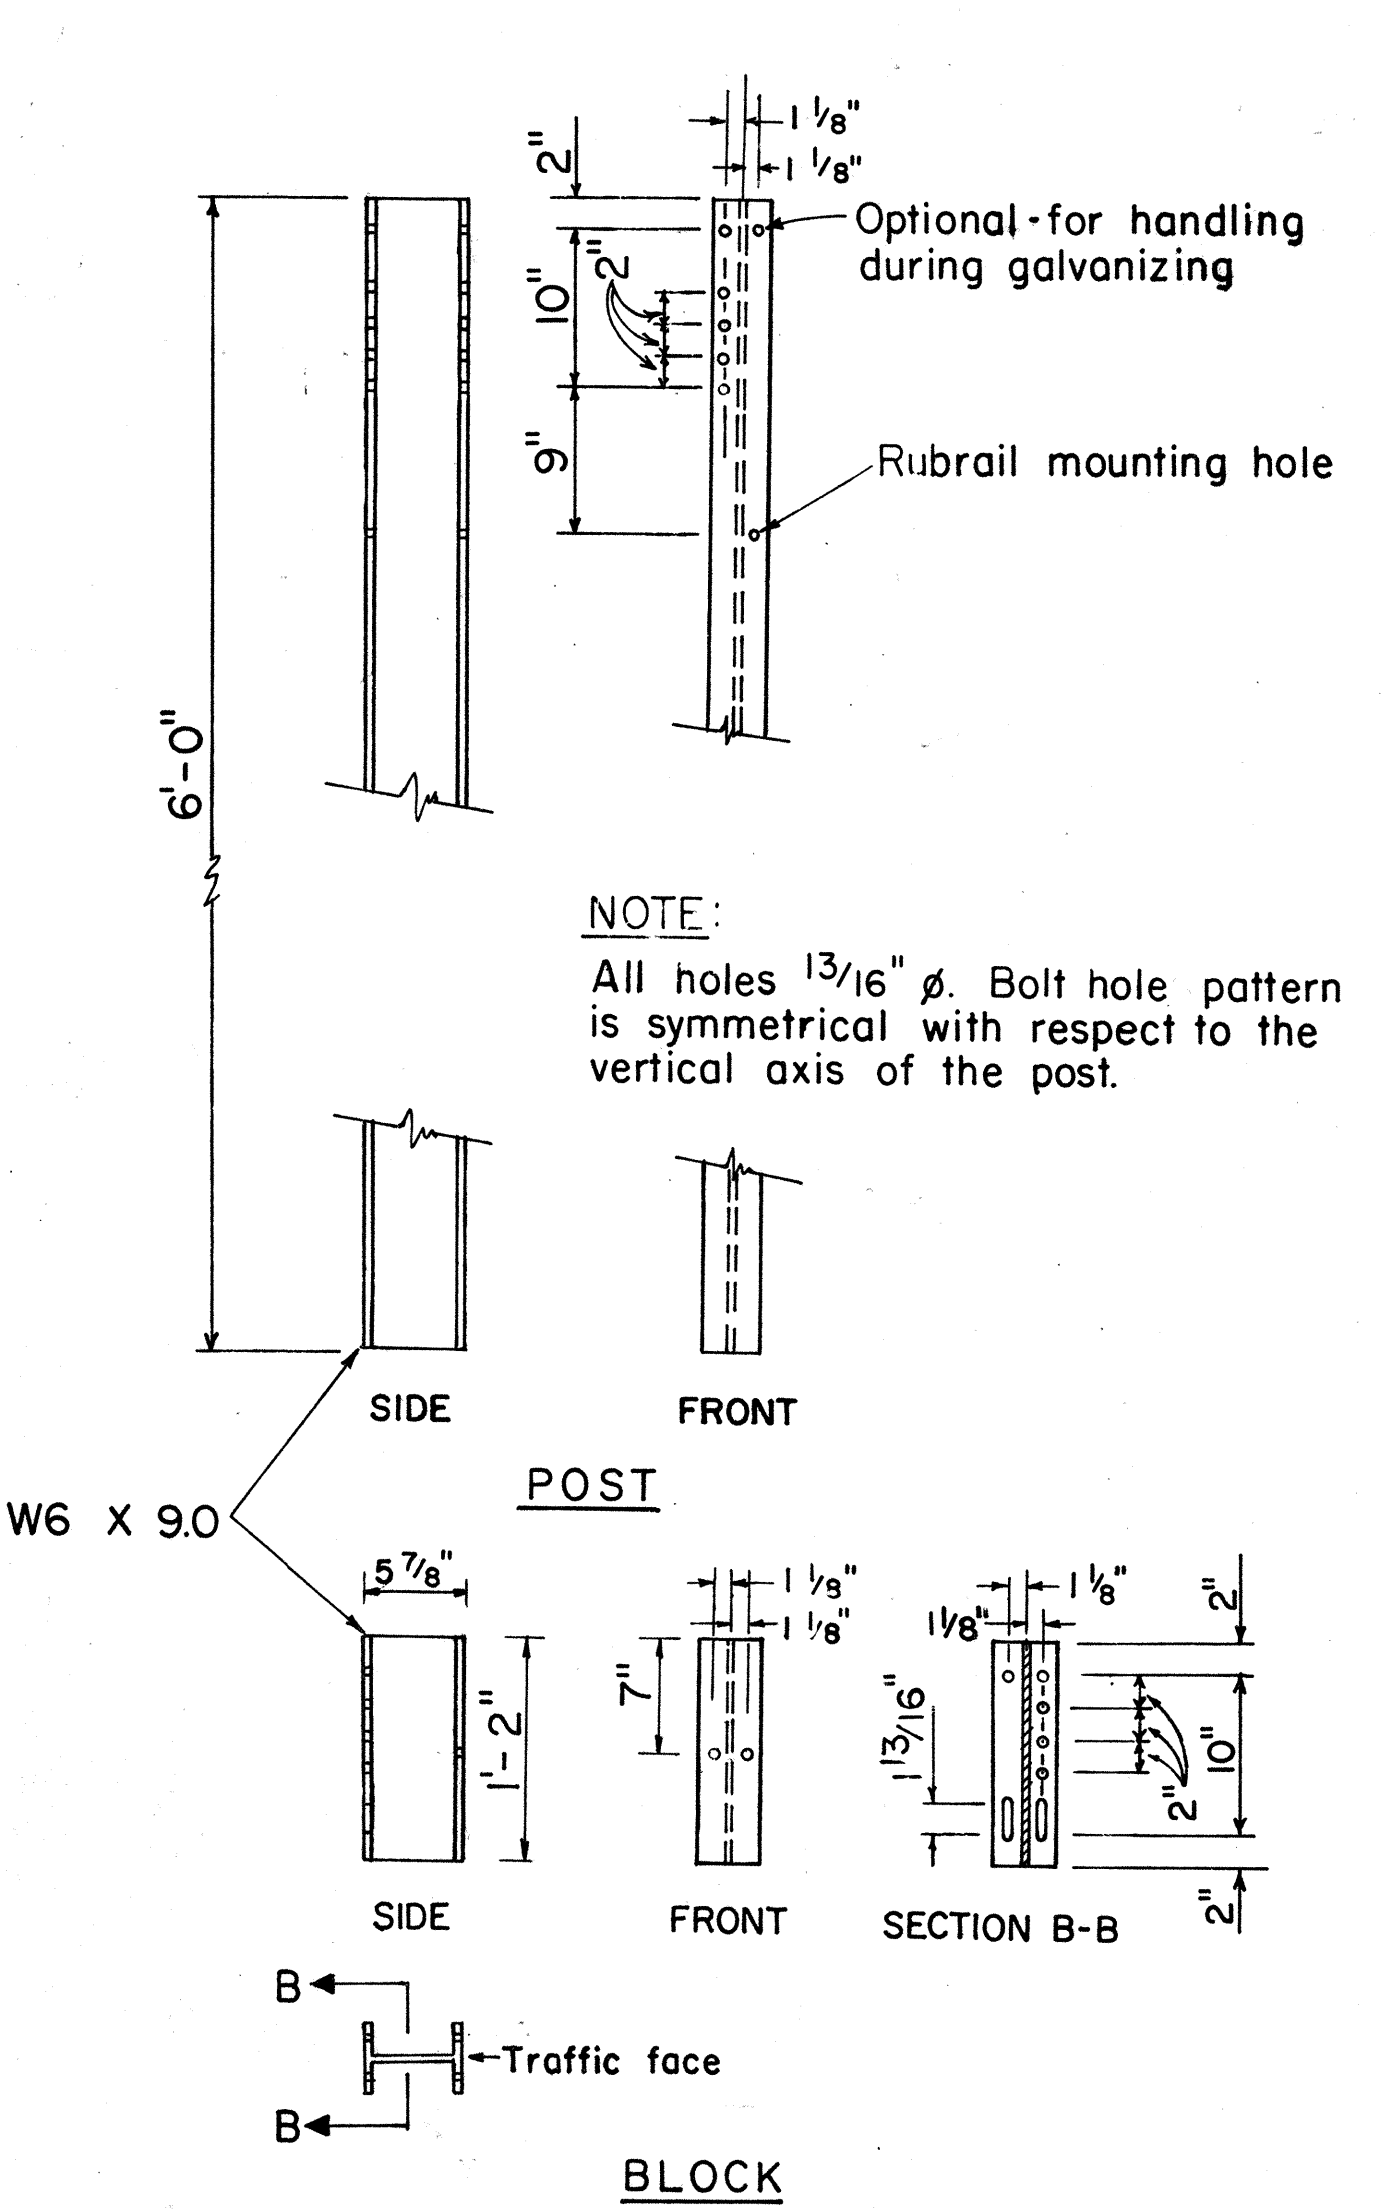


STRUCTURAL SHAPE POST AND BLOCK

SCALE: 1" = 1'-0"

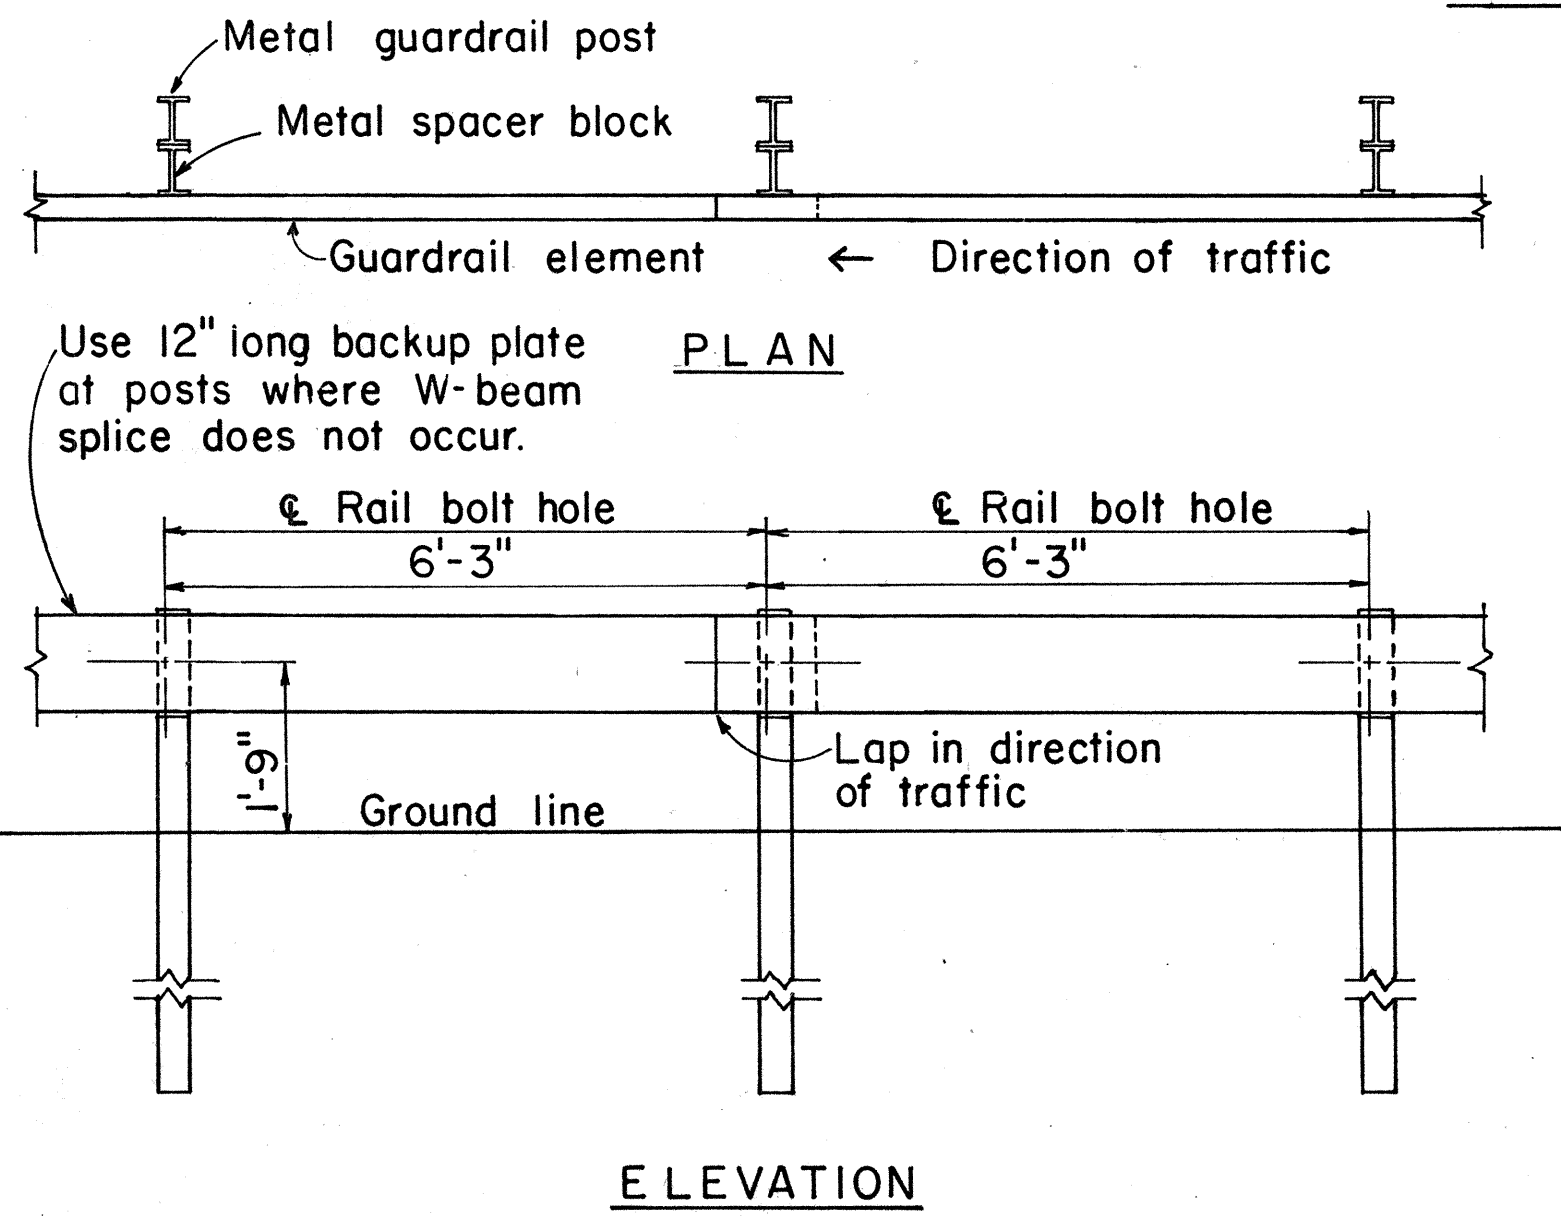

METAL GUARDRAIL ON METAL POST WITH METAL SPACER BLOCK

SCALE: $\frac{1}{2}$ " = 1'-0"

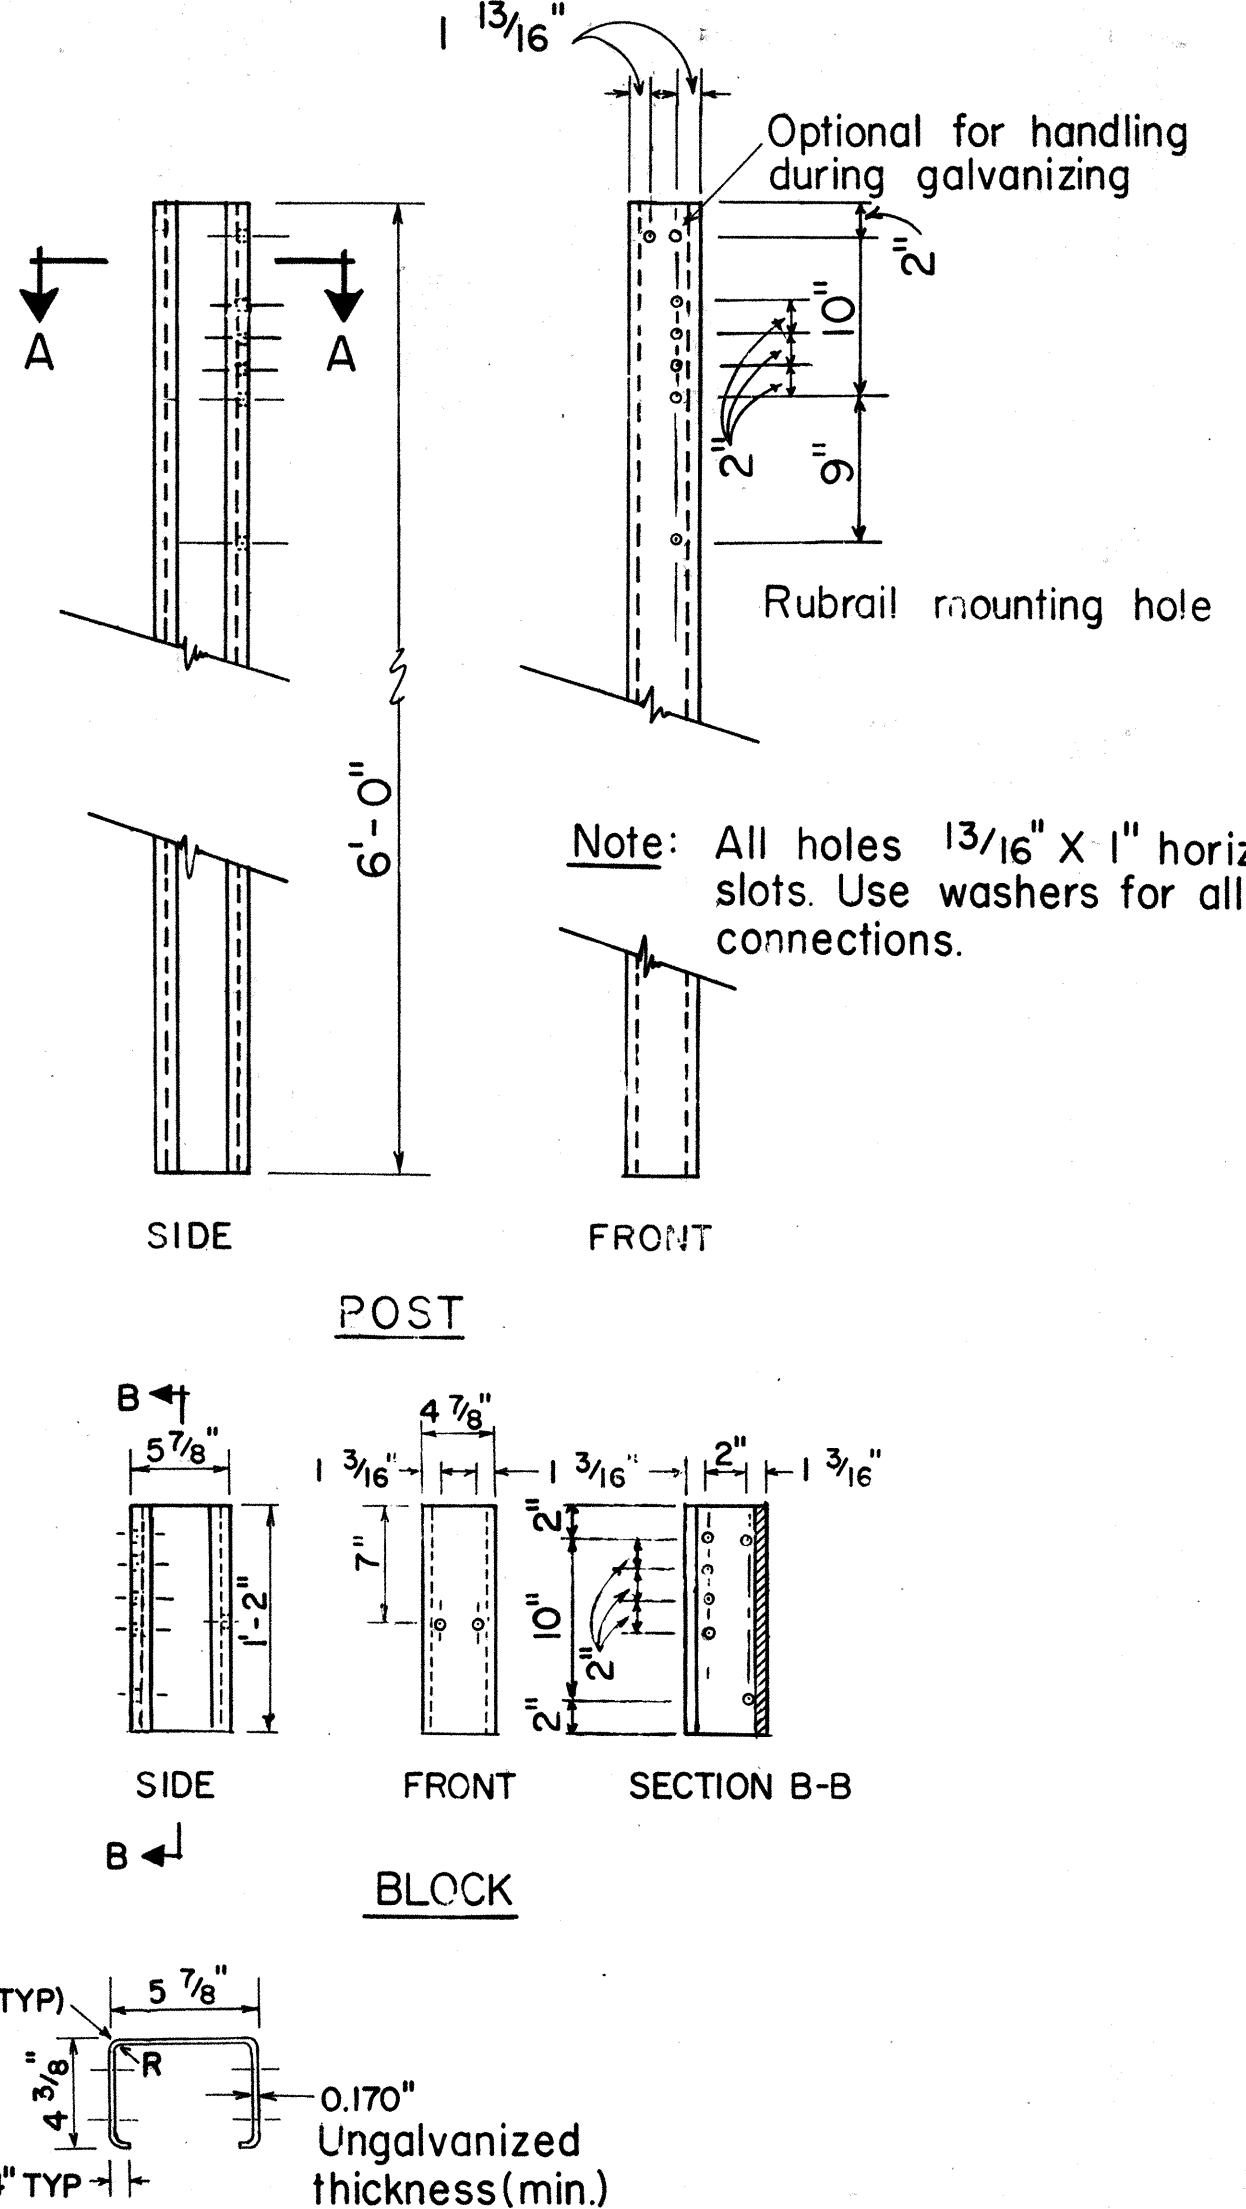


SECTION A-A

N.T.S.

BENT PLATE POST AND BLOCK

SCALE: 1" = 1'-0"

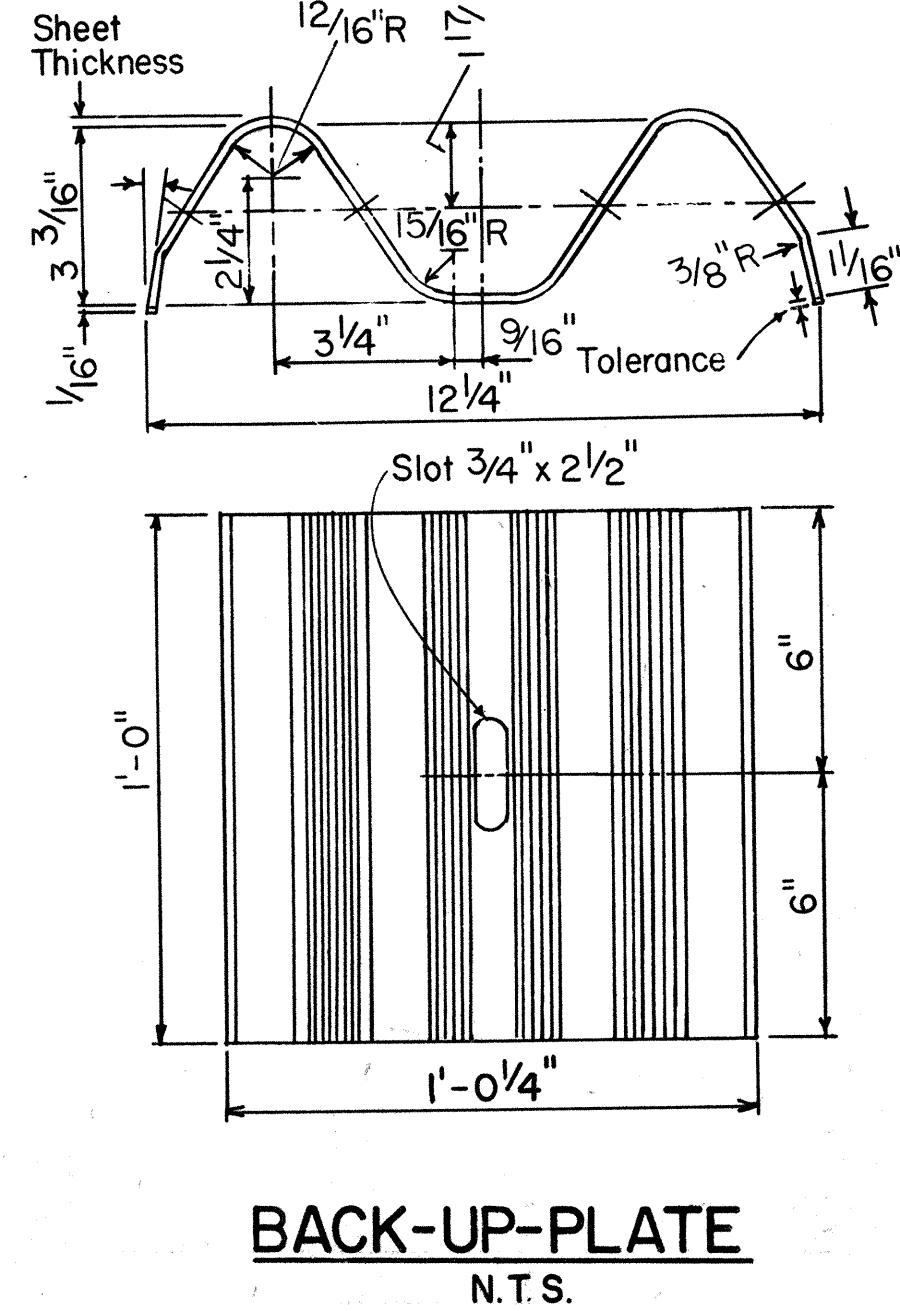

APPROVAL RECOMMENDED:

Erick Tanaka
TRAFFIC ENGINEER

9/7/82
DATE

APPROVED:

Harbert Zaleski
ASSISTANT CHIEF, ENGINEERING

9/22/82
DATE

NO.	REVISION	APPROVED BY	DATE
1	Supersedes sht. DT-500 approved 12/30/69.	H.T.	9/22/82
2	Added General Notes No. 6	J.D.	9-28-83
3	Added details for adjusting guardrail height and added Back-up Plate and washer	E.T.	9/18/85

STATE OF HAWAII
DEPARTMENT OF TRANSPORTATION
HIGHWAYS DIVISION


STANDARD DETAILS
METAL GUARDRAIL

Scale: As Shown
SHEET NO. 24 OF 14 SHEETS DT 500

July, 1982



DATE	DESIGNED BY	CHECKED BY
9/7/82	H.T.	J.D.
9/22/82	H.T.	J.D.
9/18/85	H.T.	J.D.

FED. ROAD DIST. NO.	STATE	FED. AID PROJ. NO.	FISCAL YEAR	SHEET NO.	TOTAL SHEETS
HAWAII	HAW.	IR-HI-1 (193)	1986	25	62

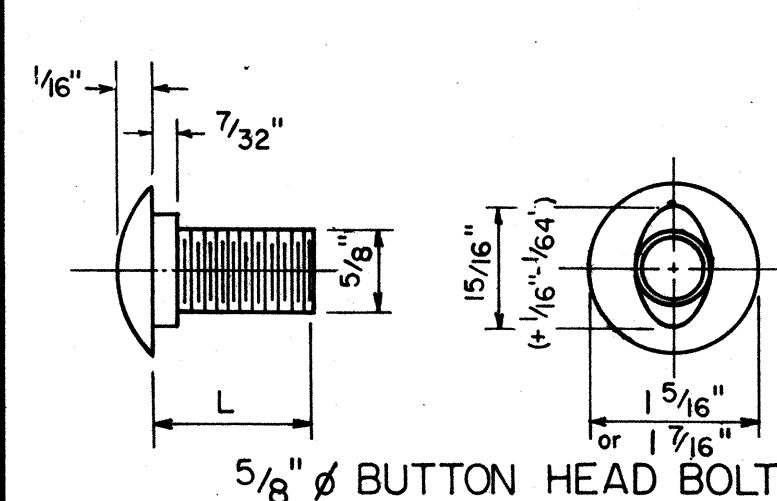


L	Thread Length	Intended Use
1 1/4"	Full length thread	Splice rail elements
2"	1/2" min. thread len.	Fasten rails to posts


5/8" BUTTON HEAD BOLT
AND RECESS NUT
Scale: NTS

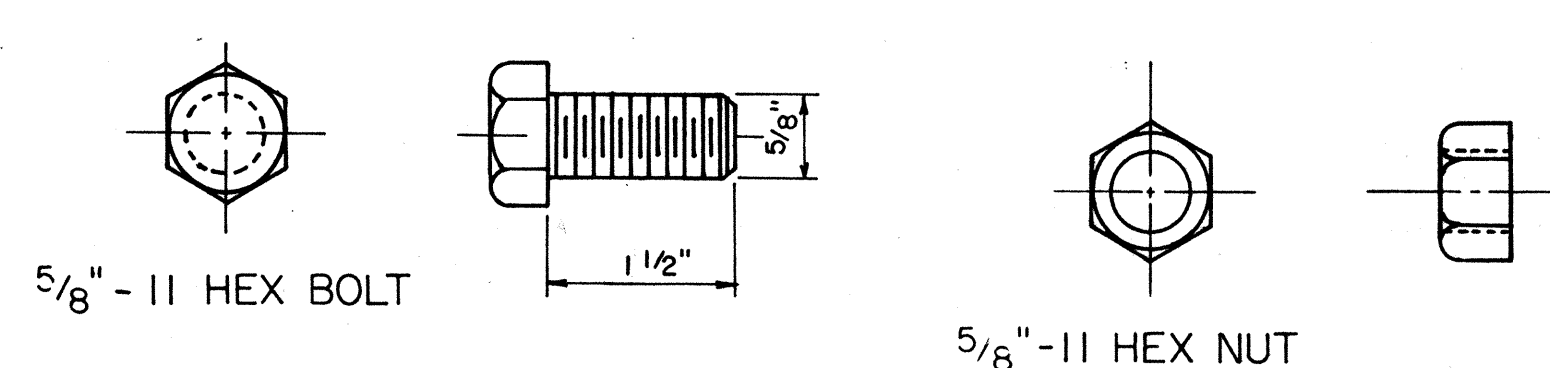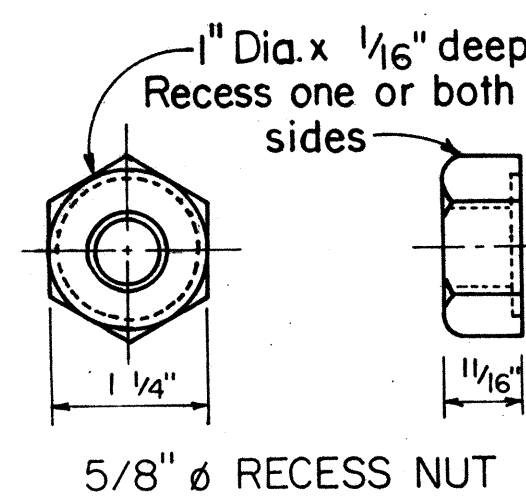


5/8" HEX POST BOLT AND NUT
Scale: N.T.S.

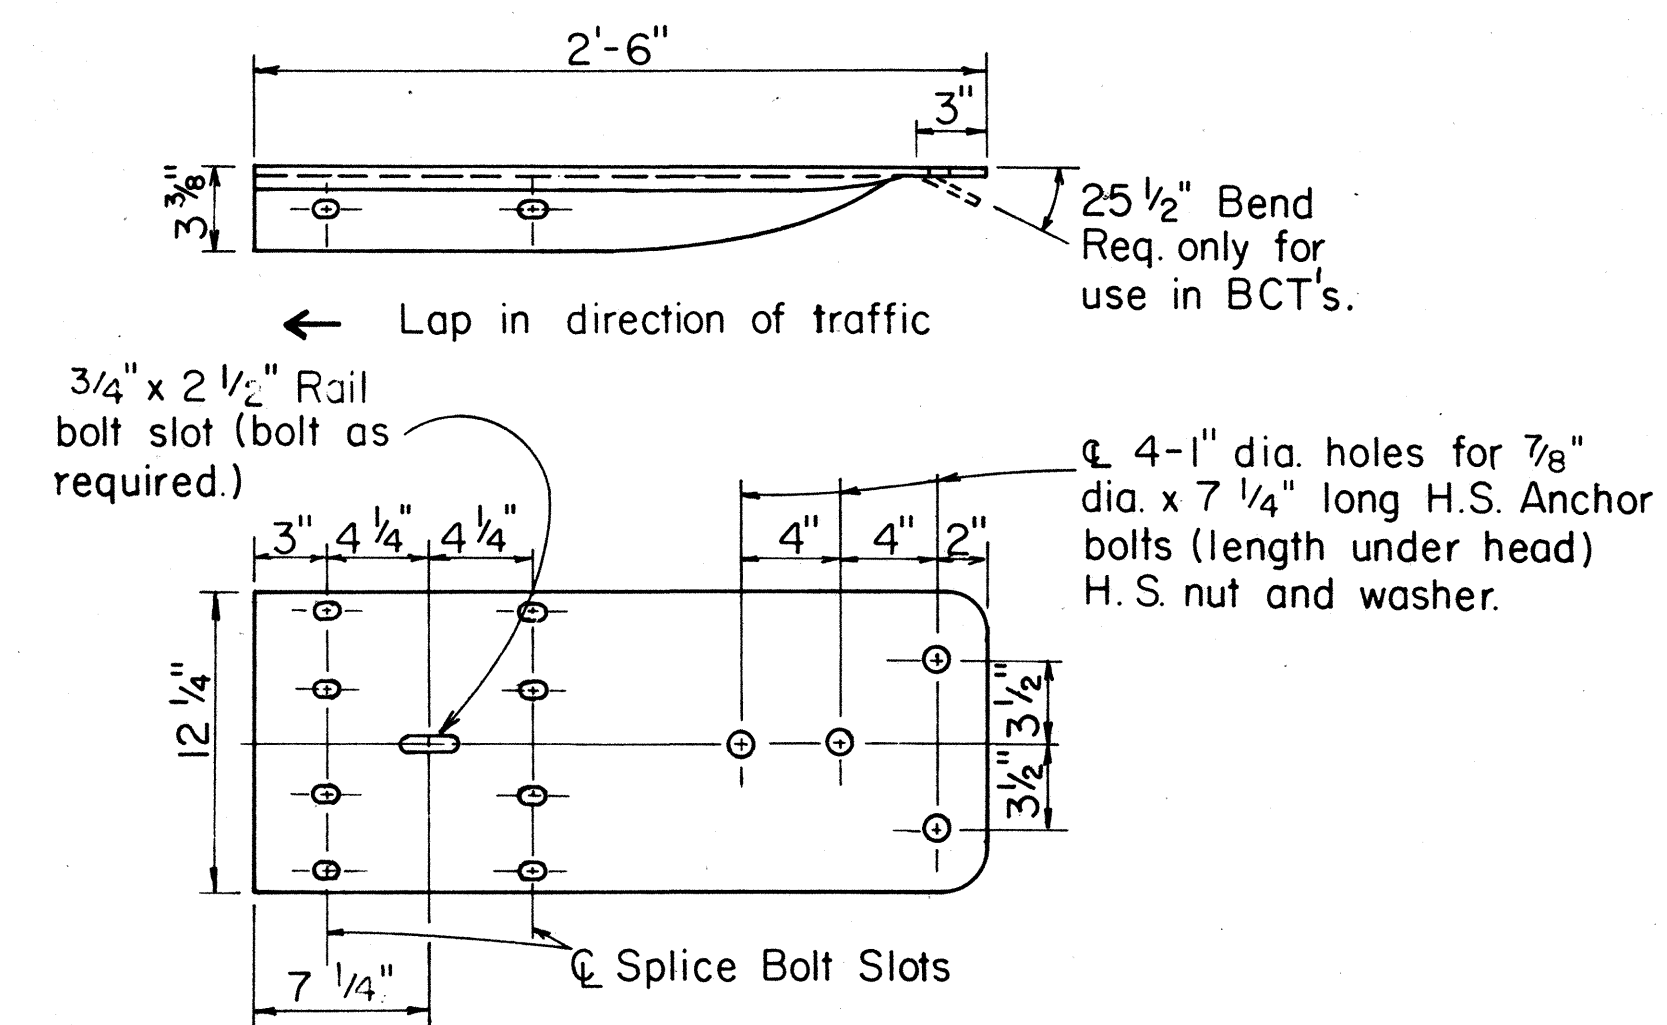


W BEAM TERMINAL CONNECTOR
Scale: $1/2" = 1'-0"$

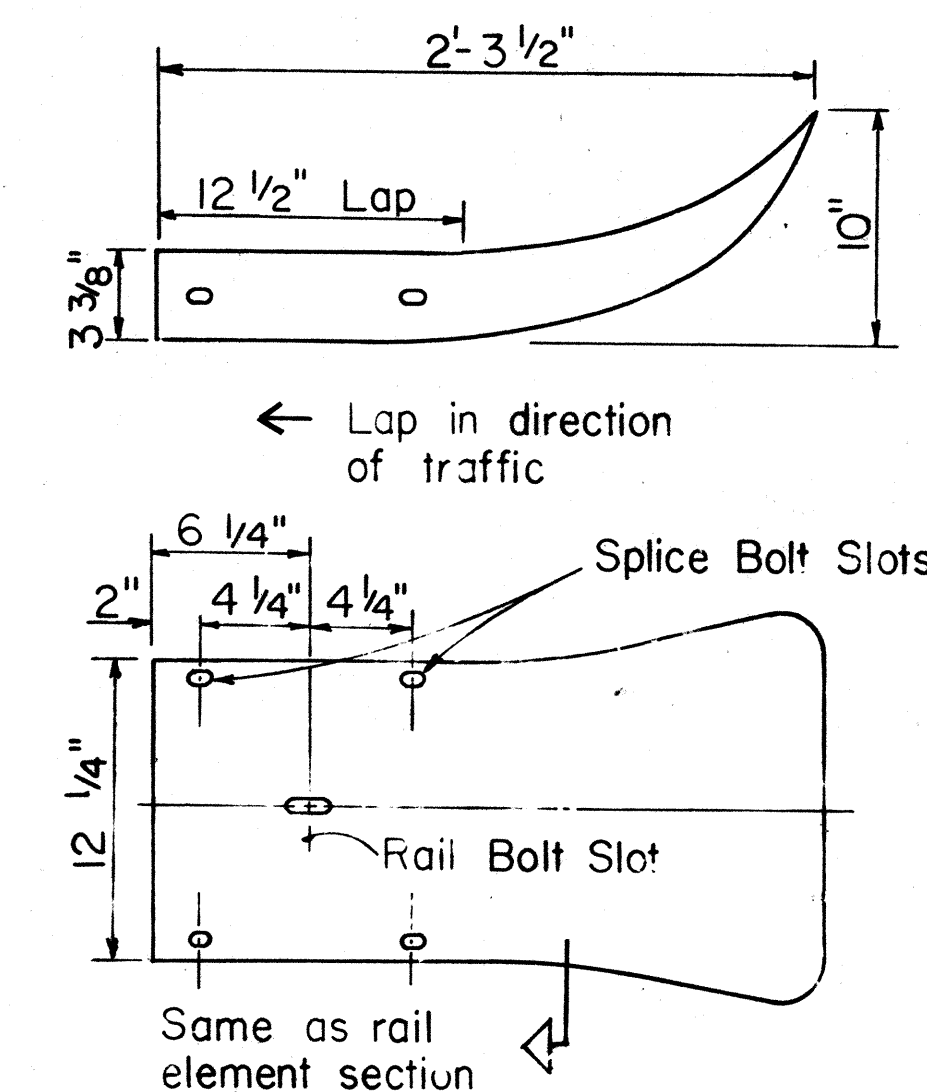


W BEAM END SECTION (FLARED)
Scale: $1\frac{1}{2}" = 1' - 0"$

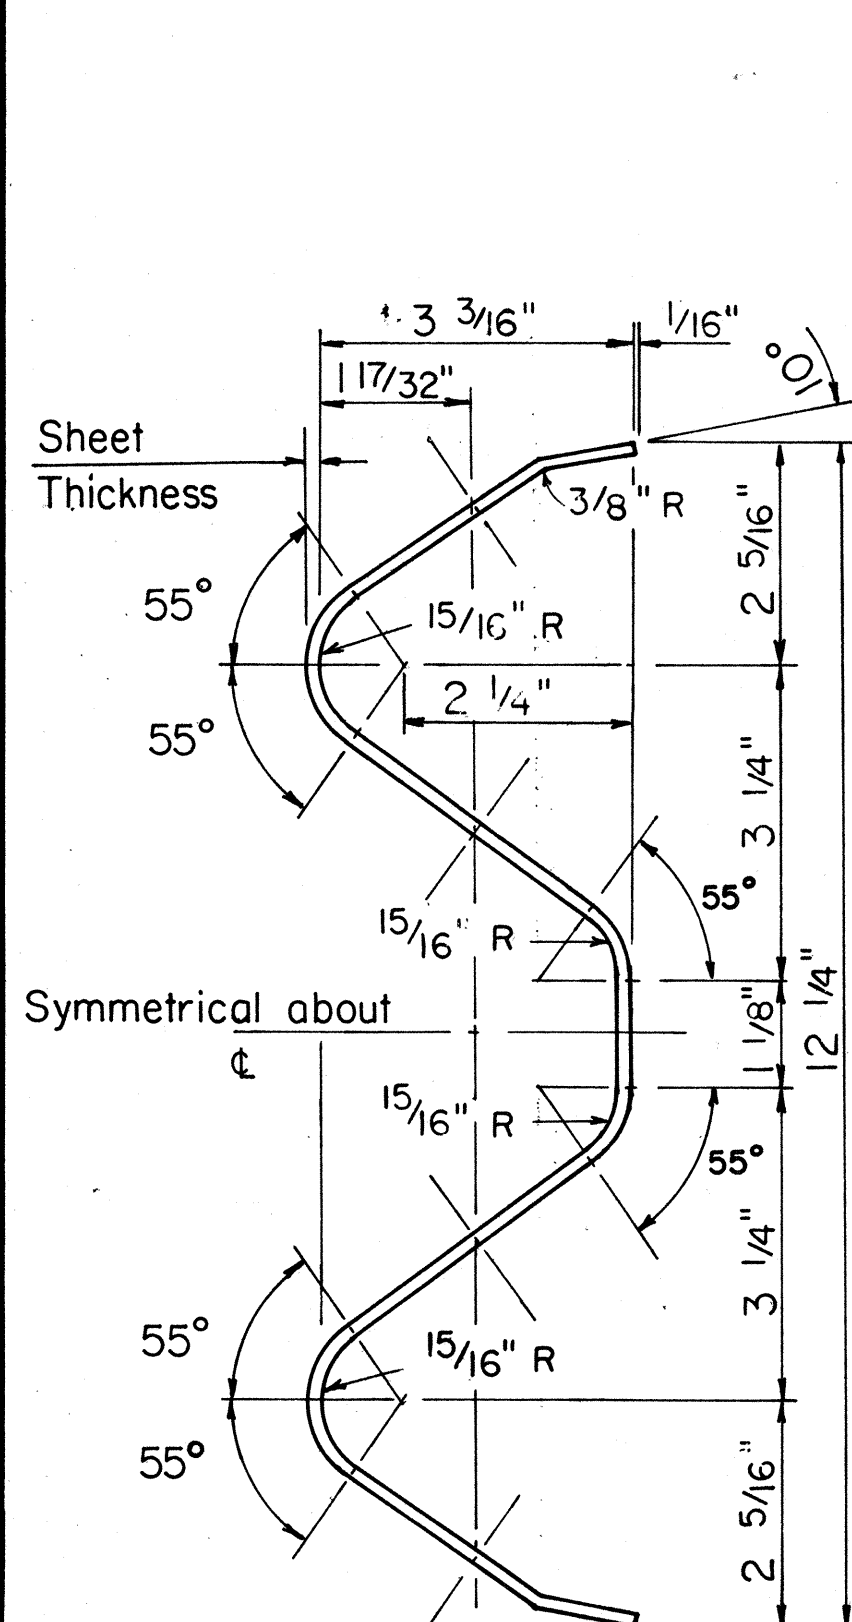


RAIL ELEMENT SECTION
Scale: 6" = 1'-0"

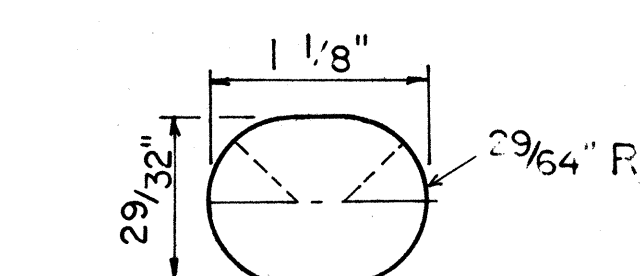


SPLICE BOLT SLOT

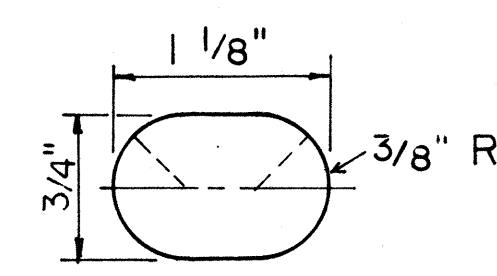


SPLICE BOLT SLOT
FOR ALL ENDS

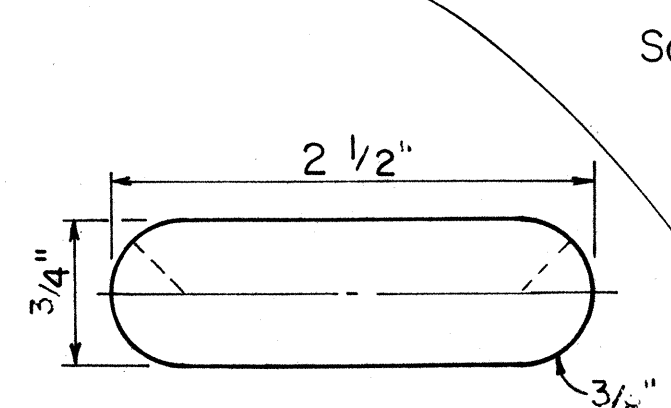



RAIL BOLT SLOT

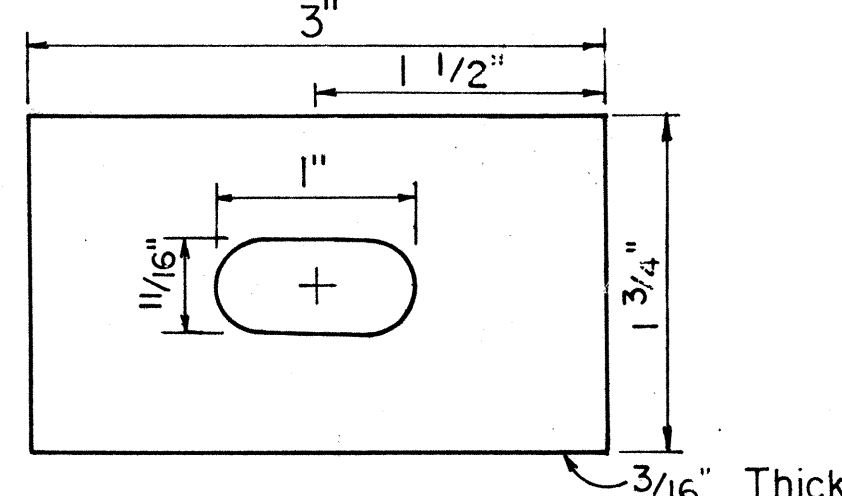

RAIL BOLT WASHER

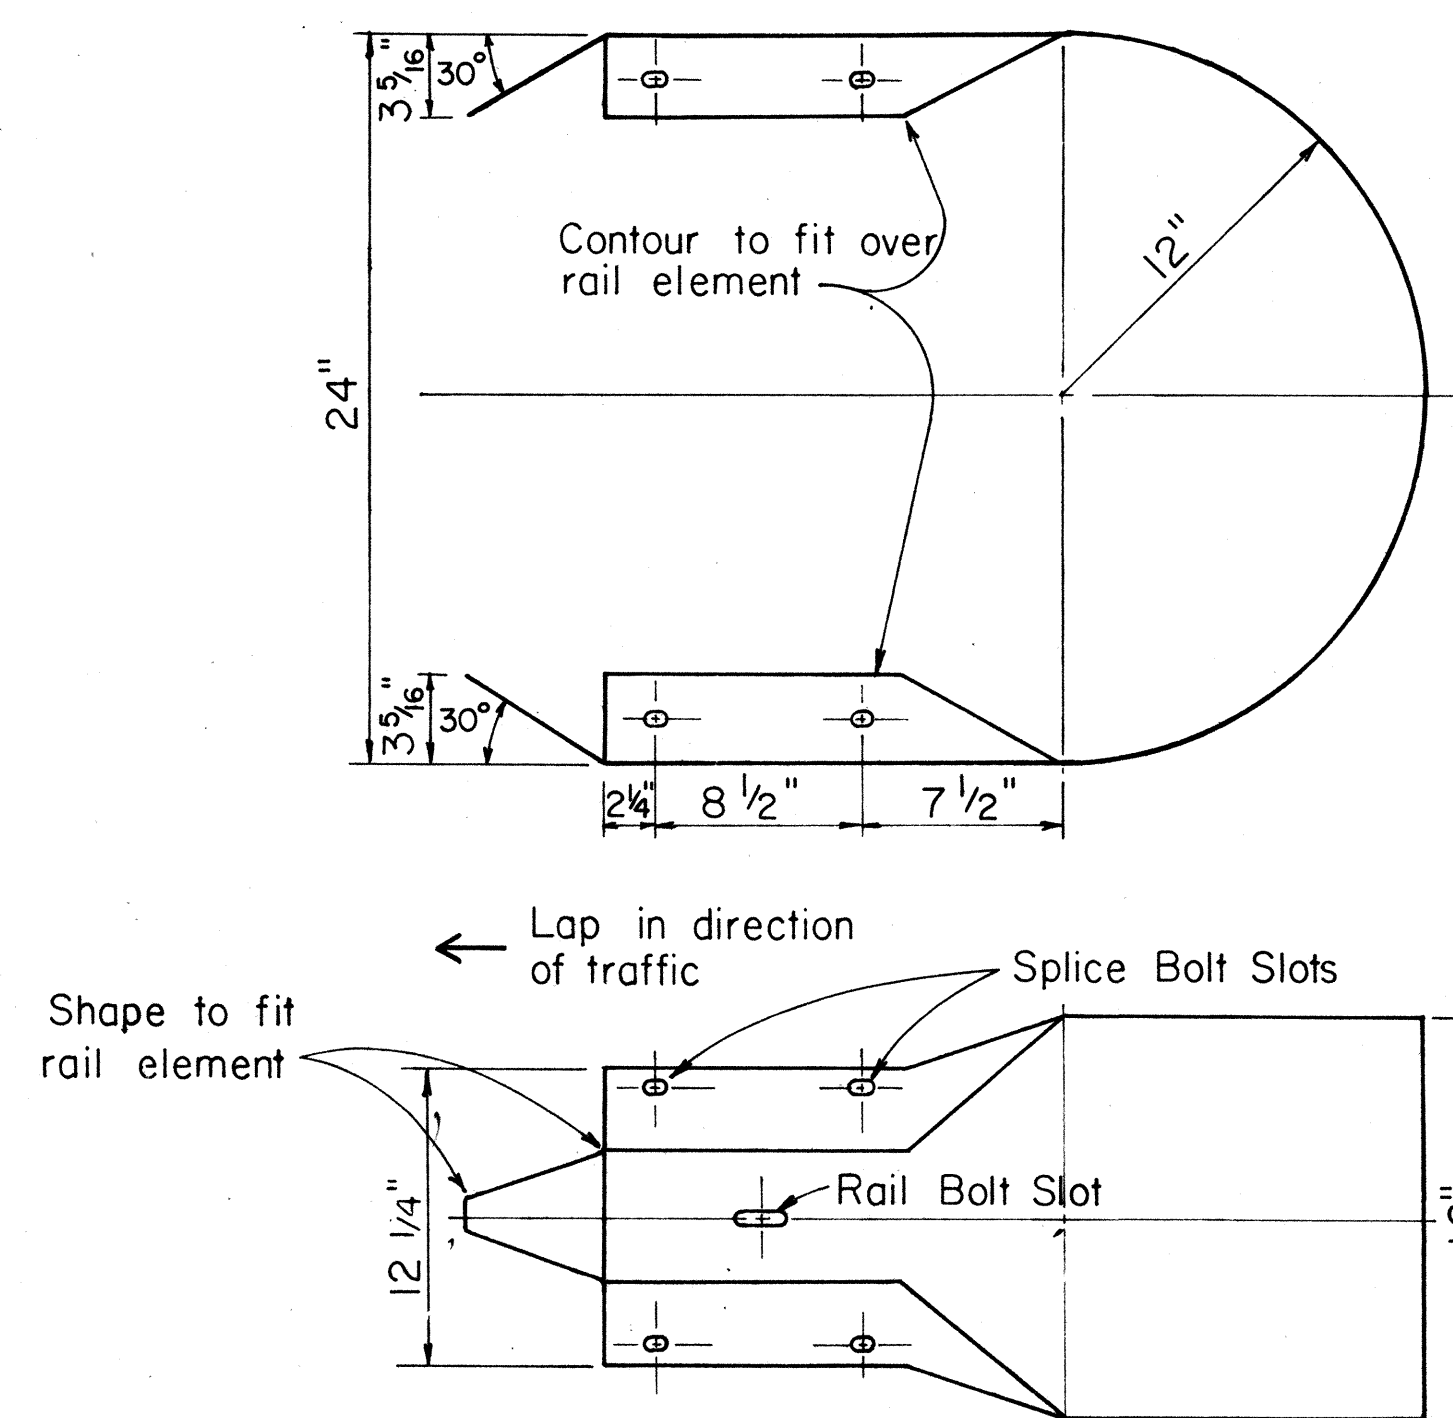

W BEAM END SECTION (BUFFER)
Scale: 1 1/2" = 1'-0"

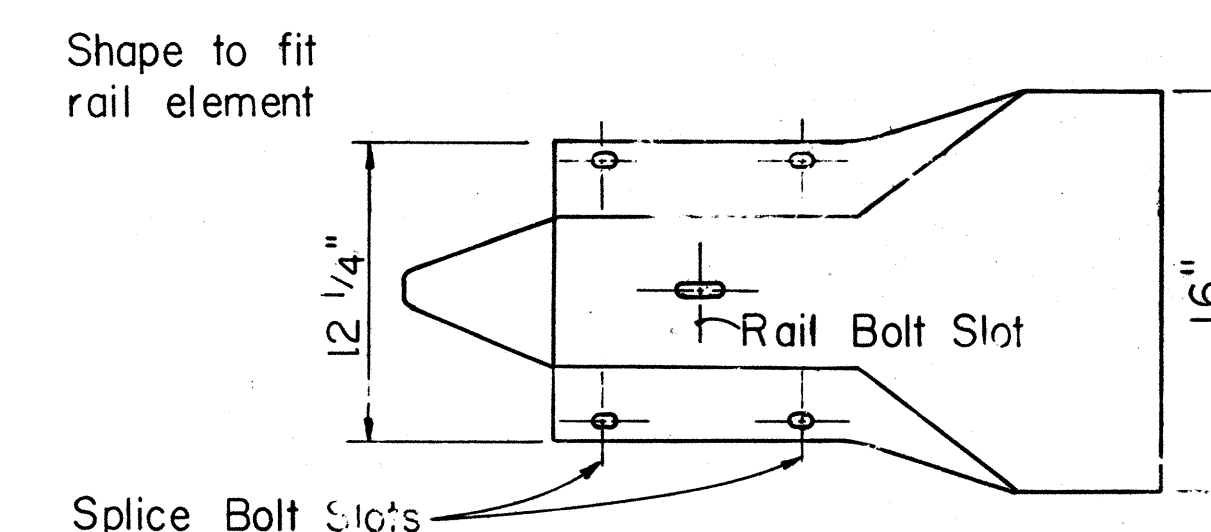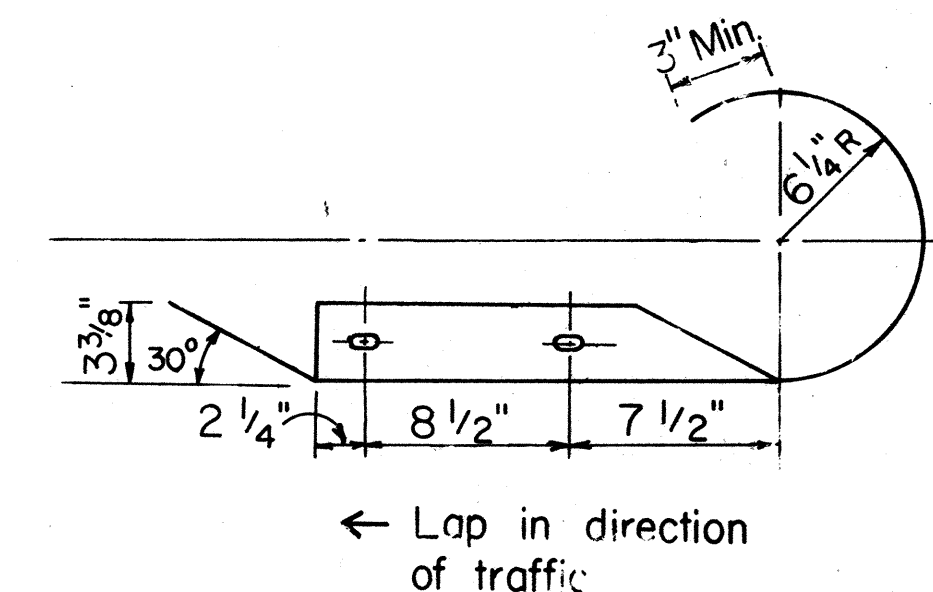

W BEAM END SECTION (ROUNDED)
Scale: $1 \frac{1}{2}" = 1' - 0"$

APPROVAL RECOMMENDED:
Eishi Tanaka
TRAFFIC ENGINEER

9/20/82
DATE

APPROVED:
Herbert Zalsch
ASSISTANT CHIEF, ENGINEERING

9/22/82
DATE

NO.	REVISION	APPROVED BY	DATE
1	Supersedes sht. DT 501 approved 12/30/69	H.F.	1/22/70


STATE OF HAWAII
DEPARTMENT OF TRANSPORTATION
HIGHWAYS DIVISION

STANDARD DETAILS


METAL GUARDRAIL

Scale: As Noted July, 1982
SHEET No. 10B OF 14 SHEETS DT 50


FED. ROAD DIST. NO.	STATE	FED. AID PROJ. NO.	FISCAL YEAR	SHEET NO.	TOTAL SHEETS
HAWAII	HAW.	IR-HI-1(103)	1986	26	62

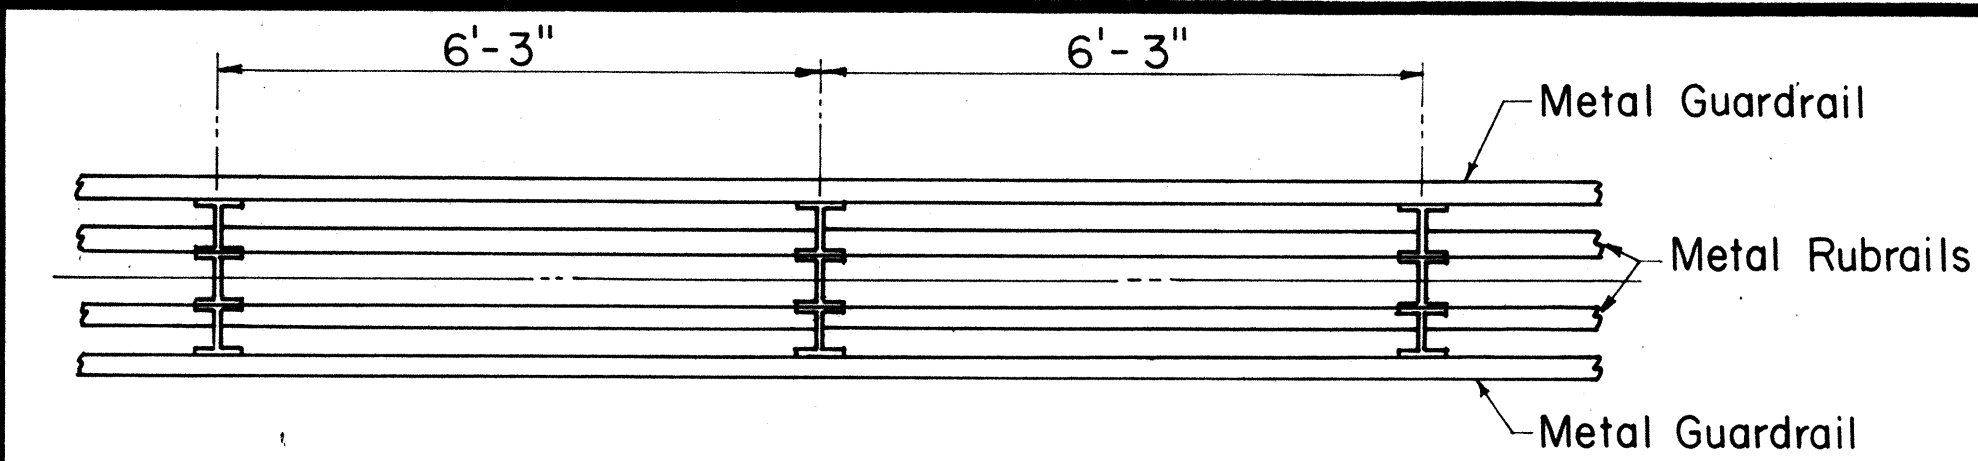

PLAN

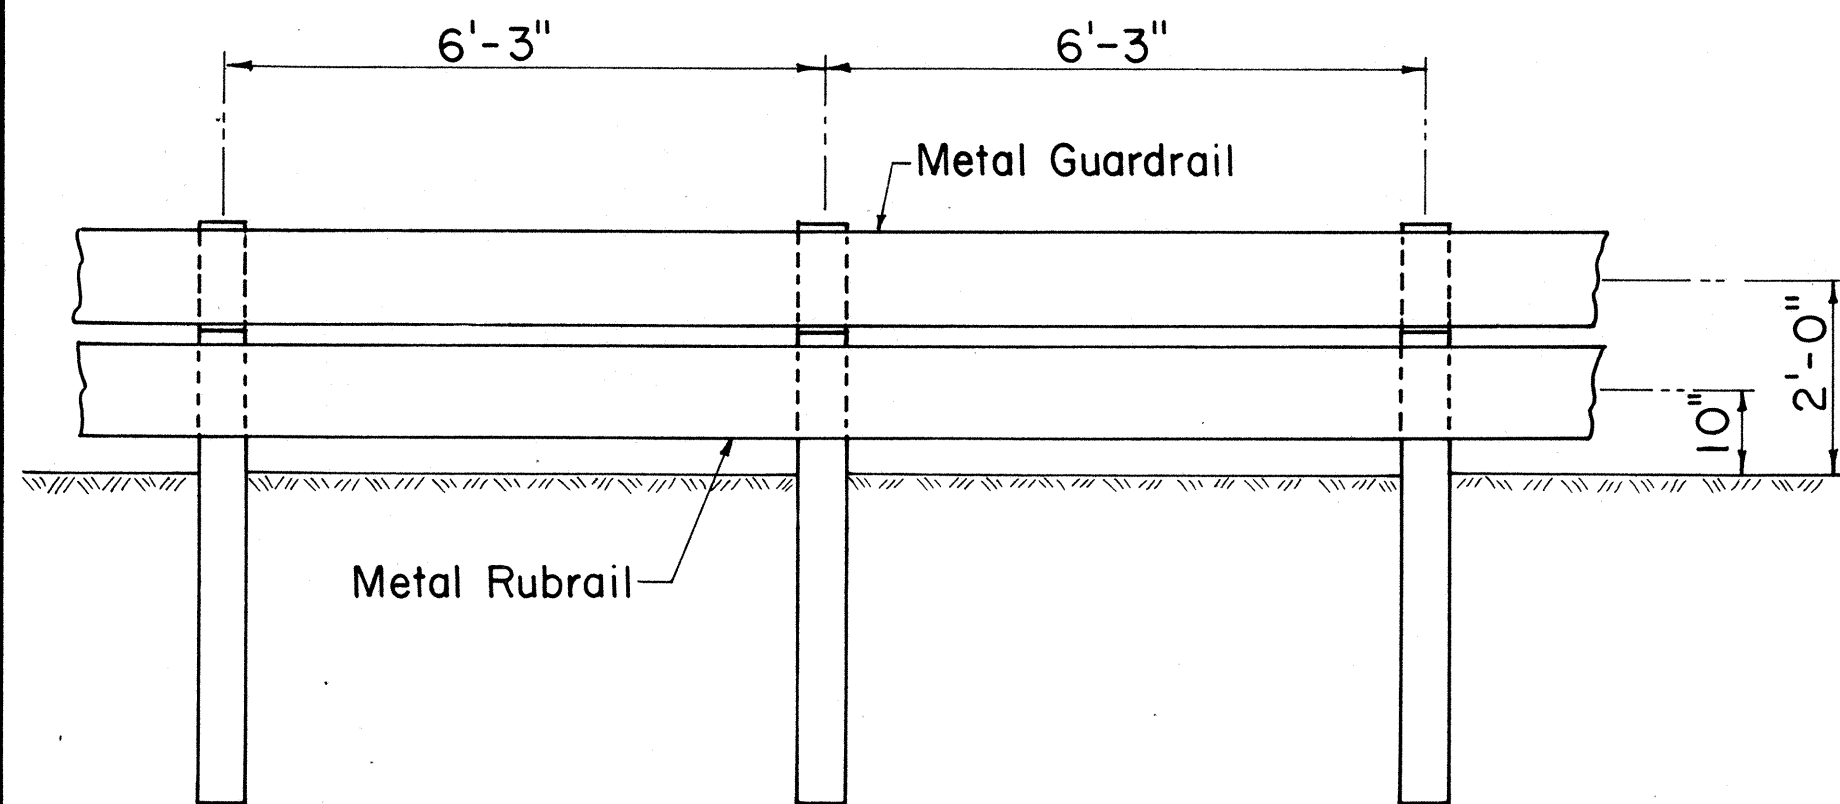


ELEVATION

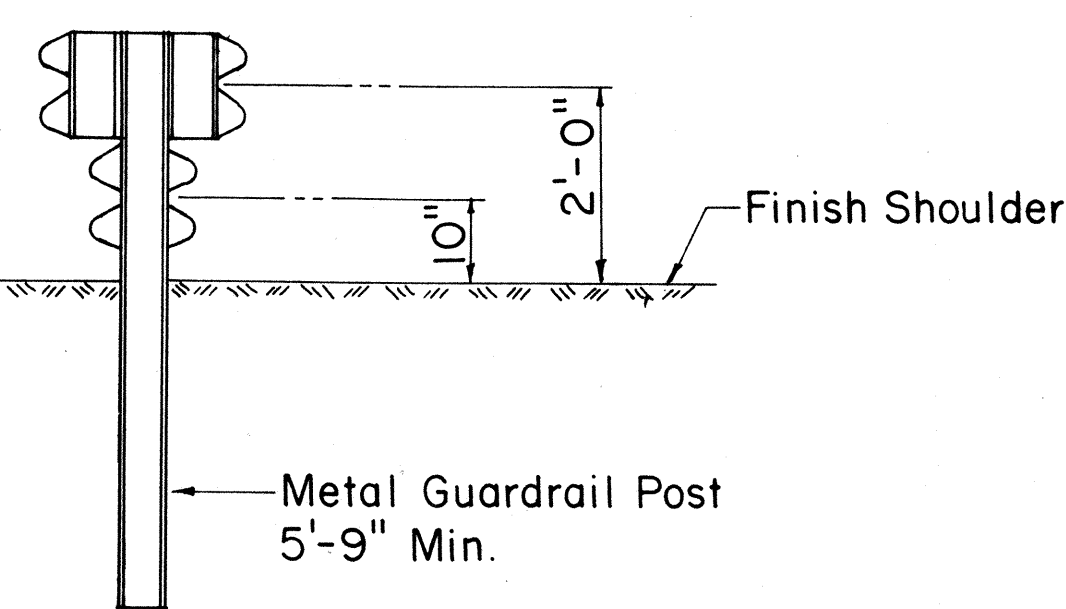


SECTION


TYPICAL MEDIAN BARRIER INSTALLATION

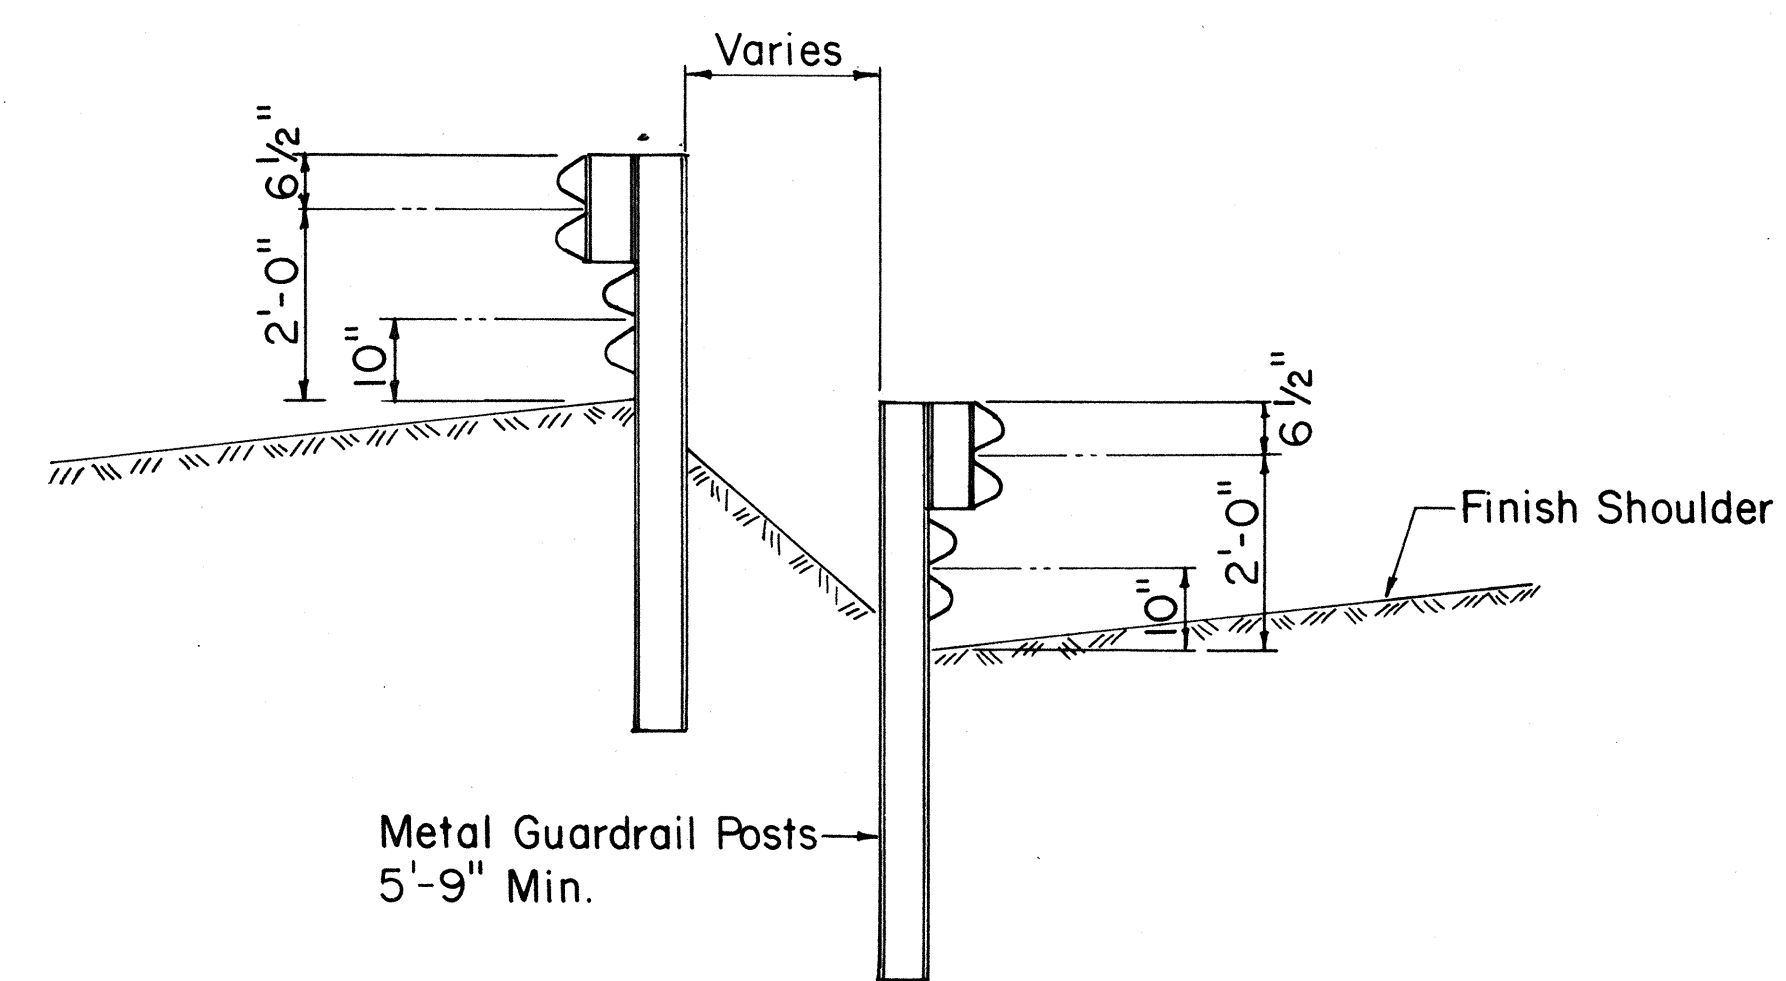


TYPICAL DOUBLE POST SECTION

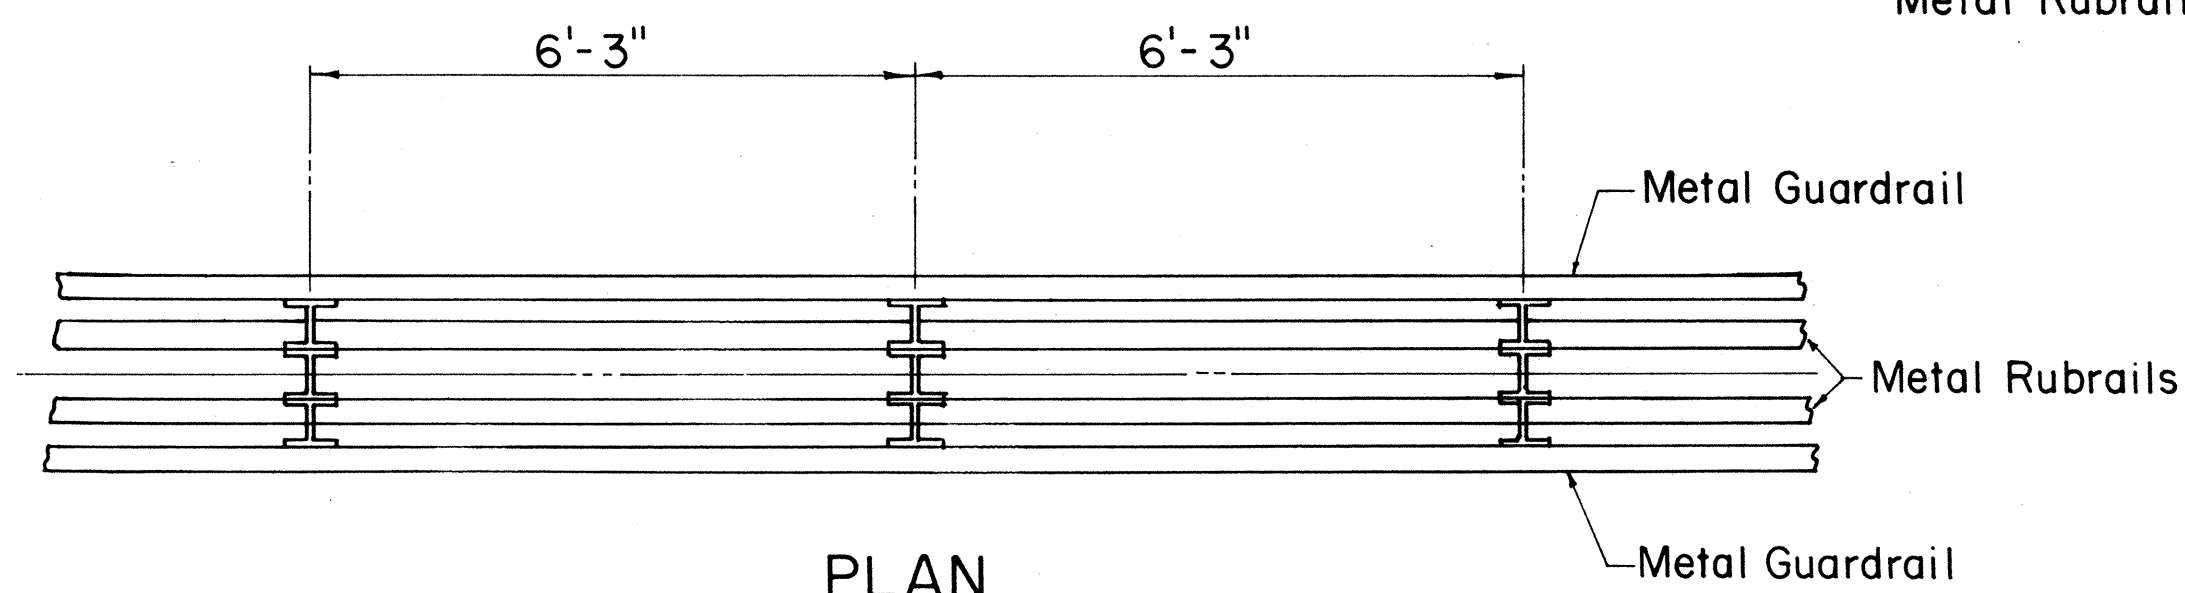

PLAN

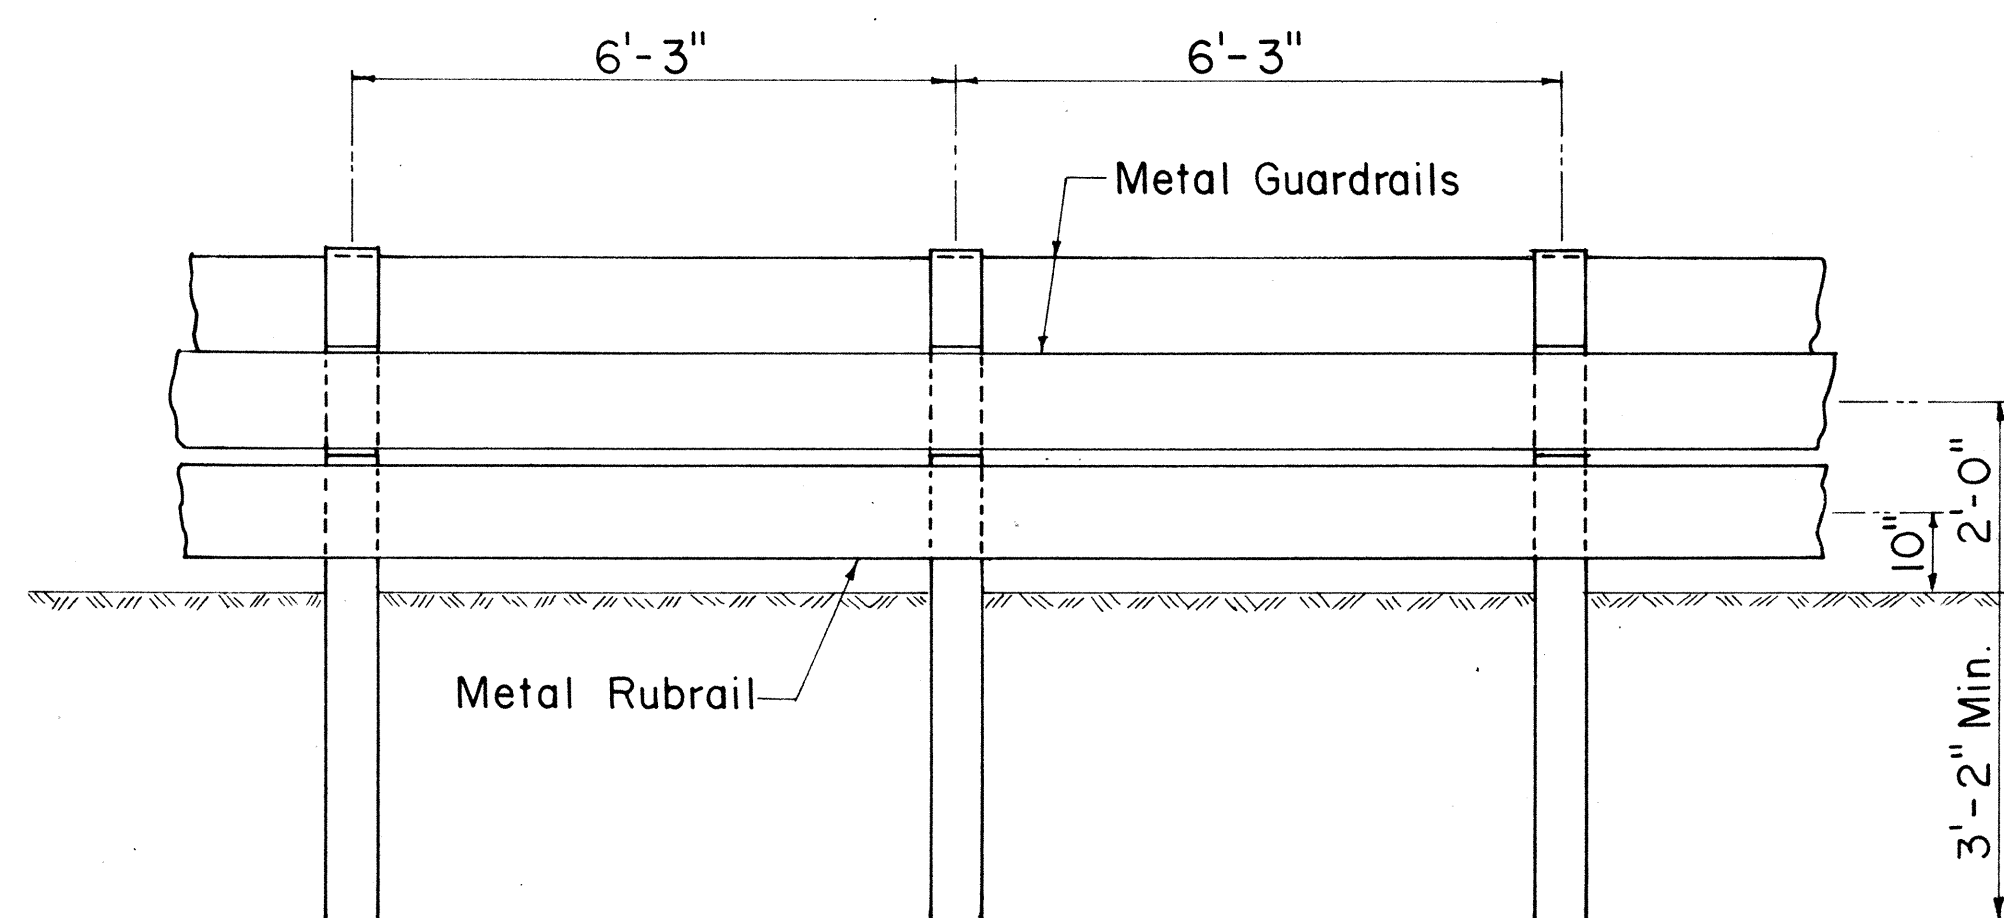


ELEVATION

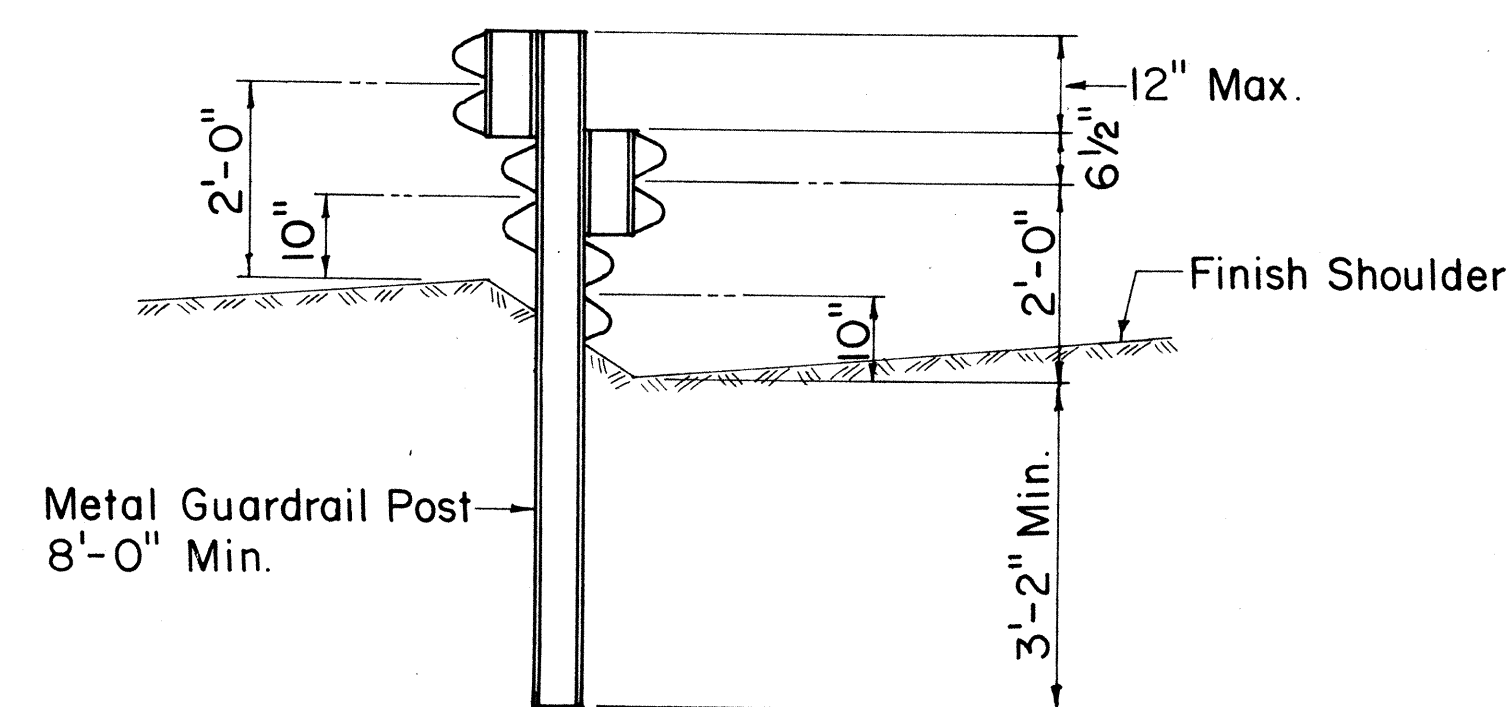


SECTION


TYPICAL SAW TOOTH INSTALLATION

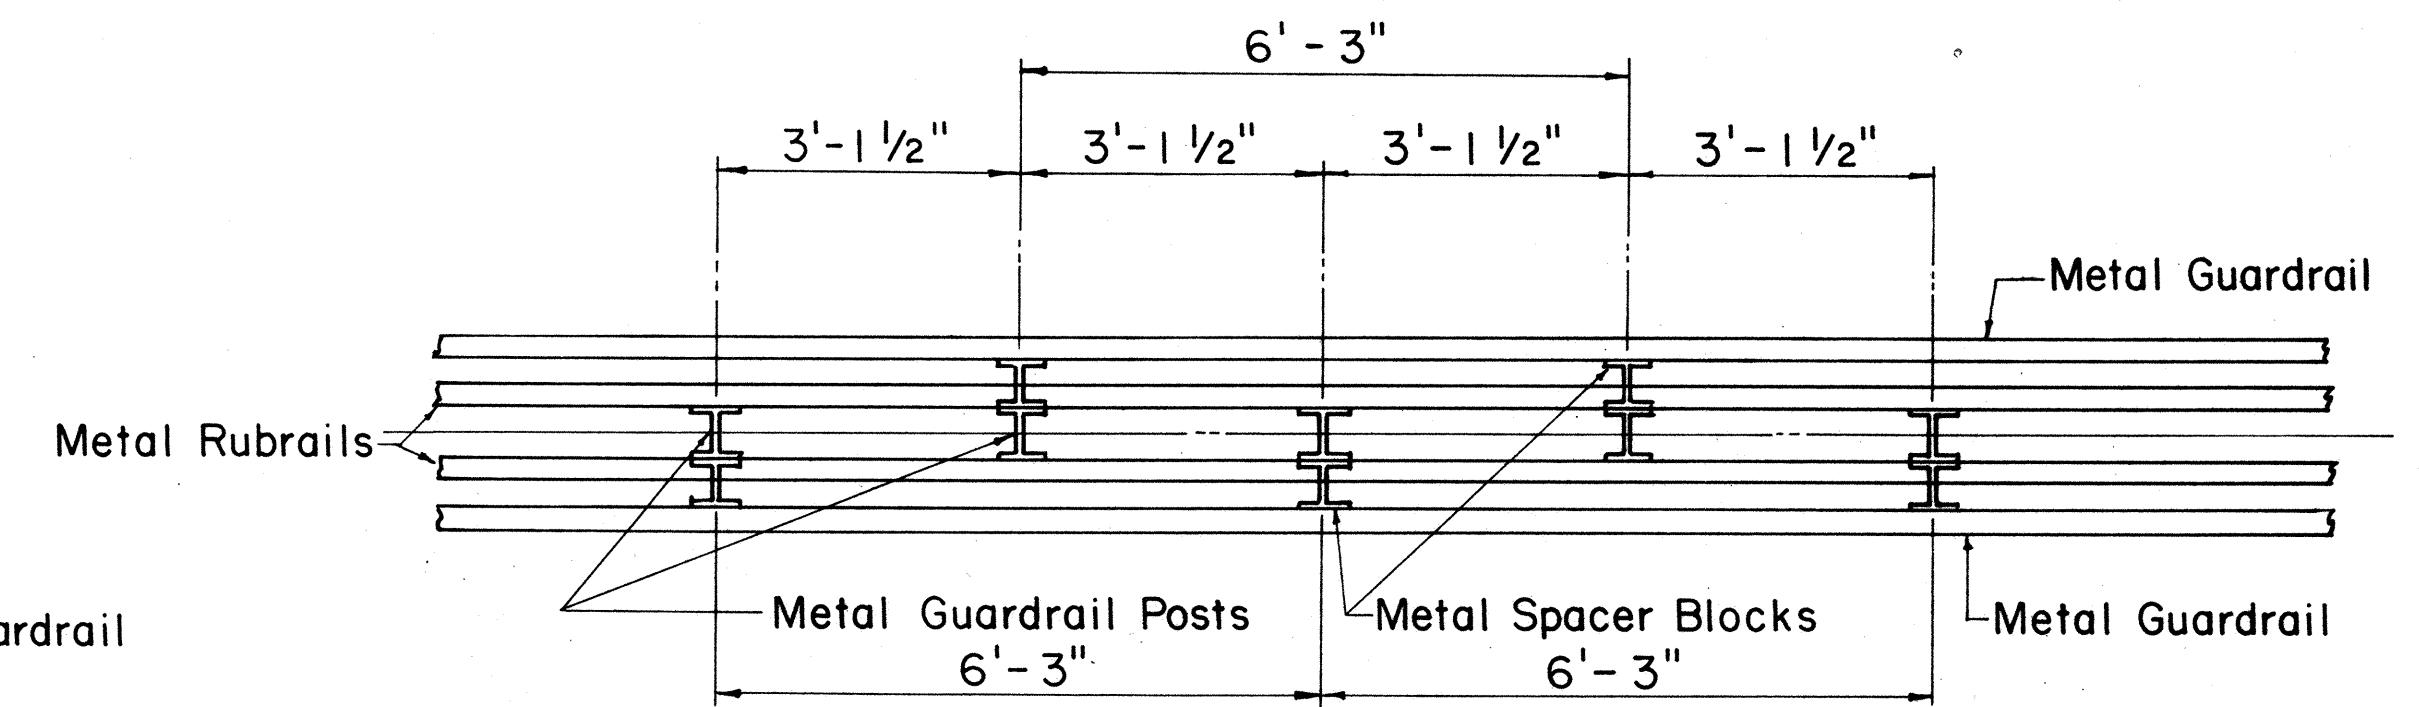

PLAN

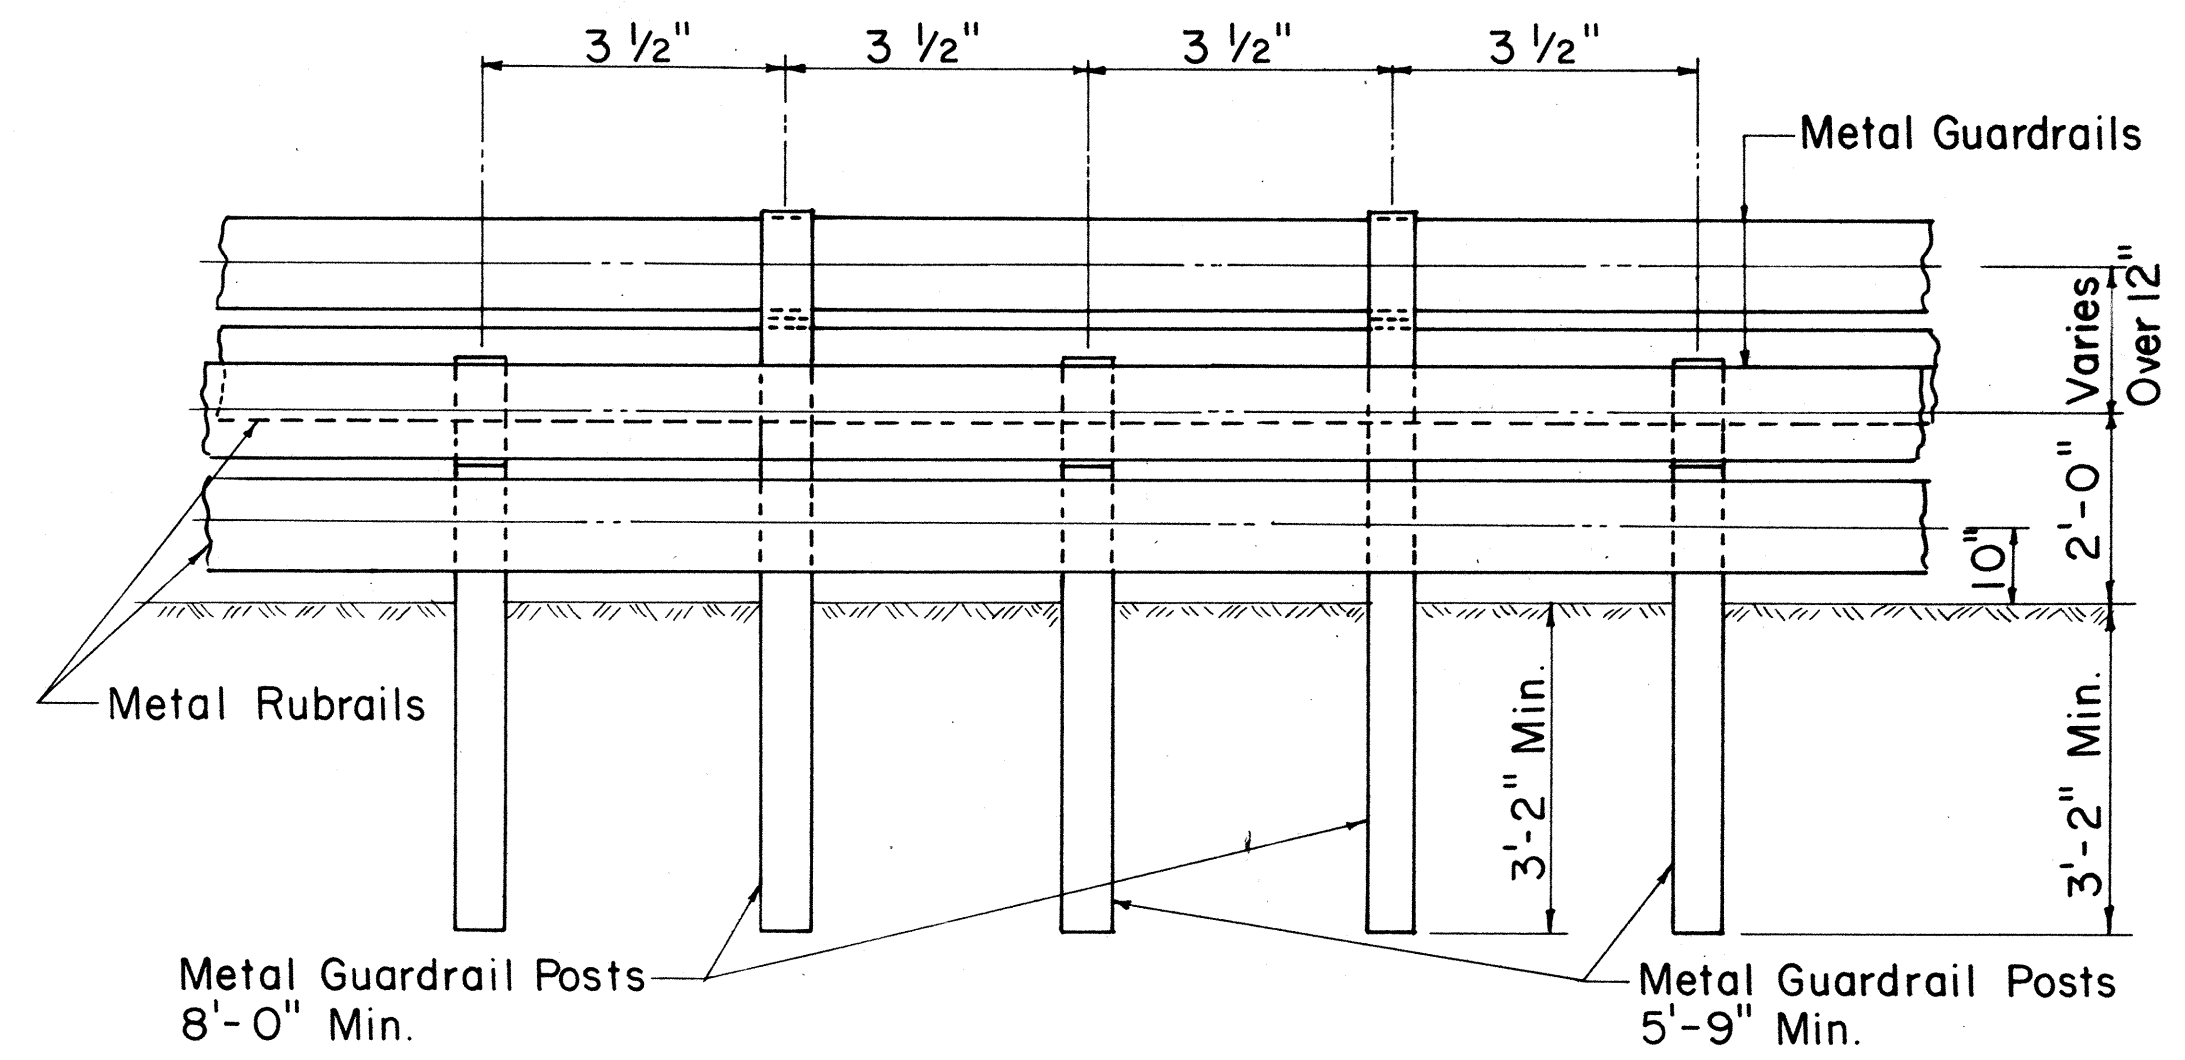

ELEVATION

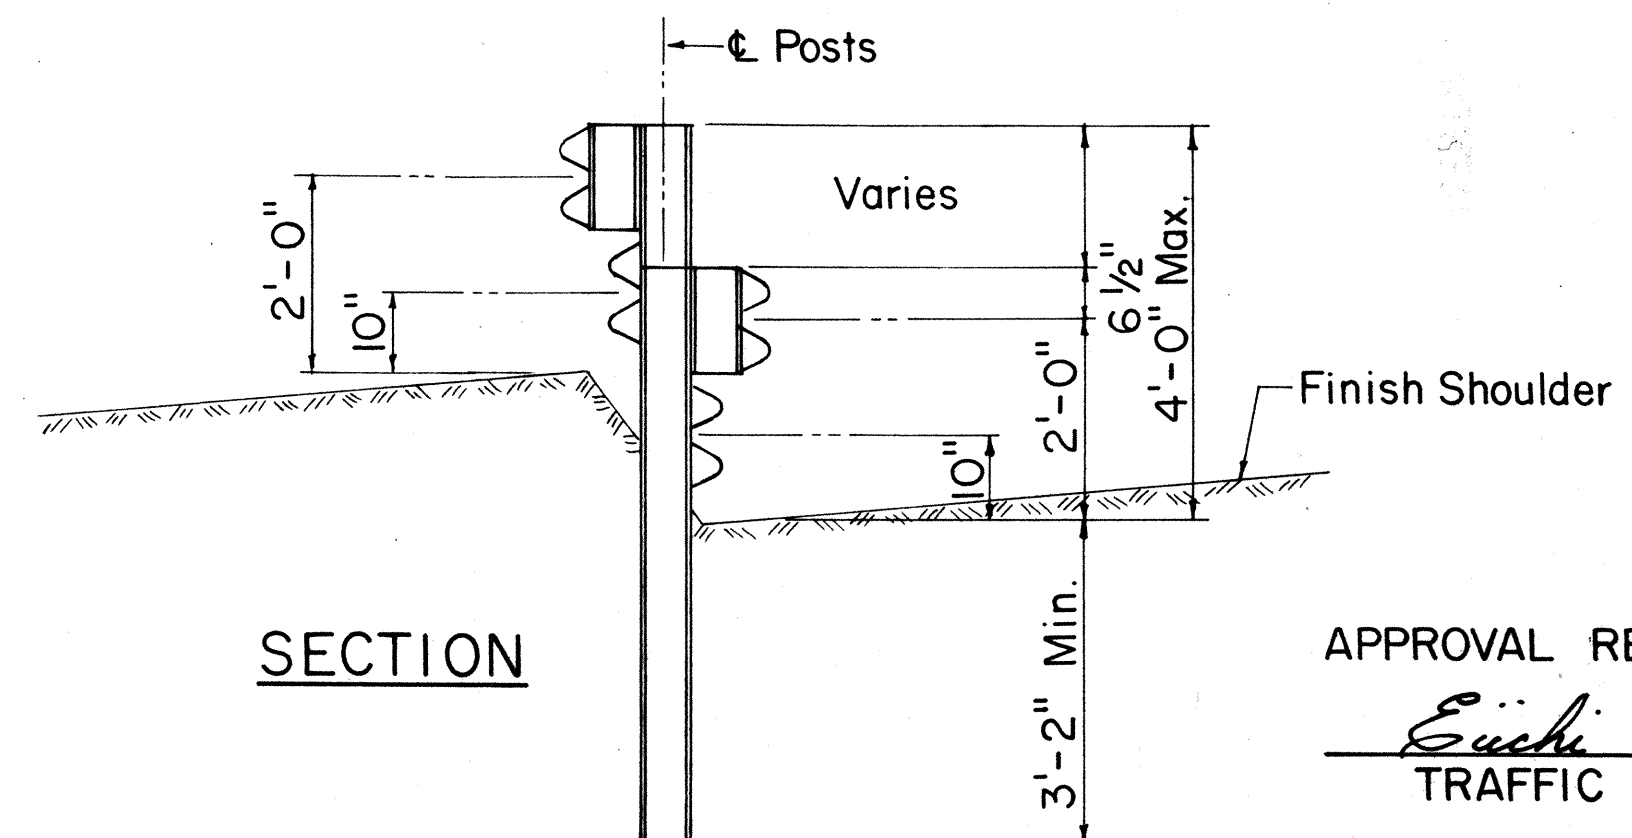

SECTION

TYPICAL STAGGERED INSTALLATION

NO.	REVISION	APPROVED BY	DATE
1	Supersedes DT 514 Approved 12/30/69	<i>[Signature]</i>	1-31-83

APPROVAL RECOMMENDED:
Euchi Tanaka
 TRAFFIC ENGINEER
 DATE 1/28/83

APPROVED:
[Signature]
 ASSISTANT CHIEF, ENGINEERING
 DATE 1-31-83

STATE OF HAWAII
 DEPARTMENT OF TRANSPORTATION
 HIGHWAYS DIVISION








STANDARD DETAILS
METAL GUARDRAIL
WITH RUBRAIL

Scale: 1/2" = 1'-0" October 1982
 SHEET NO. 11B OF 14 SHEETS DT 514

FED. ROAD DIST. NO.	STATE	FED. AID PROJ. NO.	FISCAL YEAR	SHEET NO.	TOTAL SHEETS
HAWAII	HAW.	12-41-1(193)	1987	022651	62

NOTE:

1. Metal guard rail connection to structures requires End Post Connection. See structure plans.
2. For detail of Breakaway Cable Terminal (BCT) See Sheet No. DT 519

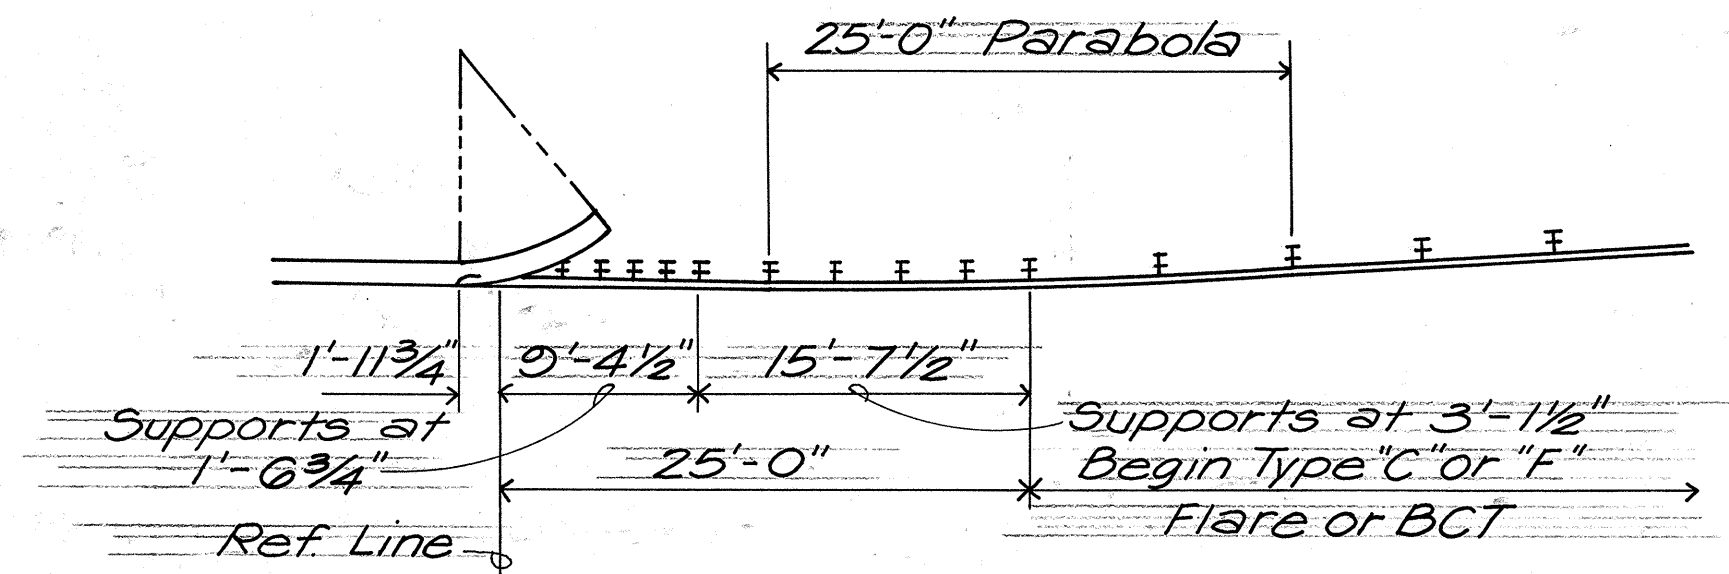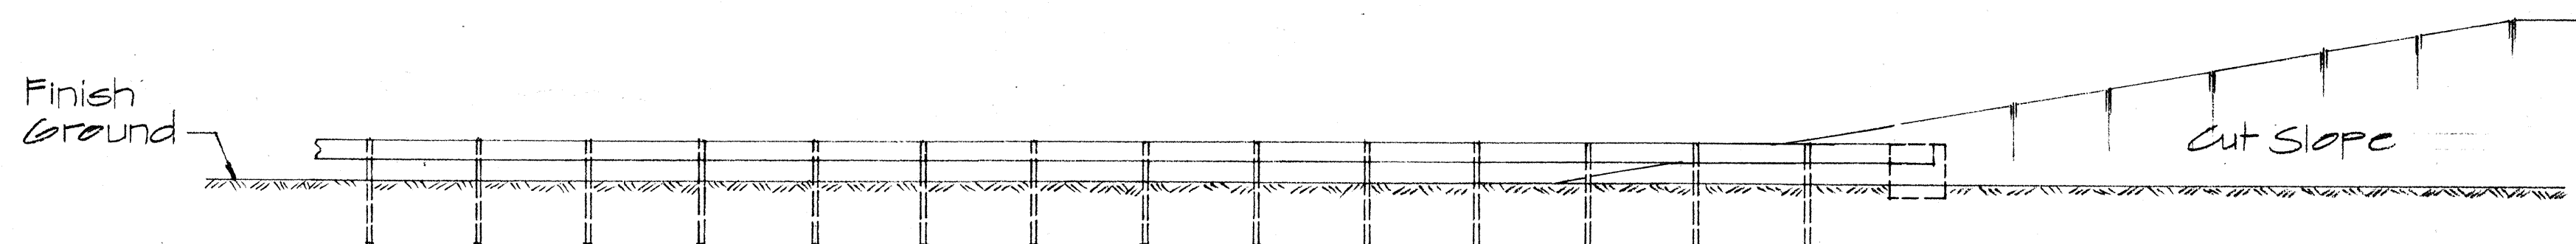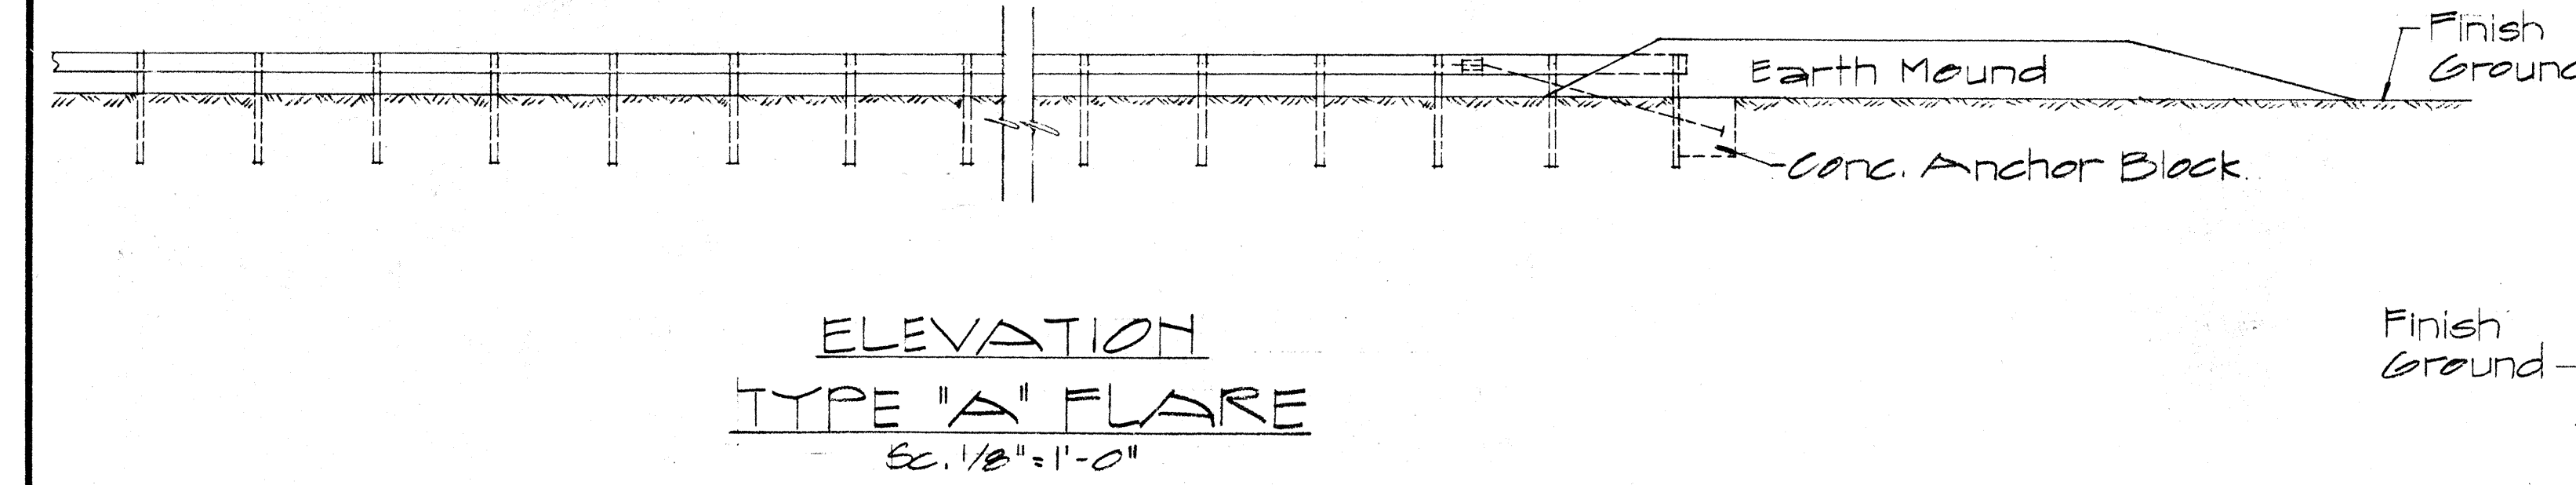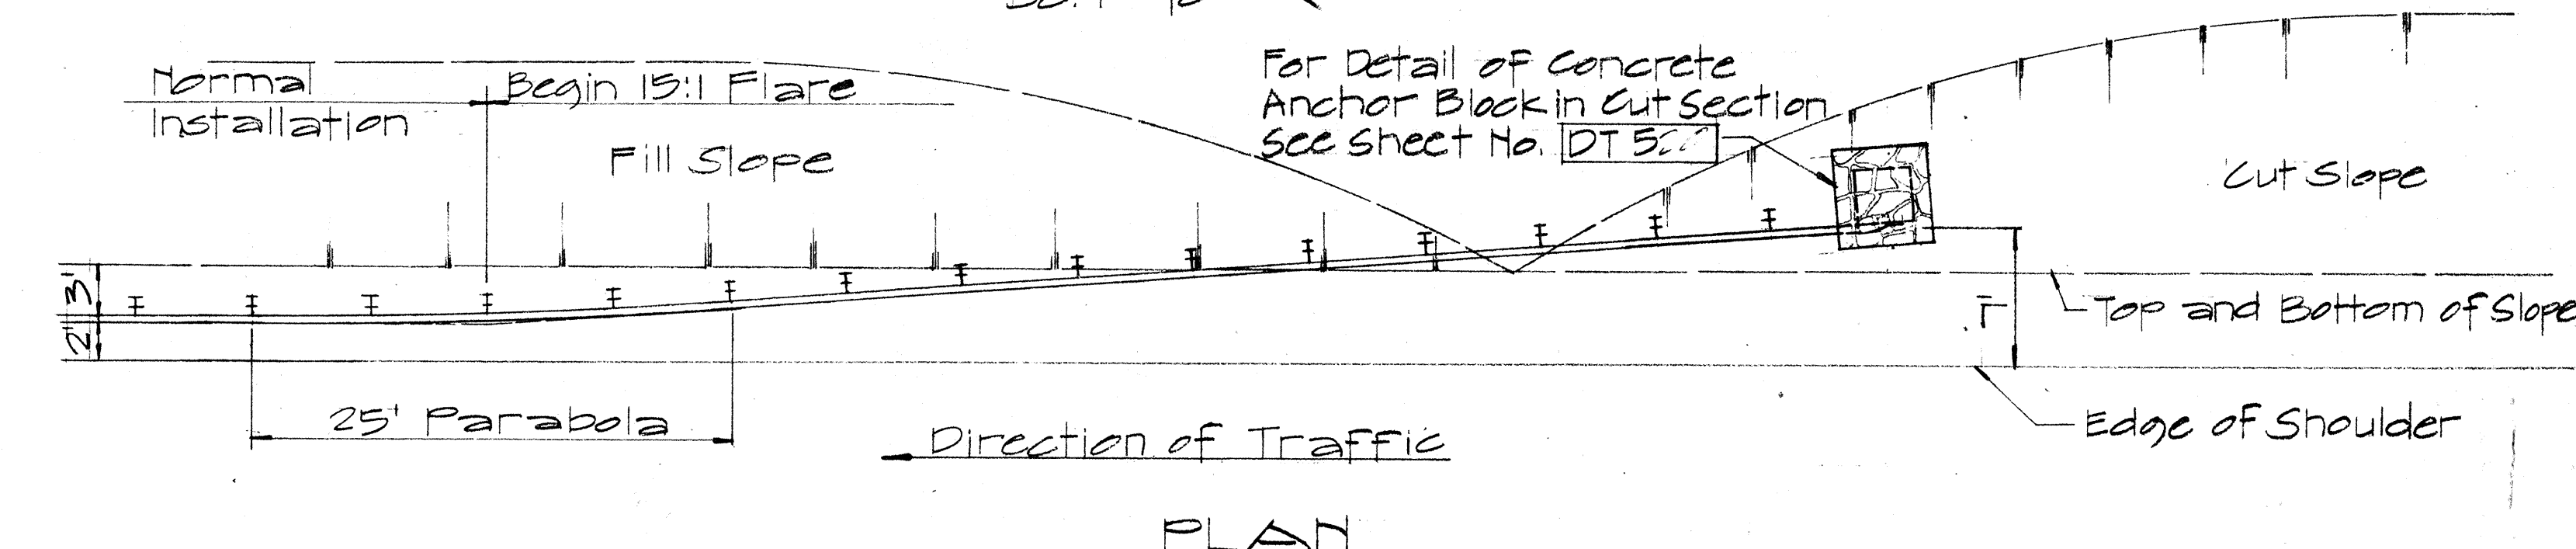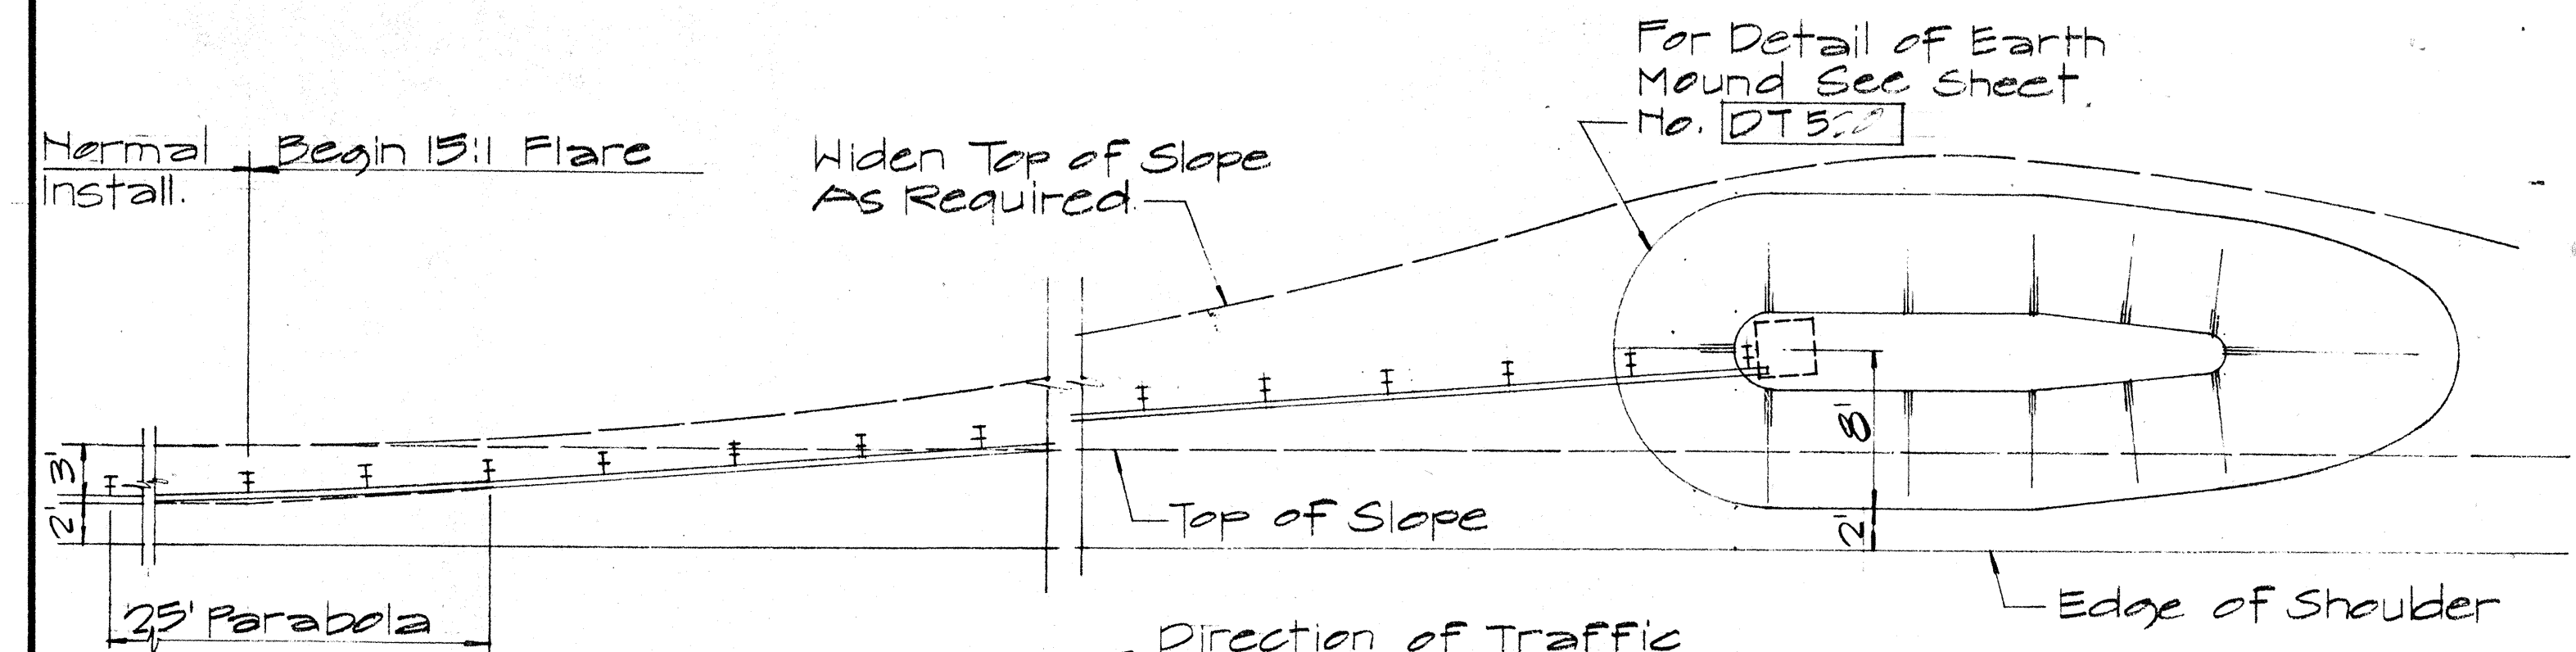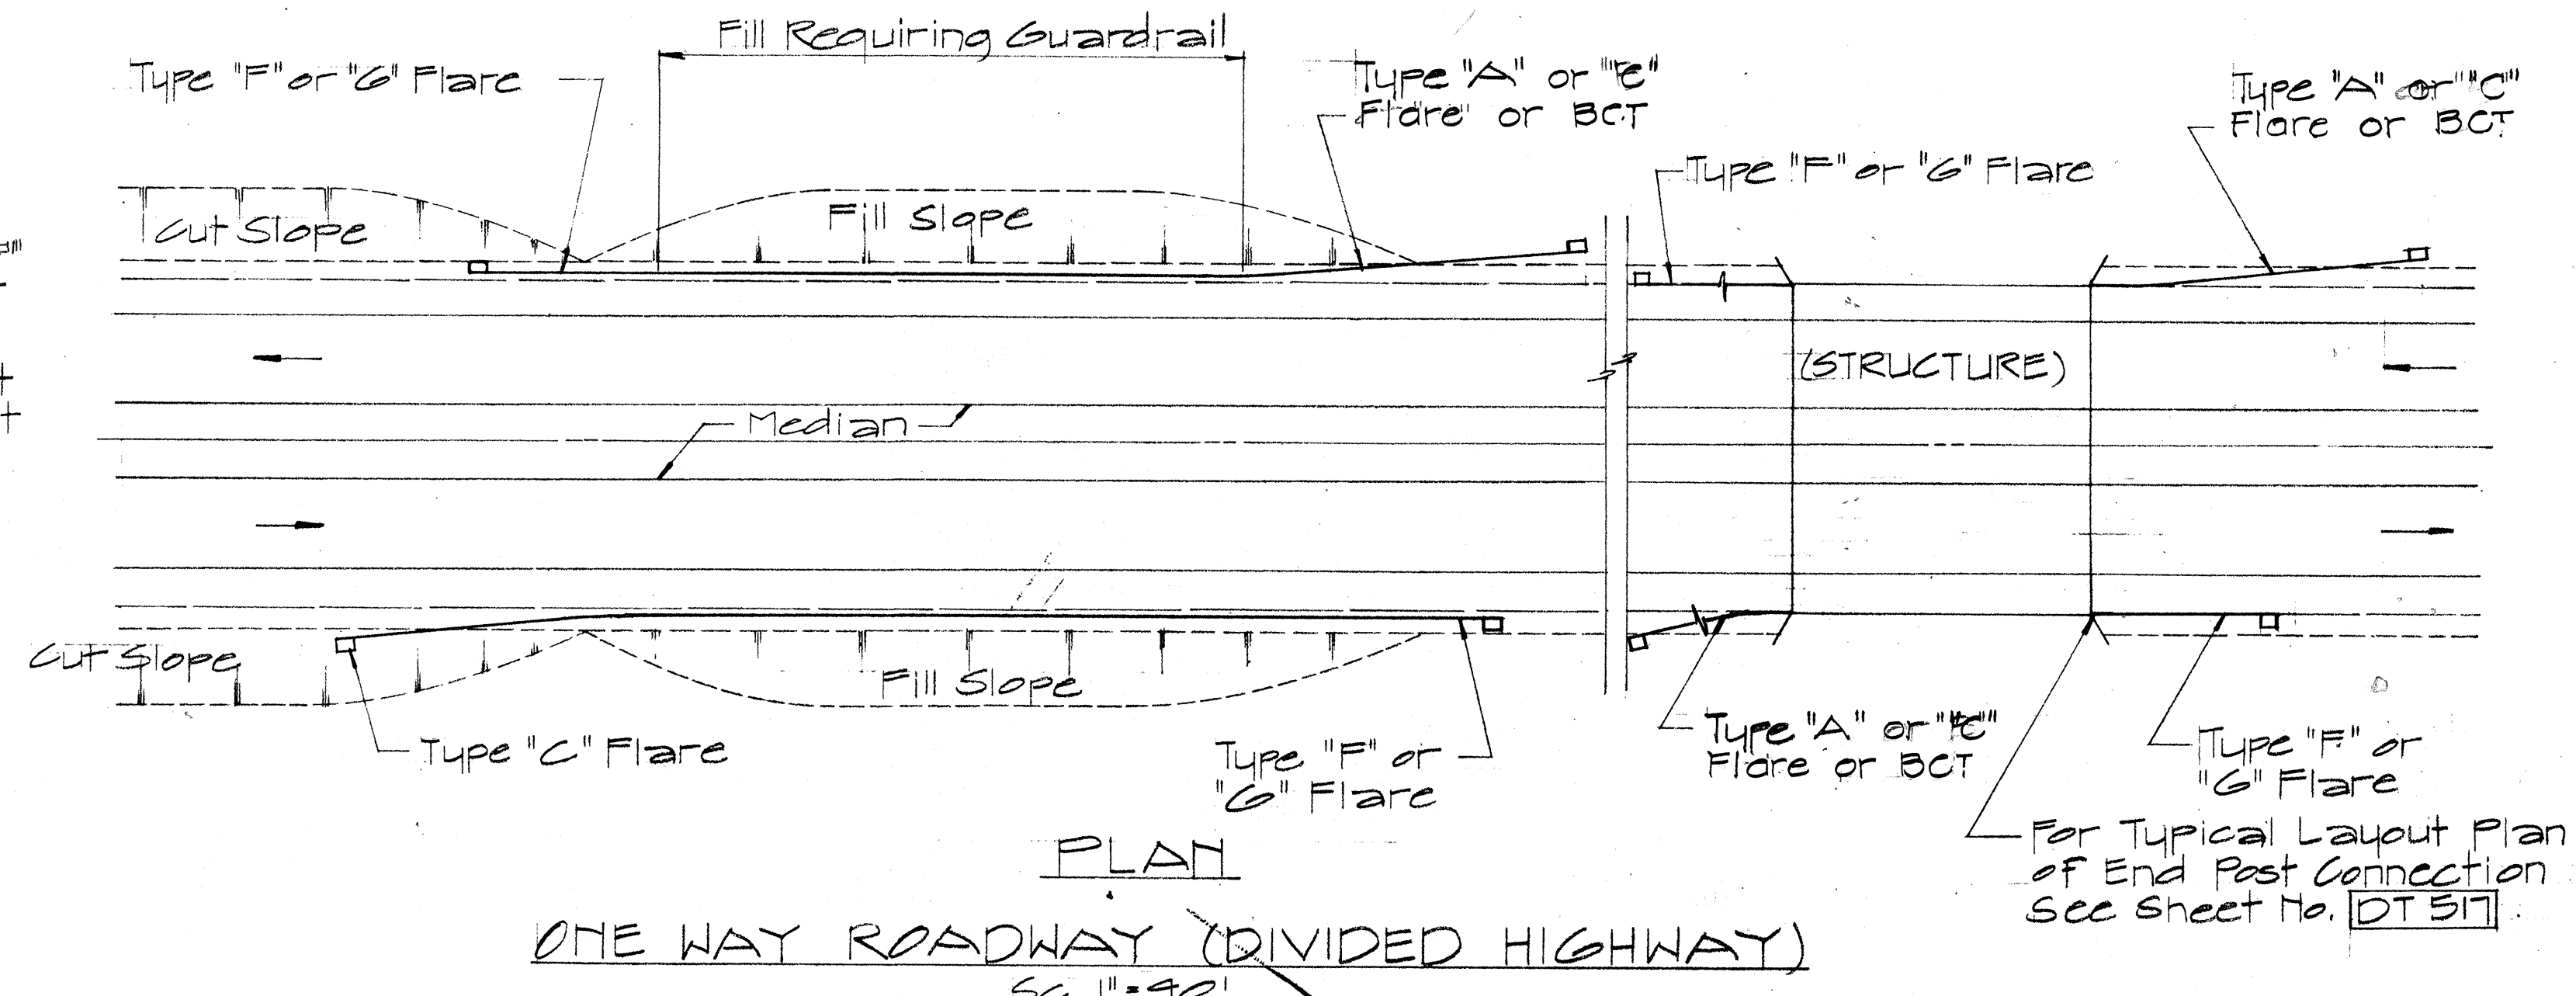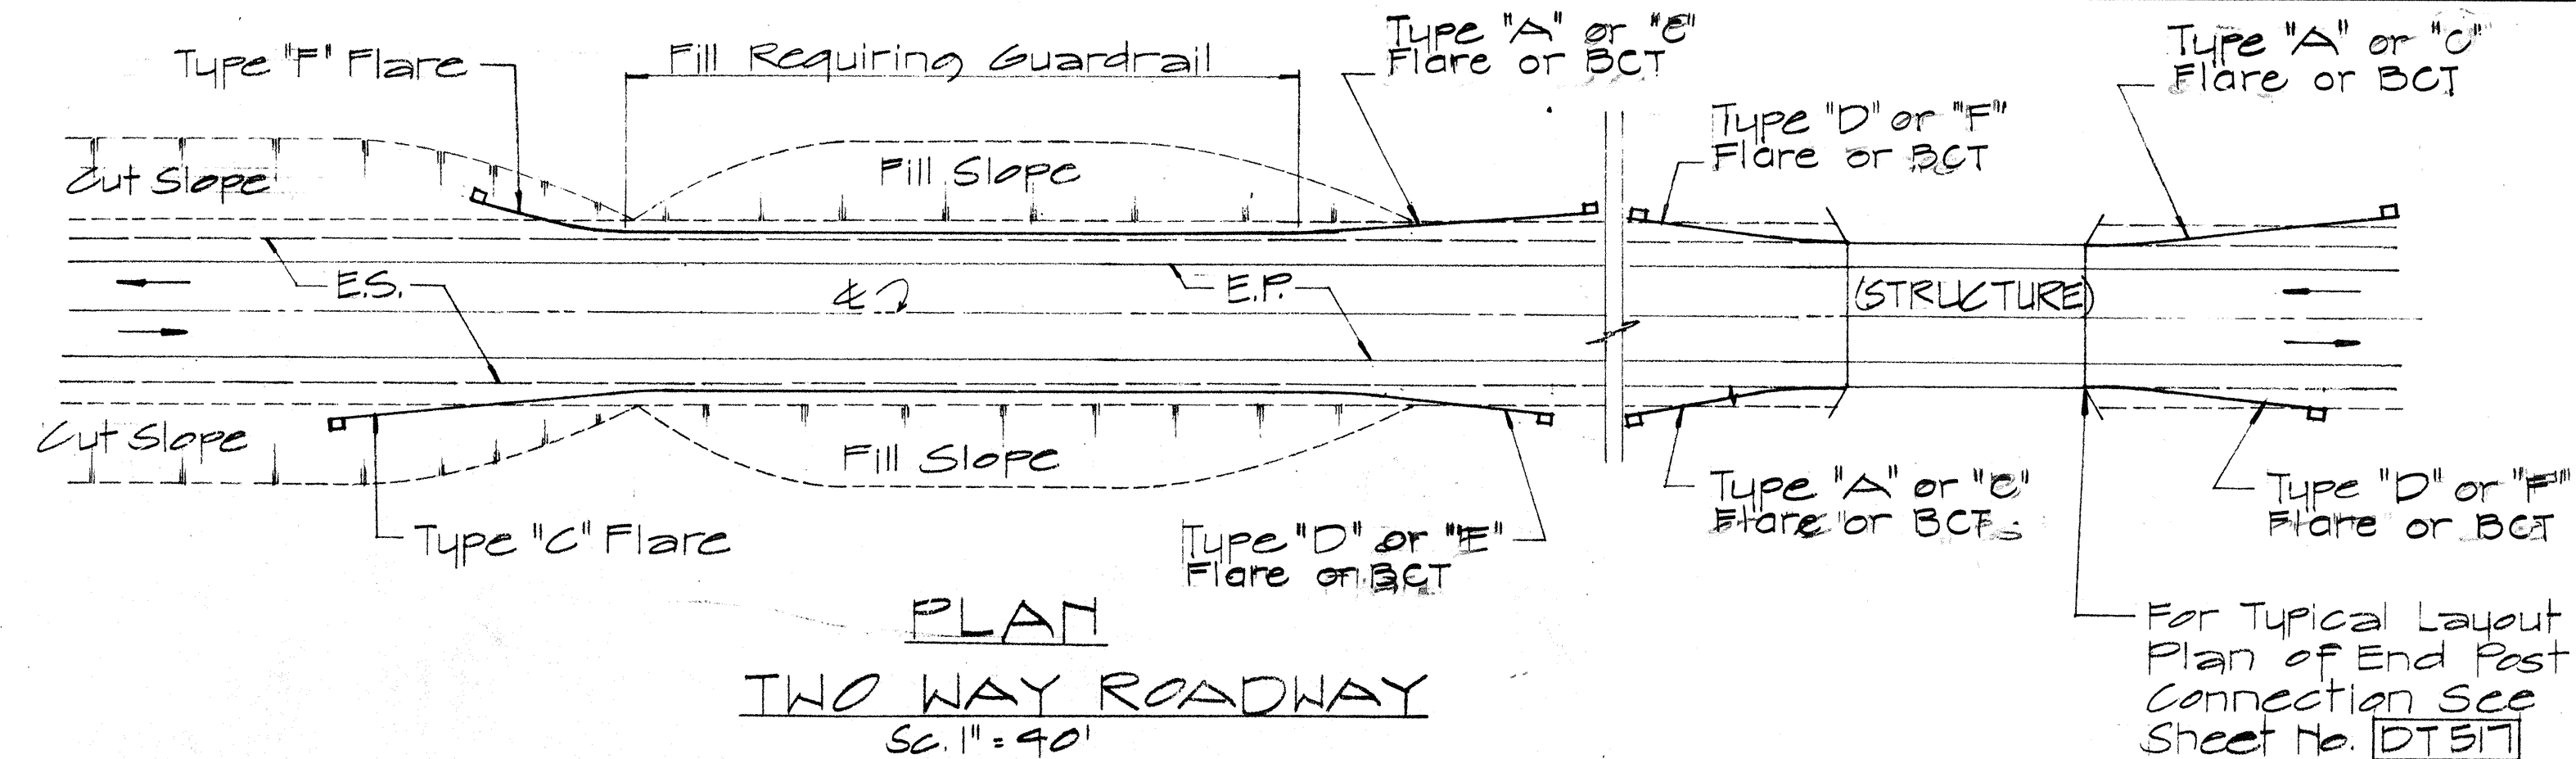

NOTE:

The approach end of the concrete structure that used sketch "A" end post connection were as follows:
H-1 Sta 533+22± Rt
H-1 Sta 110+75± Rt
H-1 Sta 123+80± Lt

Note: This tracing prepared during "As-Built" posting.

ELEVATION TYPE "C" FLARE
Scale 1/8" = 1'-0"

NO.	REVISION	APPROVED BY	DATE
1	Delete Type "B" Flare and Type "E" Flare	H.T.	6/15/88

APPROVAL RECOMMENDED:
Eugene Tanaka 12/29/69
TRAFFIC ENGINEER DATE

APPROVED:
Walter S. S. S. 12-30-69
ASSISTANT CHIEF, ENGINEERING DATE







STATE OF HAWAII
DEPARTMENT OF TRANSPORTATION
HIGHWAYS DIVISION

**STANDARD DETAILS
OF APPROACH END
FLARE - ONE & TWO
WAY ROADWAY**


Sc. As Noted April 1967
SHEET No. 118 of 14 SHEETS DT 516

DATE
DRAWN BY
CHECKED BY
QUANTITIES BY
NOTE BOOK
ORIGINAL PLAN
No.

FED. ROAD DIST. NO.	STATE	FED. AID PROJ. NO.	FISCAL YEAR	SHEET NO.	TOTAL SHEETS
HAWAII	HAW.	IR-H-1(193)	1986	27	62

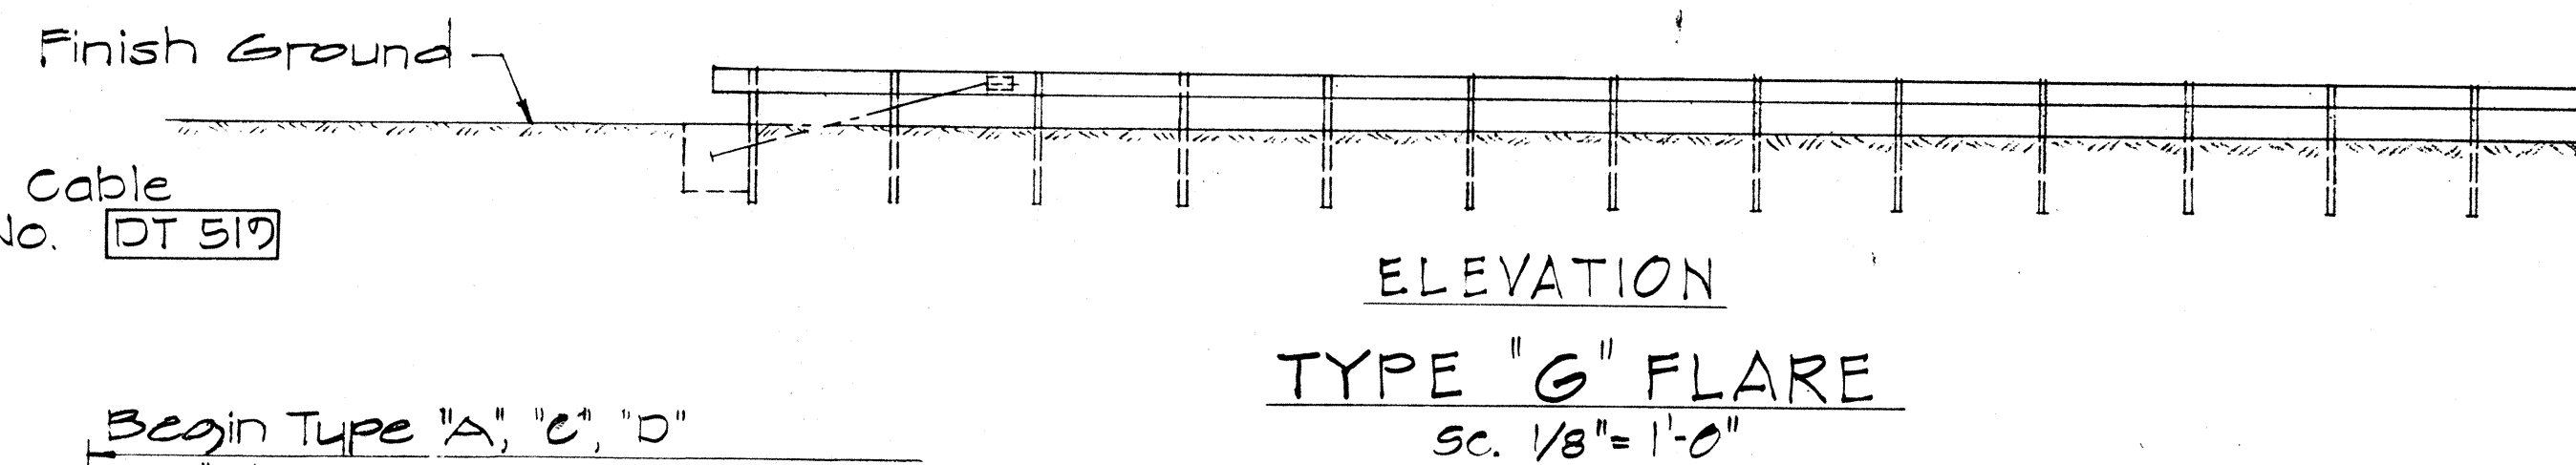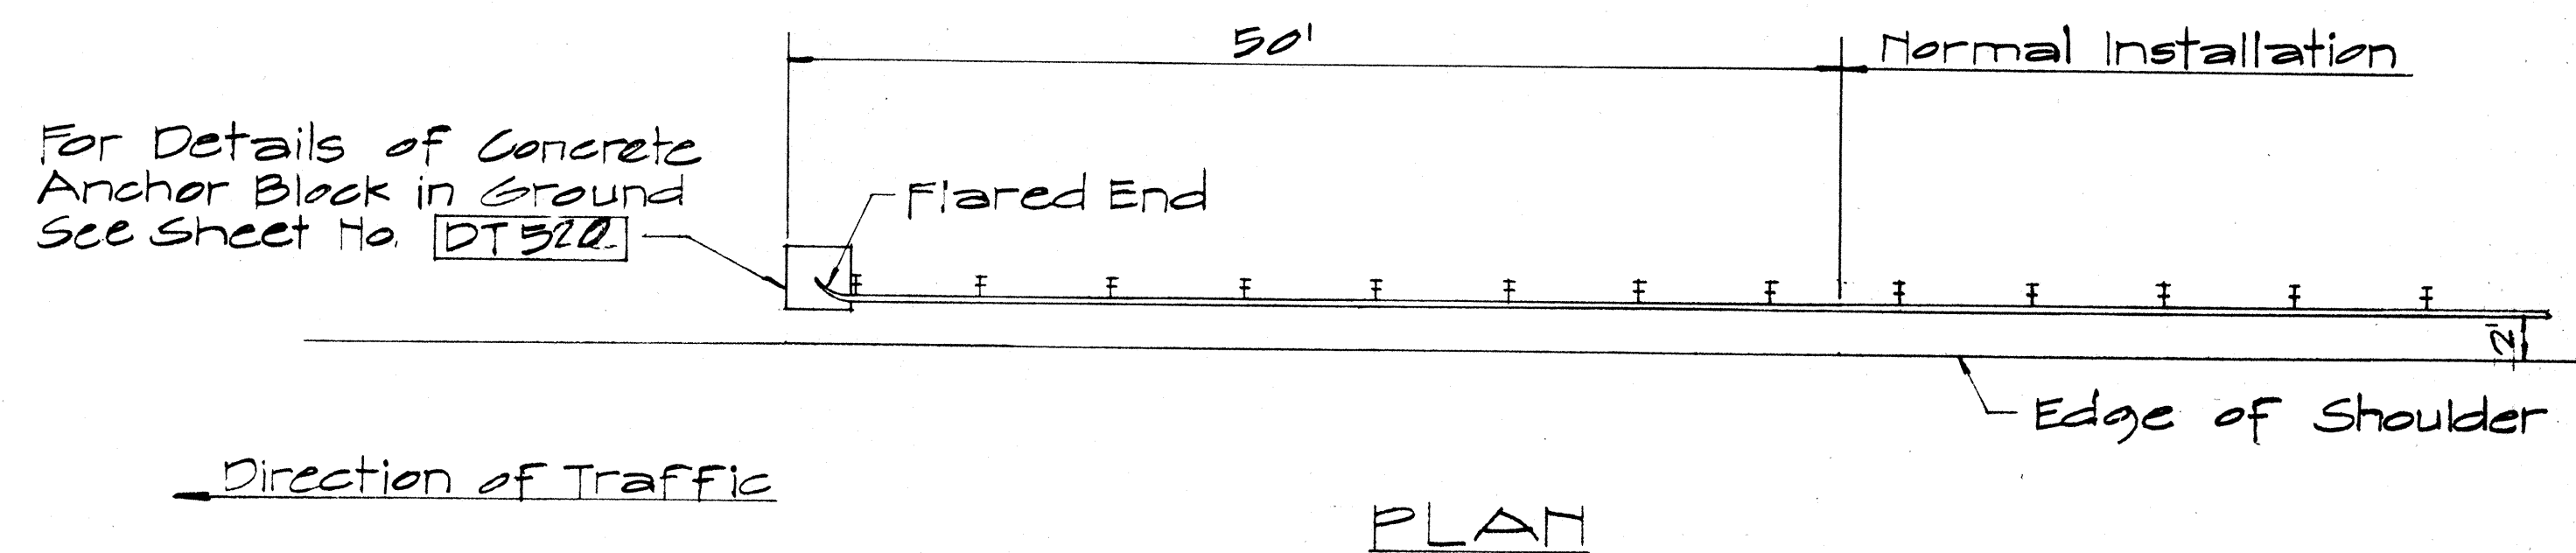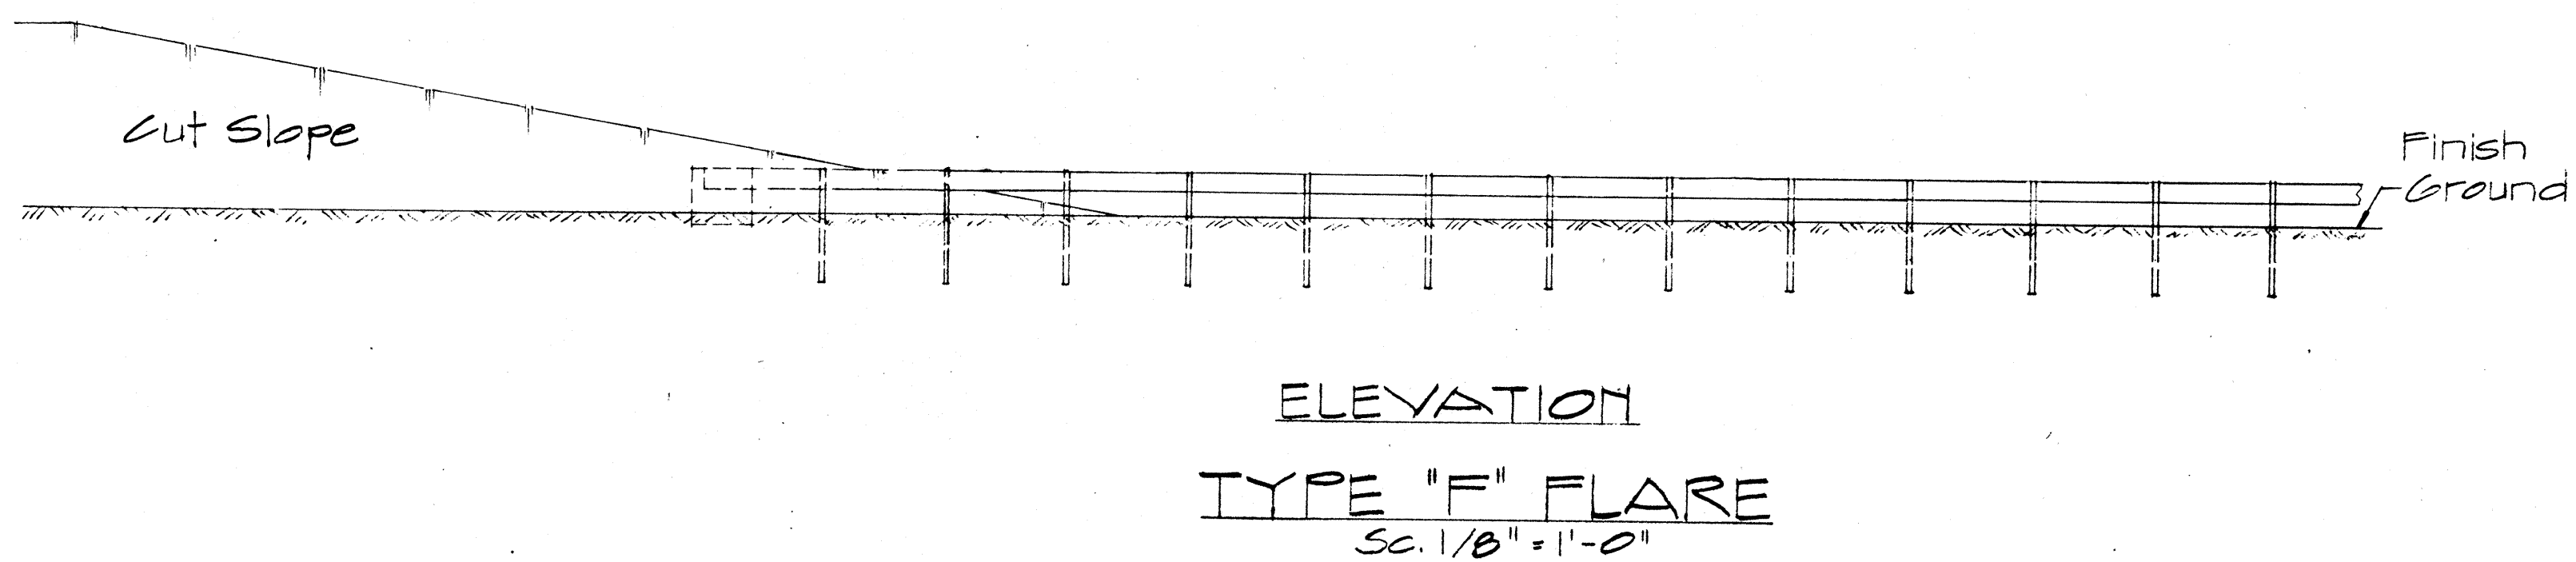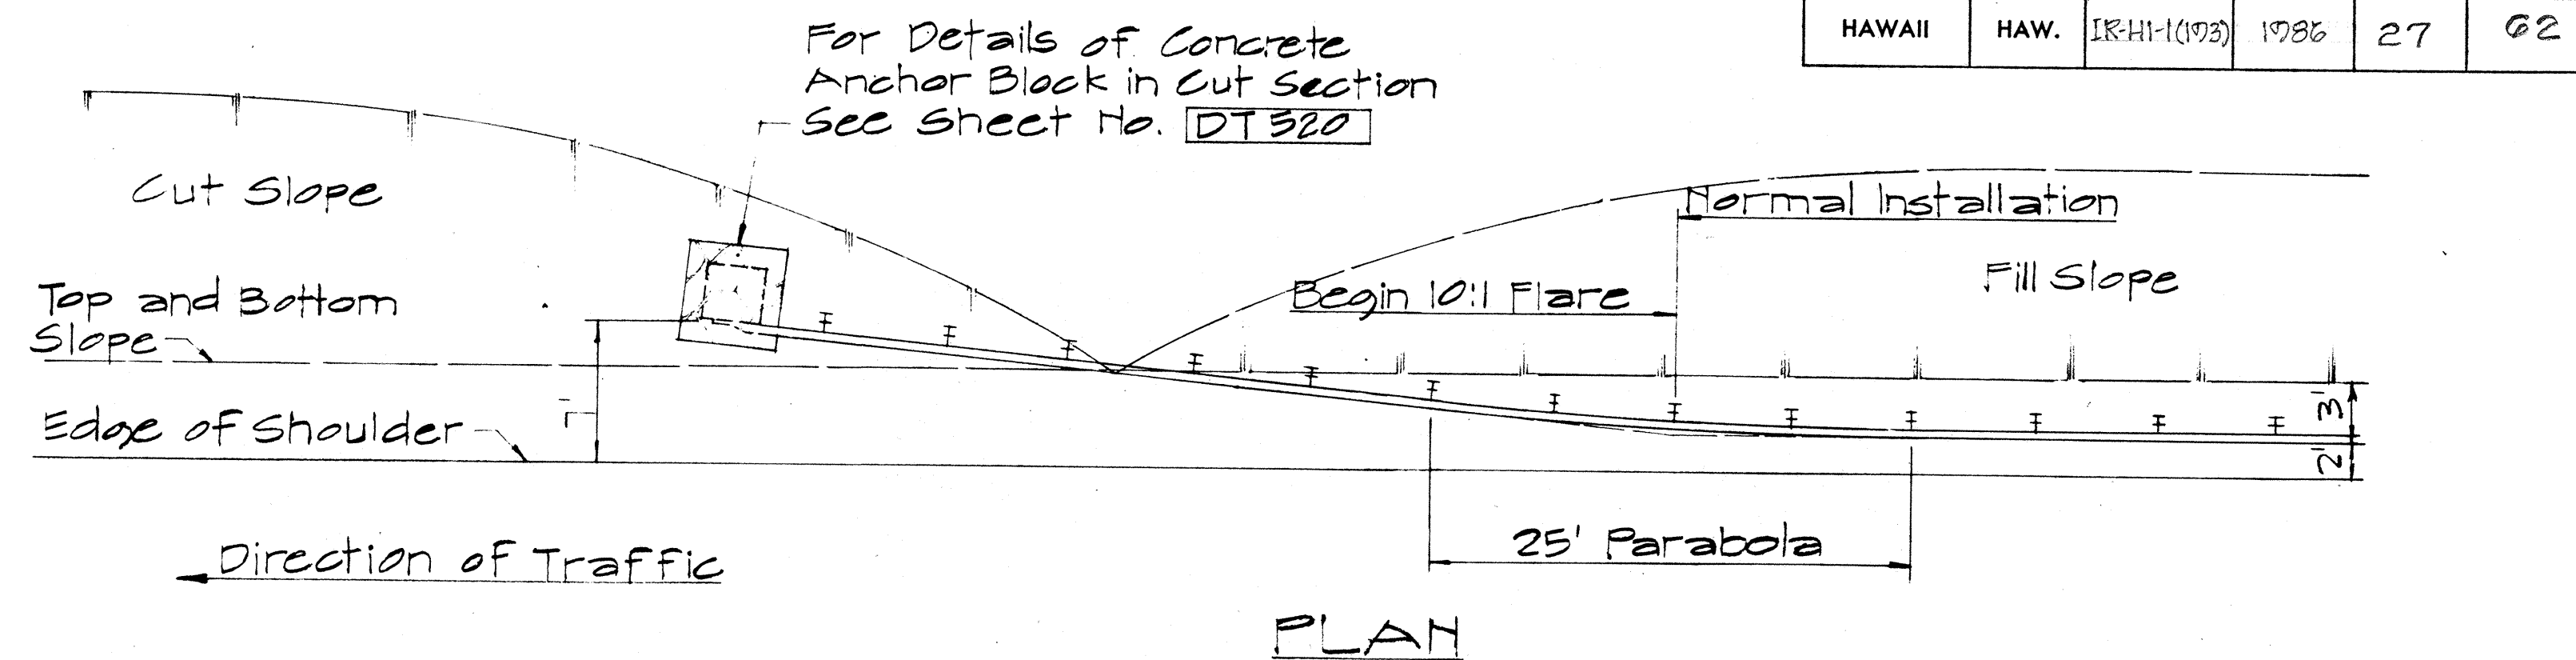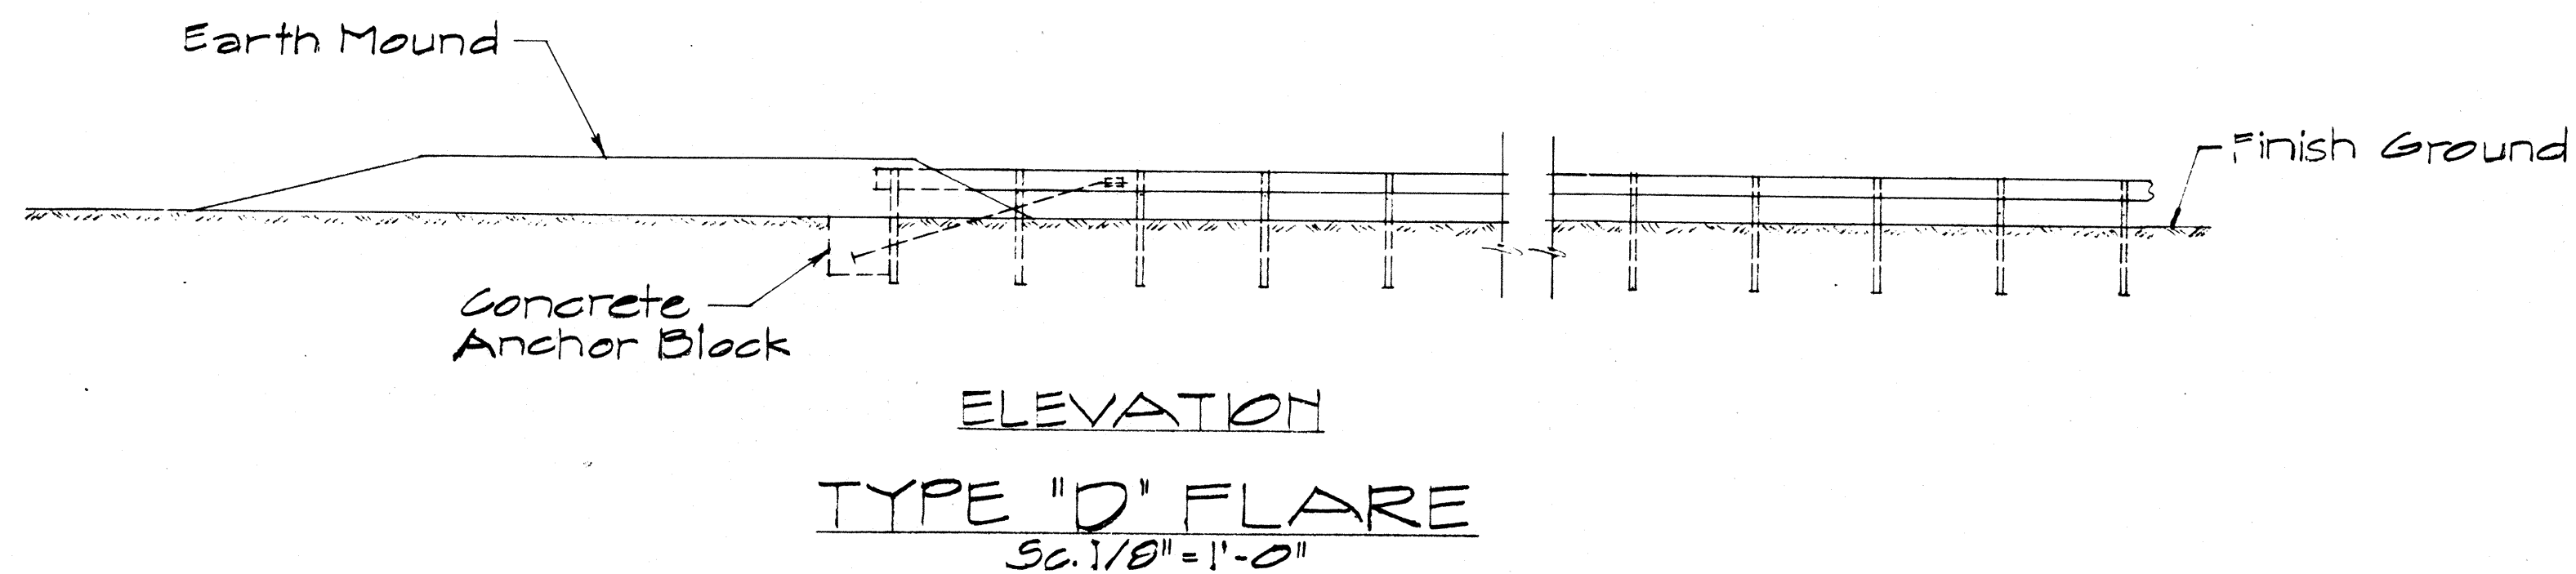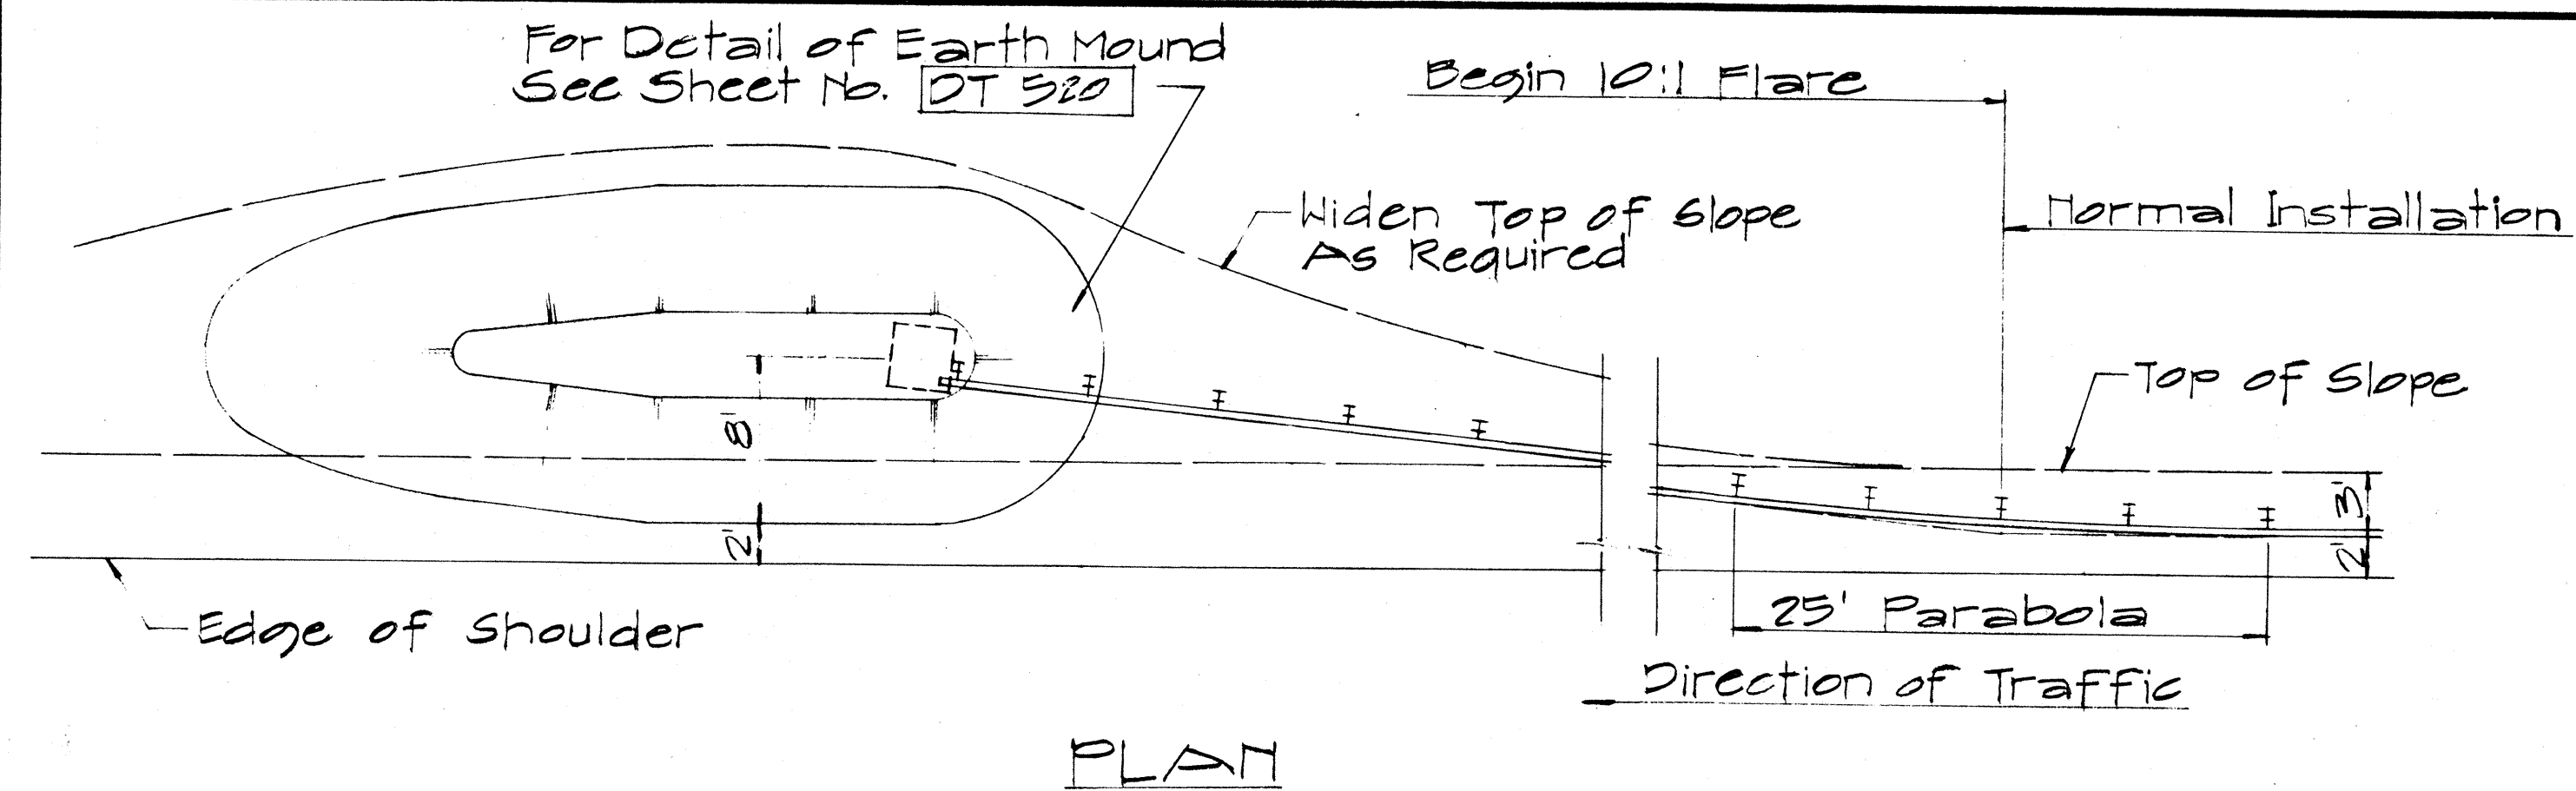

NOTE:
For detail of Breakaway Cable Terminal (BCT) See Sheet No. DT 510

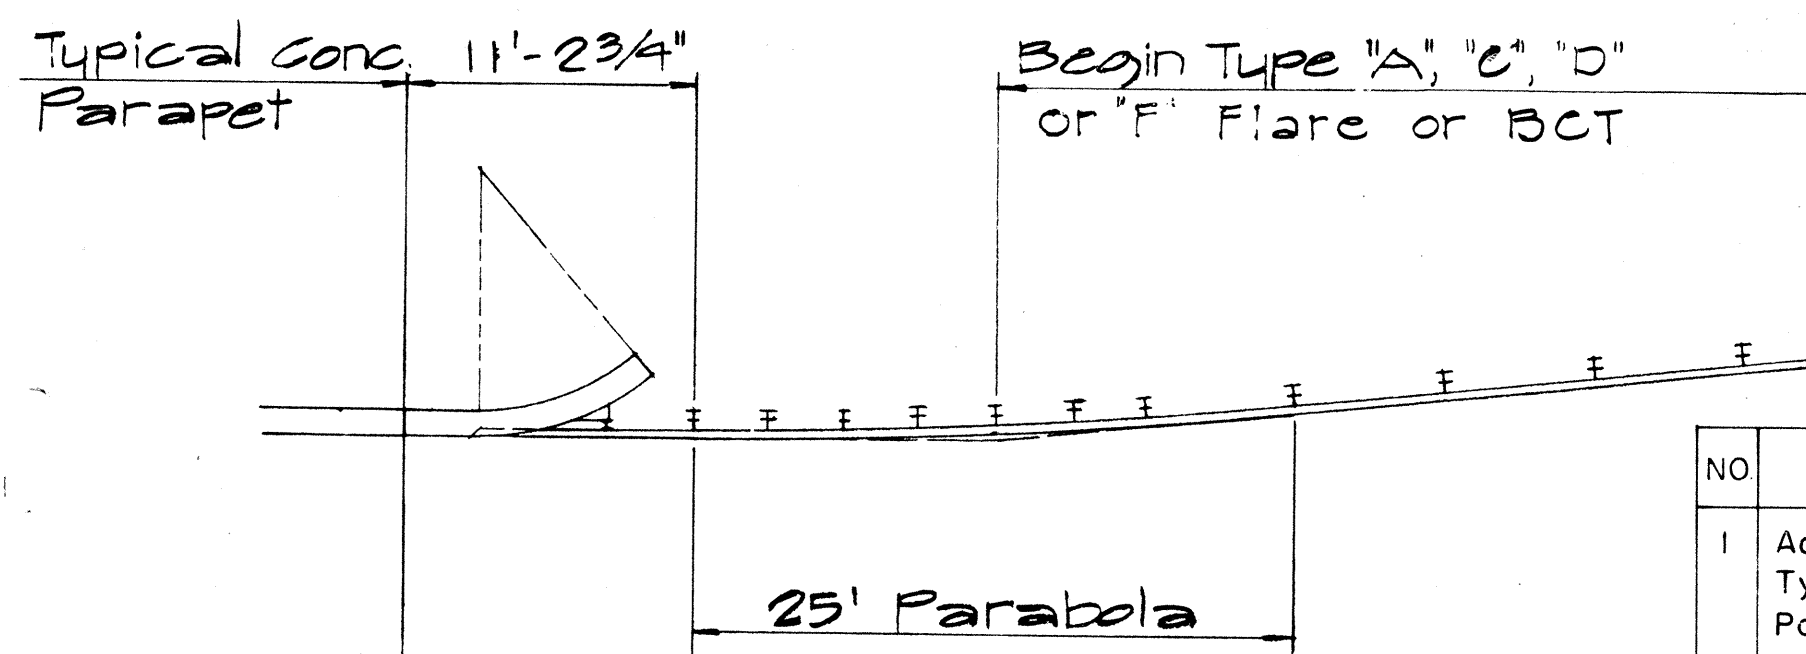

TYPICAL LAYOUT PLAN OF END POST CONNECTION

Sc. 1/8" = 1'-0"

APPROVAL RECOMMENDED:
Eishi Tanaka
TRAFFIC ENGINEER
DATE 12/29/69

APPROVED:
Assistant Chief, Engineering
DATE 12-30-69

NO	REVISION	APPROVED BY	DATE
1	Additional Posts Added to Typical Layout Plan Of End Post Connection	H.C.	4-12-72
2	Delete Type "B" Flare and Type "E" Flare	H.C.	6-15-78


STATE OF HAWAII
DEPARTMENT OF TRANSPORTATION
HIGHWAYS DIVISION

STANDARD DETAILS
TRAILING END
FLARE - ONE & TWO
WAY ROADWAY


Scale: As Noted April 1969

SHEET No. 12B OF 14 SHEETS DT 517


FED. ROAD DIST. NO.	STATE	FED. AID PROJ. NO.	FISCAL YEAR	SHEET NO.	TOTAL SHEETS
HAWAII	HAW.	IR-H-1 (197)	1986	20	62

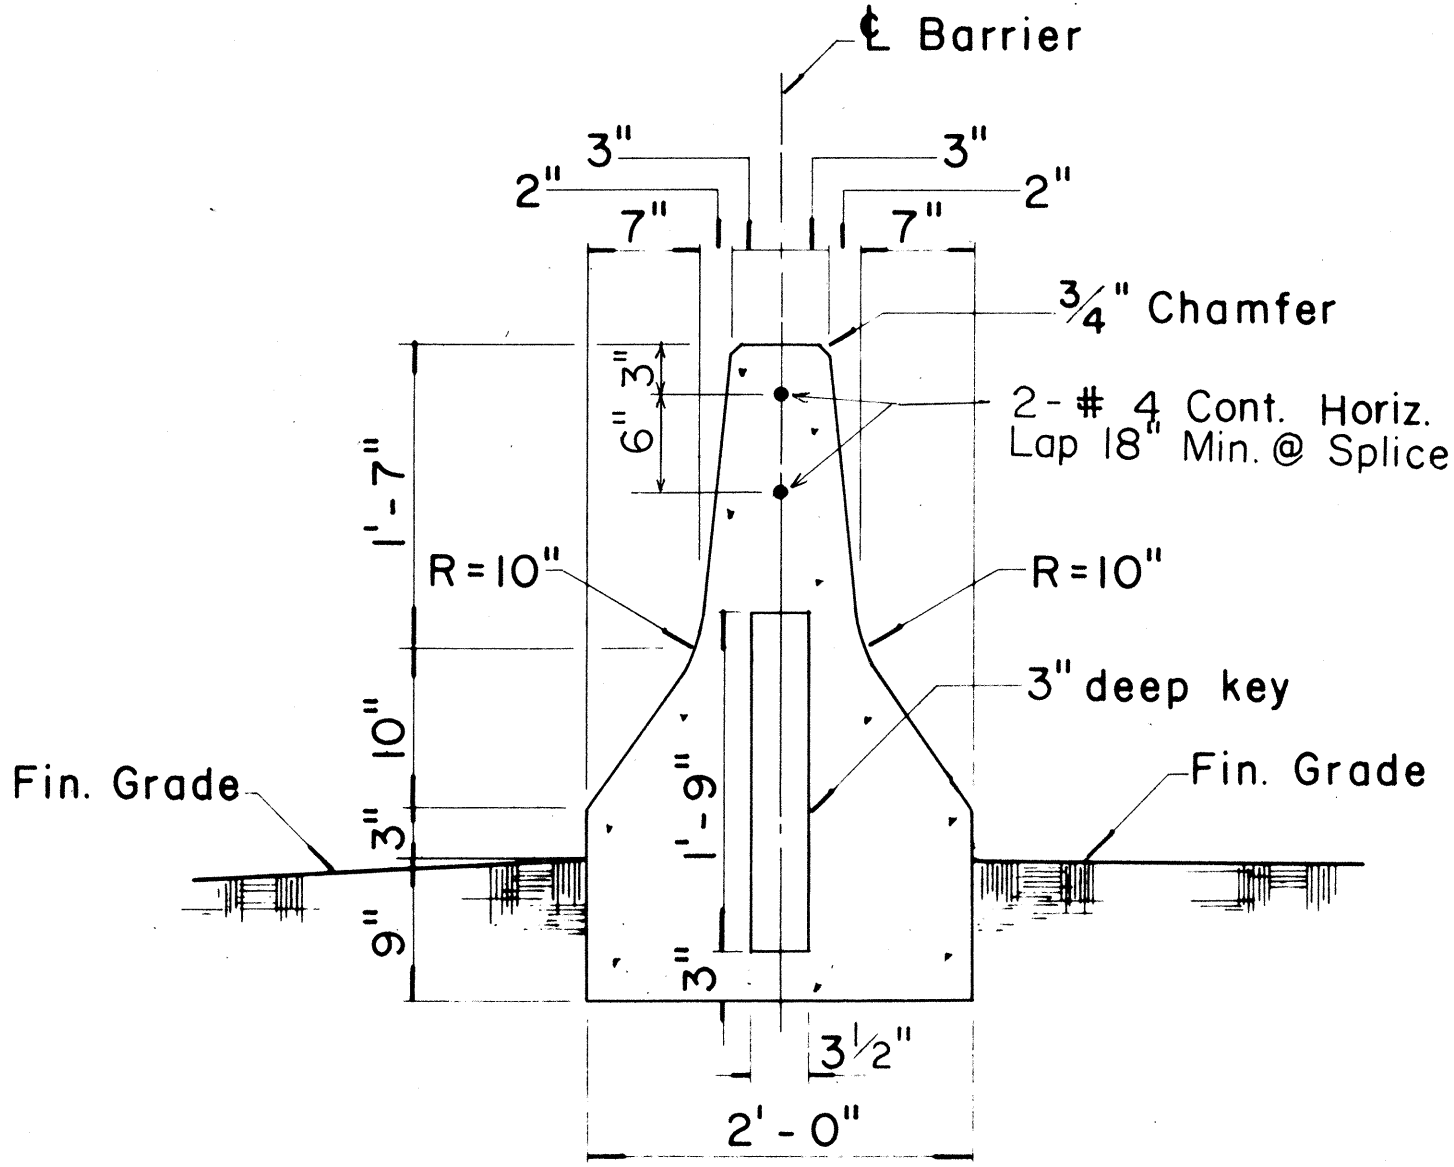

TYPE 4A
Scale: 1" = 1'-0"

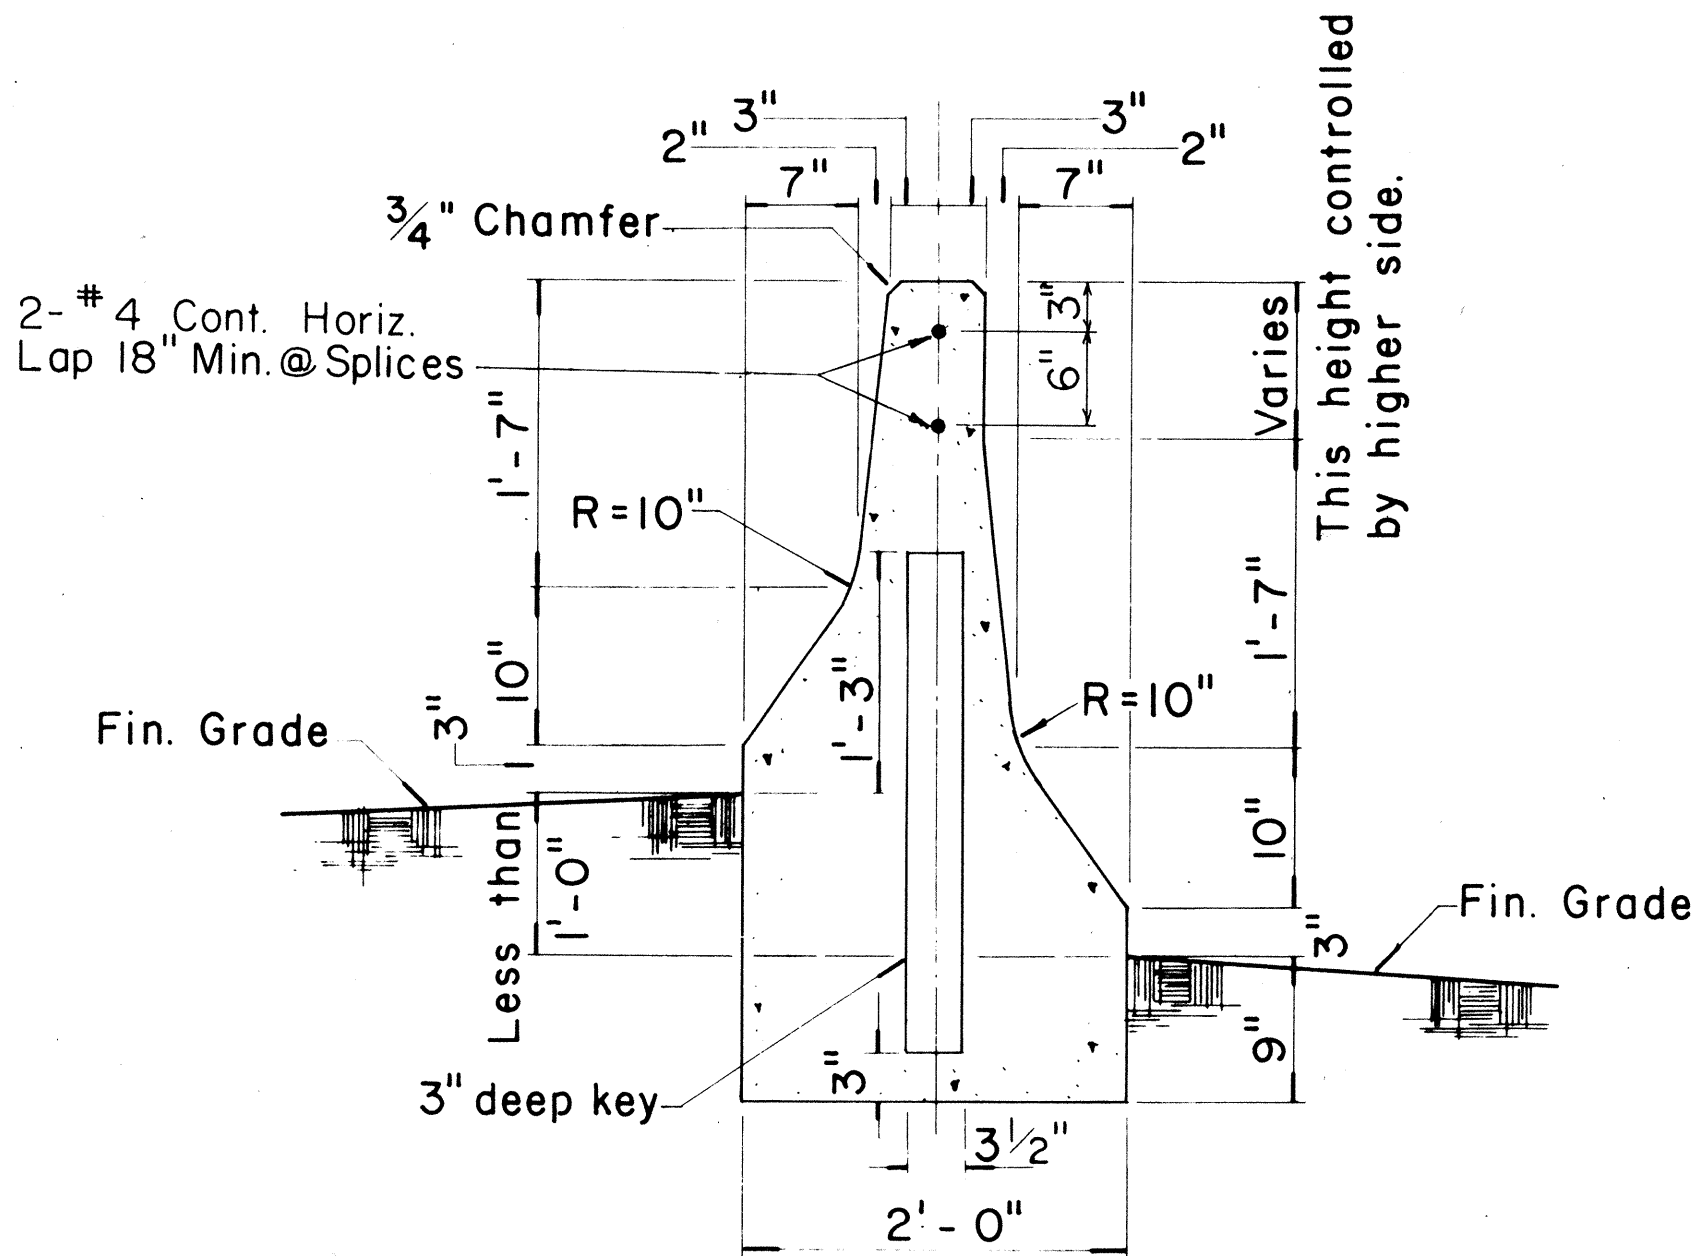


TYPE 4B
Scale: 1" = 1'-0"

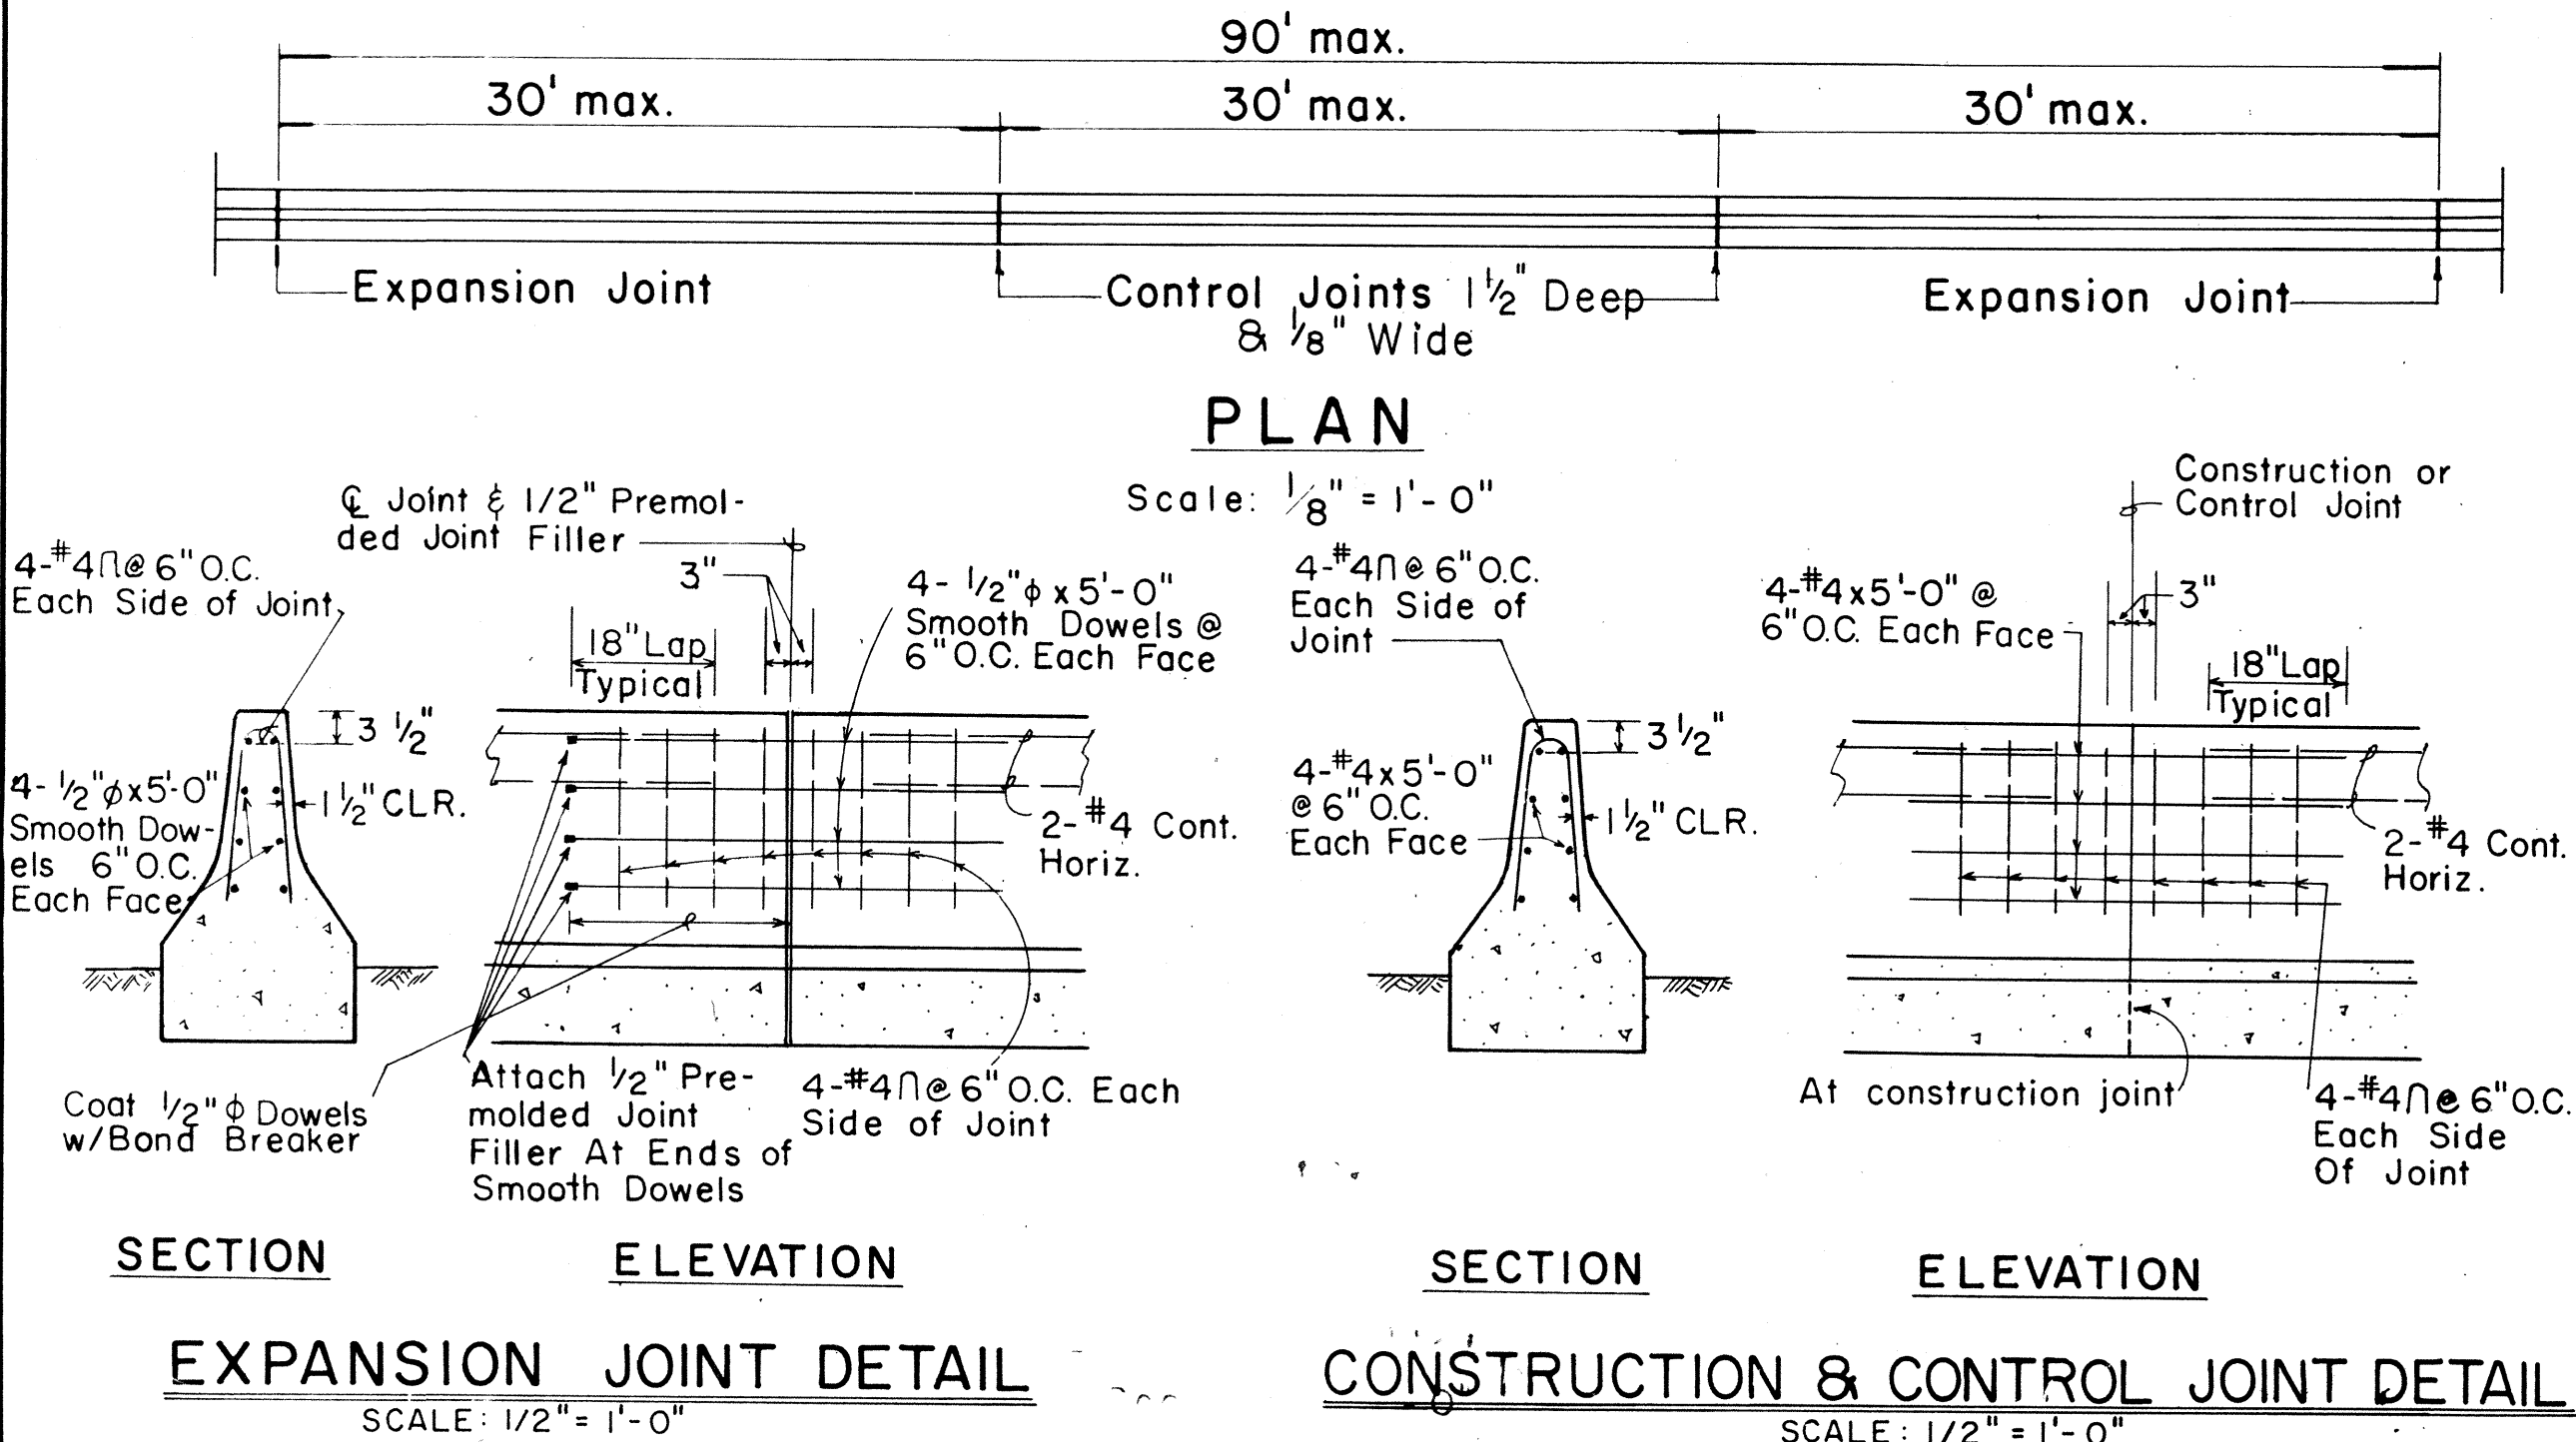

GENERAL NOTES

1. Precast Rigid Barrier Guard Rail may be installed as an option to cast-in-place Type 4 Rigid Barrier Guard Rail. Contractor shall submit shop drawings to Engineer for approval.
2. Expansion Joints shall be constructed at ninety-foot (90 ft.) maximum intervals and at existing expansion joints of structures. (Use 1/2" premolded joint filler, incidental to Type 4 Rigid Barrier Guard Rail). Control Joints shall be placed between expansion joints at 30' maximum. Shear keys shall be required at all construction joints.
3. The exterior surface and vertical alignment of the Type 4 Rigid Barrier Guard Rail shall be constructed to give a uniform and presentable appearance. Variation of more than 1/4" in 20' max. and 1/2" in 40' or more will be considered objectionable. The Engineer will determine the acceptability of the work. During the course of the work, samples may be tested and measurements made to establish whether or not the specified values or dimensions are being met. If the specified values or dimensions are not being met, the Engineer will determine the degree of the non-conformance, the effect on the serviceability of the project, whether the work be accepted and remain in place and, if so, the amount to be paid for such work, or whether the work shall be removed and replaced or otherwise corrected at the Contractor's expense.

NOTE: 1/2" PREMOLDED JOINT FILLER IS NOT REQUIRED AT CONSTRUCTION JOINTS.

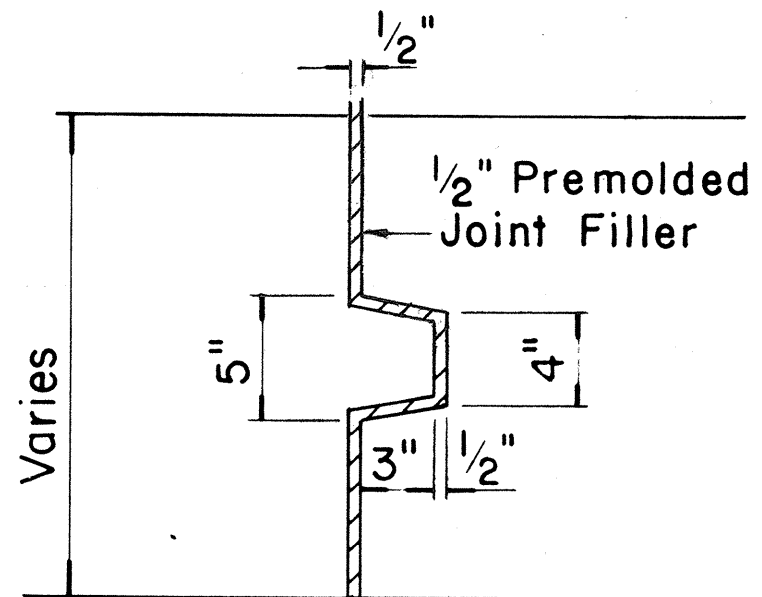

SECTION THRU KEY AT EXPANSION JOINT
Scale: 1 1/2" = 1'-0"


APPROVAL RECOMMENDED:
Euchi Tanaka 1/20/81
TRAFFIC ENGINEER DATE

APPROVED:
Robert D. Kishi 1/21/81
ASSISTANT CHIEF, ENGINEERING DATE

STATE OF HAWAII
DEPARTMENT OF TRANSPORTATION
HIGHWAYS DIVISION

STANDARD DETAILS
GUARD RAIL TYPE 4
(RIGID BARRIER)


Scale: As Shown
SHEET No. 148 OF 14 SHEETS DT 521

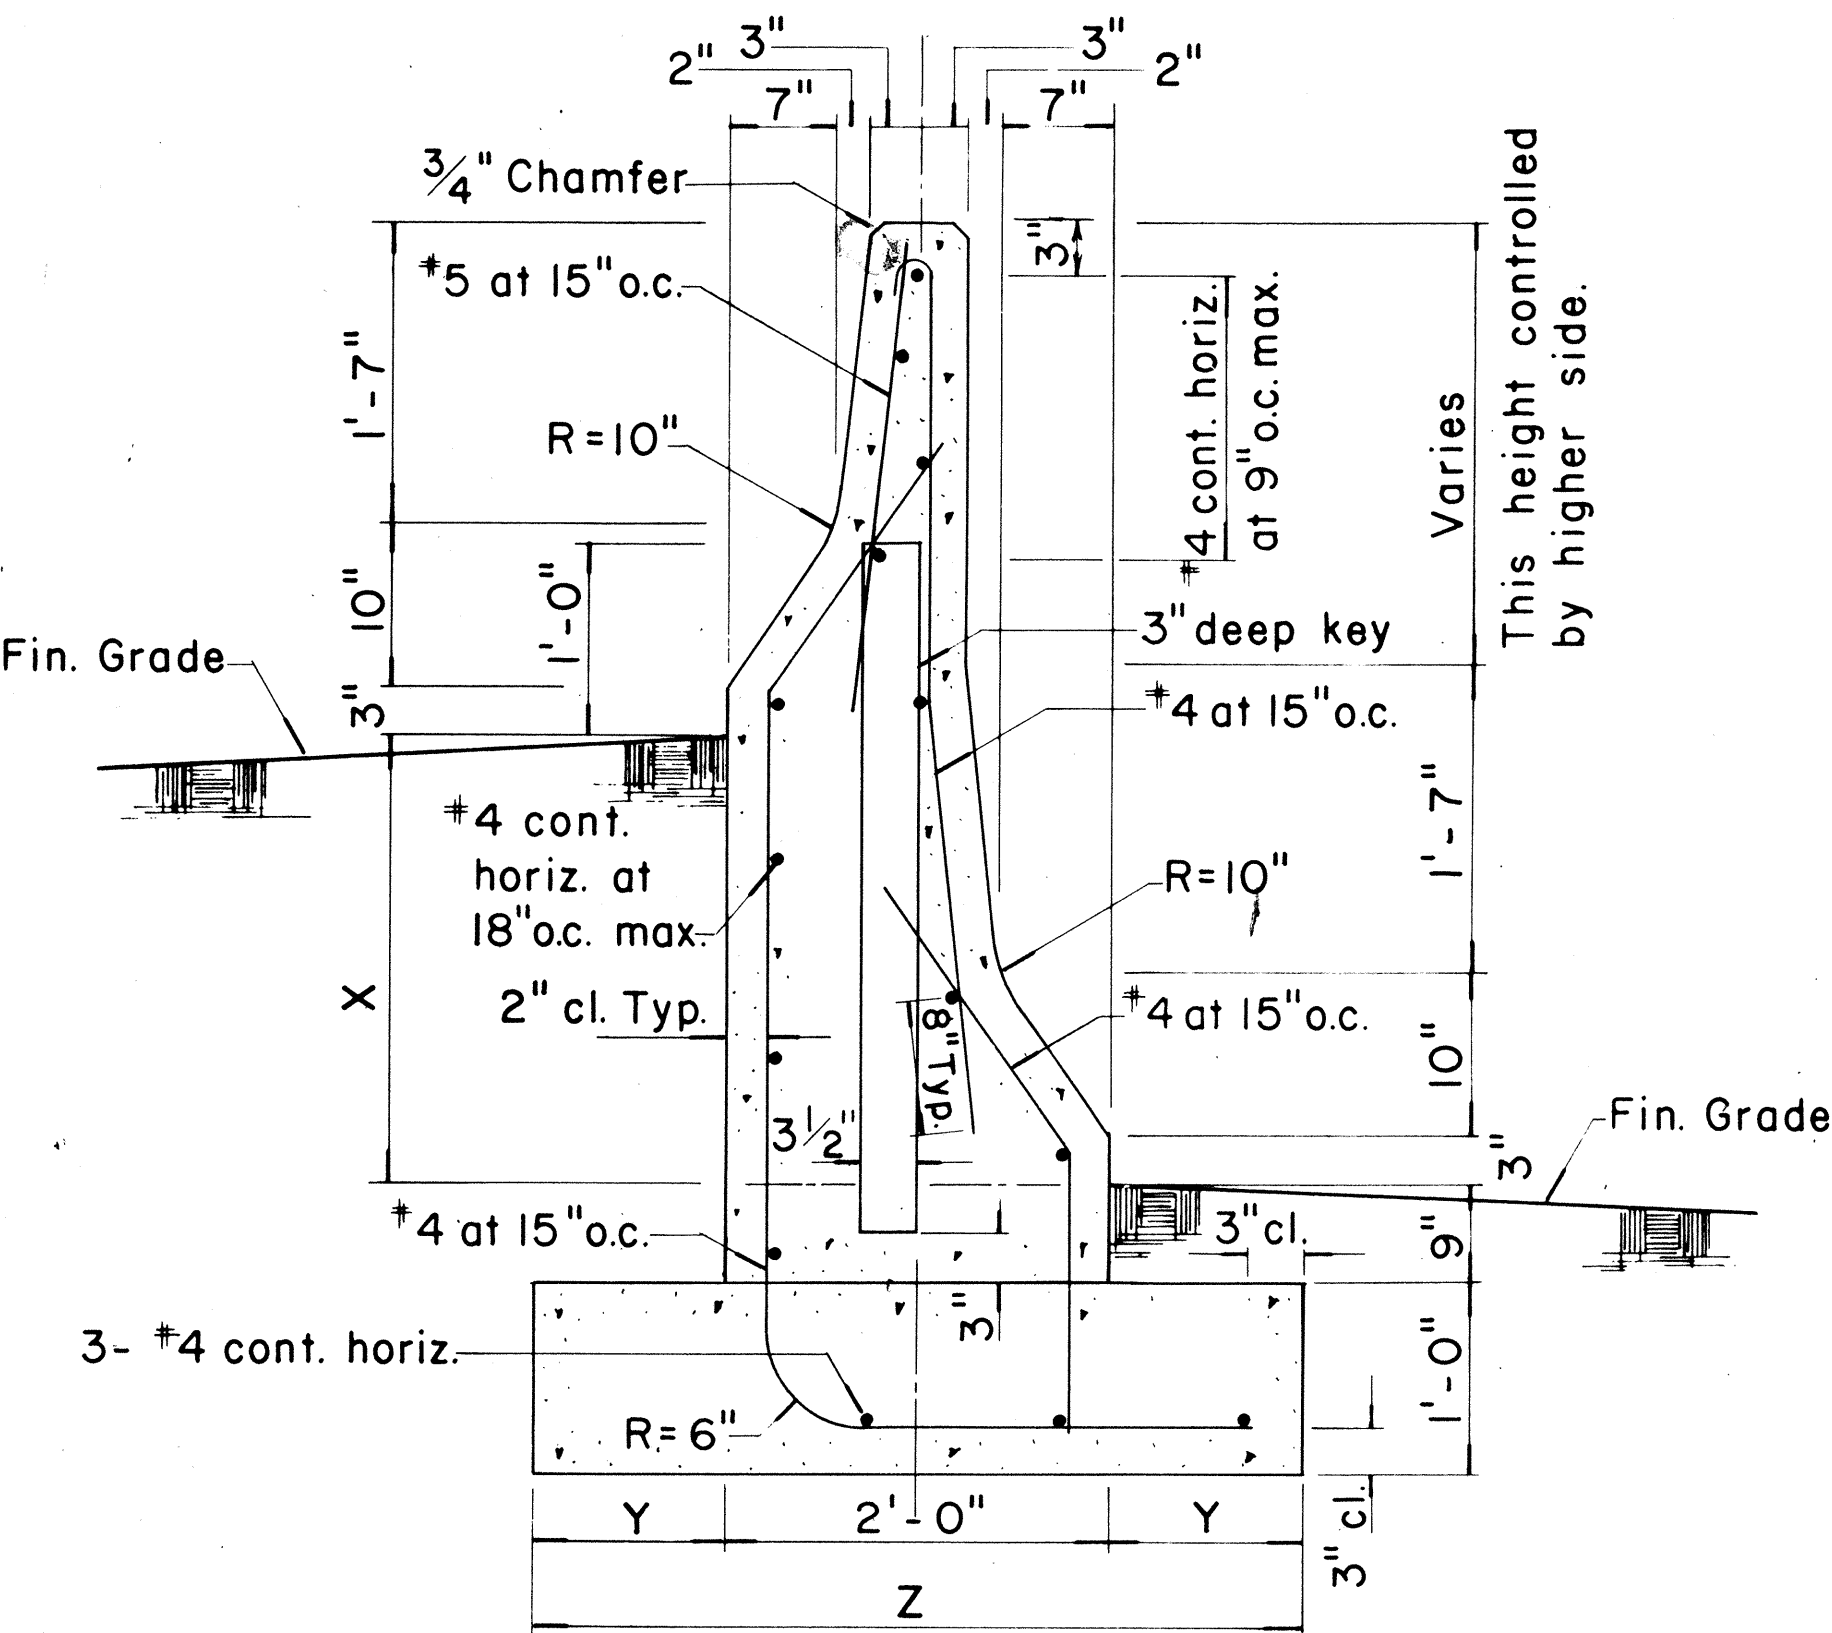

TYPE 4C & TYPE 4D
Scale: 1" = 1'-0"

TYPE	DIFFERENCE IN FIN. GRADE	FOOTING
4C	1'-0" min., 2'-4" max.	1'-0" 4'-0"
4D	Greater than 2'-4", 4'-4" max.	1'-3" 4'-6"

NOTE:
Except where noted all dimensions shall be the same for Type 4C and Type 4D.

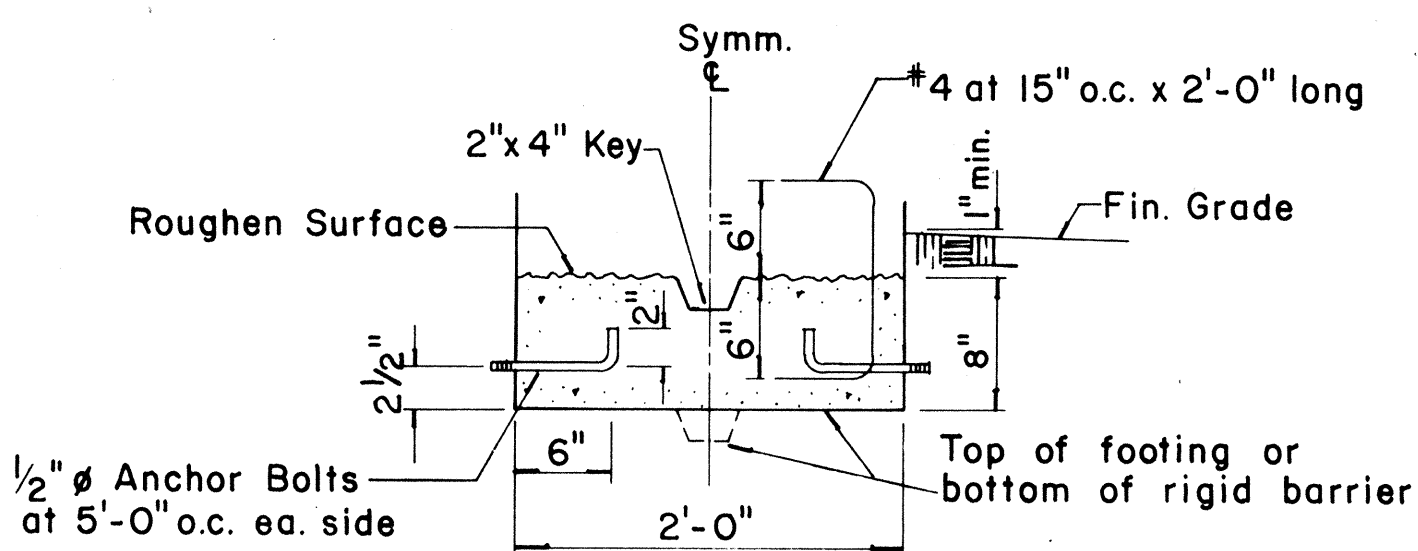

OPTIONAL CONSTRUCTION JOINT DETAILS
Scale: 1" = 1'-0"

NOTE:
The intent of the optional construction joint details for the Type 4 Rigid Barrier Guard Rail is to provide a method of securing the forms and preventing uplift so that the barrier will have a uniform and presentable appearance. The Contractor may submit an alternate method of constructing the barrier for the approval of the Engineer and for use on a trial basis. Any unsatisfactory work shall be removed or corrected as directed by the Engineer and at the Contractor's expense.

NO.	REVISION	APPROVED BY	DATE
1	Supersede Sht. DT 521 Approved 2-10-72	H.I.	7/21/81

ORIGINAL	SURVEY PLOTTED BY	DATE
PLAN	DRAWN BY	
NOTE BOOK	DESIGNED BY	
	CHECKED BY	