



FED. ROAD DIST. NO.	STATE	FED. AID PROJ. NO.	FISCAL YEAR	SHEET NO.	TOTAL SHEETS
HAWAII	HAW.	IR-HI-1(193)	1986	38	62

SIGNING NOTES


- Signs shall conform to the latest editions and amendments of the following FHWA Publications:
 - "Manual on Uniform Traffic Control Devices for Street and Highways" (MUTCD).
 - "Standard Highway Signs," and
 - "Standard Alphabets for Highway Signs."
- Letter Size
 - When letters are all uppercase, use Series "E".
 - When initial uppercase letters is used in conjunction with lowercase letters, use Series "E" (M) for uppercase letter.
- Borders shall be 2-inches wide unless otherwise noted and corner radii shall be approximately one eighth of the lesser side dimension of the sign. The maximum corner radius shall be 12-inches.
- New sign panels shall be laminated aluminum or extruded aluminum.
- Overlays shall be as specified in Section 621 of the Special Provisions.
- The Contractor shall verify the locations and dimensions of existing Expressway sign panels and supports.
- The final position of sign panels above the roadway shall be approved by the Engineer.
- Removal of existing sign posts, supports and footage shall be incidental to the various signing contract items.
- The Contractor shall not use any impacting device in relocating signs onto overpass structures.
- Existing Exit Number Signs on Destination Signs to be refurbished with new overlay panels shall also be refurbished.
- Existing Carpool/Restricted lane signs and posts, Sta. 150+00± to 229+50±, shall be removed.
- All median signs located where inside shoulder widths are 2 feet or less shall have minimum mounting height of 10 feet.
- Outbound Carpool signing shall be covered when outb. Carpool lane is not opened to traffic.

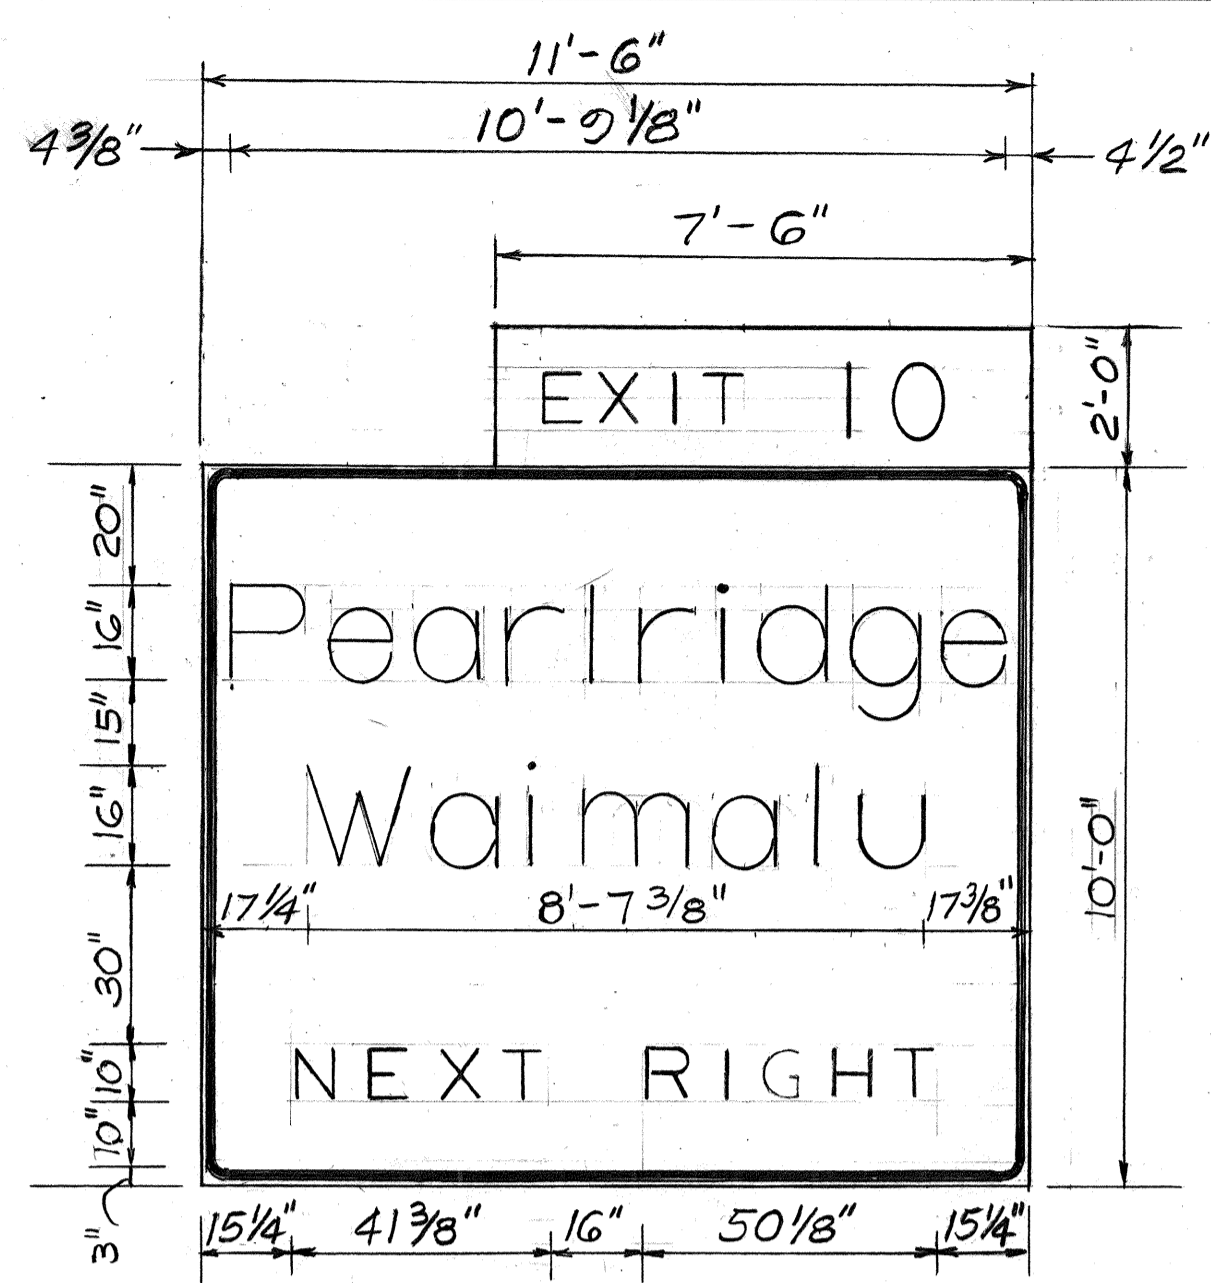


OVERLAY
 STA. 58+70± RT.
 Scale: 3/8" = 1'-0"

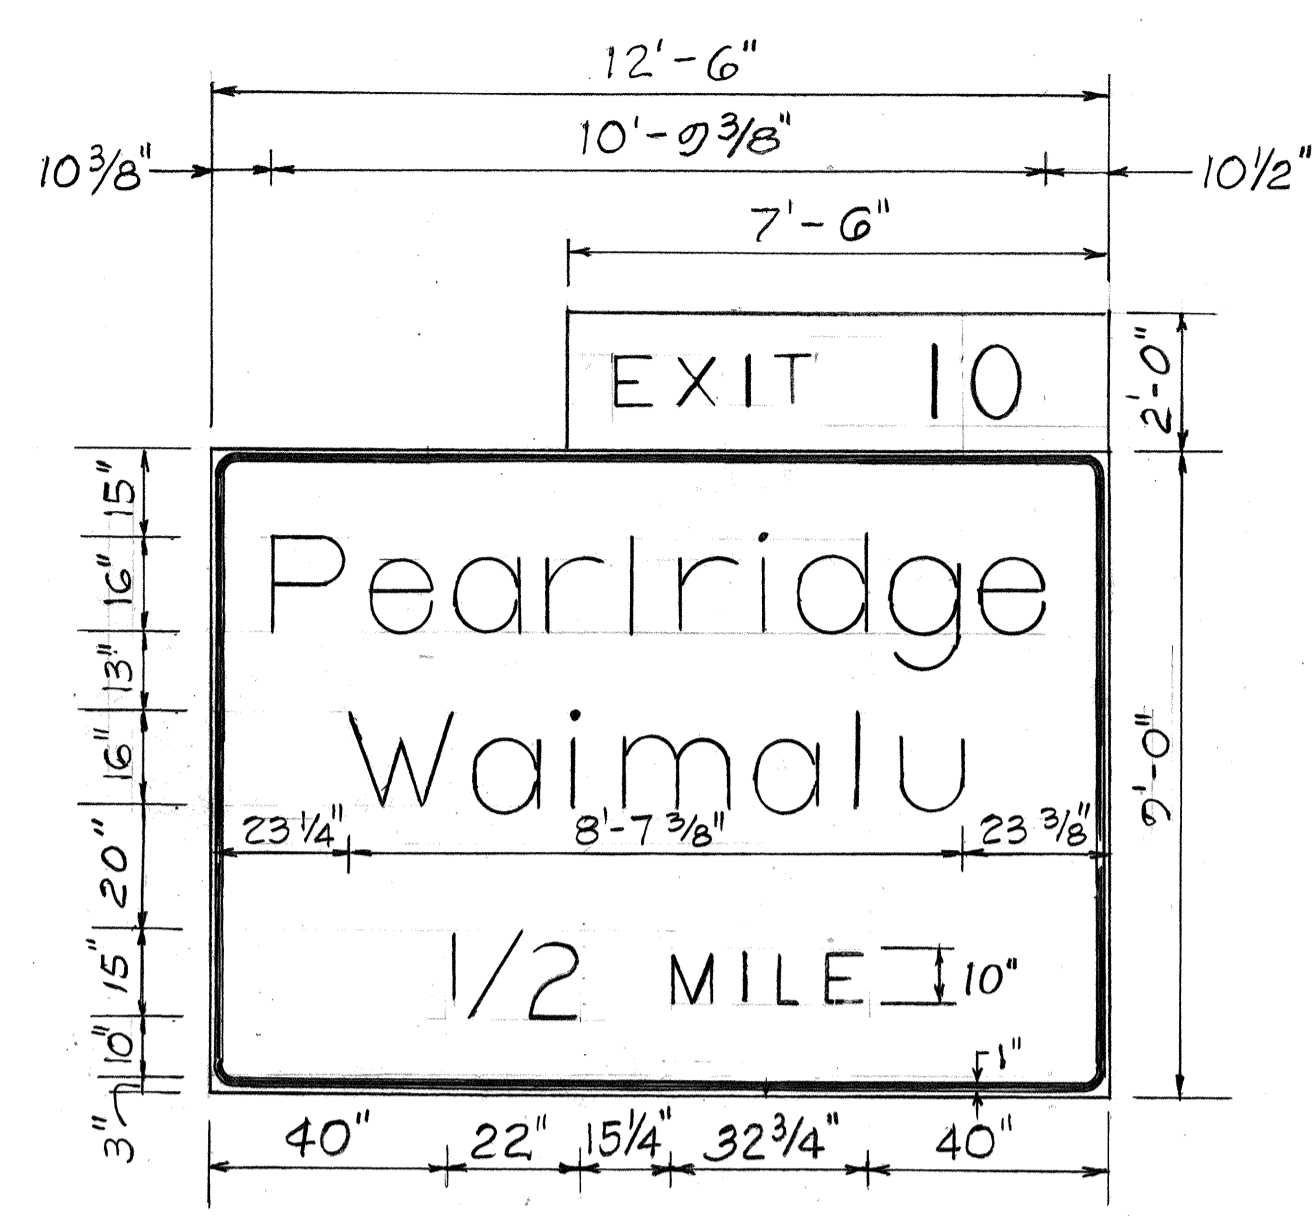


OVERLAY
 STA. 33+63± RT.
 Scale: 3/8" = 1'-0"

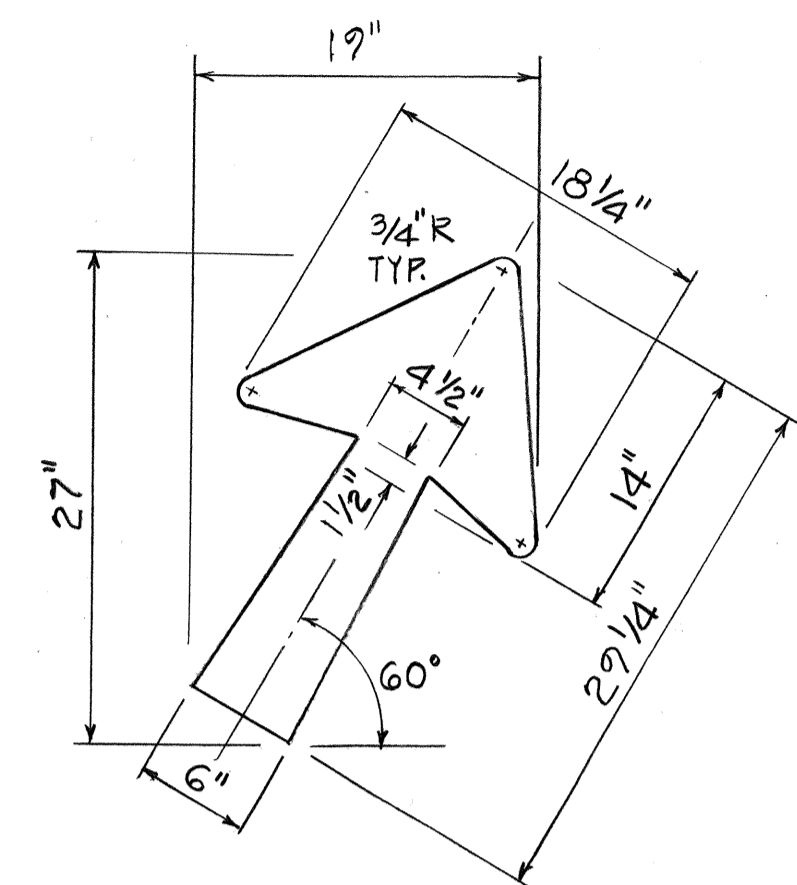

TYPE "A" DIAGONAL ARROW DETAIL
 N.T.S.

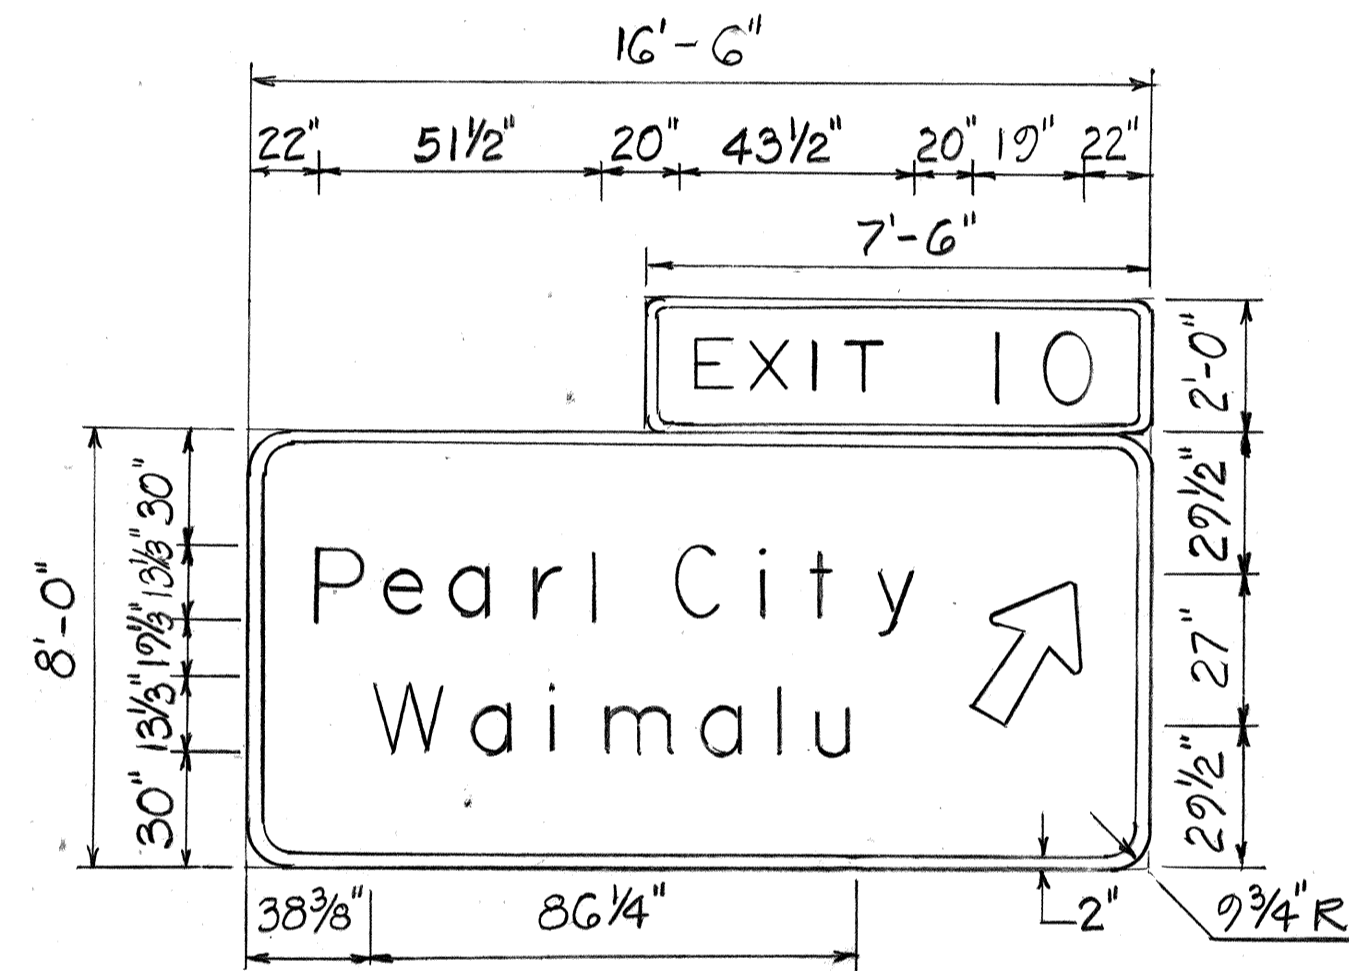

OVERLAY
 Sta. 95+60± LT.
 N.T.S.

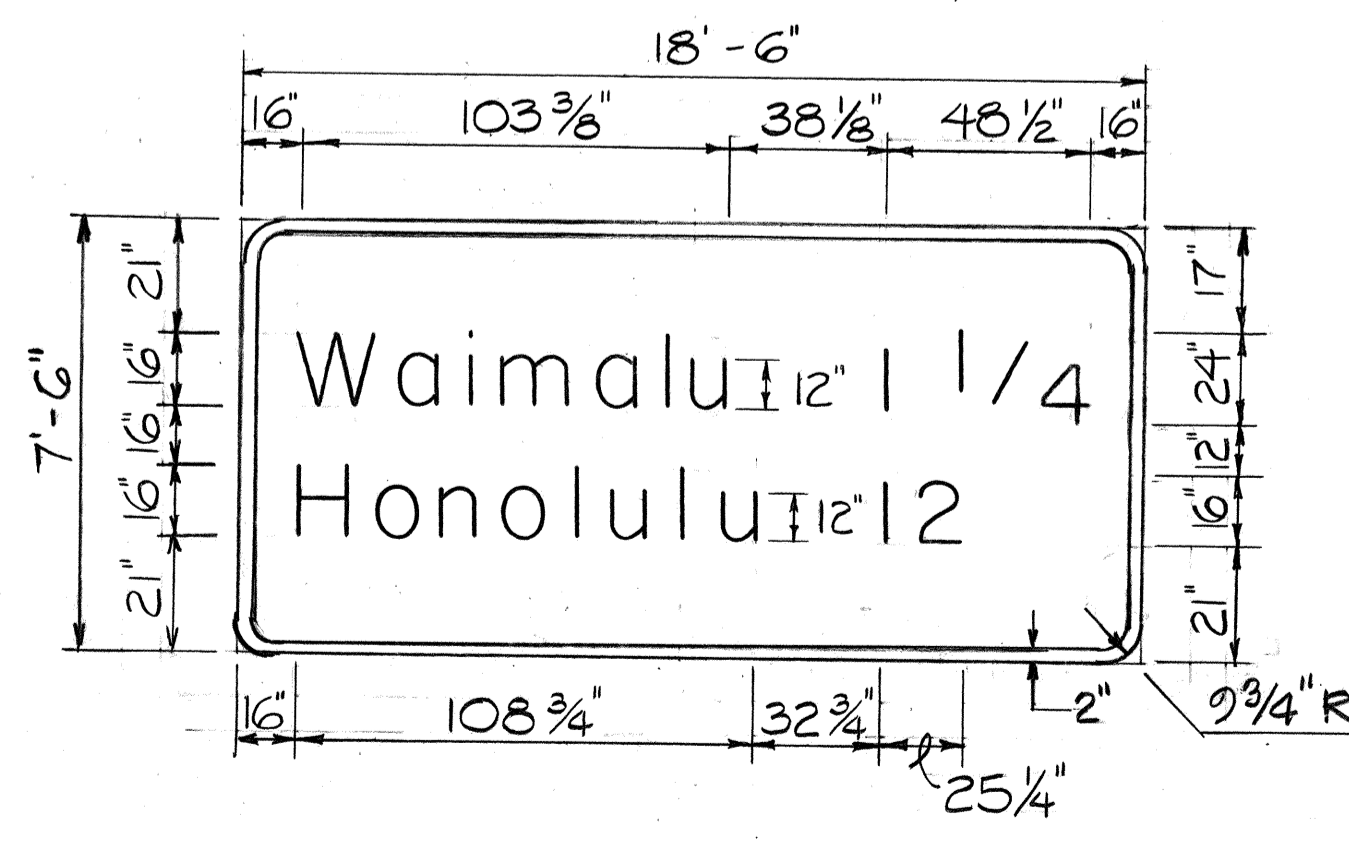

NEW
 Sta. 527+75± RT.
 N.T.S.

SIGNING SCHEDULE		
STA.	SIGN	DESCRIPTION OF WORK
527+75± Median	RM-4's	Install RM-4 on Structure No. 1 piers facing Inbound and Outbound Direction.
527+75± Rt.	Waimalu Honolulu	Remove Exist. Sign Supports and Footings. Install New Sign on Waiawa Rd. Overpass.
33+63± Rt.	Pearlridge Waimalu 1/2 MILE	Refurbish Exist. Expressway and Exit No. Sign w/Overlay Panels.
58+70± Rt.	Pearlridge Waimalu NEXT RIGHT	Refurbish Exist. Expressway and Exit No. Sign w/Overlay Panels.
75+60± Lt.	Pearl City Waimalu ↗	Refurbish Exist. Expressway and Exit No. Sign w/Overlay Panels.
75+60± Median	RM-4's	Install RM-4 on Kaahumanu Overpass Structure piers facing Inbound and Outbound Direction.
102+00 Lt.	Pearl City Waimalu ↗	Refurbish Exist. Expressway and Exit No. Sign w/Overlay Panels.
139+00 Median	RM-4's	Install RM-4 on Kaonohi Overpass Structure piers facing Inbound and Outbound Direction.
Kaonohi, Kaamilo, and Aiea Hts Rd. overpasses, inbound	Expressway signs, Exit no. panels	Refurbish Exist. Expressway and Exit no. Signs w/Overlay Panels.

SURVEY PLOTTED BY: _____ DATE: _____
 DRAWN BY: _____
 DESIGNED BY: _____
 QUANTITIES BY: _____
 CHECKED BY: _____
 ORIGINAL PLAN NOTE BOOK NO. _____


6/1/86	Revised overlay panel Messages. Added Signing Notes. Added Exit Number Signs. Revised Signing Schedule.
DATE	REVISION

STATE OF HAWAII
 DEPARTMENT OF TRANSPORTATION
 HIGHWAYS DIVISION
SIGNING DETAILS, NOTES
 AND SCHEDULE
 ADDITIONAL LANES
 INTERSTATE ROUTE H-1
 F.A.I. PROJ. NO. IR-HI-1(193)
 Scale: As Noted Sept. 1985
SHEET No. 71 OF 19 SHEETS


FED. ROAD DIST. NO.	STATE	FED. AID PROJ. NO.	FISCAL YEAR	SHEET NO.	TOTAL SHEETS
HAWAII	HAW.	IR-HI-1 (193)	1986	38	62

CARPOOL LANE SIGNING


STA.	INB.	OUTB.	SIGN
H-2	471+20±	LT. INB.	R3-10
"	477+45±	LT. INB.	R3-10A
H-1	502+00±	LT. INB.	R3-10
	512+00±	LT. INB.	R3-20A
	520+00±	LT. INB.	R3-10A
	528+25±	INB. (Waiawa Rd. OP)	R3-11A
	9+00±	INB.	R3-20A
	19+00±	"	R3-10A
	29+00±	"	R3-20A
	39+00±	"	R3-10A
	49+00±	"	R3-20A
	59+00±	"	R3-10A
	69+00±	"	R3-20A
	79+00±	"	R3-10A
	89+00±	"	R3-20A
	89+00±	OUTB.	R3-12
	95+00±	INB. & OUTB. (Kaahumanu St. OP)	R3-11A
	105+00±	INB. & OUTB.	R3-20A
	115+00±	" # #	R3-10A
	125+00±	" # #	R3-20A
	139+00±	INB. & OUTB. (Kaonohi St. OP)	R3-11A
	150+00±	INB. & OUTB.	R3-20A
	160+00±	" # #	R3-10A
	172+50±	" # # (Kaamilo St. OP)	R3-11A
	181+50±	INB. & OUTB. (Mahiko Pedestrian OP)	R3-11A
	192+00±	INB. & OUTB. (Aiea Hts. Dr. OP)	R3-11A
	204+50±	INB. & OUTB. (Kaimakani St. OP)	R3-11A
	215+00±	INB. & OUTB.	R3-20A
	221+00±	" # (Moanalua Rd. OP)	R3-11A
	229+50±	INB. & OUTB. (Ramp WE OP)	R3-11A

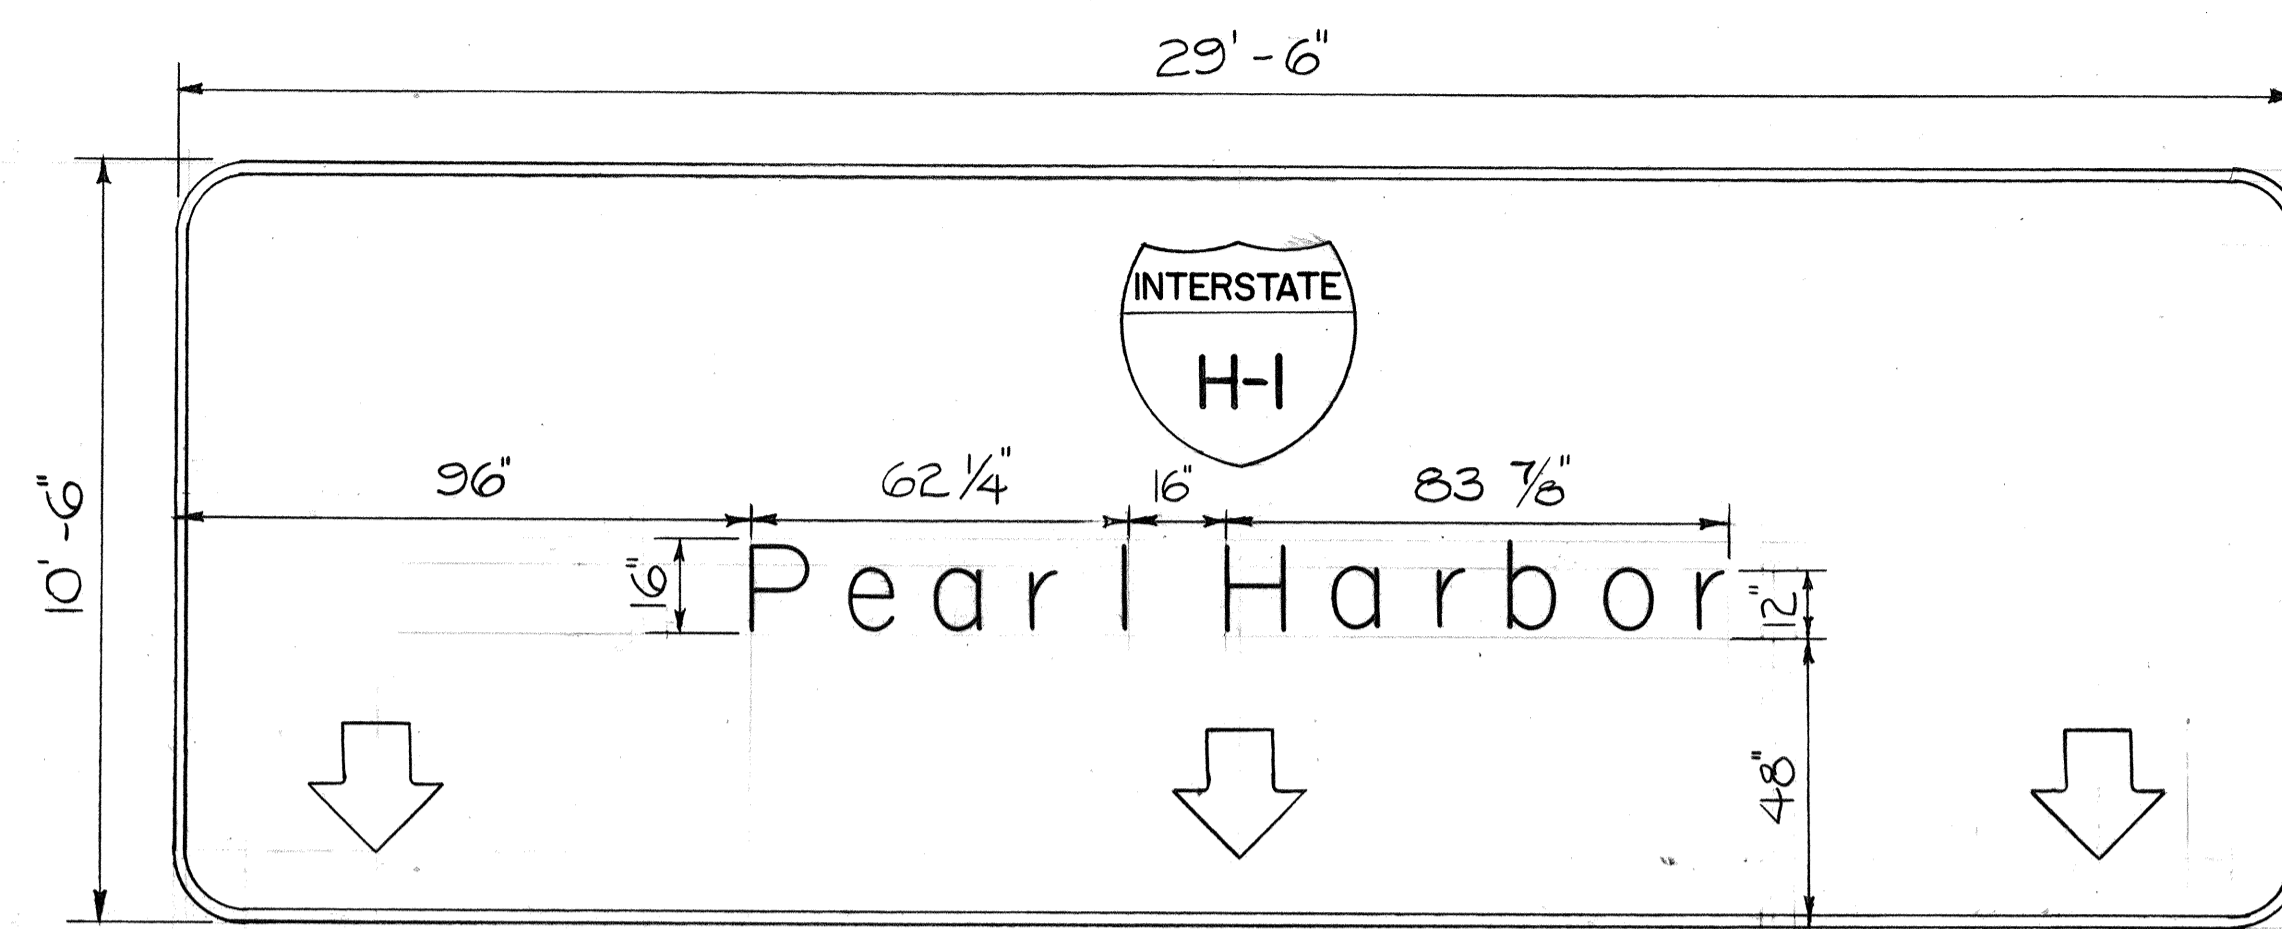


KAONOHI O.P. INB. OVERLAY PANELS

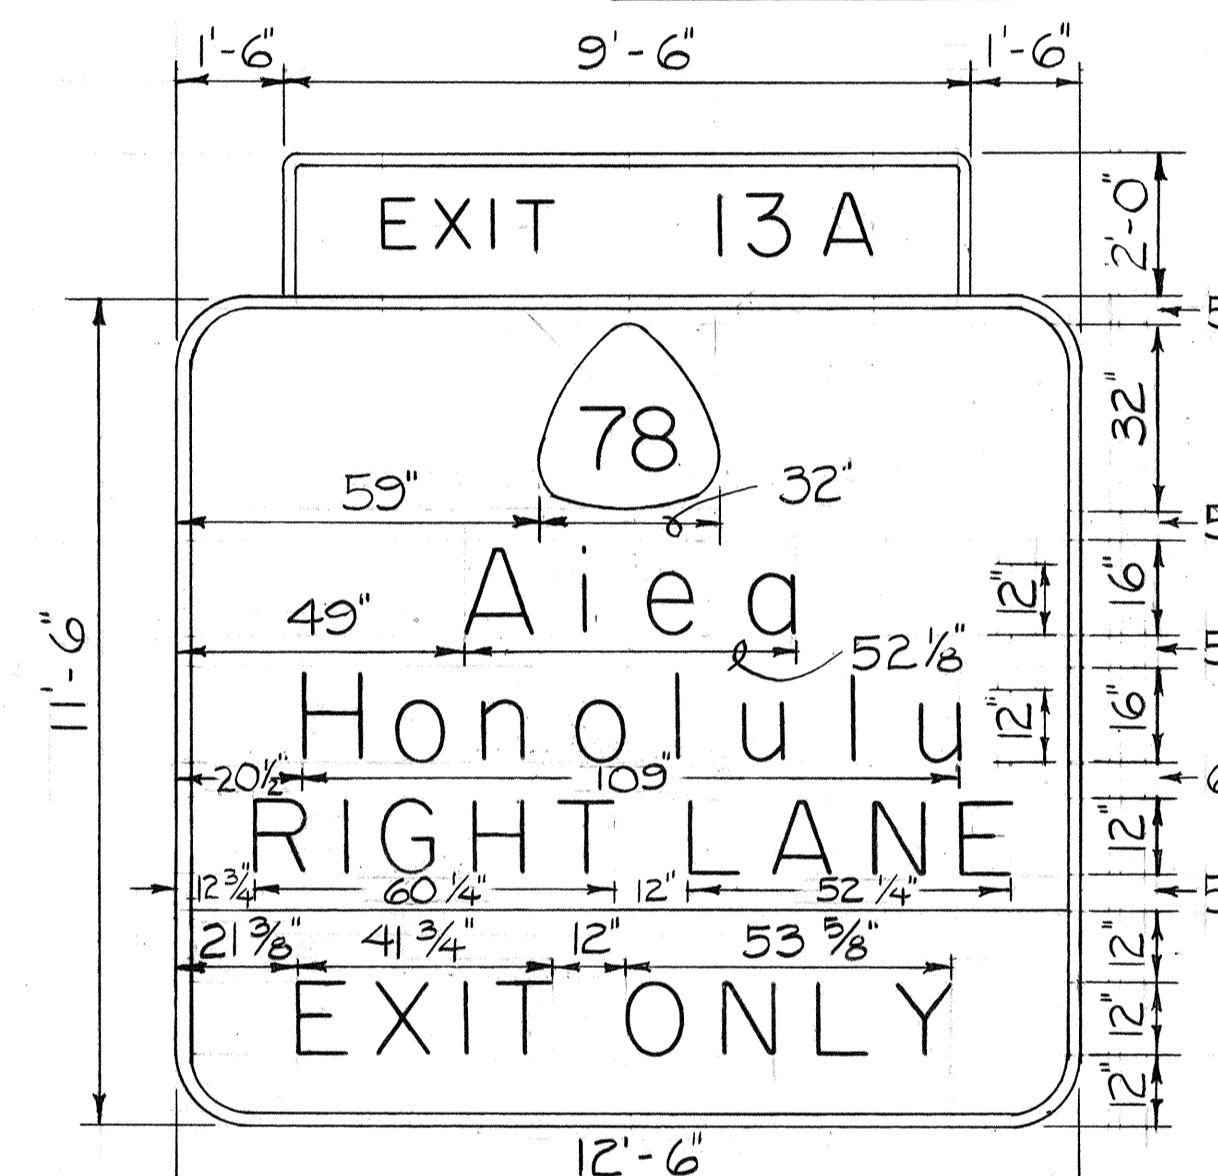


KAAMILO O.P. INB. OVERLAY PANELS

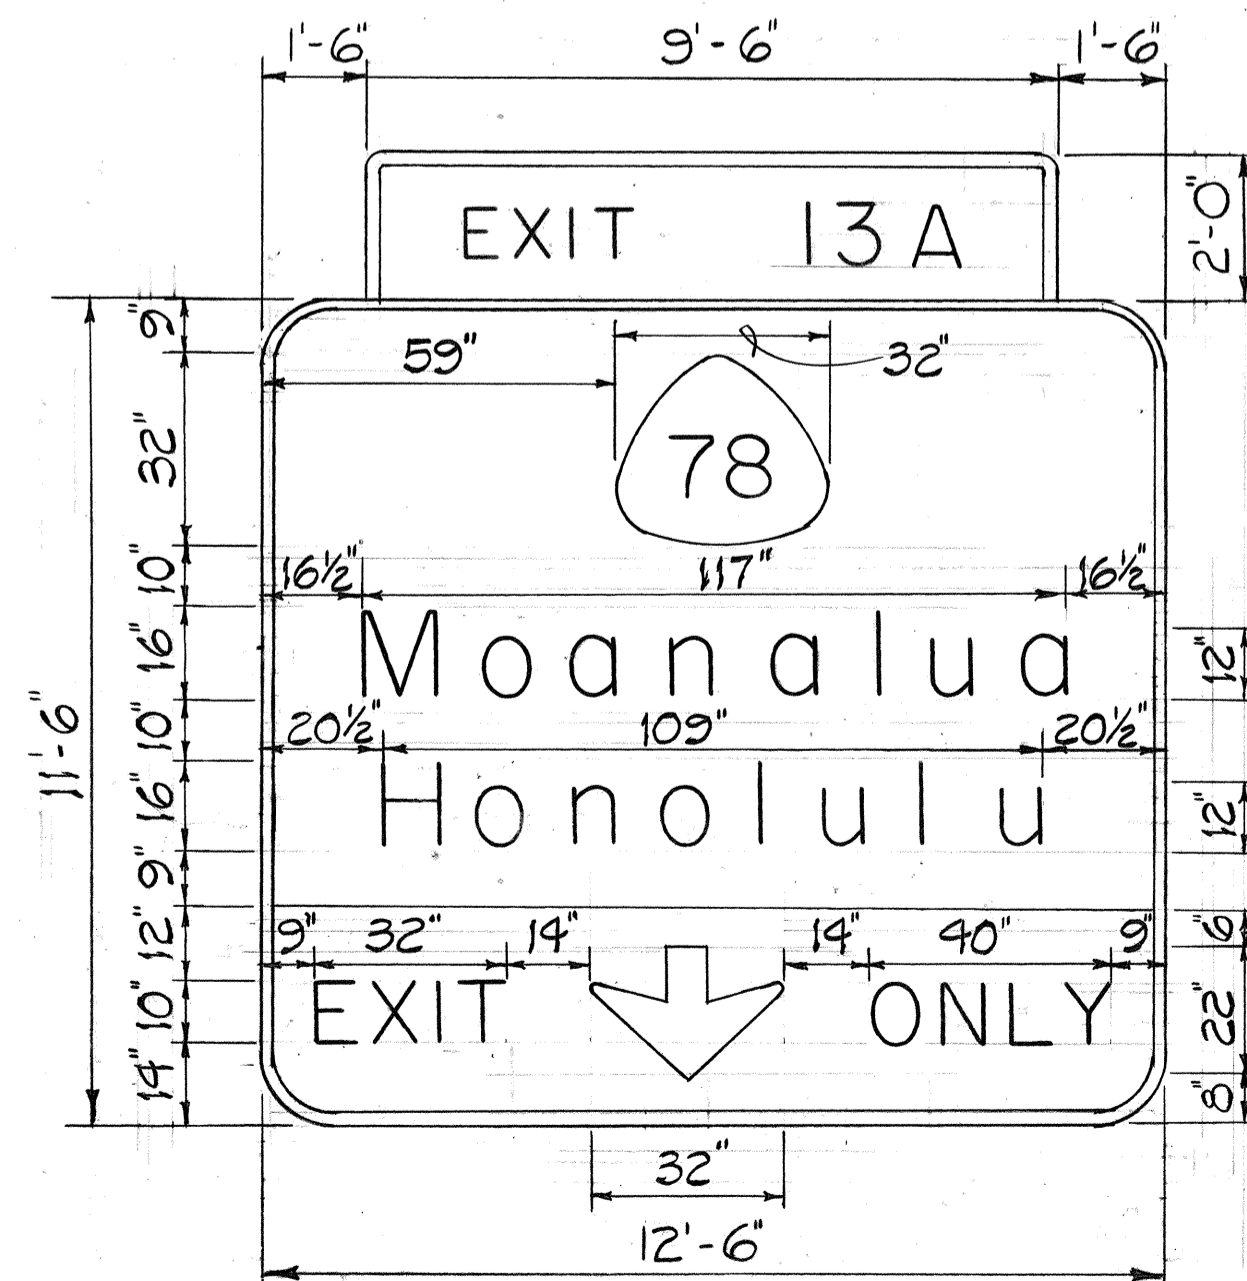

AIEA HTS. RD O.P. INB. OVERLAY PANELS

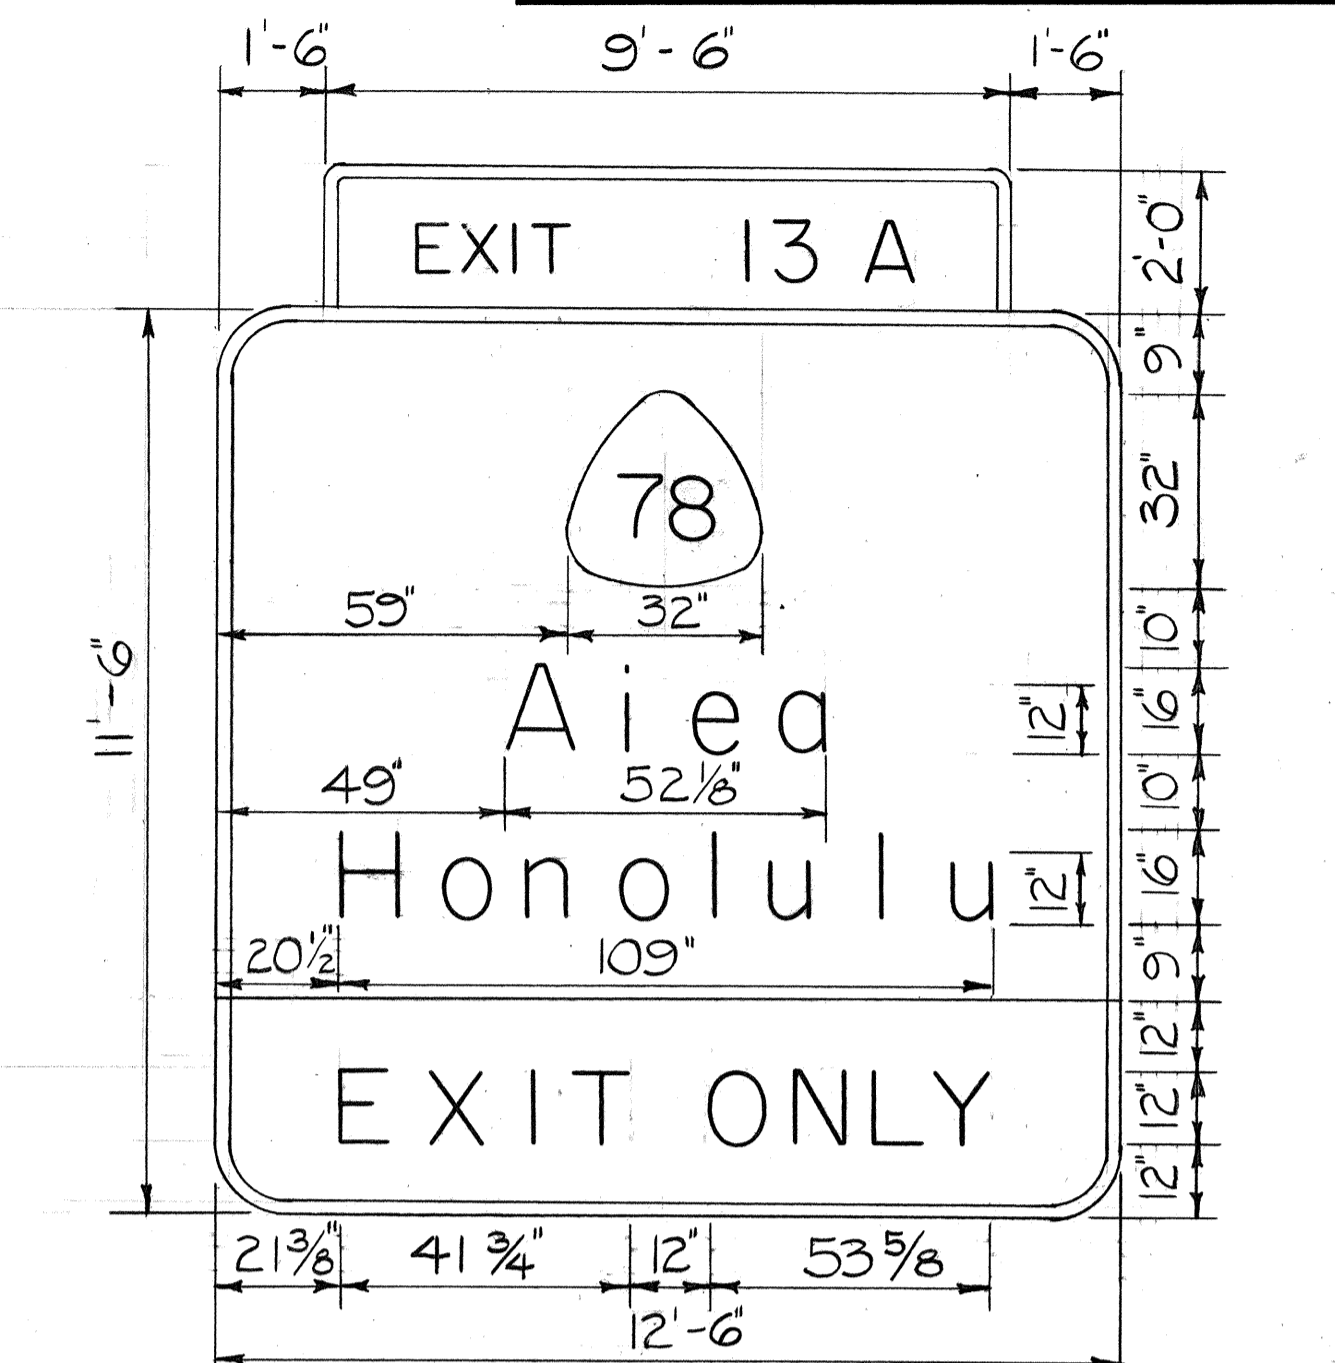

KAONOHI O.P. INB. OVERLAY PANELS



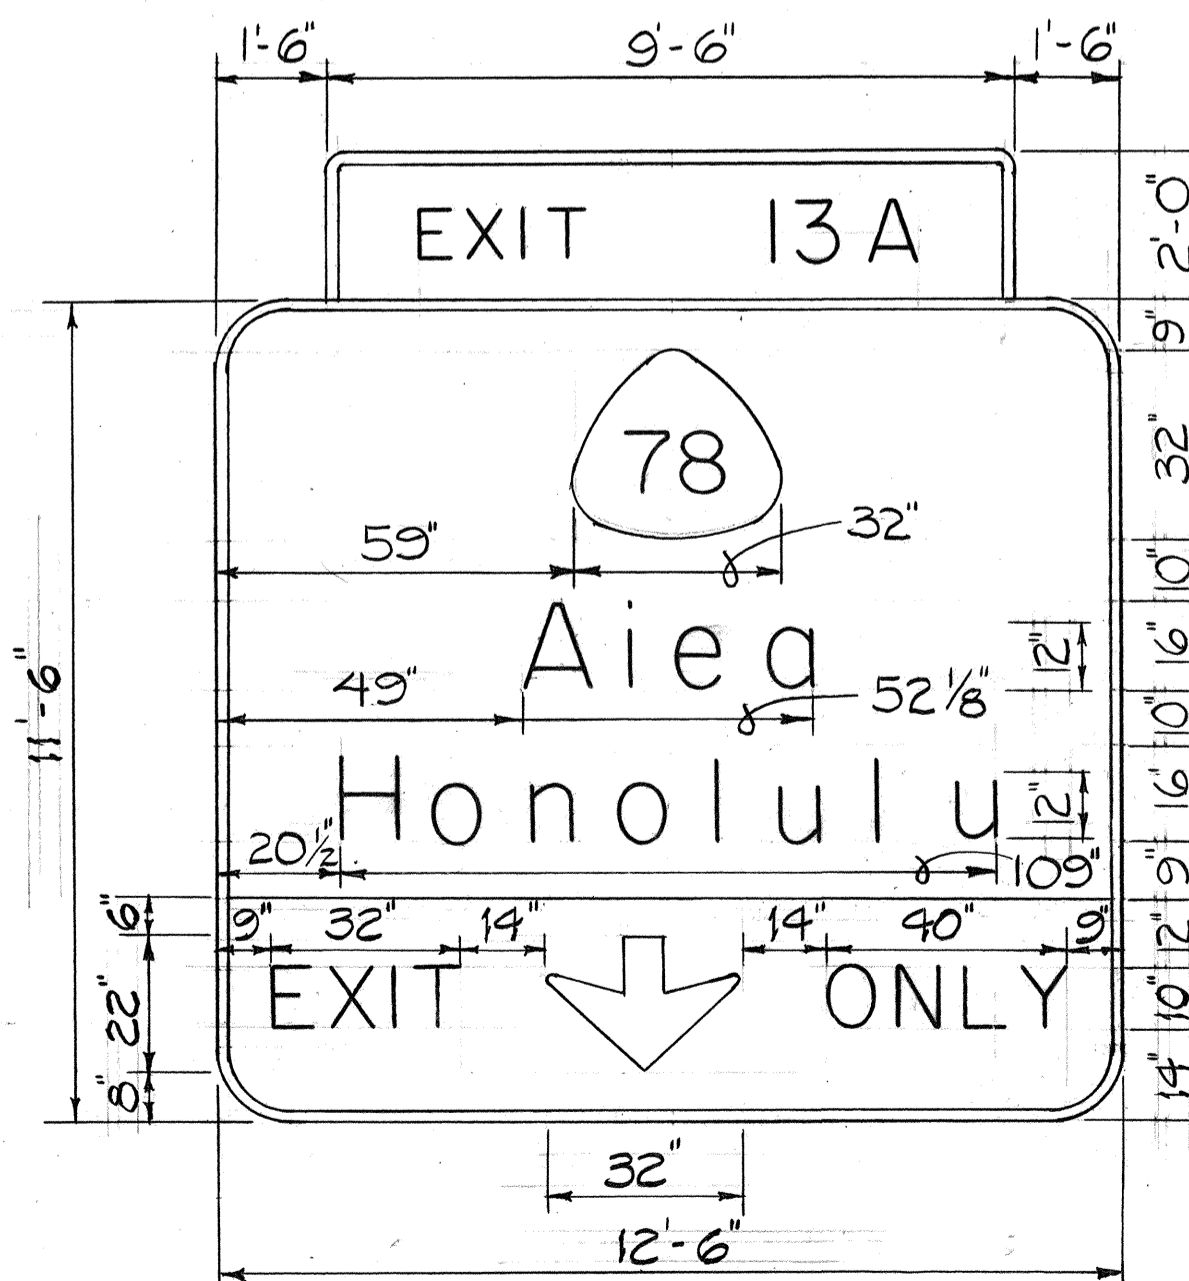


SURVEY PLOTTED BY _____ DATE _____
 DRAWN BY _____
 DESIGNED BY _____
 CHECKED BY _____
 ORIGINAL PLAN _____
 NOTE BOOK _____
 No. _____





Date	Revision
11/13/87	Revised Aiea Hts. Rd. O.P. Inb. Panels Message.
8/22/86	Expressway sign details added.
7/1/86	This Sheet added.

STATE OF HAWAII
 DEPARTMENT OF TRANSPORTATION
 HIGHWAYS DIVISION
SIGNING DETAILS AND SCHEDULE
 INTERSTATE ROUTE H-1
 ADDITIONAL LANES
 FAI PROJ. NO. IR-HI-1(193)
 Scale: 3/8" = 1'-0" Date: July, 1985

FED. ROAD DIST. NO.	STATE	FED. AID PROJ. NO.	FISCAL YEAR	SHEET NO.	TOTAL SHEETS
HAWAII	HAW.	IR-HI-1(193)	1986	38	62

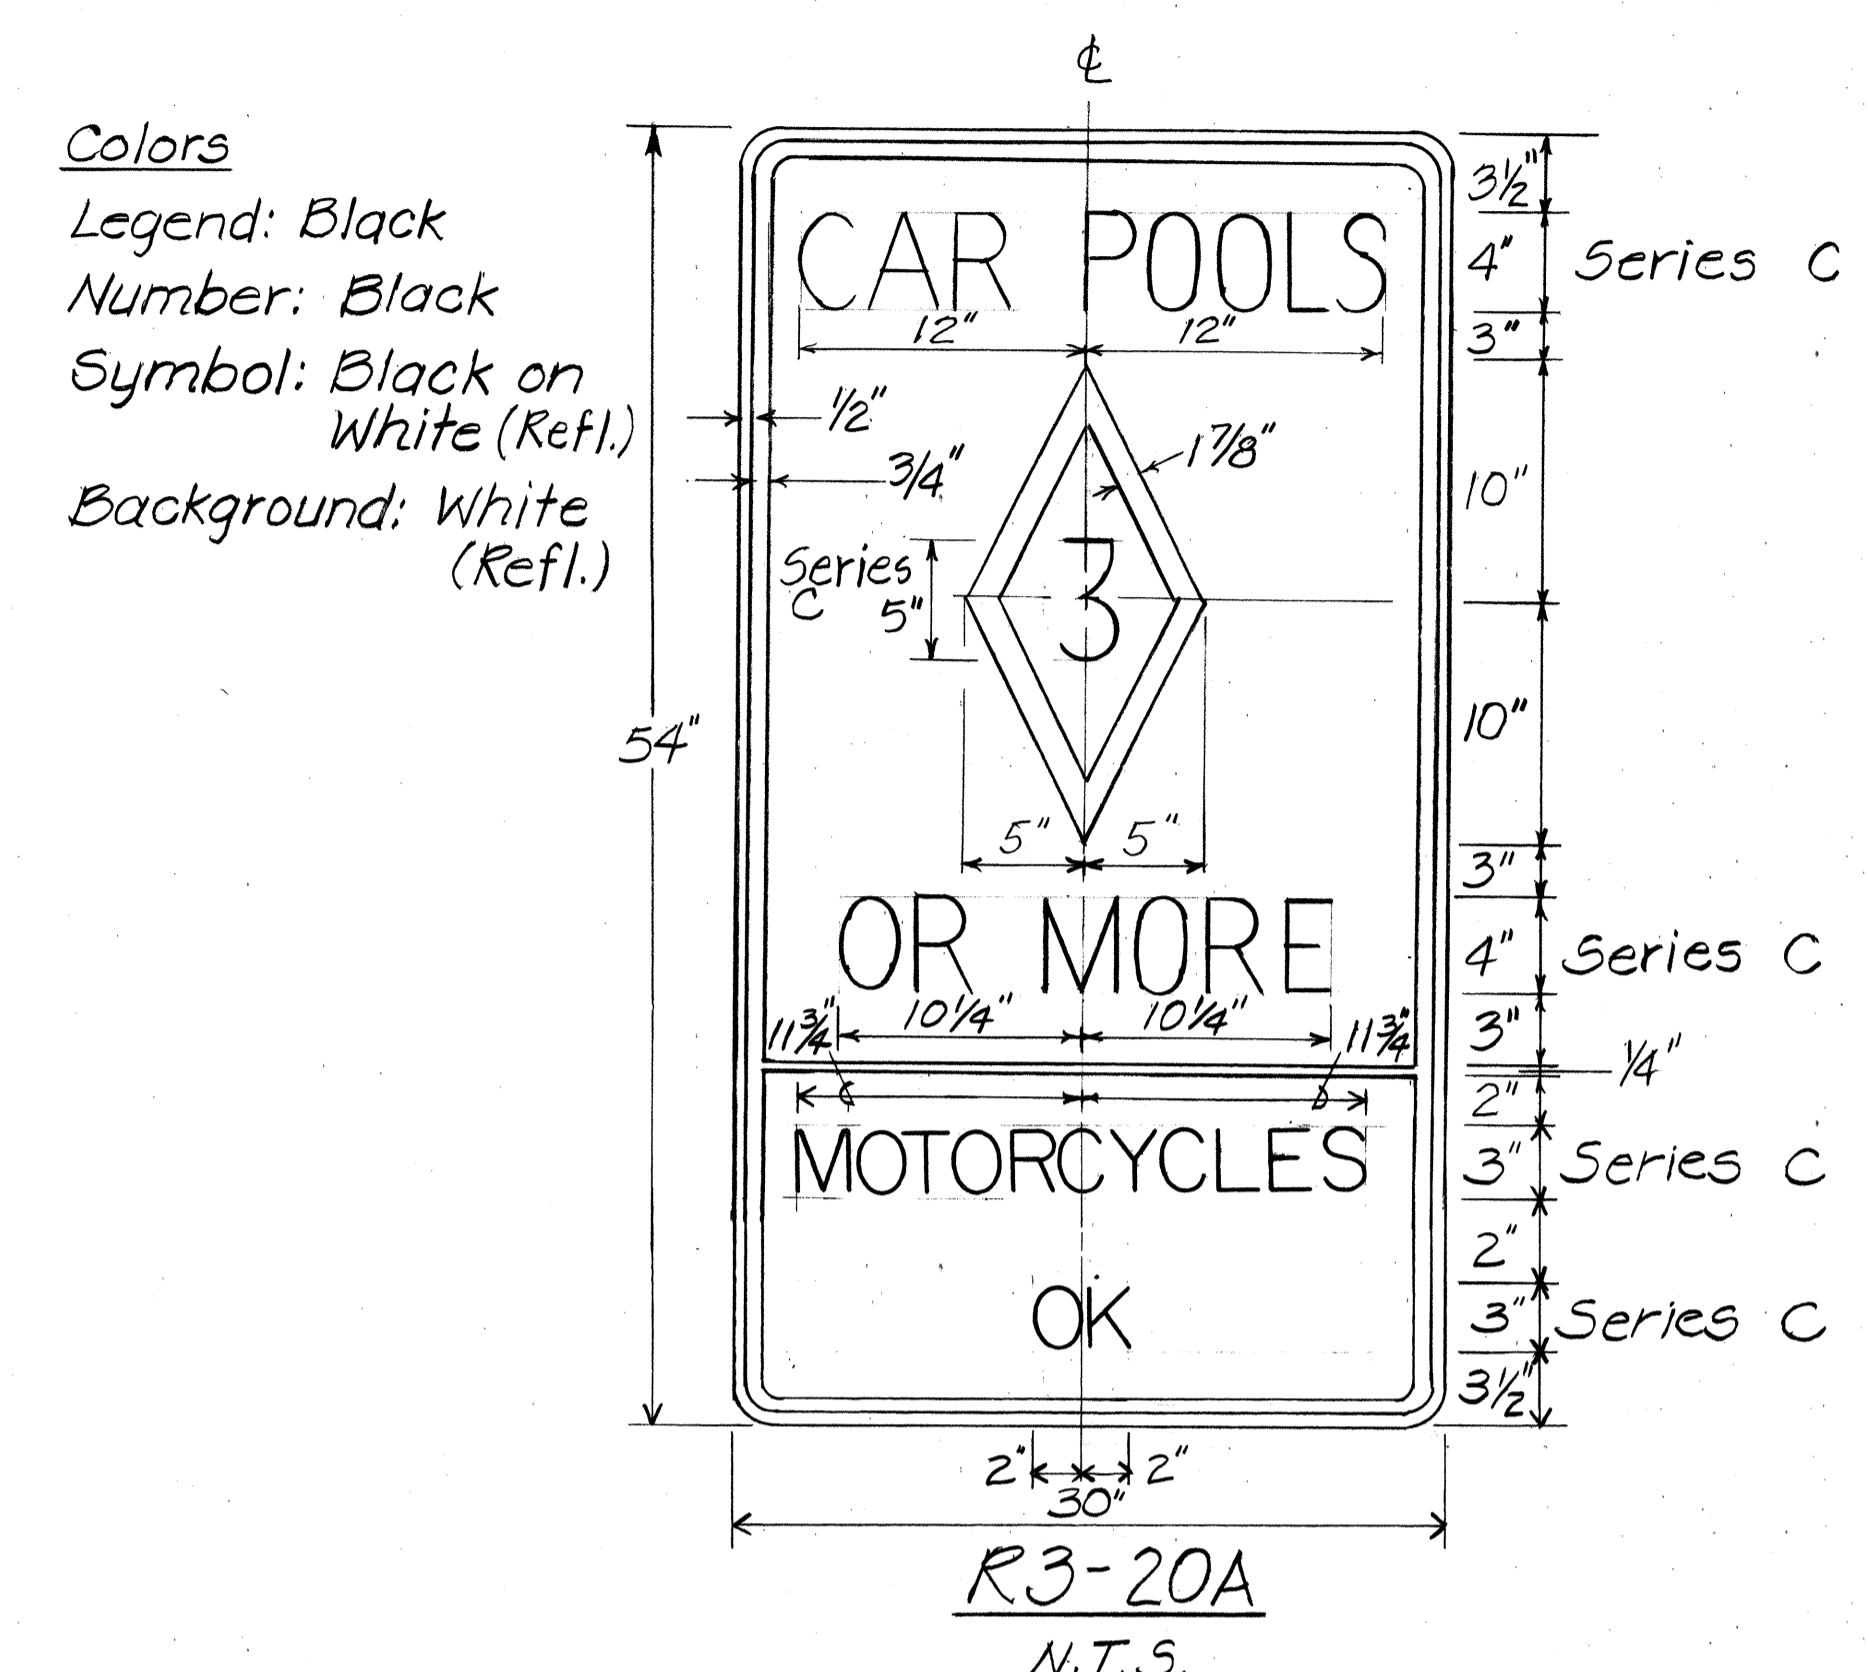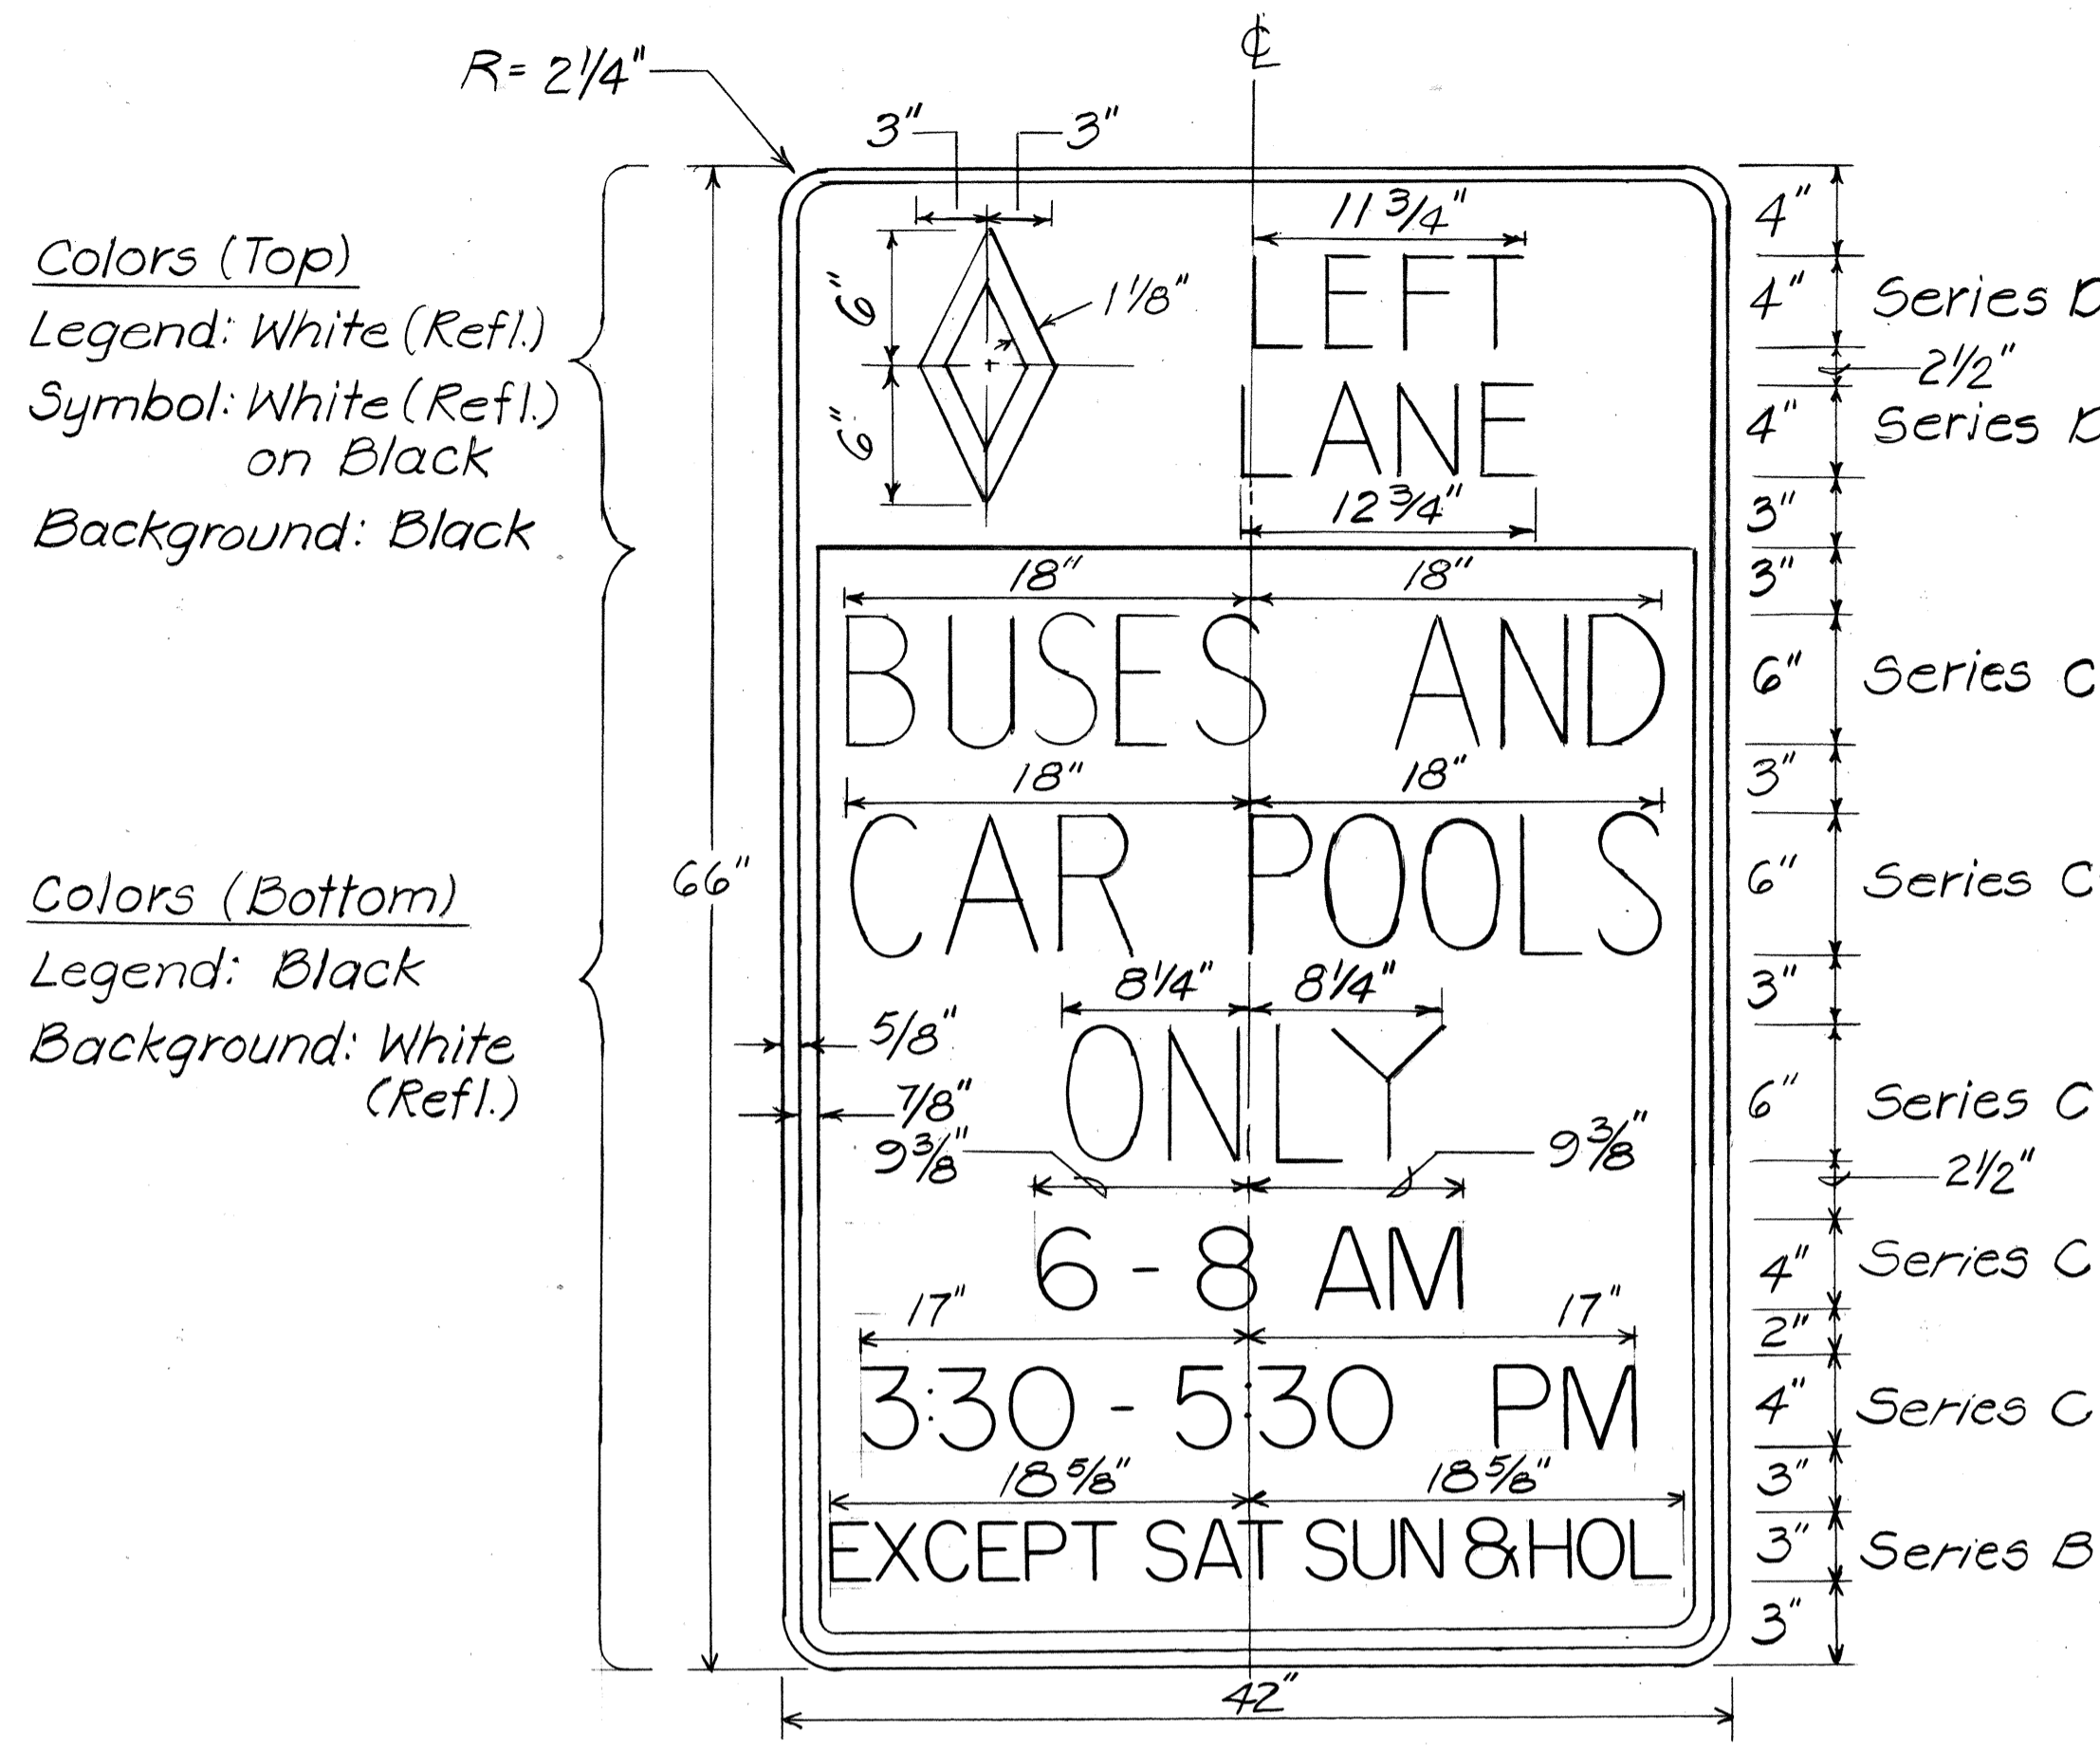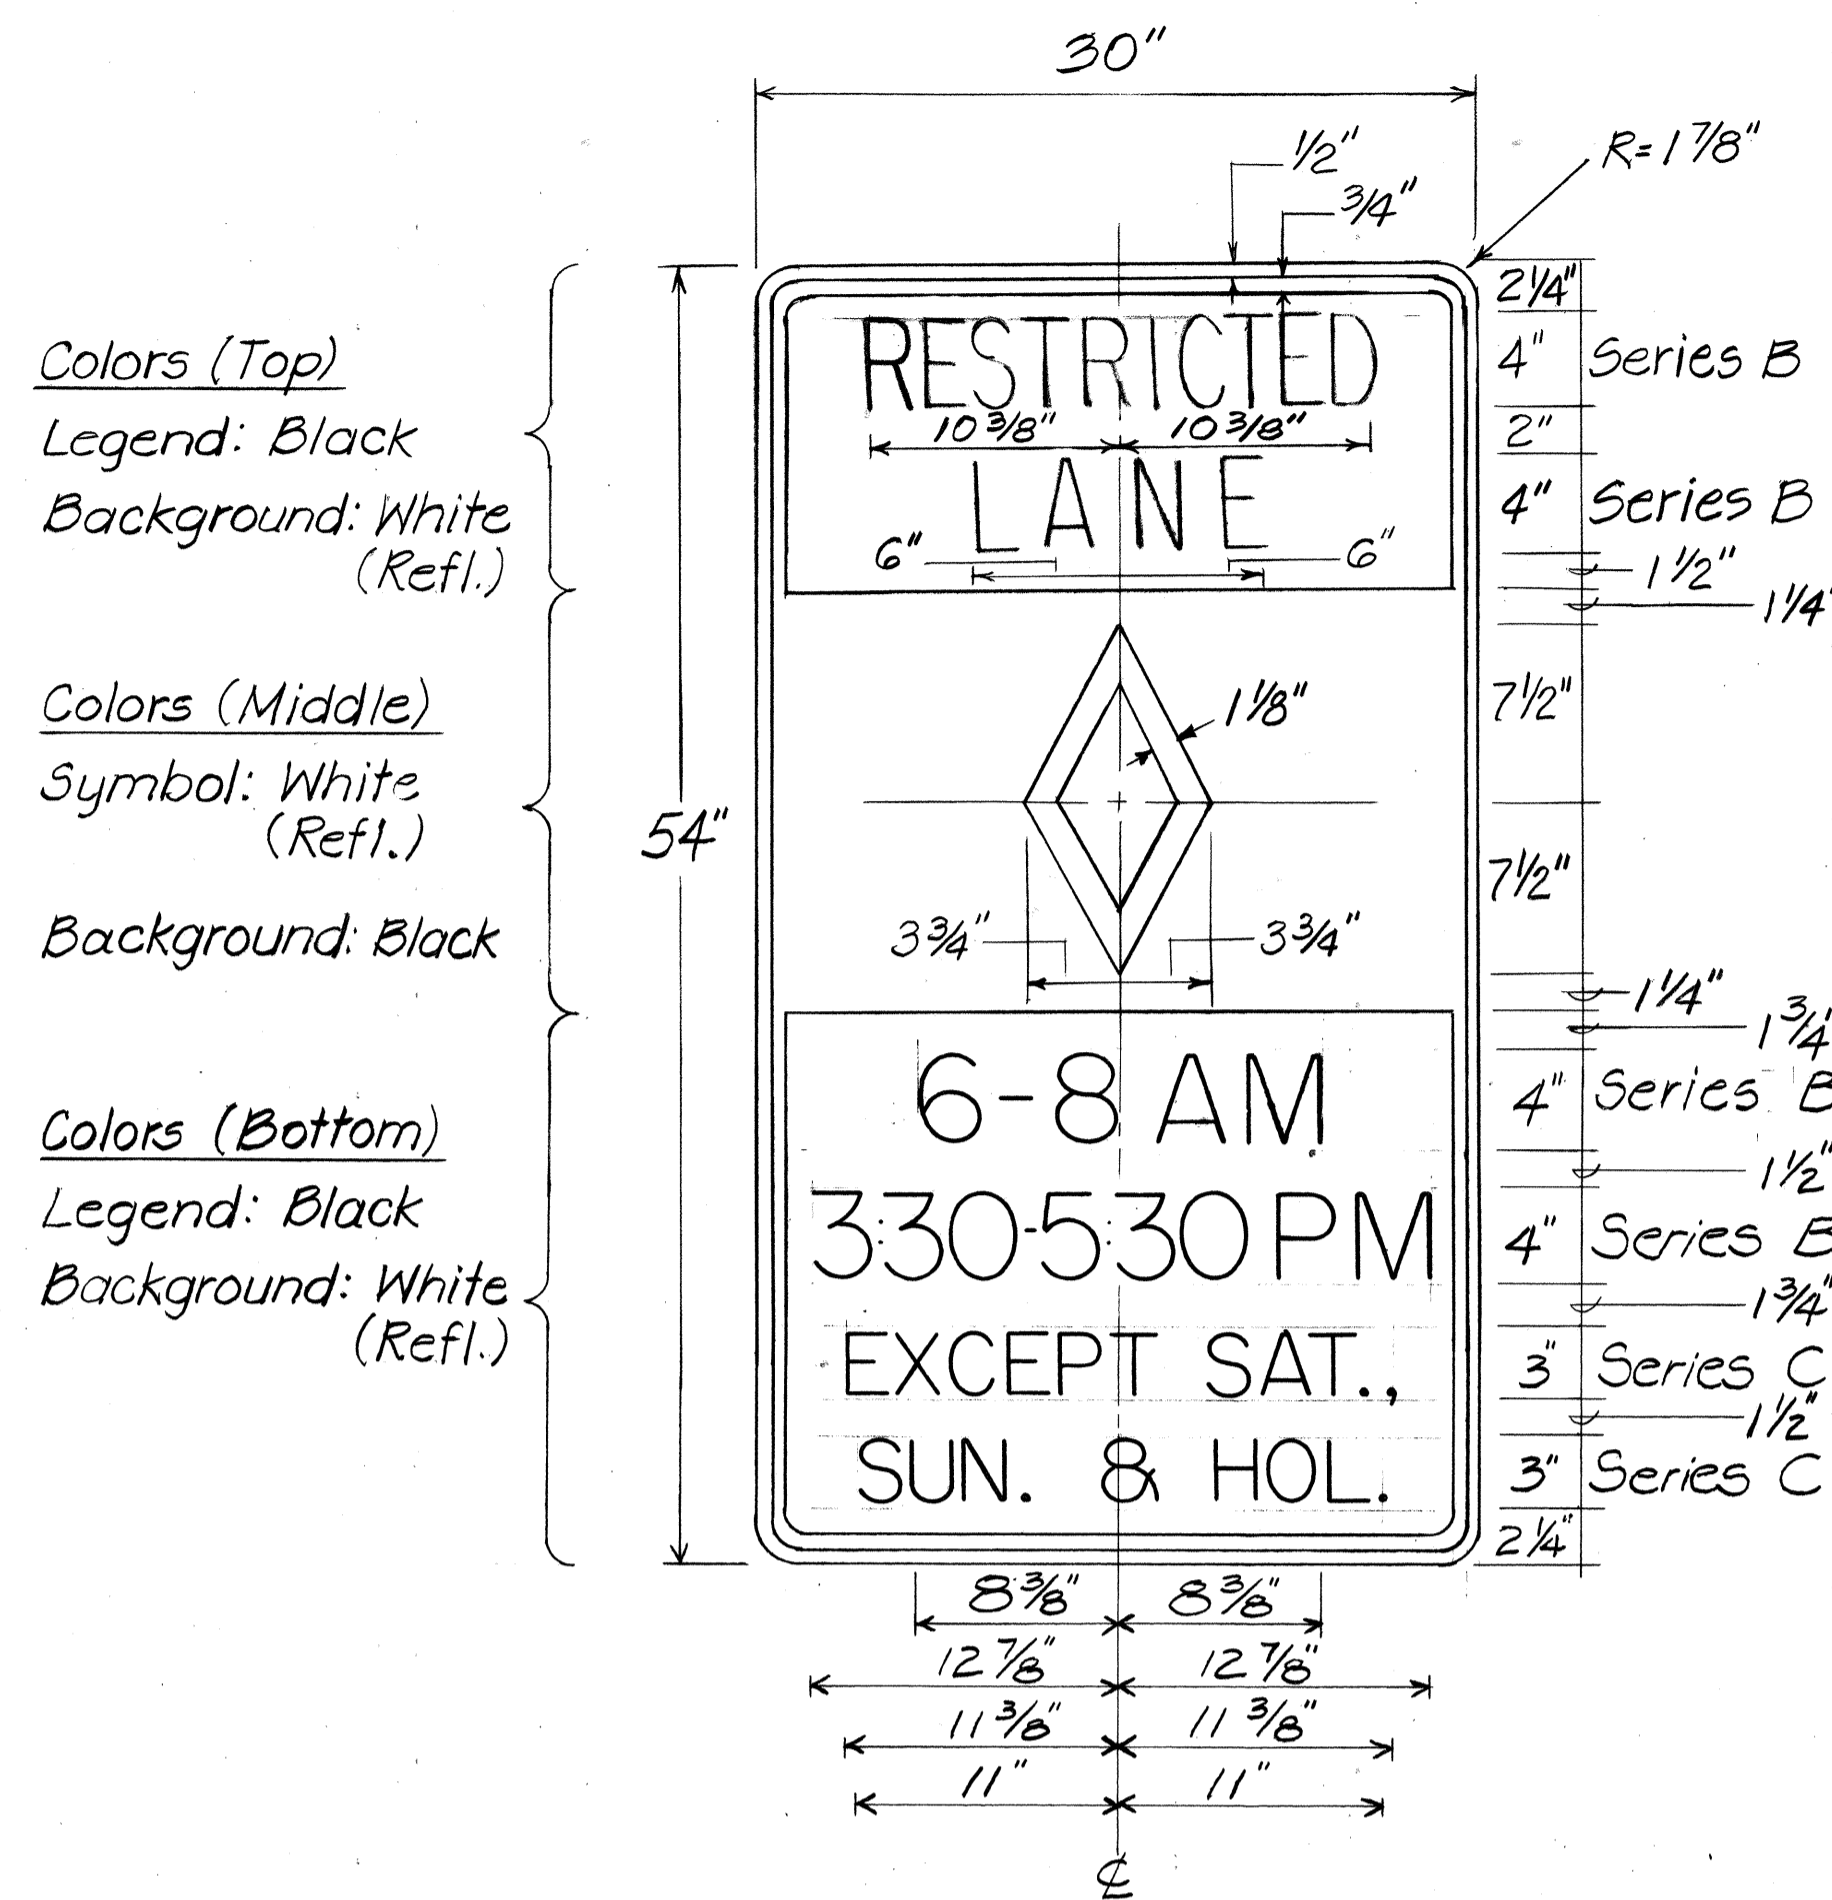

4" O.D. Galv. Pipe Post welded to Base Plate before installation

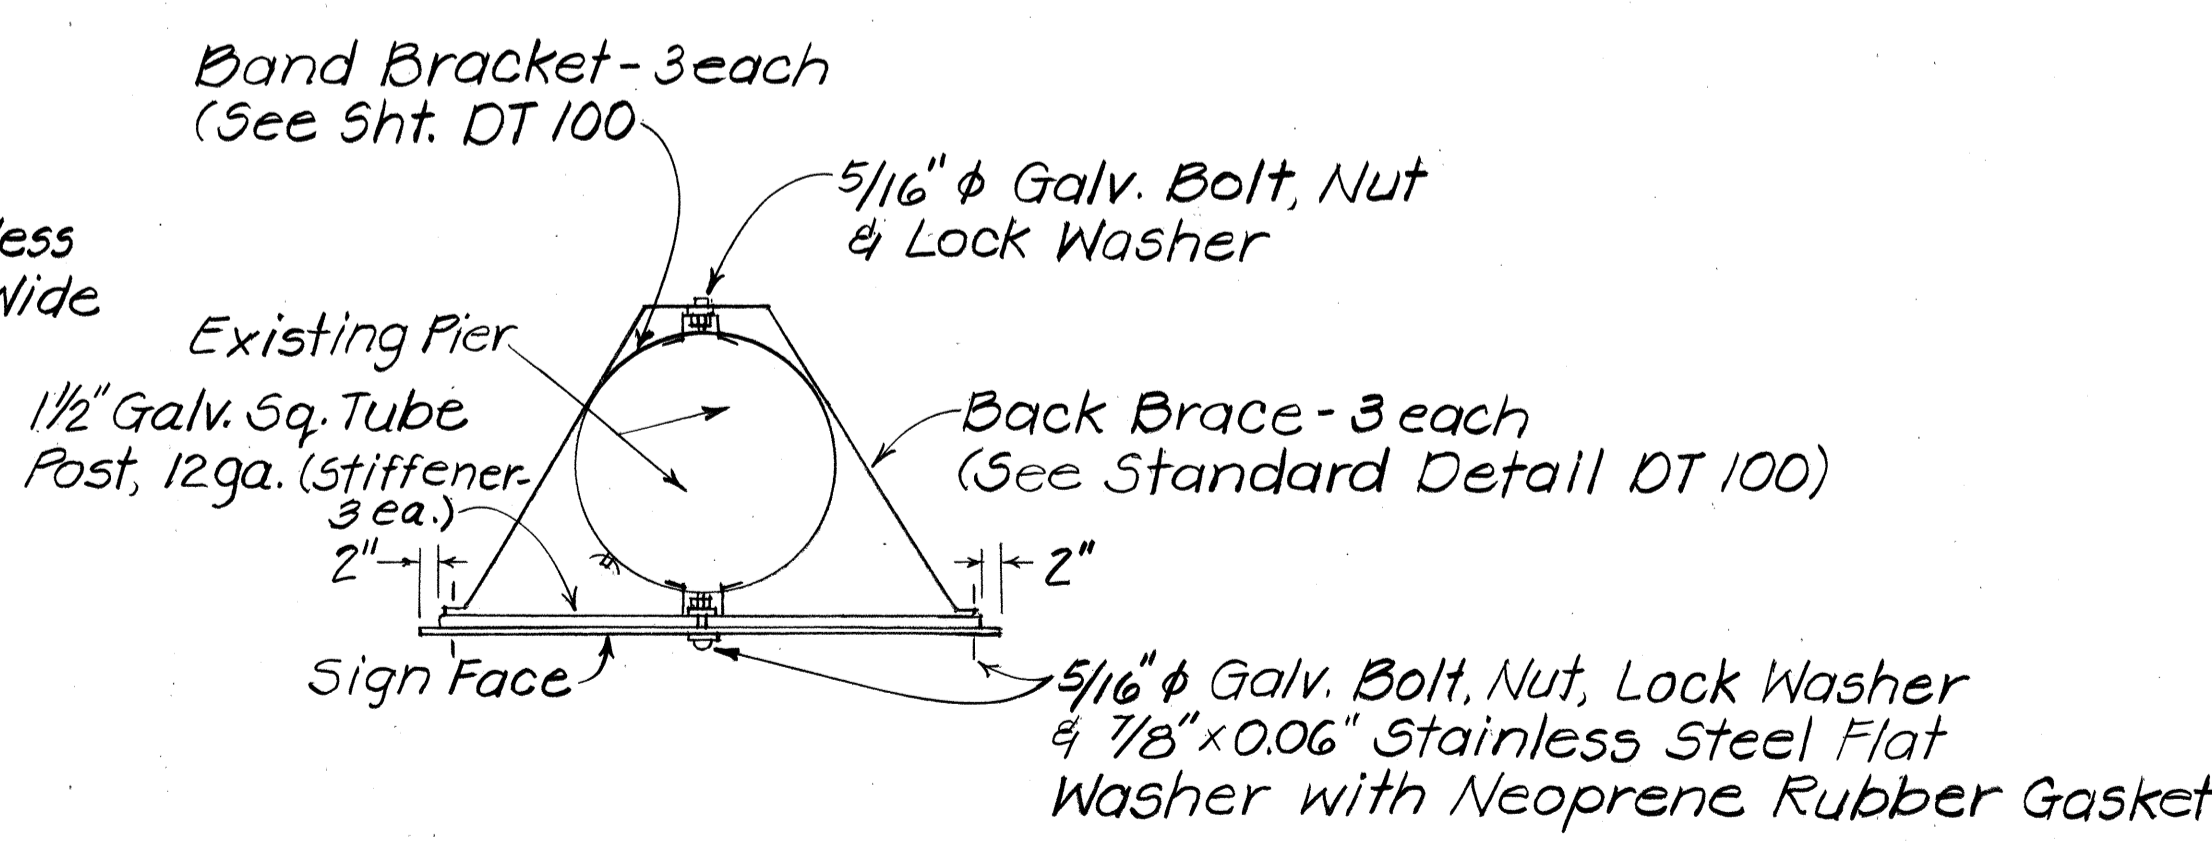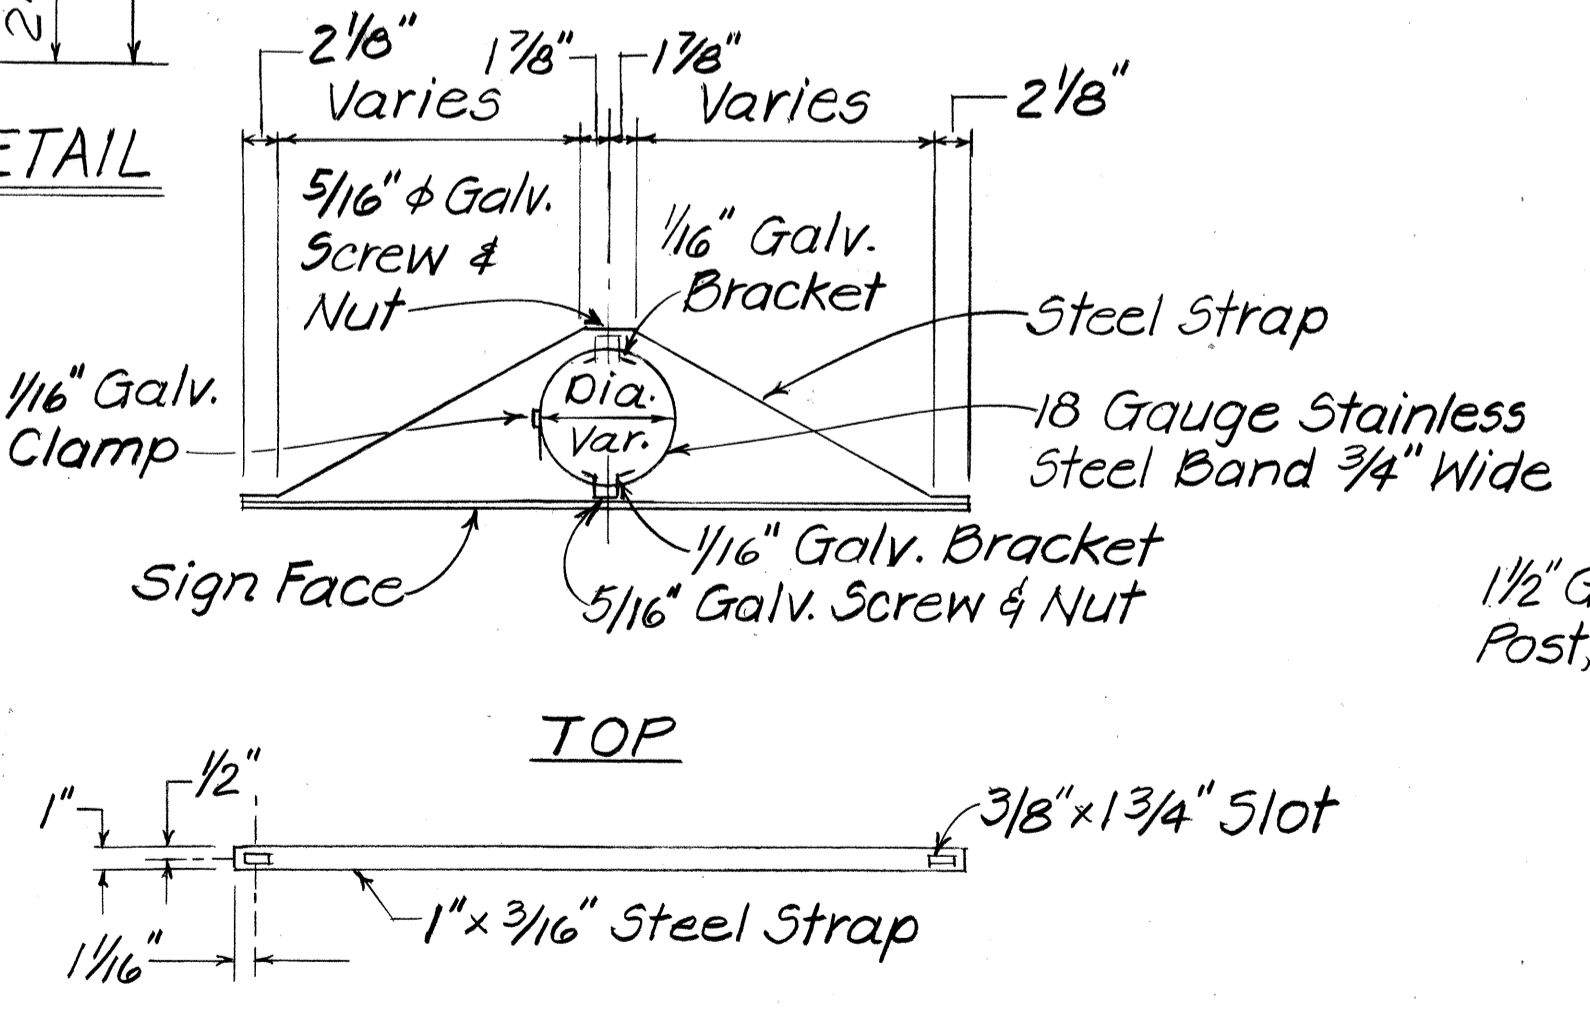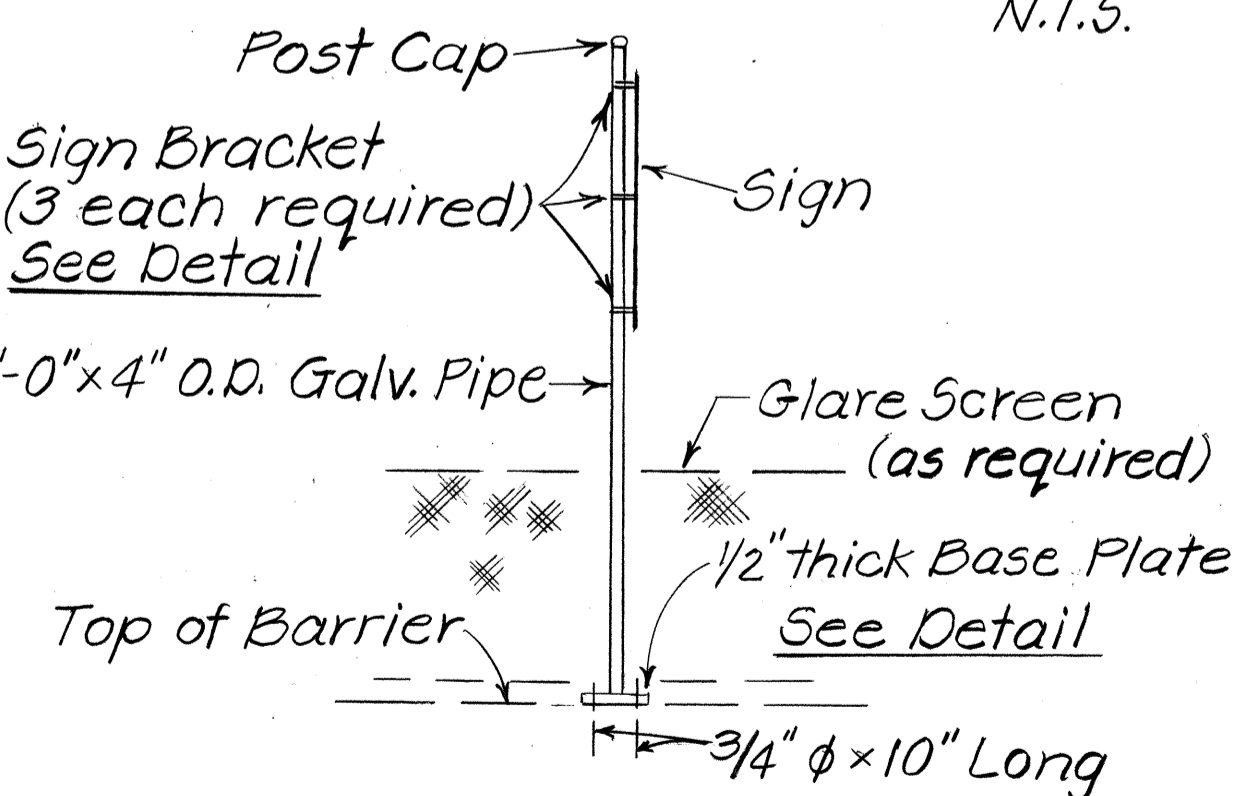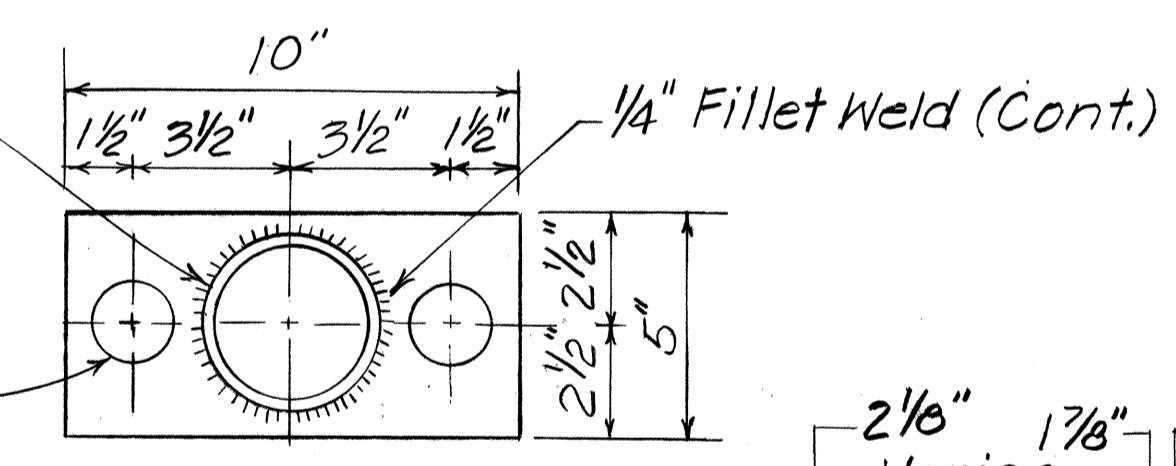

DATE: _____
SURVEY PLOTTED BY: _____
DRAWN BY: _____
DESIGNED BY: _____
CHECKED BY: _____
NO. _____


7/1/86	This Sheet added
Date	Revision

STATE OF HAWAII
DEPARTMENT OF TRANSPORTATION
HIGHWAYS DIVISION

SIGNING NOTES & DETAILS








INTERSTATE ROUTE H-1
ADDITIONAL LANES
FAI PROJ. NO IR-HI-1(193)
Scale: As Shown Date: July, 1985
SHEET NO. OF SHEETS

FED. ROAD DIST. NO.	STATE	FED. AID PROJ. NO.	FISCAL YEAR	SHEET NO.	TOTAL SHEETS
HAWAII	HAW.	13-H-1(193)	1966	38	62

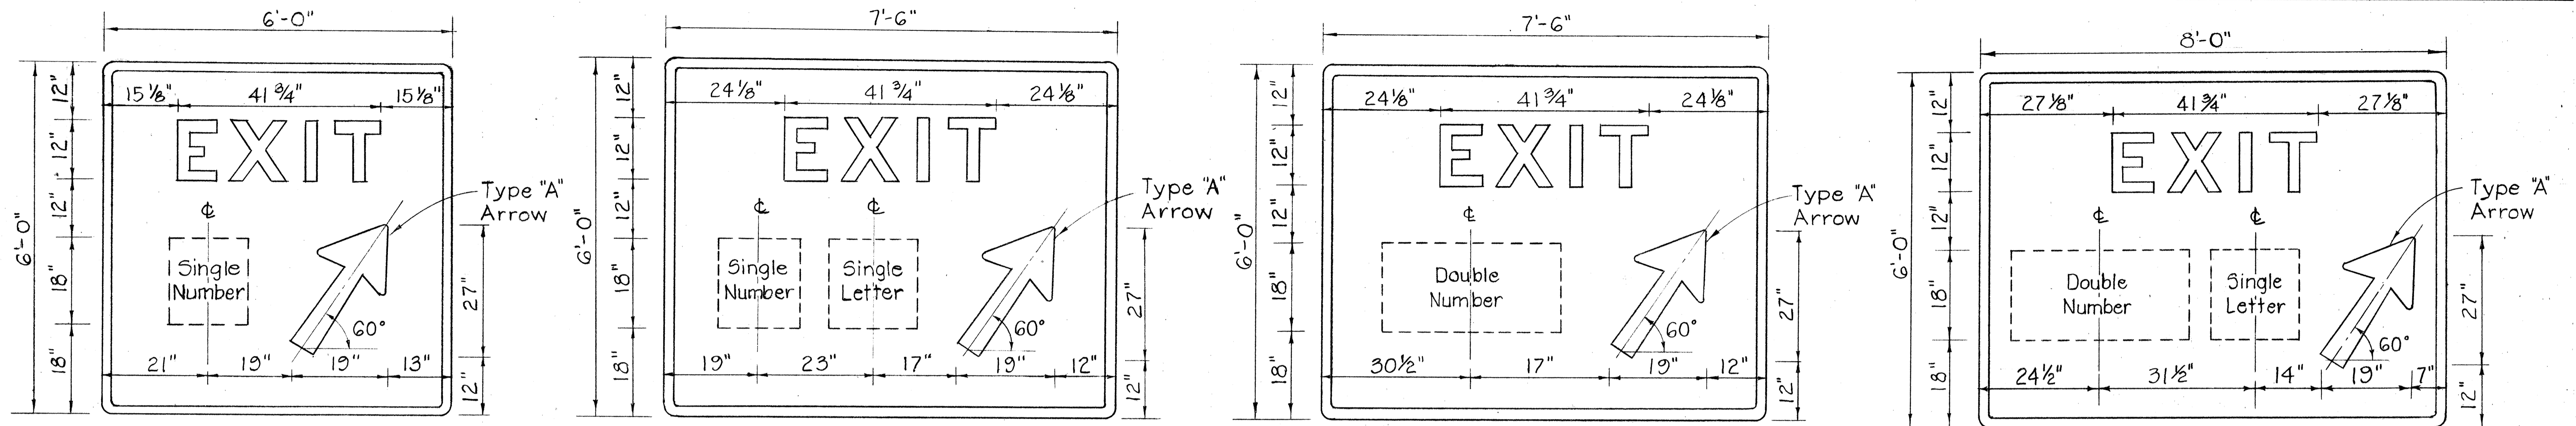

GORE EXIT SIGNS
Scale: 3/4" = 1'-0"

1. Design of Exit Number Panels shall conform to plans and specifications for either the Expressway or Destination Sign to which the Exit Number Panel will be attached.
2. Sign message shall be lettered in uppercase according to Standard Alphabets for Highway Signs, FHWA, 1966. Use Series "E" letters unless otherwise noted.
3. Arrows, Borders, and Route Markers shall conform with details as shown on plans.
4. Contractor shall submit for approval, shop drawings for the attachment of Exit Number Panels to Sign Panels.

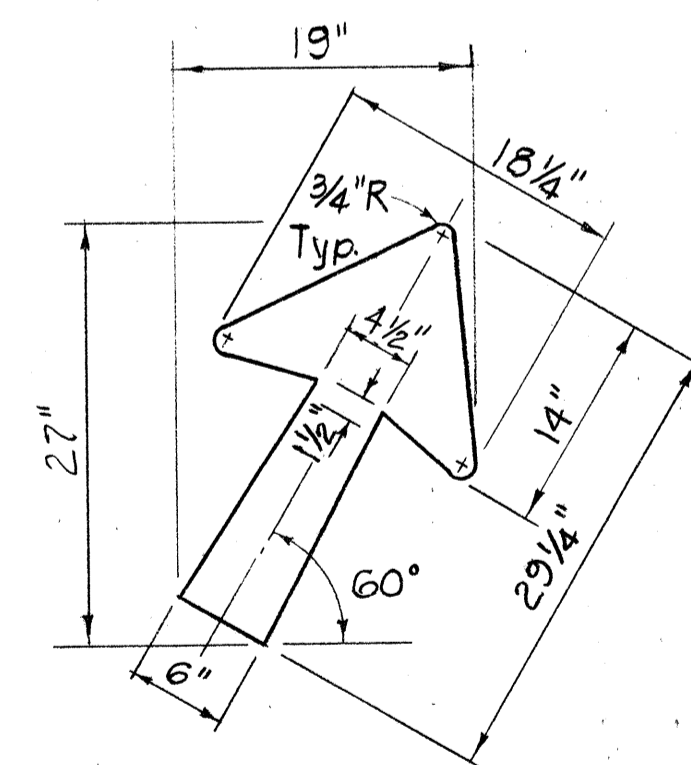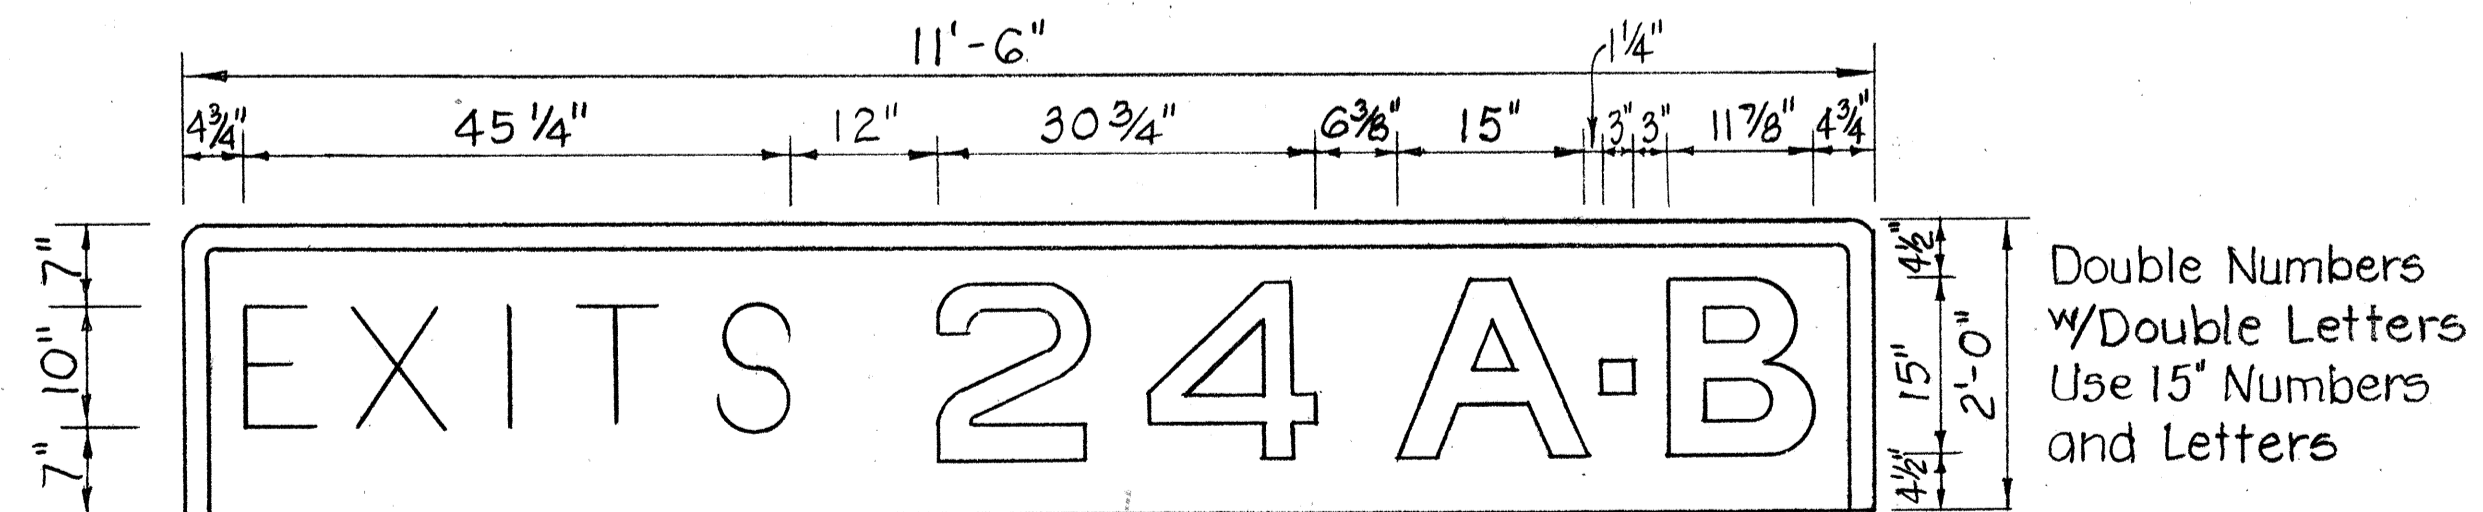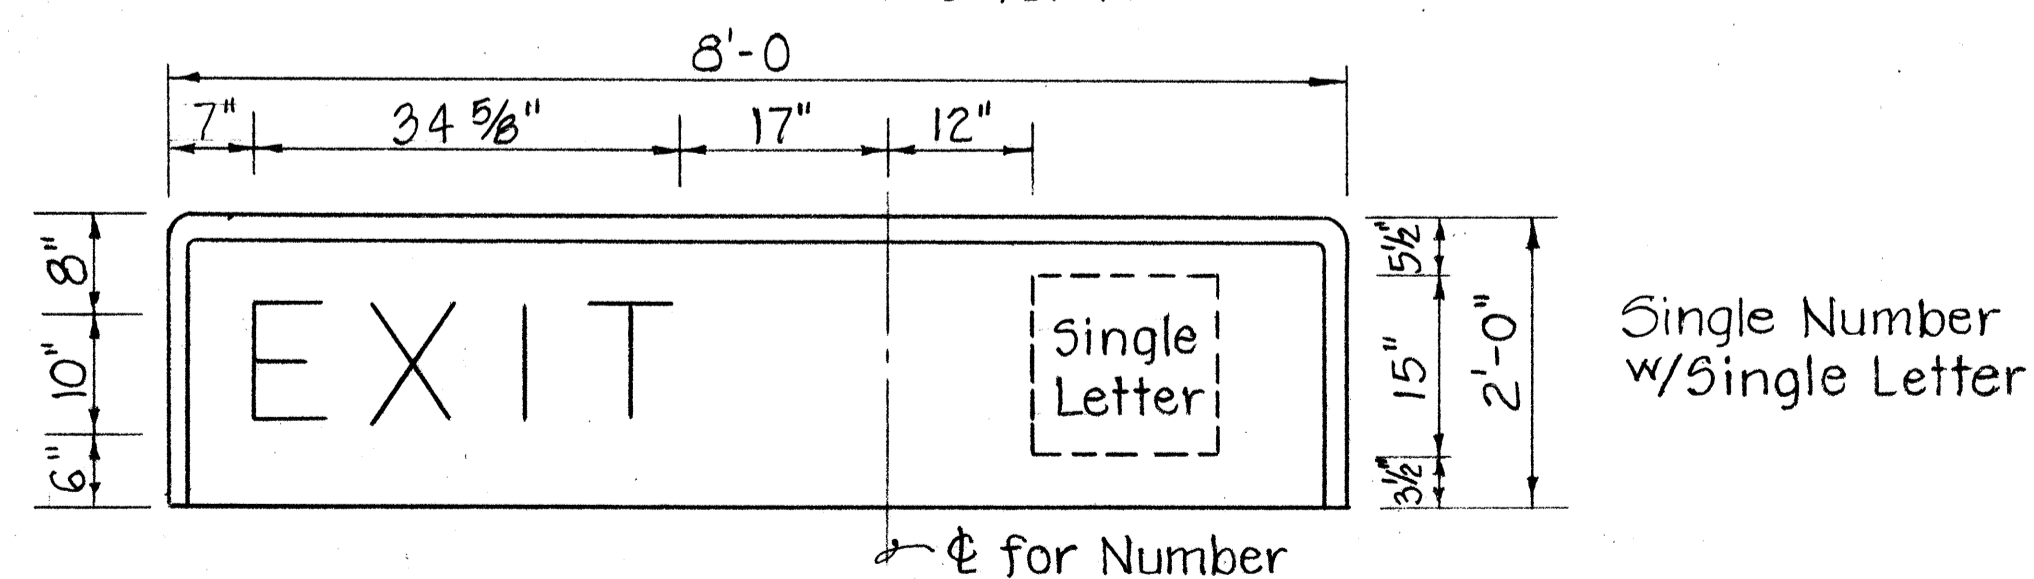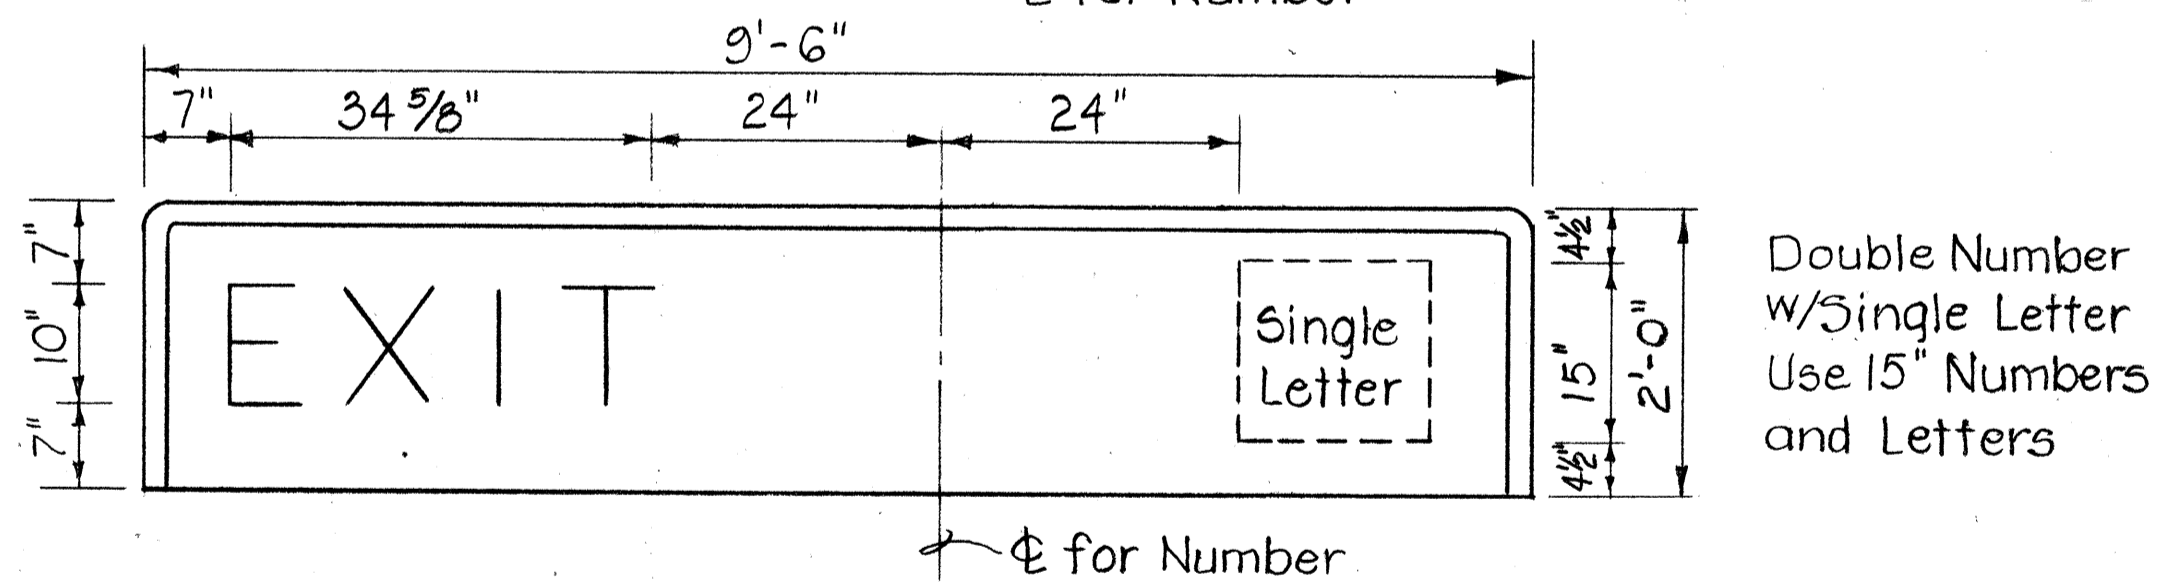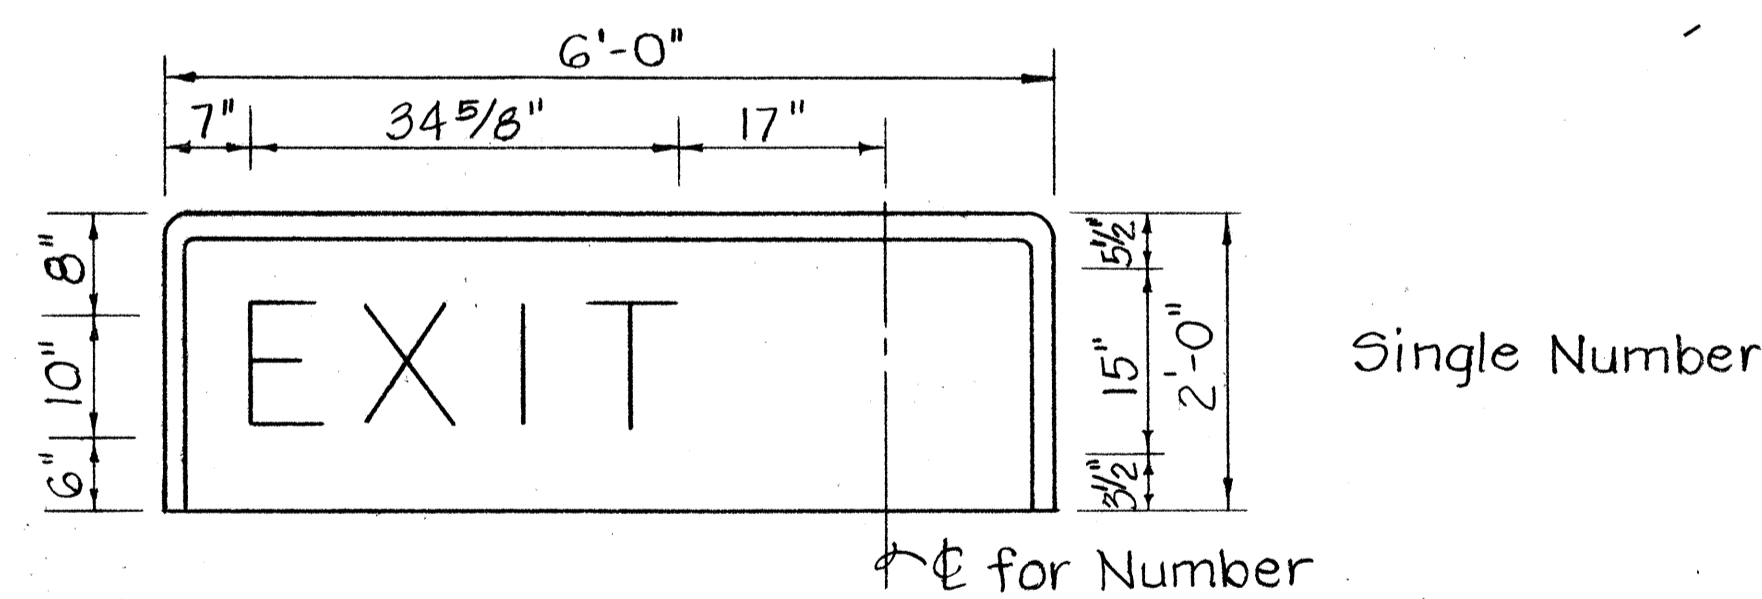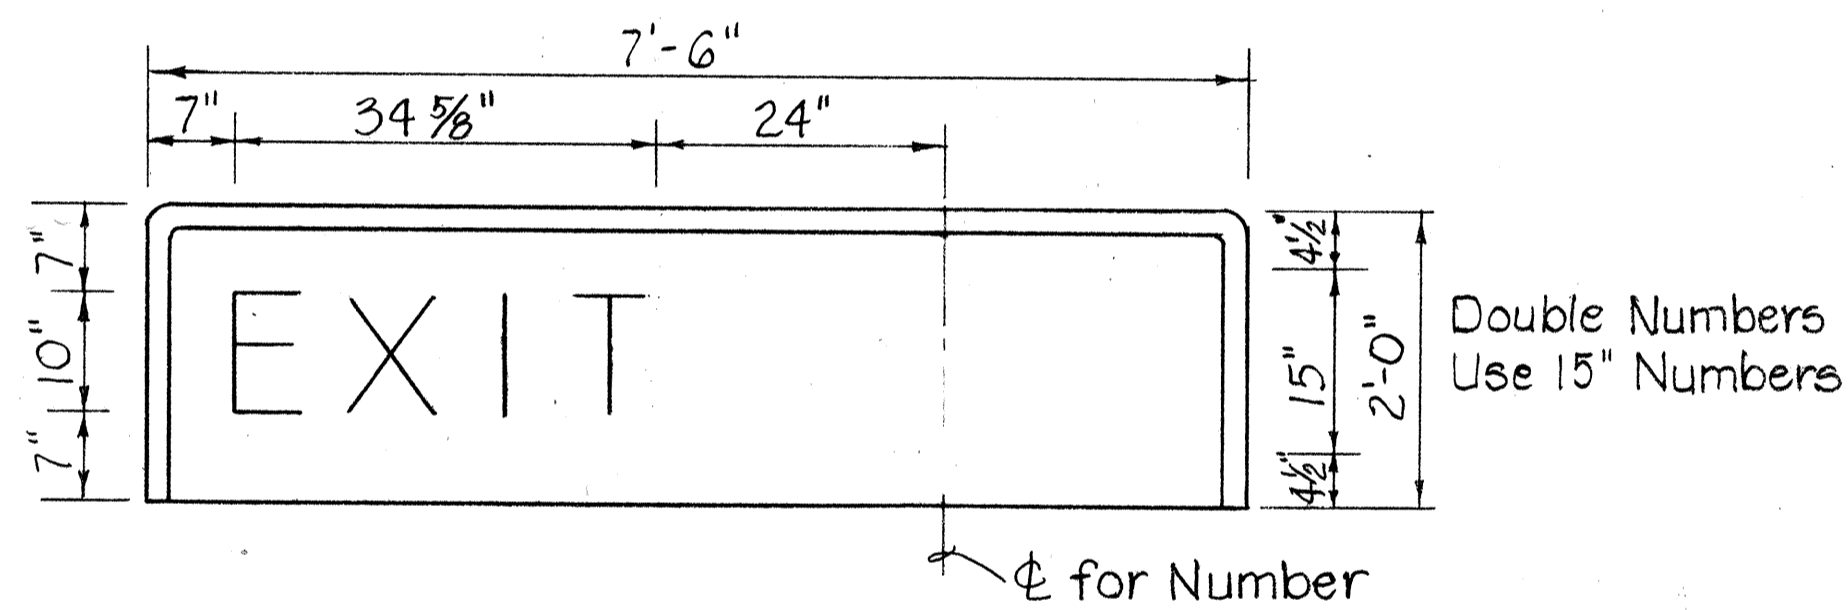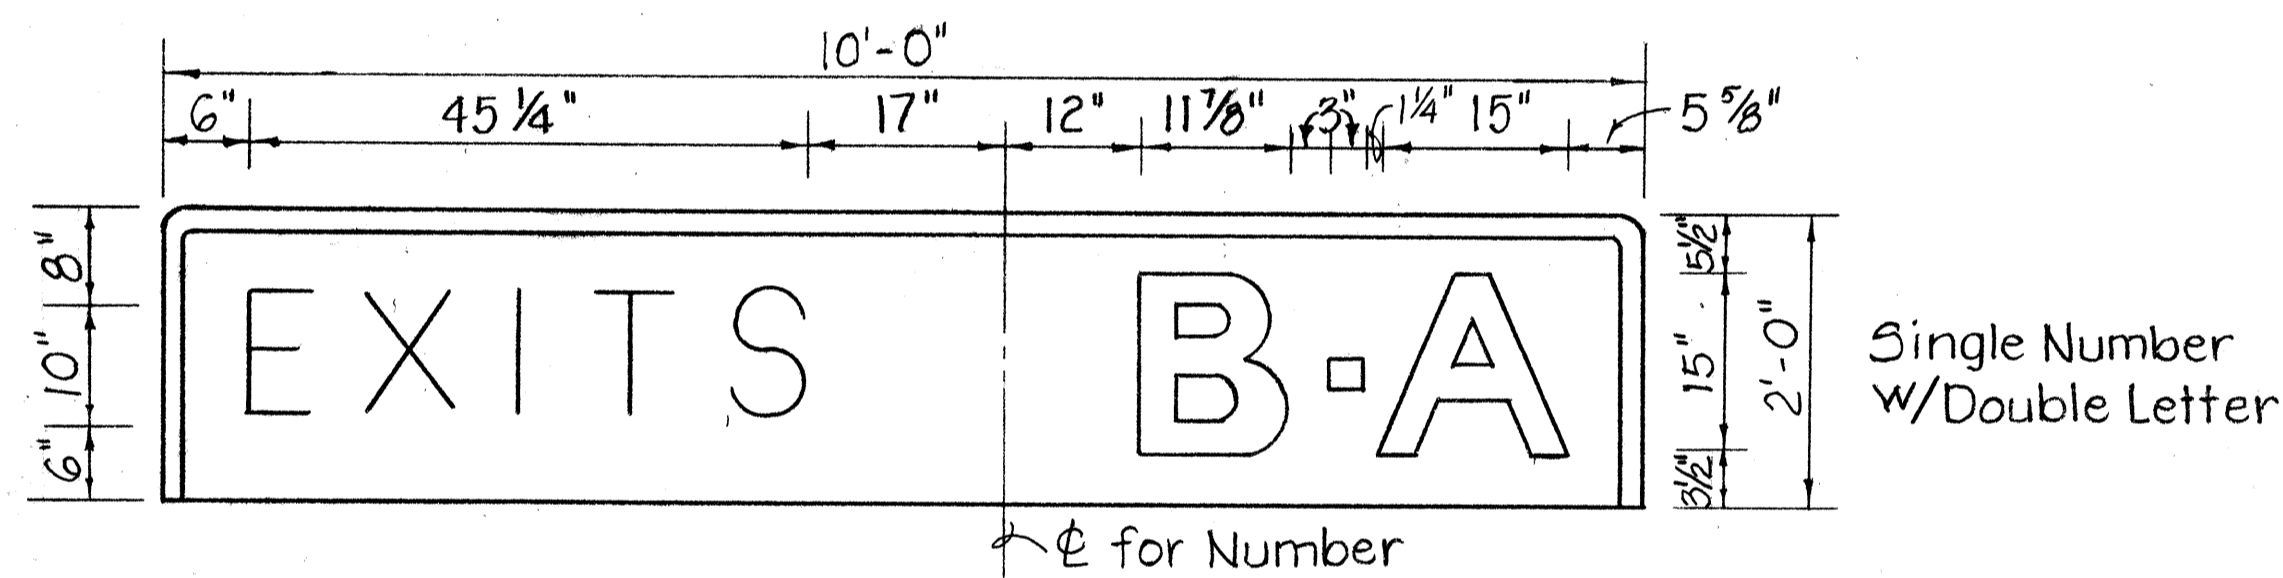

TYPE "A" DIAGONAL ARROW DETAIL
N.T.S.

EXIT NUMBER PANELS
Scale: 3/4" = 1'-0"


STATE OF HAWAII
DEPARTMENT OF TRANSPORTATION
HIGHWAYS DIVISION

TYPICAL EXIT NUMBER SIGN PANEL LAYOUT


Scale: As Shown

SHEET NO. OF SHEETS


FED. ROAD DIST. NO.	STATE	FED. AID PROJ. NO.	FISCAL YEAR	SHEET NO.	TOTAL SHEETS
HAWAII	HAW.	IR-HI(193)	1987	C038 S-4	62

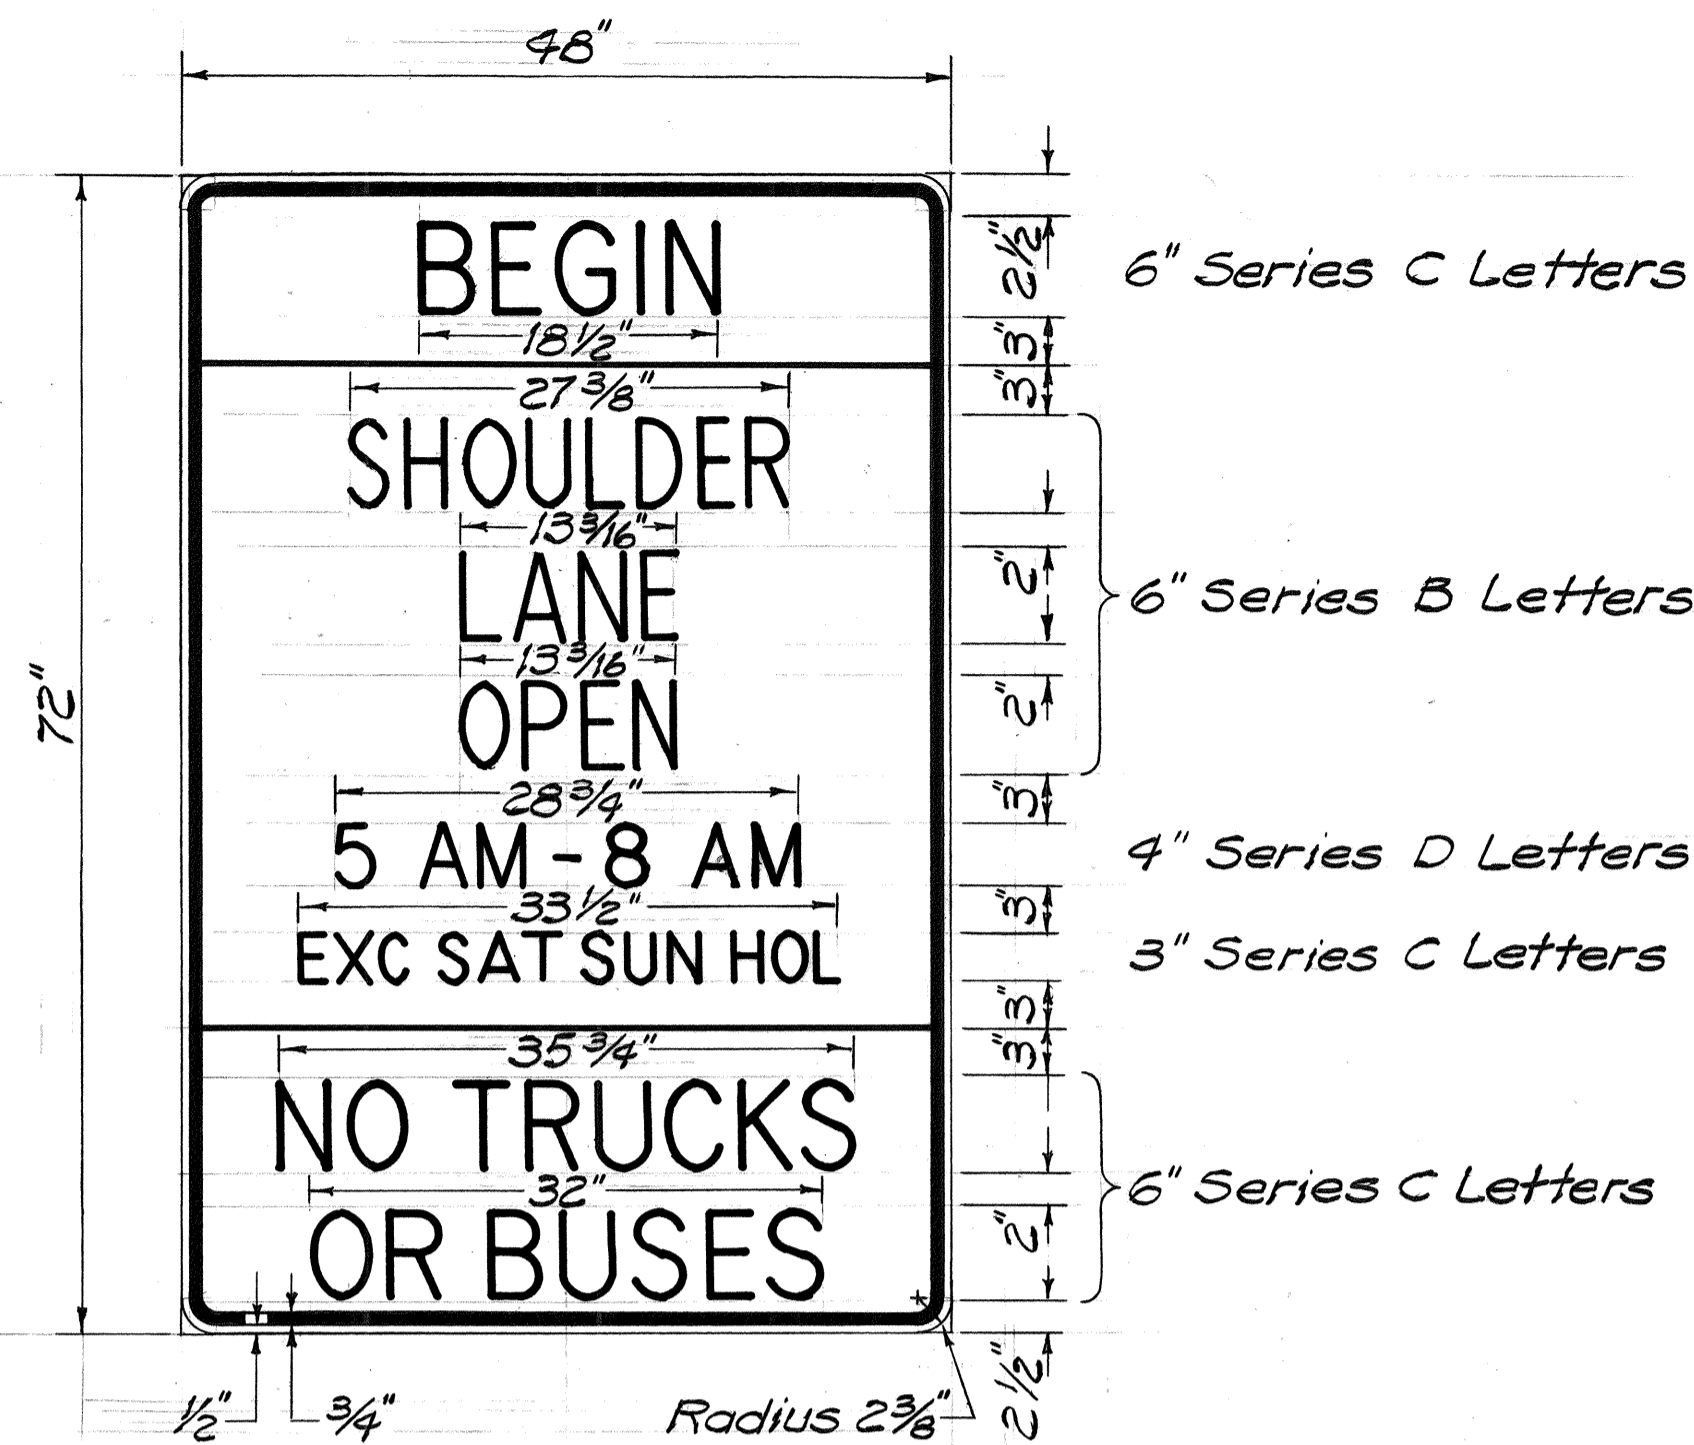


Use 2-Post Flanged Channel
Installation 4.00 Lbs/Ft.
R16-9
Scale: 1"=1'-0"

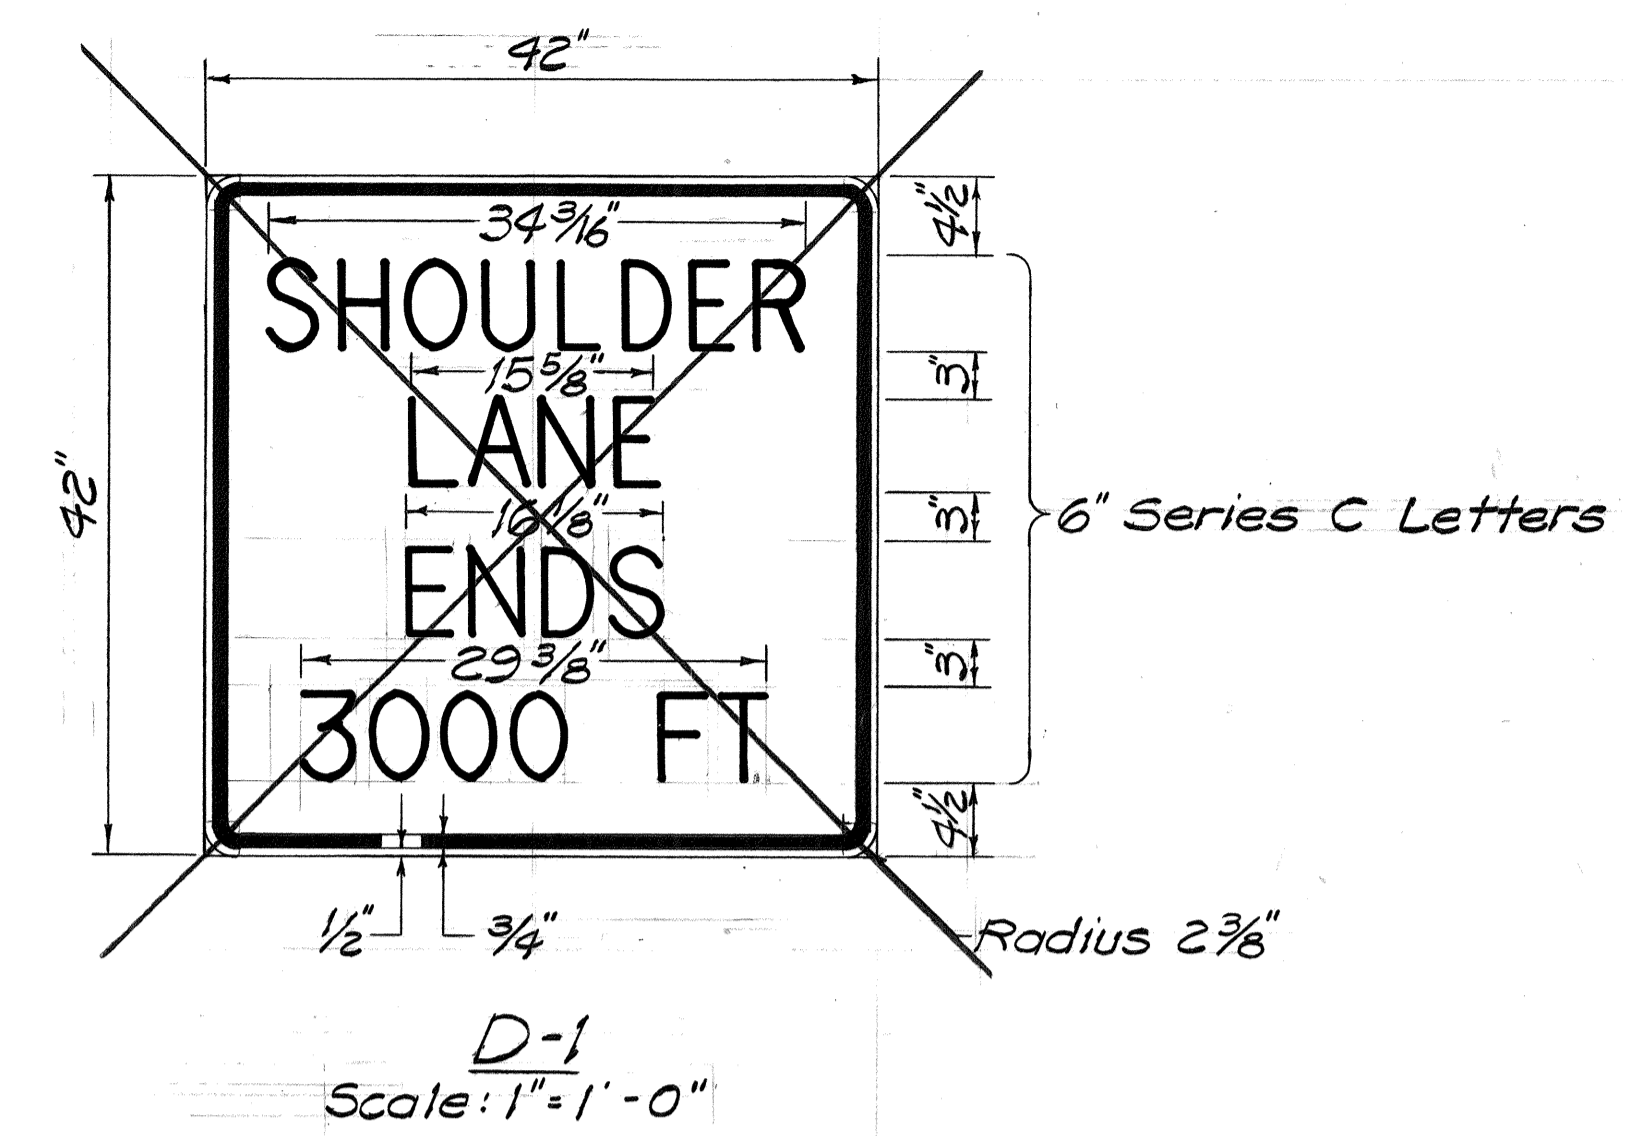


D-1
Scale: 1"=1'-0"

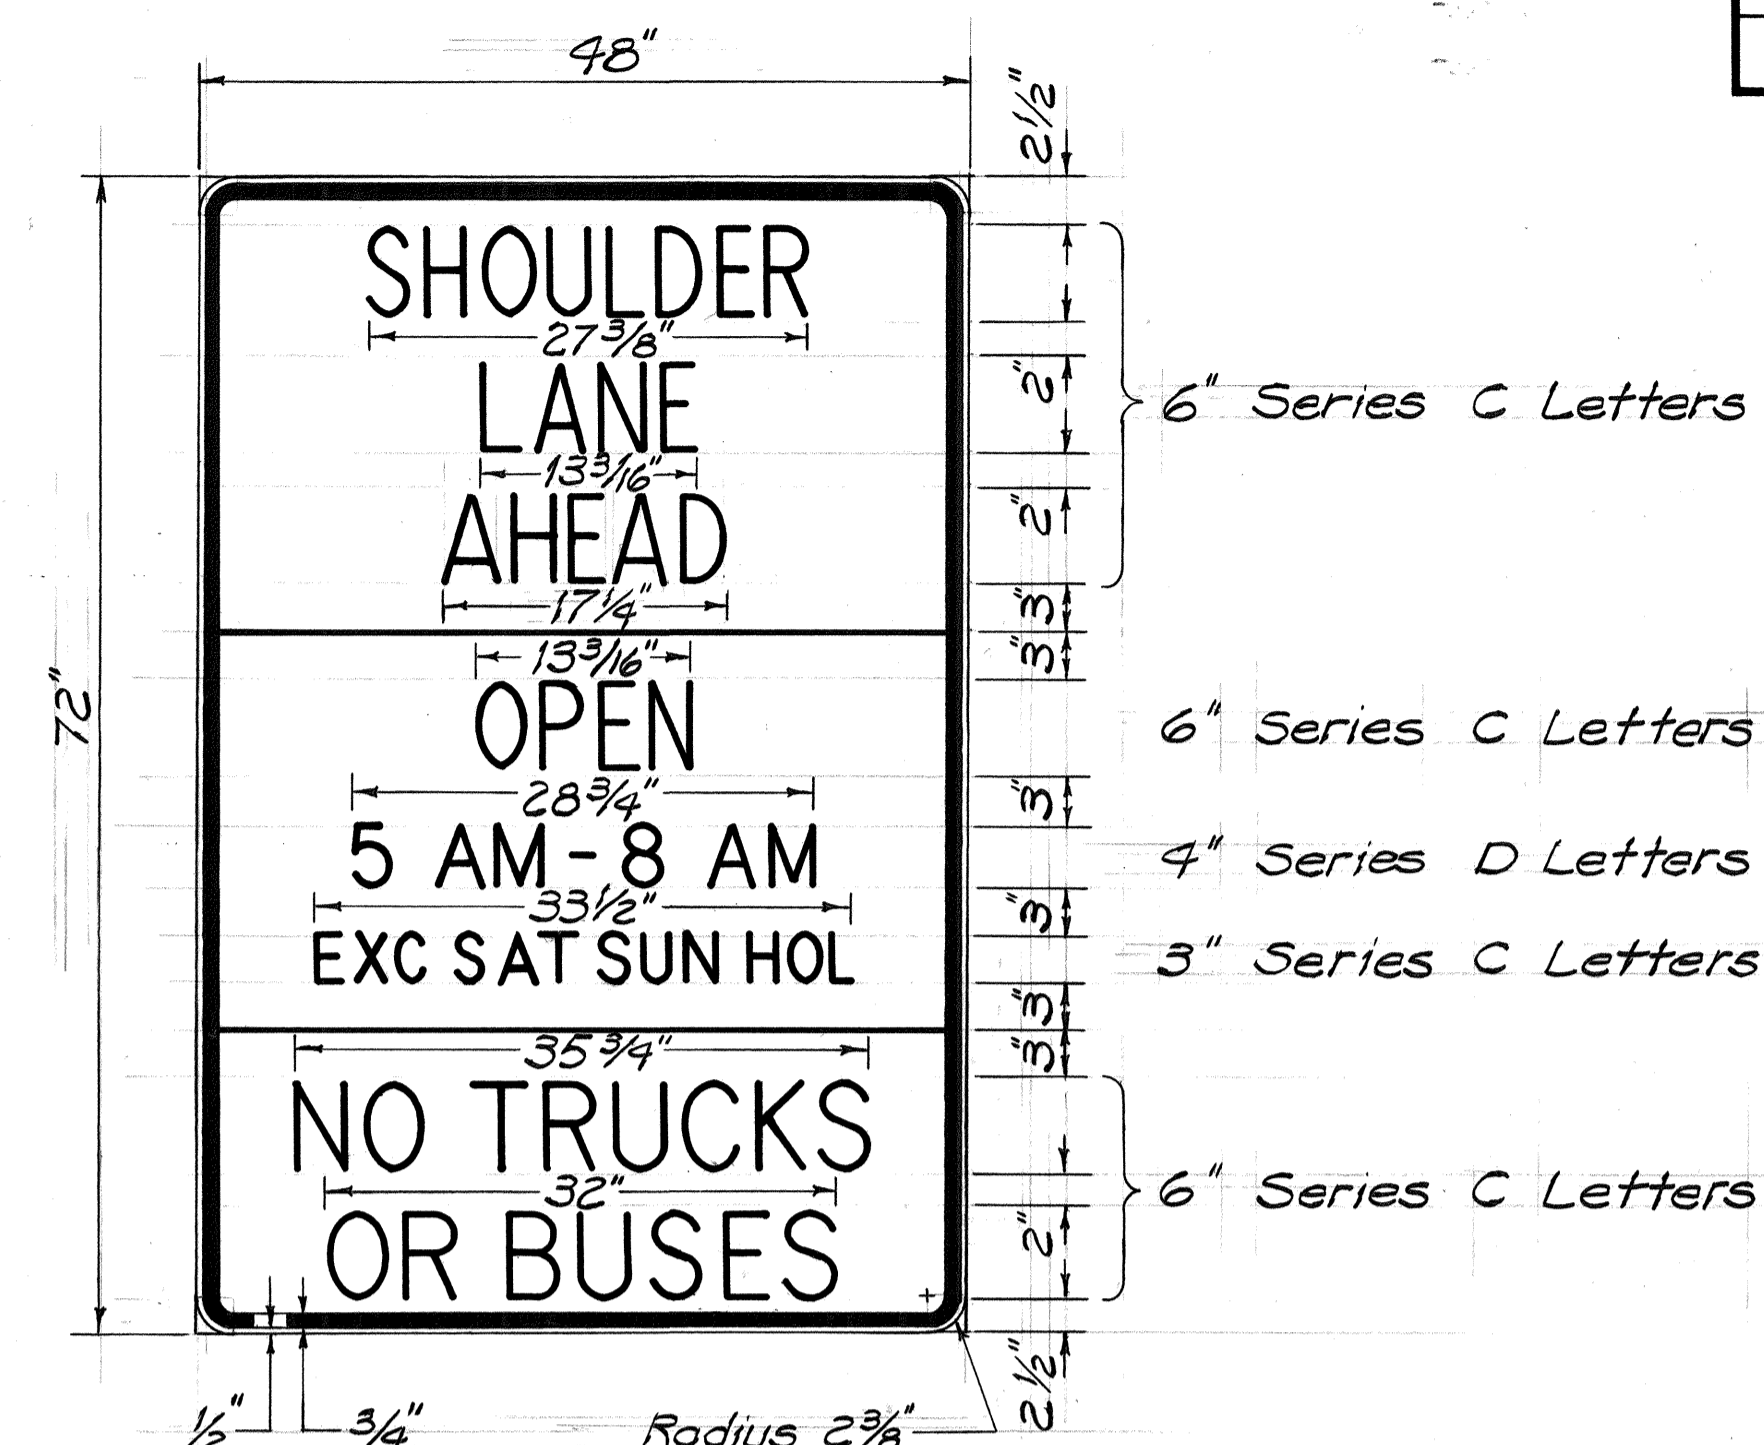


Use 2-Post Flanged Channel
Installation 4.00 Lbs/Ft.
R16-11
Scale: 1"=1'-0"

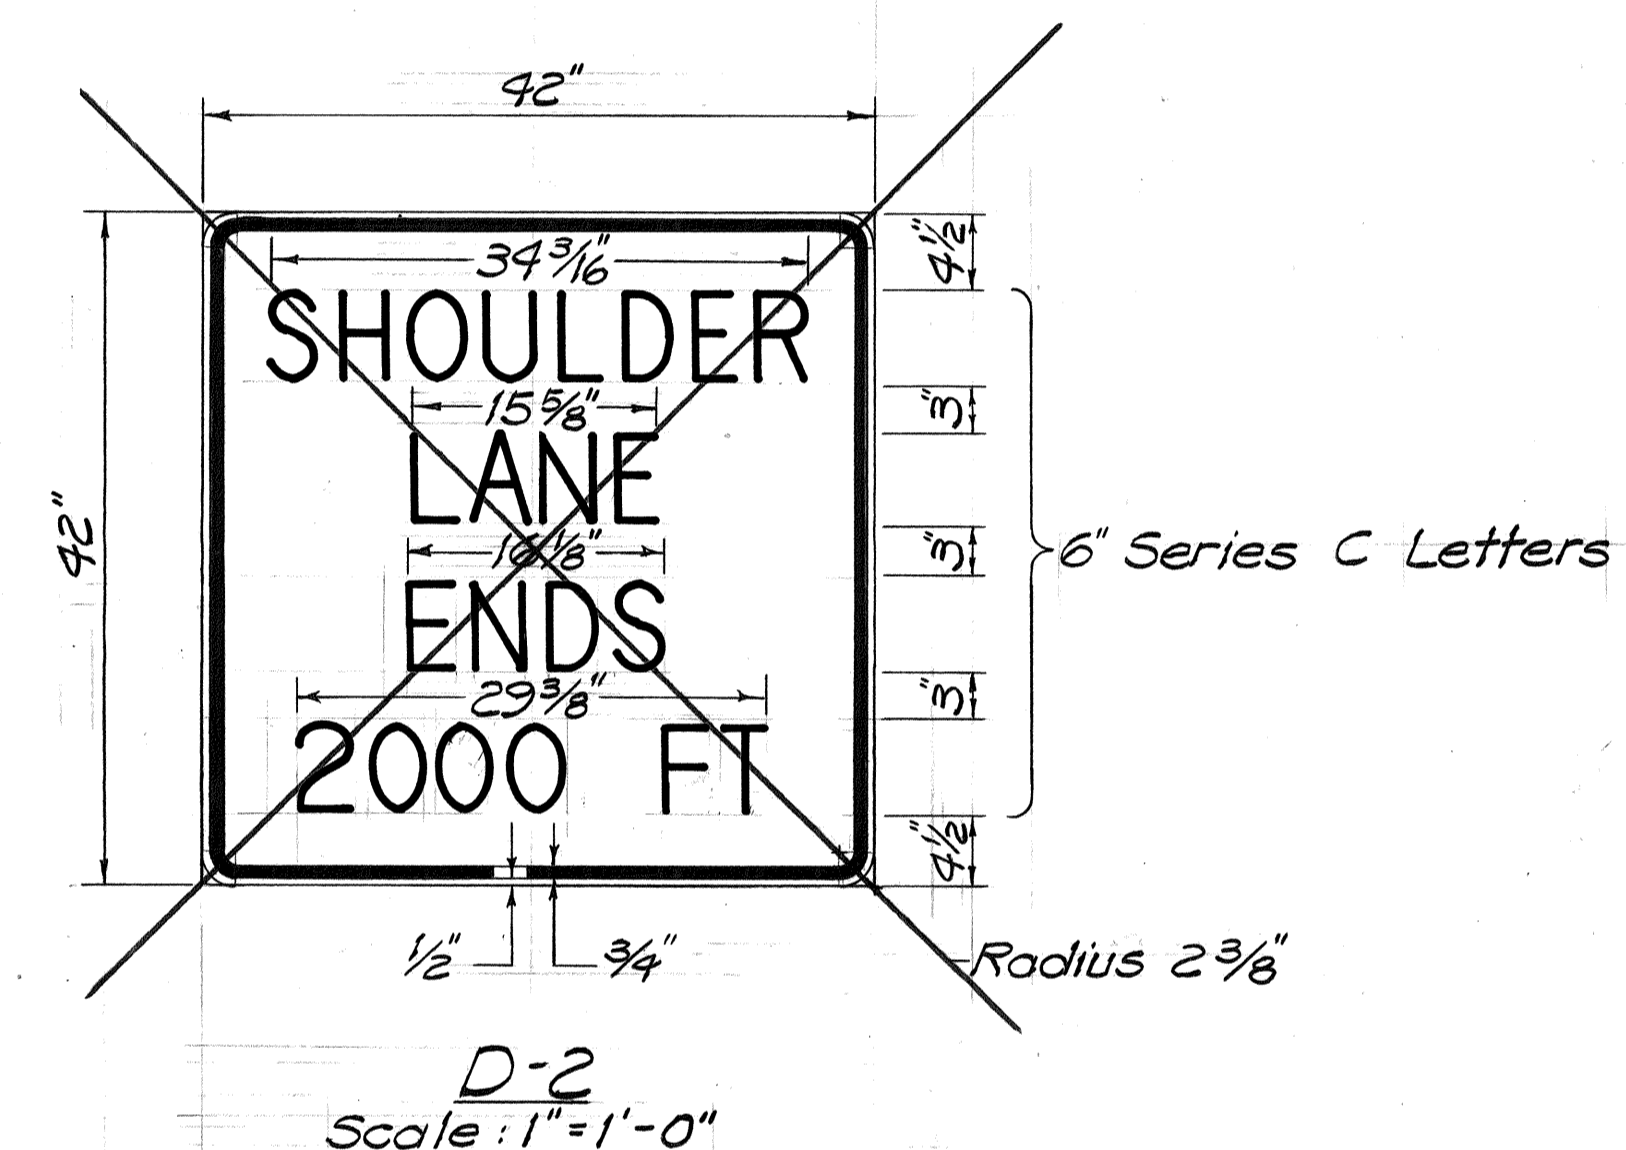


D-2
Scale: 1"=1'-0"

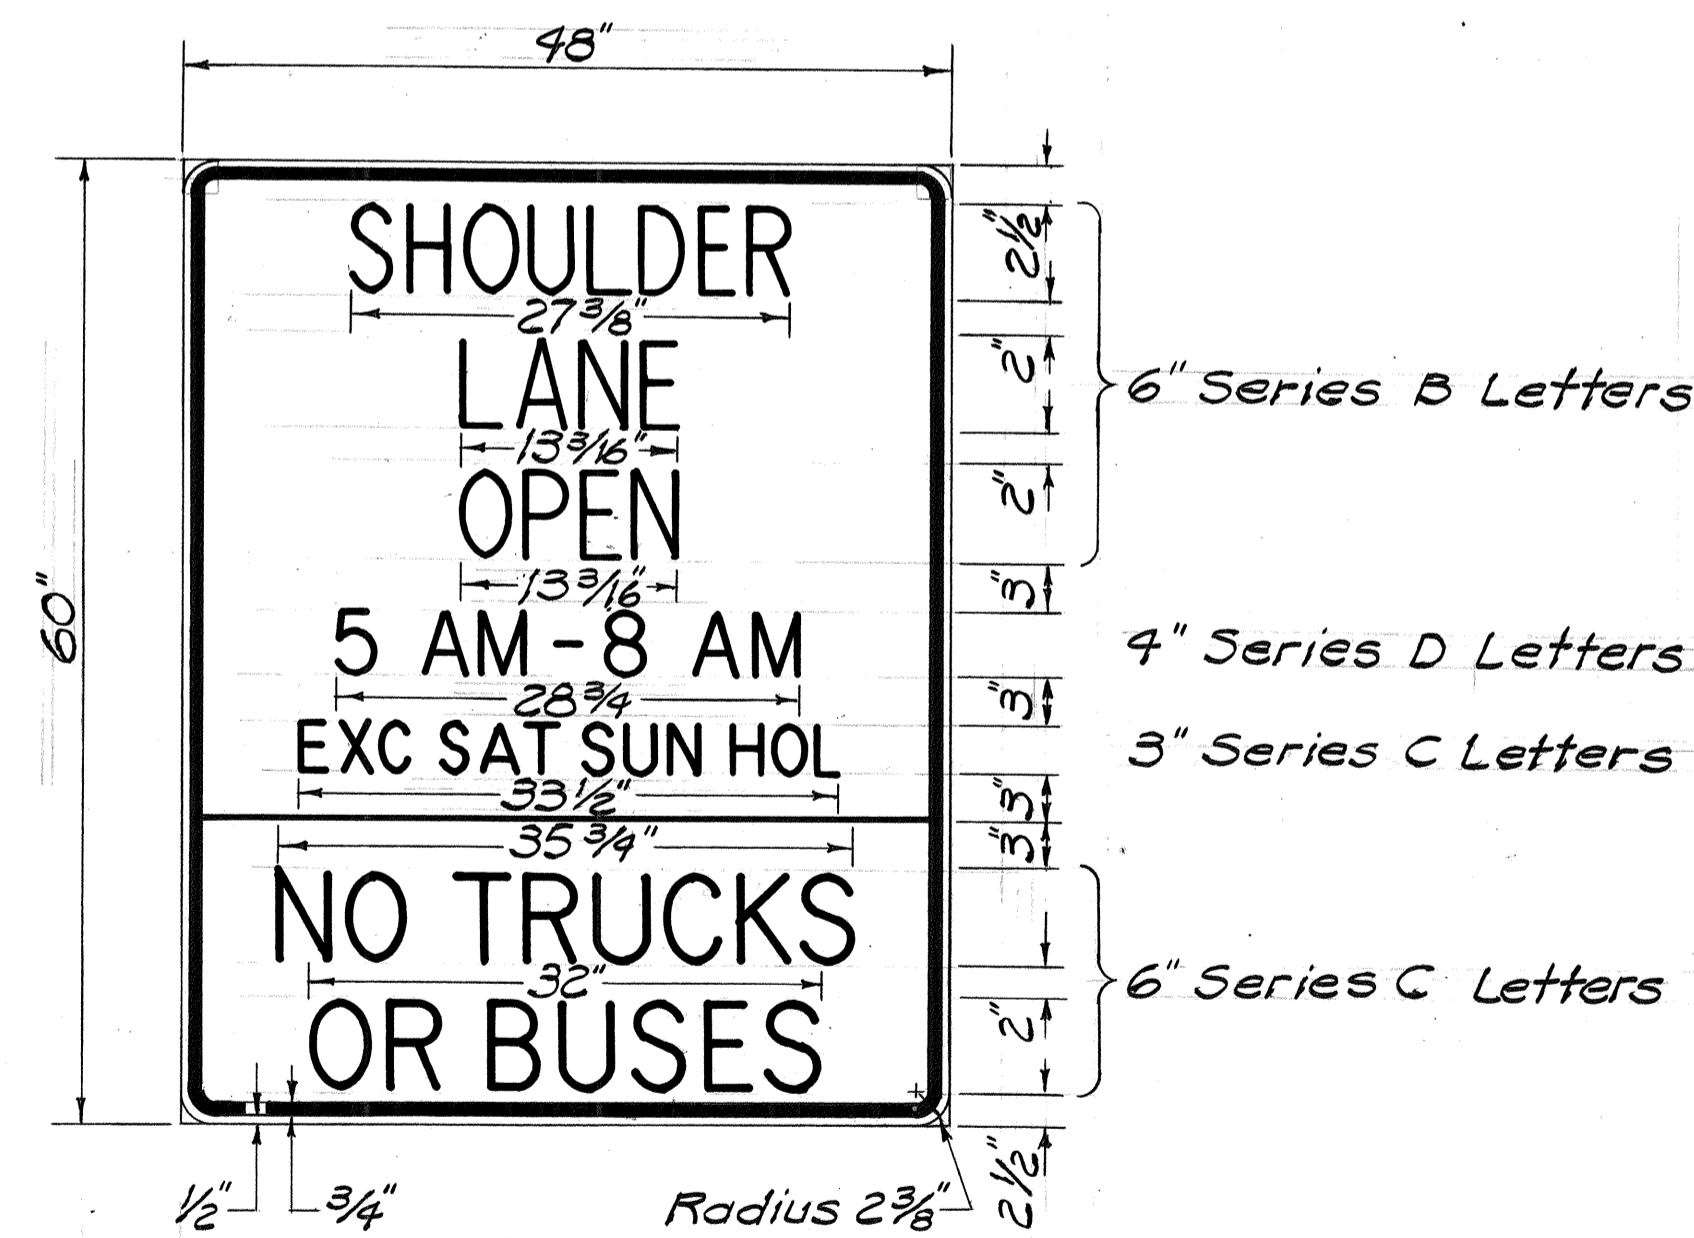

Use 2-Post Flanged Channel
Installation 4.00 Lbs/Ft.
R16-10
Scale: 1"=1'-0"

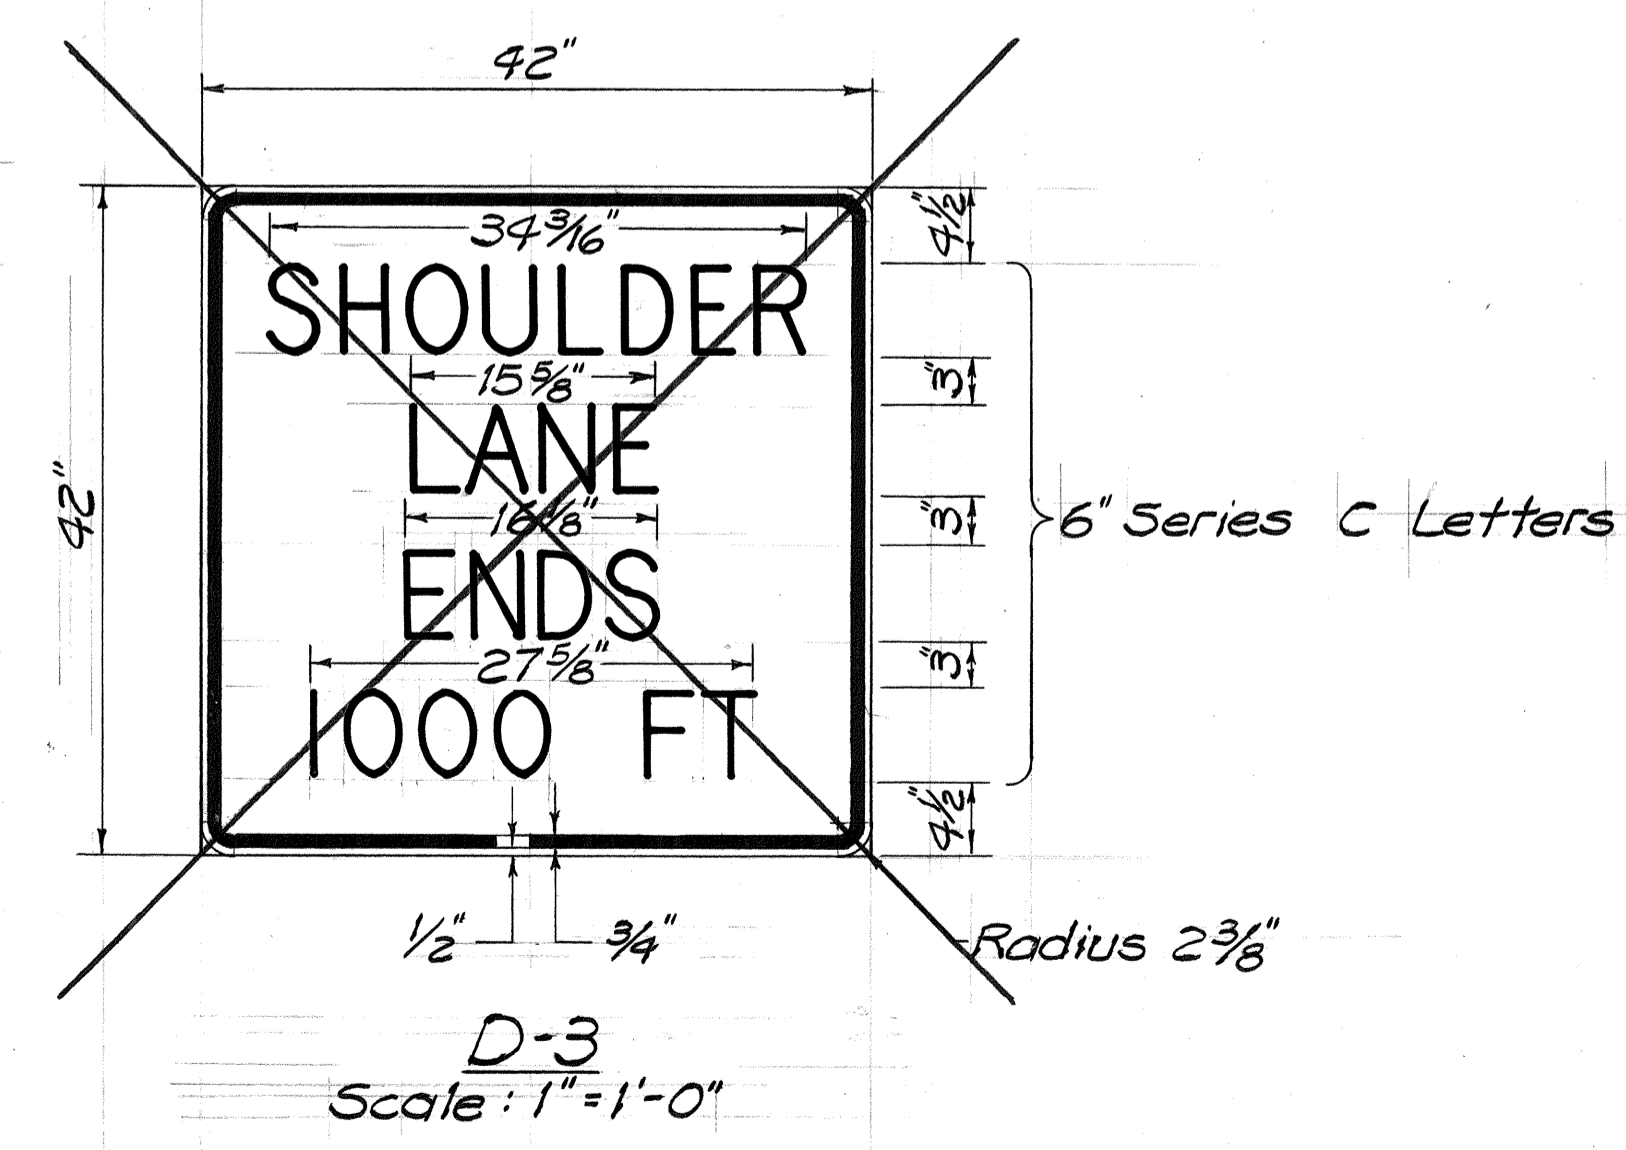

D-3
Scale: 1"=1'-0"

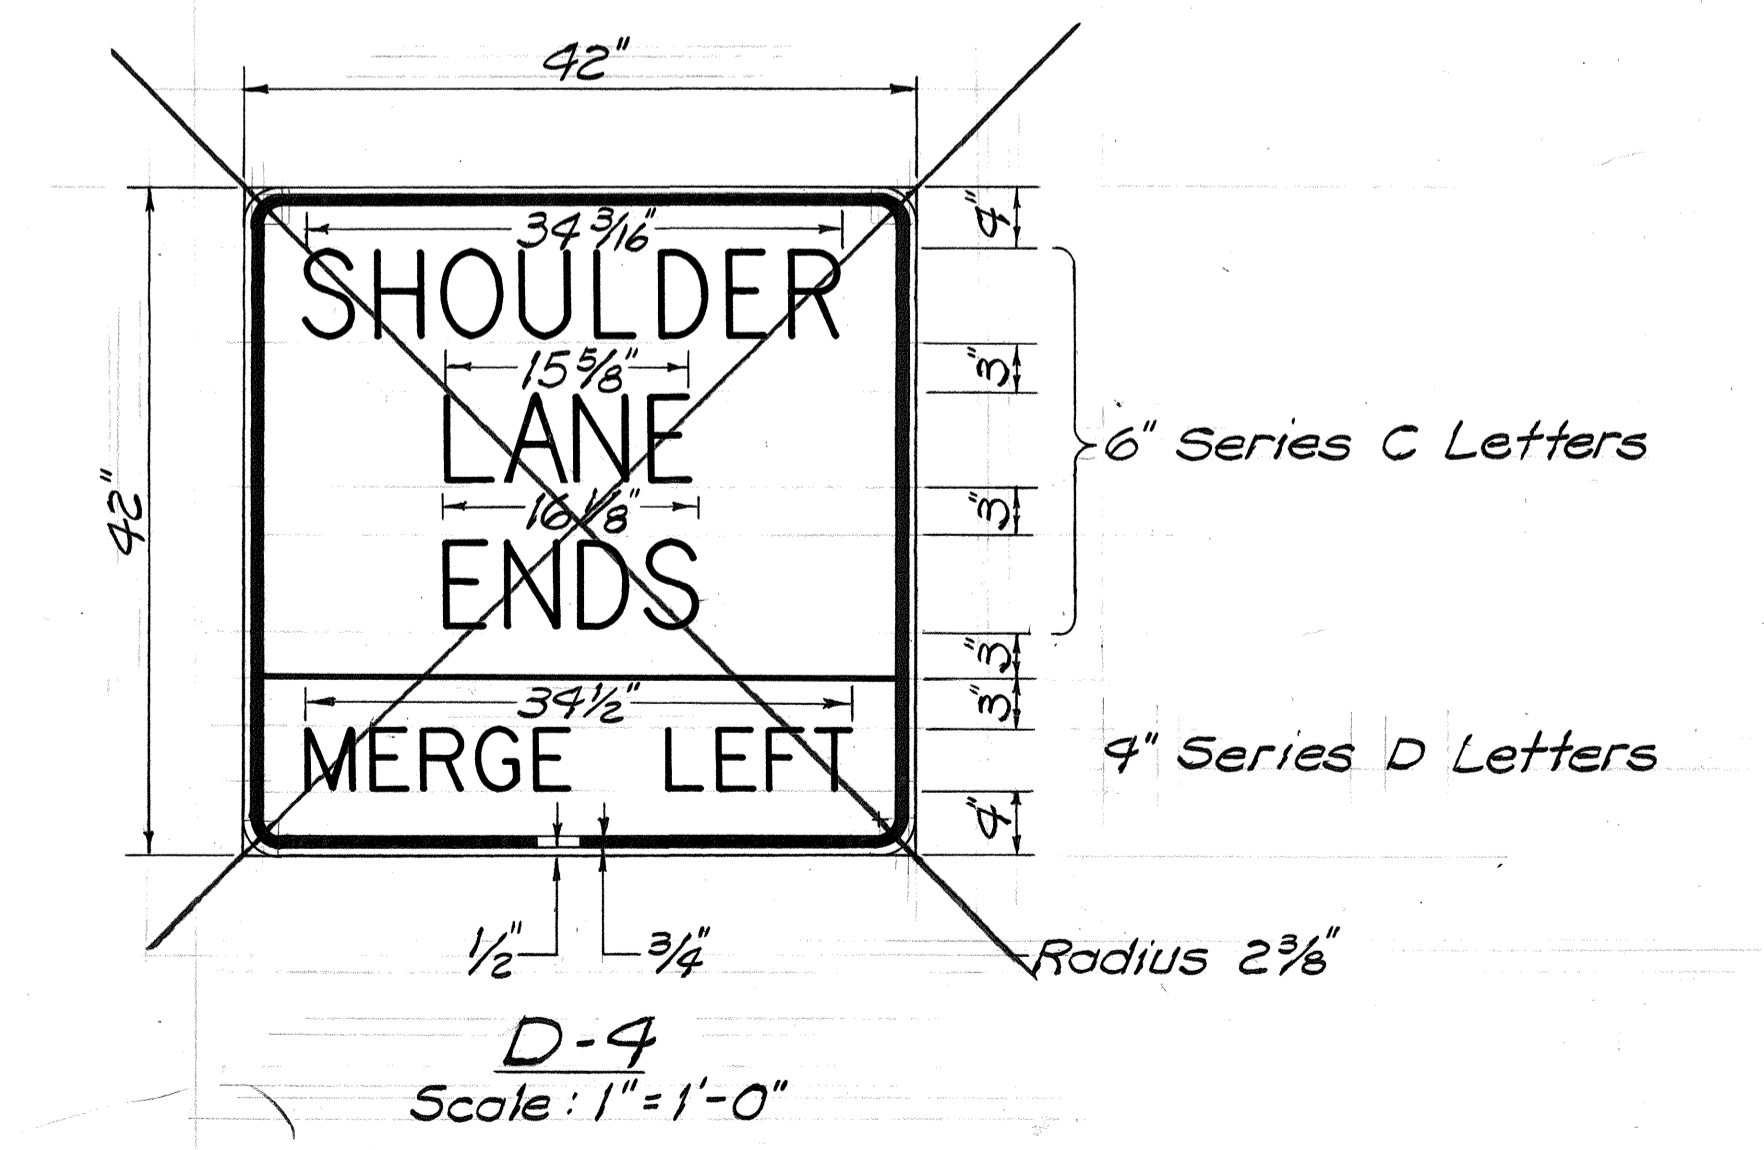

D-4
Scale: 1"=1'-0"

DATE	
DESIGNED BY	
CHECKED BY	
NO.	

10/5/87	Added Sign Layouts for I.B. Shoulder Lane.
DATE	REVISION
STATE OF HAWAII DEPARTMENT OF TRANSPORTATION HIGHWAYS DIVISION	
SIGN LAYOUTS	
INTERSTATE ROUTE H-1 ADDITIONAL LANES F.A.I. PROJ. NO. IR-HI-1(193)	
Scale: As Shown Date: Oct, 1987	
SHEET No. 71d OF 19 SHEETS	


FED. ROAD DIST. NO.	STATE	FED. AID PROJ. NO.	FISCAL YEAR	SHEET NO.	TOTAL SHEETS
HAWAII	HAW.	IR-HI-1(193)	1985	39	62

Remove existing destination sign


WAIMALU 1 1/4
HONOLULU 12

WAIMALU 1 1/4
HONOLULU 12

Install new destination sign

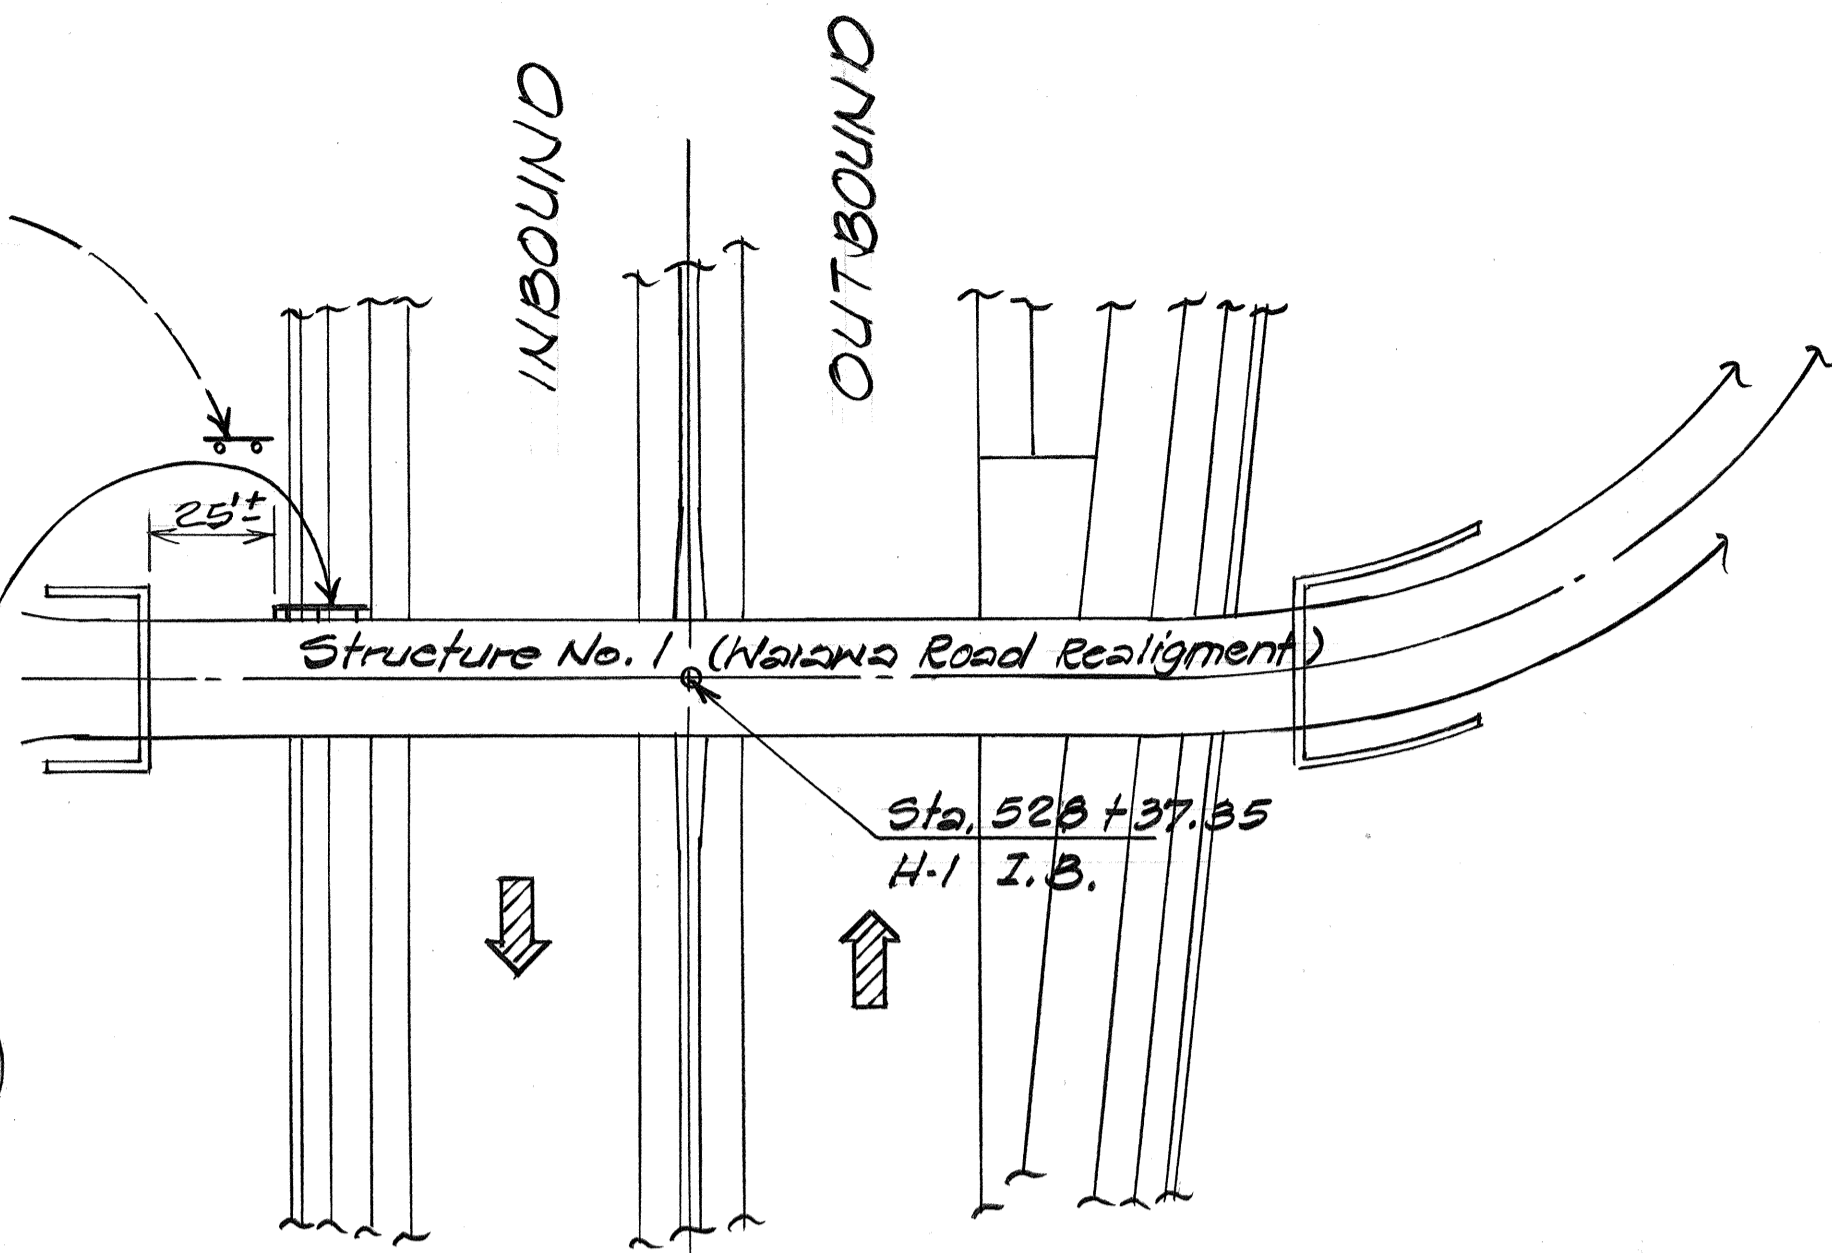


LAYOUT PLAN
Scale: 1" = 40'

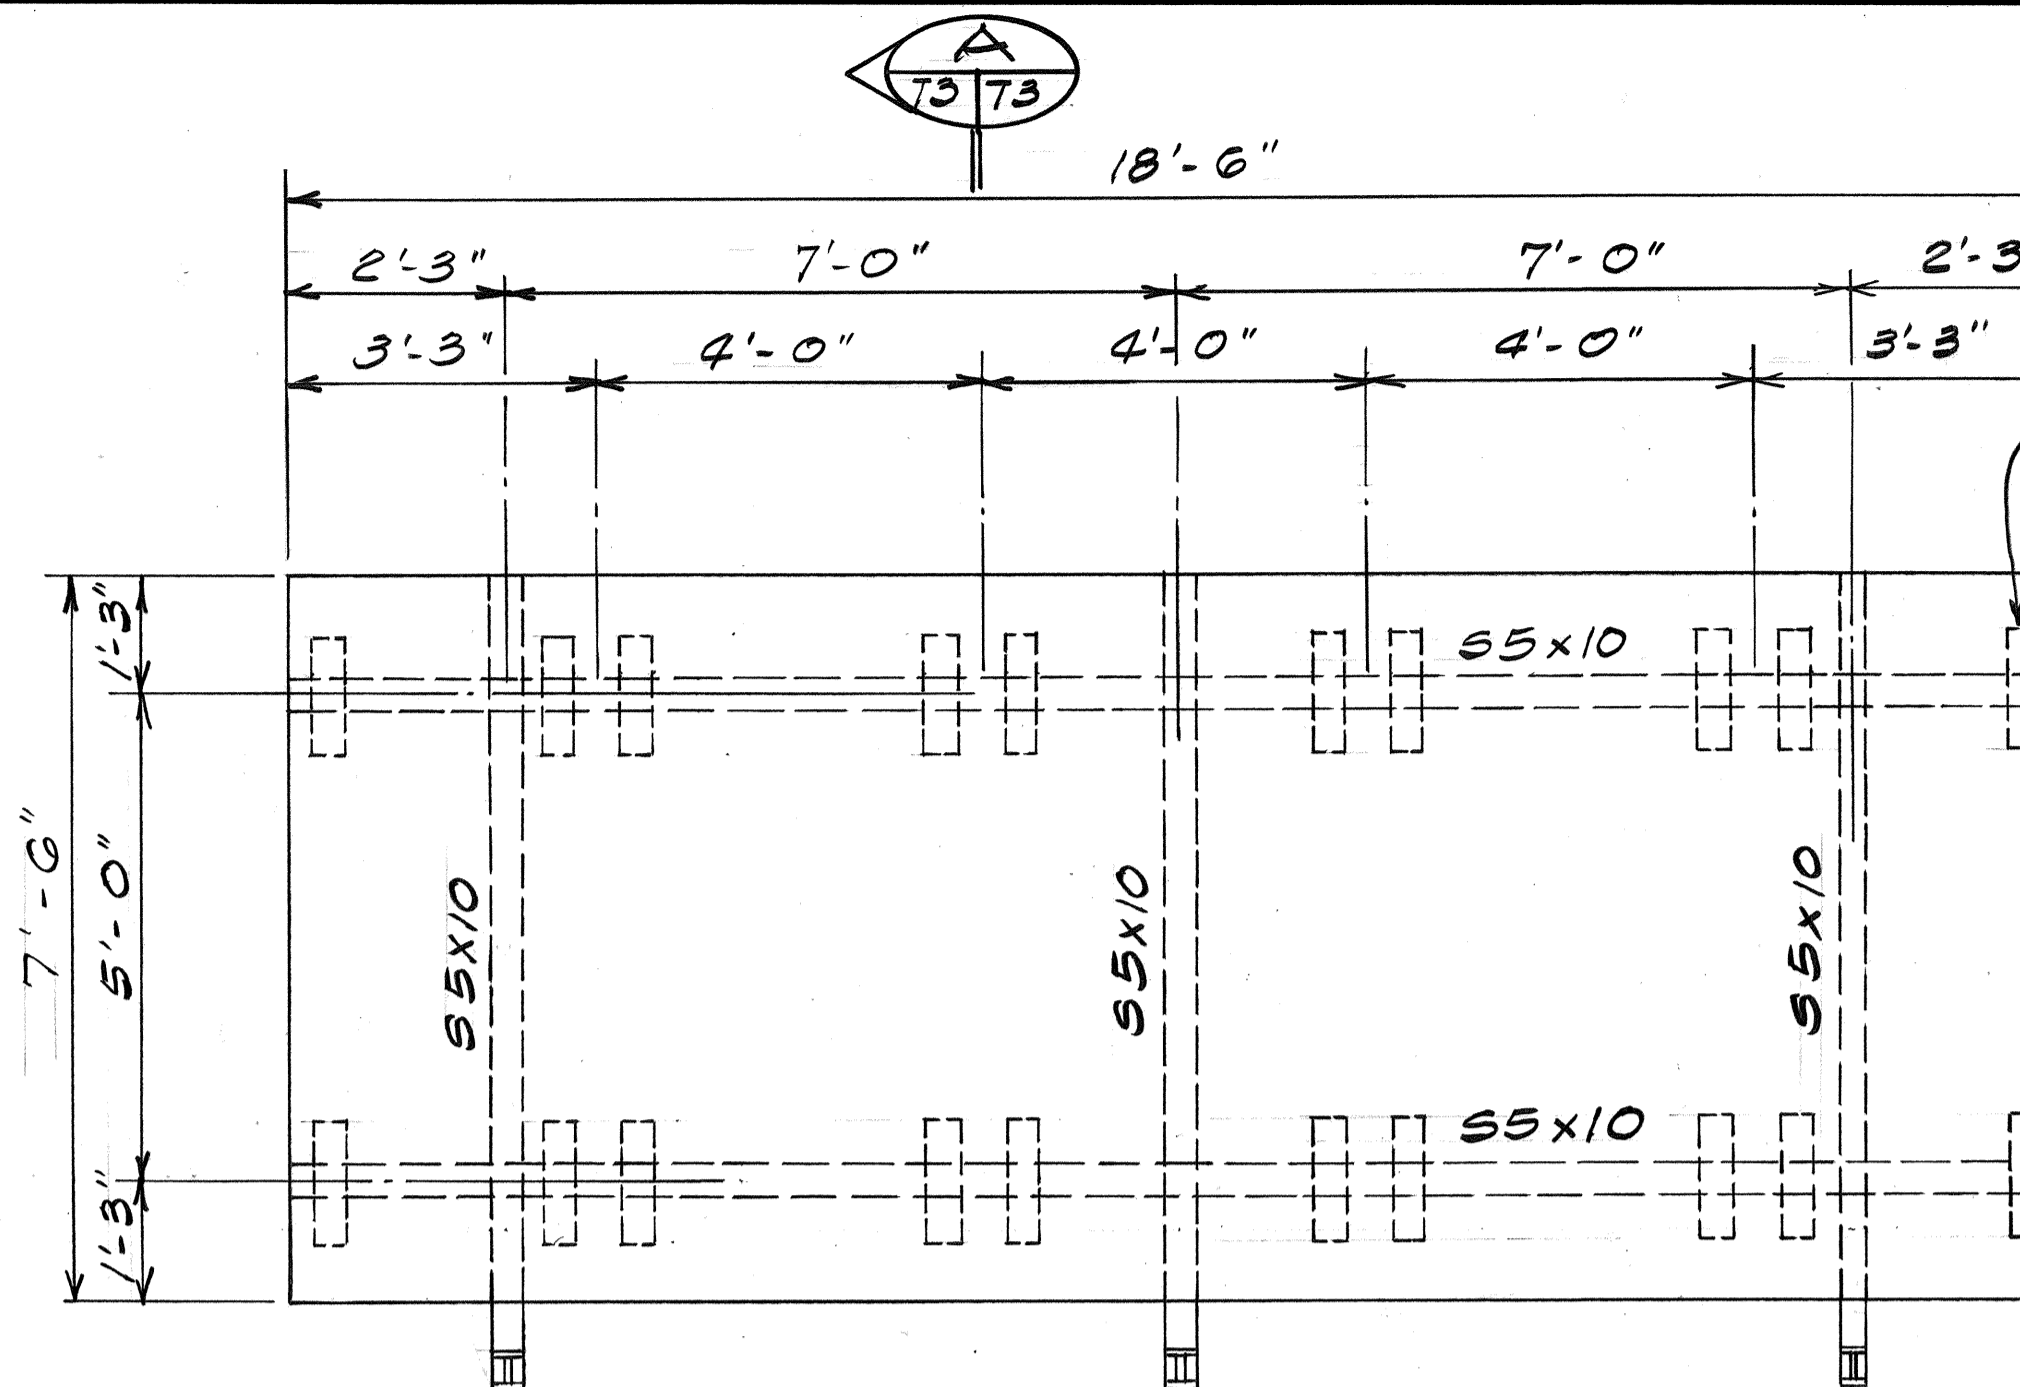

ELEVATION ~ FORMER GROUND MOUNTED SIGN E-27

Scale: 1/2" = 1'-0"

For details of aluminum mountings see sht. no. T12.

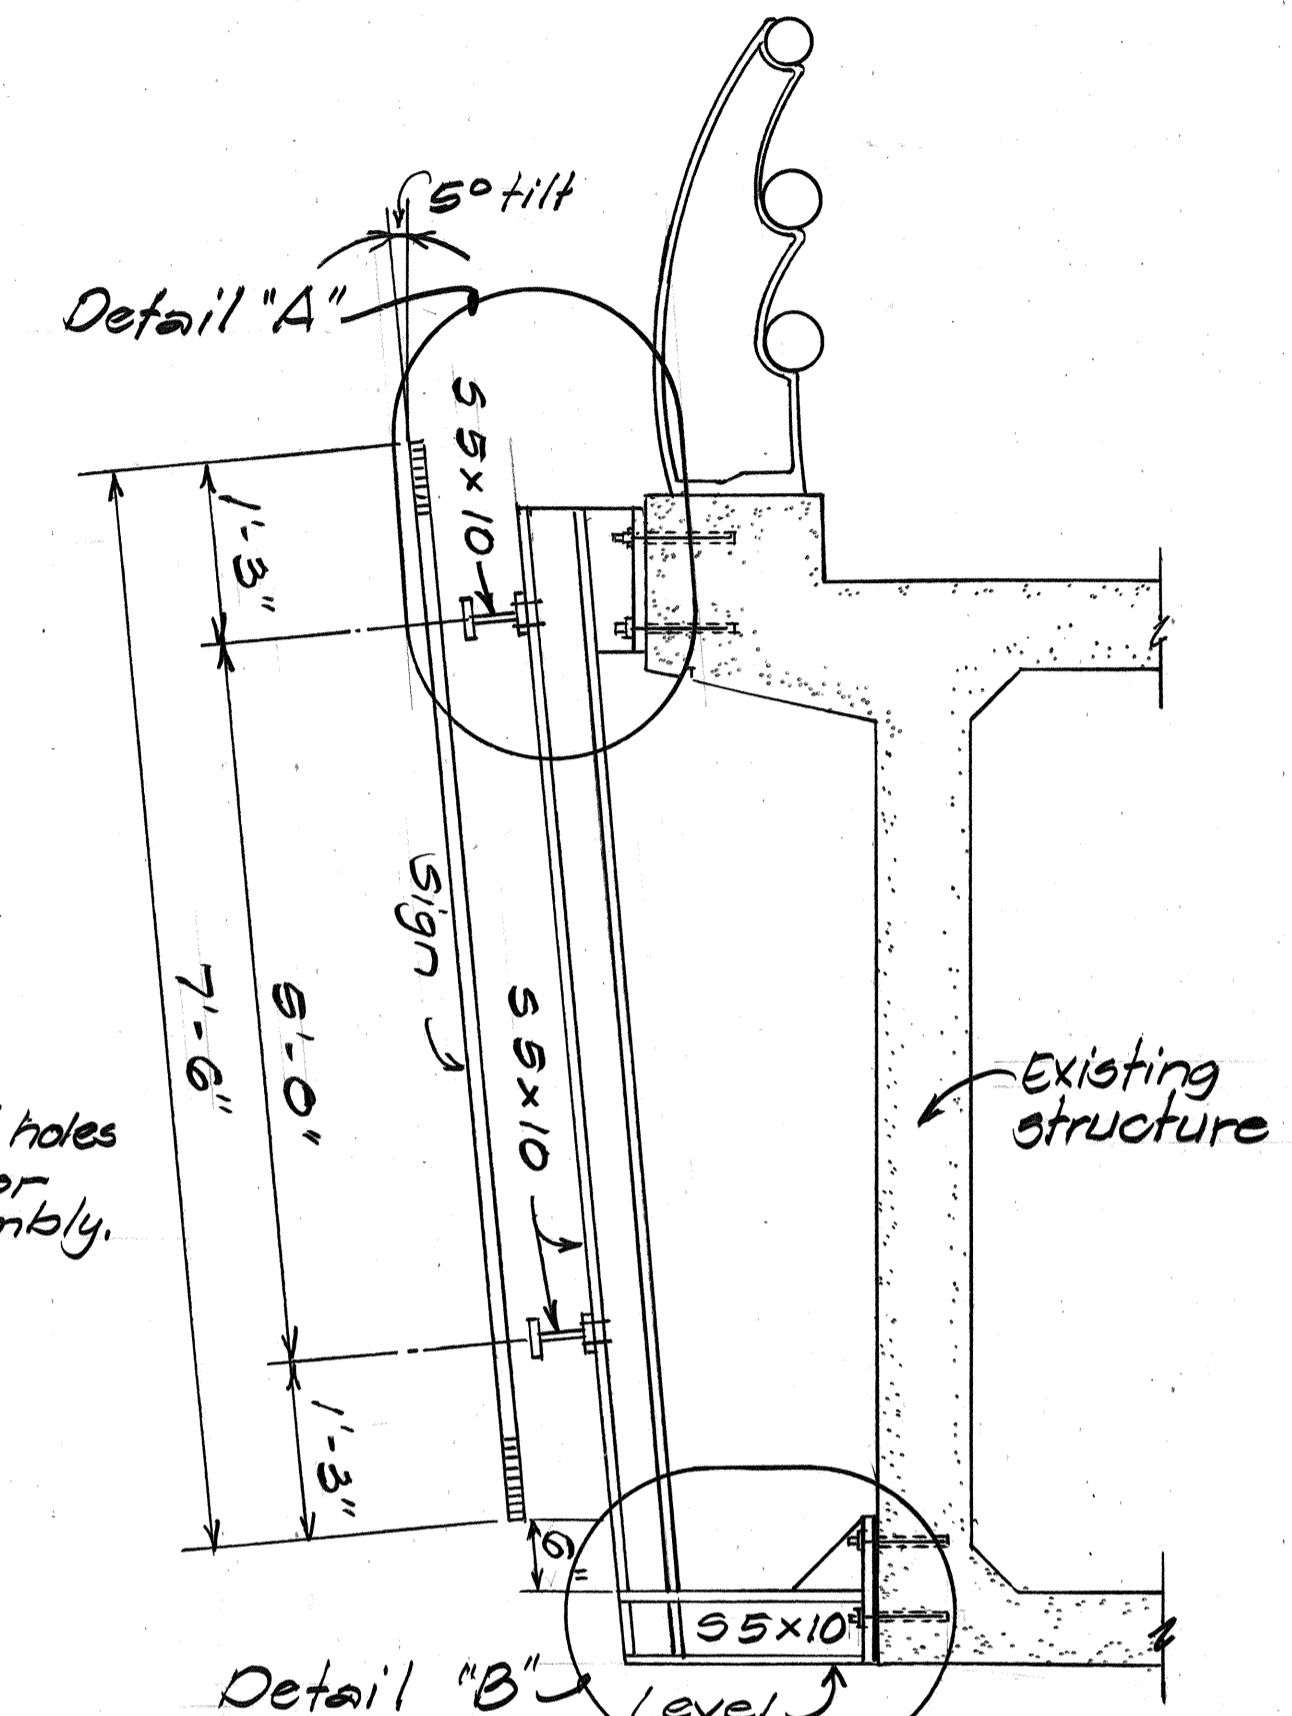

SECTION
Scale: 3/4" = 1'-0"

GENERAL NOTES

MATERIALS:


1. Structural steel shapes, plates & bars shall conform to ASTM A-36.
2. Anchor rod assemblies shall conform to ASTM A-325.
3. All structural steel assemblies and hardware shall be hot-dip galvanized after fabrication, except for stainless steel connectors.
4. All aluminum to steel connectors to be stainless steel.
5. An appropriate adhesive anchor system shall be used to anchor the bolts in the concrete.

CONSTRUCTION REQUIREMENTS:


1. The Contractor shall remove the existing ground mounted sign E-27 from its present support and reinstall it on the structure as indicated in the plans. He shall repair any damage to the sign structure including changes in the sign mounting locations.
2. All work shall be done by workmen skilled in the trade and workmanship shall be first class, conforming to the applicable requirements of the plans.
3. All dimensions for sign bracket assemblies shall be verified by the Contractor before fabrication and any discrepancy shall be promptly reported to the Engineer.
4. No percussion or impact drills shall be permitted in drilling holes in the existing structure.
5. Care shall be taken to not damage existing reinforcing during the drilling operation. Any unused drilled holes shall be filled with a suitable epoxy grout as approved by the Engineer.
6. All aluminum in contact with steel or concrete to be properly protected to prevent corrosion.
7. Except as noted otherwise, all vertical dimensions are measured plumb.

GENERAL:

1. All elastomeric pads shall be secured against displacement with adhesives approved by the Engineer.
2. All work involved in the relocation of the sign, including all materials, labor and equipment necessary for the removal, repair and reinstallation of the sign, shall be paid for under Item No. G21.1500 "Relocate Existing Destination Sign on to Overpass Structure."
3. Existing materials removed and not used in the work as determined by the Engineer, shall be stock piled at the job site. Removal of existing sign support posts and footings, including stock piling and/or disposal, shall be incidental to Item No. G21.1500.
4. If copies of existing plans of Structure No. 1 are needed, they may be obtained from the State DOT Highway office at 860 Punchbowl St. in Honolulu.

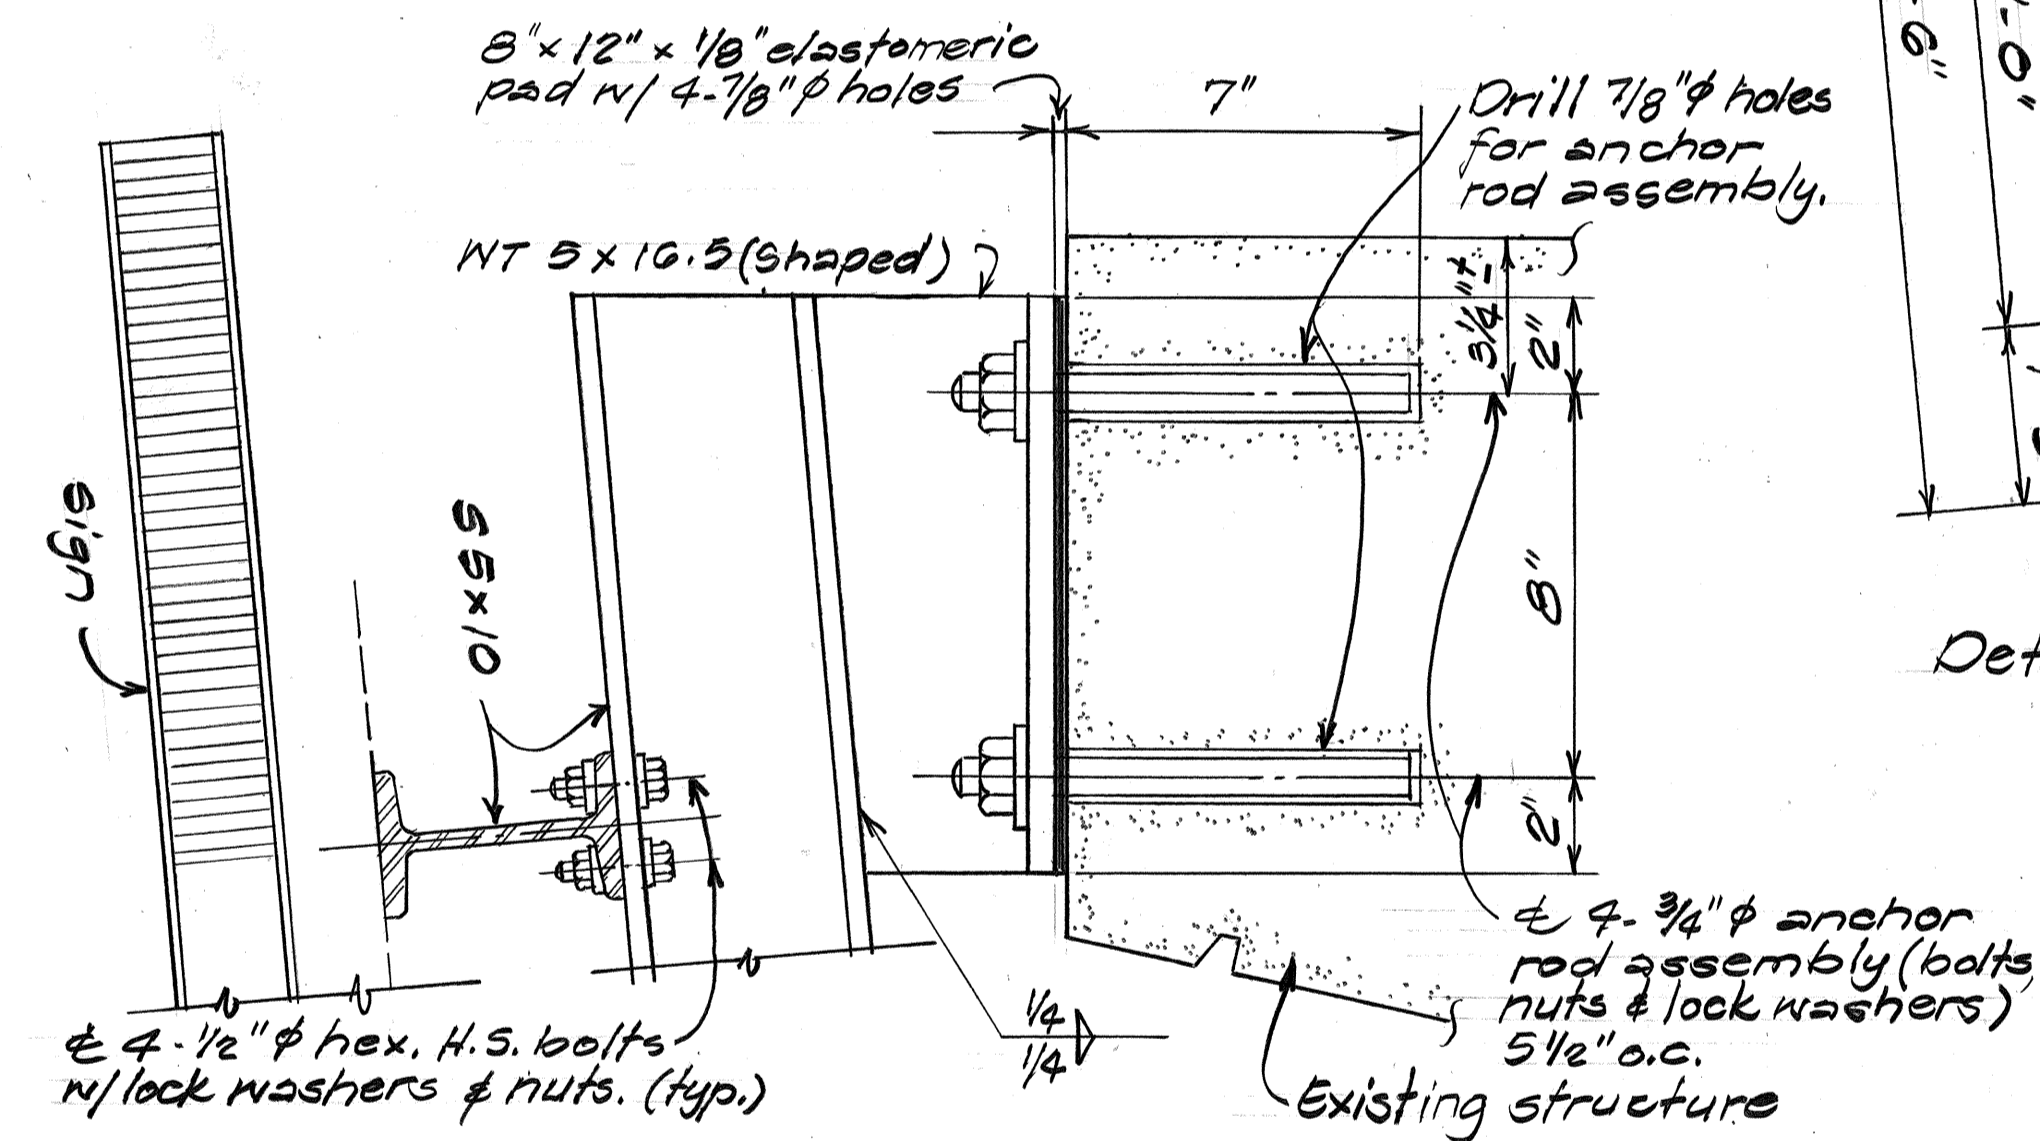

DETAIL "A"
Scale: 3" = 1'-0"

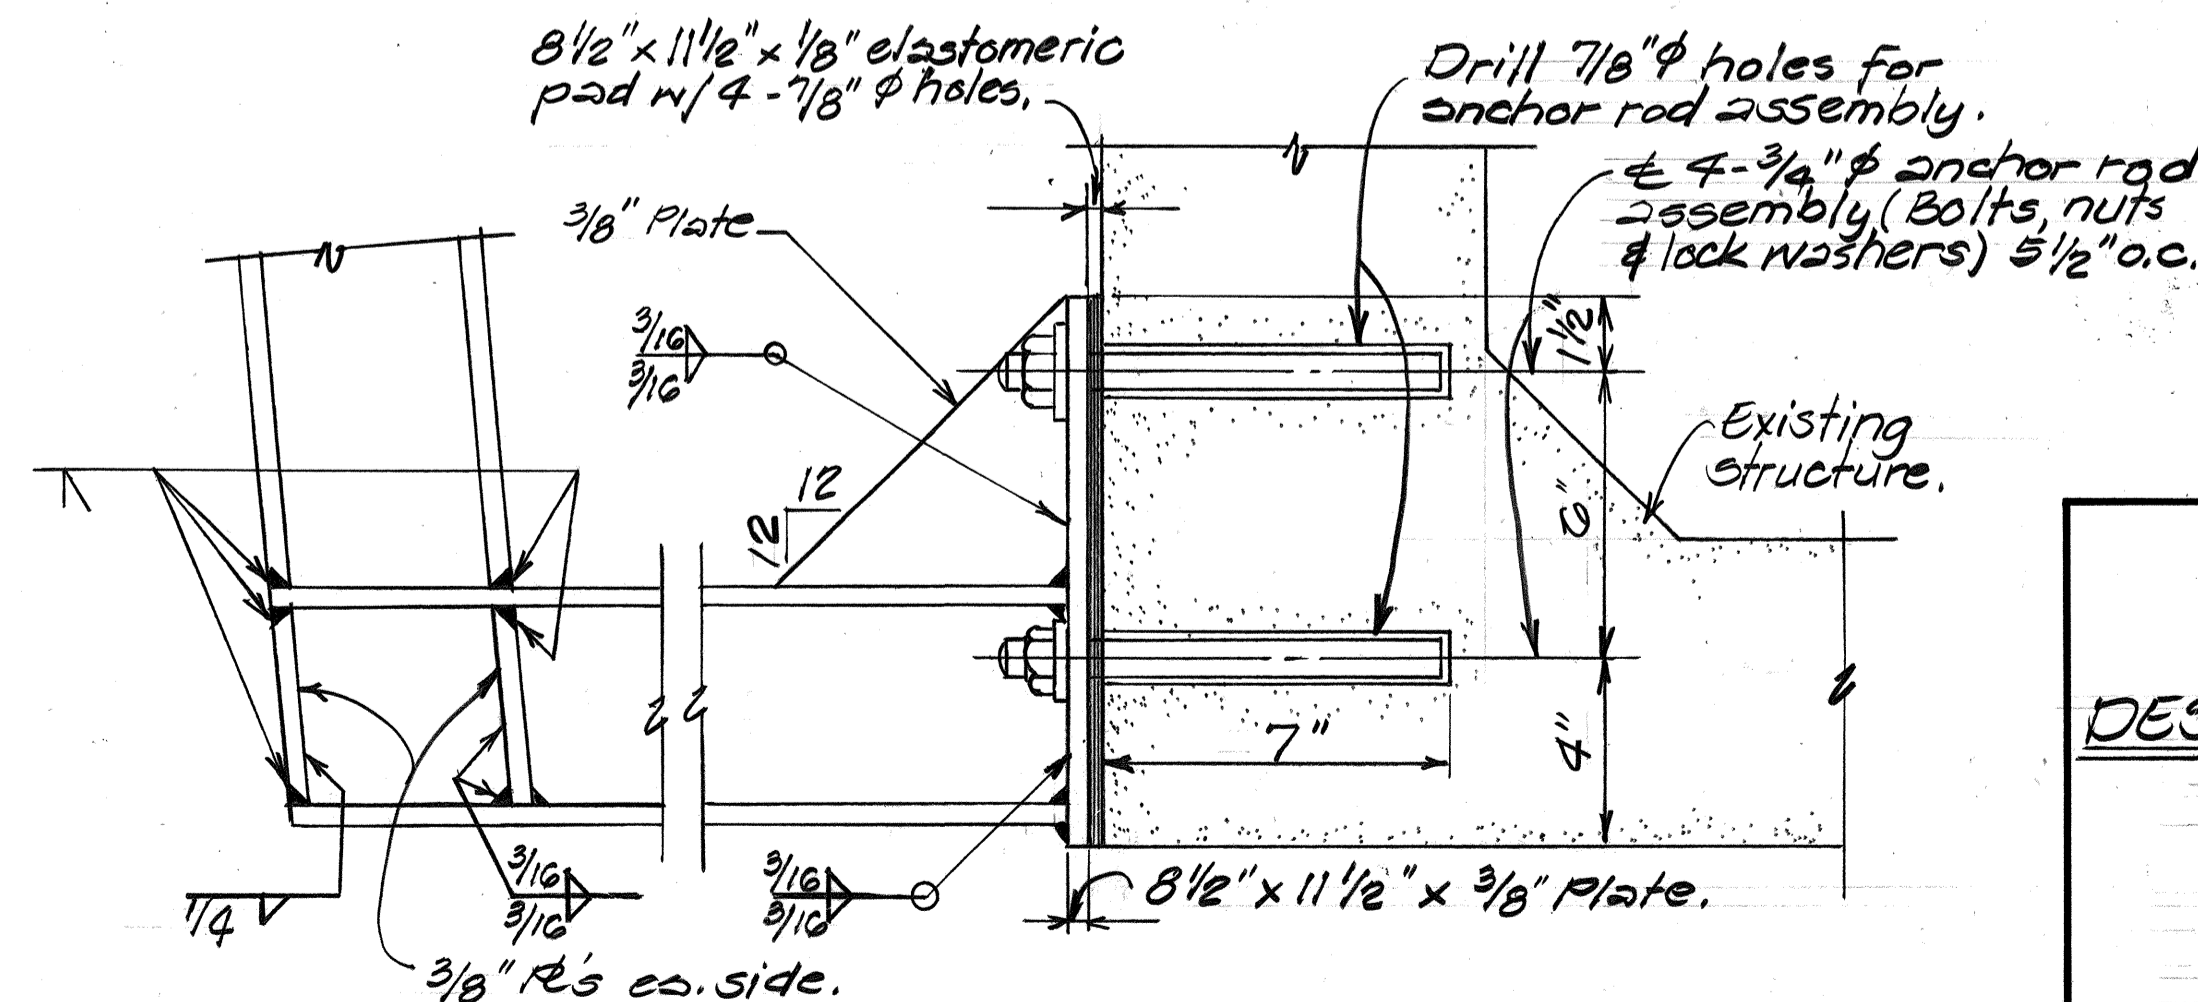

DETAIL "B"
Scale: 3" = 1'-0"

DATE	REVISION
10/3/86	Install new sign in lieu of relocation.

STATE OF HAWAII
DEPARTMENT OF TRANSPORTATION
HIGHWAYS DIVISION

DESTINATION SIGN RELOCATION

NOTES AND DETAILS

INTERSTATE ROUTE H-1
F.A.I. Proj. No. IR-HI-1(193)
Scale: As Noted Date: Sept. 1985

SHEET NO. 39 OF 19 SHEETS

DATE: _____
SURVEY PLOTTED BY: _____
DRAWN BY: _____
CHECKED BY: _____
ORIGINAL PLAN: _____
NOTE BOOK: _____
NO. _____


FED. ROAD DIST. NO.	STATE	FED. AID PROJ. NO.	FISCAL YEAR	SHEET NO.	TOTAL SHEETS
HAWAII	HAW.	IR-HI-1(1983)	1986	40	62

HIGHWAY LIGHTING SCHEDULE	
± STA.	DESCRIPTION OF WORK
511 + 20 ± RT.	Breakaway Coupling & Skirt
512 + 20 ±	
512 + 65 ±	
514 + 20 ±	
515 + 60 ±	
517 + 10 ±	
518 + 55 ±	
520 + 05 ±	
521 + 50 ±	
523 + 00 ±	
524 + 50 ±	
526 + 00 ±	
527 + 65 ±	
529 + 00 ±	
530 + 45 ±	
532 + 00 ±	
66 + 85 ±	
68 + 55 ±	
70 + 25 ±	
71 + 95 ±	
76 + 25 ±	
92 + 30 ±	
93 + 90 ±	
95 + 60 ±	
97 + 50 ±	
99 + 50 ±	
125 + 95 ±	New Conc. Base & Breakaway Coupling & Skirt
127 + 90 ±	
129 + 55 ±	
131 + 80 ±	
133 + 75 ±	
135 + 85 ±	
137 + 65 ±	
139 + 75 ±	
141 + 70 ±	
143 + 65 ±	
151 + 50 ±	
153 + 45 ±	
155 + 45 ±	
157 + 40 ±	
159 + 35 ±	
161 + 30 ±	
171 + 15 ±	
173 + 15 ±	
175 + 10 ±	

HIGHWAY LIGHTING SCHEDULE	
± STA.	DESCRIPTION OF WORK
.75 + 35 ± LT.	Breakaway Coupling & Skirt
77 + 00 ±	
77 + 65 ±	
80 + 30 ±	
81 + 95 ±	
83 + 60 ±	
85 + 25 ±	
126 + 95 ±	New Conc. Base & Breakaway Coupling & Skirt
128 + 90 ±	
130 + 85 ±	
132 + 80 ±	
134 + 75 ±	
136 + 70 ±	
138 + 65 ±	
140 + 70 ±	
142 + 70 ±	
144 + 65 ±	
152 + 50 ±	
154 + 45 ±	
156 + 40 ±	
158 + 40 ±	
160 + 35 ±	
162 + 30 ±	
172 + 15 ±	Breakaway Coupling & Skirt
174 + 10 ±	New Conc. Base & Breakaway Coupling & Skirt
176 + 10 ±	
506 + 00 RT.	Breakaway Coupling & Skirt
503 + 90	New Conc. Base & Breakaway Coupling & Skirt
507 + 90	
509 + 80	

HIGHWAY LIGHTING NOTES

- The final locations of all highway lighting equipment shall be approved by the Engineer.
- All existing highway lighting standards as shown on the Highway Lighting Schedule shall have breakaway support couplings and skirt covers installed. Those requiring new concrete bases shall be relocated as close to the existing standard as possible.
- All existing Highway Lighting Standards shall be operable during the Contractor's non-working hours.
- The Contractor shall assume that existing utilities may exist, although not shown. The Contractor shall verify the locations of existing utilities with the respective owners prior to start of construction. Any damage to existing utilities shall be repaired at the Contractor's expense.

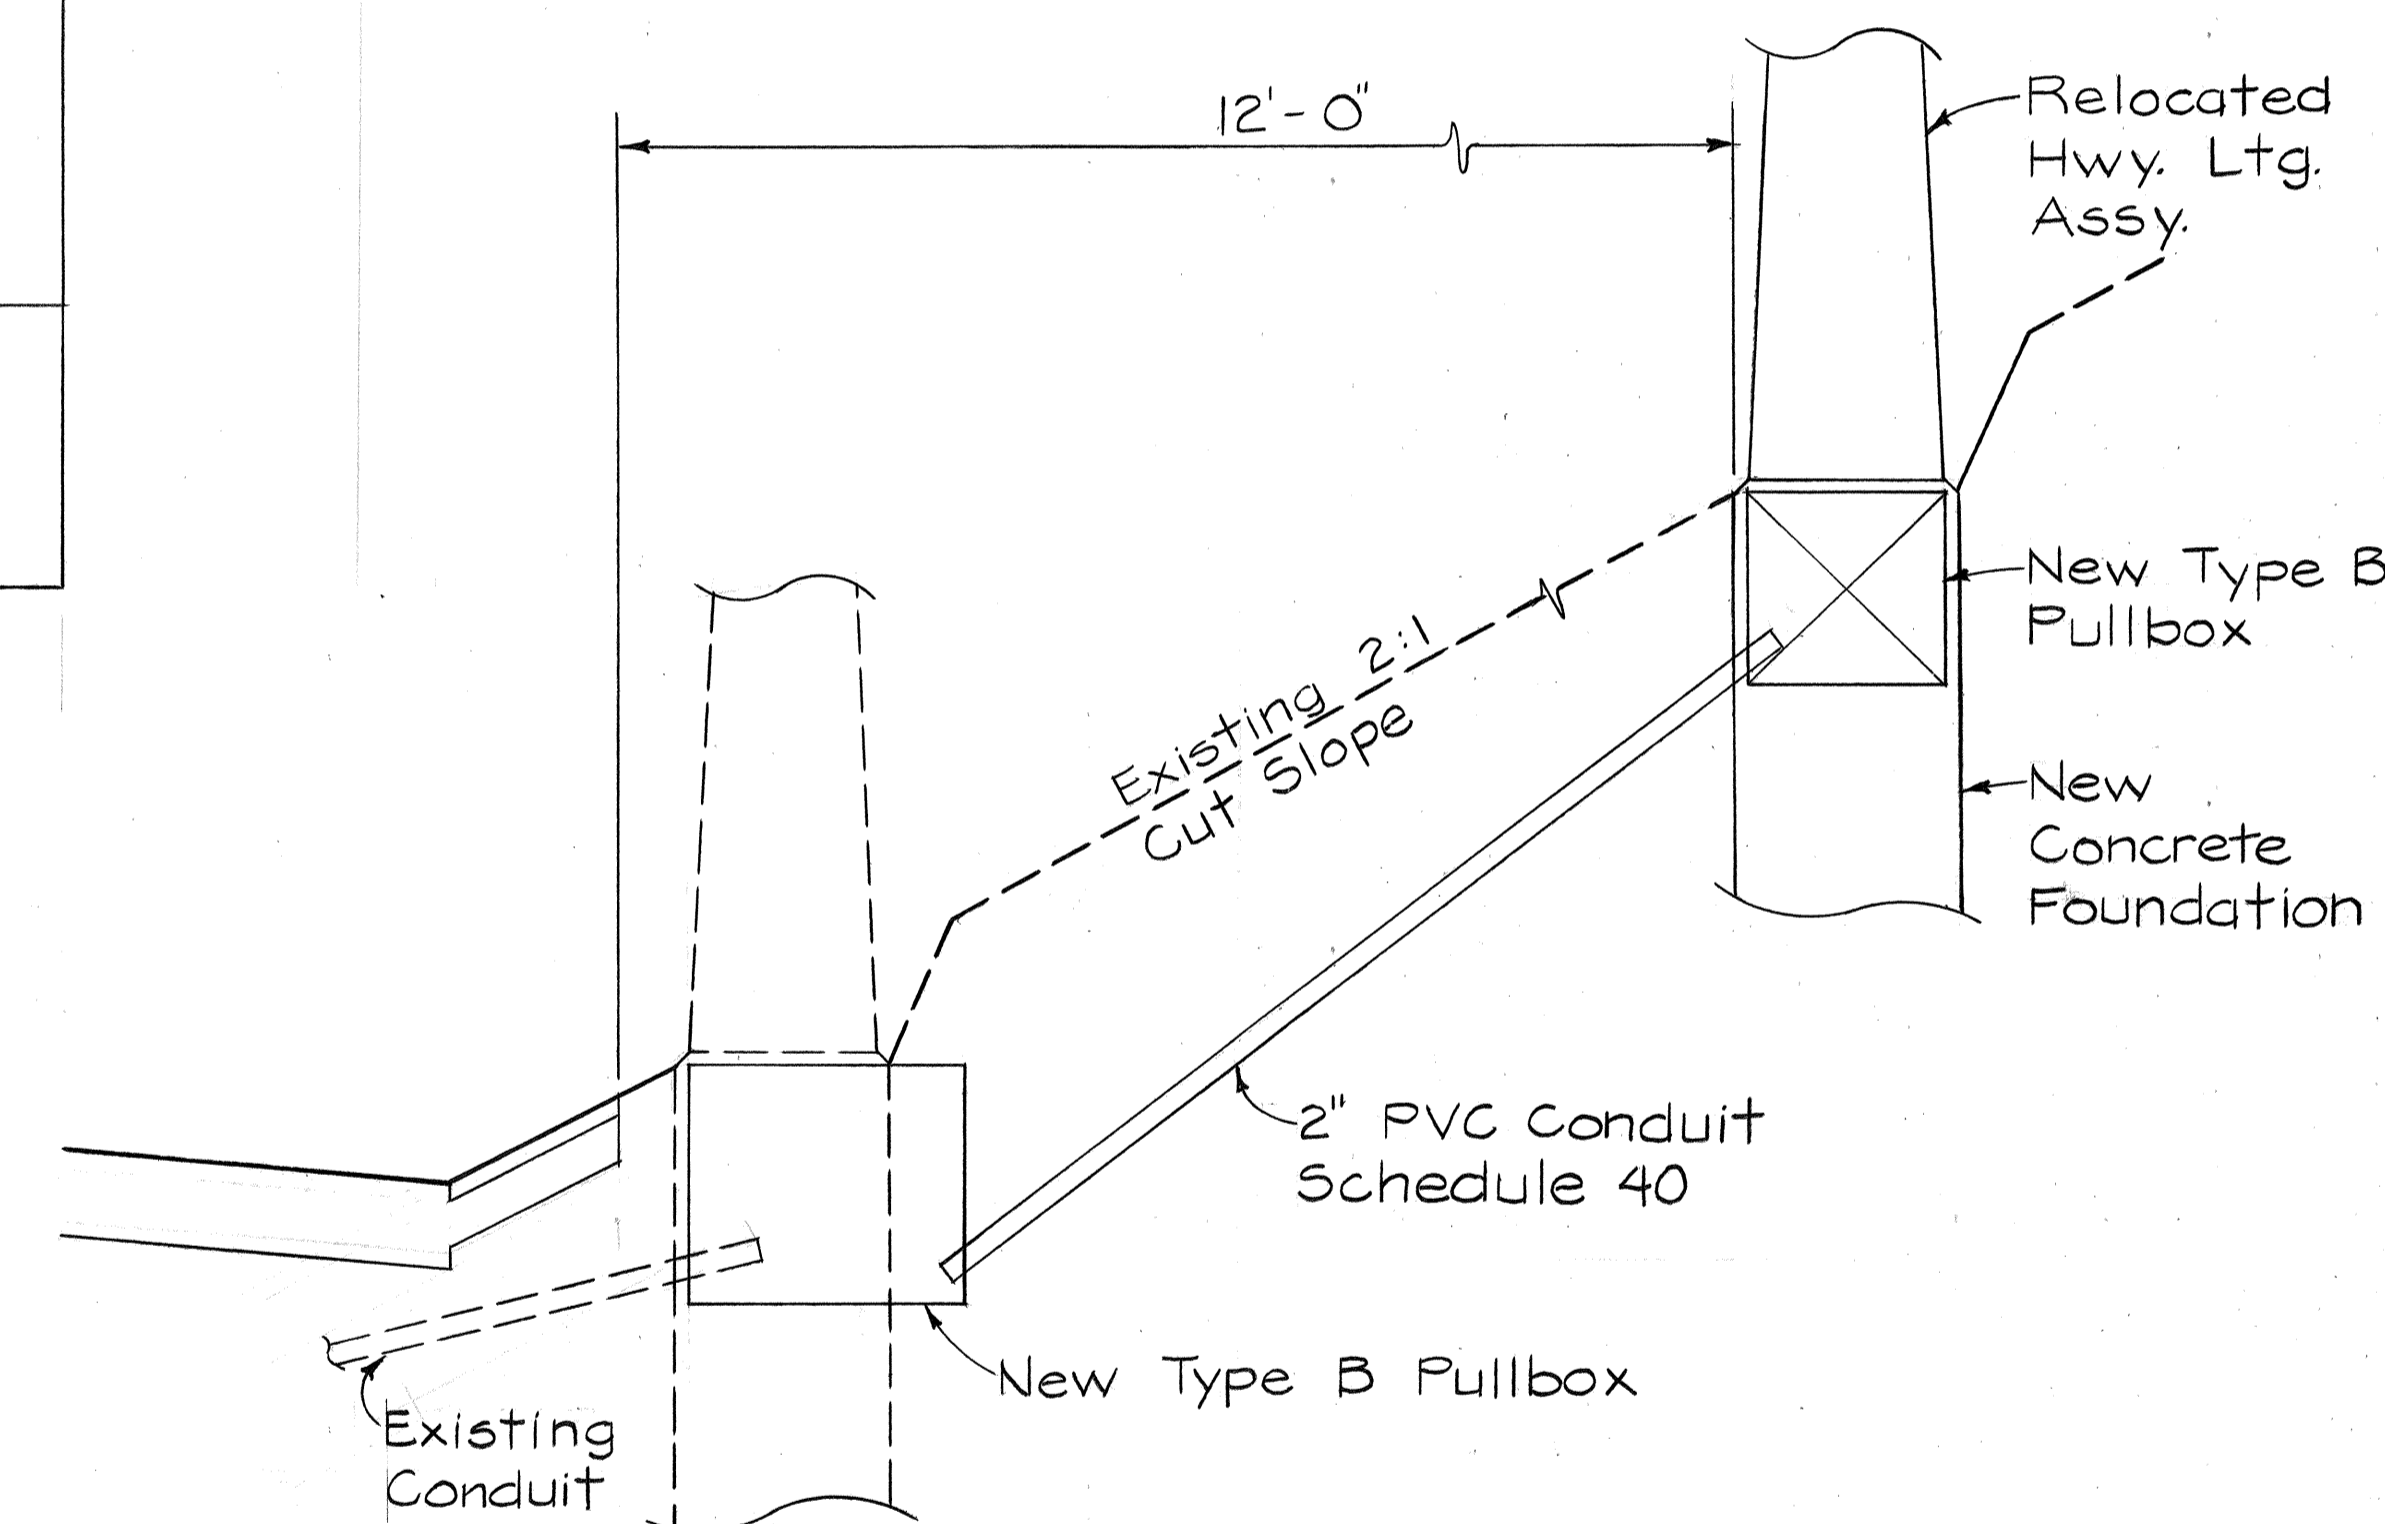

TYPICAL DETAIL
RELOCATION OF HIGHWAY
LIGHTING ASSEMBLY

7/1/86	Additional Highway Lighting Adjusted.
	Highway Lighting Slope Relocation Detail Added.
Date	Revision

STATE OF HAWAII
DEPARTMENT OF TRANSPORTATION
HIGHWAYS DIVISION

**HIGHWAY LIGHTING NOTES
AND SCHEDULE
ADDITIONAL LANES
INTERSTATE ROUTE H-1
F.A.I. PROJ. NO. IR-HI-1(1983)**


Sept. 1985

SHEET No. T3 OF 19 SHEETS


DATE: _____
SURVEY PLOTTED BY: _____
DRAWN BY: _____
DESIGNED BY: _____
CHECKED BY: _____
CREATED BY: _____
ORIGINAL PLAN: _____
NOTE BOOK: _____
No. _____

A-6.6

FED. ROAD DIST. NO.	STATE	FED. AID PROJ. NO.	FISCAL YEAR	SHEET NO.	TOTAL SHEETS
HAWAII	HAW.	IR-HI-1(193)	1985	405-1	62

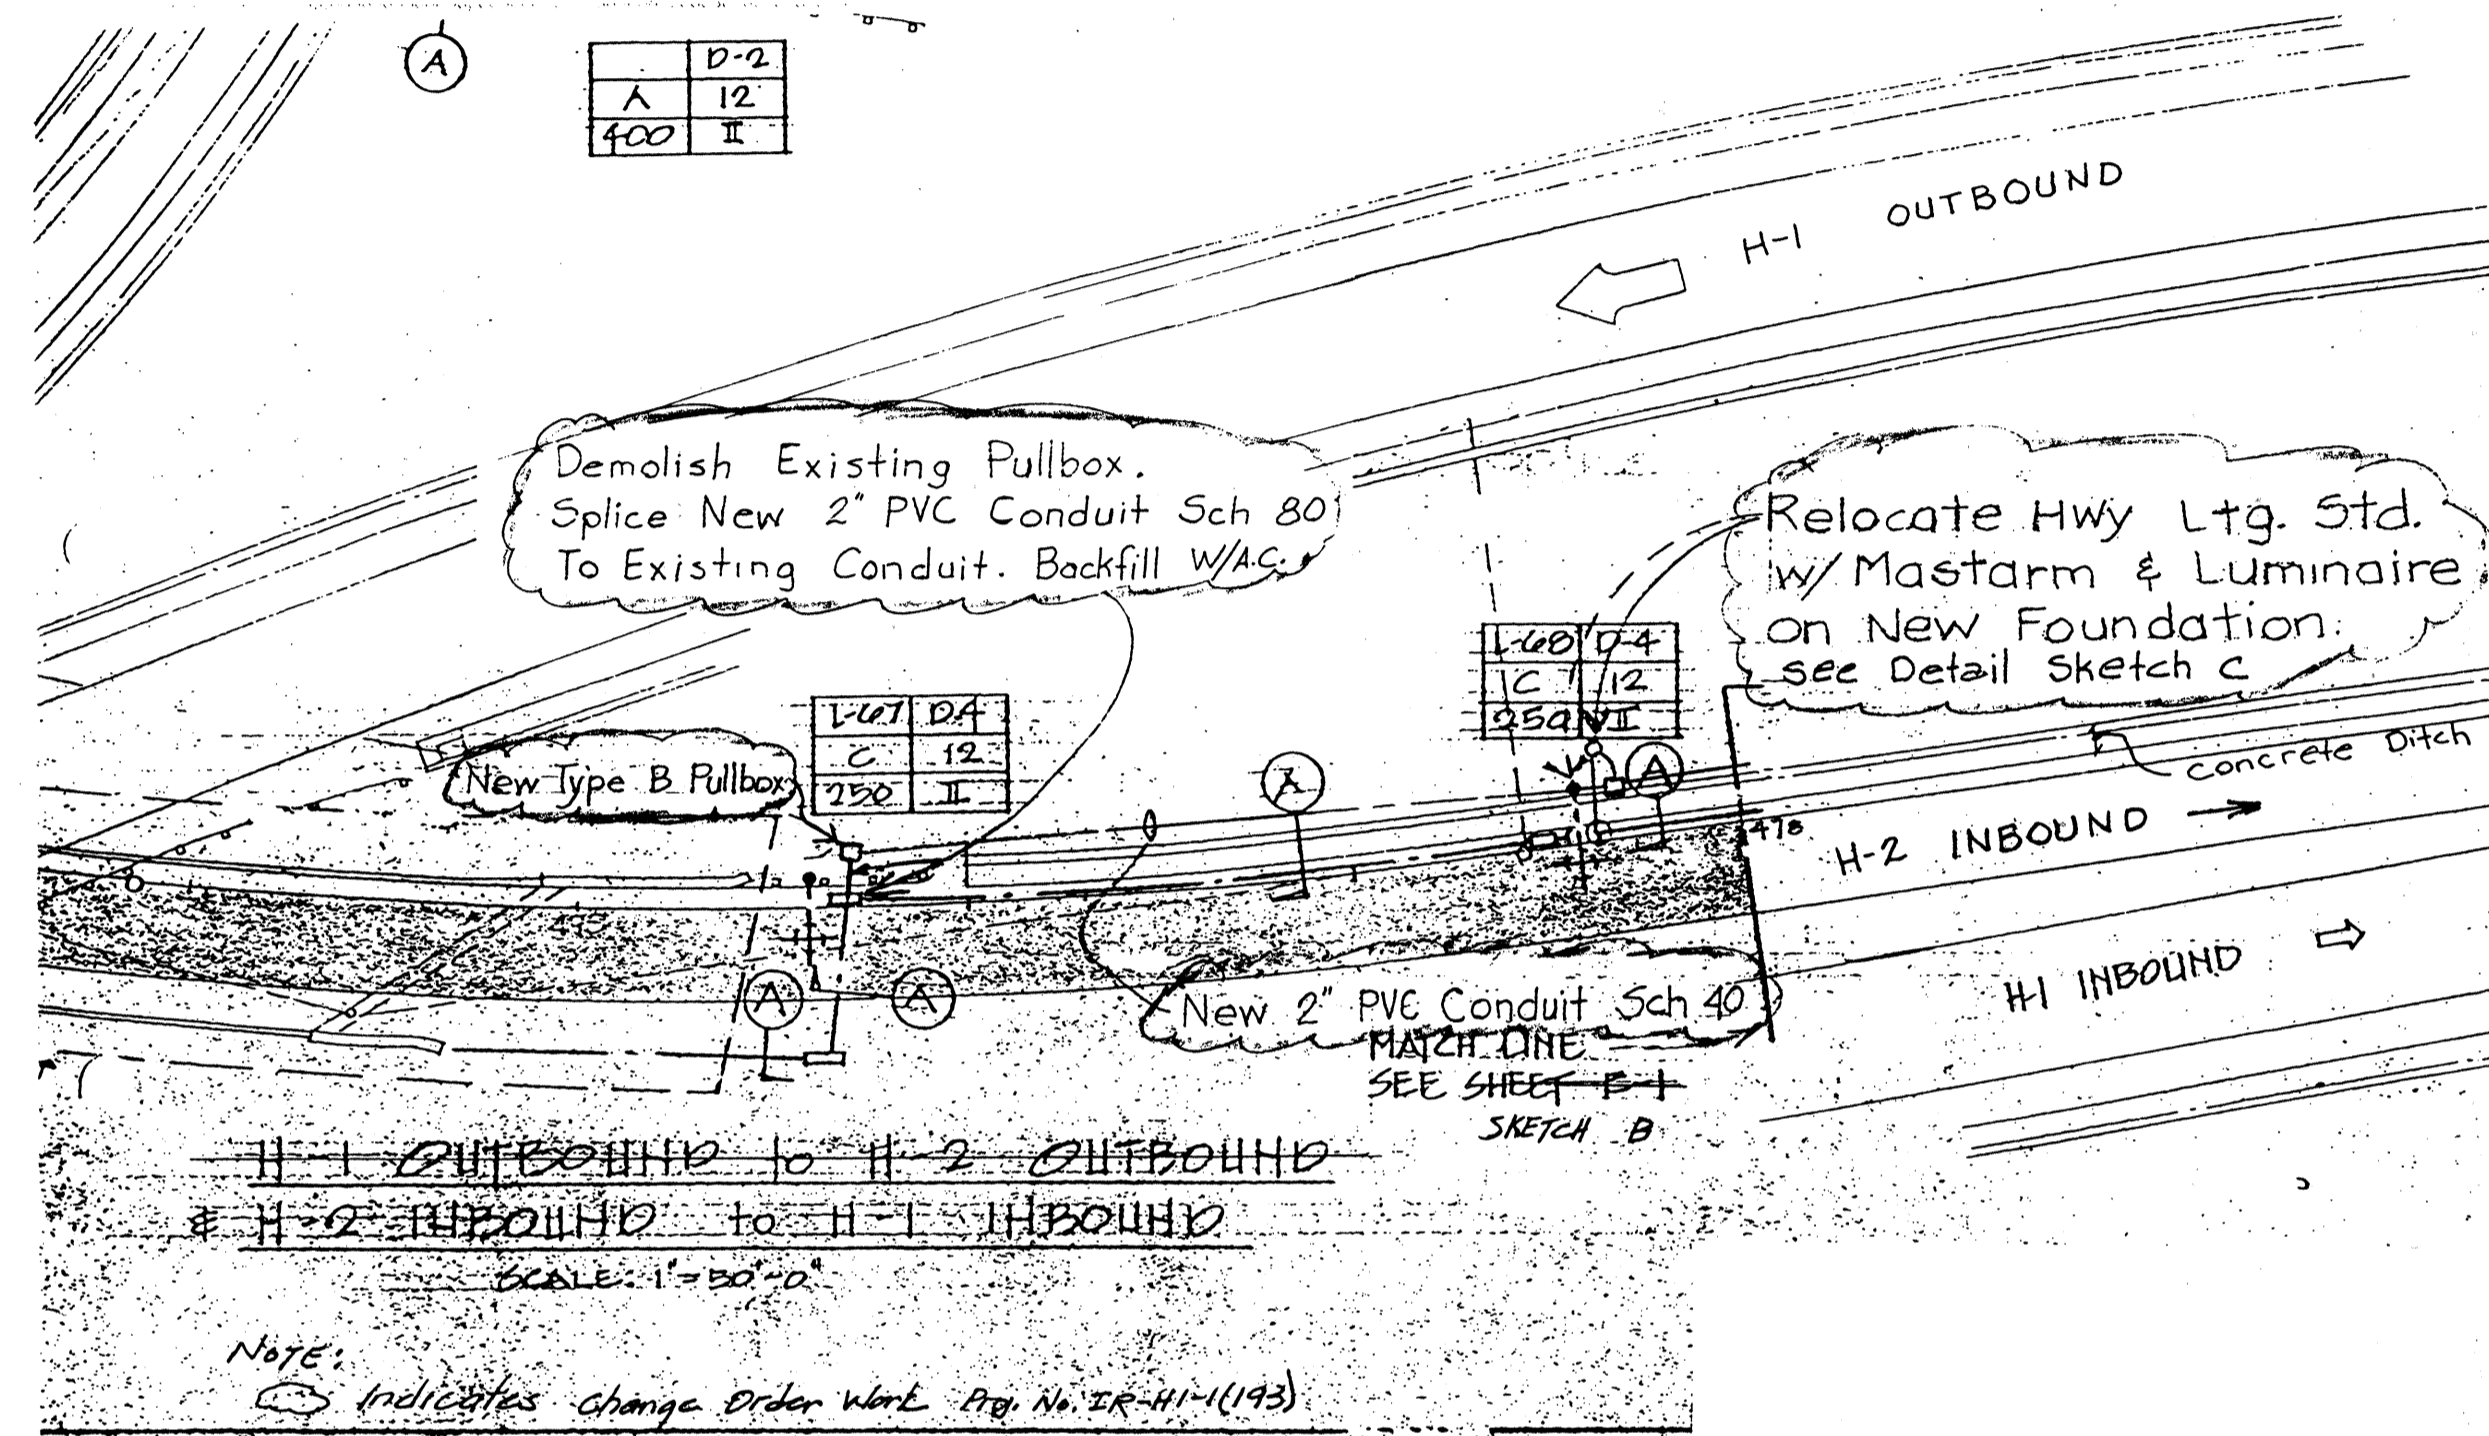

H-1 ADDITIONAL LANES
WAIWA I.C. TOWARD HALAWA I.C.
Change Order No. 12
Sketch A

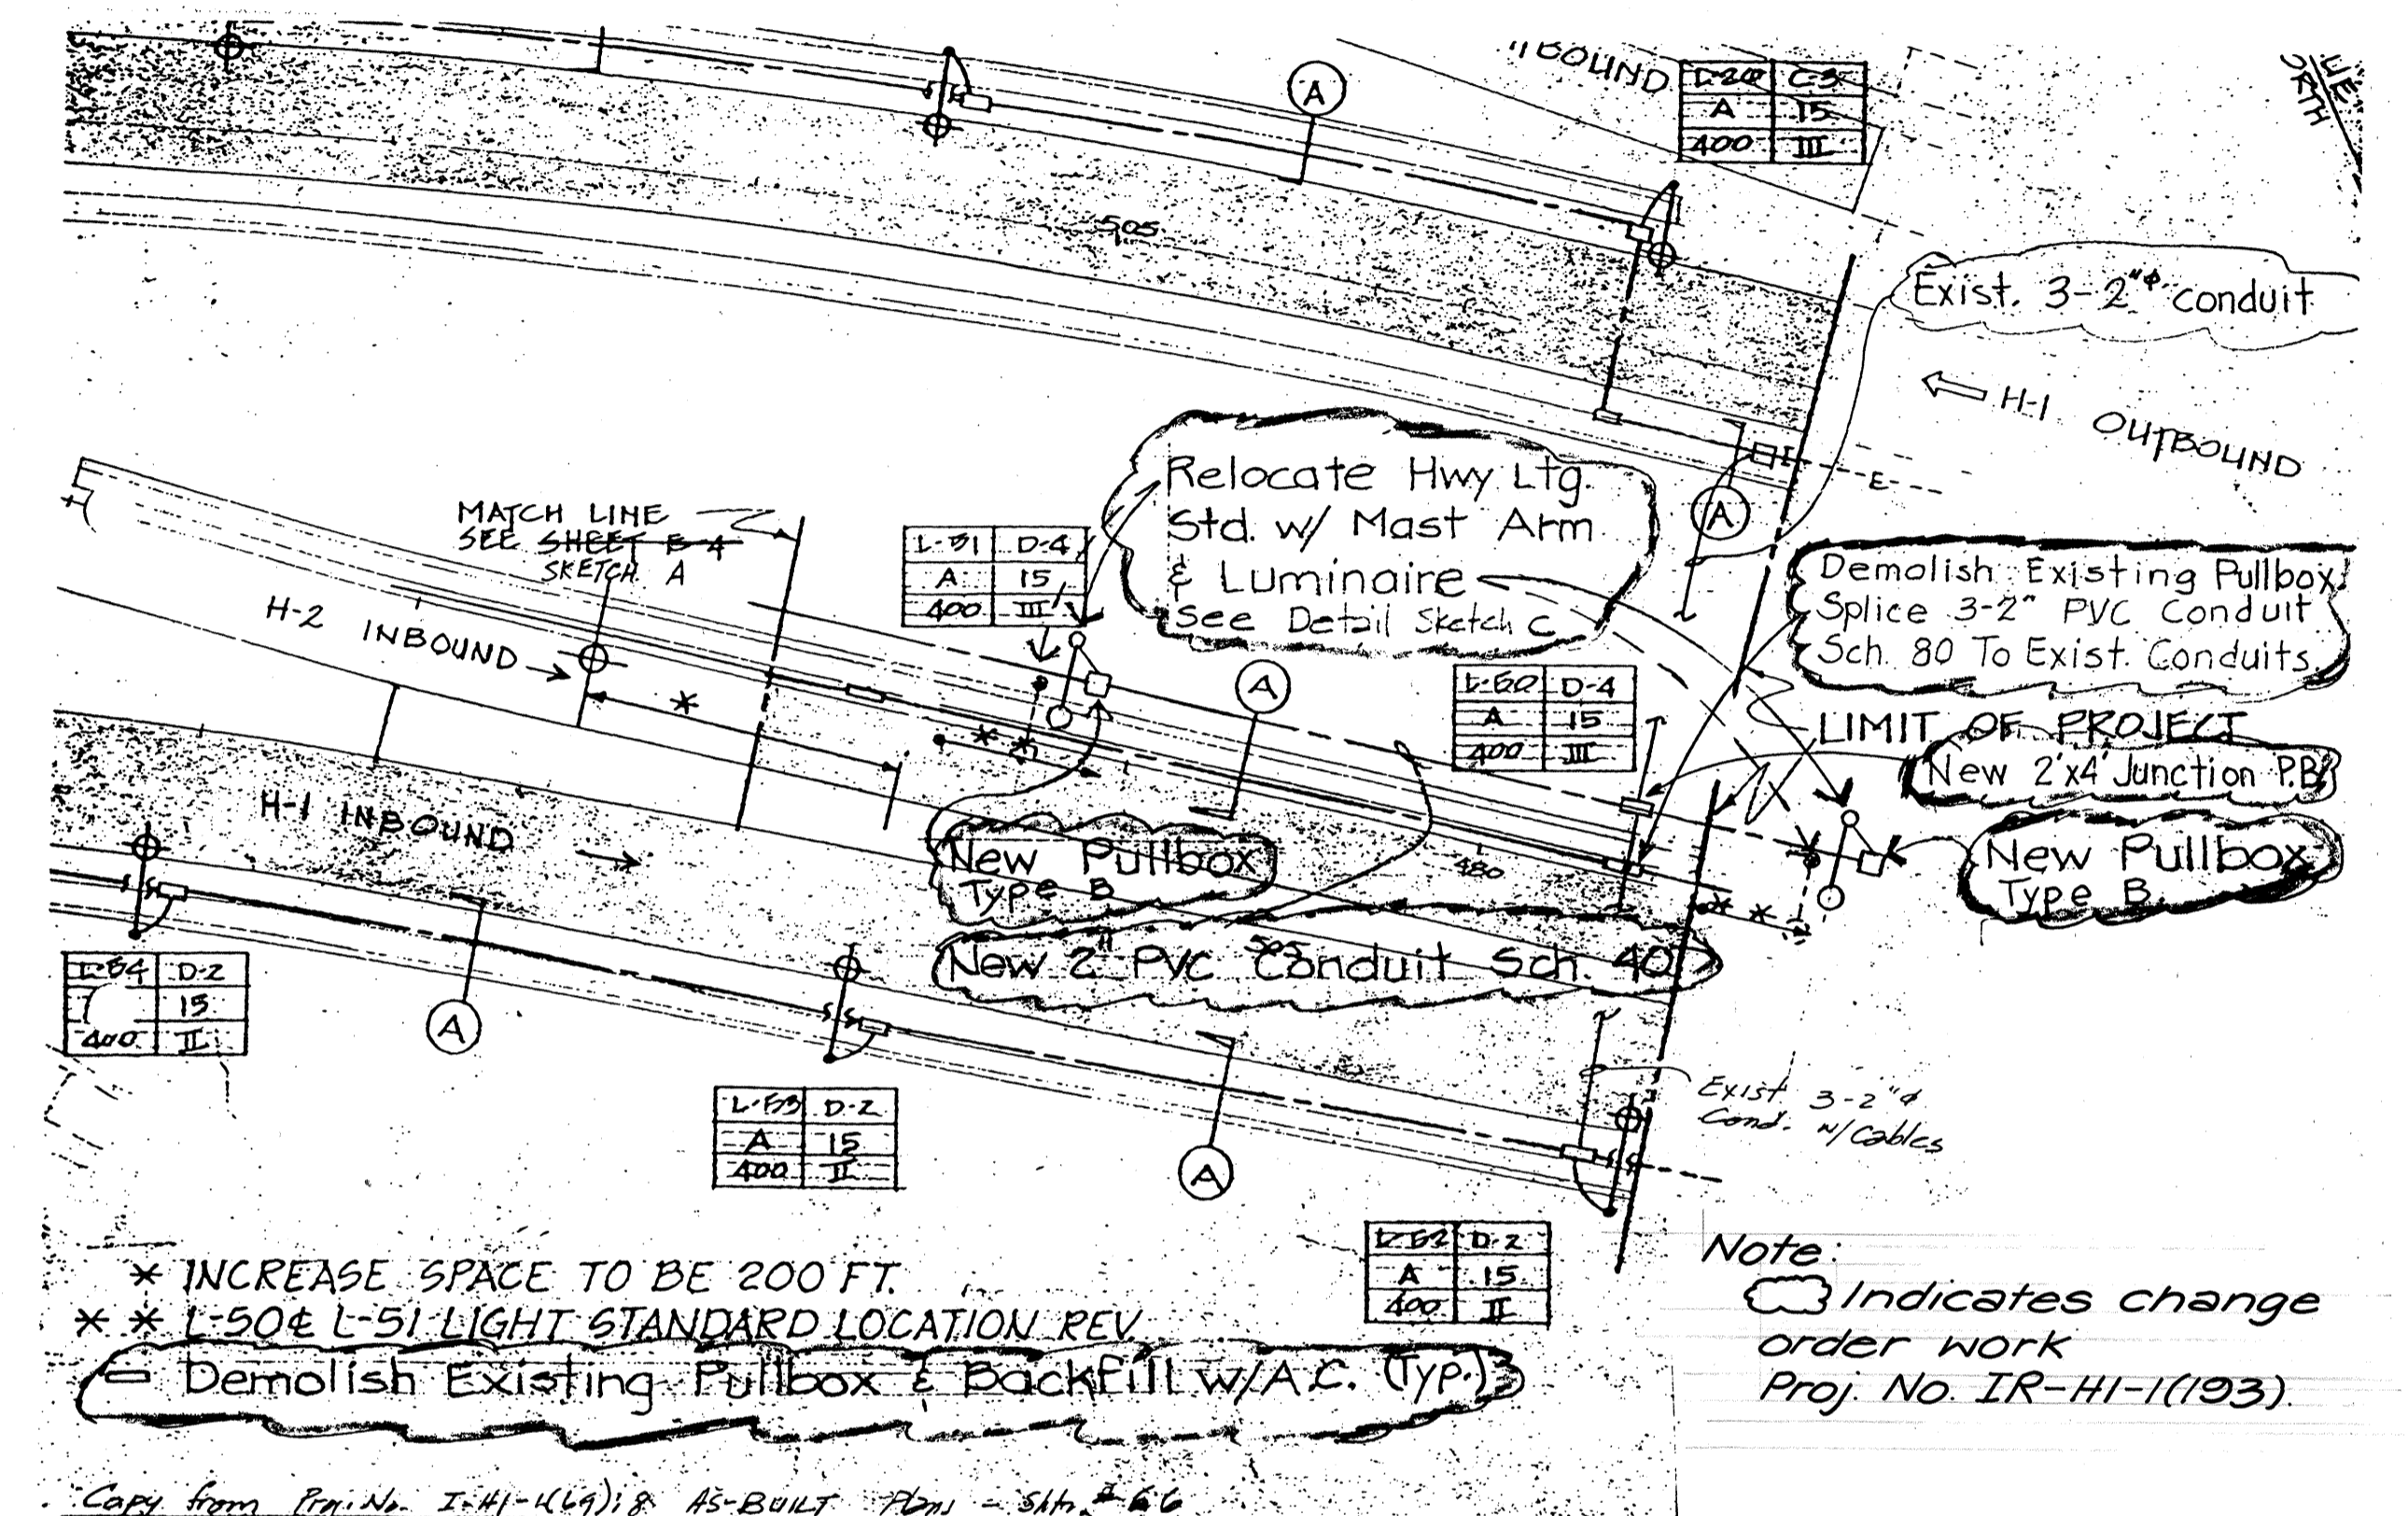

H-1 ADDITIONAL LANES
WAIWA I.C. TOWARD HALAWA I.C.
Change Order No. 12
Sketch B

Note:
The above sketches are for the relocations of three (3) existing highway light standard at H-2 (I.B.) Sta 475+50± to 482+00±. Detail C refer to the above sketches is the same as the the Typical Detail for Relocation of Highway Lighting Assemble found on Sheet No. C.O. 40.

Note:
⊖ Indicates change order work
Proj. No. IR-HI-1(193).

Note:
This tracing prepared during "As-Built" posting.

ORIGINAL PLAN	NO.
SURVEY PLOTTED BY	DATE
DRAWN BY	
DESIGNED BY	
CHECKED BY	

STATE OF HAWAII
DEPARTMENT OF TRANSPORTATION
HIGHWAYS DIVISION



**RELOCATION OF
HIGHWAY LIGHTING
STANDARD**

INTERSTATE ROUTE H-1
F.A.I. Proj. No. IR-HI-1(193)


Not to Scale Date: Feb. 1989

SHEET No. 1 OF 1 SHEETS

FED. ROAD DIST. NO.	STATE	FED. AID PROJ. NO.	FISCAL YEAR	SHEET NO.	TOTAL SHEETS
HAWAII	HAW.	IR-HI-1(193)	1986	41	62

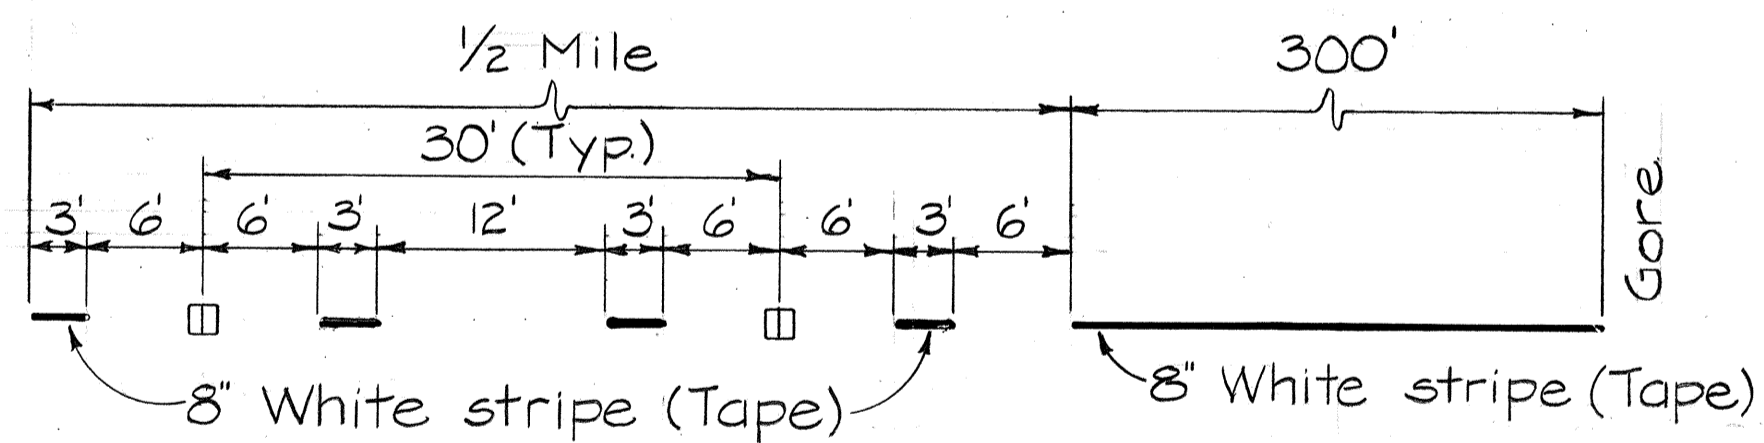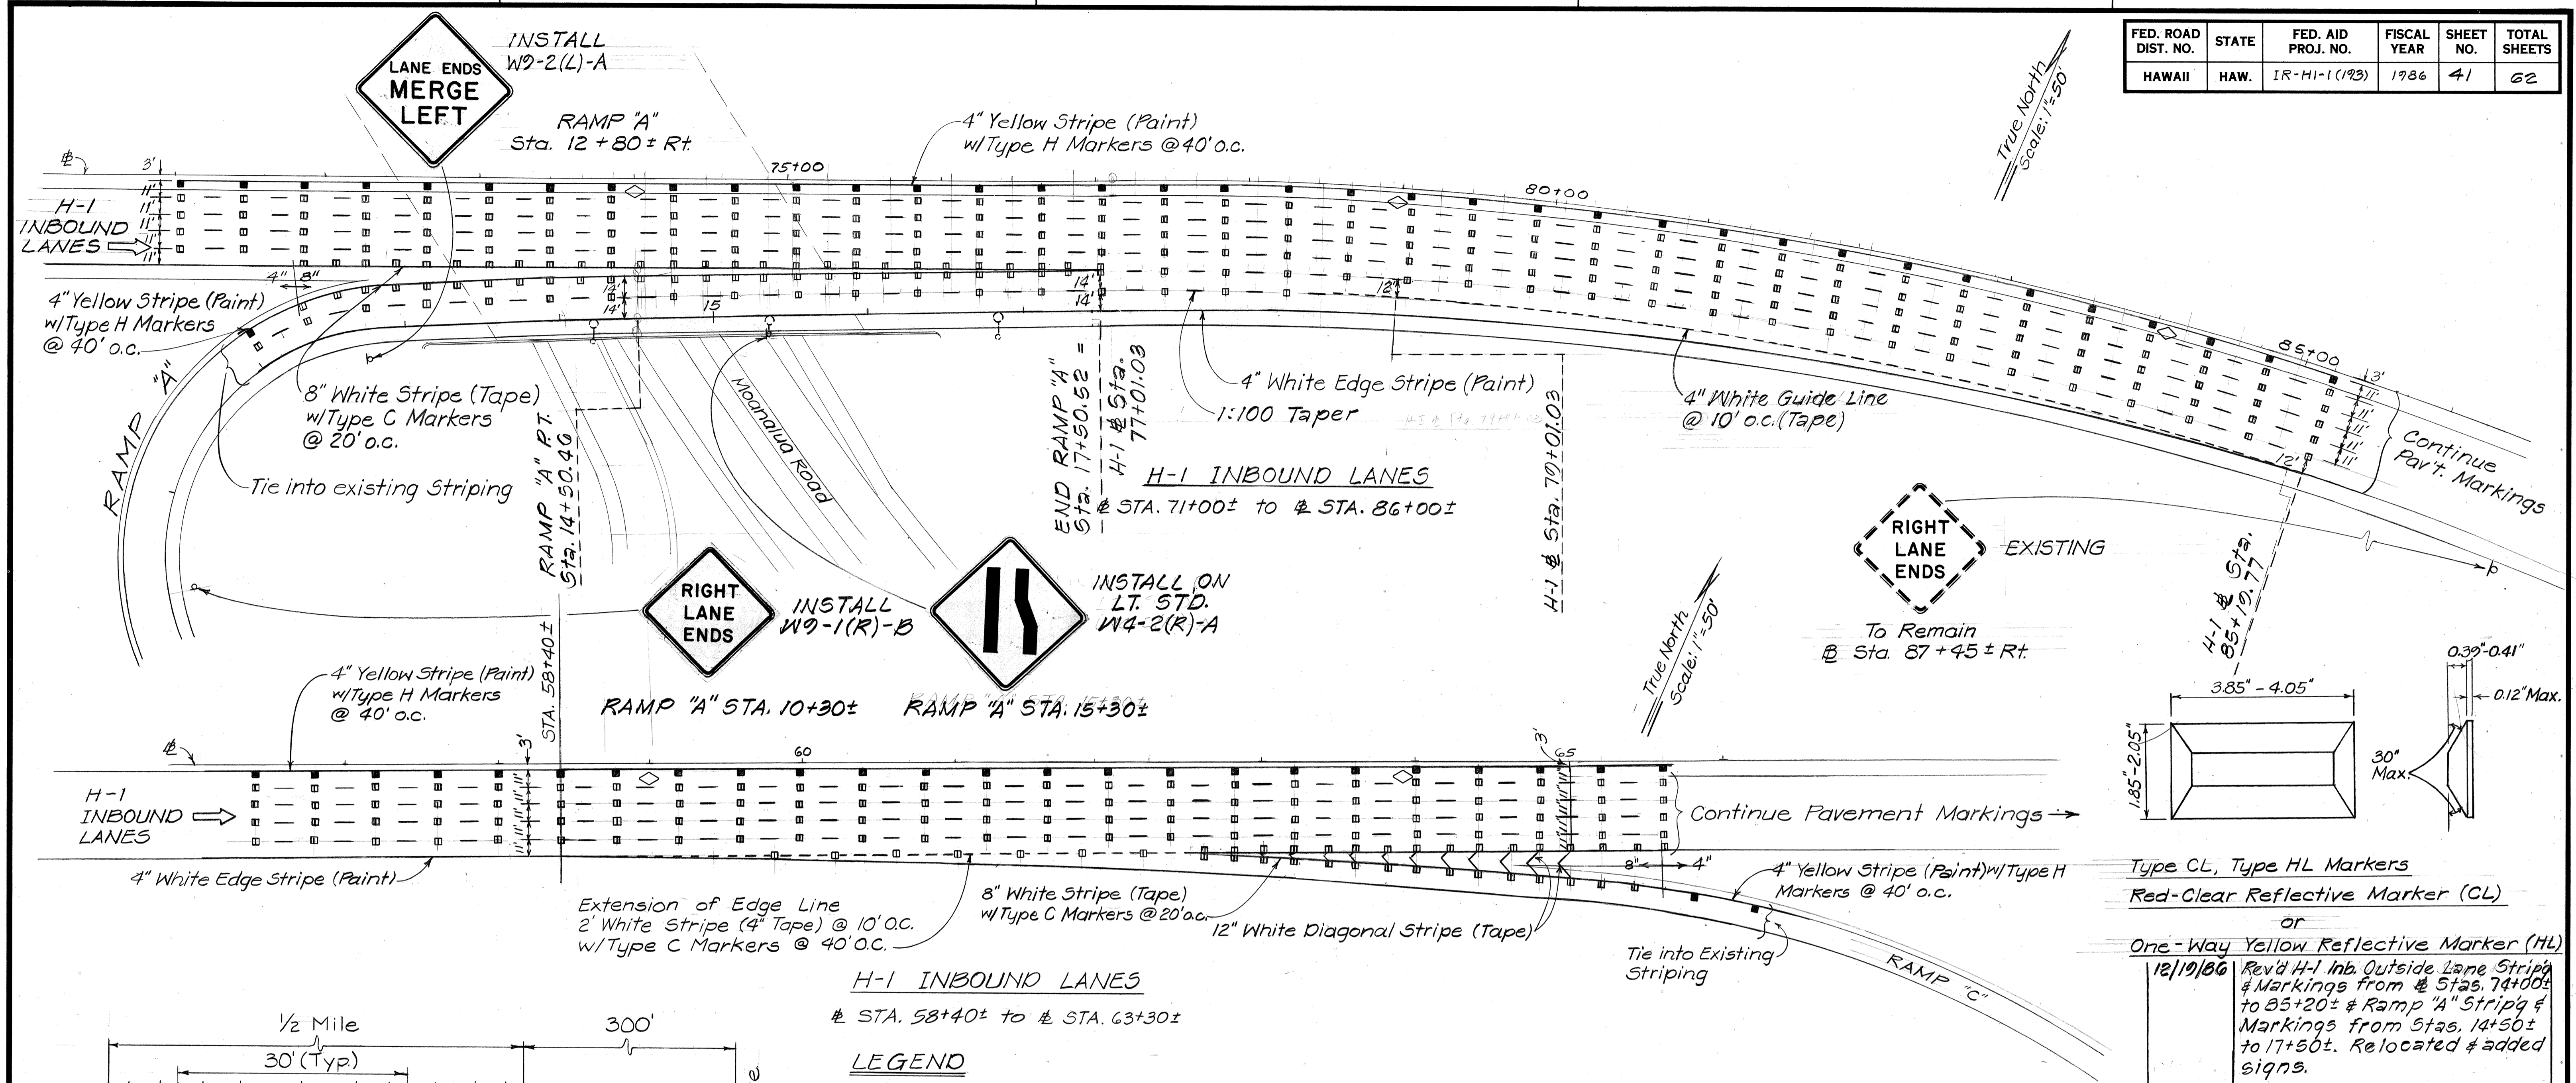

LANE DROP STRIPING
Scale: 1" = 10'-0"

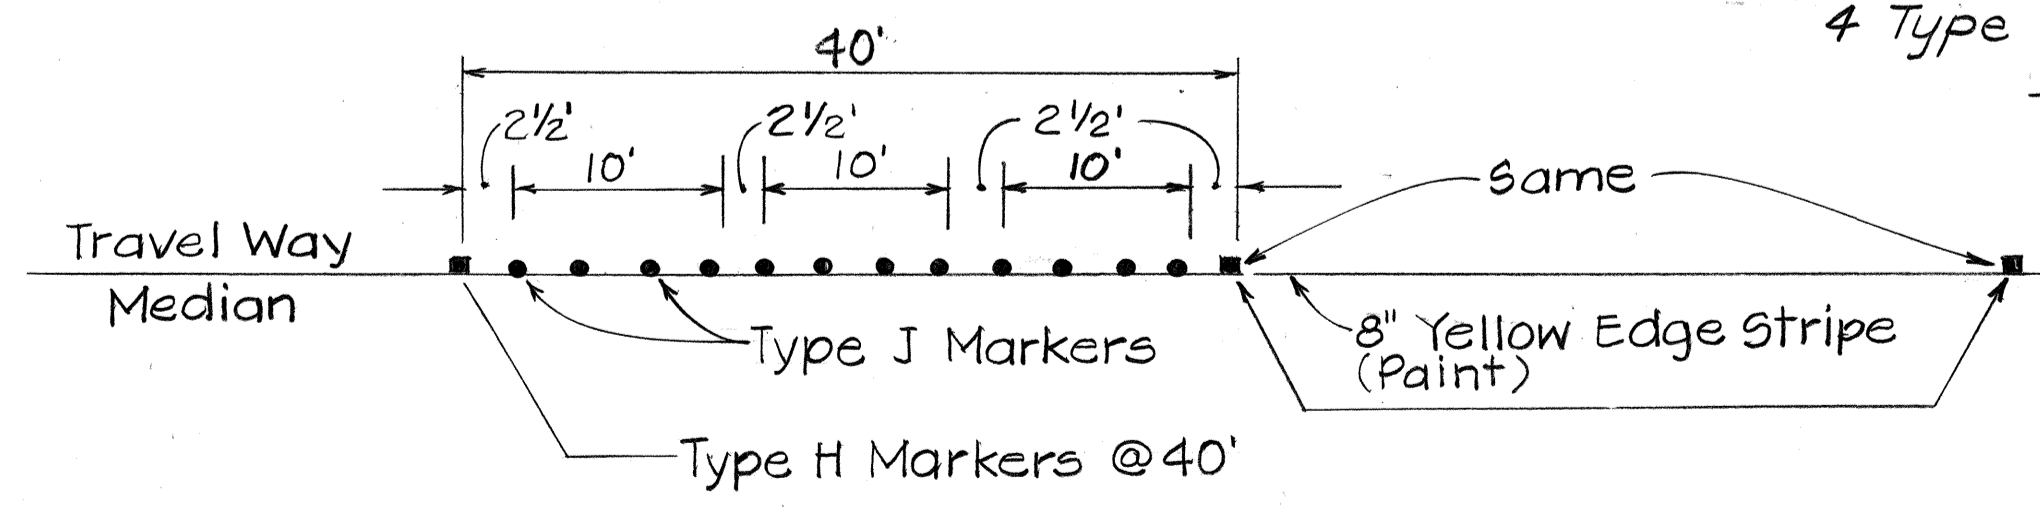

INSIDE E.P. STRIPING DETAIL

- Sta. 95+00± TO 95+40± INB. (KAAHUMANU OVERPASS)
- Sta. 134+03± TO 141+77± INB. (KAONOHI OVERPASS)
- Sta. 523+31± TO 530+93± INB. (STRUCTURE NO. 1 OVERPASS)

LEGEND

- 4" Yellow Edge Stripe (Paint) w/Type H Pavement Markers @ 40' o.c.
- 4" White Edge Stripe (Paint)
- 4 Each Type A Pavement Markers
- Type C Pavement Markers @ 40' o.c.
- 4 Type A
- 4" White Stripe (Tape) Lane Change Restriction Striping
- Pavement Diamond Symbol @ 500' o.c.

PAVEMENT MARKING NOTES (con't.)

- 5. Pavement Diamond symbols shall be installed for the I.B. carpool lanes @ 500' o.c. - H-1 I.B. Sta. 503+00 to H-1 I.B. Sta. 174+90.

PAVEMENT MARKING NOTES

- Locations of all new pavement markings shall be staked out in the field by the Contractor for approval by the Engineer prior to installation.
- Existing pavement markings not incorporated in the final traffic pattern shall be removed as directed by the Engineer. Cost will be paid for under item No. 629,3000 - Removal of existing pavement markings.
- Final pavement striping and markings installed in settlement construction areas shall be in accordance with details shown on Sht. Nos. 716-718.
- Details of Type C and Type H Markers on Sht. No. 716 shall be deleted and replaced with details of Type CL and Type HL Markers as shown on this sheet. All references to Type C and Type H Markers in the plans shall mean Type CL and Type HL Markers.

- Type CL, Type HL Markers
- Red-Clear Reflective Marker (CL)
- or
- One-Way Yellow Reflective Marker (HL)

12/19/86 Rev'd H-1 Inb. Outside Lane Striping & Markings from Sta. 74+00± to 85+20± & Ramp "A" Striping & Markings from Stas. 14+50± to 17+50±. Relocated & added signs.

6/1/86 Deleted H-1 Inb. Lane Details & Sta. 509+10 to 516+00. Added H-1 Inb. Lane Details & Sign @ Sta. 71+00 to 86+00. Revised H-1 Inb. Sta. 58+40 to 63+30 and Ramp C Pavement Markings.

1/7/86 Revised Inside E.P. Striping Detail

DATE	REVISION
12/19/86	Rev'd H-1 Inb. Outside Lane Striping & Markings from Sta. 74+00± to 85+20± & Ramp "A" Striping & Markings from Stas. 14+50± to 17+50±. Relocated & added signs.
6/1/86	Deleted H-1 Inb. Lane Details & Sta. 509+10 to 516+00. Added H-1 Inb. Lane Details & Sign @ Sta. 71+00 to 86+00. Revised H-1 Inb. Sta. 58+40 to 63+30 and Ramp C Pavement Markings.
1/7/86	Revised Inside E.P. Striping Detail

STATE OF HAWAII
DEPARTMENT OF TRANSPORTATION
HIGHWAYS DIVISION


PAVEMENT MARKING DETAILS
LEGEND AND NOTES

INTERSTATE ROUTE H-1
ADDITIONAL LANES
FAI PROJ. NO. IR-HI-1(193)

Scale: As Shown Date: Sept. 1985
SHEET No. T4 OF 19 SHEETS

DATE: _____
SURVEY PLOTTED BY: _____
DRAWN BY: _____
DESIGNED BY: _____
CHECKED BY: _____
NO. _____

FED. ROAD DIST. NO.	STATE	FED. AID PROJ. NO.	FISCAL YEAR	SHEET NO.	TOTAL SHEETS
HAWAII	HAW.	IR-HI-1(193)	1986	41	62

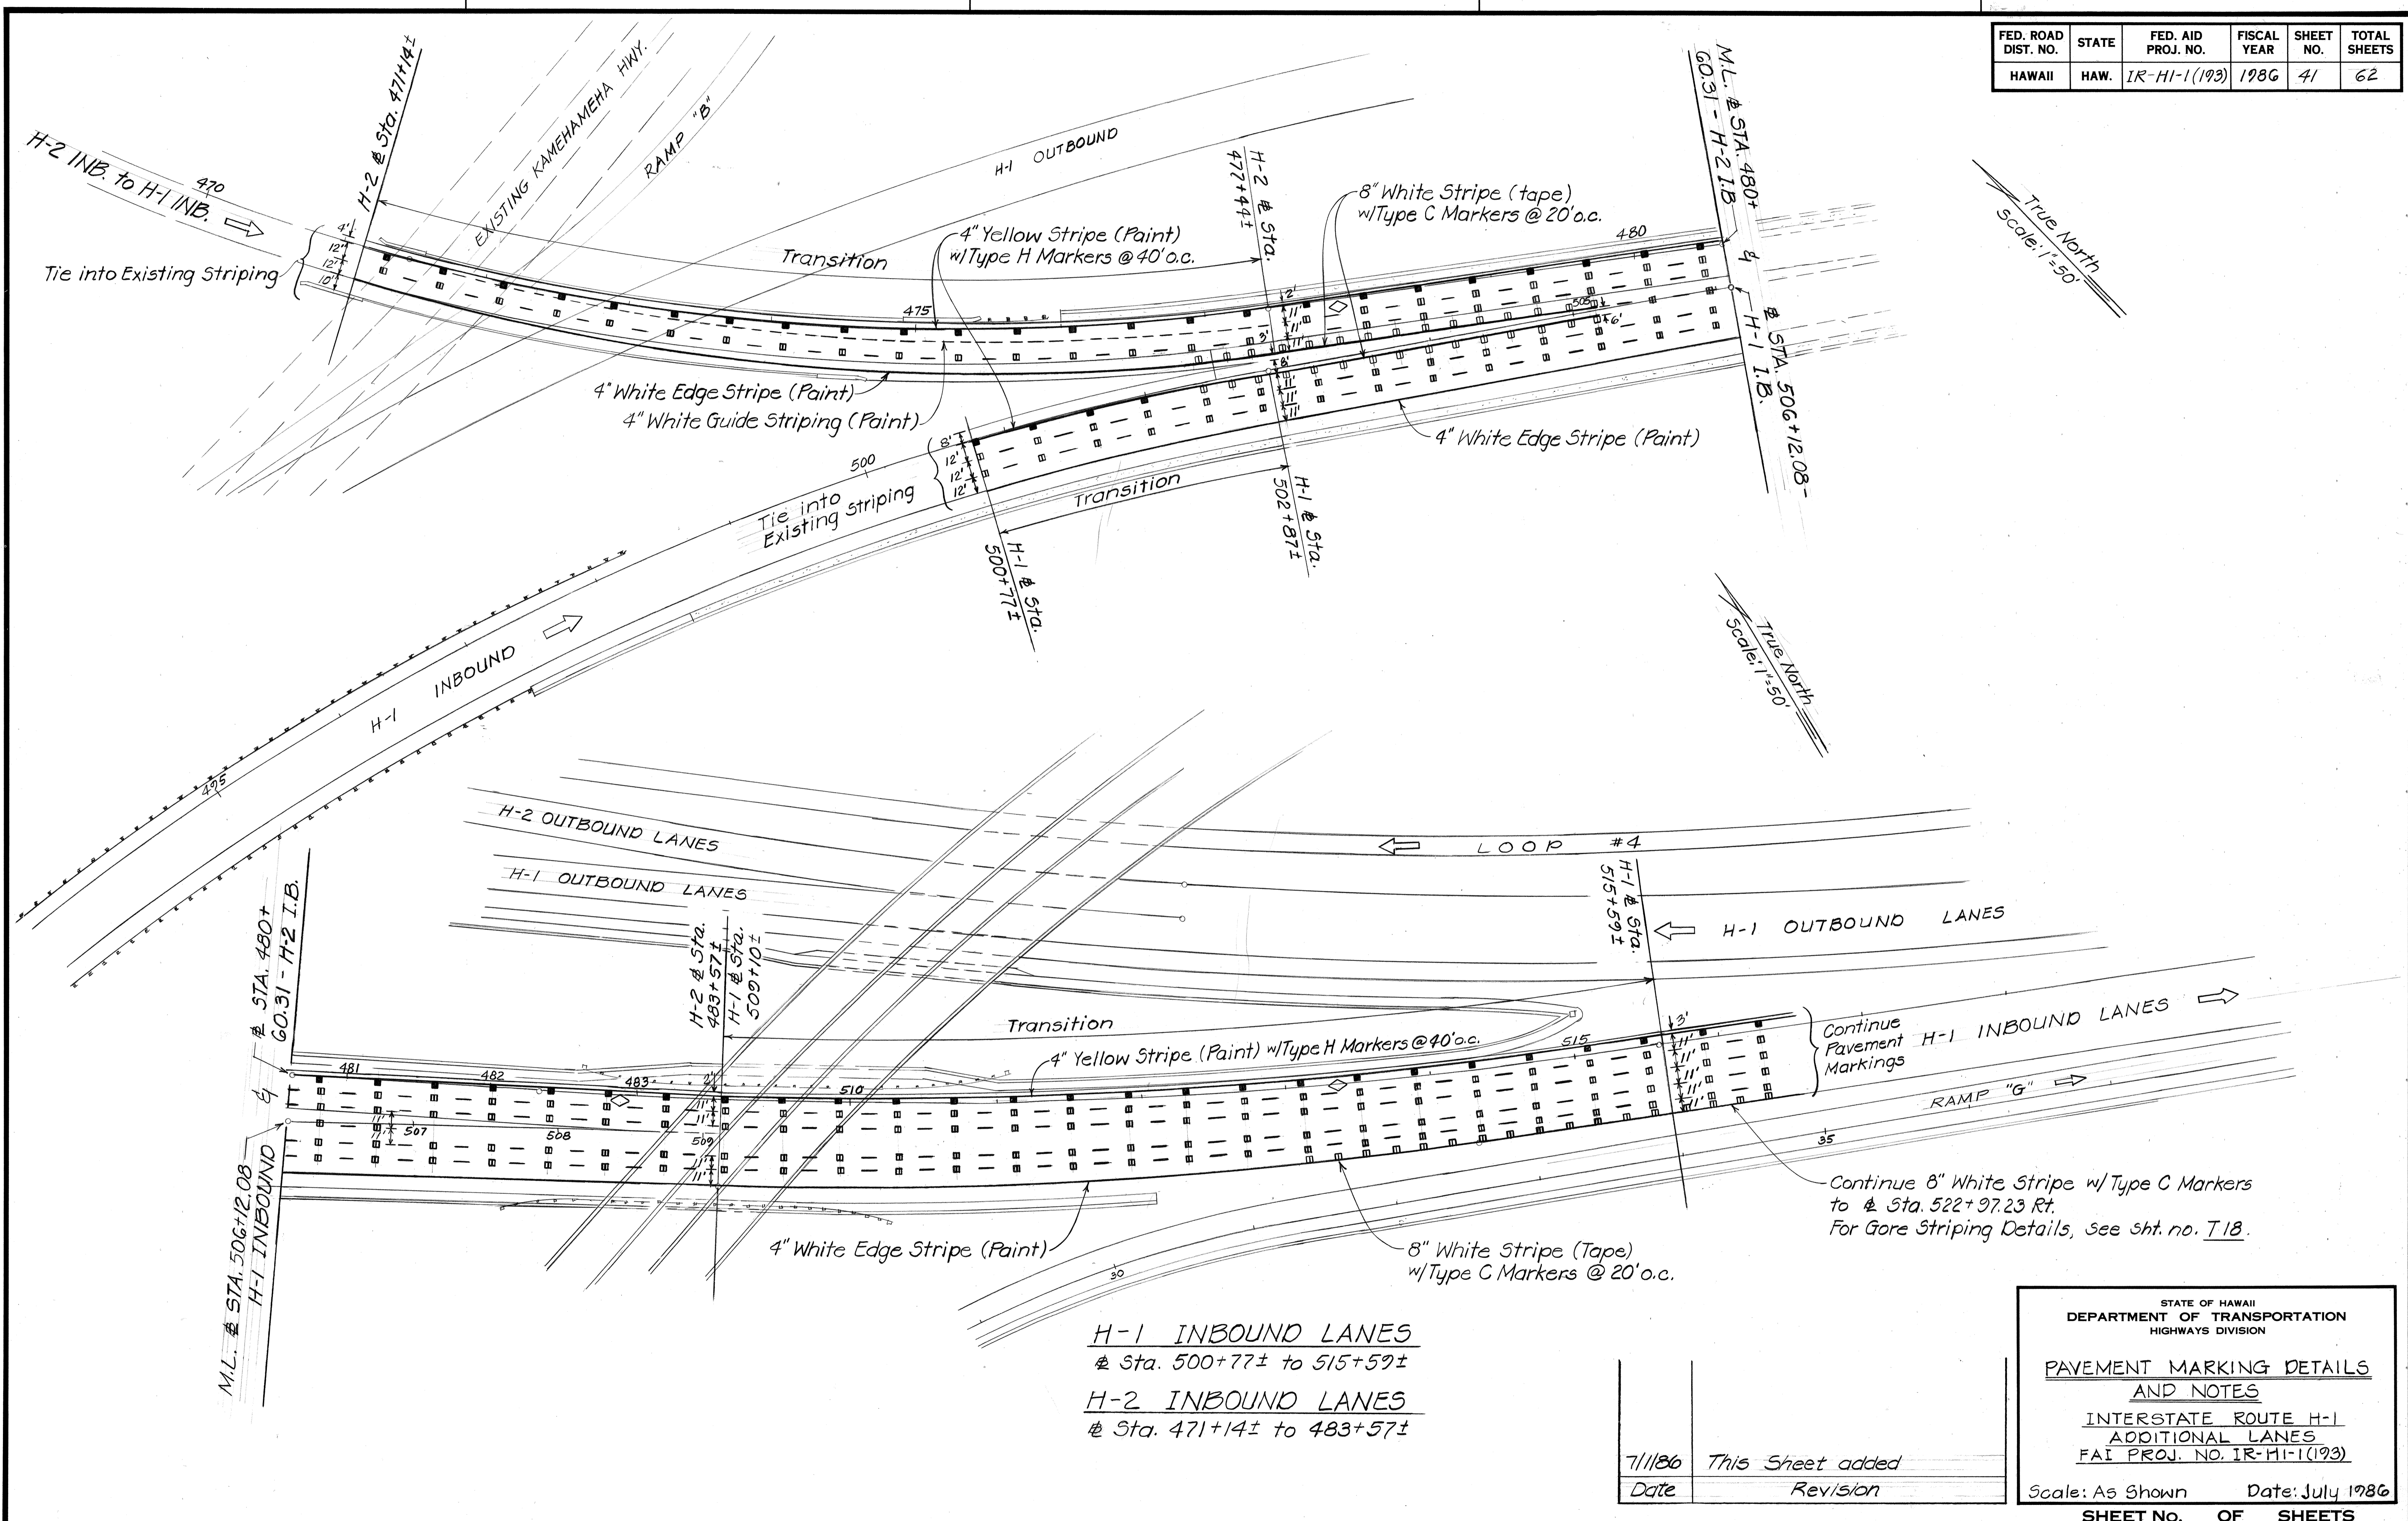

True North
Scale: 1"=50'

True North
Scale: 1"=50'

SURVEY PLOTTED BY	DATE
DRAWN BY	
DESIGNED BY	
CHECKED BY	
ORIGINAL PLAN	
NOTE BOOK	
No.	

H-1 INBOUND LANES
Sta. 500+77± to 515+59±
H-2 INBOUND LANES
Sta. 471+14± to 483+57±

Continue 8" White Stripe w/Type C Markers to Sta. 522+97.23 Rt. For Gore Striping Details, see sht. no. T.18.

7/1/86	This Sheet added
Date	Revision


STATE OF HAWAII
DEPARTMENT OF TRANSPORTATION
HIGHWAYS DIVISION

PAVEMENT MARKING DETAILS AND NOTES

INTERSTATE ROUTE H-1
ADDITIONAL LANES
FAI PROJ. NO. IR-HI-1(193)

Scale: As Shown Date: July 1986
SHEET NO. OF SHEETS

FED. ROAD DIST. NO.	STATE	FED. AID PROJ. NO.	FISCAL YEAR	SHEET NO.	TOTAL SHEETS
HAWAII	HAW.	IR-HI-1(193)	1986	42	62

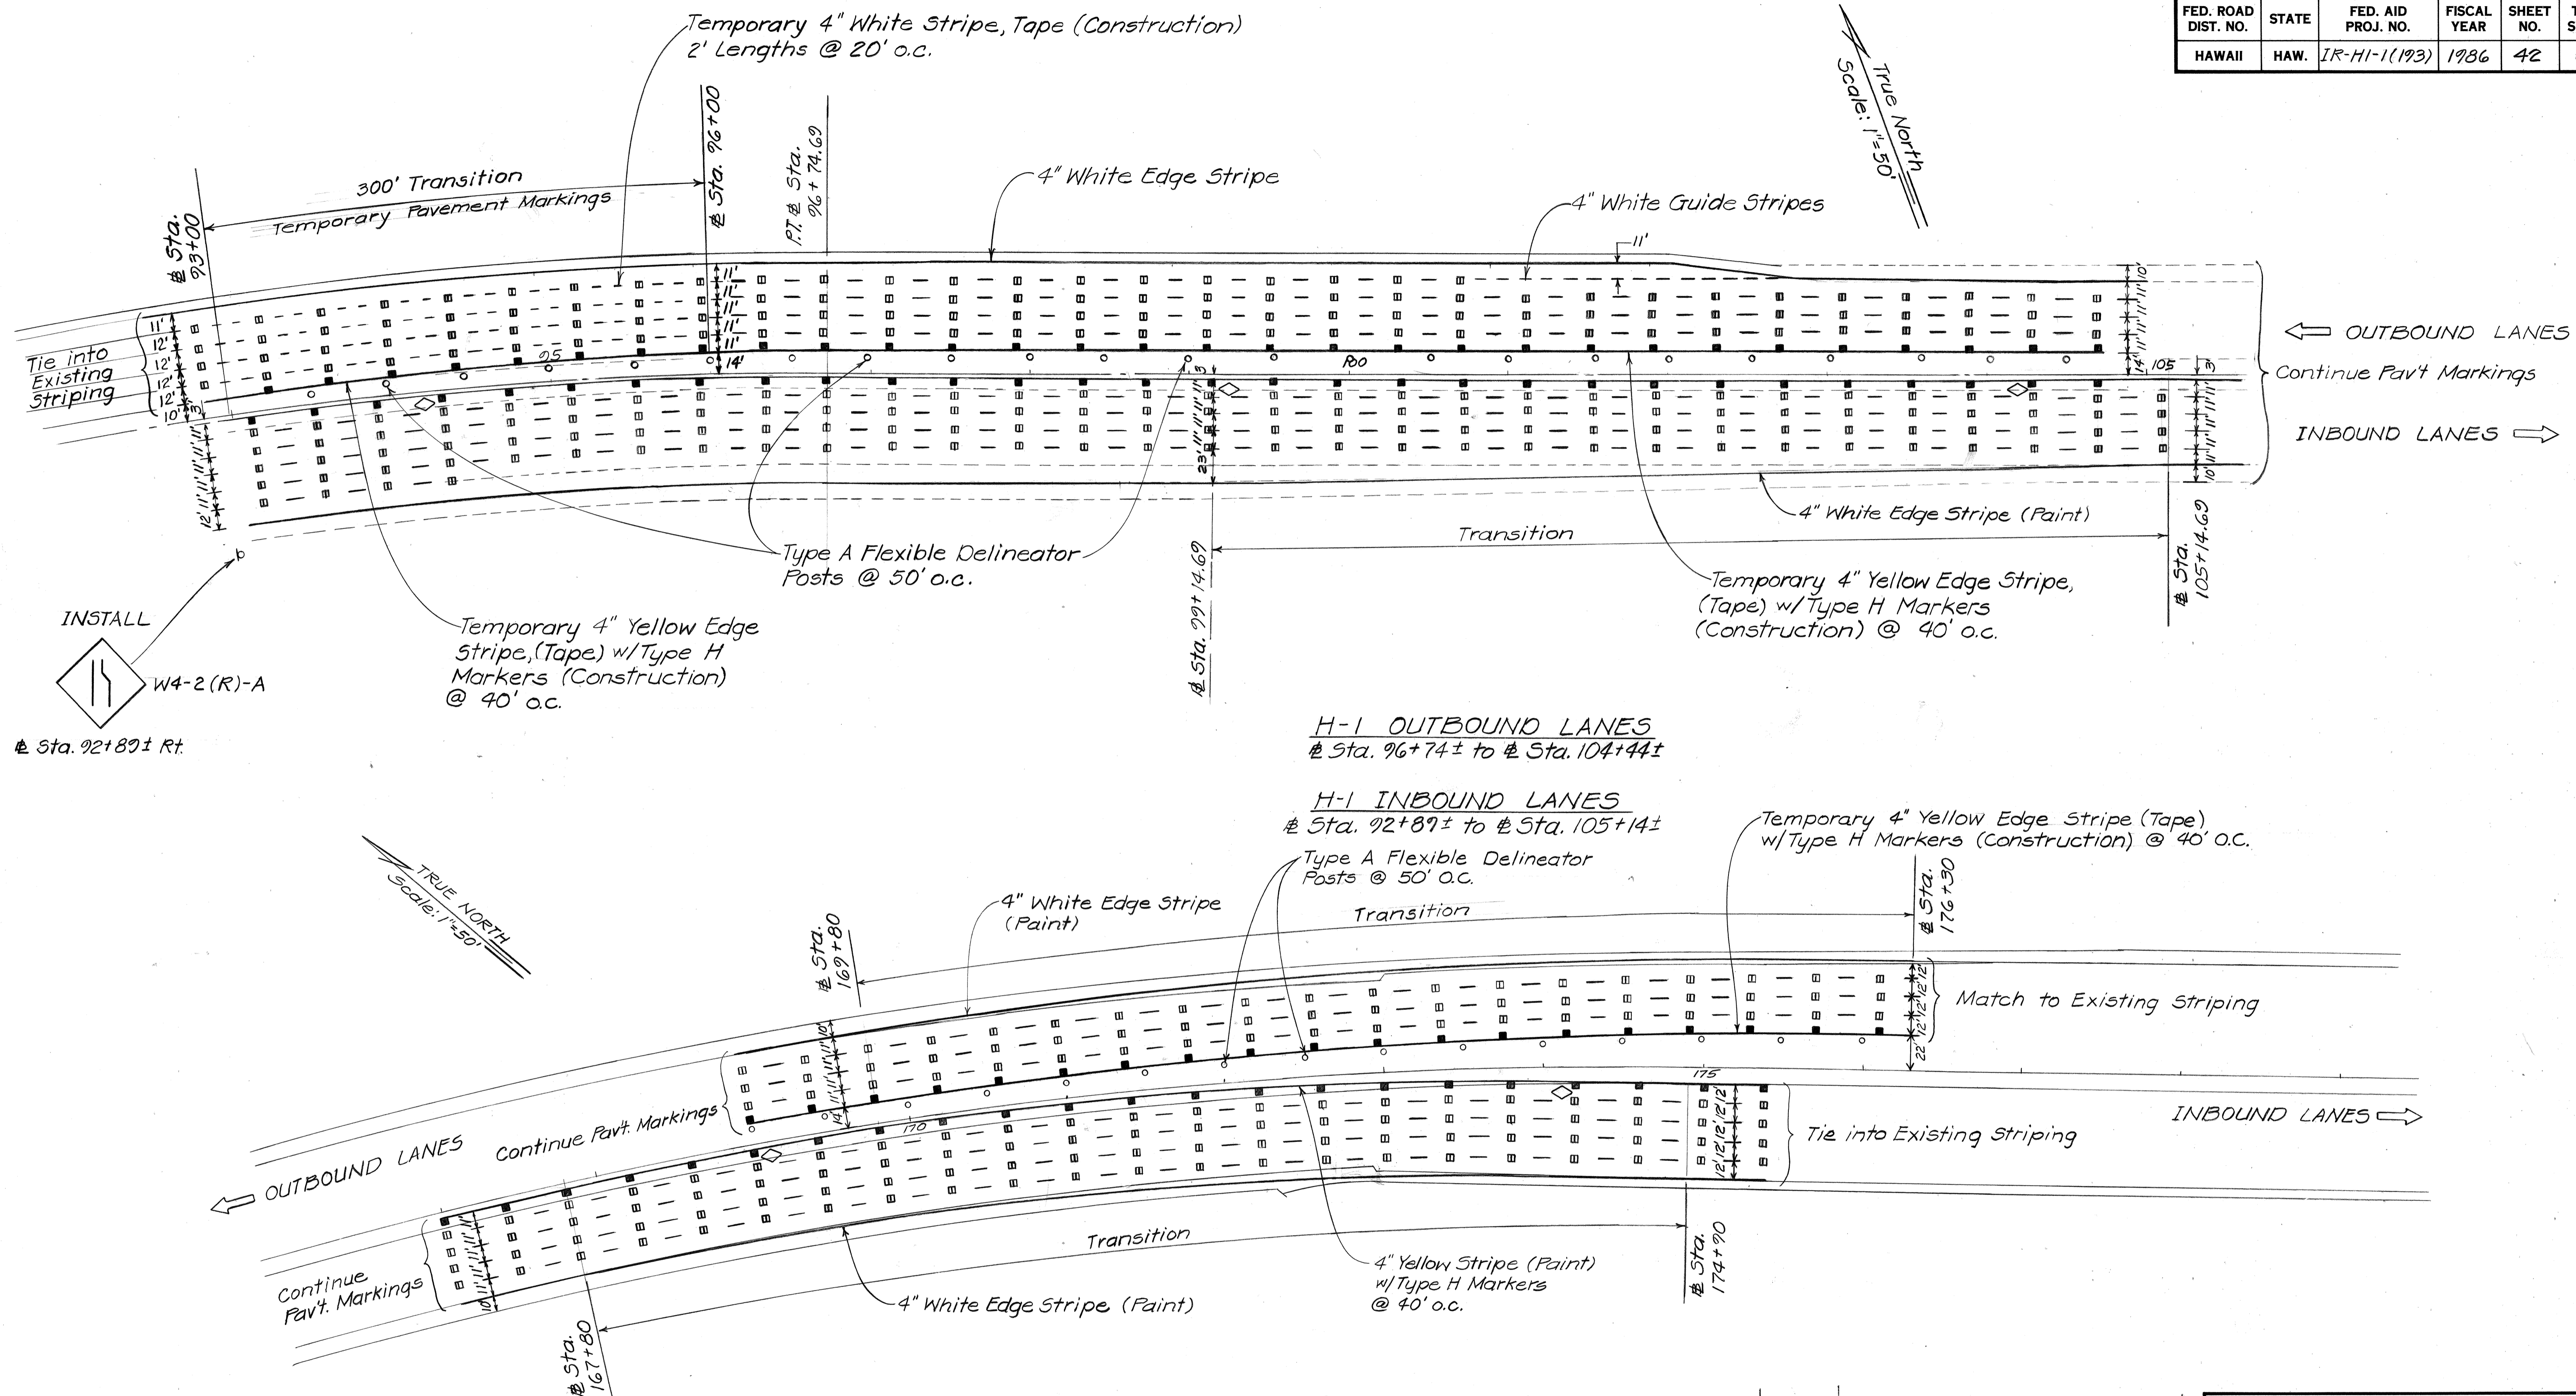

H-1 OUTBOUND LANES
 ± Sta. 96+74± to ± Sta. 104+44±

H-1 INBOUND LANES
 ± Sta. 92+89± to ± Sta. 105+14±
 Type A Flexible Delineator Posts @ 50' o.c.

H-1 OUTBOUND LANES
 ± Sta. 169+80± to ± Sta. 176+30±

H-1 INBOUND LANES
 ± Sta. 167+80± to ± Sta. 174+90±

6/1186 Revised Pavement Markings
 ± Sta. 92+89 to 105+14.
 Added Sign ± Sta. 92+89± Rt.

DATE REVISION

STATE OF HAWAII
 DEPARTMENT OF TRANSPORTATION
 HIGHWAYS DIVISION




PAVEMENT MARKING DETAILS

INTERSTATE ROUTE H-1
 ADDITIONAL LANES
 FAI PROJ. NO. IR-HI-1(193)

Scale: As Shown Date: Sept, 1985
 SHEET No. 15 OF 19 SHEETS

SURVEY PLOTTED BY	DATE
DRAWN BY	
DESIGNED BY	
CHECKED BY	
NO.	

FED. ROAD DIST. NO.	STATE	FED. AID PROJ. NO.	FISCAL YEAR	SHEET NO.	TOTAL SHEETS
HAWAII	HAW.	IK-HI-1(193)	1987	C042 S-1	62

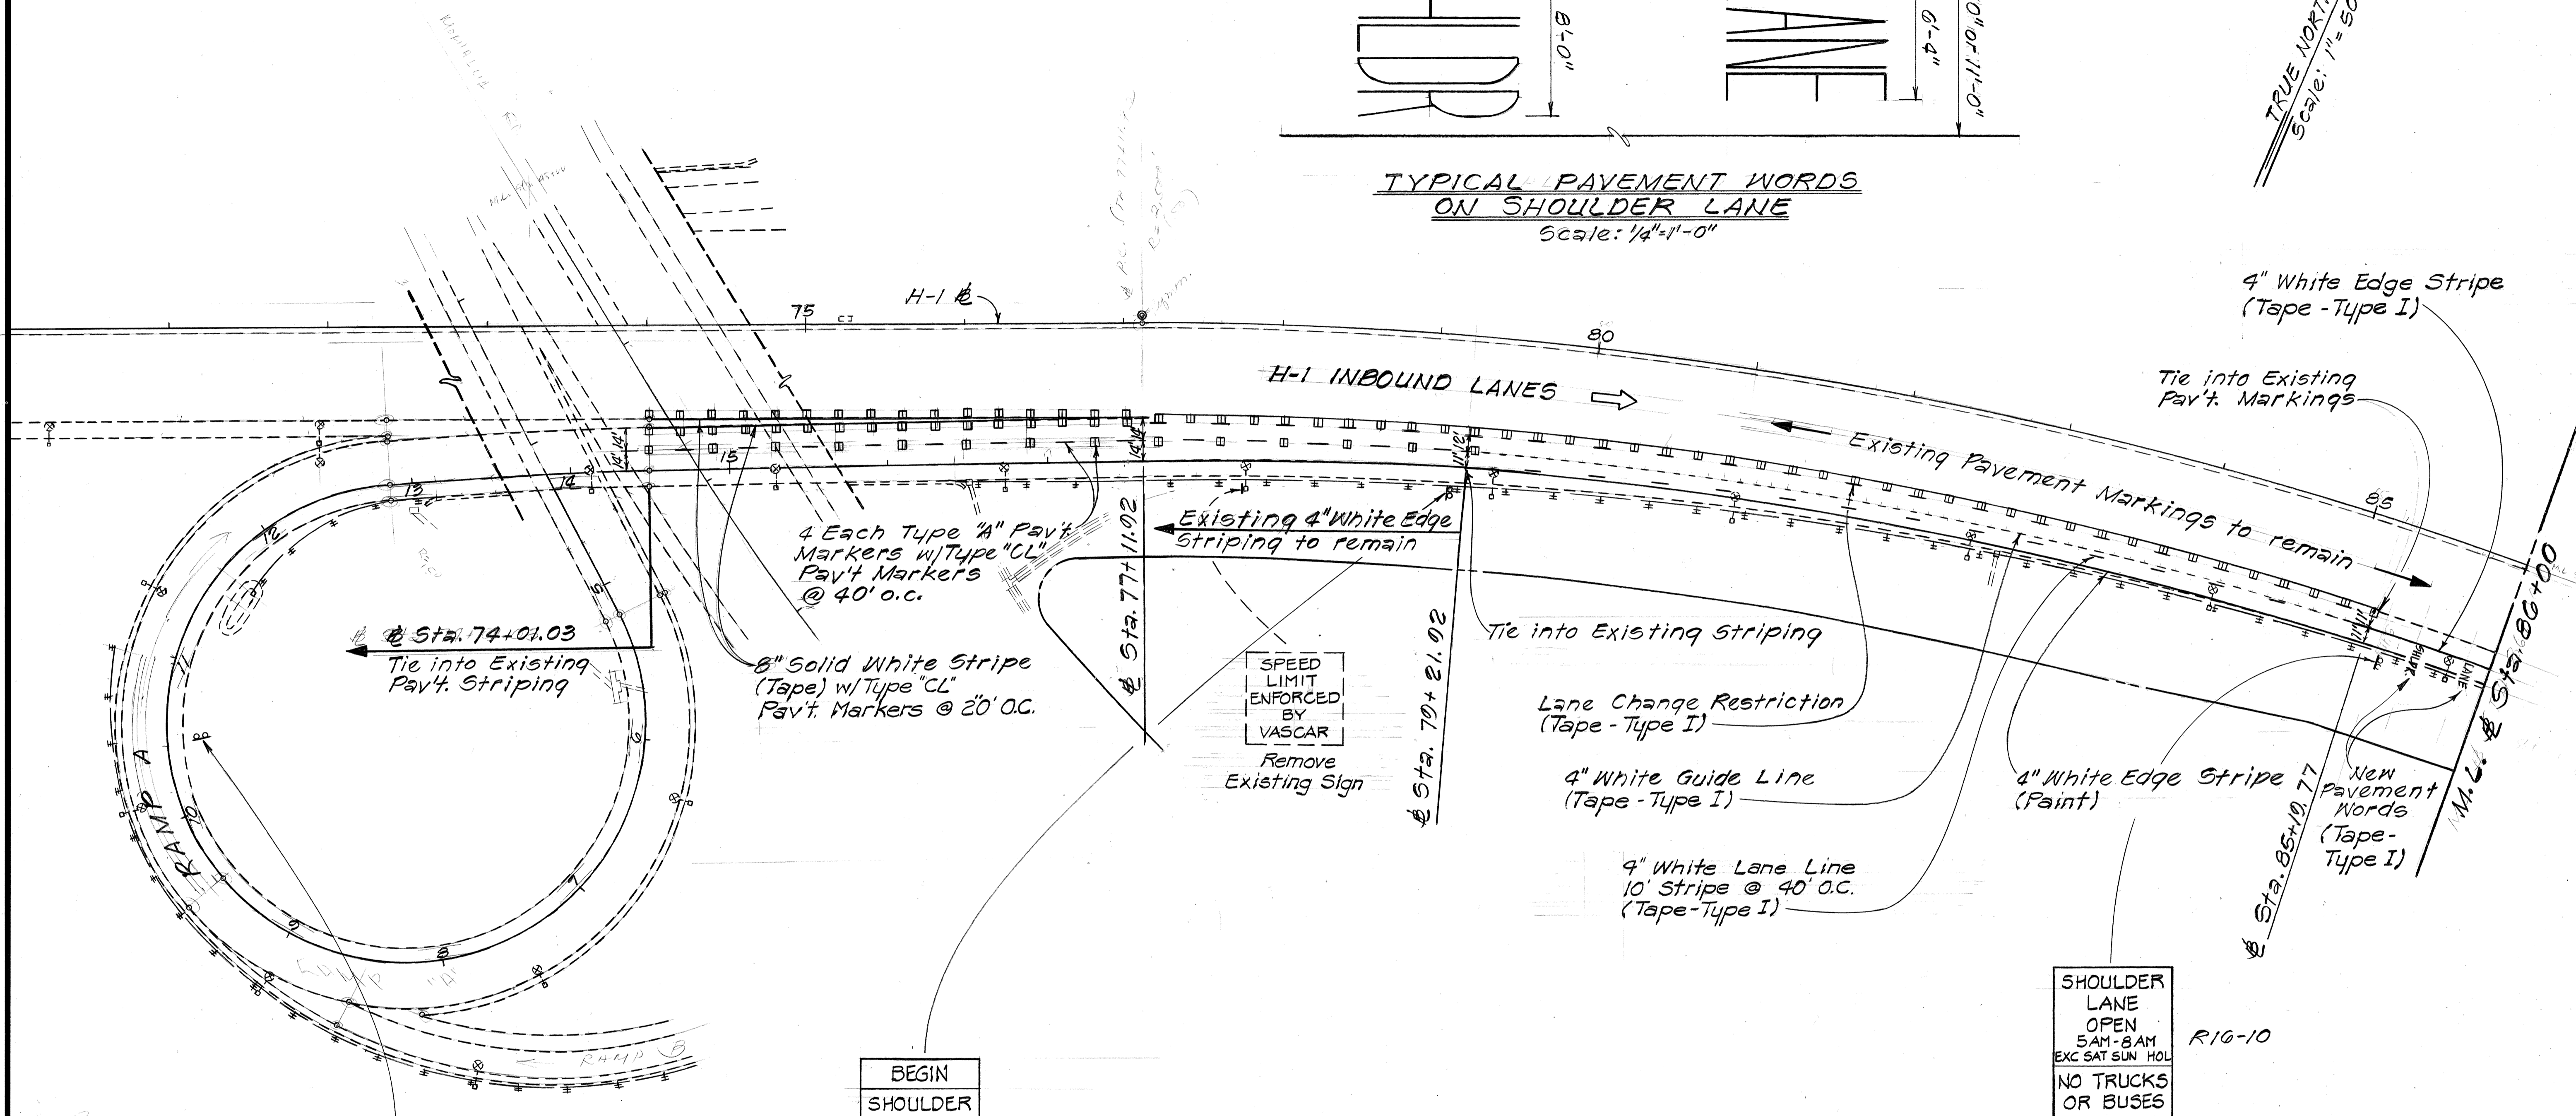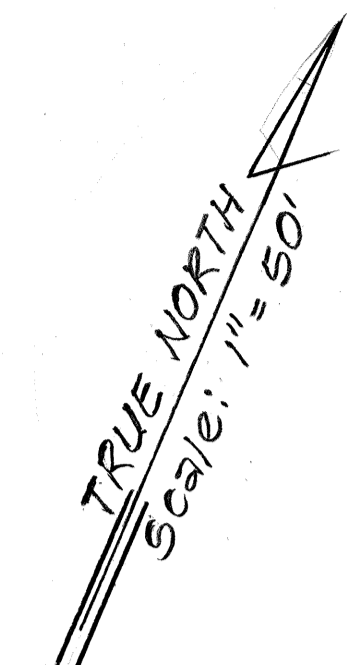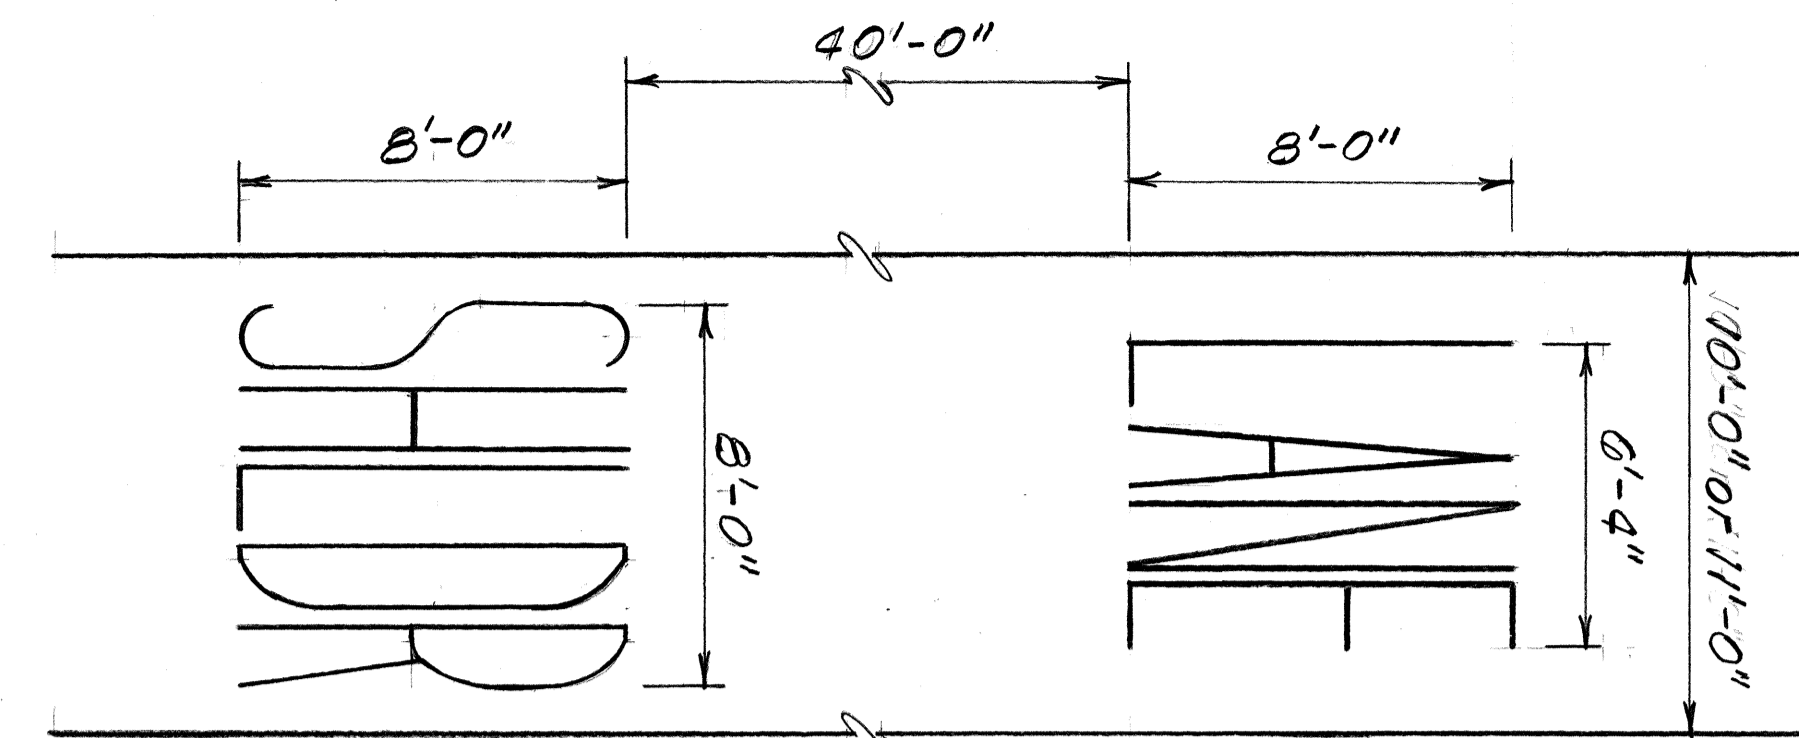

SURVEY PLOTTED BY	DATE
DRAWN BY	
DESIGNED BY	
CHECKED BY	
NO.	

SHOULDER LANE AHEAD
 OPEN
 5AM-8AM
 EXC SAT SUN HOL
 NO TRUCKS OR BUSES
 R10-11
 Install w/Posts
 Ramp A Sta. 10+50±Rt.

BEGIN SHOULDER LANE OPEN
 5AM-8AM
 EXC SAT SUN HOL
 NO TRUCKS OR BUSES
 R10-9
 Install w/Posts
 @ Sta. 79+20±Rt.


SHOULDER LANE OPEN
 5AM-8AM
 EXC SAT SUN HOL
 NO TRUCKS OR BUSES
 R10-10
 Install w/Posts
 @ Sta. 85+30±Rt.

SPEED LIMIT ENFORCED BY VASCAR
 Remove Existing Sign

STATE OF HAWAII
 DEPARTMENT OF TRANSPORTATION
 HIGHWAYS DIVISION
SIGNING AND PAVEMENT MARKINGS
 INTERSTATE ROUTE H-1
 ADDITIONAL LANES
 F.A.I. PROJ. No. IK-HI-1(193)
 Scale: As Shown Date: Oct, 1987
 SHEET No. 75 OF 19 SHEETS

DATE	REVISION
10/5/87	Revised Pavement Markings and Added Signs for I.B. Shoulder Lane.

FED. ROAD DIST. NO.	STATE	FED. AID PROJ. NO.	FISCAL YEAR	SHEET NO.	TOTAL SHEETS
HAWAII	HAW.	IR-HI-1(193)	1987	C0.42 S-2	62

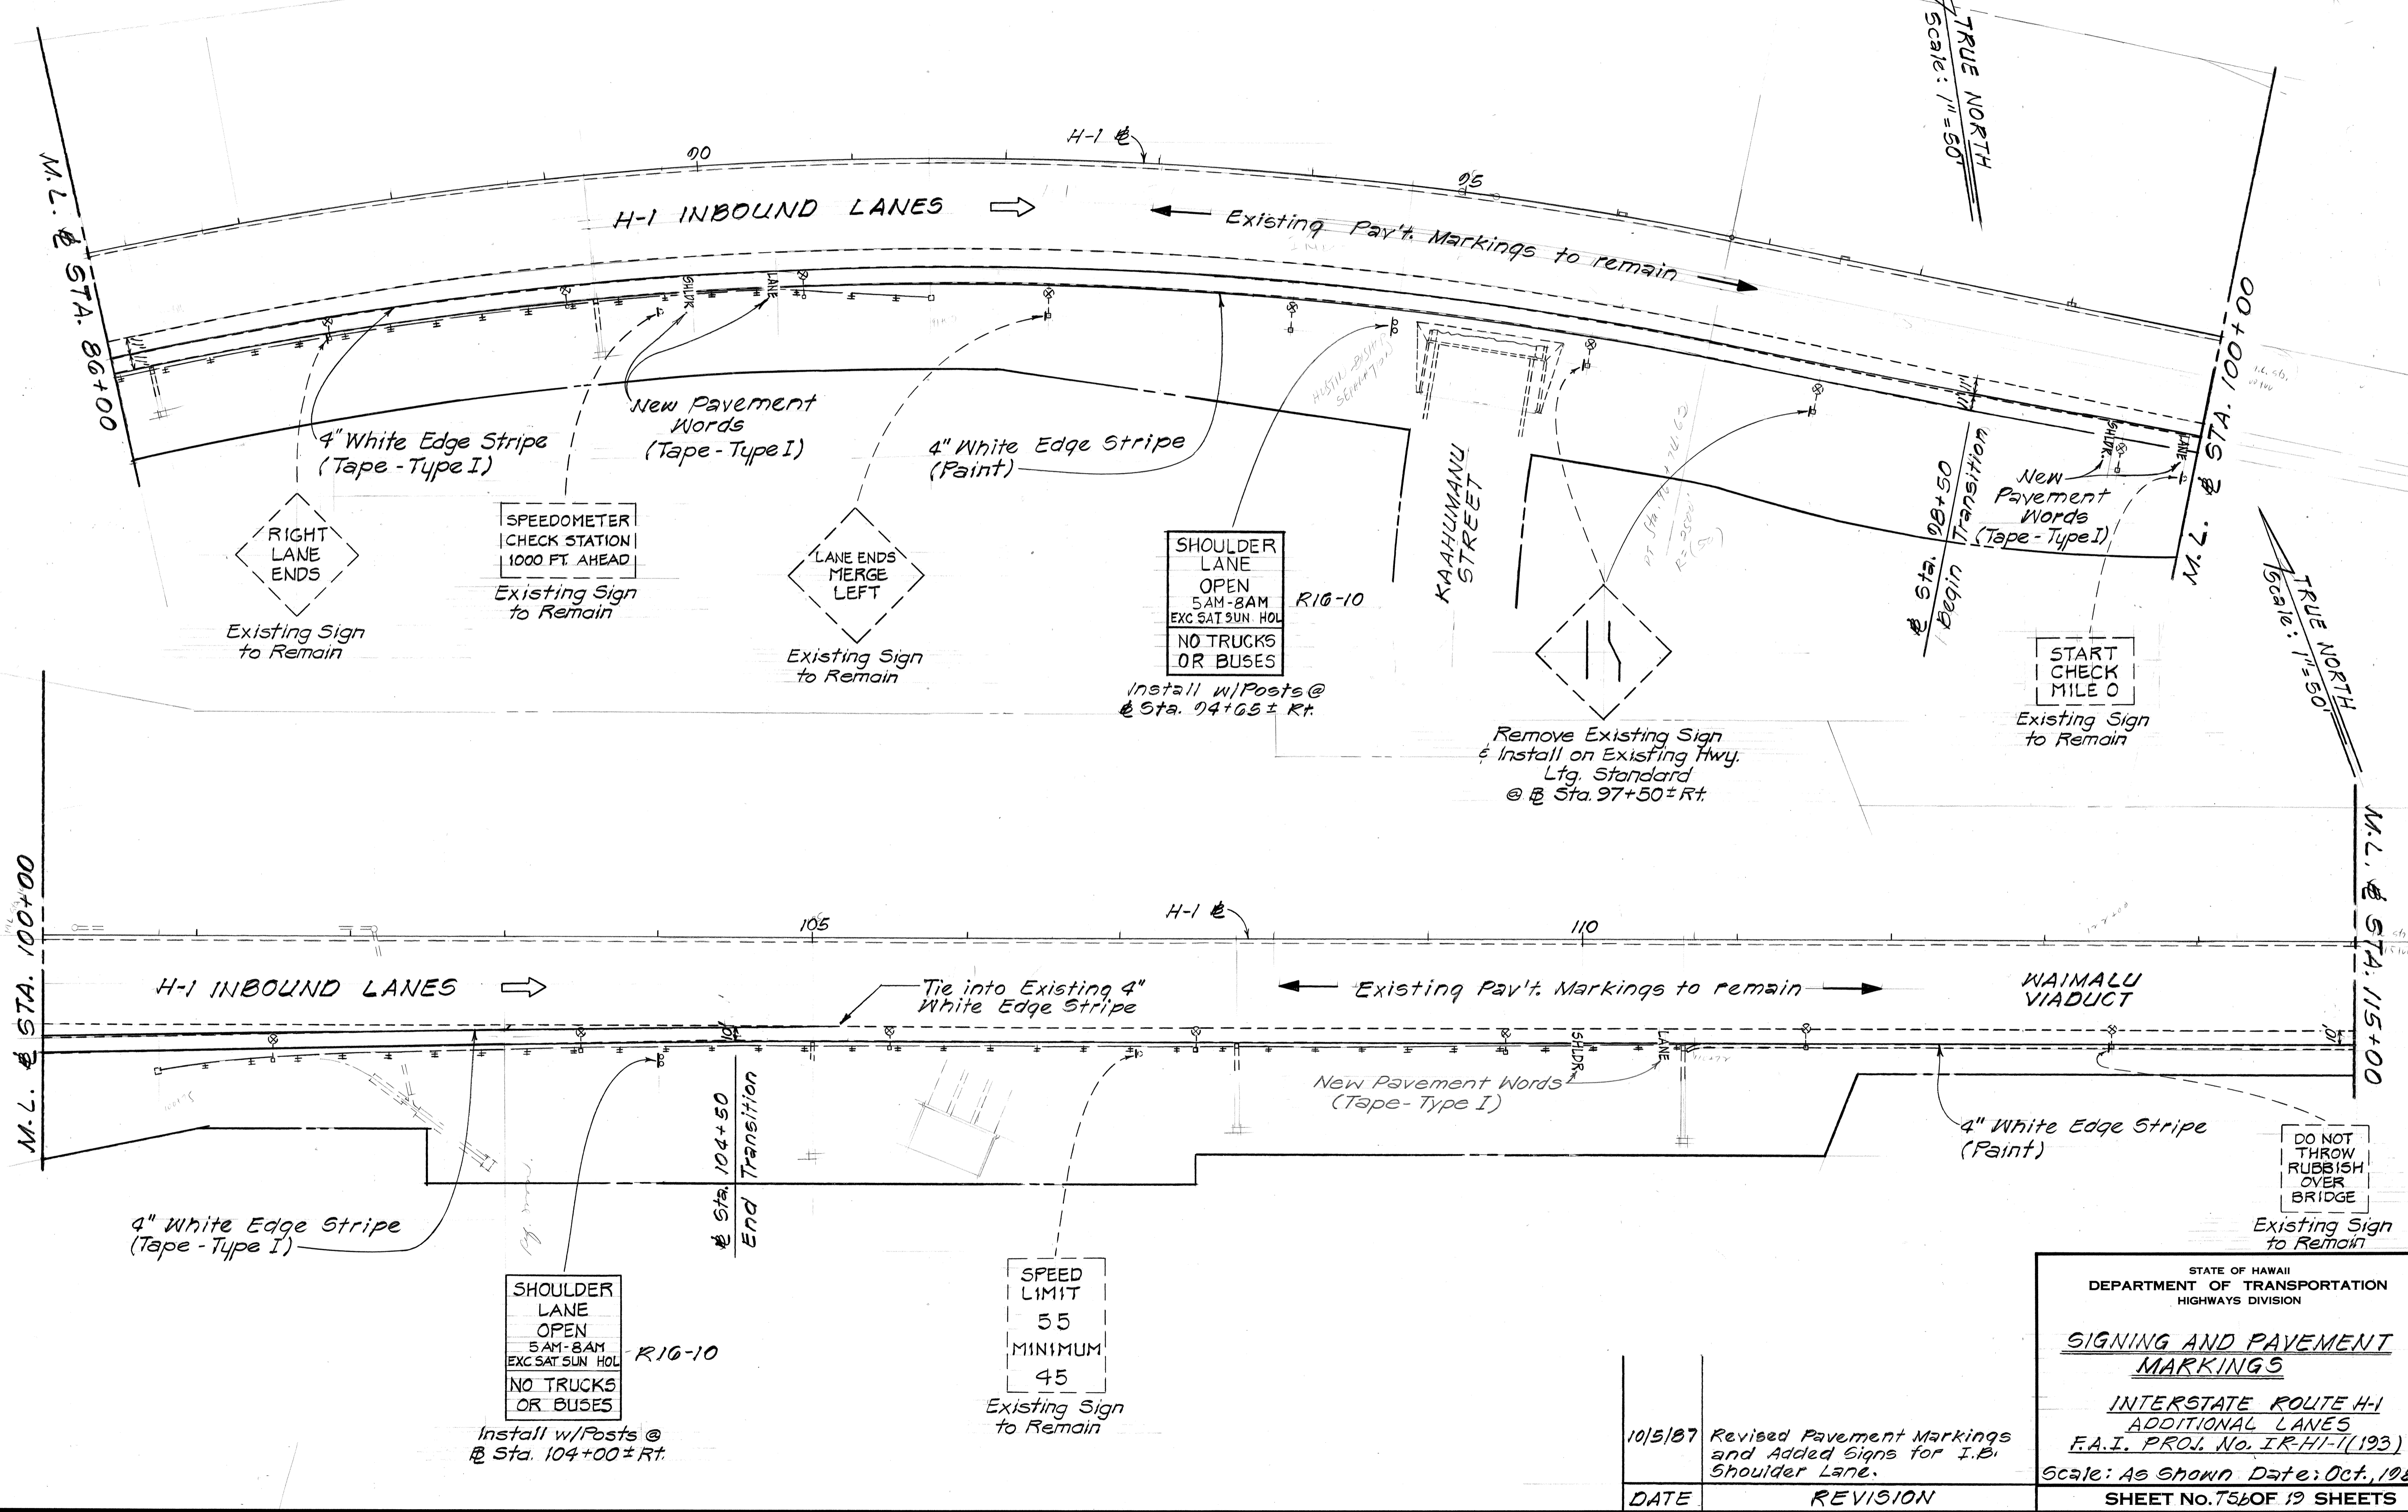

DATE	
SURVEY PLOTTED BY	
DRAWN BY	
TRACED BY	
DESIGNED BY	
QUANTITIES BY	
CHECKED BY	
NO.	

DATE	REVISION
10/5/87	Revised Pavement Markings and Added Signs for I.B. Shoulder Lane.

STATE OF HAWAII
DEPARTMENT OF TRANSPORTATION
HIGHWAYS DIVISION


SIGNING AND PAVEMENT MARKINGS

INTERSTATE ROUTE H-1
ADDITIONAL LANES
F.A.I. PROJ. No. IR-HI-1(193)

Scale: As Shown Date: Oct, 1987
SHEET No. 75 of 19 SHEETS

FED. ROAD DIST. NO.	STATE	FED. AID PROJ. NO.	FISCAL YEAR	SHEET NO.	TOTAL SHEETS
HAWAII	HAW.	IR-HI-1(193)	1987	60-42 S-3	62

TRUE NORTH
Scale: 1"=50'

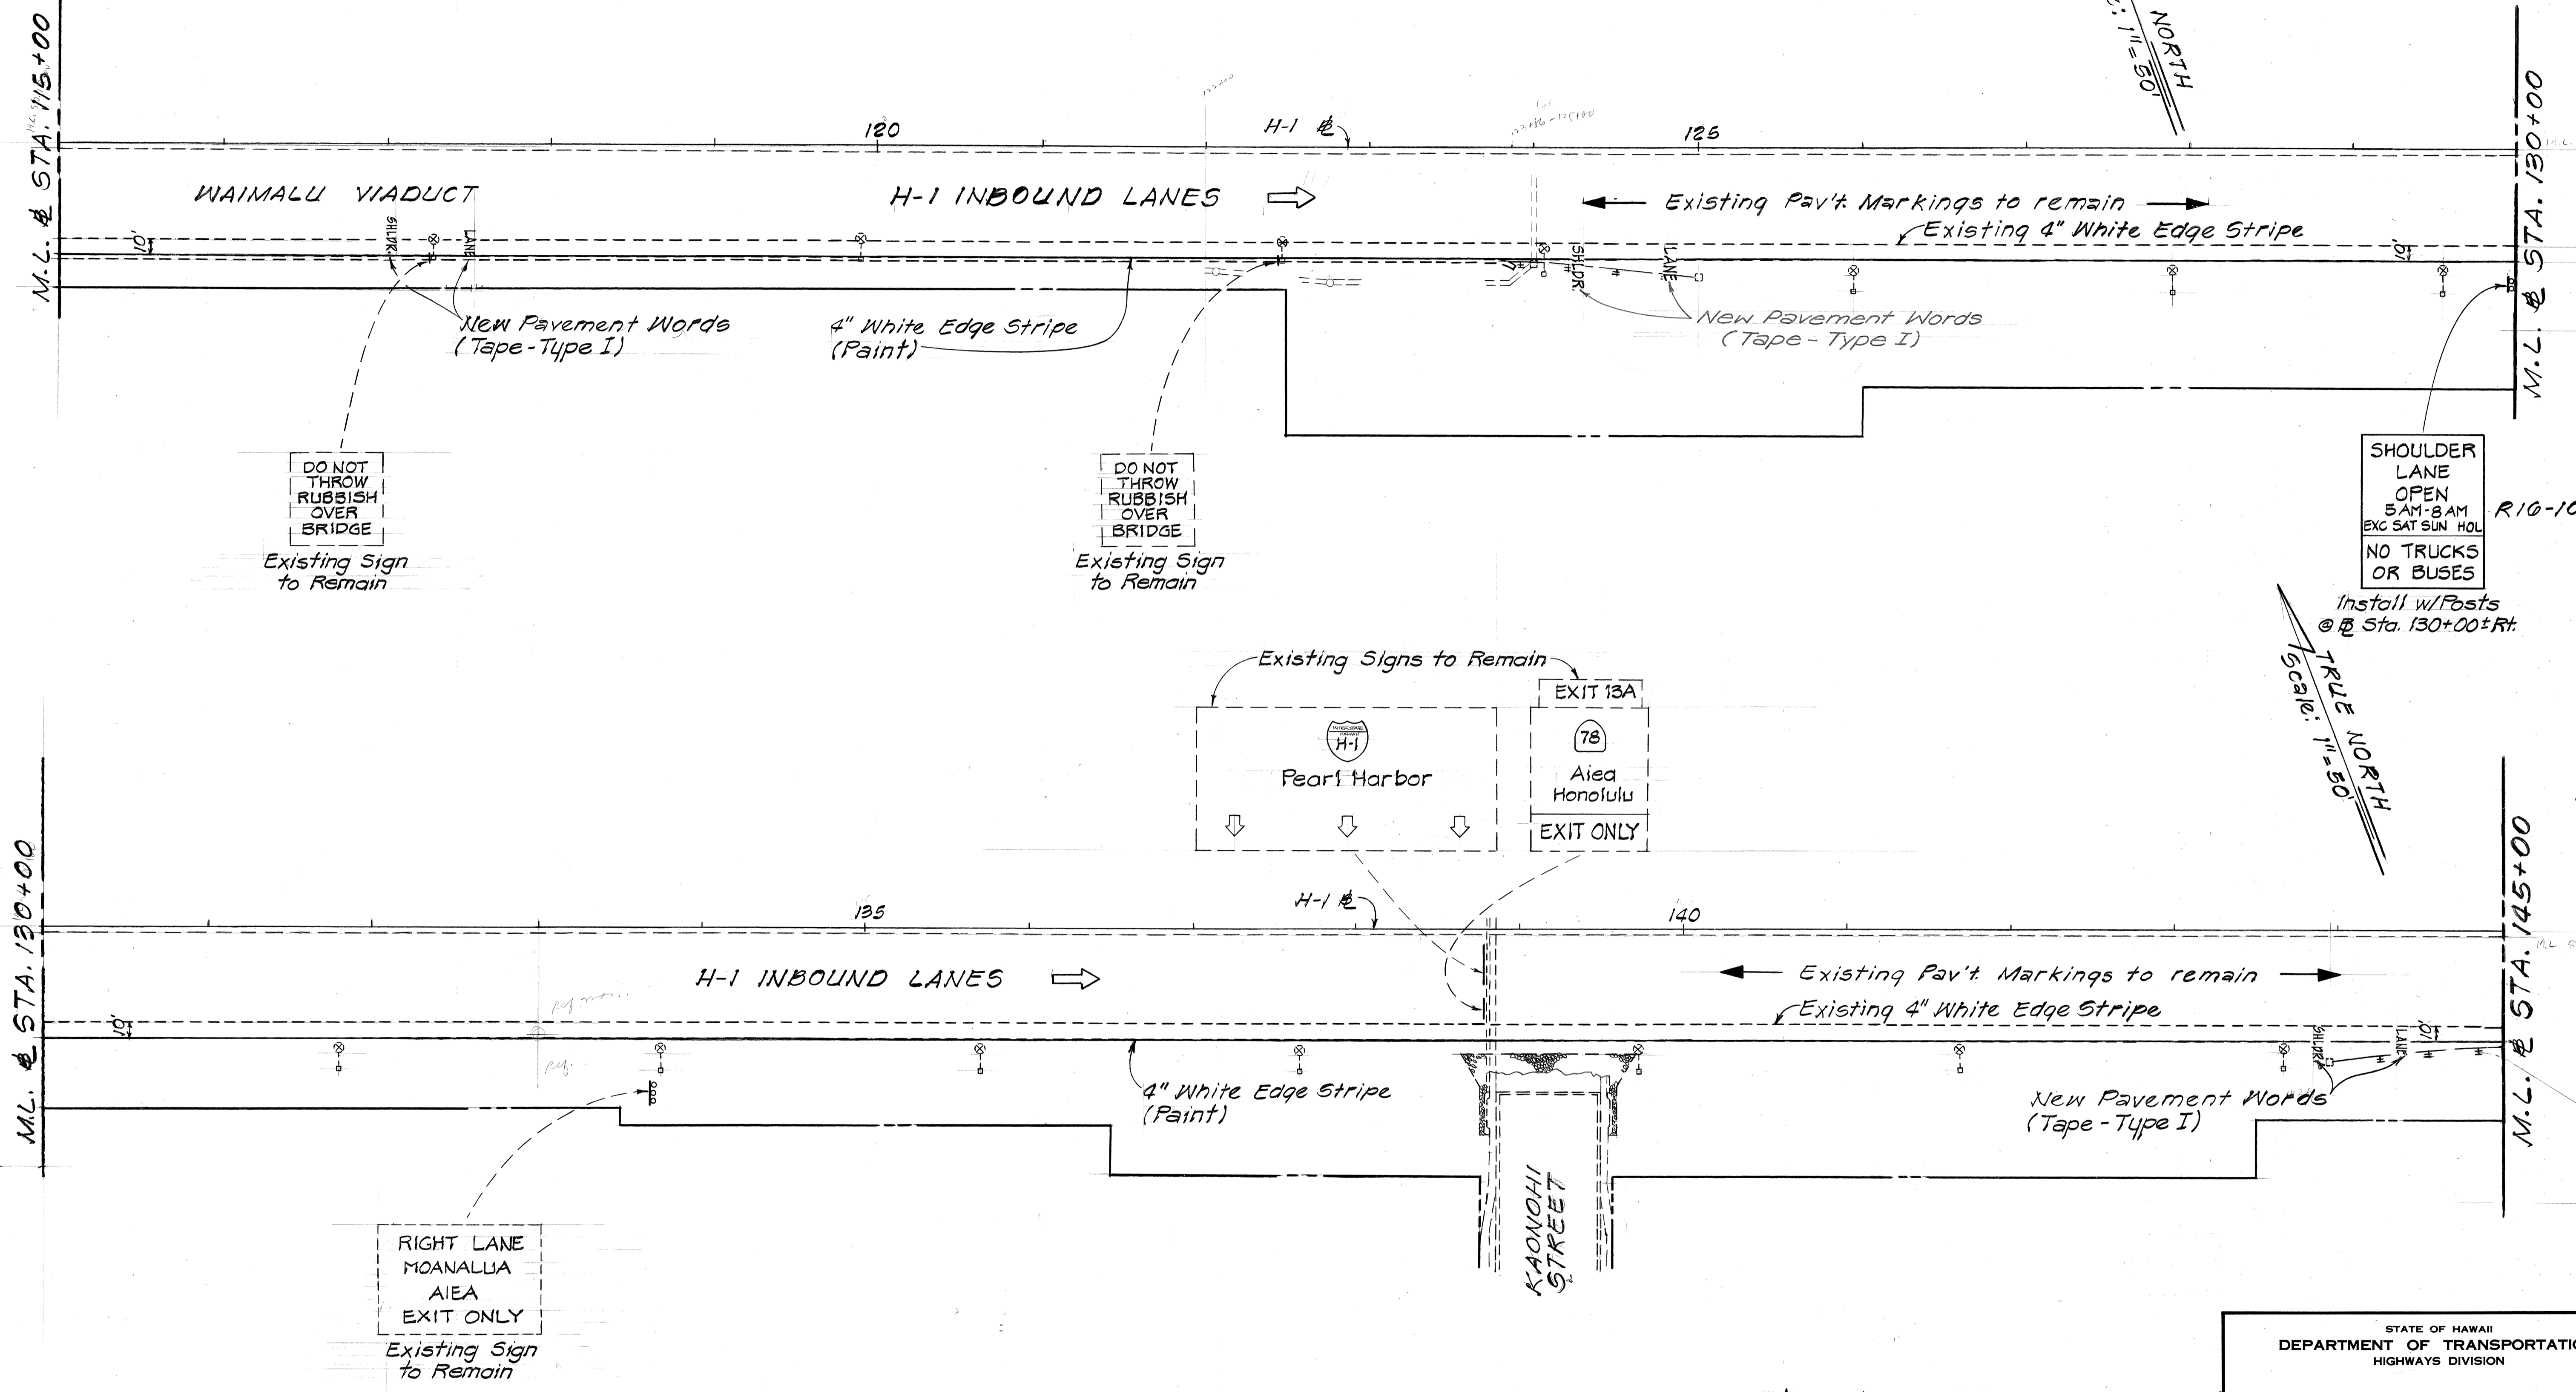

DATE	
SURVEY PLOTTED BY	
DRAWN BY	
DESIGNED BY	
QUANTITIES BY	
CHECKED BY	
ORIGINAL PLAN	
NOTE BOOK	
No.	

STATE OF HAWAII
DEPARTMENT OF TRANSPORTATION
HIGHWAYS DIVISION

SIGNING AND PAVEMENT MARKINGS

INTERSTATE ROUTE H-1
ADDITIONAL LANES
F.A.I. PROJ. No. IR-HI-1(193)


10/5/87 Revised Pavement Markings and Added Signs for I.B. Shoulder Lane.
Scale: As Shown Date: Oct., 1987

DATE	REVISION

SHEET No. 75c OF 12 SHEETS

FED. ROAD DIST. NO.	STATE	FED. AID PROJ. NO.	FISCAL YEAR	SHEET NO.	TOTAL SHEETS
HAWAII	HAW.	IR-HI-1(193)	1987	C042 S-4	62

TRUE NORTH
Scale: 1"=50'

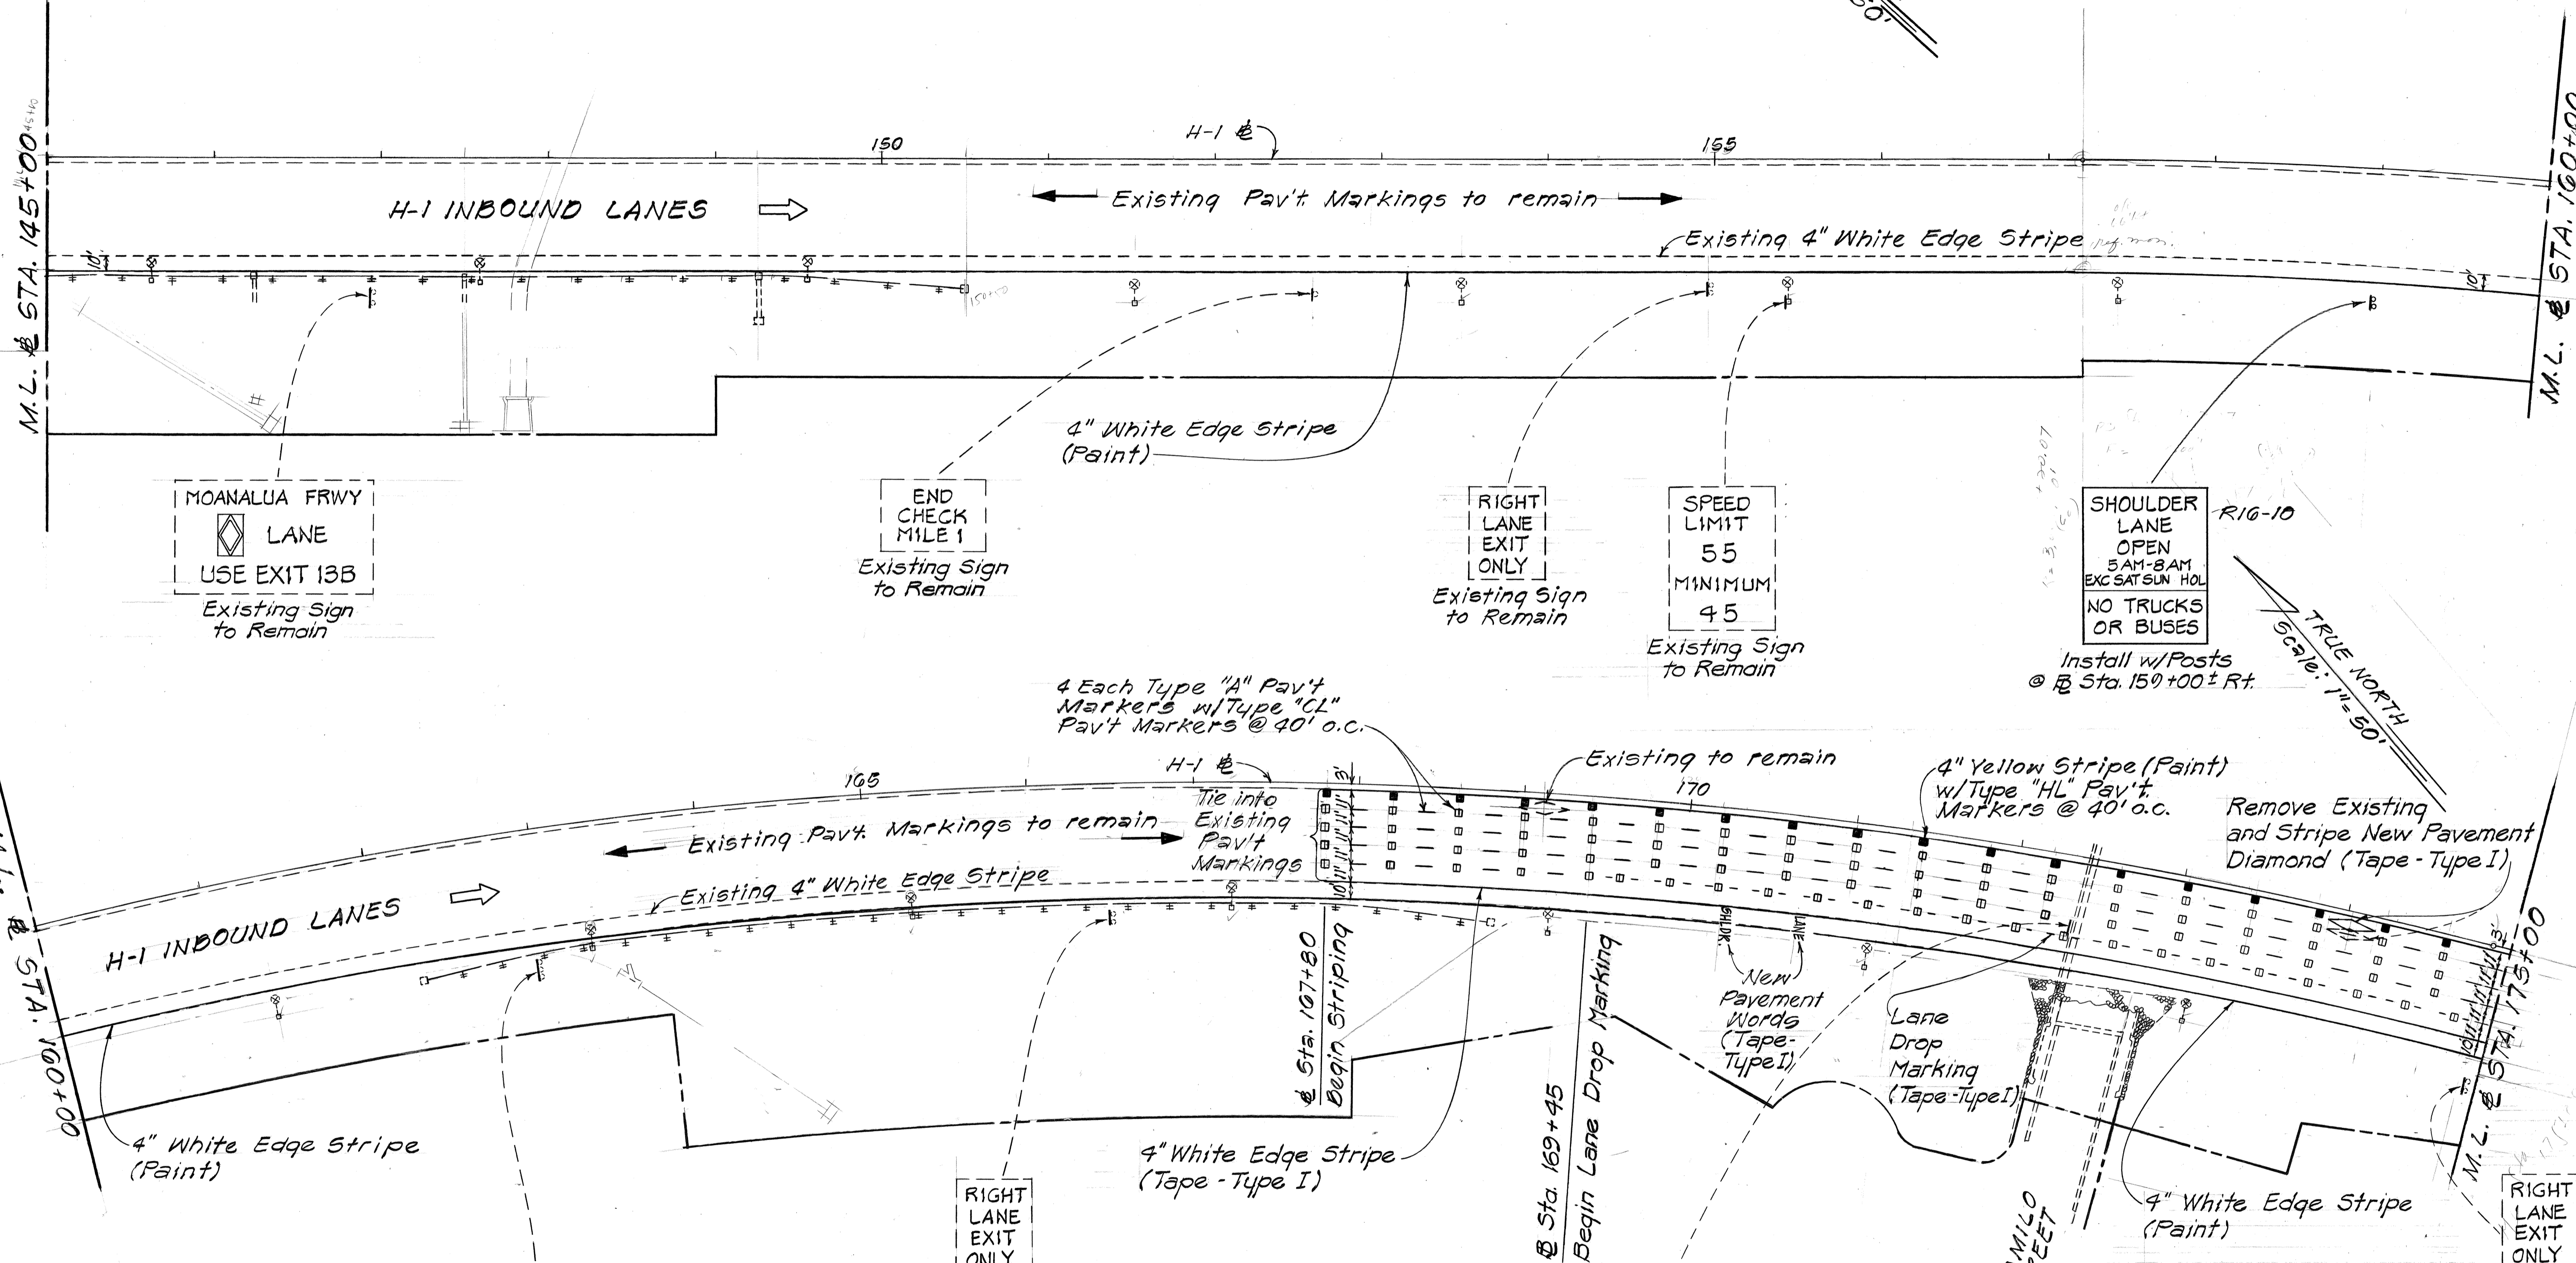

TRUE NORTH
Scale: 1"=50'

DATE	
SURVEY PLOTTED BY	
ORIGINAL PLAN	
DRAWN BY	
DESIGNED BY	
QUANTITIES BY	
CHECKED BY	
NO.	

RIGHT LANE MOANALUA AIEA EXIT ONLY
Existing Sign to Remain

EXIT 13A
Aiea Honolulu RIGHT LANE
EXIT ONLY
Existing Sign to Remain

DATE	REVISION
10/5/87	Revised Pavement Markings and Added Signs for I.B. Shoulder Lane.


STATE OF HAWAII
DEPARTMENT OF TRANSPORTATION
HIGHWAYS DIVISION

SIGNING AND PAVEMENT MARKINGS

INTERSTATE ROUTE H-1
ADDITIONAL LANES
F.A.I. PROJ. No. IR-HI-1(193)

Scale: As Shown Date: Oct, 1987
SHEET No. 75d OF 19 SHEETS

FED. ROAD DIST. NO.	STATE	FED. AID PROJ. NO.	FISCAL YEAR	SHEET NO.	TOTAL SHEETS
HAWAII	HAW.	IR-41-1(193)	1987	CO 42 S-5	62

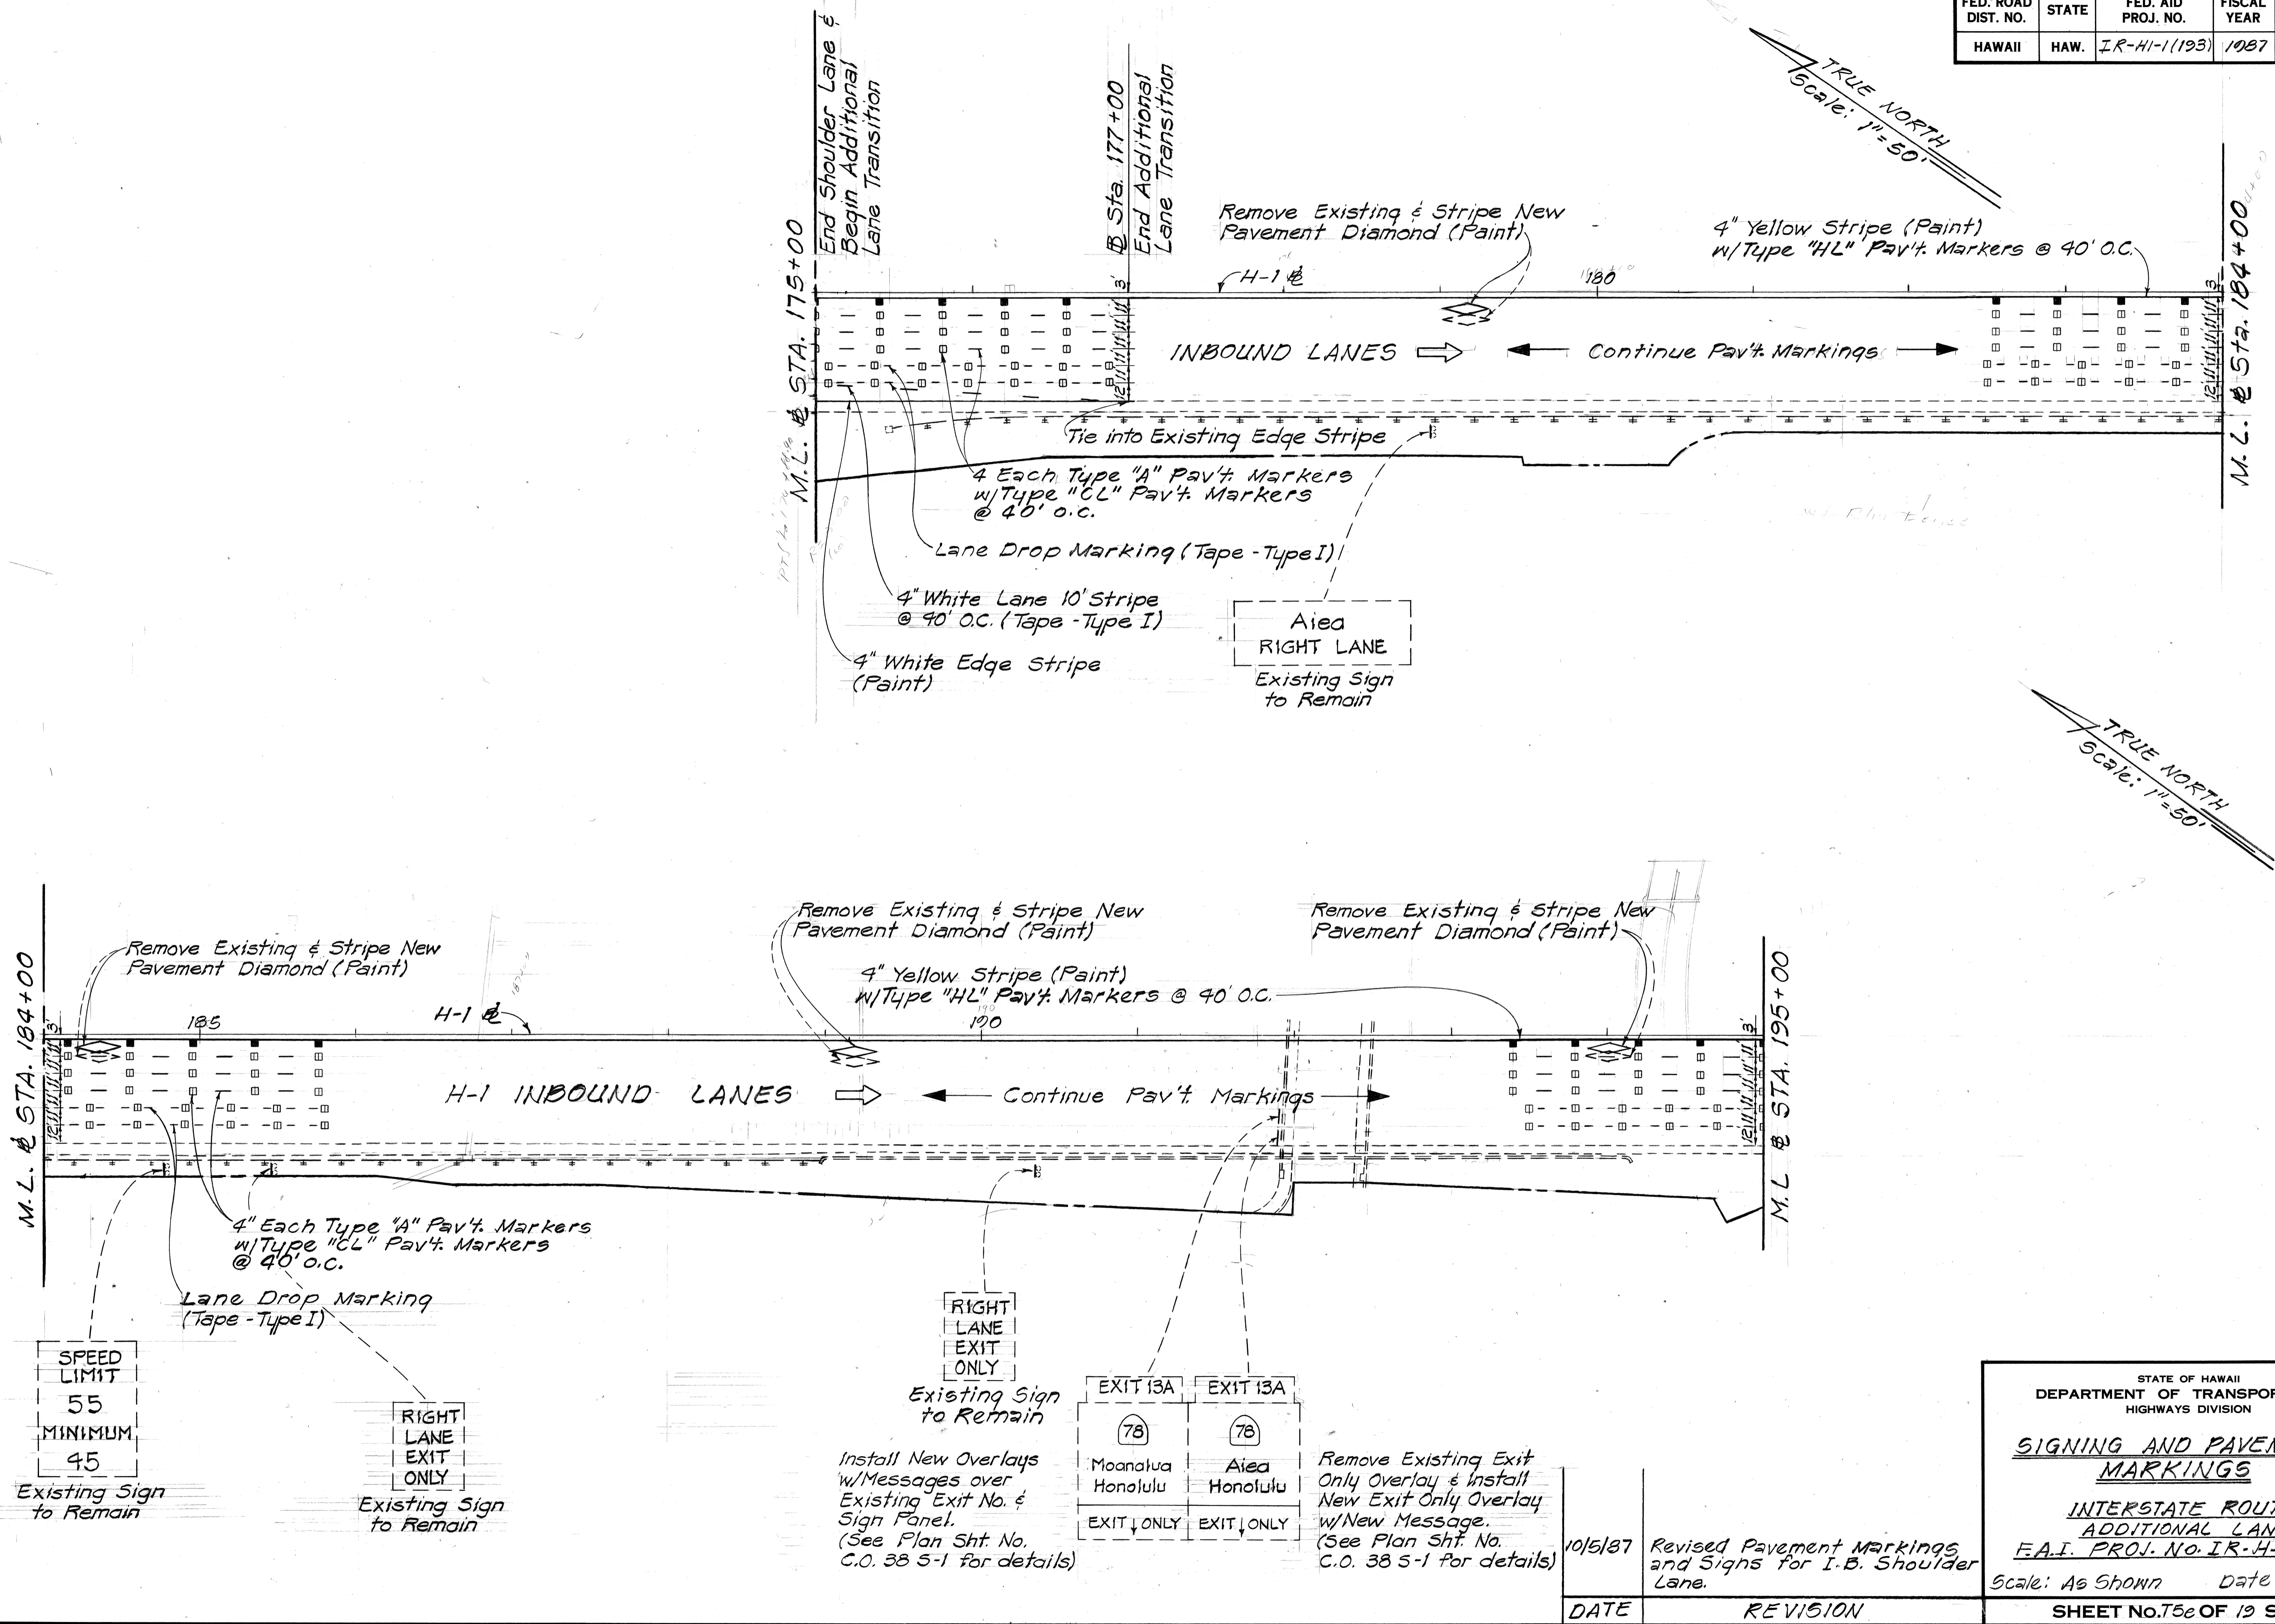

DATE	
SURVEY PLOTTED BY	
DRAWN BY	
TRACED BY	
DESIGNED BY	
QUANTITIES BY	
CHECKED BY	
NOTE BOOK	
No.	

SPEED LIMIT
MINIMUM
45
Existing Sign to Remain

RIGHT LANE
EXIT ONLY
Existing Sign to Remain

RIGHT LANE
EXIT ONLY
Existing Sign to Remain

EXIT 13A	EXIT 13A
78	78
Moanalua Honolulu	Aiea Honolulu
EXIT ONLY	EXIT ONLY

Install New Overlays w/Messages over Existing Exit No. & Sign Panel.
(See Plan Sht. No. C.O. 38 5-1 for details)

Remove Existing Exit Only Overlay & Install New Exit Only Overlay w/New Message.
(See Plan Sht. No. C.O. 38 5-1 for details)

DATE	REVISION
10/5/87	Revised Pavement Markings and Signs for I.B. Shoulder Lane.

STATE OF HAWAII
DEPARTMENT OF TRANSPORTATION
HIGHWAYS DIVISION


SIGNING AND PAVEMENT MARKINGS

INTERSTATE ROUTE H-1
ADDITIONAL LANES
F.A.I. PROJ. NO. IR-41(193)

Scale: As Shown Date: Oct, 1987


SHEET No. 75e OF 12 SHEETS

FED. ROAD DIST. NO.	STATE	FED. AID PROJ. NO.	FISCAL YEAR	SHEET NO.	TOTAL SHEETS
HAWAII	HAW.	1R-HI-1(193)	1987	60 OF 62	62

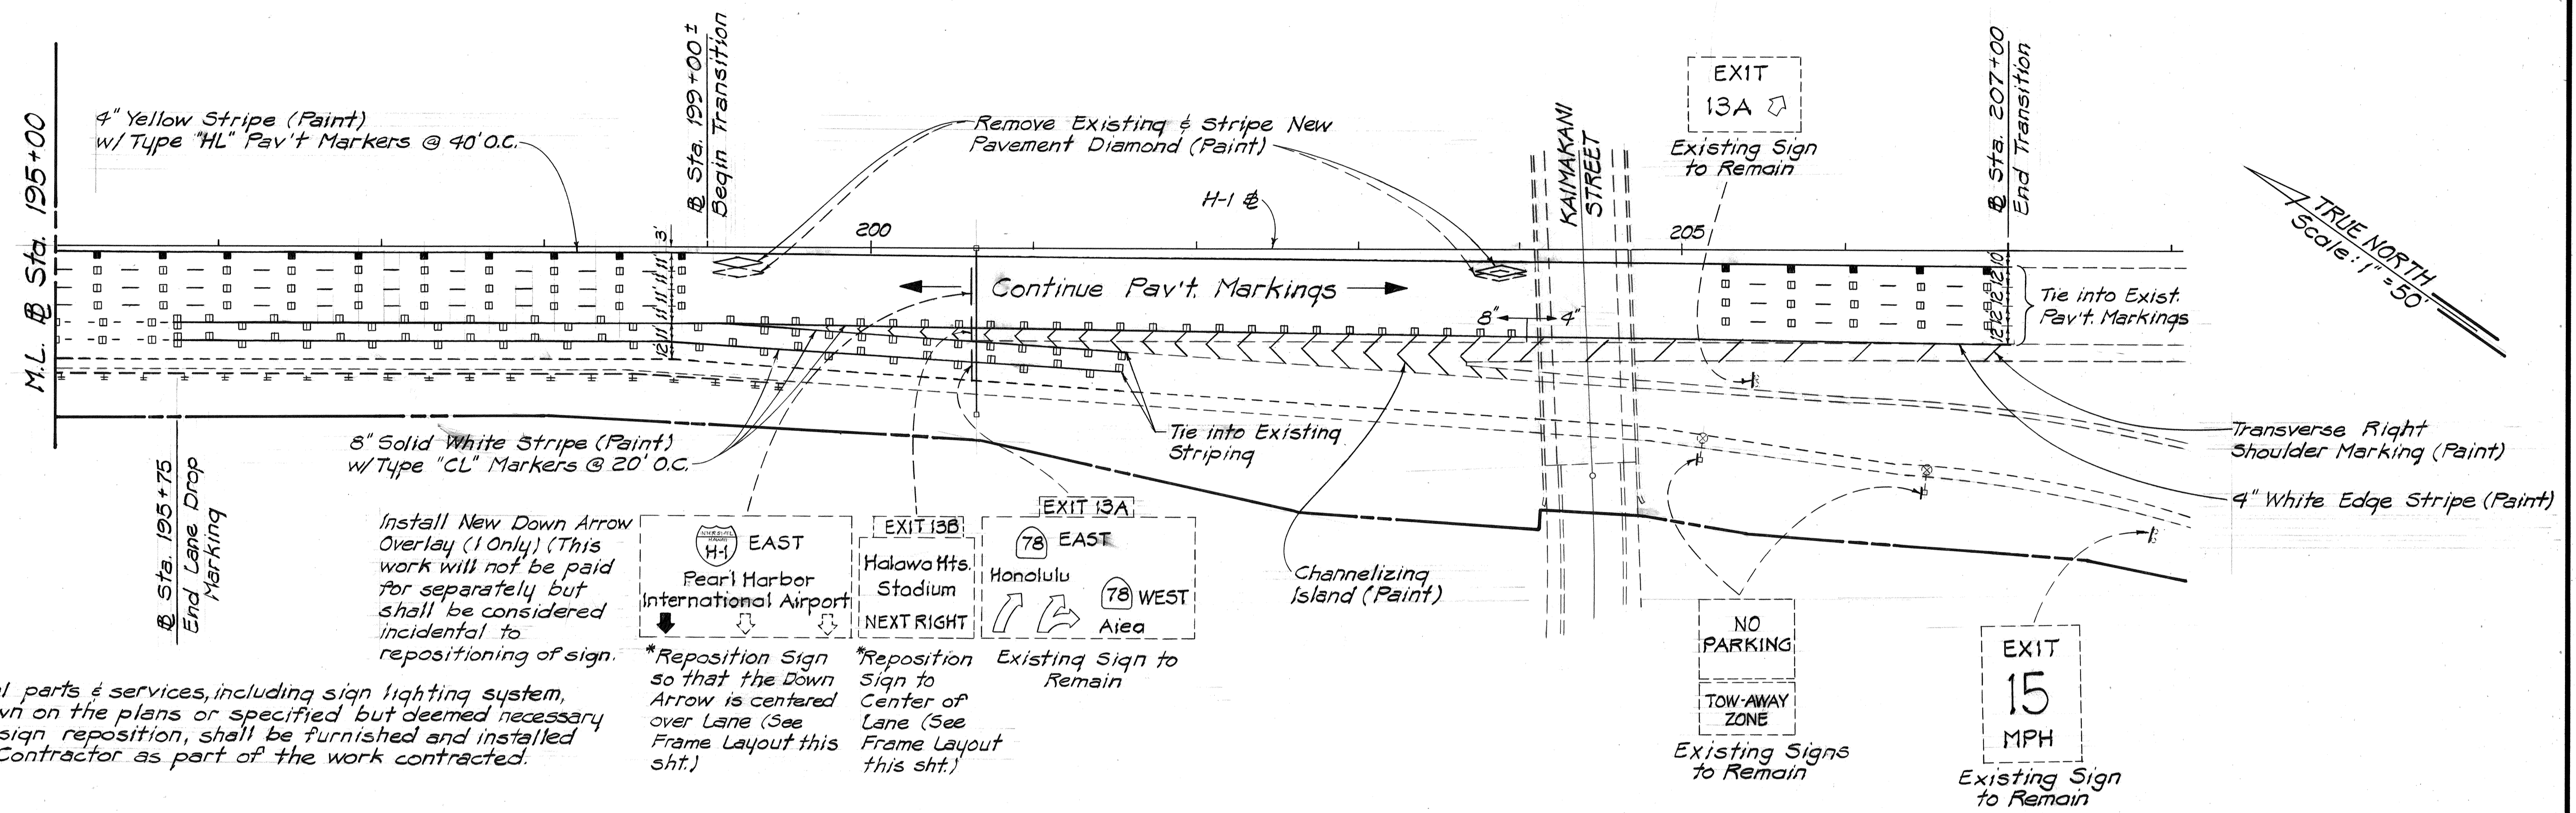

*Incidental parts & services, including sign lighting system, not shown on the plans or specified but deemed necessary for the sign reposition, shall be furnished and installed by the Contractor as part of the work contracted.

- Install New Down Arrow Overlay (1 Only) (This work will not be paid for separately but shall be considered incidental to repositioning of sign.)
- *Reposition Sign so that the Down Arrow is centered over Lane (See Frame Layout this sht.)
- *Reposition Sign to Center of Lane (See Frame Layout this sht.)
- Existing Sign to Remain

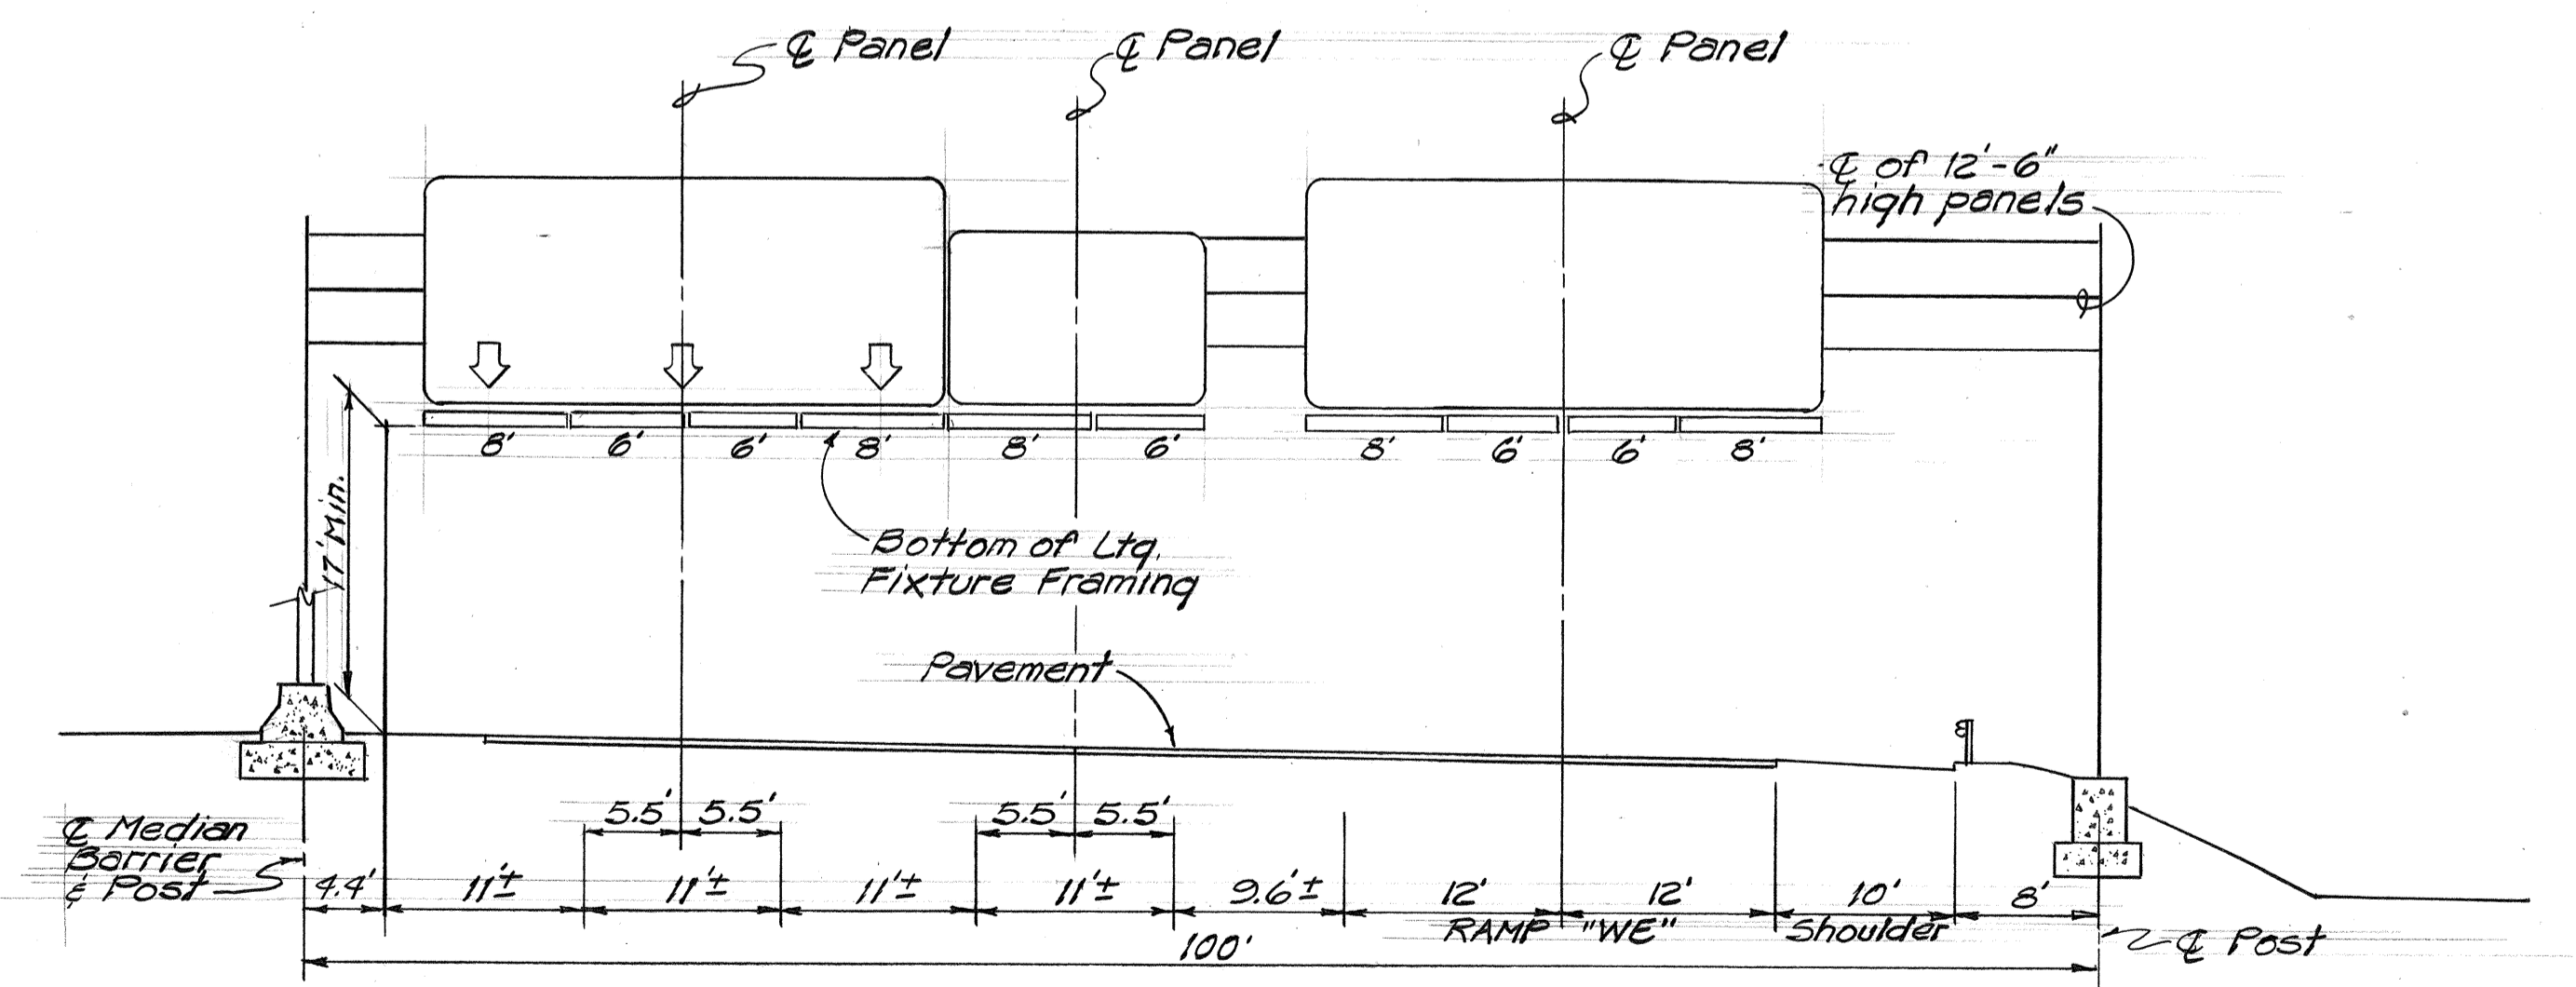

SIGN FRAME LAYOUT
 INTERSTATE ROUTE H-1 INBOUND STA. 200+65
 SCALE: 1" = 10'

DATE	REVISION
10/15/87	Revised Pavement Markings and Signs for I.B. Shoulder Lane.

STATE OF HAWAII
 DEPARTMENT OF TRANSPORTATION
 HIGHWAYS DIVISION

SIGNING & PAVEMENT MARKINGS & SIGN FRAME LAYOUT

INTERSTATE ROUTE H-1
 ADDITIONAL LANES
 F.A.I. PROJ. No. IR-HI-1(193)


Scale: As Shown Date: Oct., 1987
 SHEET No. 15 OF 19 SHEETS

SURVEY PLOTTED BY: _____ DATE: _____
 ORIGINAL PLAN: _____
 DRAWN BY: _____
 NOTE BOOK: _____
 DESIGNED BY: _____
 CHECKED BY: _____
 NO. _____


FED. ROAD DIST. NO.	STATE	FED. AID PROJ. NO.	FISCAL YEAR	SHEET NO.	TOTAL SHEETS
HAWAII	HAW.	IR-HI-1 (1983)	1986	43	62

GENERAL NOTES






- Signs shall be placed in conformance with positions shown and described in the "Manual on Uniform Traffic Control Devices for Streets and Highways", 1978, Part II, Section 2A-21, as amended, and as supplemented herein.
- Sign 48" and wider or larger than 10 sq. ft. in area shall be mounted on two or more sign posts except as noted below.
- Signs 48" and wider or larger than 10 sq. ft. in area may be mounted on objects other than sign posts (i.e. on highway lighting poles) as follows:
 - Signs 48" and wider but less than 10 sq. ft. in area shall be mounted with a minimum of two sets of band bracket and back braces.
 - Signs larger than 10 sq. ft. and less than 28 sq. ft. in area shall be mounted with a minimum of two sets of band brackets and back braces.
 - Signs larger than 28 sq. ft. in area shall be mounted with a minimum of three sets of band bracket and back braces.
- All parking restriction signs with arrows shall be mounted 45° to the line of traffic flow.
- Sign posts shall extend 3 1/2" above each sign, where required, for attachment of City and County street name signs.
- (R) or (L) indicates right or left and shown on the plans.
- * 7. See plans for special details of signs along bikeways.
- * * 8. The minimum lateral distances shown are guidelines and shall be exceeded whenever possible. The Contractor shall place signs at the maximum practical lateral distance from the edge of the traveled way up to 30 feet and shall utilize protected locations whenever possible. Final locations of all signs shall be approved by the Engineer.
- Signs in medians shall be placed at midpoint of median up to a maximum distance of 30 feet from the edge of traveled way. When appropriate, signs for opposing directions shall be placed back to back.
- Anchor bases shall be installed for all signpost installations, unless otherwise shown or directed. See sheets DT 100A and DT 100B.

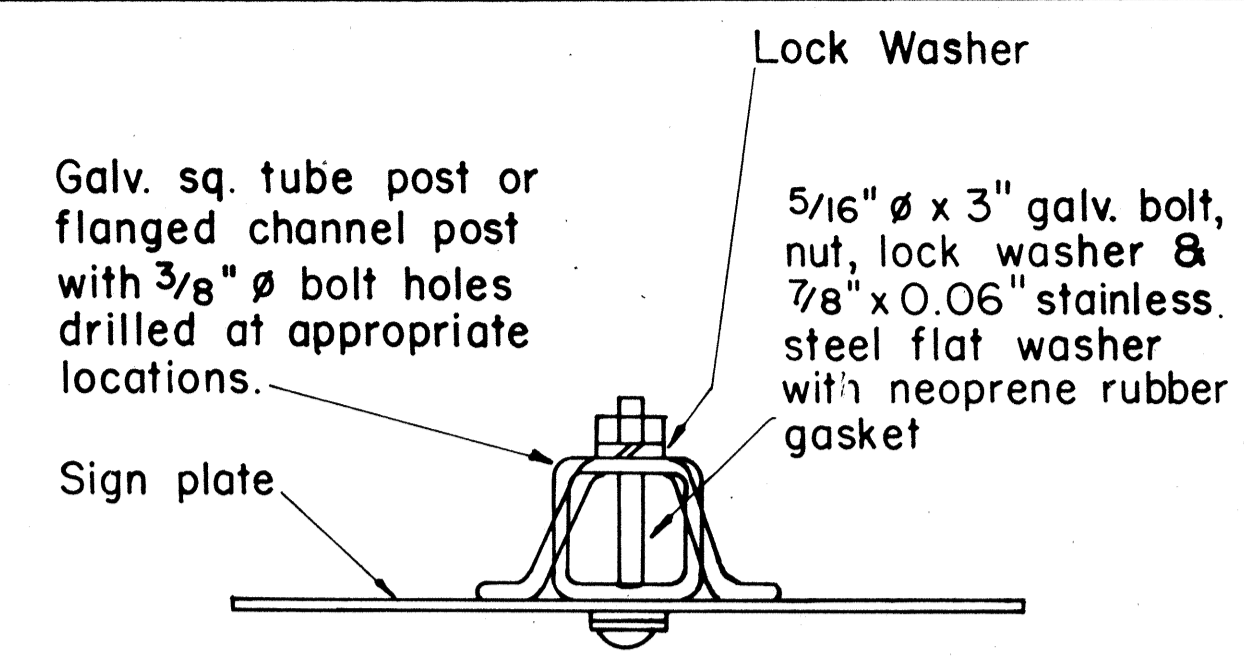

GALVANIZED SQUARE TUBE OR FLANGED CHANNEL POST

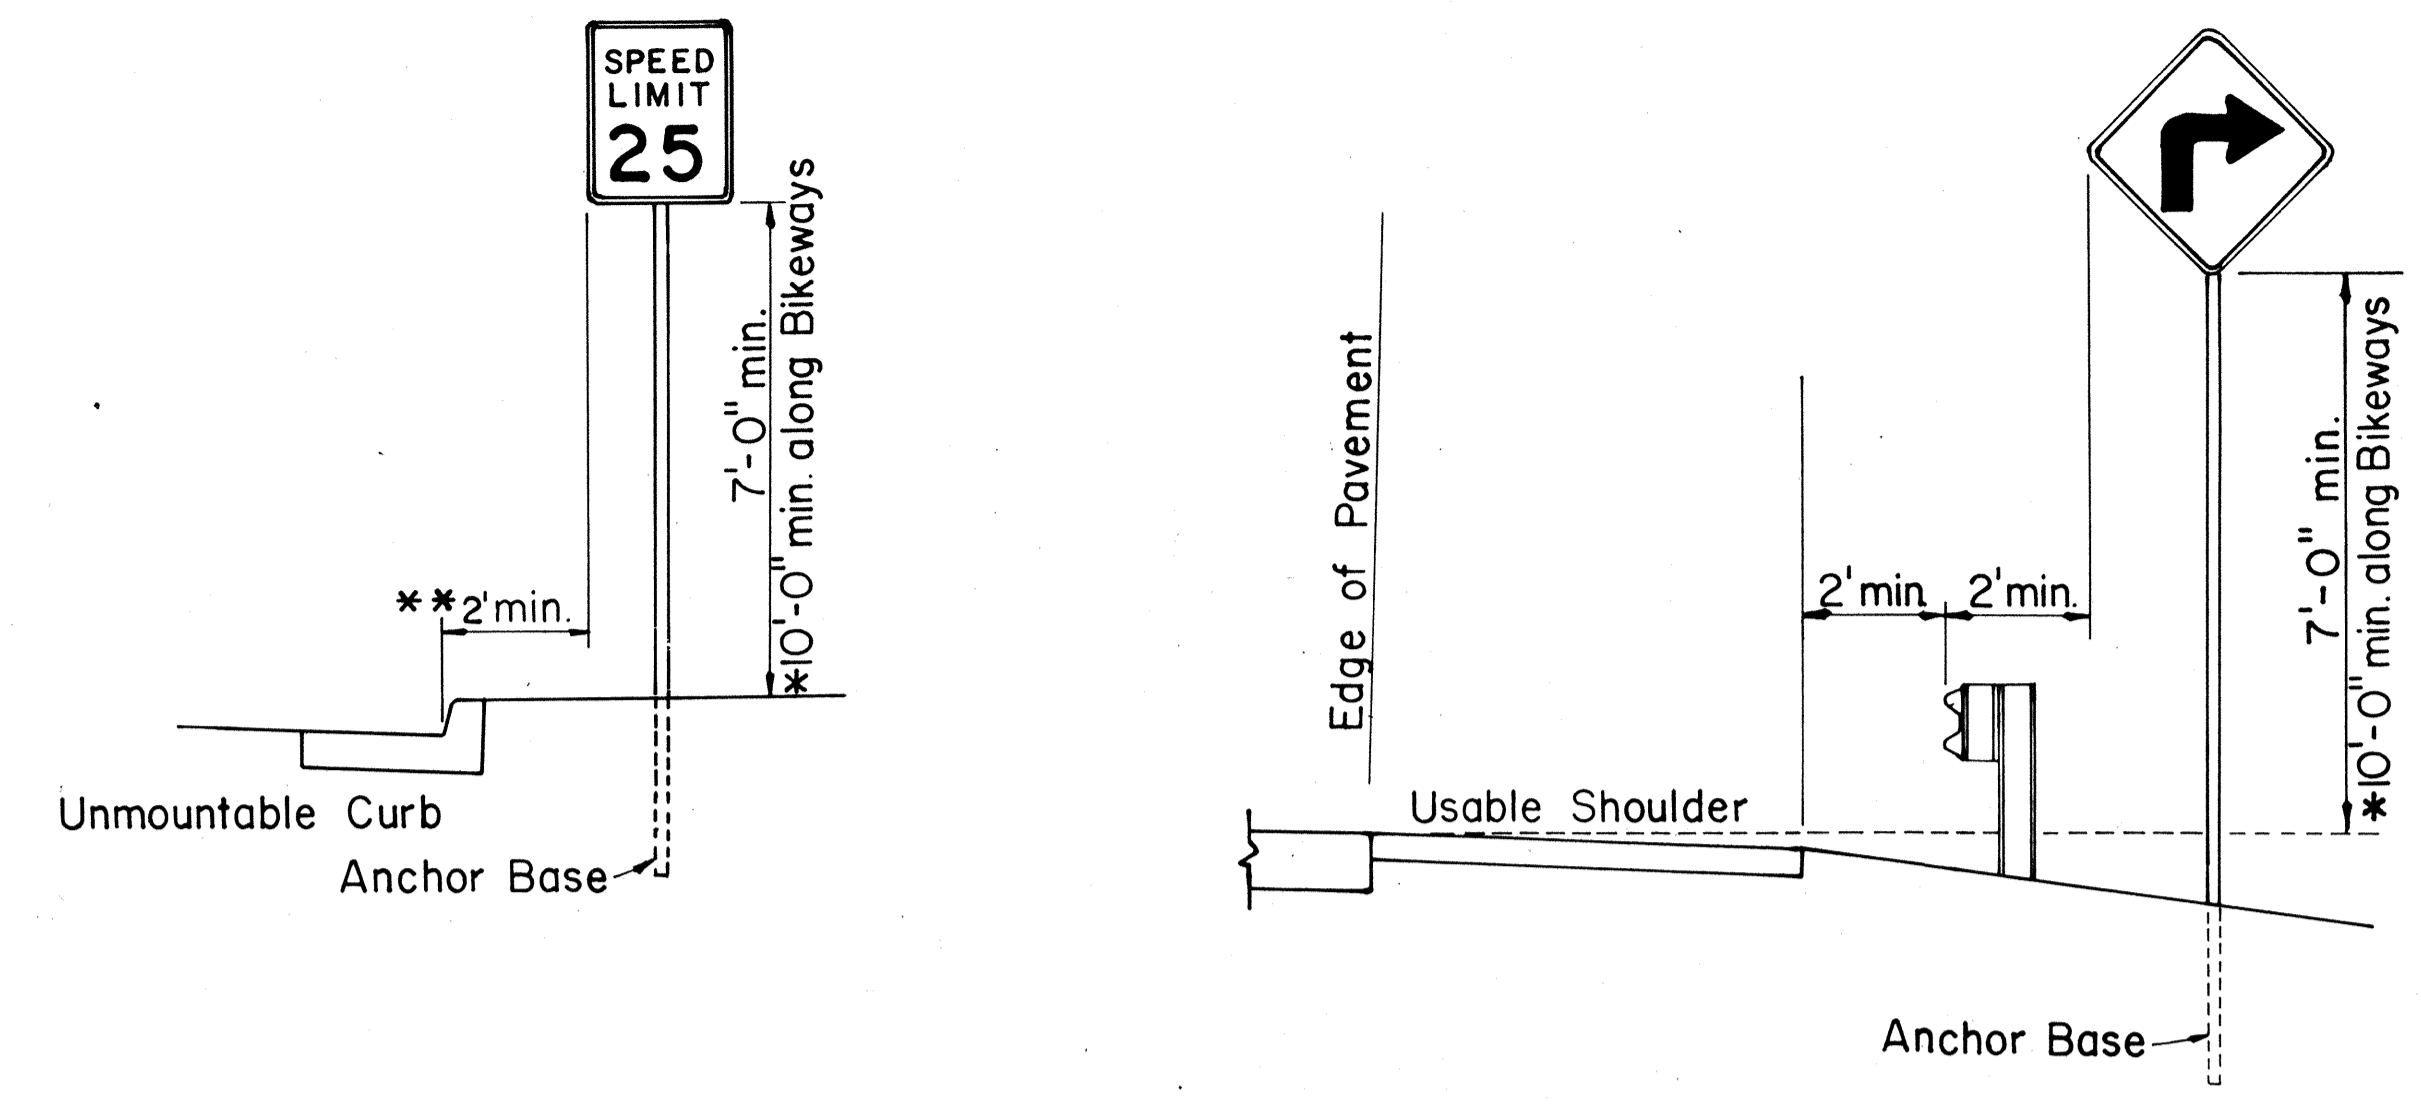

ROADSIDE ASSEMBLY RURAL DISTRICT

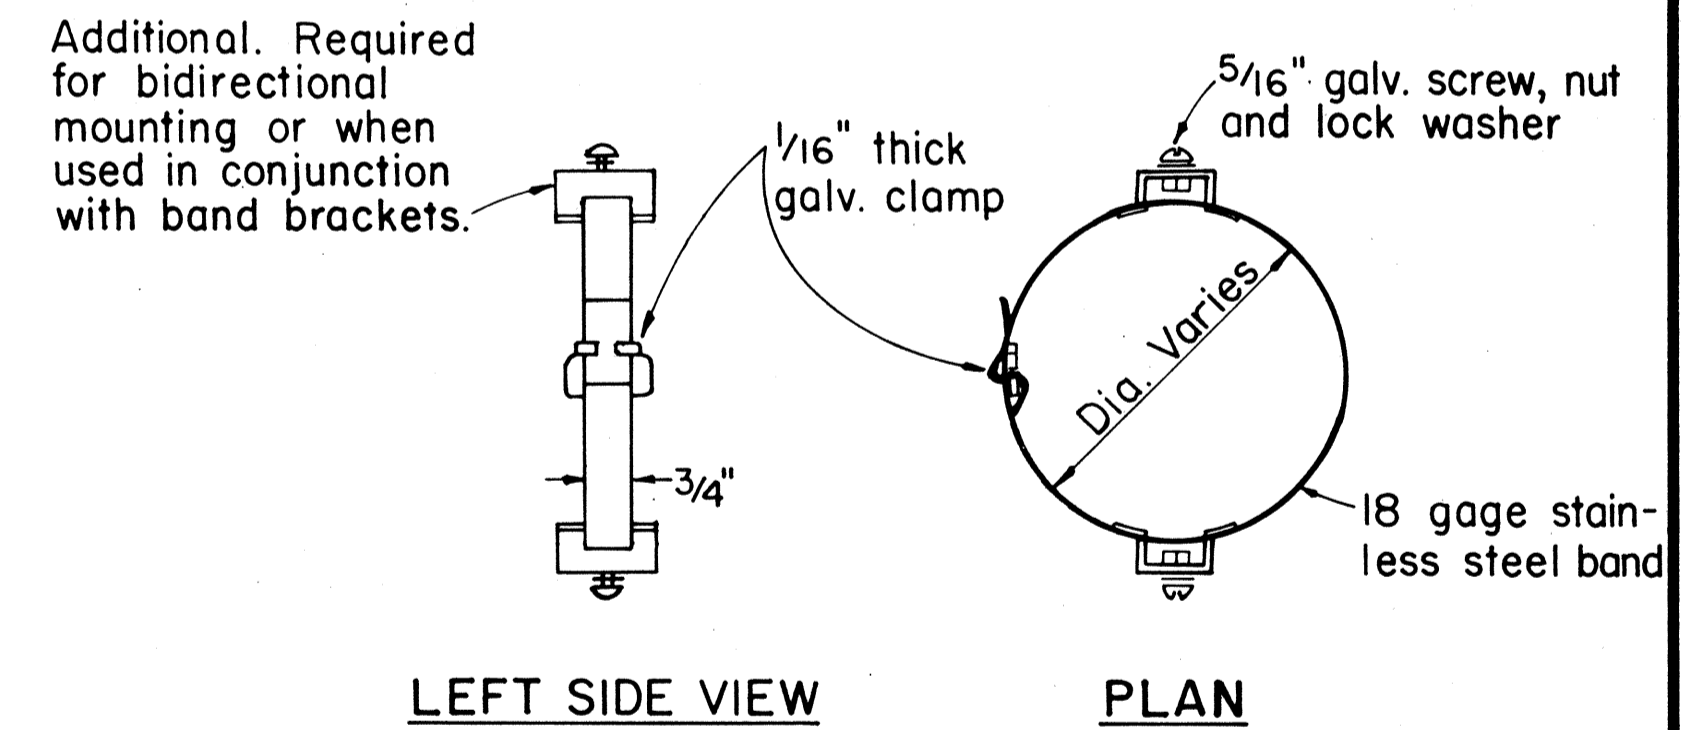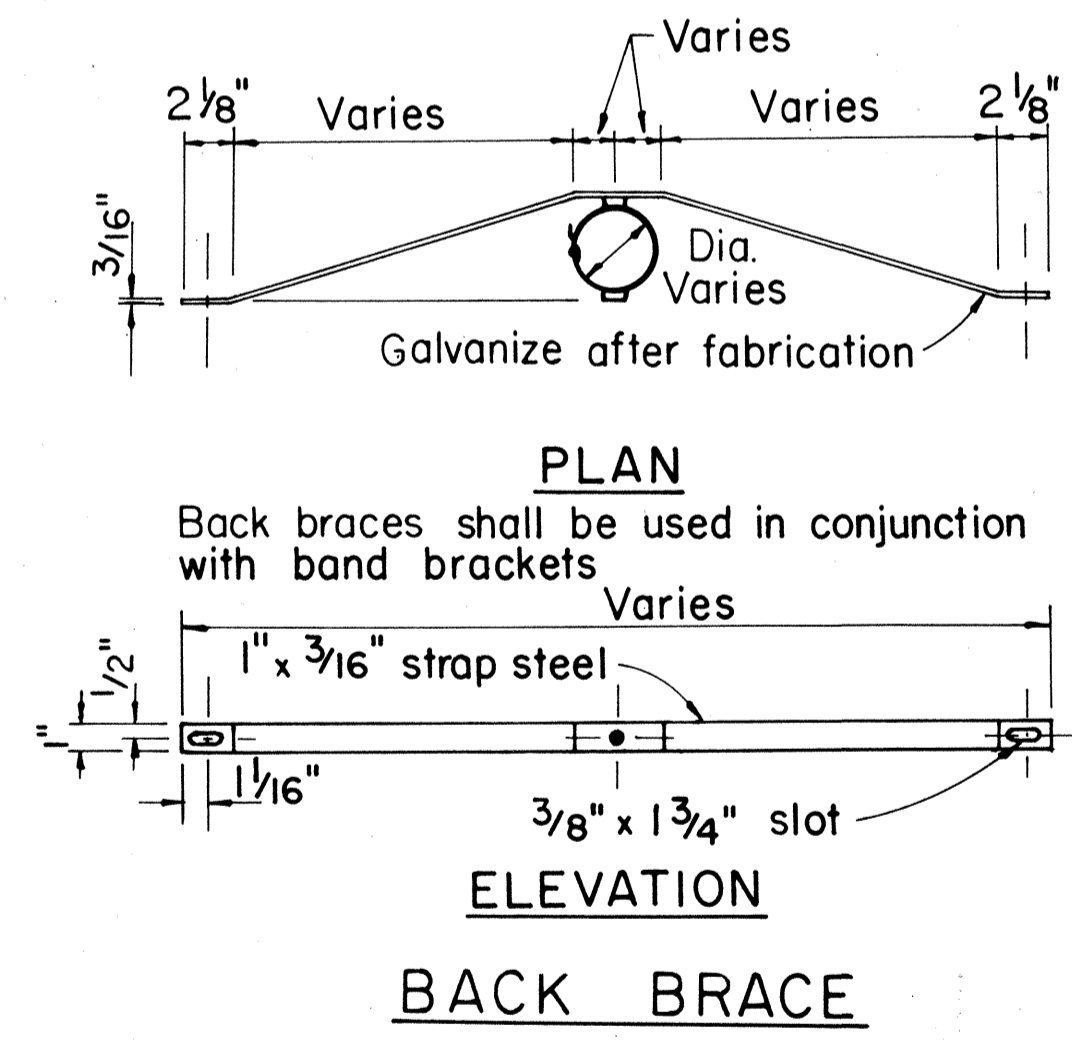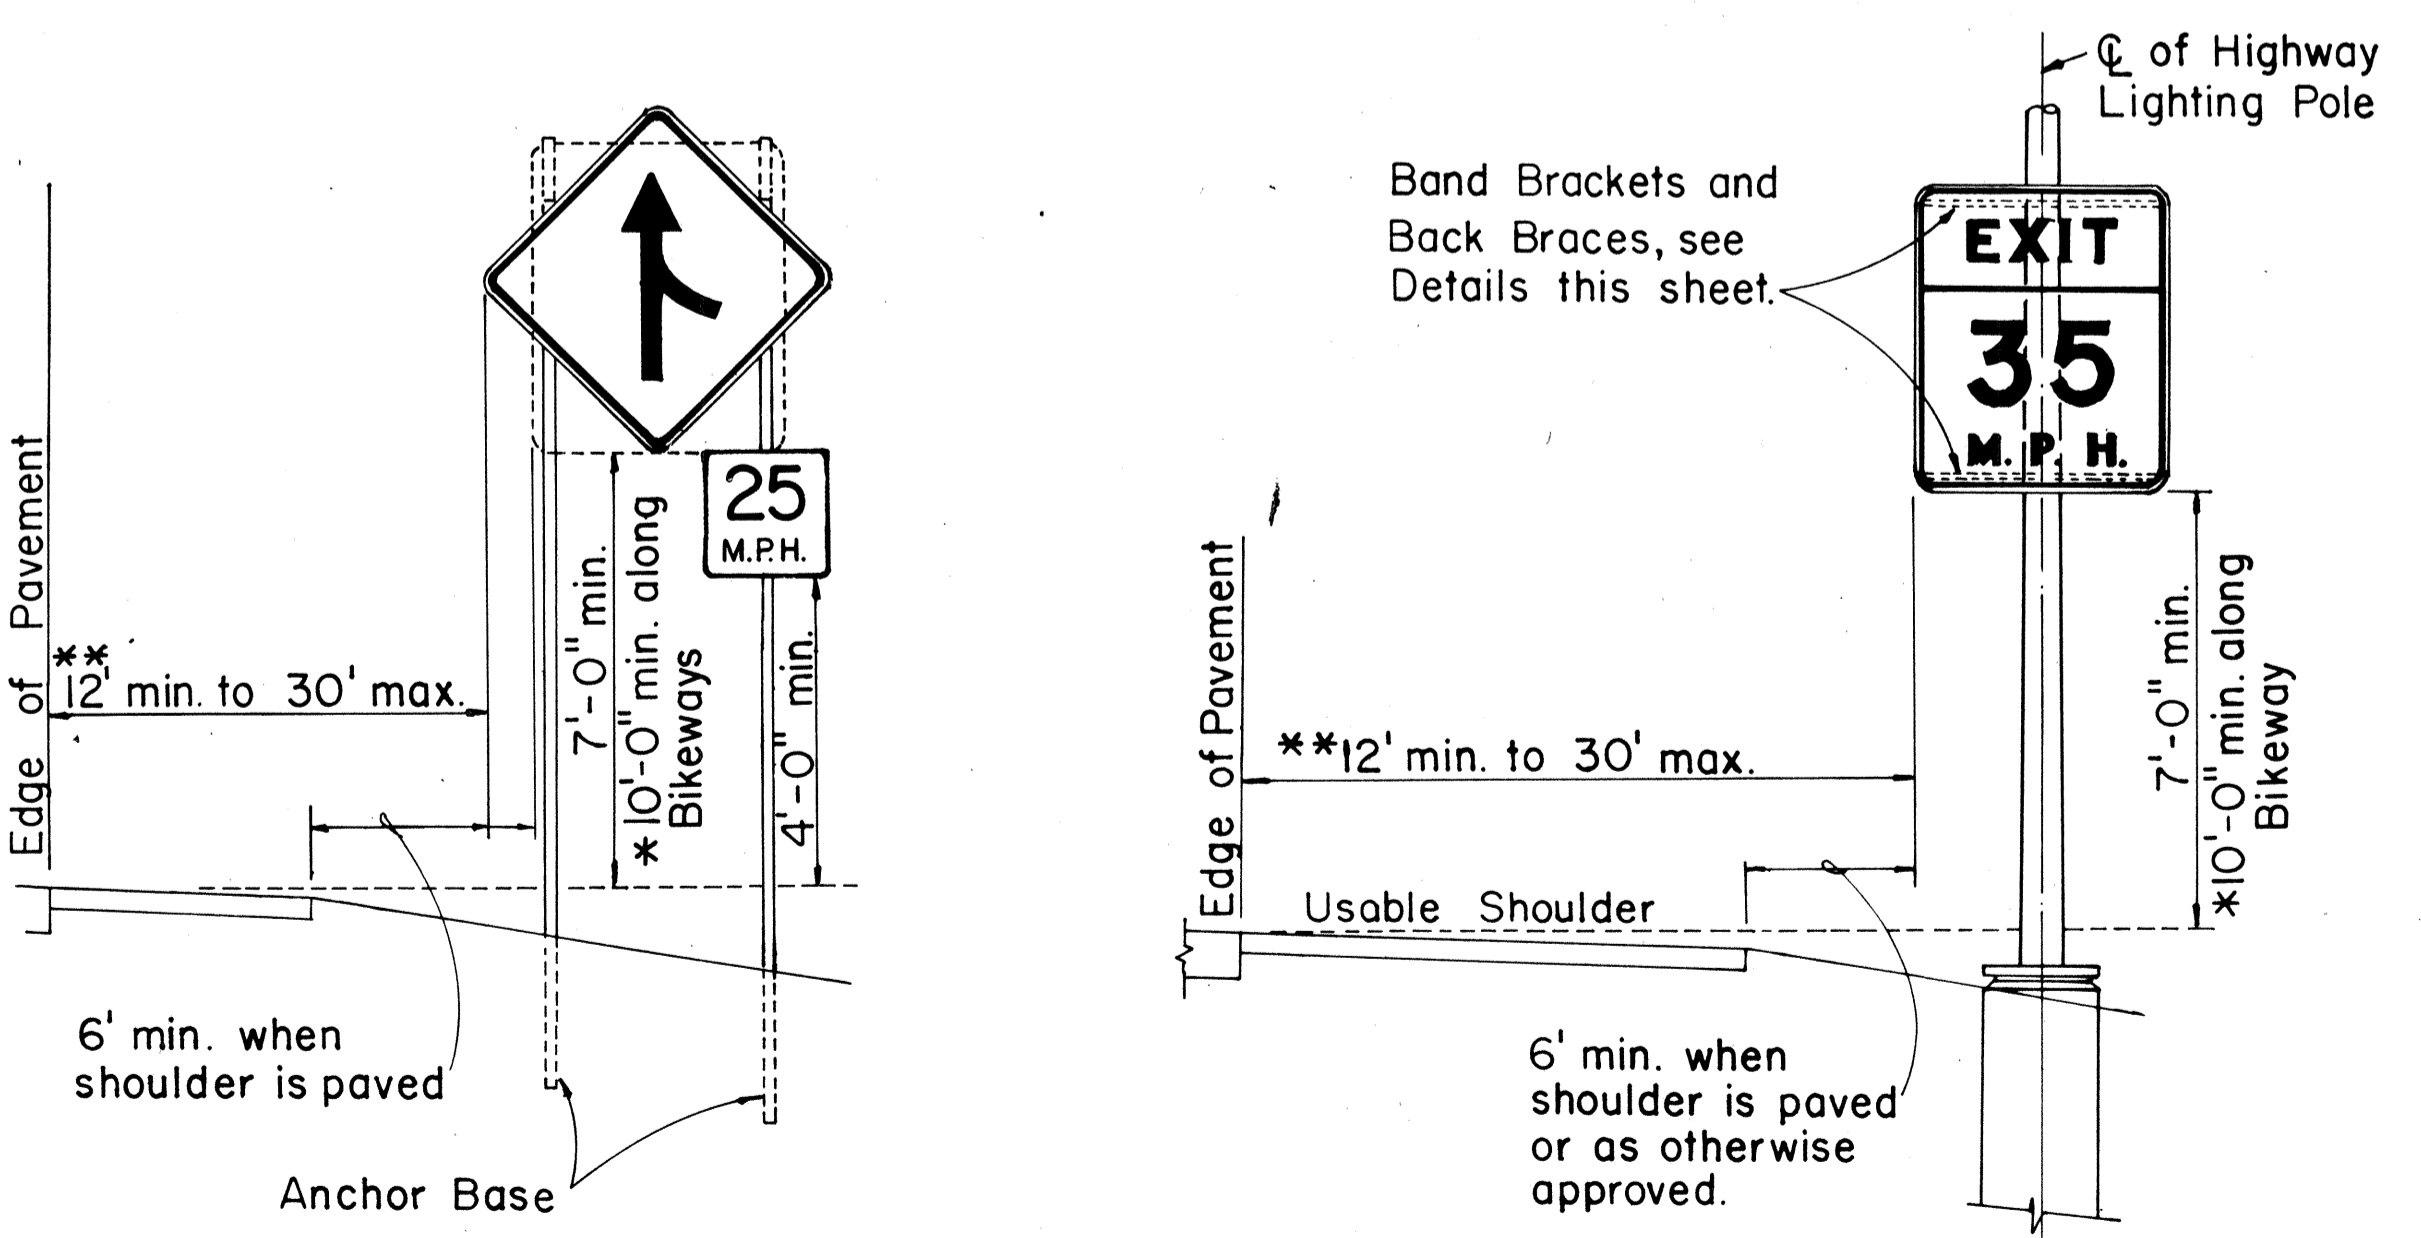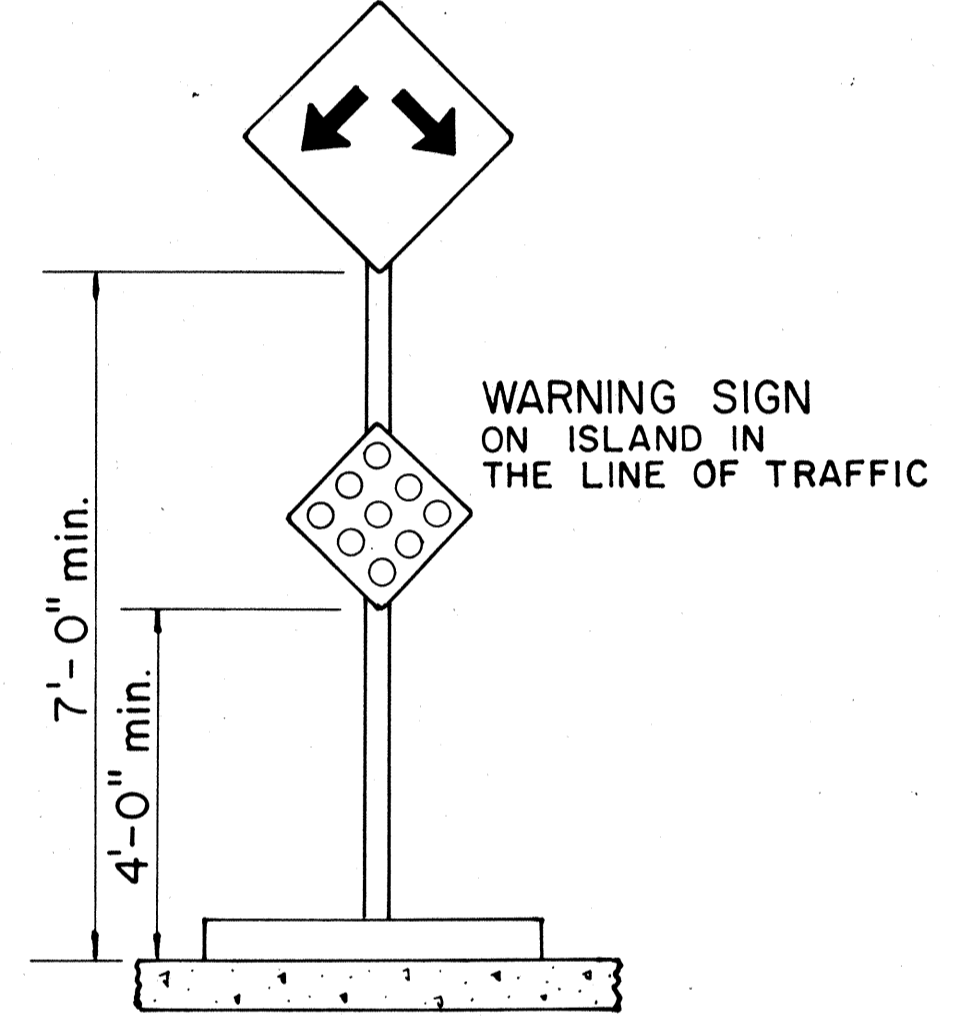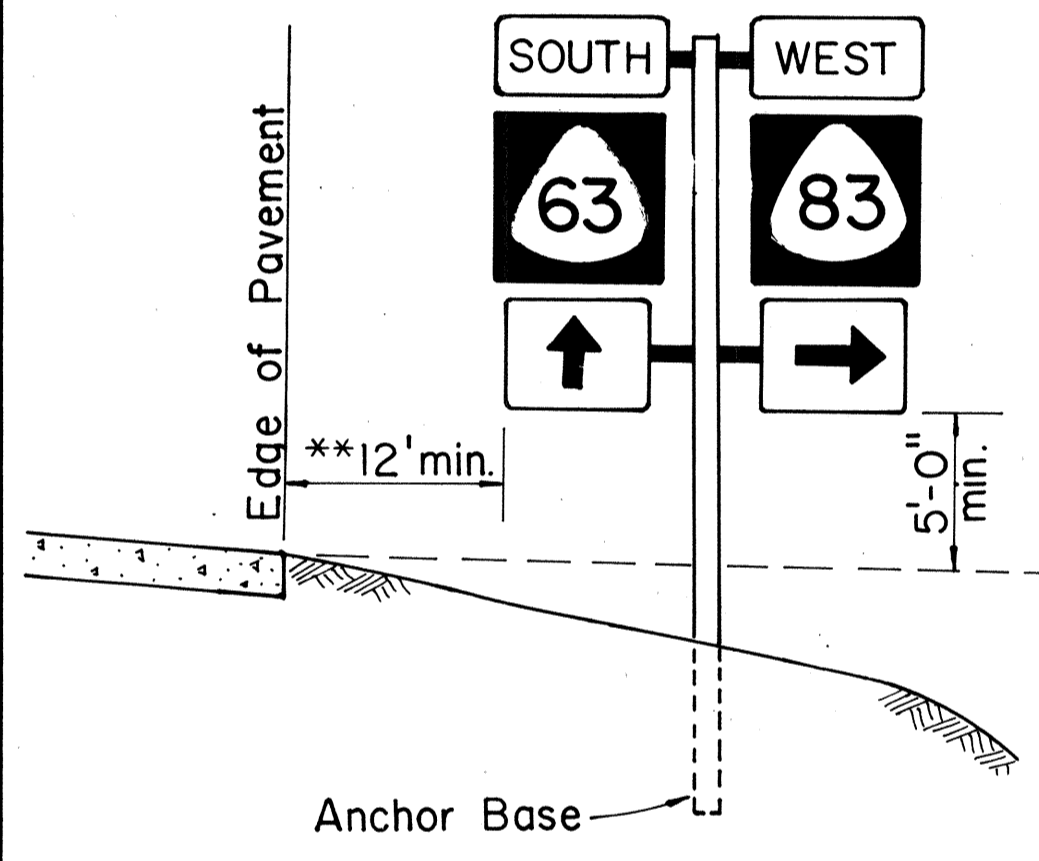

TYPICAL MOUNTING DETAILS

NO.	REVISION	APPROVED BY	DATE
1	Supercedes Sht. DT 100 approved 11/15/77	[Signature]	10-18-83

APPROVAL RECOMMENDED:
Eiichi Tanaka 10/17/83
 TRAFFIC ENGINEER DATE

APPROVED:
S. Fujiyama 10-18-83
 ASSISTANT CHIEF, ENGINEERING DATE

STATE OF HAWAII
 DEPARTMENT OF TRANSPORTATION
 HIGHWAYS DIVISION

STANDARD DETAILS

MISCELLANEOUS SIGN DETAILS

Not to Scale: Oct. 1983
 SHEET NO. 43 OF 19 SHEETS DT 100

DATE	
SURVEY PLOTTED BY	
DRAWN BY	
DESIGNED BY	
QUANTITIES BY	
CHECKED BY	
NO.	

HEIGHT AND LATERAL LOCATION OF SIGNS TYPICAL INSTALLATION

FED. ROAD DIST. NO.	STATE	FED. AID PROJ. NO.	FISCAL YEAR	SHEET NO.	TOTAL SHEETS
HAWAII	HAW.	IR-HI-1 (193)	1986	44	62

A or A ₁	C	C ₁
36"	6"	-
48"	9"	19"
60"	12"	24"

NOTE: Frame stiffeners are required when D is greater than 24". See Gen. Note 4.

GENERAL NOTES

- Sign posts and base posts shall be flanged channel type structural steel conforming to ASTM A 499 and galvanized in accordance with ASTM A 123.
NOMINAL DIMENSIONS:
2.50 lbs./ft. - 3.125" x 1.562"
4.00 lbs./ft. - 3.500" x 1.750"
- Retainer - Spacer Strap shall be AISI 1020 steel and galvanized in accordance with ASTM A 123.
- Retainer and Connector Bolts shall be 5/16 - 18 UNC x 1.75" long hex. head, integral flange conforming to ASTM A 354 Grade BC. Nuts shall be 5/16 - 18 UNC hex. head, integral flange conforming to ASTM A 563 Grade D. All bolts and nuts shall be cadmium plated per Federal spec. QQP 416 B, Class 2, Type 2.
- All accessories, fittings and stiffener details (as required) shall be submitted to Engineer for approval 20 days prior to installation.
- For additional details see sht. DT 100.
- Basic formulas for use with the windload charts:
Factor = A x B x H
Therefore, if sign area (A x B) is known,
Maximum H = $\frac{\text{Factor}}{\text{sign area (A x B)}}$
and if H is known,
Maximum sign area (A x B) = $\frac{\text{Factor}}{H}$

APPROVAL RECOMMENDED:

Eishi Tanaka 9/21/82
TRAFFIC ENGINEER DATE


APPROVED:
ASSISTANT CHIEF, ENGINEERING DATE

STATE OF HAWAII
DEPARTMENT OF TRANSPORTATION
HIGHWAYS DIVISION

STANDARD DETAILS
GALVANIZED FLANGED CHANNEL
SIGN POST MOUNTING

Scale: As Shown Date: Sept. 1982

SHEET NO. 44 OF 19 SHEETS DT 100A

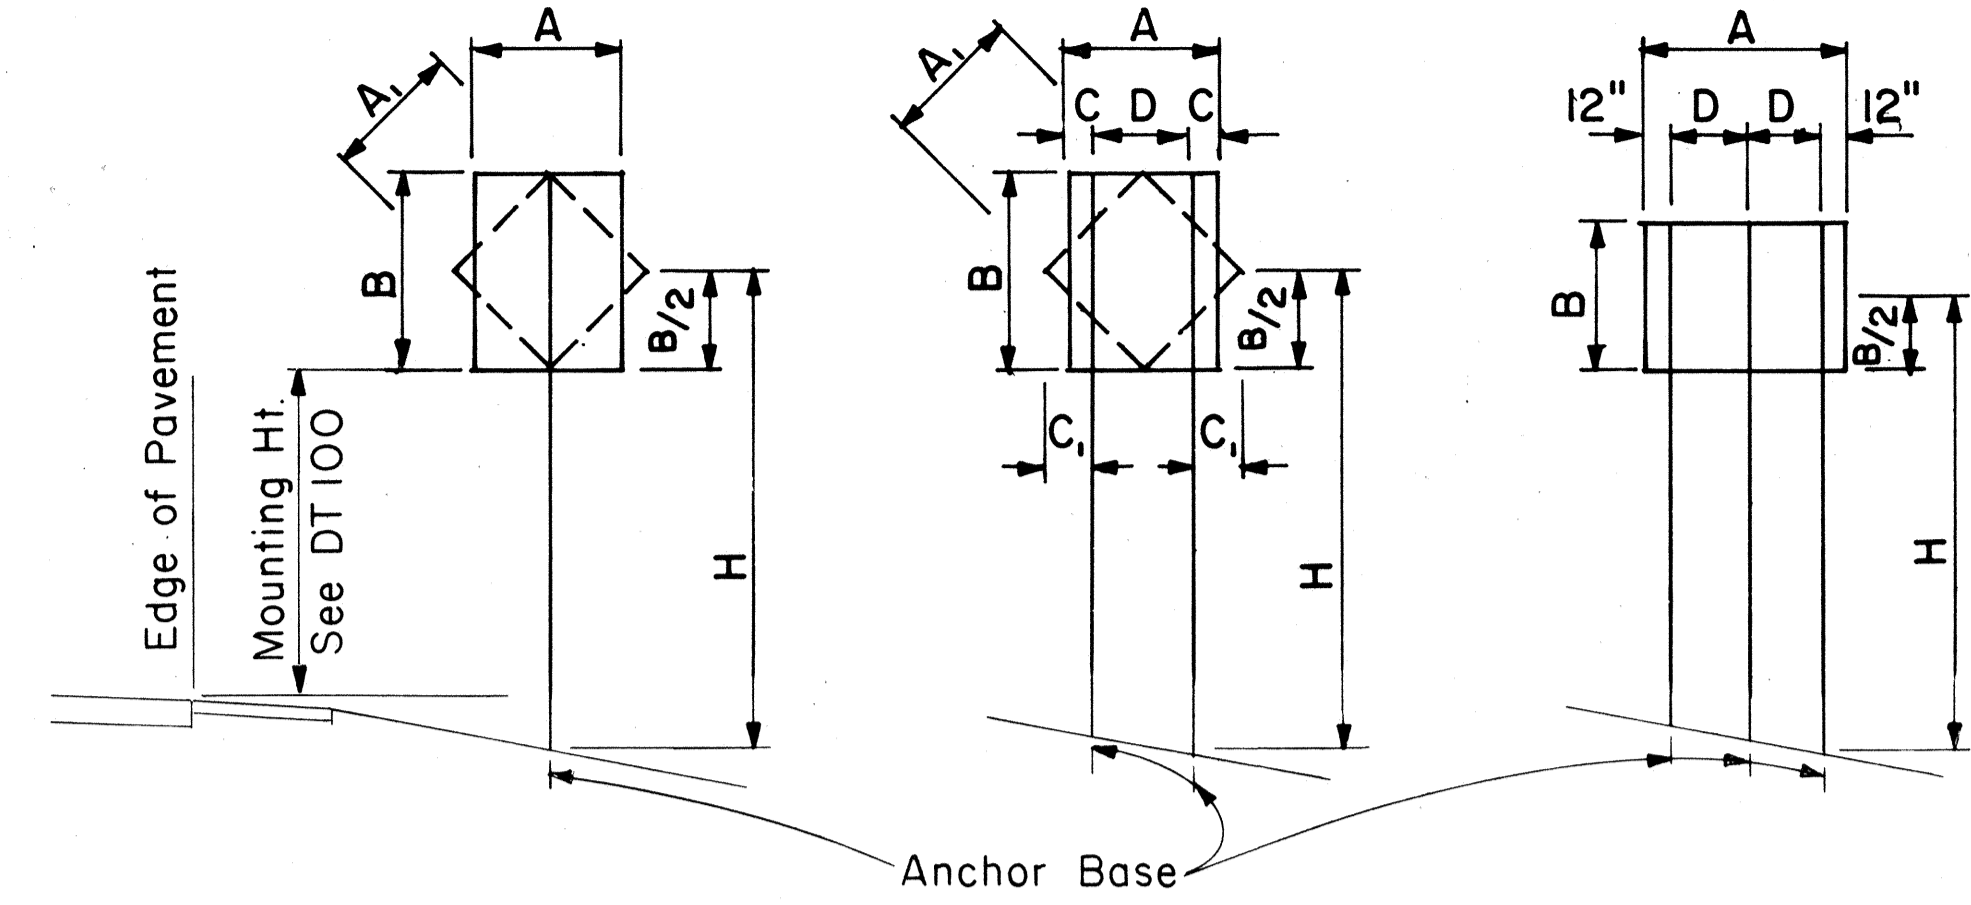

1- POST Sign area 10 sq. ft. and less
2- POST Sign area greater than 10 sq. ft. or A = 48" - 60"
3- POST A = greater than 60"

TYPICAL INSTALLATION

Not to Scale

FLANGED CHANNEL: 1-POST INSTALLATION

Post Size	A x B x H (Factor)	H = Ground Level to Midpoint (ft.)						A x B (Area, sq. ft.)
		7	8	9	10	11	12	
2.50 lbs./ft.	57	8.14	7.13	6.33	5.70	5.18	4.75	
4.00 lbs./ft.	112	-	-	-	-	-	9.33	

FLANGED CHANNEL: 2-POST INSTALLATION


Post Size	A x B x H (Factor)	H = Ground Level to Midpoint (ft.)						A x B (Area, sq. ft.)
		7	8	9	10	11	12	
2.50 lbs./ft.	124	17.71	15.50	13.77	12.40	11.27	10.33	
4.00 lbs./ft.	241	34.43	30.13	26.78	24.10	21.91	20.08	

FLANGED CHANNEL: 3-POST INSTALLATION

Post Size	A x B x H (Factor)	H = Ground Level to Midpoint (ft.)						A x B (Area, sq. ft.)
		7	8	9	10	11	12	
2.50 lbs./ft.	187	26.71	23.38	20.78	18.70	17.00	15.58	
4.00 lbs./ft.	362	51.71	45.25	40.22	36.20	32.91	30.17	


WINDLOAD CHARTS

NO.	REVISION	APPROVED BY	DATE

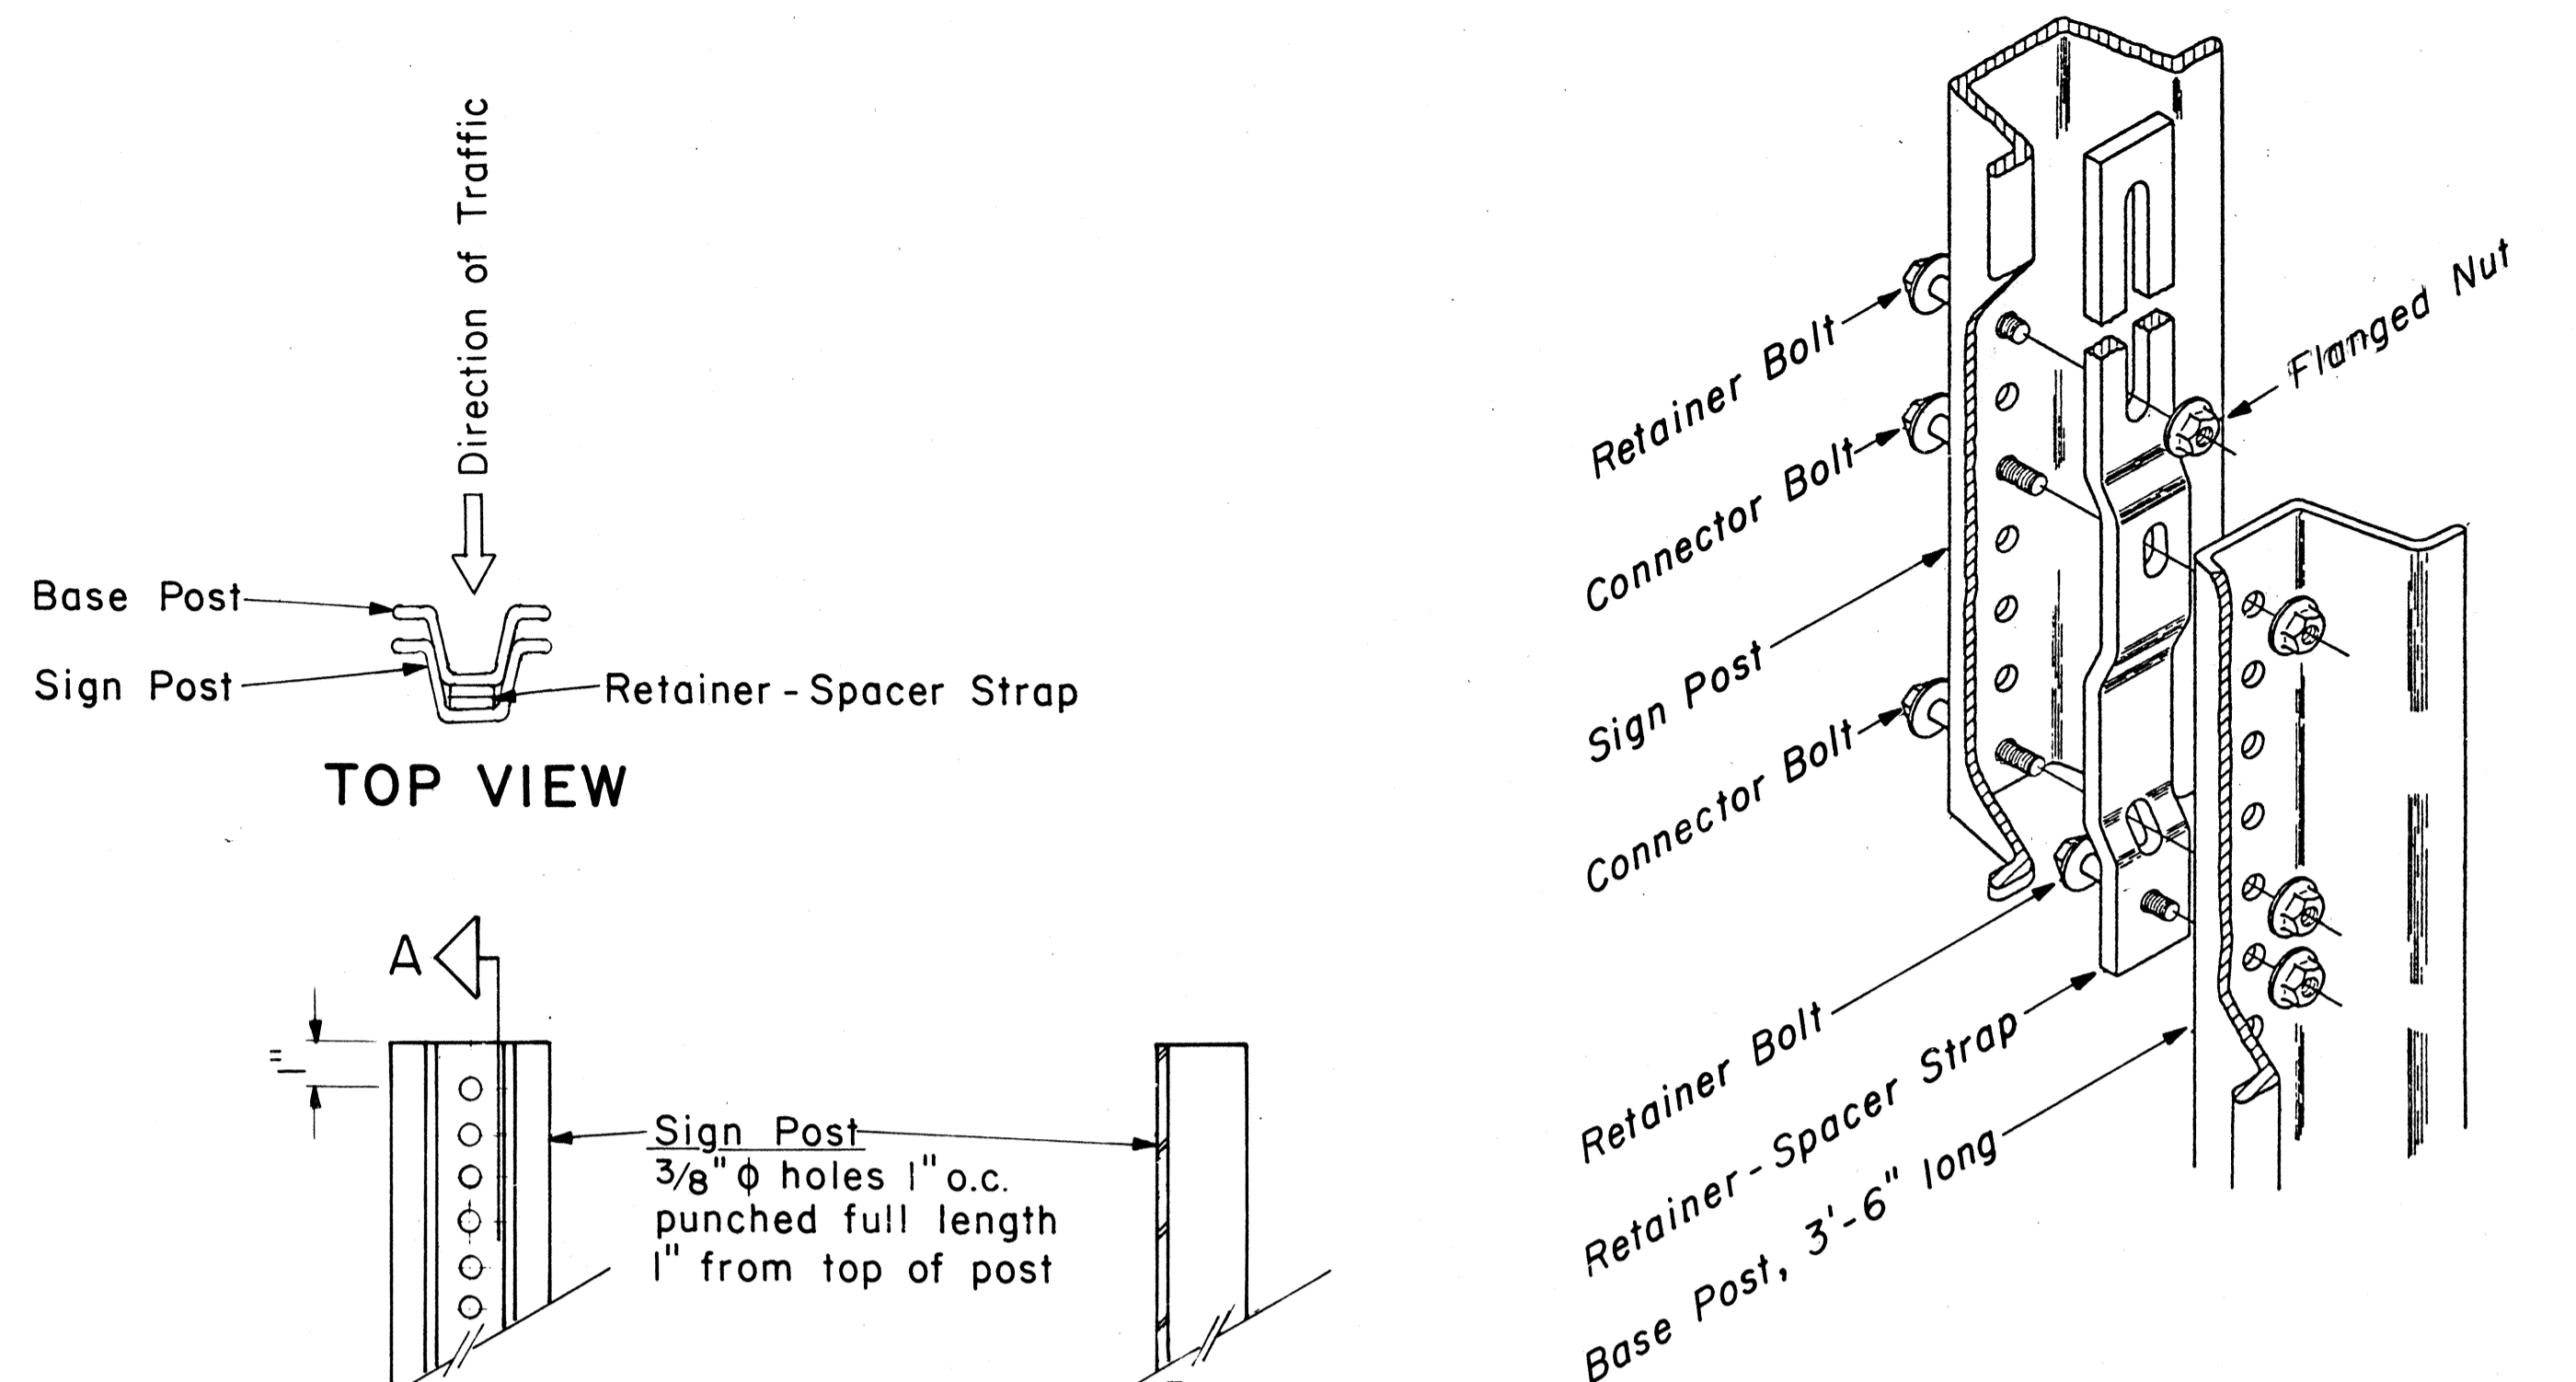

CONNECTION DETAIL

Not to Scale

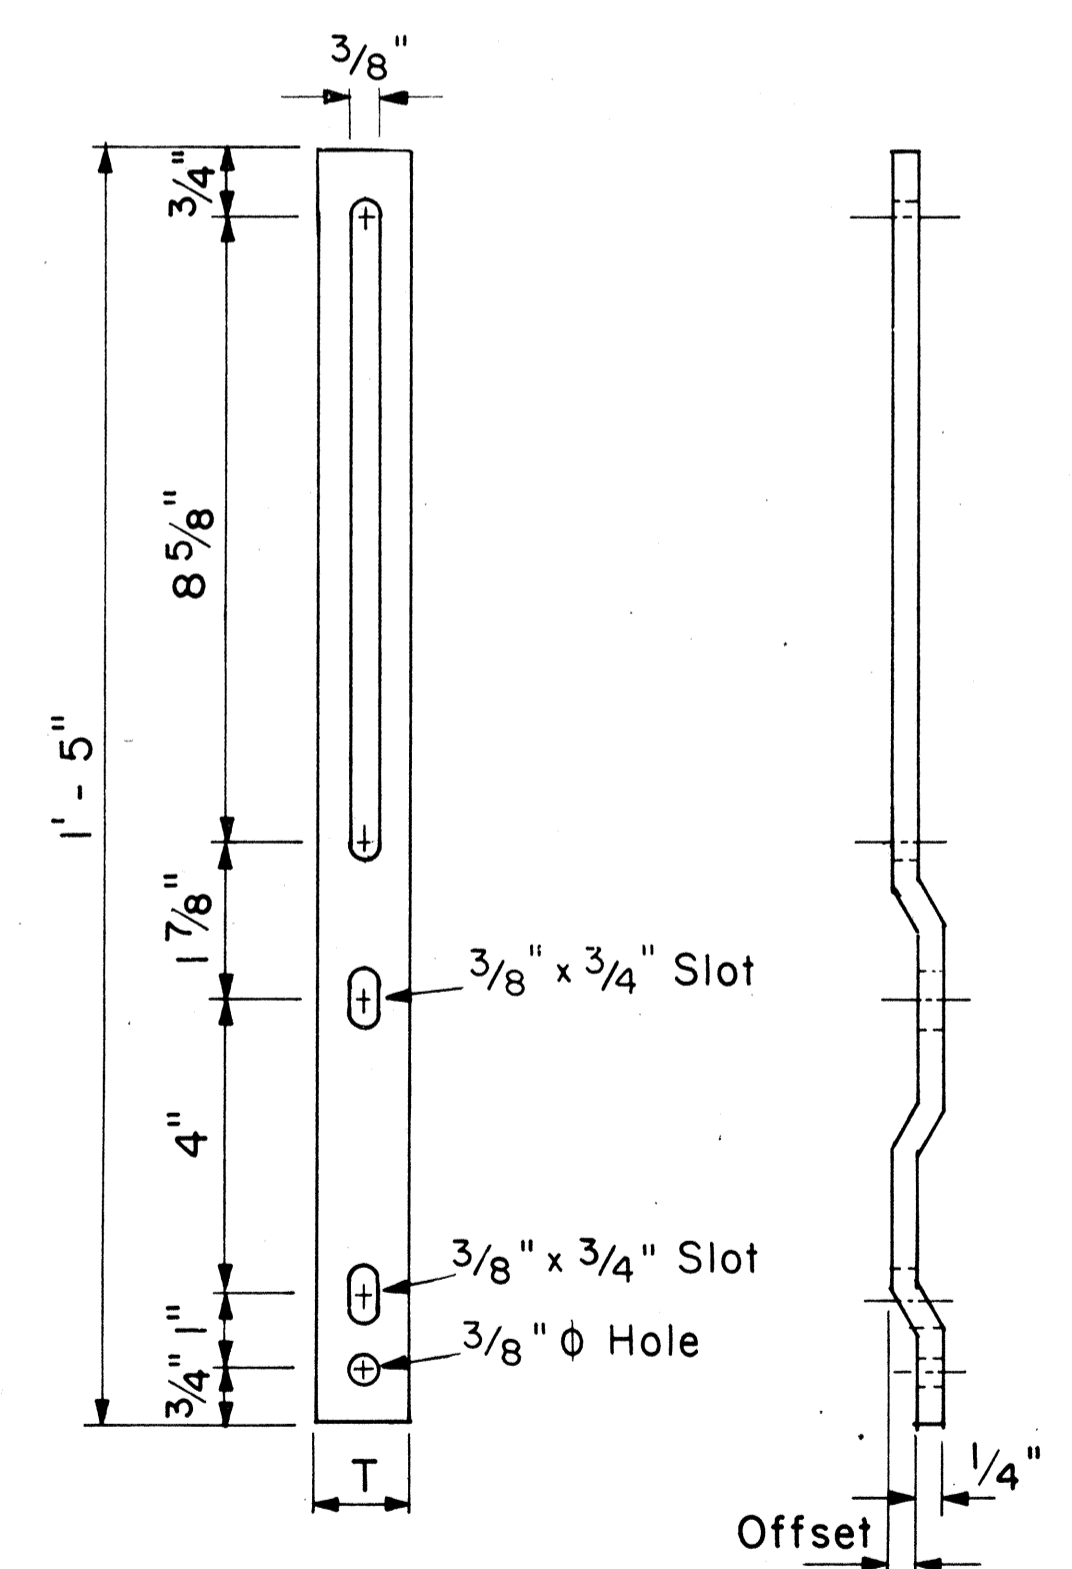


RETAINER-SPACER STRAP

Not to Scale

RETAINER-SPACER STRAP

Post Size	T	Offset
2.50 lbs./ft.	1.00"	0.145"
4.00 lbs./ft.	1.12"	0.280"

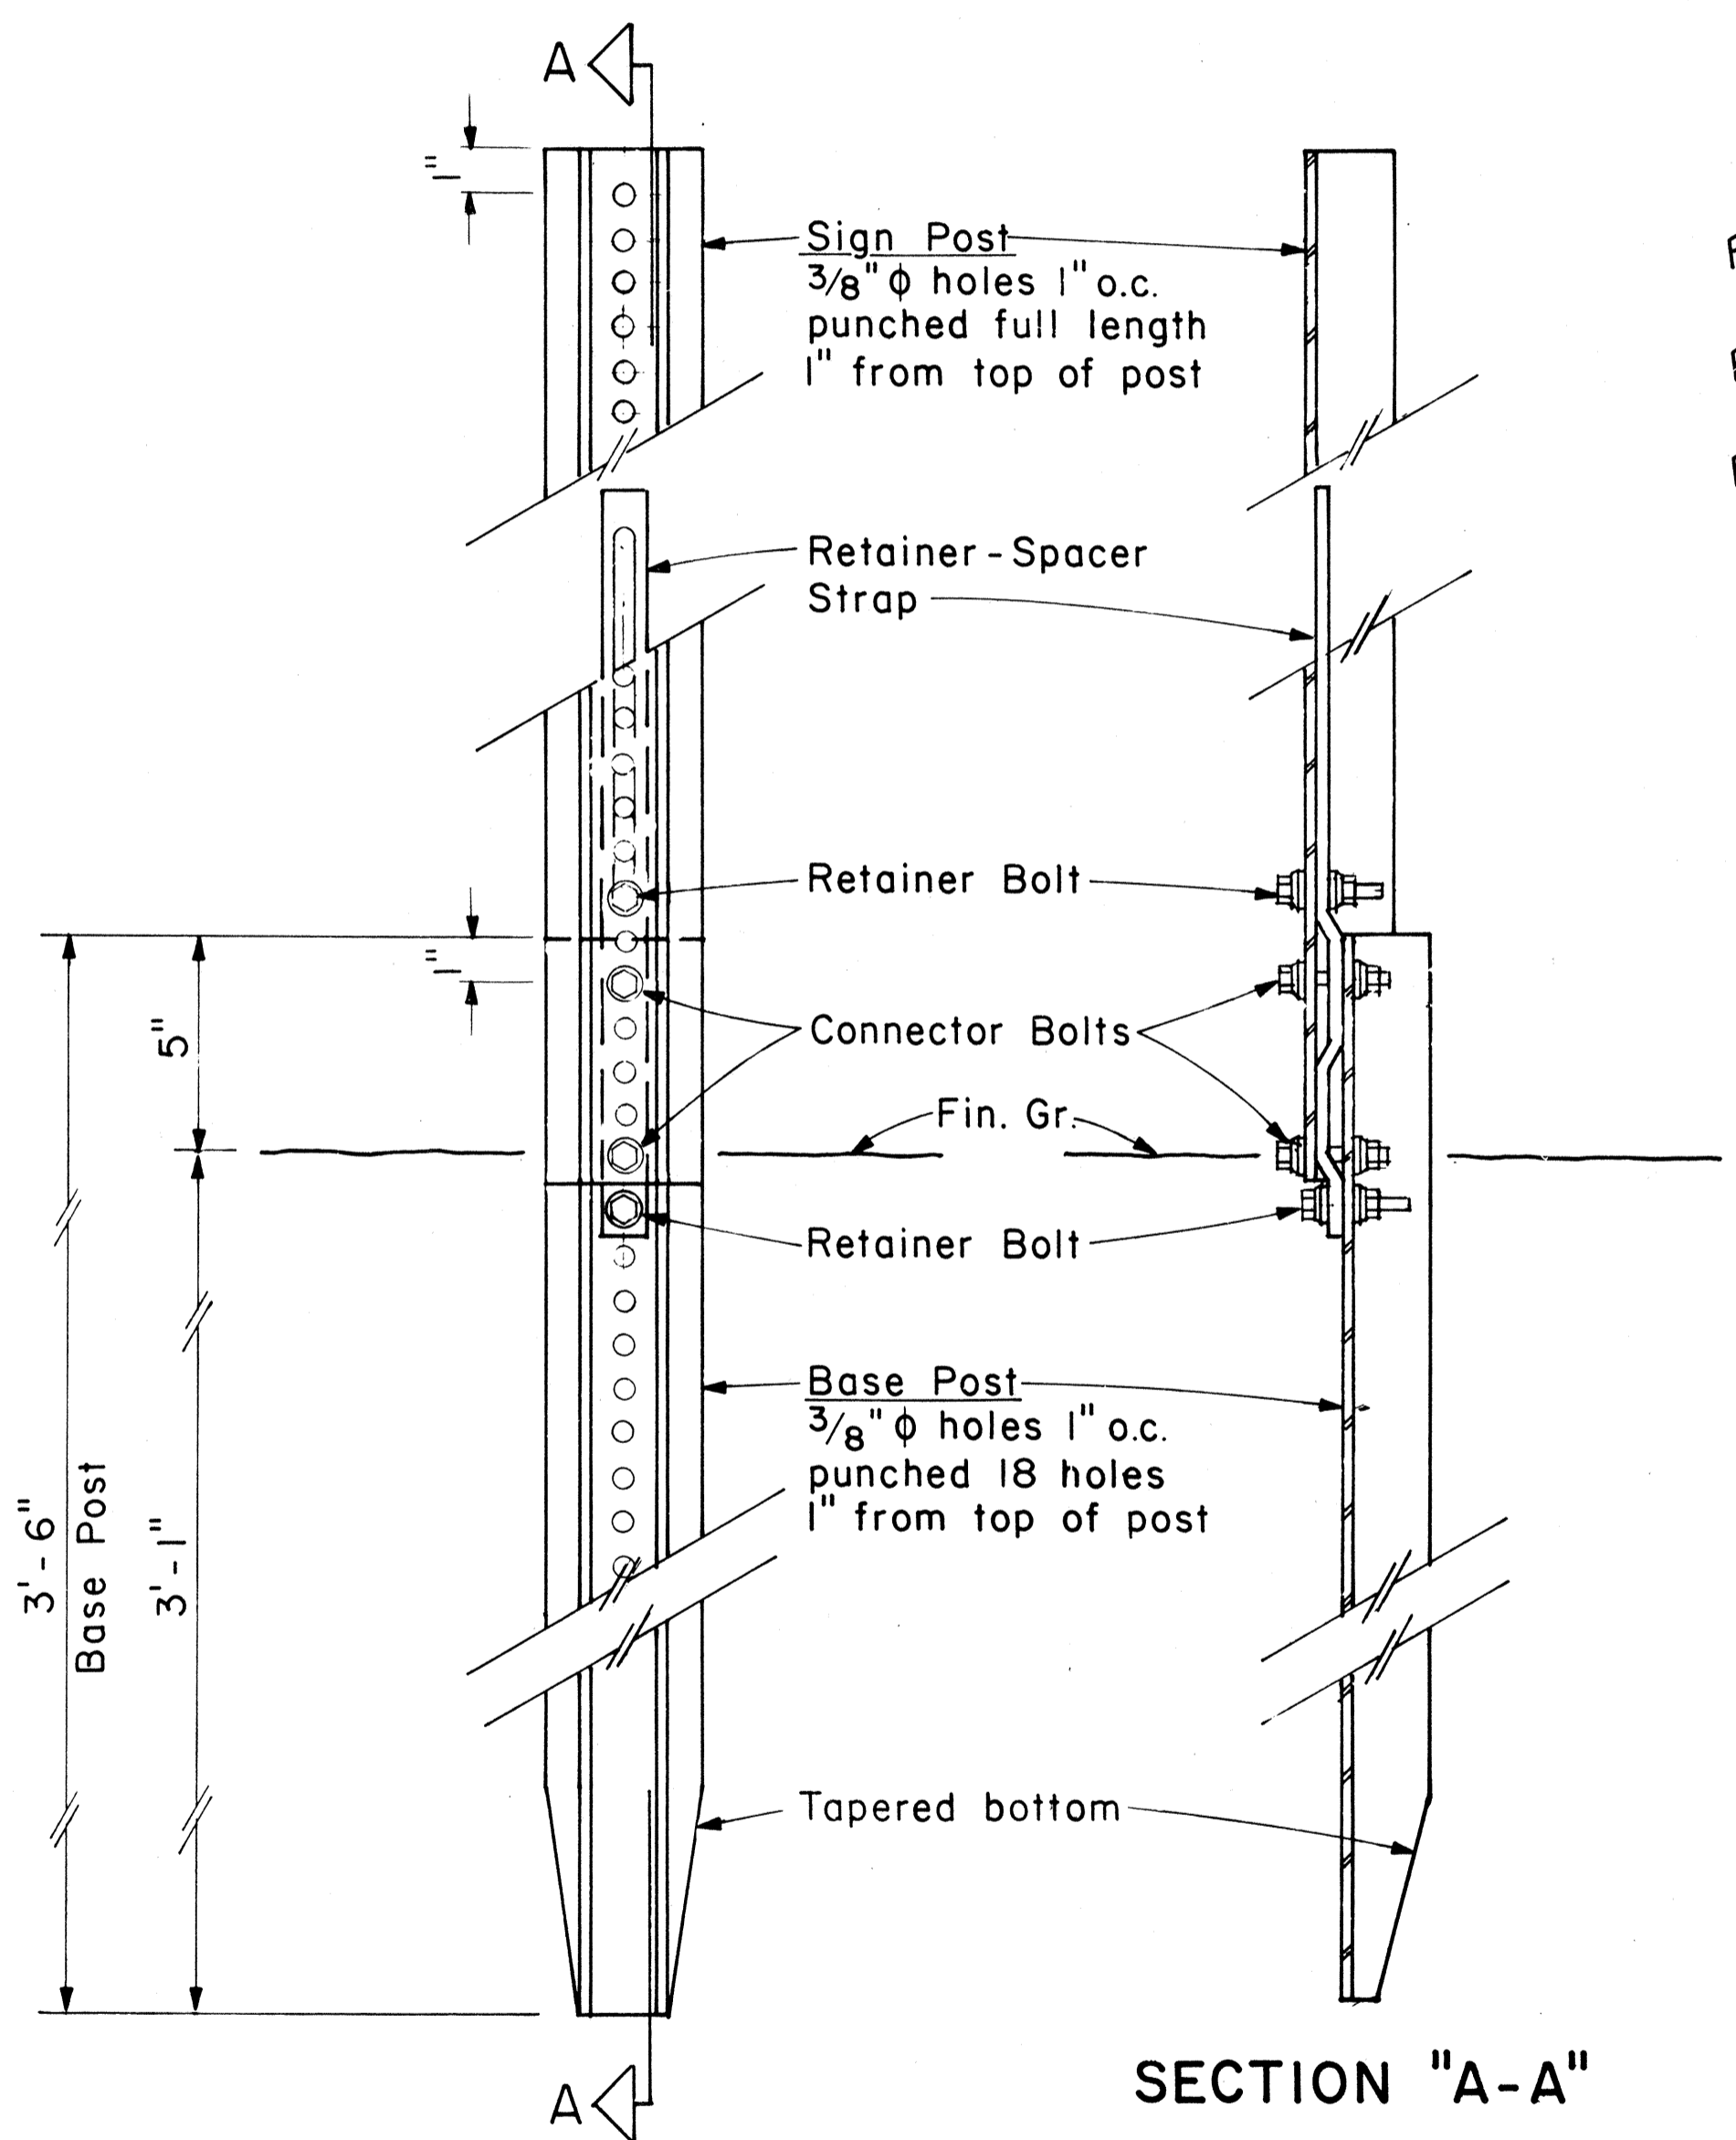

SECTION "A-A"

BACK VIEW


ANCHOR BASE DETAIL

Scale: 3" = 1'-0"


DATE: _____
SURVEY PLOTTED BY: _____
DRAWN BY: _____
DESIGNED BY: _____
NOTE BOOK NO.: _____
QUANTITIES BY: _____
CHECKED BY: _____

GENERAL NOTES

- Square tube sign posts shall conform to Subsection 713.11(C) Square Tube Posts of the Specifications.
- All accessories, fittings and stiffener details (as required) shall be submitted to Engineer for approval 20 days prior to installation.
- Square tube posts shall be perforated with $\frac{7}{16}$ " ϕ holes, 1" o.c., 4 sides, along entire length of post.
- All posts shall be 12 gage unless otherwise specified or shown on the plans.
- For additional details see sht. DT 100.
- Basic formulas for use with the windload charts:
 $Factor = A \times B \times H$
Therefore, if sign area (A x B) is known,
 $Maximum\ H = \frac{Factor}{sign\ area(A \times B)}$
and if H is known,
 $Maximum\ sign\ area(A \times B) = \frac{Factor}{H}$

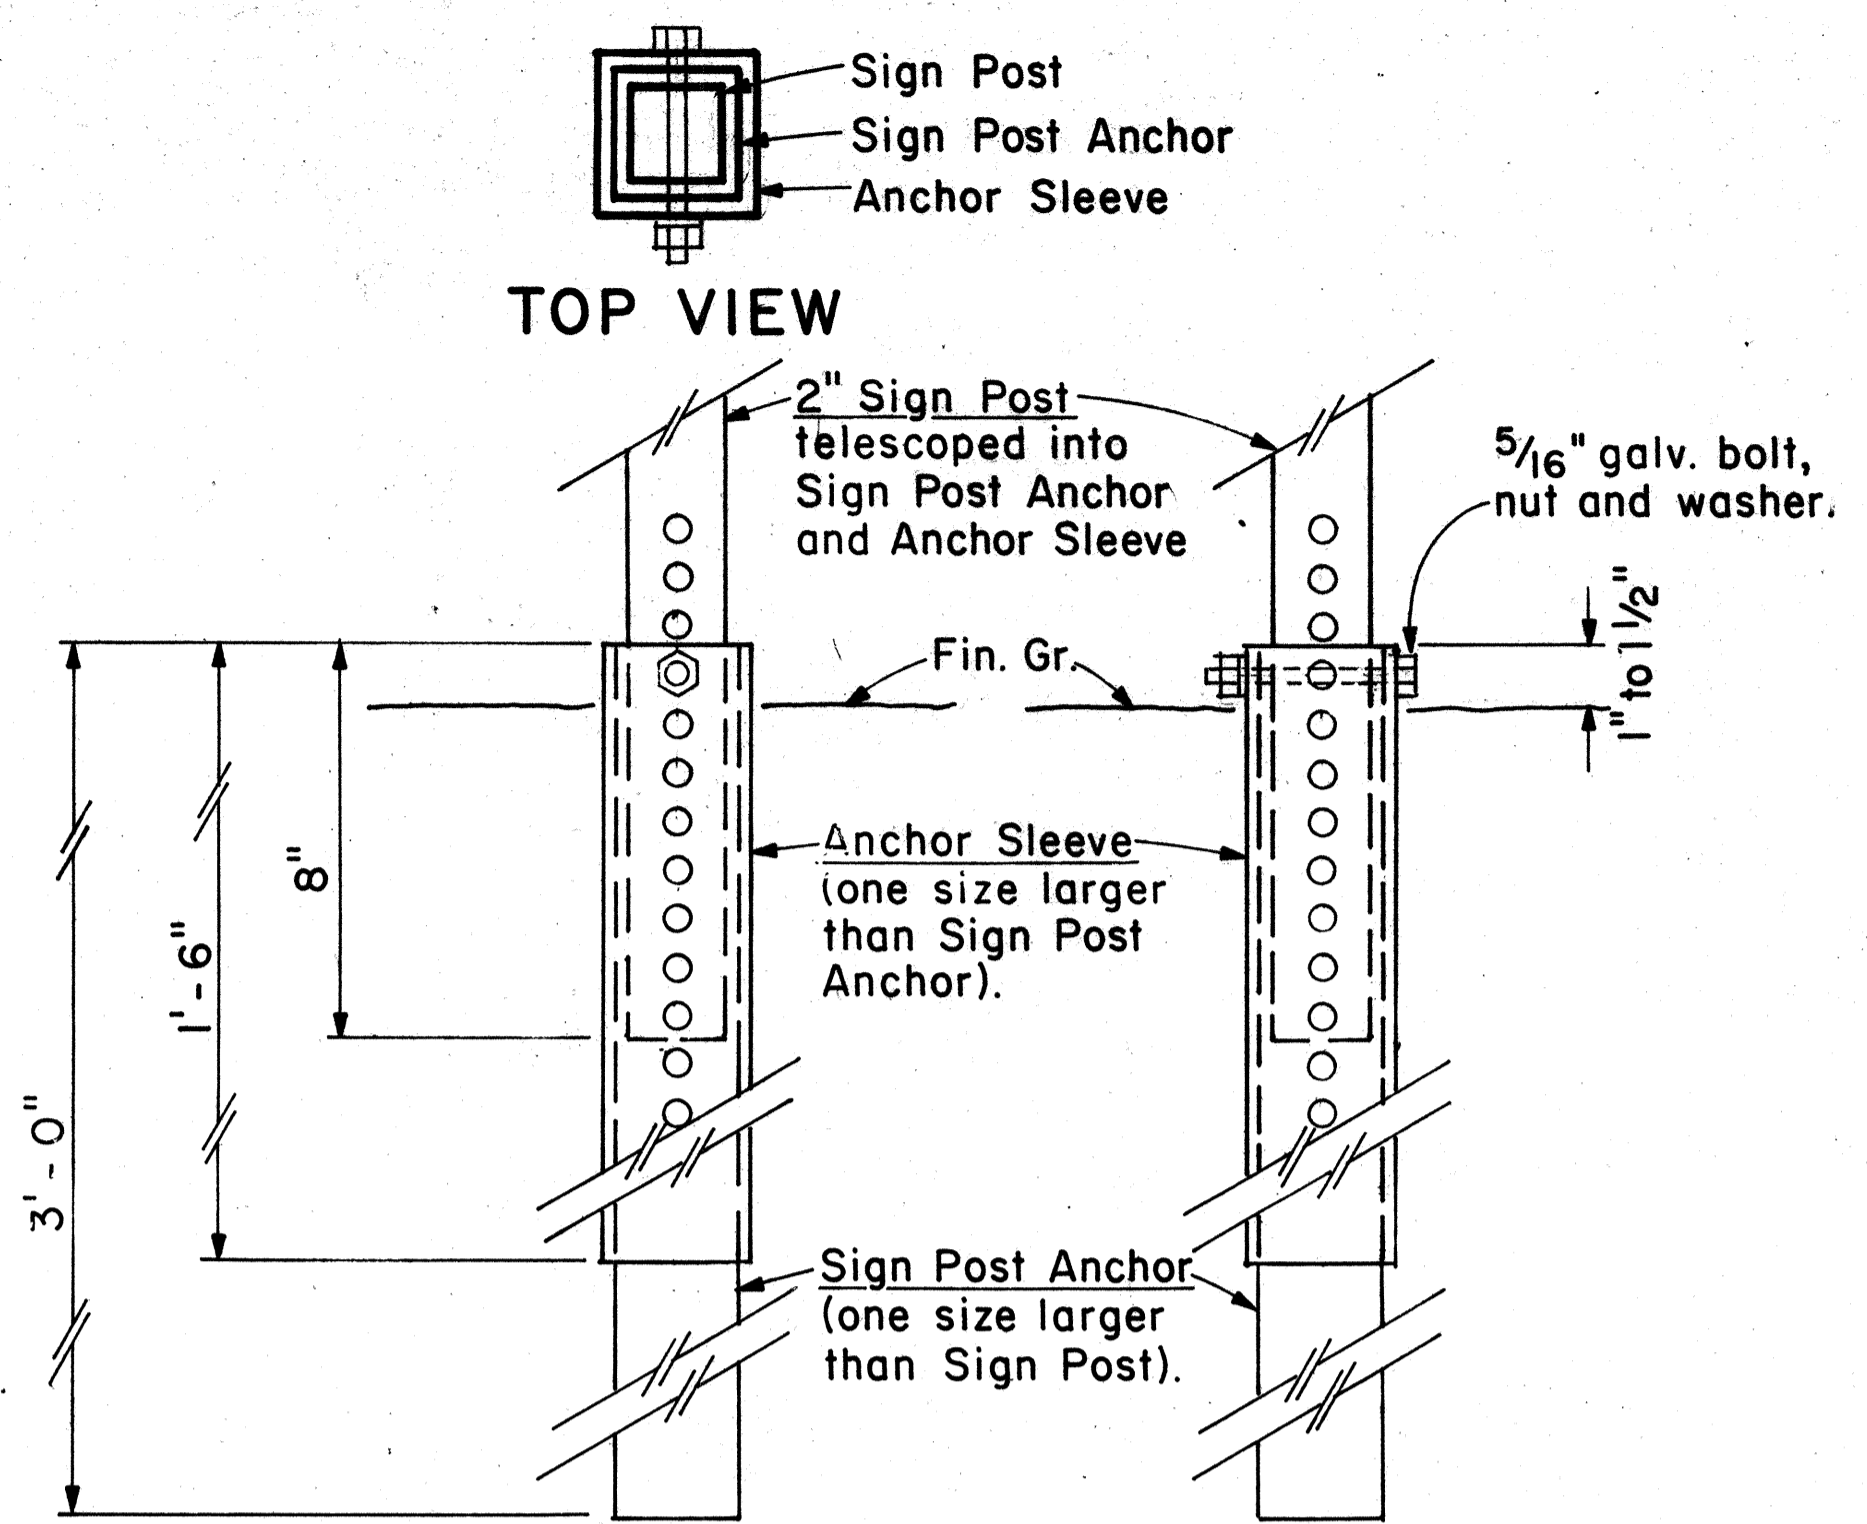

BACK VIEW SIDE VIEW
2" SIGN POST INSTALLATION

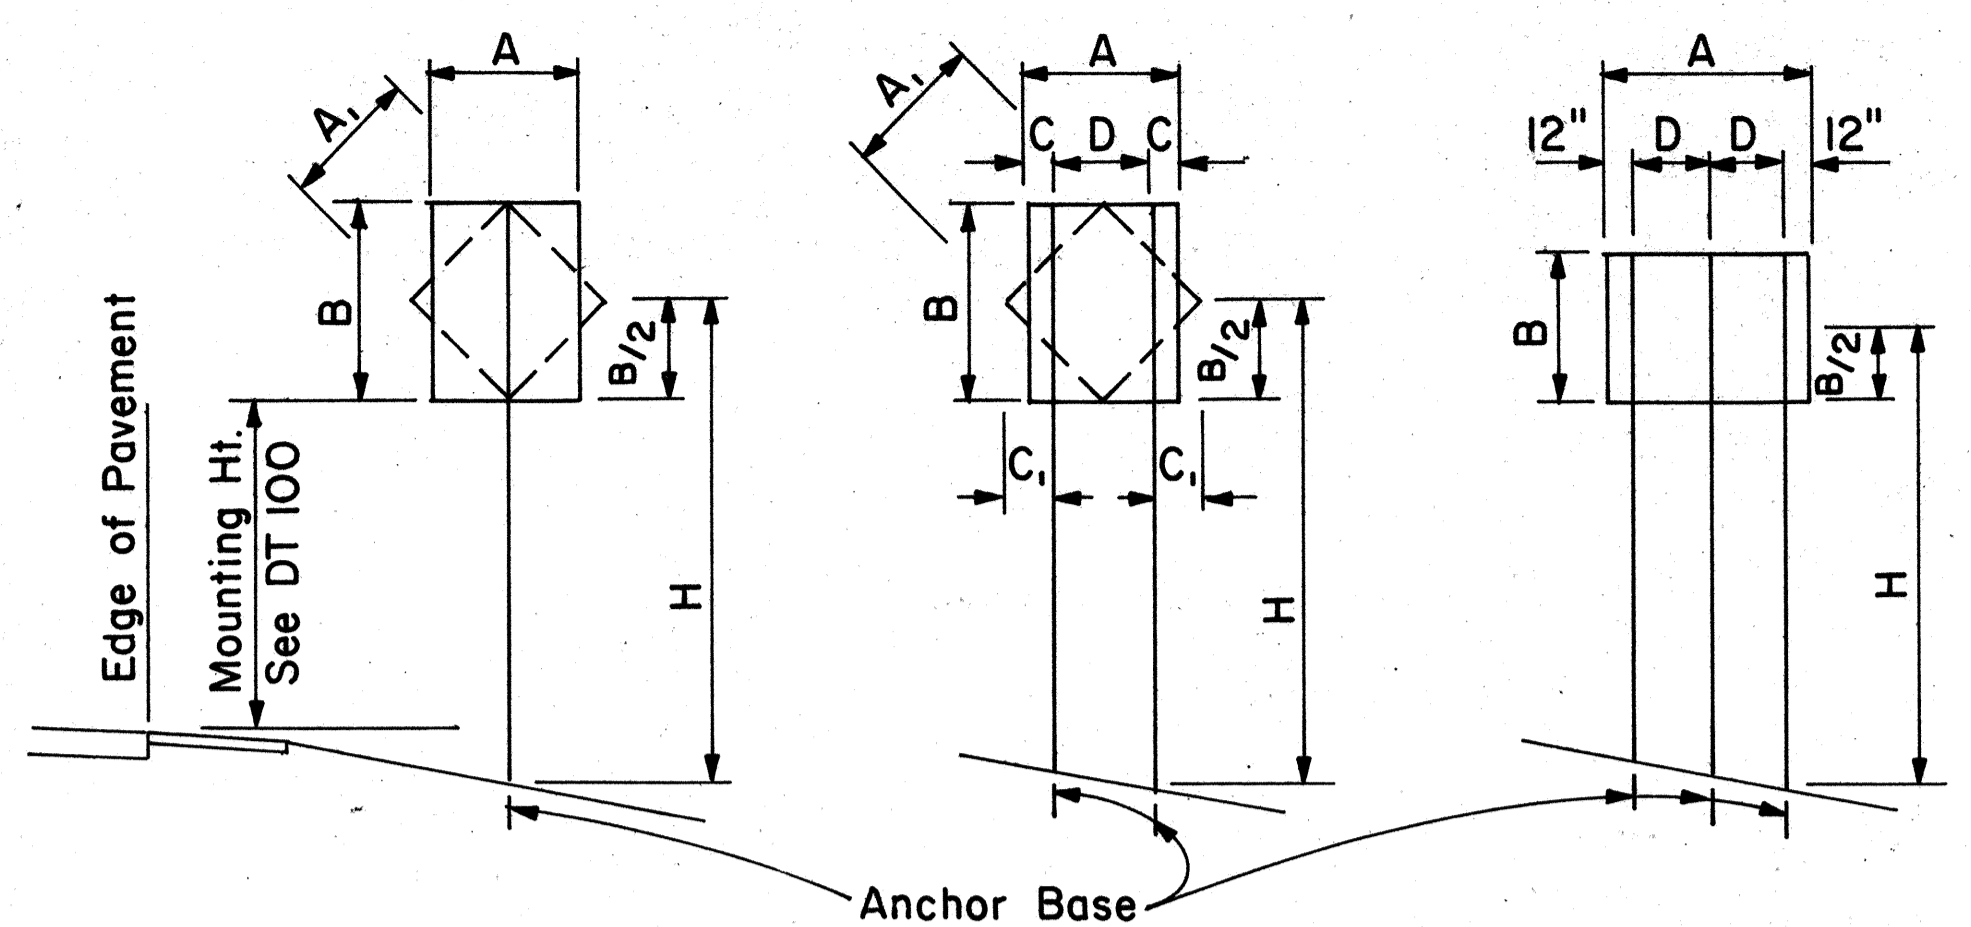

1-POST Sign area 10 sq. ft. and less
2-POST Sign area greater than 10 sq. ft. or A=48"-60"
3-POST A = greater than 60"

TYPICAL INSTALLATION

Not to Scale

A or A ₁	C	C ₁
36"	6"	-
48"	9"	19"
60"	12"	24"

NOTE: Frame stiffeners are required when D is greater than 24". See Gen. Note 2.

SQUARE TUBE: 1-POST INSTALLATION							
Post Size	A x B x H (Factor)	H = Ground Level to Midpoint (ft.)					
		7	8	9	10	11	12
2"	62	8.8	7.7	6.8	6.1	5.6	4.8
2 1/2"	107	-	-	-	-	9.6	8.8

A x B (Area, sq. ft.)


SQUARE TUBE: 2-POST INSTALLATION							
Post Size	A x B x H (Factor)	H = Ground Level to Midpoint (ft.)					
		7	8	9	10	11	12
2"	122	17.4	15.2	13.5	12.2	11.0	10.1
2 1/2"	212	30.2	26.5	23.5	21.1	19.2	17.6
2 1/2", 10 ga.	260	37.0	32.0	28.6	26.0	23.5	21.5

A x B (Area, sq. ft.)

SQUARE TUBE: 3-POST INSTALLATION							
Post Size	A x B x H (Factor)	H = Ground Level to Midpoint (ft.)					
		7	8	9	10	11	12
2"	183	26.0	22.8	20.3	18.2	16.6	15.2
2 1/2"	318	45.4	39.5	35.2	31.5	28.8	26.5
2 1/2", 10 ga.	388	55.0	48.5	43.0	38.5	35.0	32.0

A x B (Area, sq. ft.)

WINDLOAD CHARTS

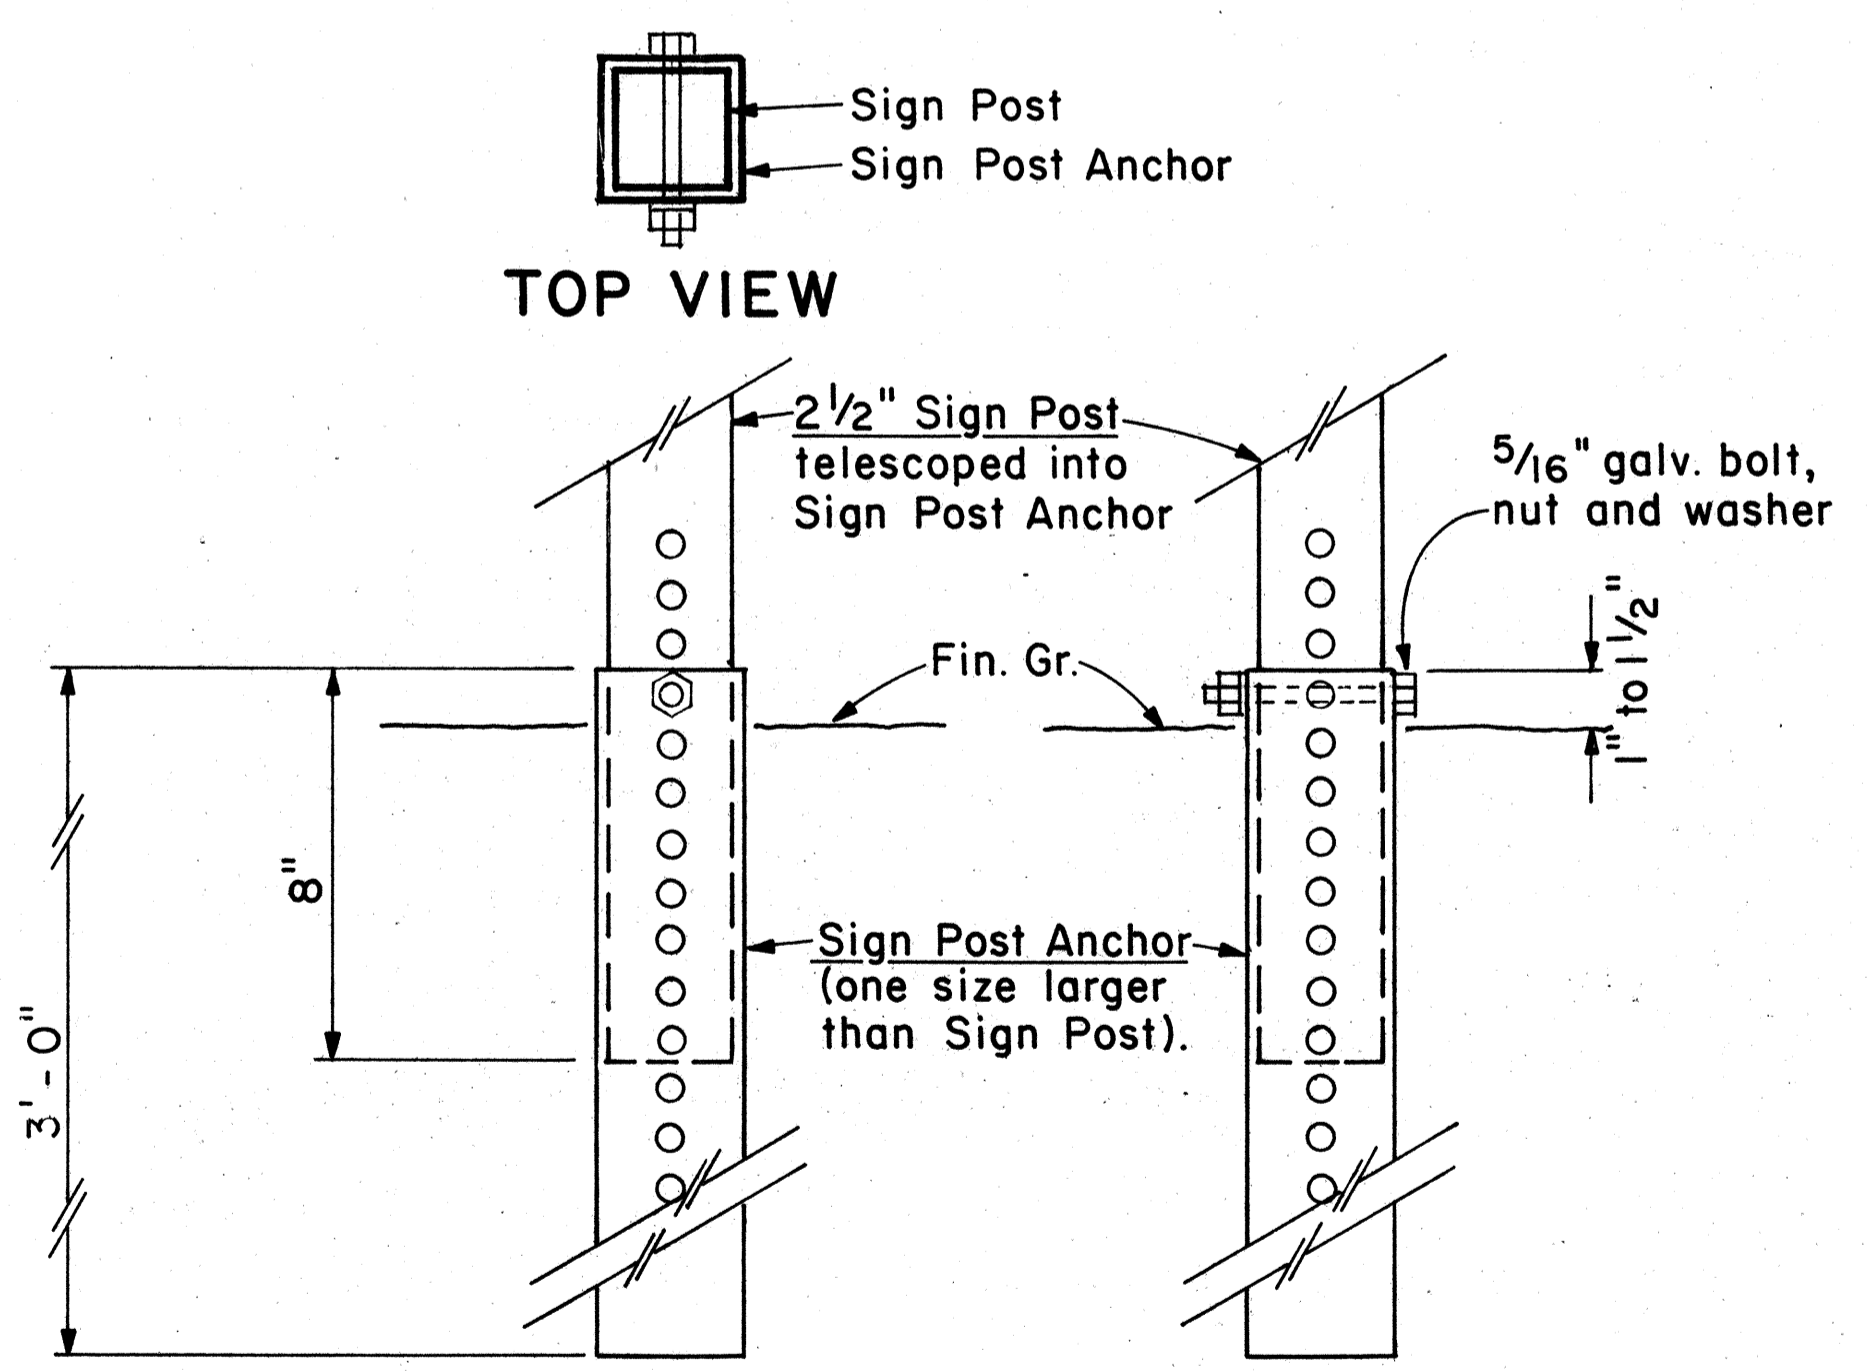

BACK VIEW SIDE VIEW
2 1/2" SIGN POST INSTALLATION
ANCHOR BASE DETAIL

Scale: 3" = 1'-0"

APPROVAL RECOMMENDED:
Eishi Tanaka 9/21/82
TRAFFIC ENGINEER DATE

APPROVED:
Albert Salasiki 9/22/82
ASSISTANT CHIEF, ENGINEERING DATE

NO.	REVISION	APPROVED BY	DATE

STATE OF HAWAII
DEPARTMENT OF TRANSPORTATION
HIGHWAYS DIVISION

STANDARD DETAILS
GALVANIZED SQUARE TUBE
SIGN POST MOUNTING


Scale: As Shown Date: Sep: 1982

DATE: _____
SURVEY PLOTTED BY: _____
DRAWN BY: _____
DESIGNED BY: _____
QUANTITIES BY: _____
CHECKED BY: _____
ORIGINAL PLAN NO.: _____


FED. ROAD DIST. NO.	STATE	FED. AID PROJ. NO.	FISCAL YEAR	SHEET NO.	TOTAL SHEETS
HAWAII	HAW.	IR-HI-1(198)	1986	47	62

GENERAL NOTES:


1. Clearance markers (RM-3, RM-4) shall be installed with the edge of the marker in line with the inner edge of the obstruction.
2. (R) or (L) indicates right or left and shall be as shown on the plans.
3. Reflector markers RM-1 and RM-2 shall be:
 - a) Yellow if placed along the left edge of divided roadways, one-way roadways, and ramps in the direction of travel.
 - b) White if placed along the right edge of divided roadways, one-way roadways, and ramps in the direction of travel.
4. For RM-4, the stripes shall slope downward at an angle of 45° toward the side of the obstruction that traffic is to pass.
5. For reflector marker RM-9, reflective sheeting material may be used as an alternate.
6. (H) indicates horizontal mounting of reflector marker.
7. Height = 4'-0" min. for RM-1, RM-2 and RM-3.
Height = 5'-6" min. for RM-4 and RM-9.
8. Final locations of reflector markers shall be approved by the Engineer.

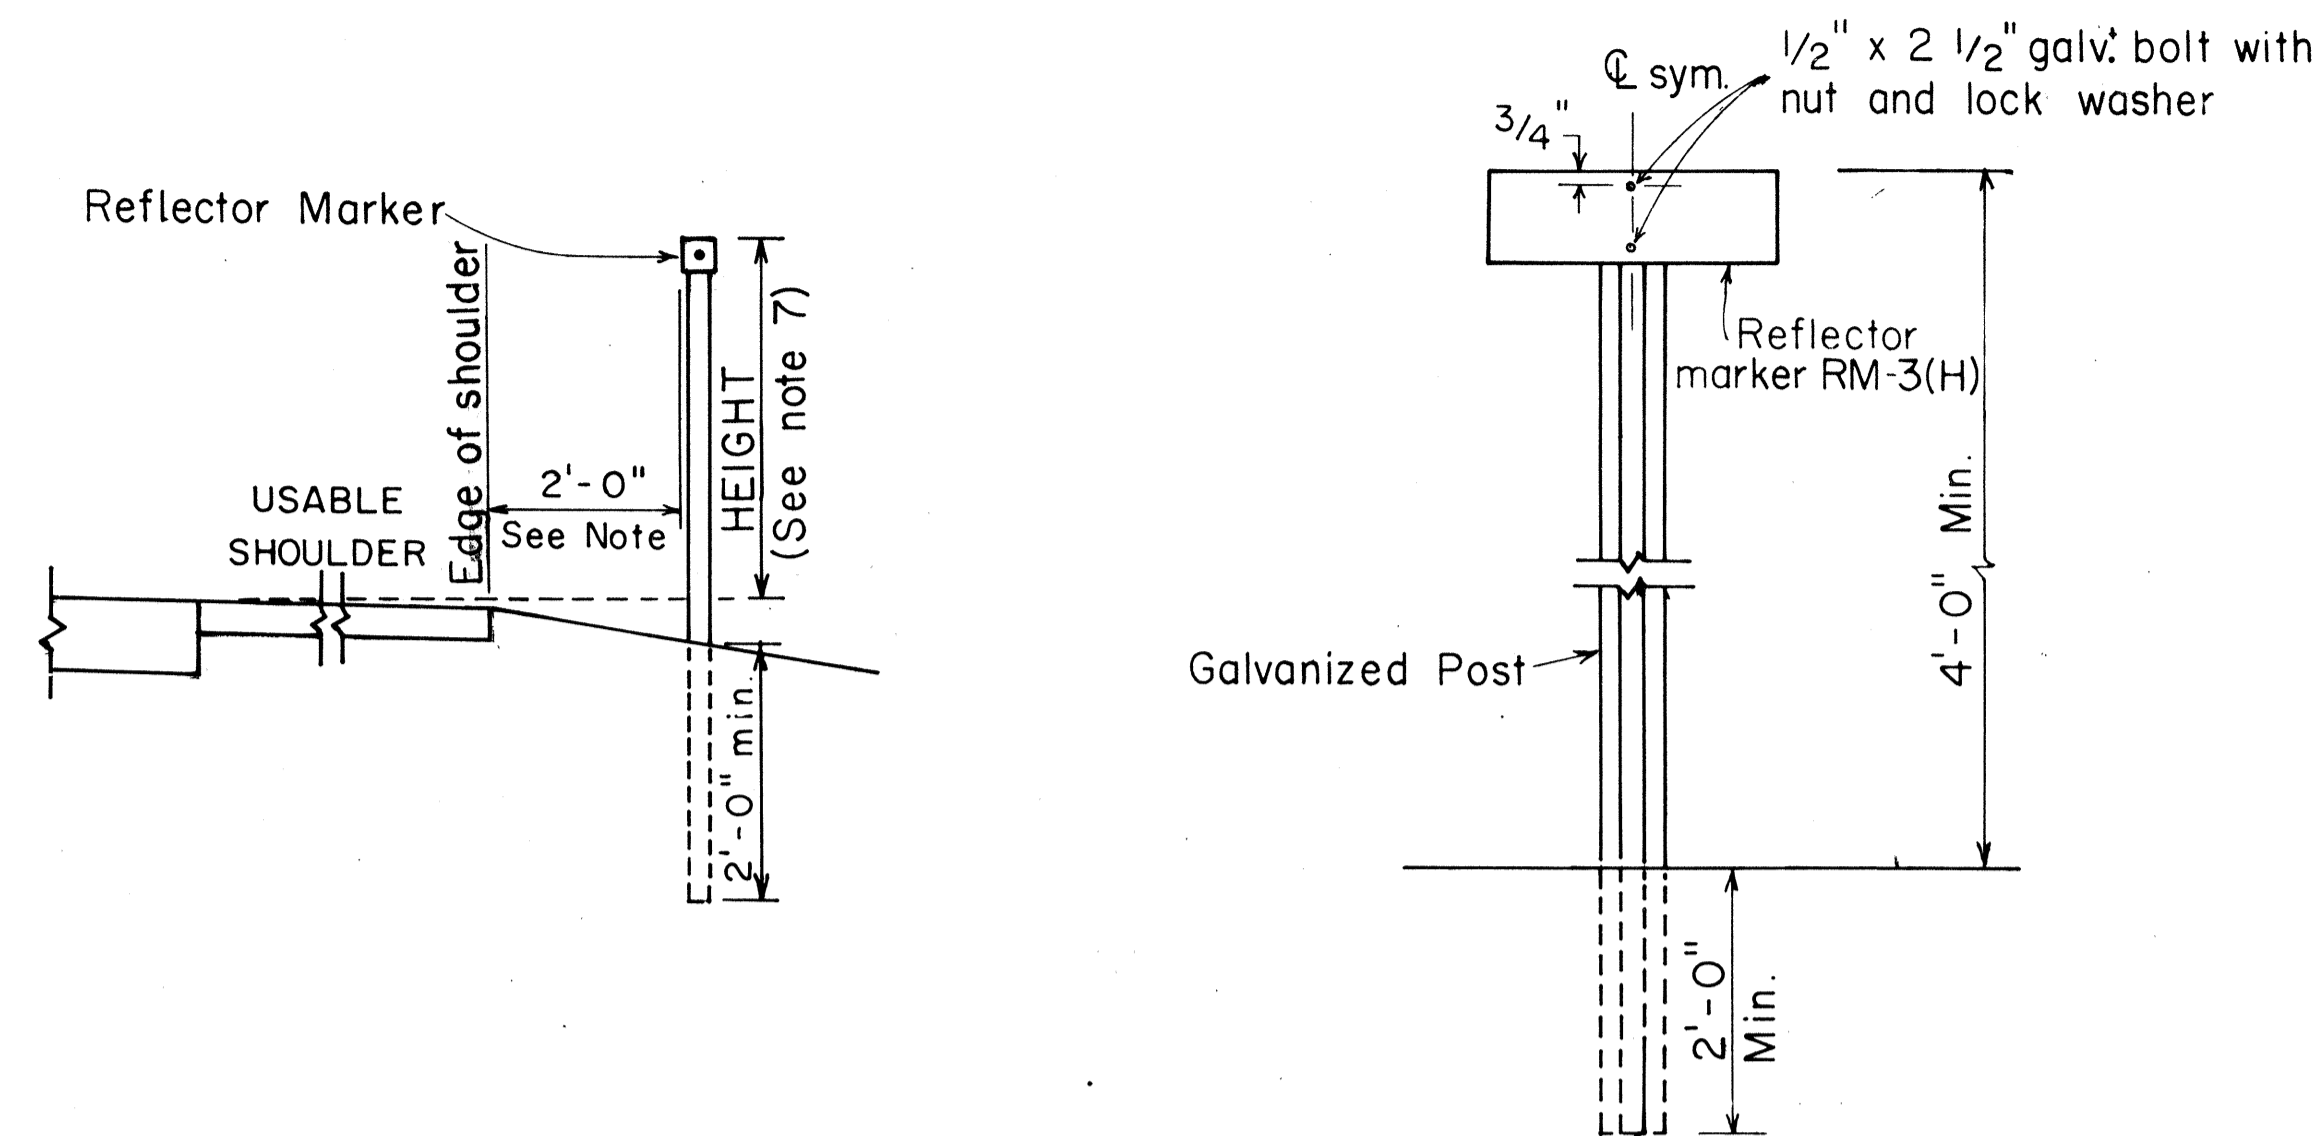

REFLECTOR MARKER MOUNTING DETAIL

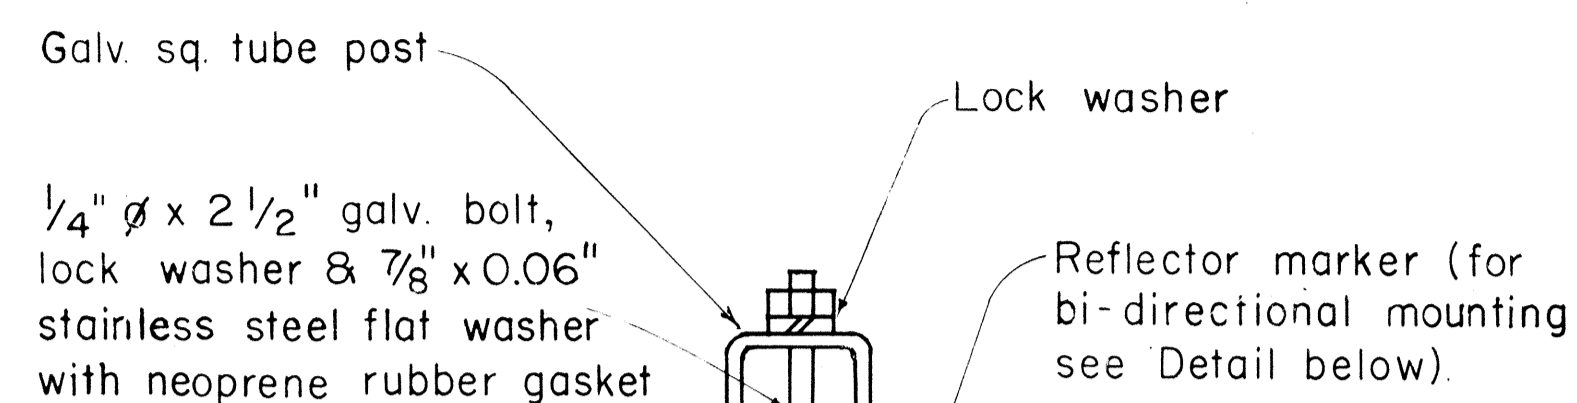


GALVANIZED SQUARE TUBE POST

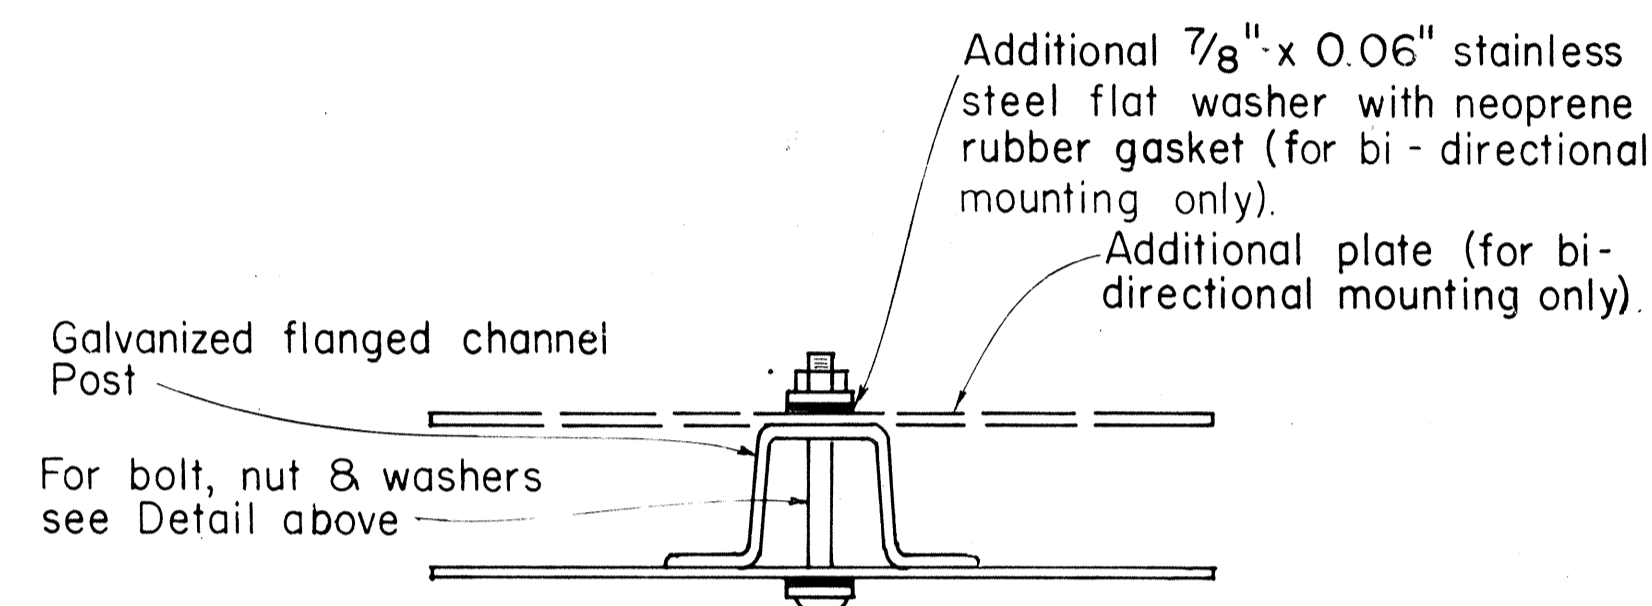

GALVANIZED FLANGED CHANNEL POST

TYPICAL MOUNTING DETAILS

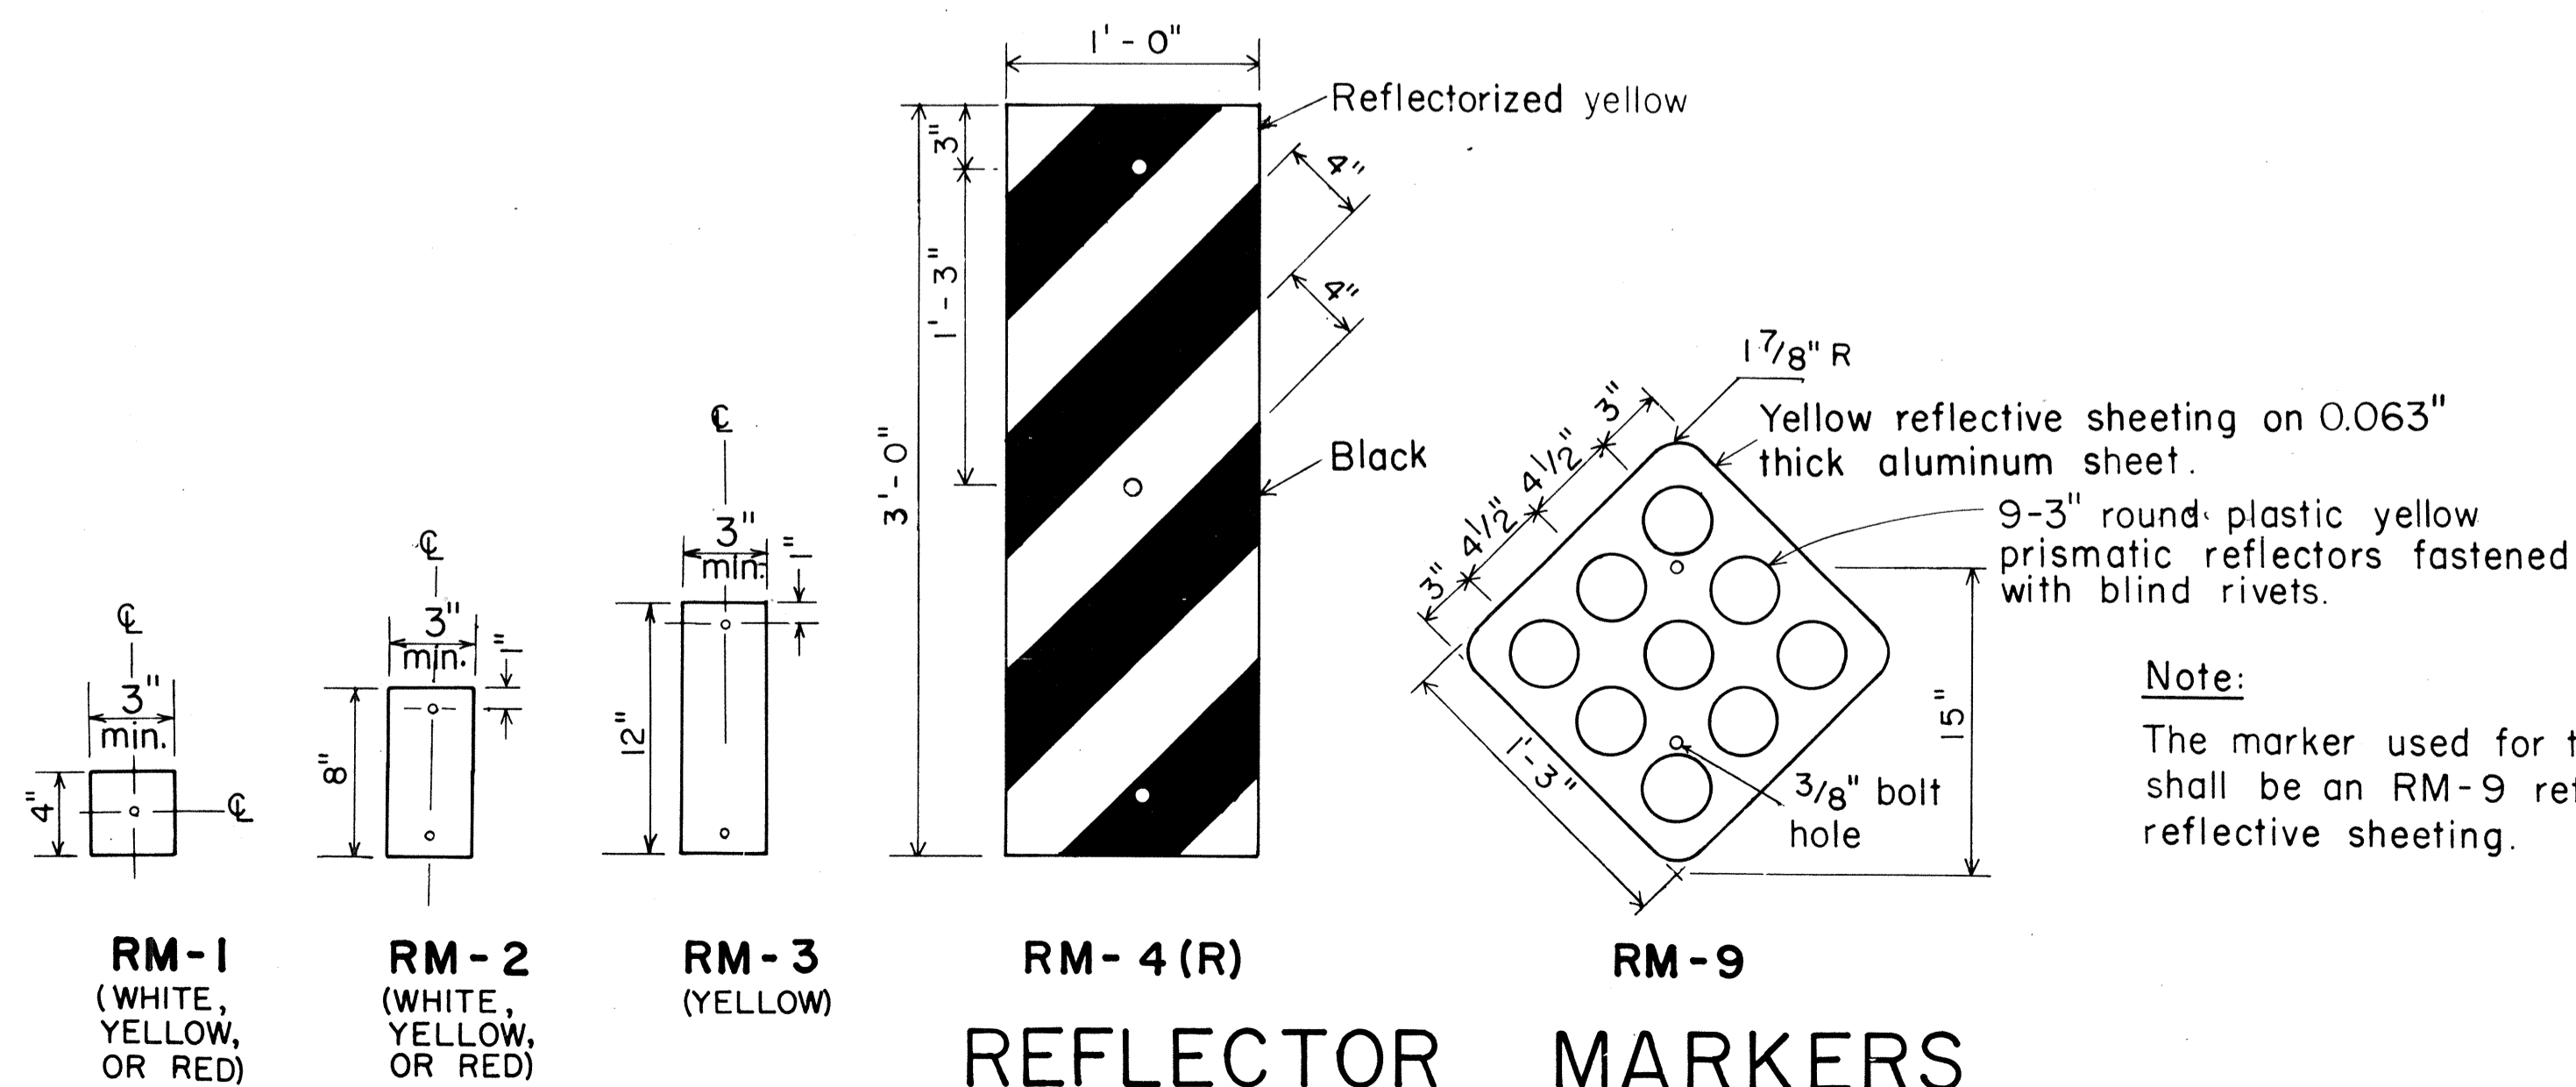

REFLECTOR MARKERS

APPROVAL RECOMMENDED:
Euchi Tanaka 11/2/77
 TRAFFIC ENGINEER DATE

APPROVED:
Robert S. Sakemoto 11/2/77
 ASSISTANT CHIEF, ENGINEERING DATE

NO.	REVISION	APPROVED BY	DATE
1	Revised Mounting Details	H.H.	4/23/80
2	Revised General Notes, Mounting Details and Reflector Markers.	P.J.O.	2-28-83
3	Eliminated White for RM-4	P.J.O.	1-30-85



STATE OF HAWAII
 DEPARTMENT OF TRANSPORTATION
 HIGHWAYS DIVISION

STANDARD DETAILS
 MISCELLANEOUS REFLECTOR MARKERS


Not to scale June, 1977

DATE: _____
 SURVEY PLOTTED BY: _____
 DRAWN BY: _____
 DESIGNED BY: _____
 QUANTITIES BY: _____
 CHECKED BY: _____
 ORIGINAL PLAN: _____
 NOTE BOOK: _____
 No. _____


FED. ROAD DIST. NO.	STATE	FED. AID PROJ. NO.	FISCAL YEAR	SHEET NO.	TOTAL SHEETS
HAWAII	HAW.	IRH-1(193)	1986	48	62

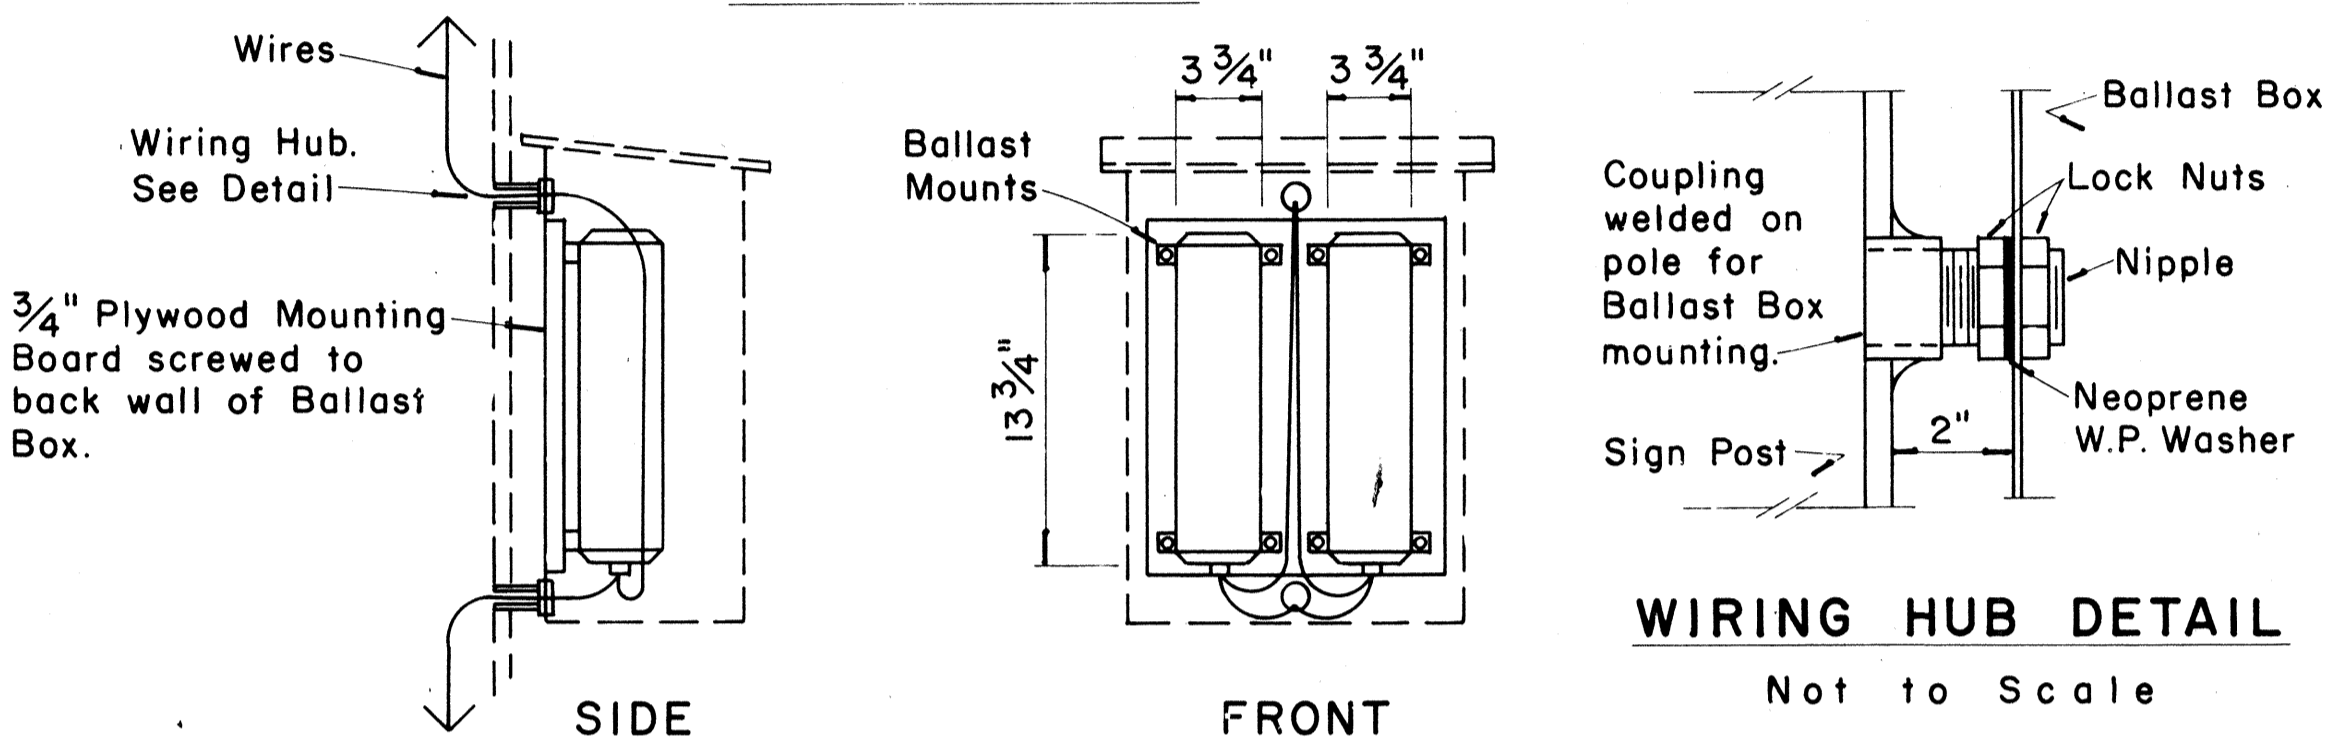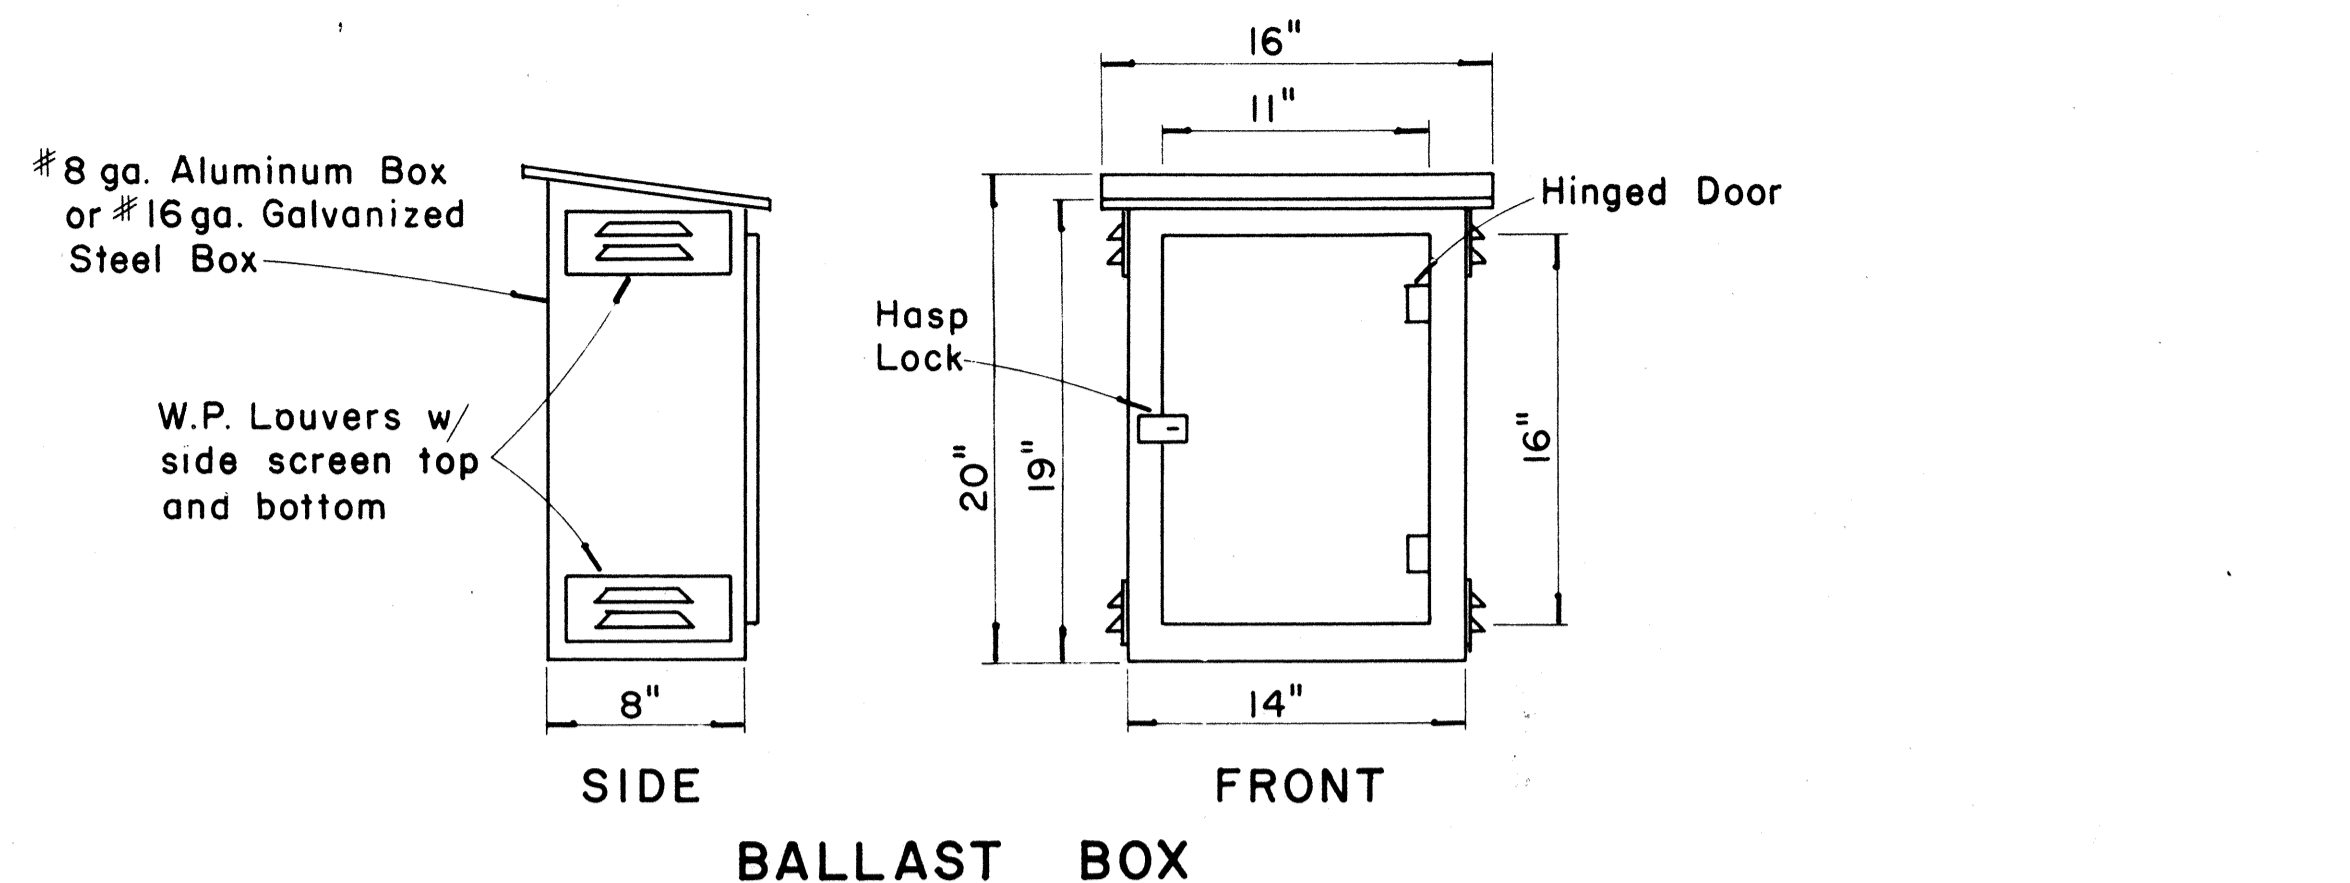


WEATHERPROOF BALLAST BOX
Scale: 1 1/2" = 1'-0"

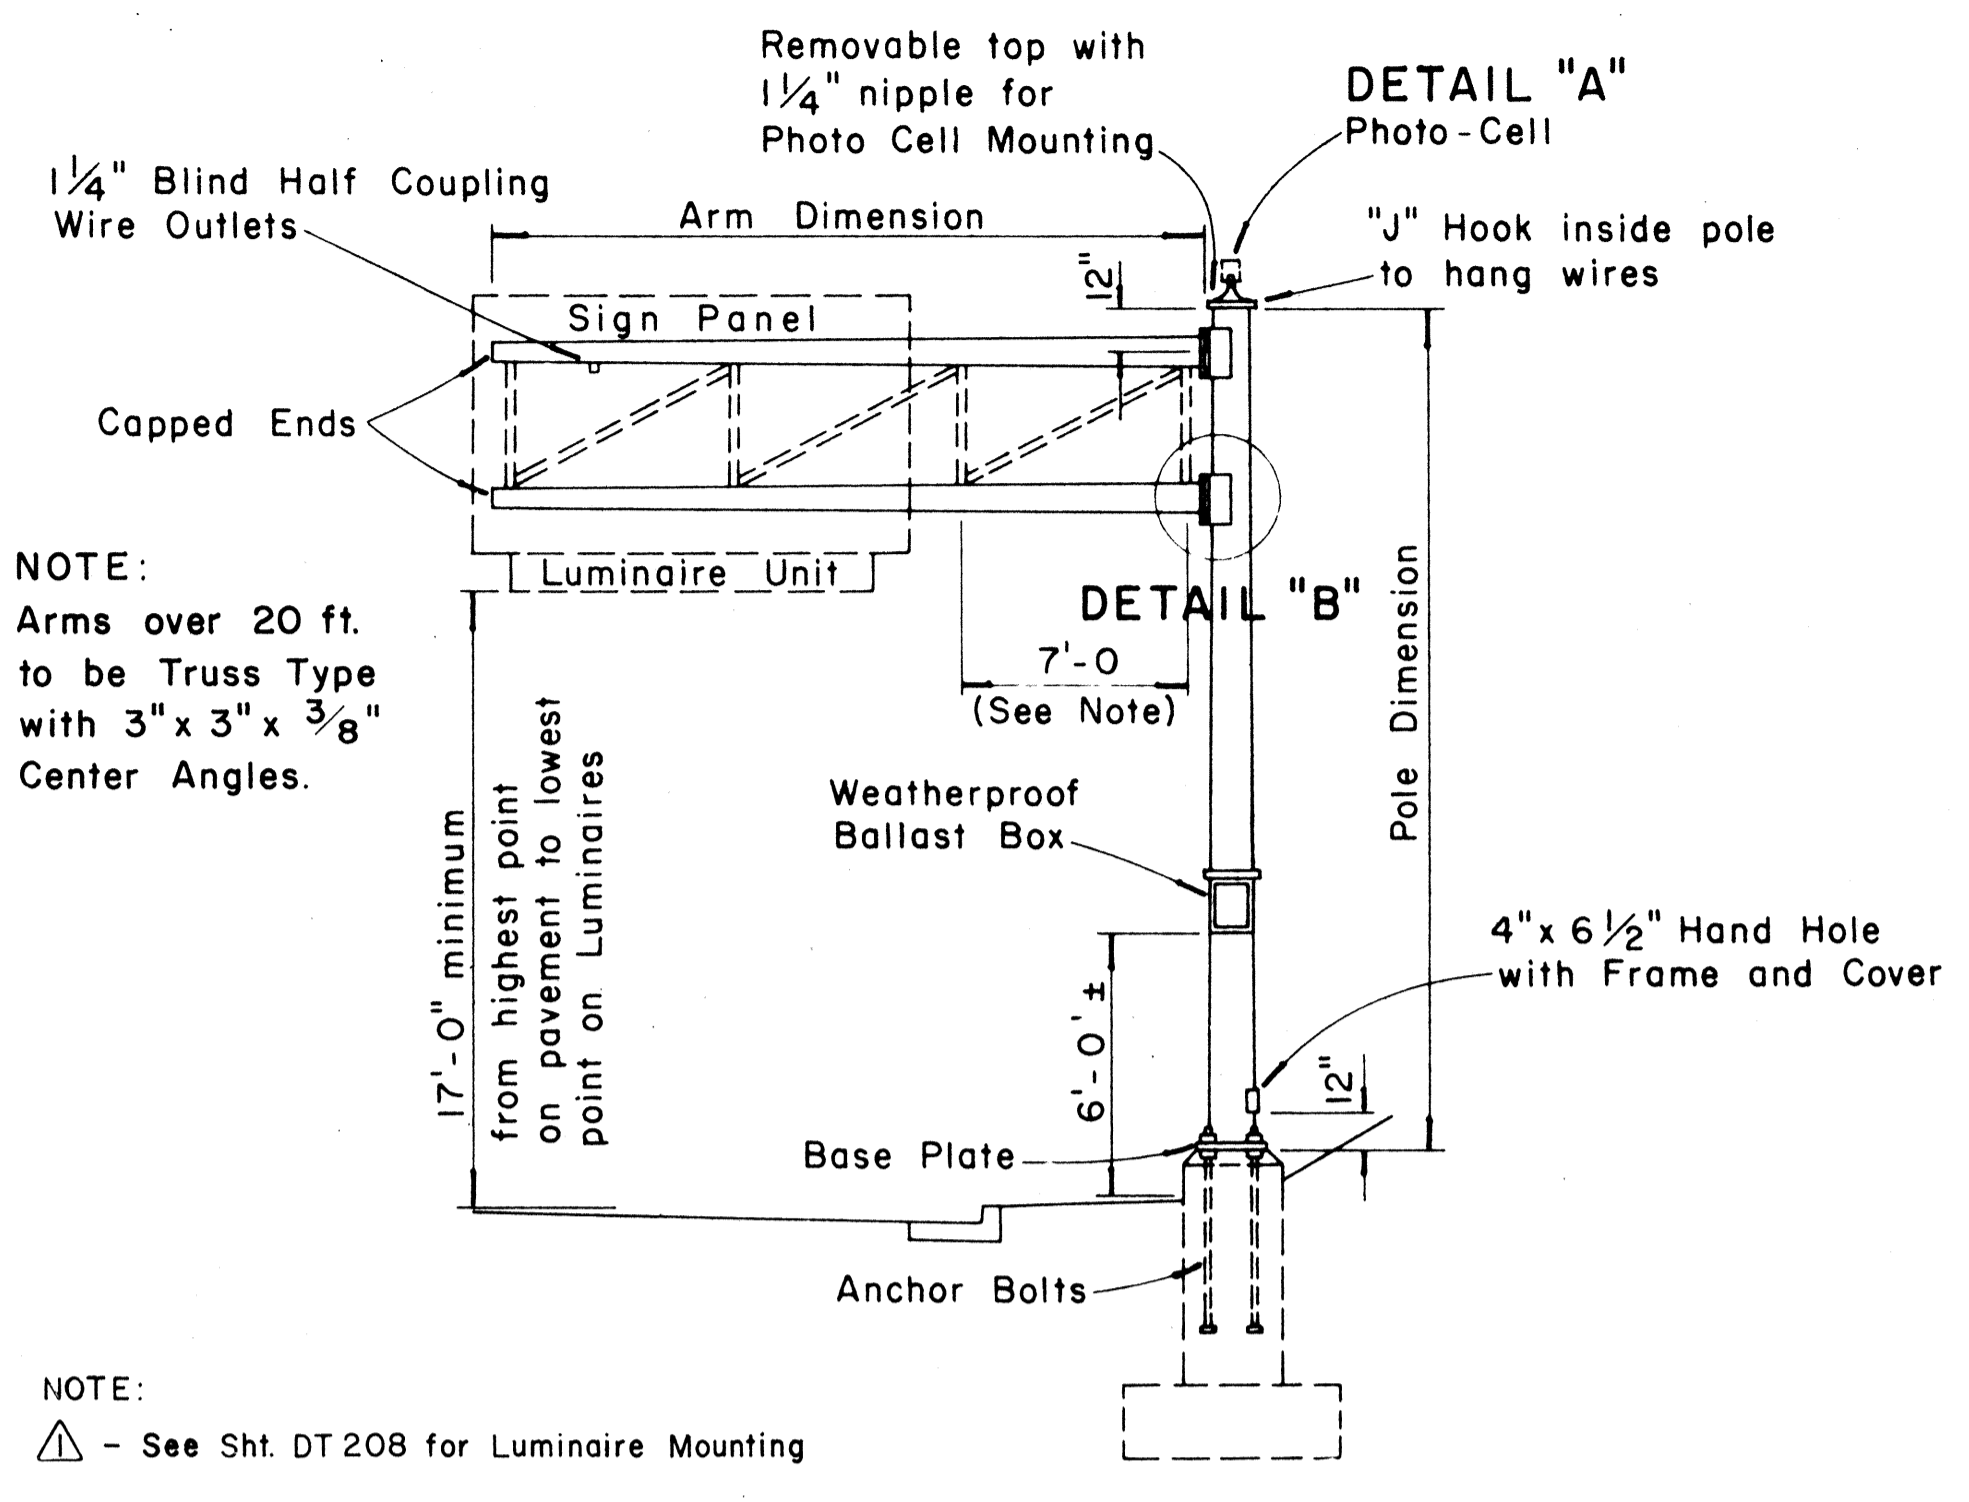





TYPE "C"
SINGLE SIGN POST — CANTILEVER TYPE
DOUBLE MAST ARM
Scale: 3/16" = 1'-0"

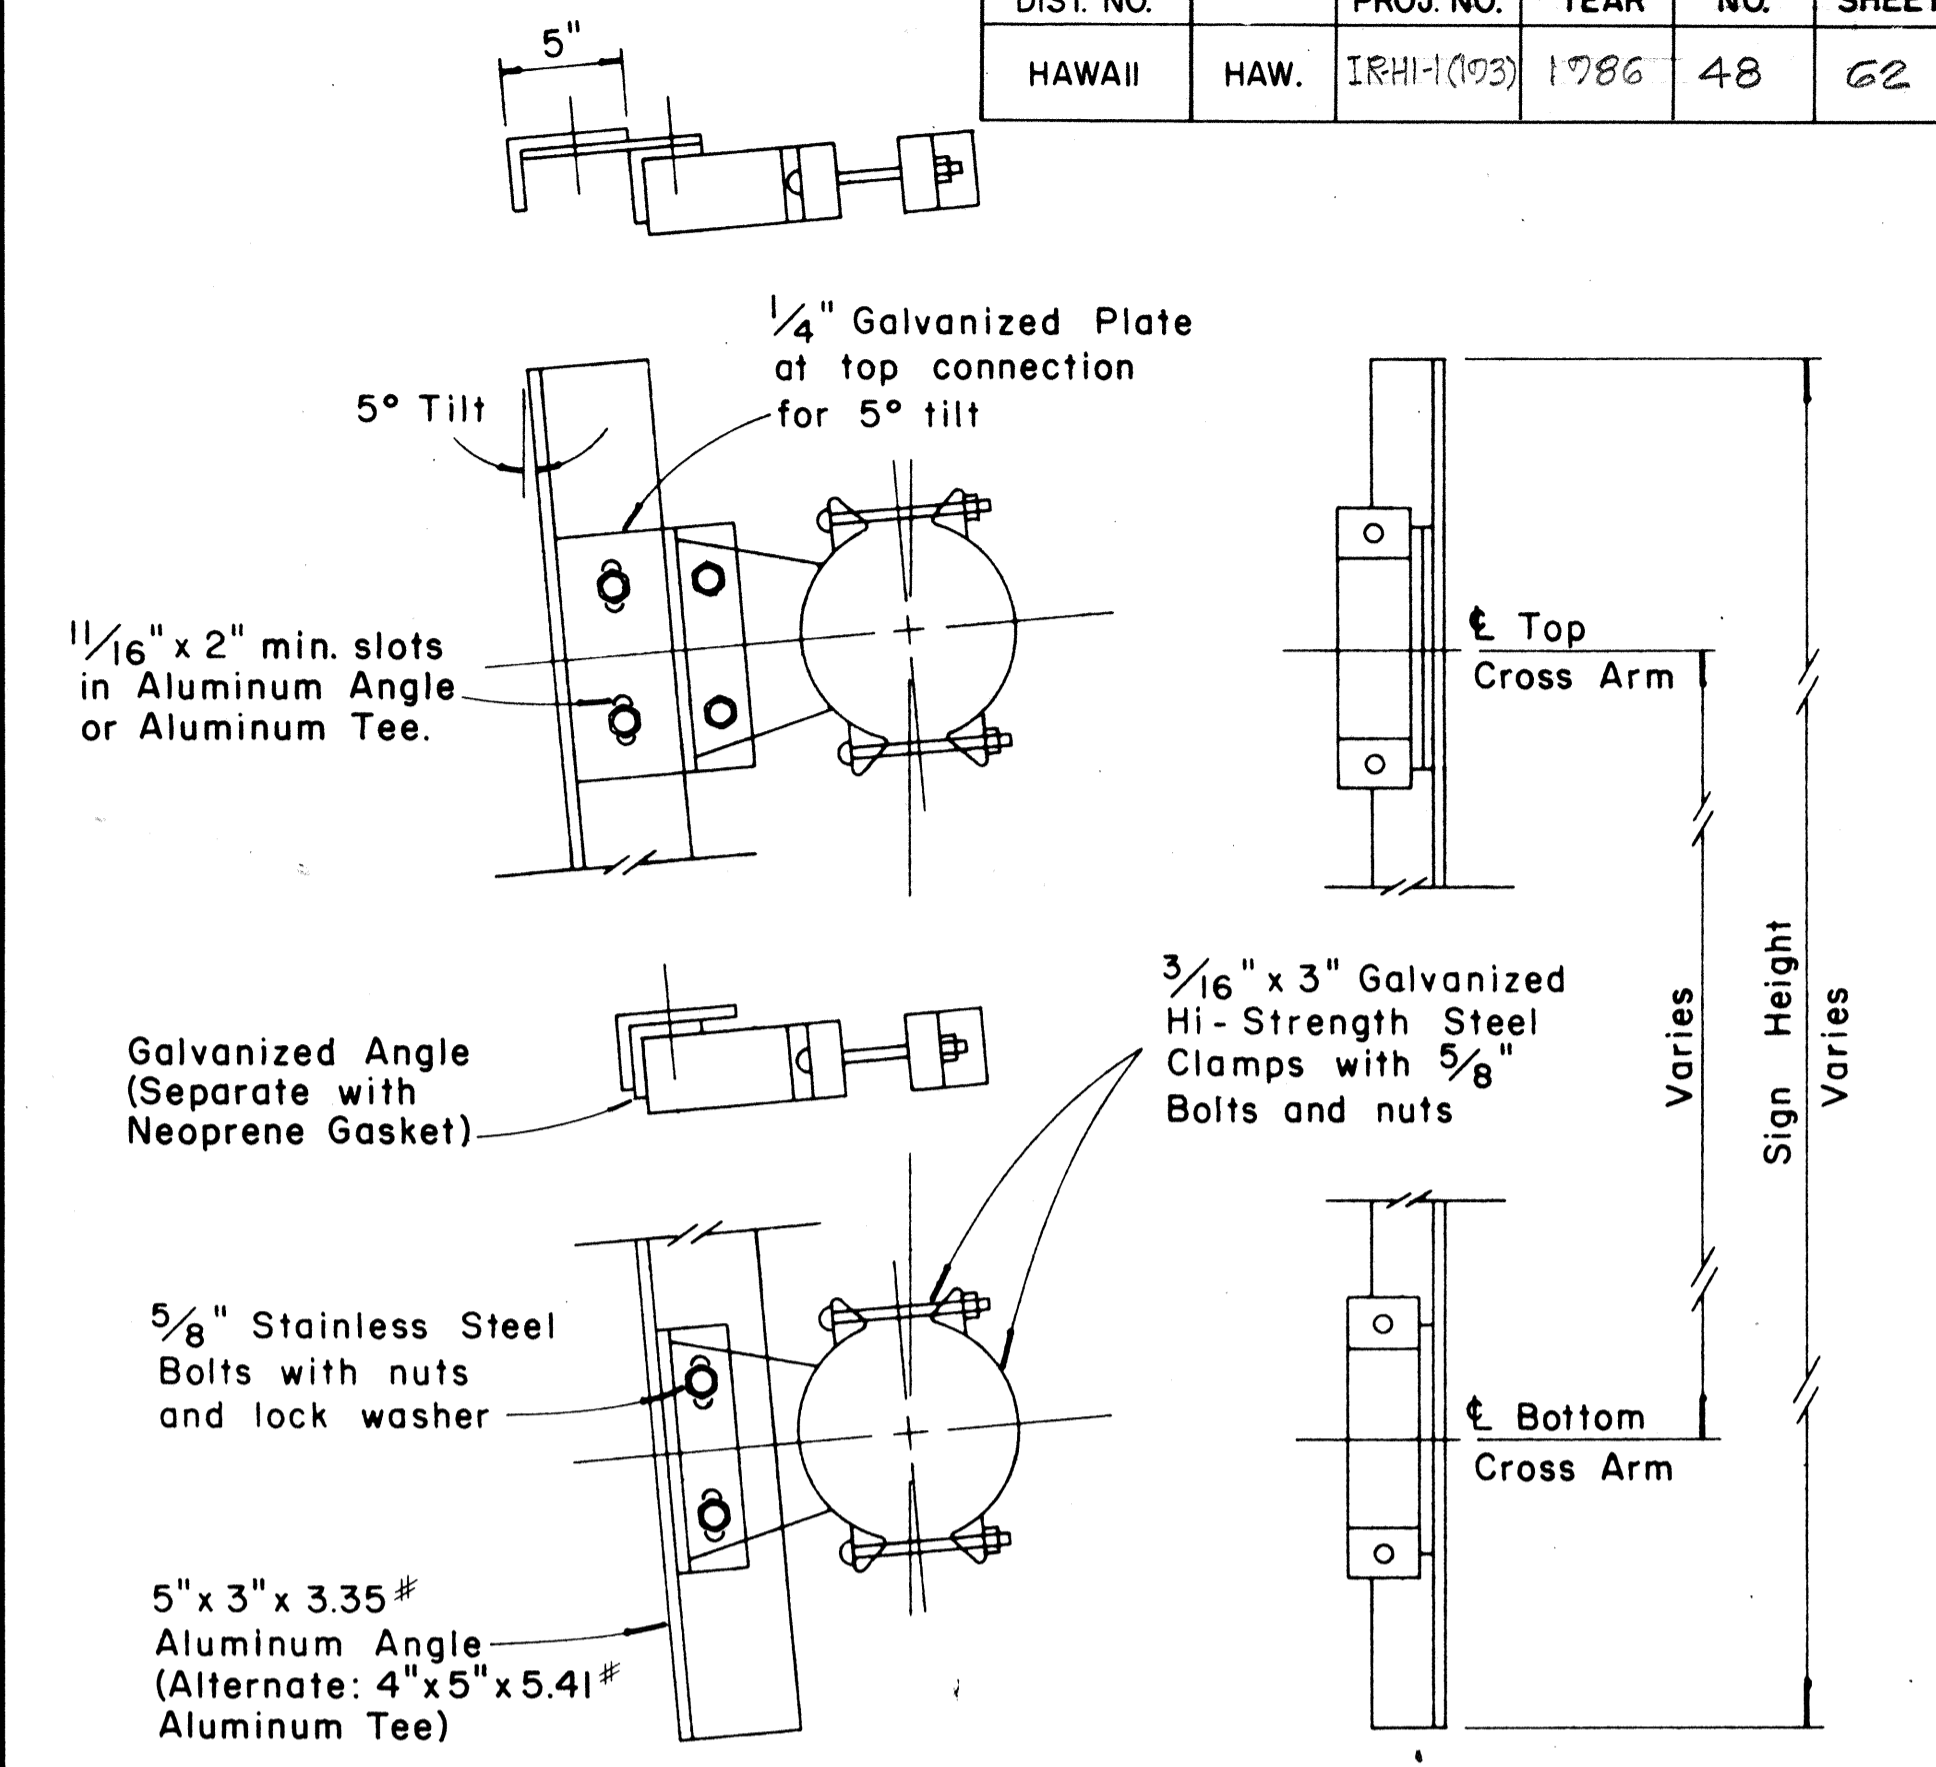

SIGN BRACKET ASSEMBLY
Scale: 1 1/2" = 1'-0"

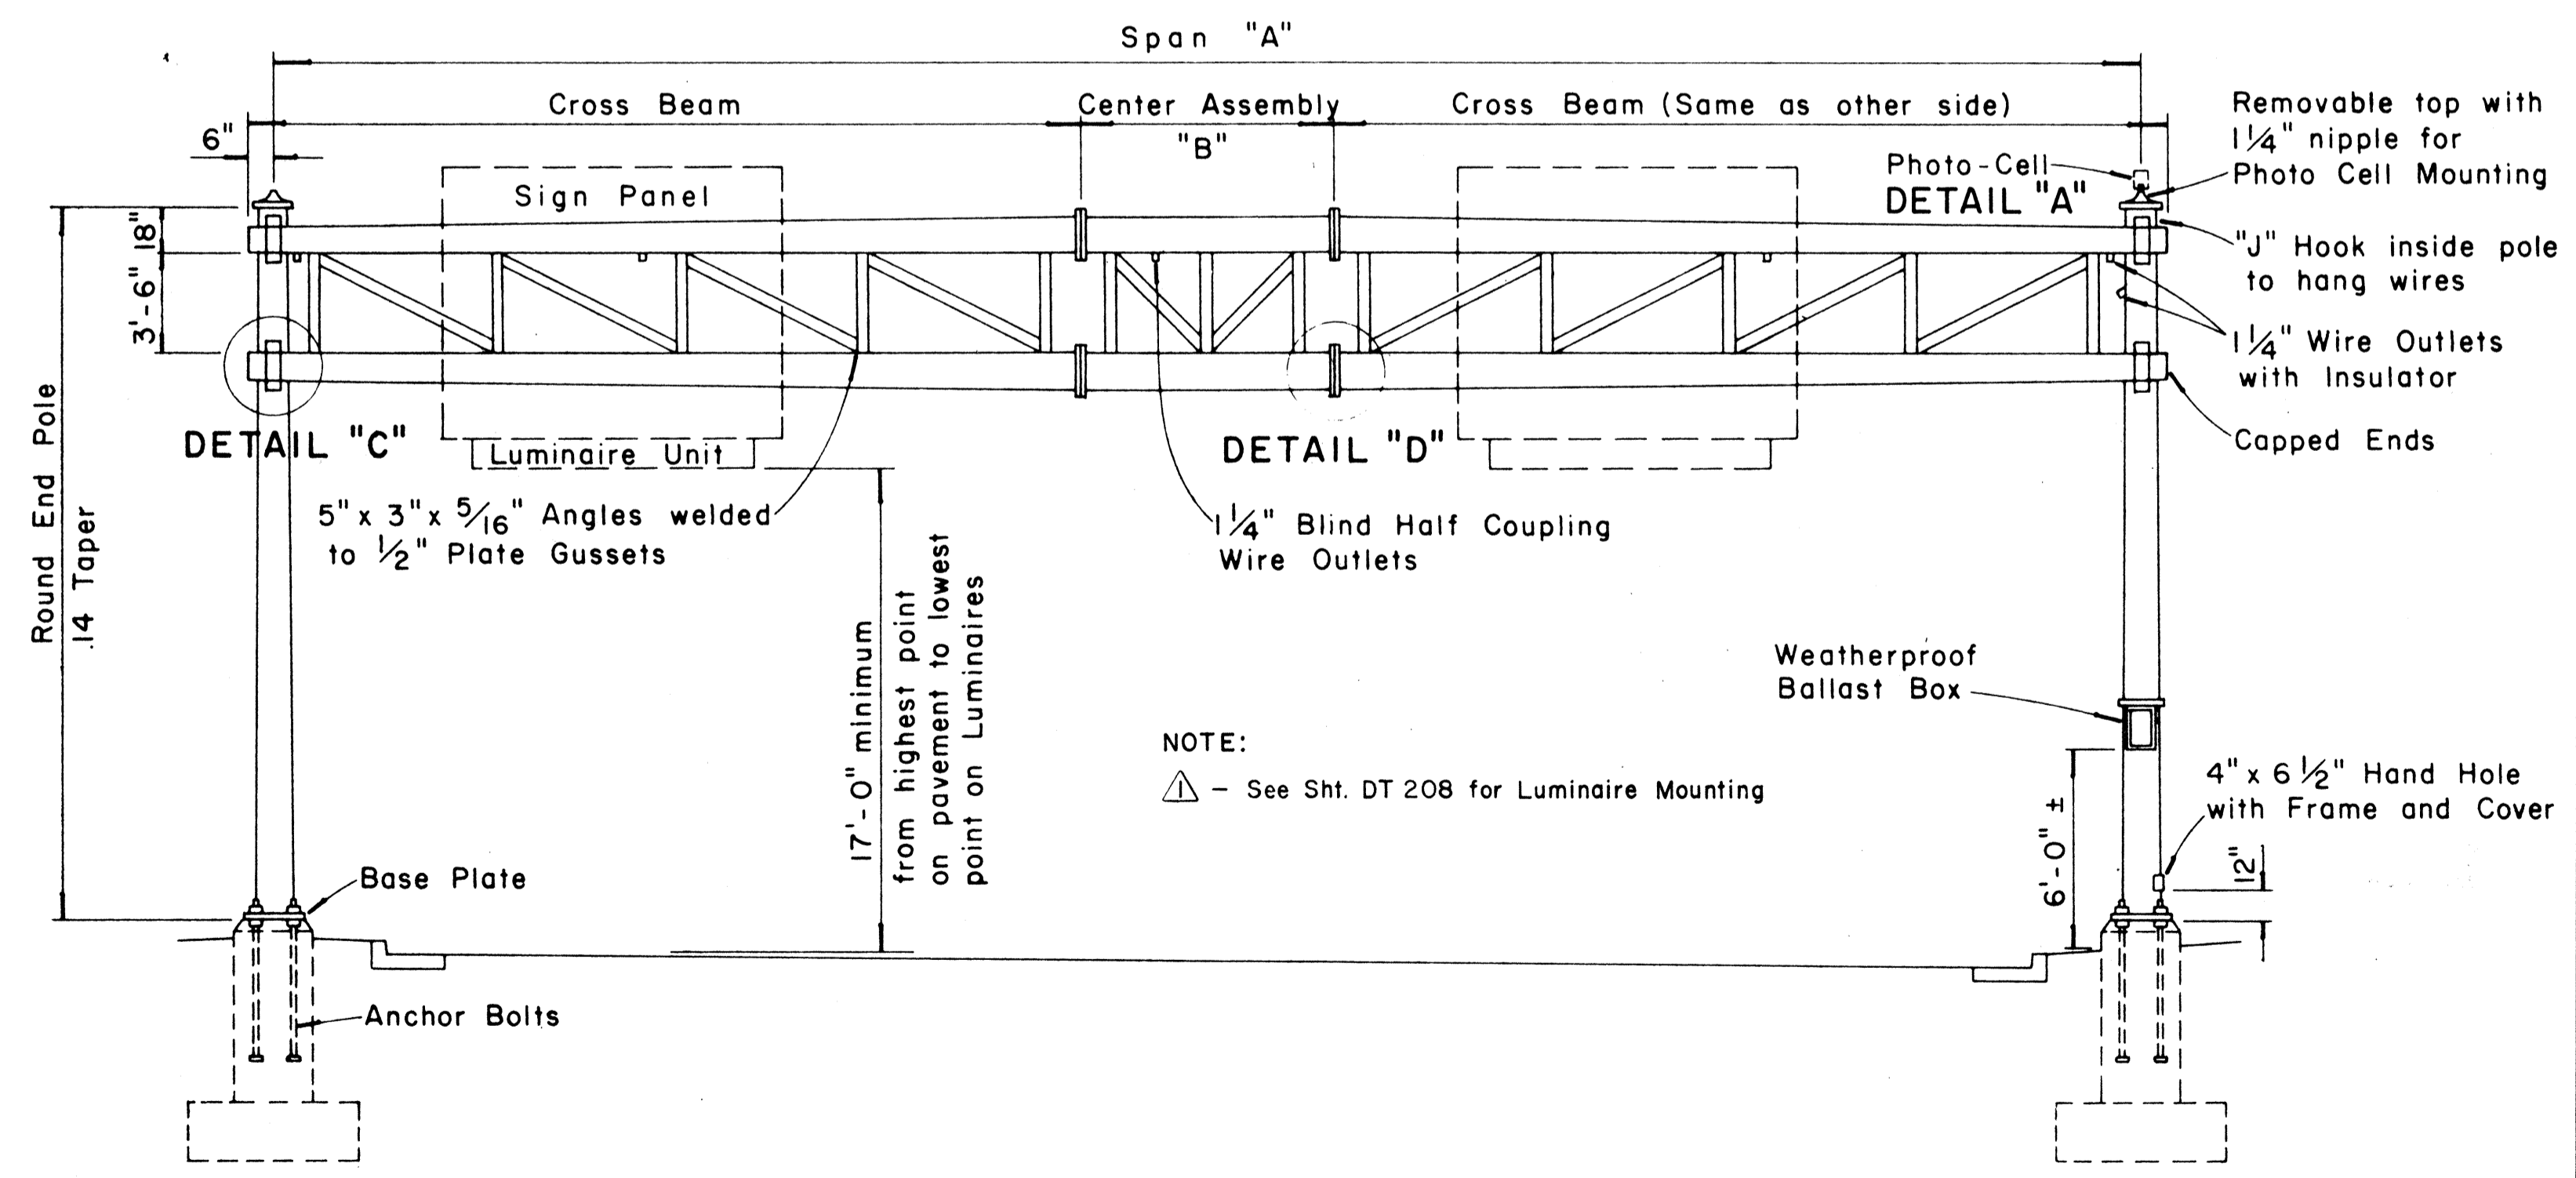

TYPE "D"
TWO-TUBE TRUSS — SPAN TYPE
Scale: 3/16" = 1'-0"

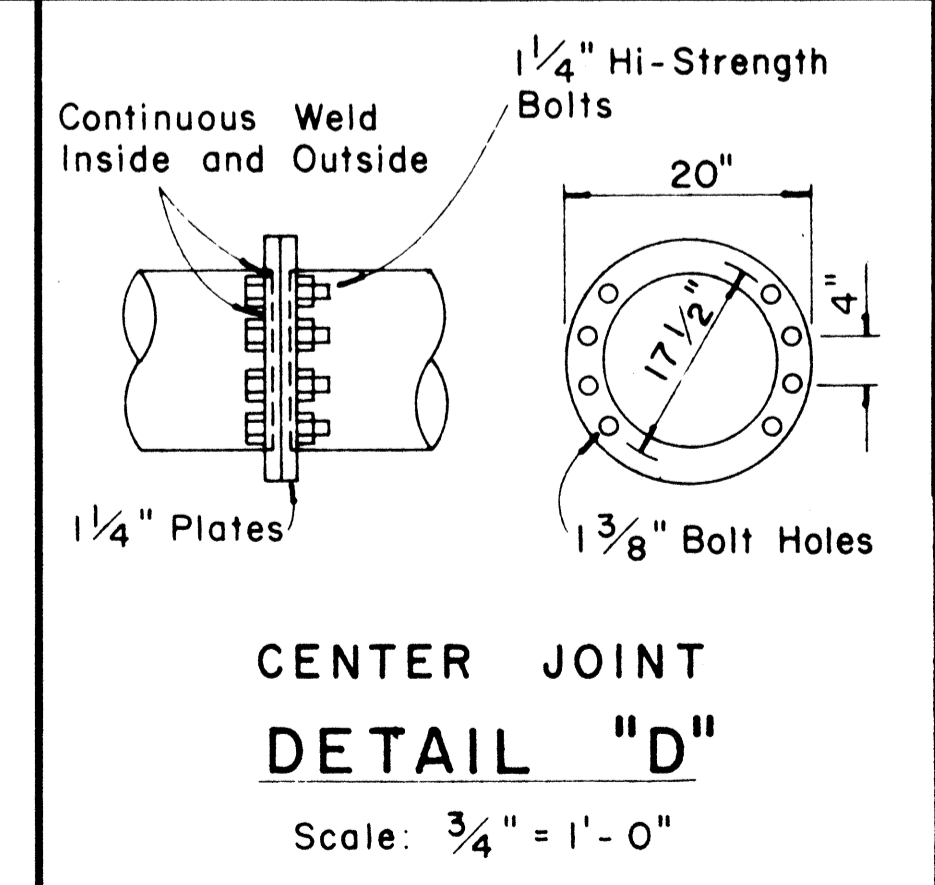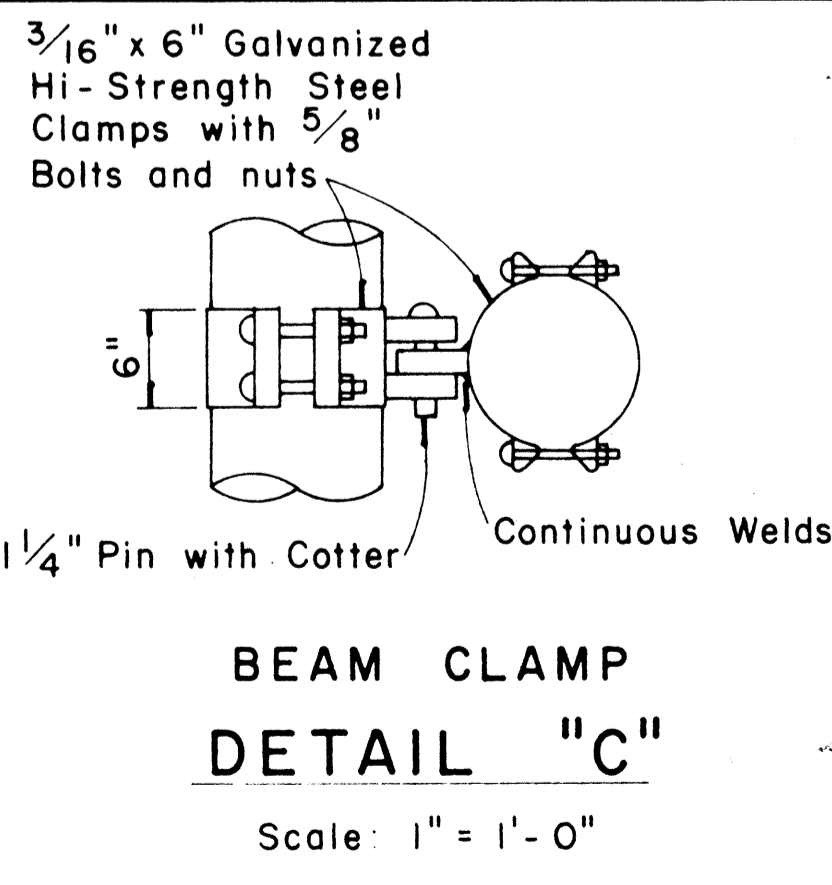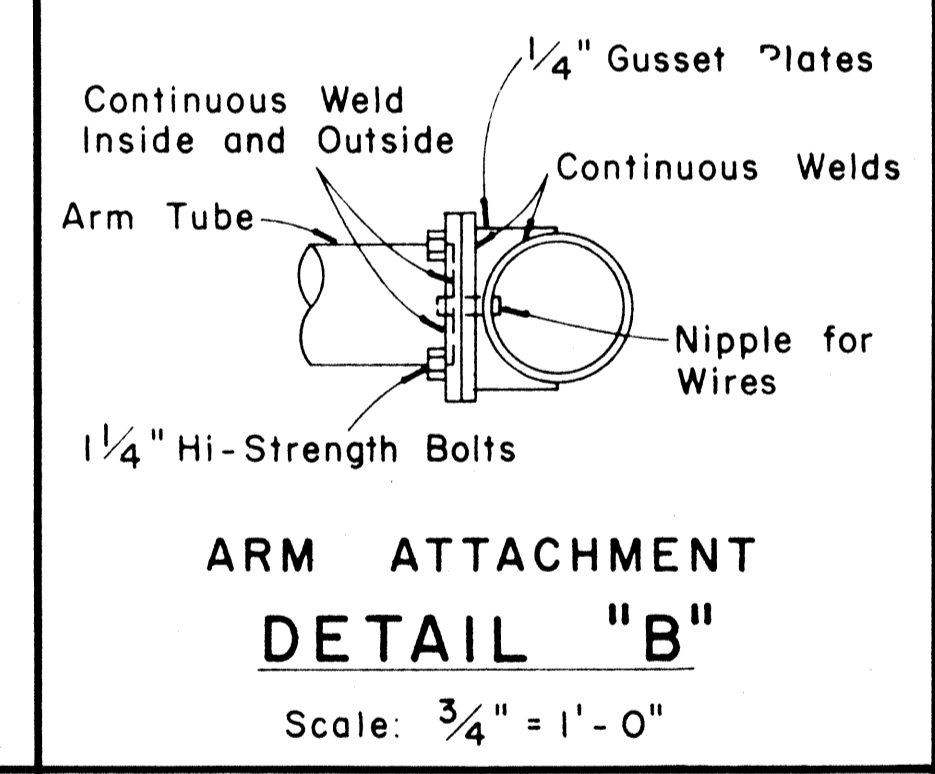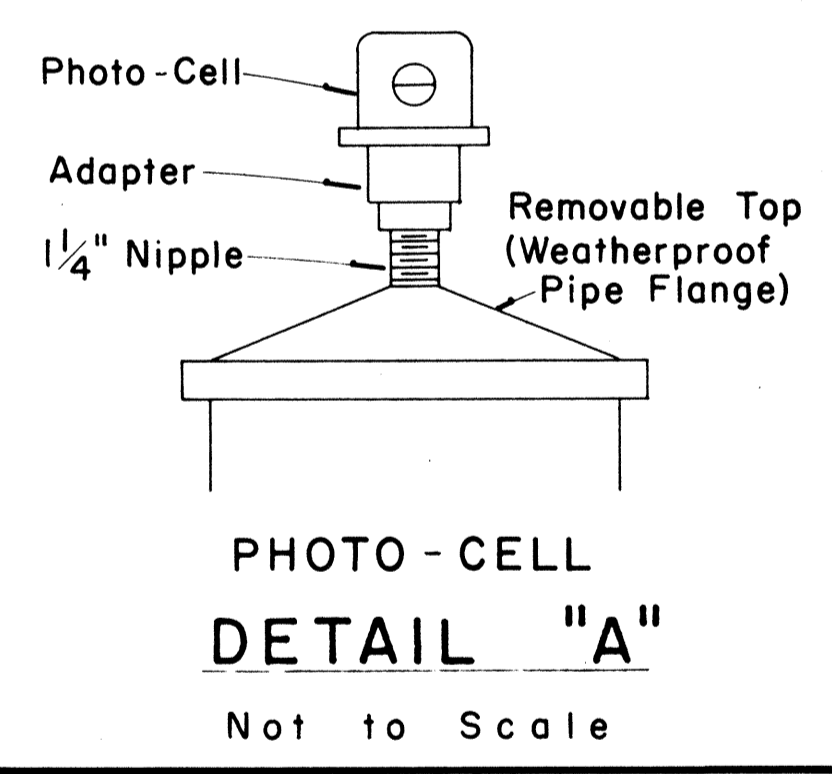

APPROVAL RECOMMENDED:
Erich Tanaka 12/29/69
TRAFFIC ENGINEER DATE

APPROVED:
John S. Saito 12-30-69
ASSISTANT CHIEF, ENGINEERING DATE

NO.	REVISION	APPROVED BY	DATE
△	Added Note	HT	10/2/69

STATE OF HAWAII
DEPARTMENT OF TRANSPORTATION
HIGHWAYS DIVISION

STANDARD DETAILS
OVERHEAD SIGN SUPPORTS

Scale: As Shown
SHEET No. 111 OF 19 SHEETS DT 200

DATE
SURVEY PLOTTED BY
DESIGNED BY
NOTE BOOK
QUANTITIES BY
CHECKED BY

FED. ROAD DIST. NO.	STATE	FED. AID PROJ. NO.	FISCAL YEAR	SHEET NO.	TOTAL SHEETS
HAWAII	HAW.	1KHH-1003	1986	49	62

(OVERHEAD SIGNS)
SUPPORT SPACING TABLE


PANEL THICK.	LENGTH OF SIGN		NO. OF SUPPORTS	OVERHANG B	SUPPORT SPACING C or C ₁
	A	C			
1"	6'-0"	6'-0"	2	12"	48"
1"	6'-6"	6'-6"	2	15"	48"
1"	7'-0"	7'-0"	2	15"	54"
1"	7'-6"	7'-6"	2	18"	54"
1"	8'-0"	8'-0"	2	18"	60"
1"	8'-6"	8'-6"	2	20"	62"
1"	9'-0"	9'-0"	2	22"	64"
1"	9'-6"	9'-6"	2	23"	68"
1"	10'-0"	10'-0"	2	24"	72"
1"	10'-6"	10'-6"	2	24"	78"
1"	11'-0"	11'-0"	2	24"	84"
1"	11'-6"	11'-6"	2	27"	84"
1"	12'-0"	12'-0"	2	30"	84"
1"	12'-6"	12'-6"	2	30"	90"
1"	13'-0"	13'-0"	2	30"	96"
1"	13'-6"	13'-6"	2	30"	102"
1"	14'-0"	14'-0"	2	30"	108"
1"	14'-6"	14'-6"	2	36"	102"
1"	15'-0"	15'-0"	2	36"	108"
1"	15'-6"	15'-6"	3	24"	69"
1"	16'-0"	16'-0"	3	24"	72"
1"	16'-6"	16'-6"	3	24"	75"
1"	17'-0"	17'-0"	3	24"	78"
1"	17'-6"	17'-6"	3	24"	81"
1"	18'-0"	18'-0"	3	24"	84"
1"	18'-6"	18'-6"	3	27"	84"
1"	19'-0"	19'-0"	3	27"	87"
1"	19'-6"	19'-6"	3	27"	90"
1"	20'-0"	20'-0"	3	30"	90"
1"	20'-6"	20'-6"	3	30"	93"
1"	21'-0"	21'-0"	3	30"	96"
1"	21'-6"	21'-6"	3	33"	96"
1"	22'-0"	22'-0"	3	36"	96"
1"	22'-6"	22'-6"	3	36"	99"
1"	23'-0"	23'-0"	3	36"	102"
1"	23'-6"	23'-6"	3	36"	105"
1"	24'-0"	24'-0"	3	36"	108"

APPROVAL RECOMMENDED:
Eishi Tanaka 12/29/69
TRAFFIC ENGINEER DATE


APPROVED:
John S. Saha 12-30-69
ASSISTANT CHIEF, ENGINEERING DATE

NO.	REVISION	APPROVED BY	DATE

STATE OF HAWAII
DEPARTMENT OF TRANSPORTATION
LAND TRANSPORTATION FACILITIES DIVISION
STANDARD DETAILS
LAMINATED ALUMINUM
SIGN PANELS
(OVERHEAD)
Scale: As Shown

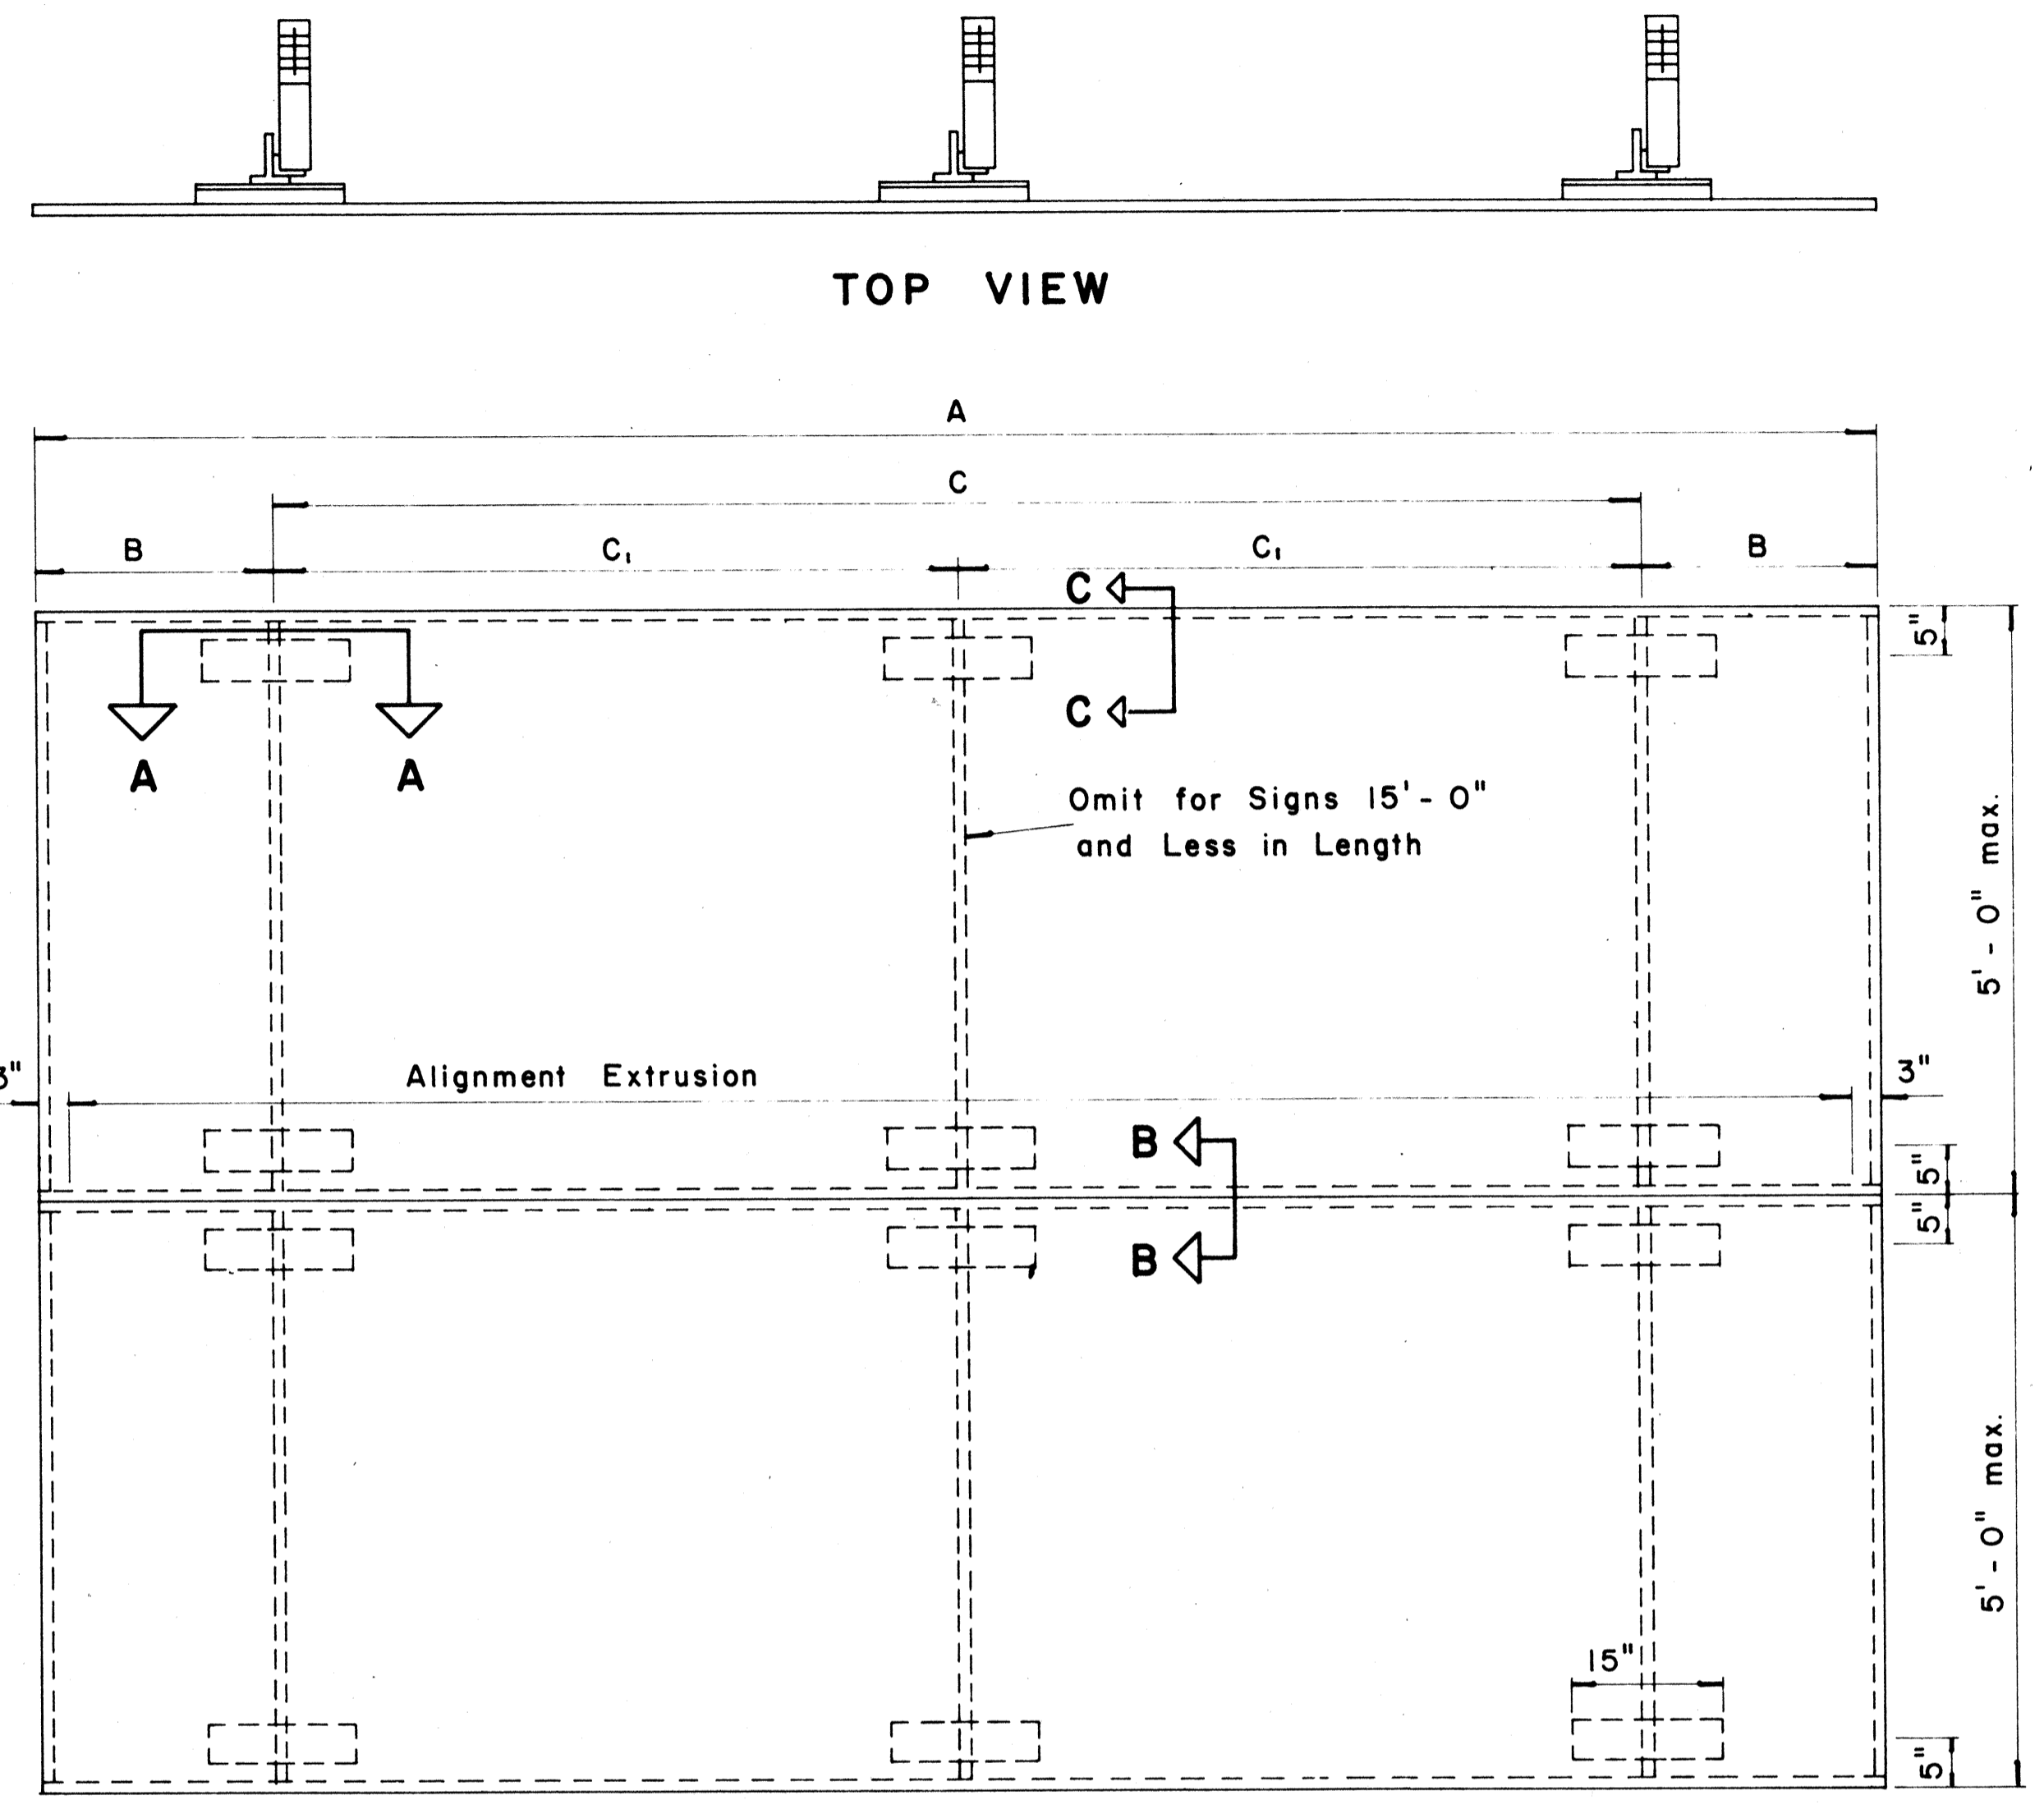


TYPICAL SIGN ASSEMBLY
Scale: $\frac{3}{4}$ " = 1'-0"

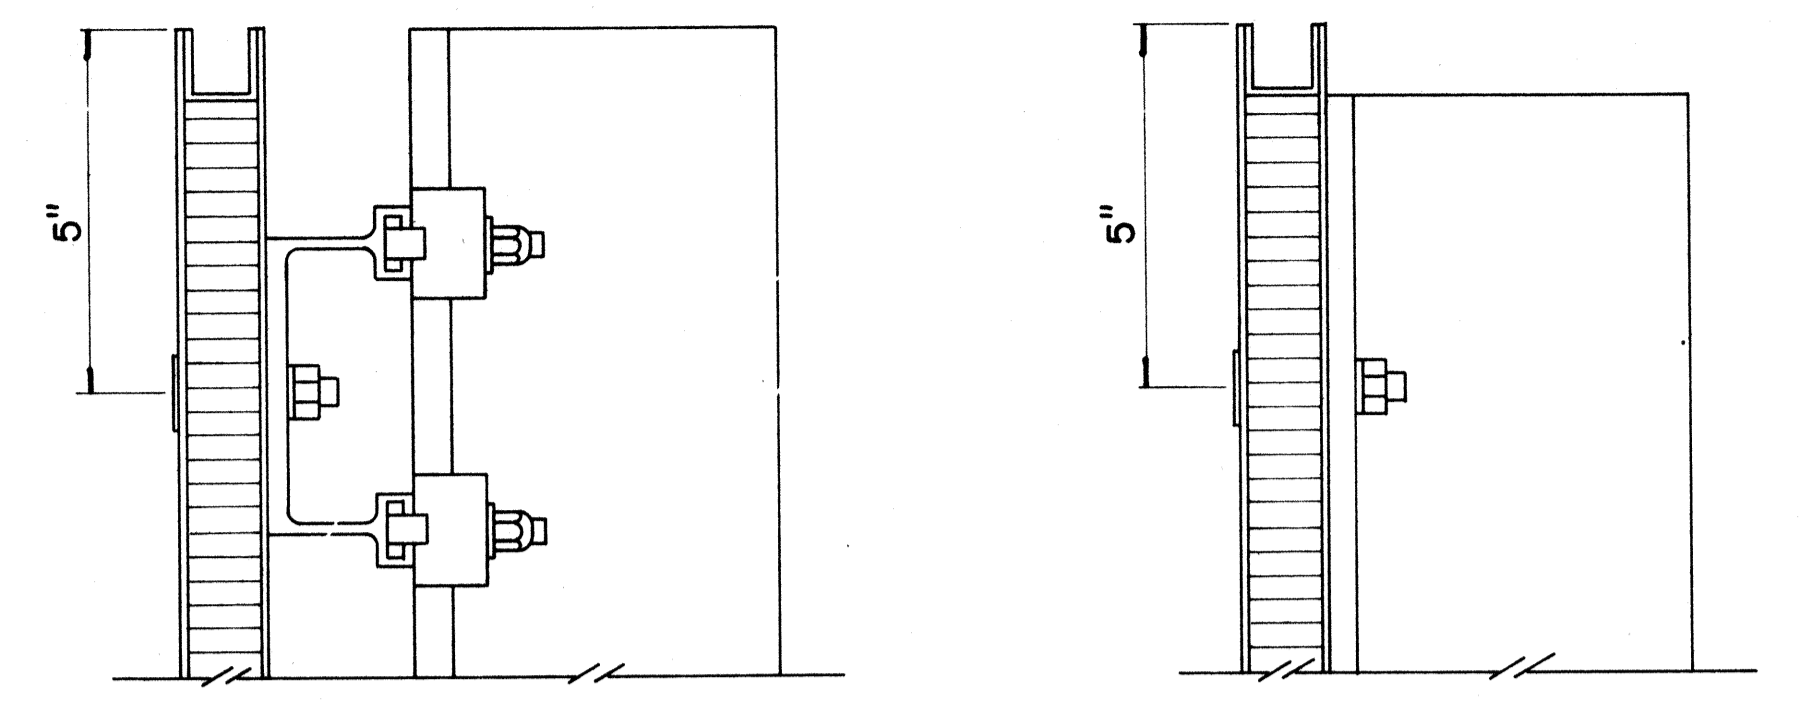


SECTION "C-C"
Scale: $\frac{3}{8}$ " = 1"

SECTION "C-C" (Alternate)
Scale: $\frac{3}{8}$ " = 1"

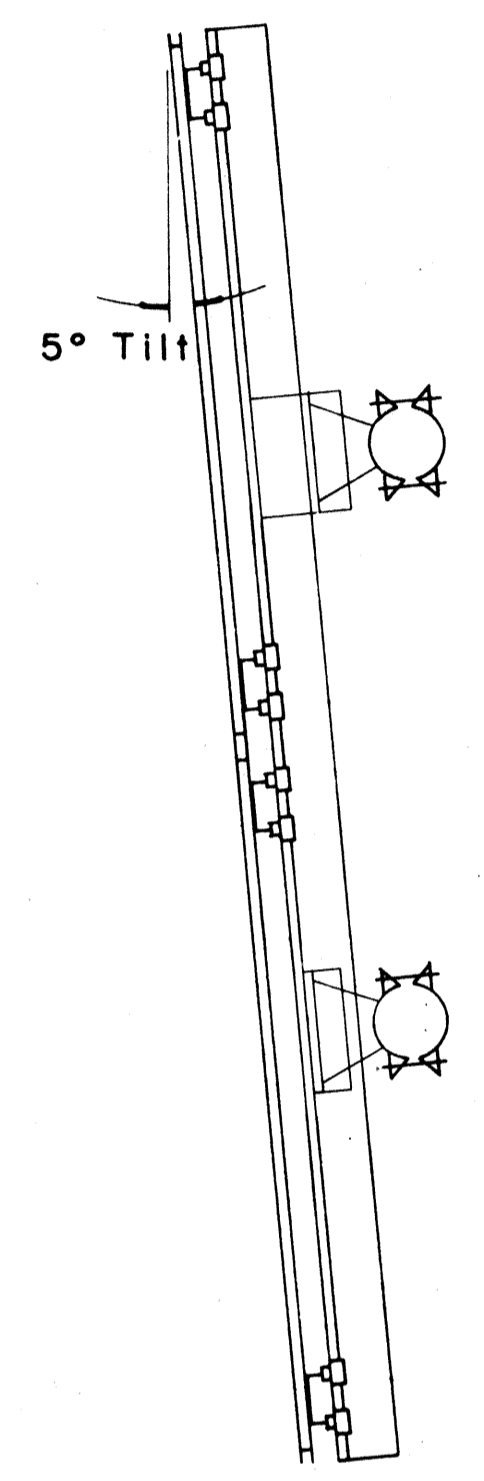


SIDE VIEW

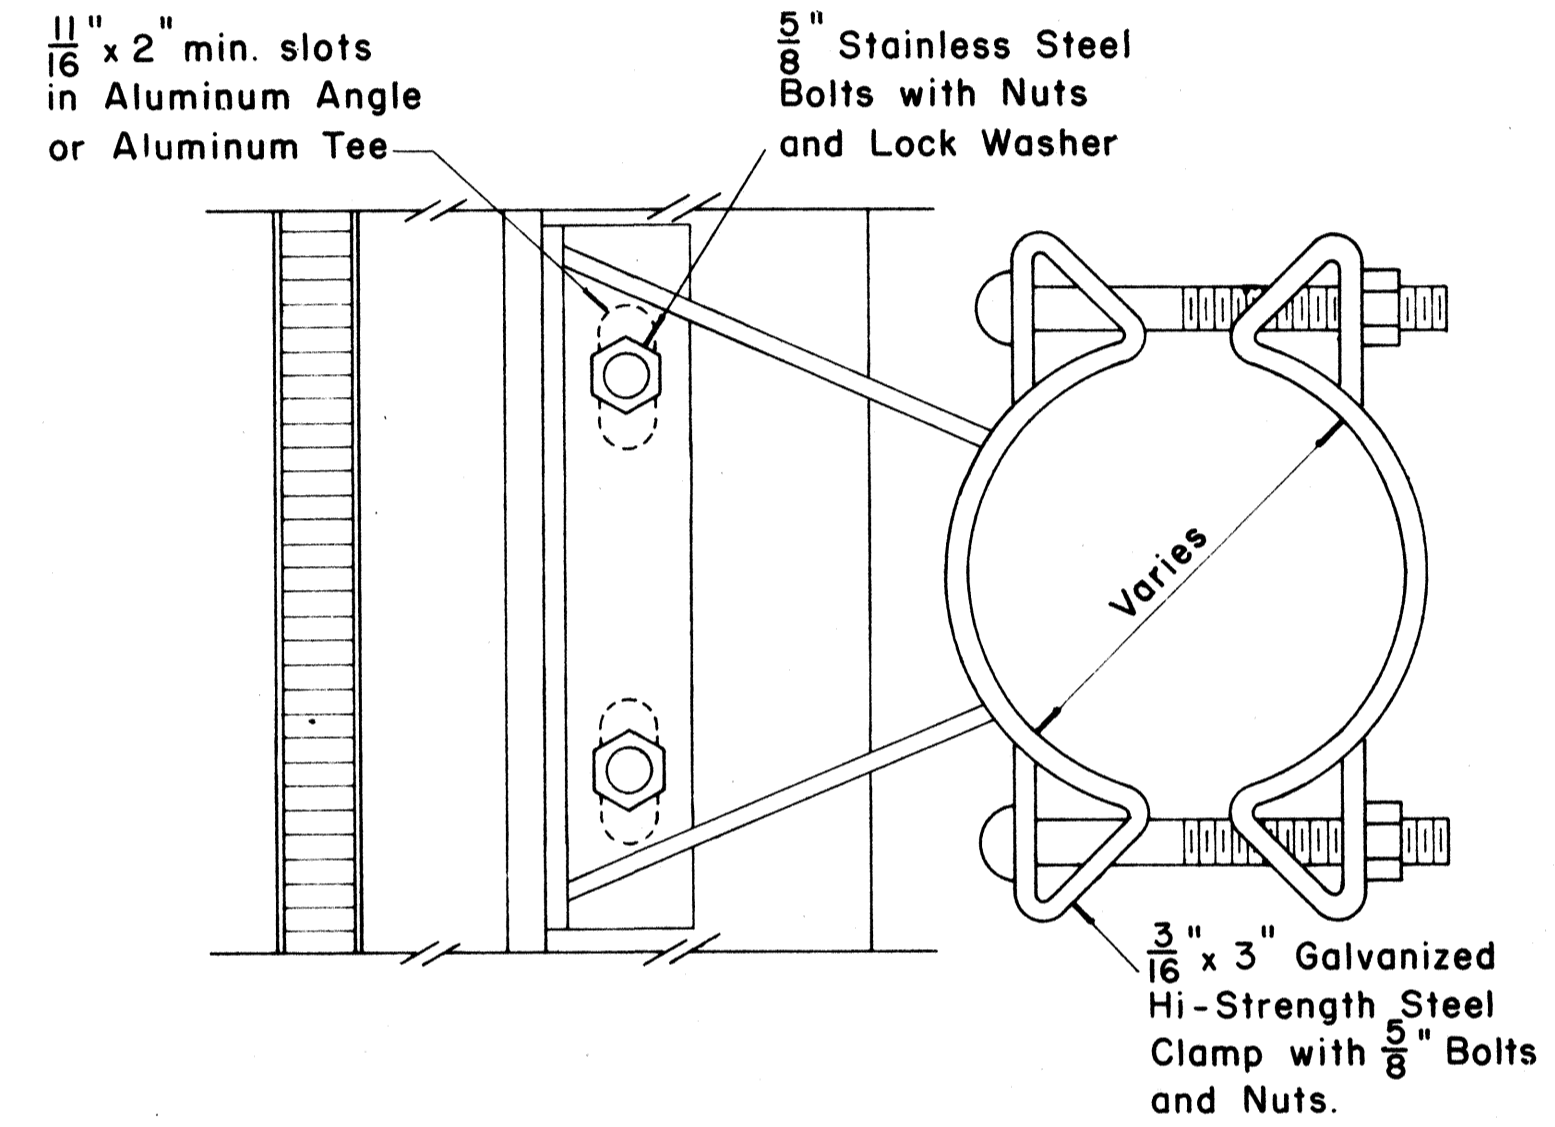


SIGN BRACKET ASSEMBLY
Scale: $\frac{3}{8}$ " = 1"


NOTE: For additional details of Sign Bracket Assembly, see Standard Detail Sheet "Overhead Sign Supports."

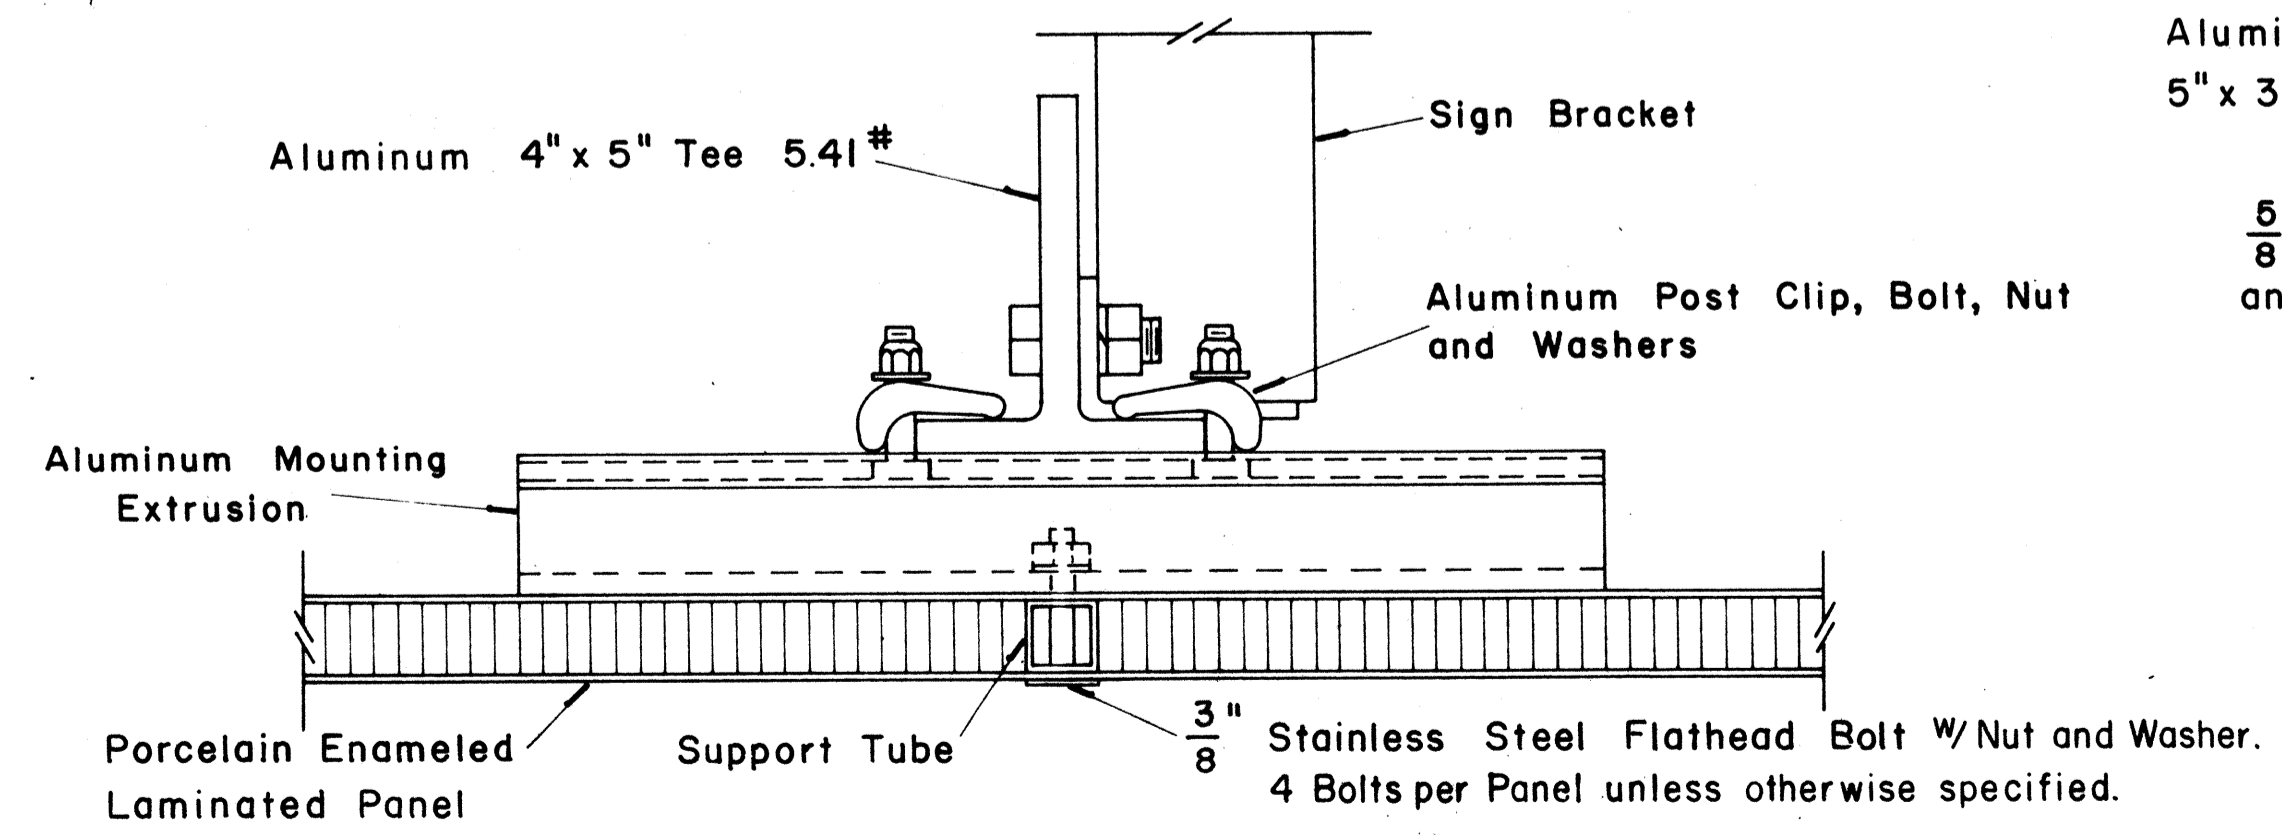

SECTION "A-A"
Scale: $\frac{3}{8}$ " = 1"

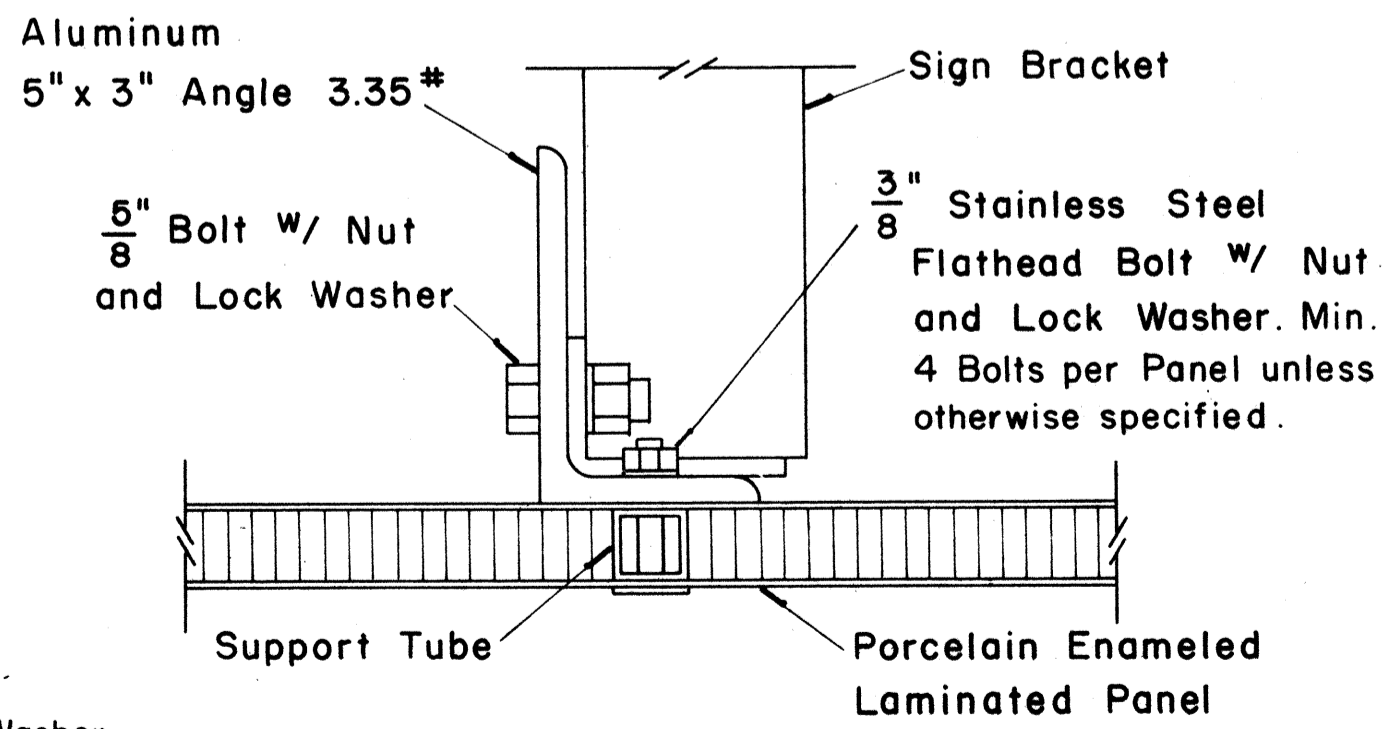


SECTION "A-A" (Alternate)
Scale: $\frac{3}{8}$ " = 1"

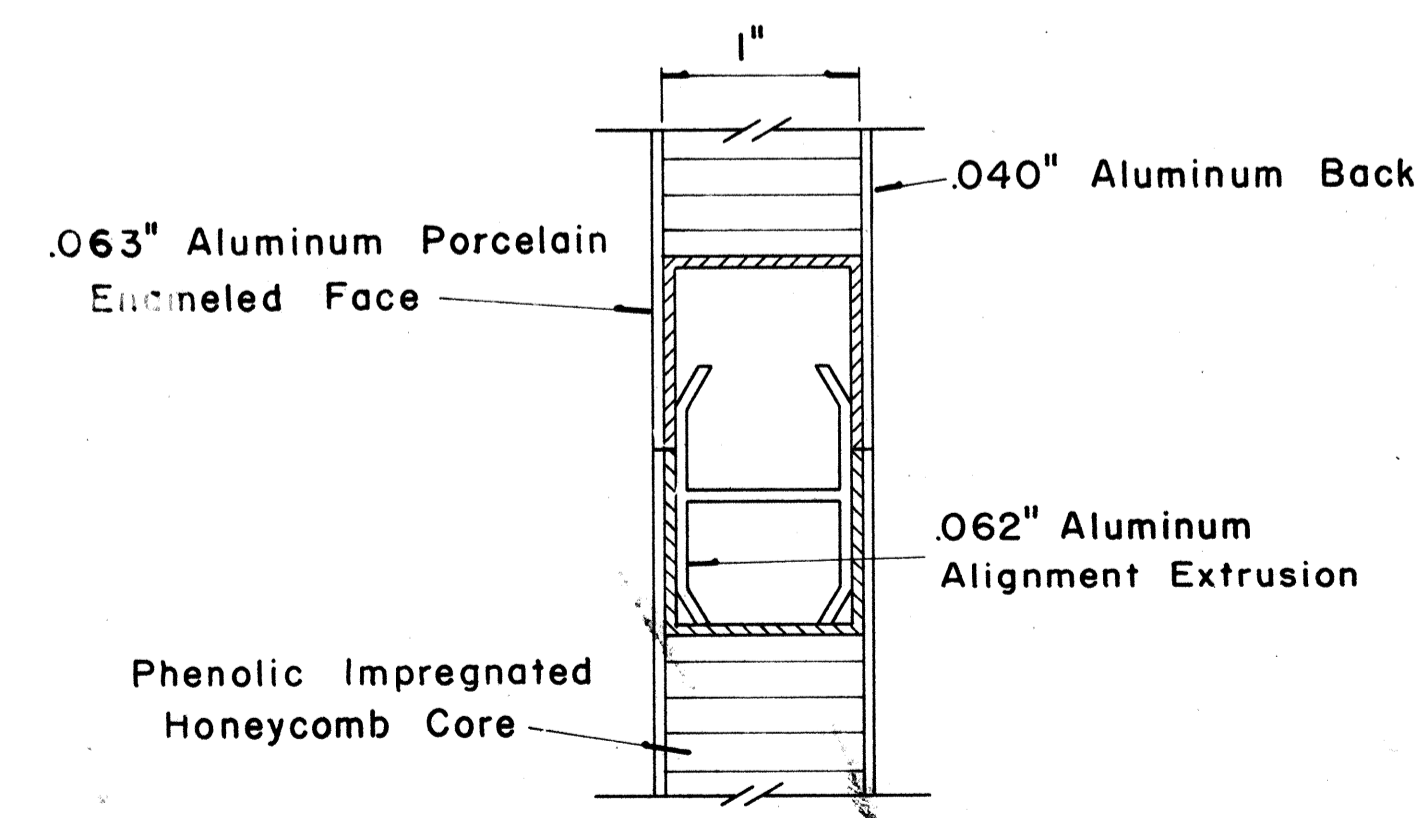


CLOSURE DETAIL SECTION "B-B"
FULL SCALE

DATE
SURVEY PLOTTED BY
DRAWN BY
DESIGNED BY
NOTE BOOK
QUANTITIES BY
CHECKED BY
No.


FED. ROAD DIST. NO.	STATE	FED. AID PROJ. NO.	FISCAL YEAR	SHEET NO.	TOTAL SHEETS
HAWAII	HAW.	IR-HI-1(193)	1986	51	62

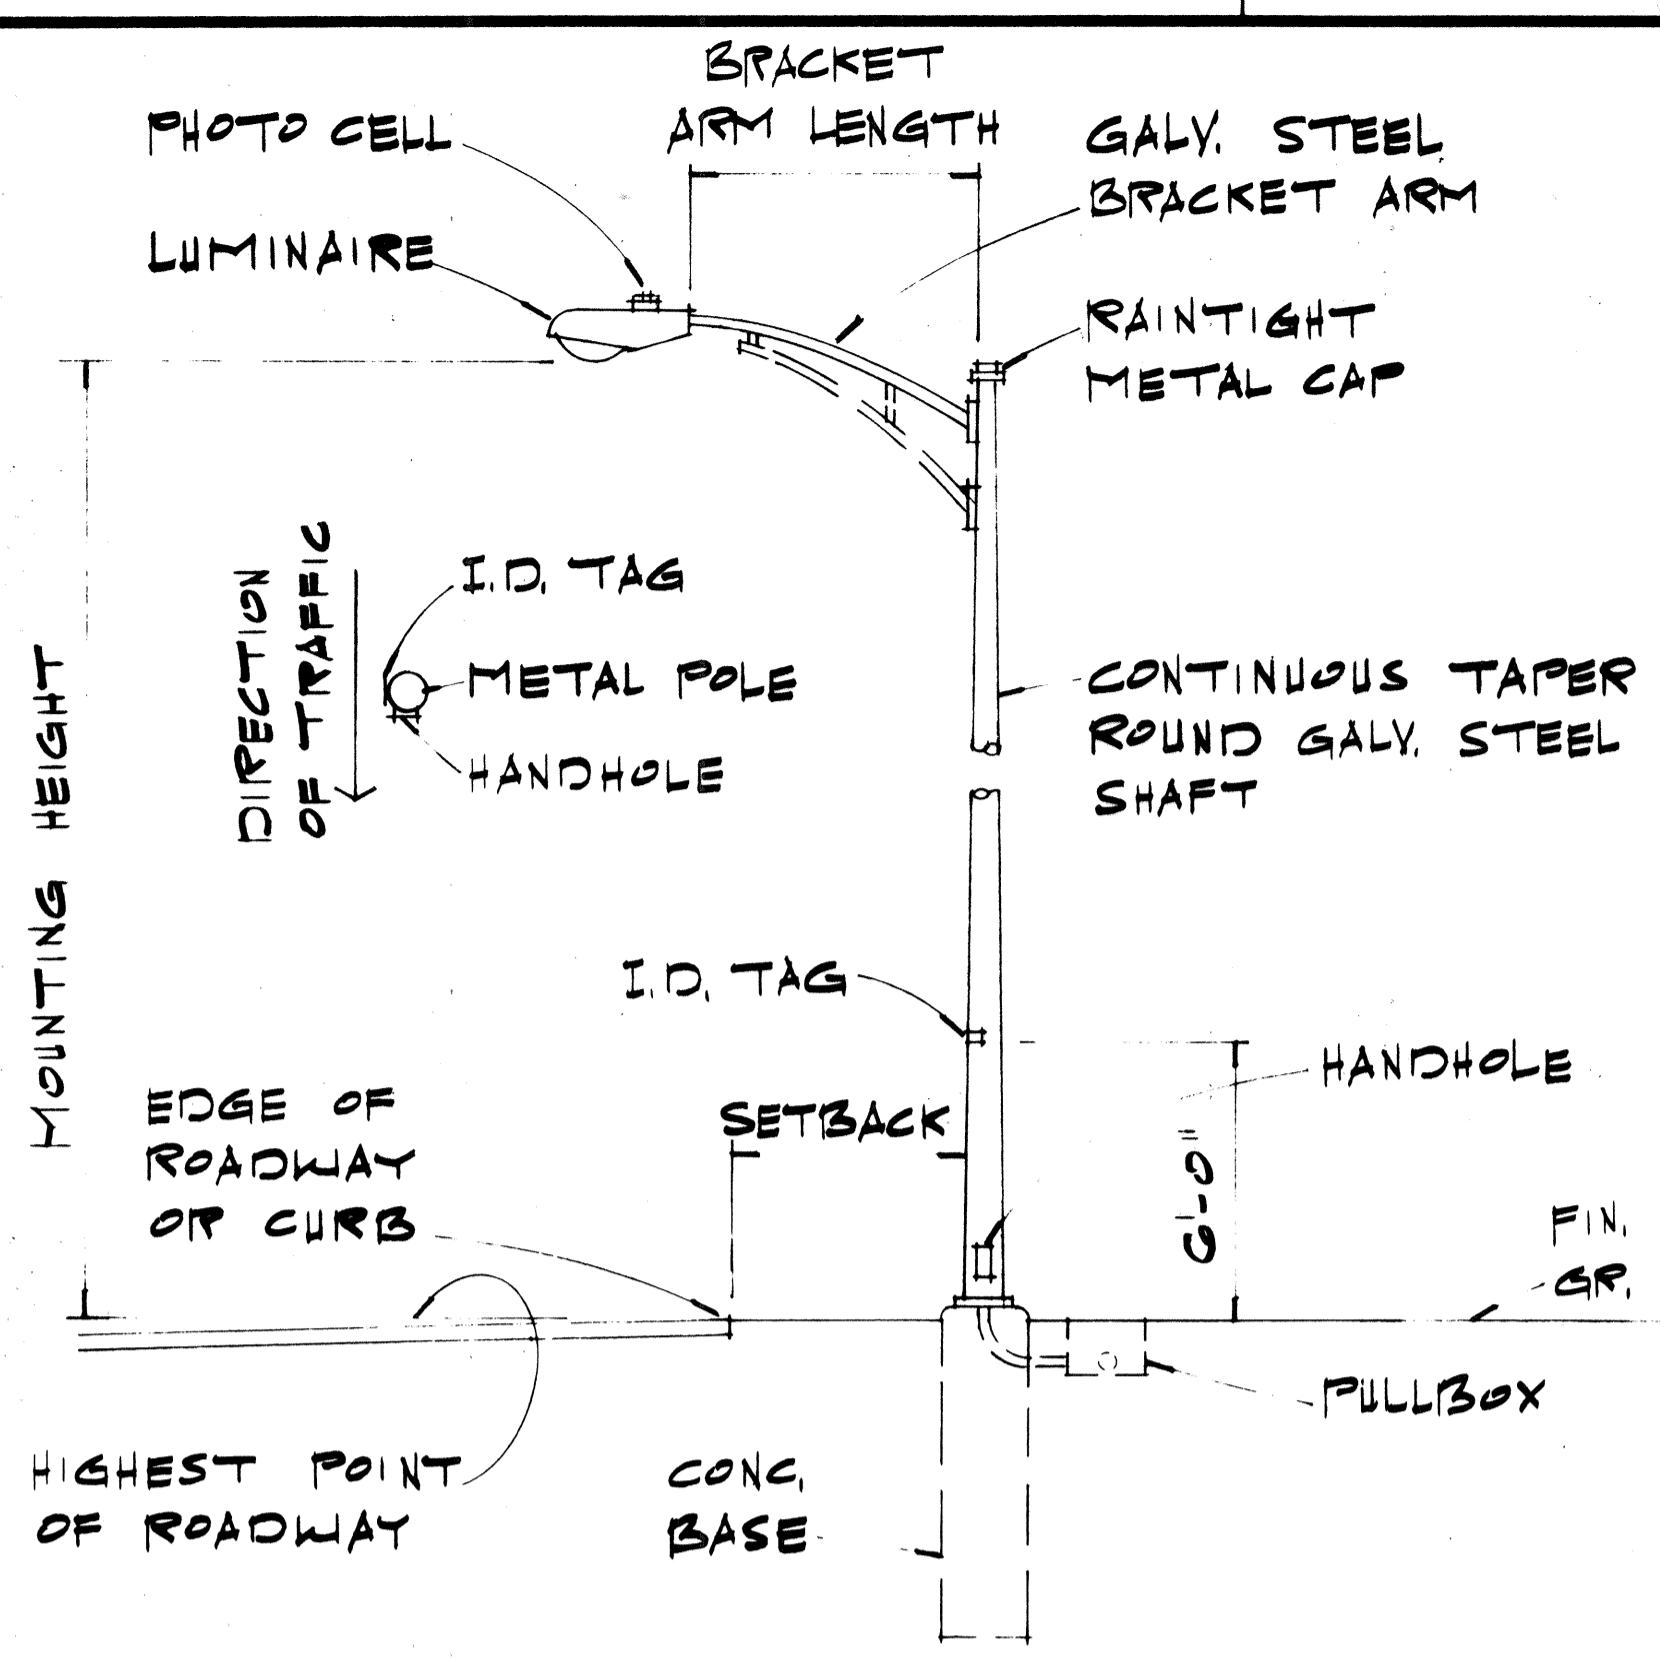

STREET LIGHT DETAIL
SCALE: 1/4" = 1'-0"

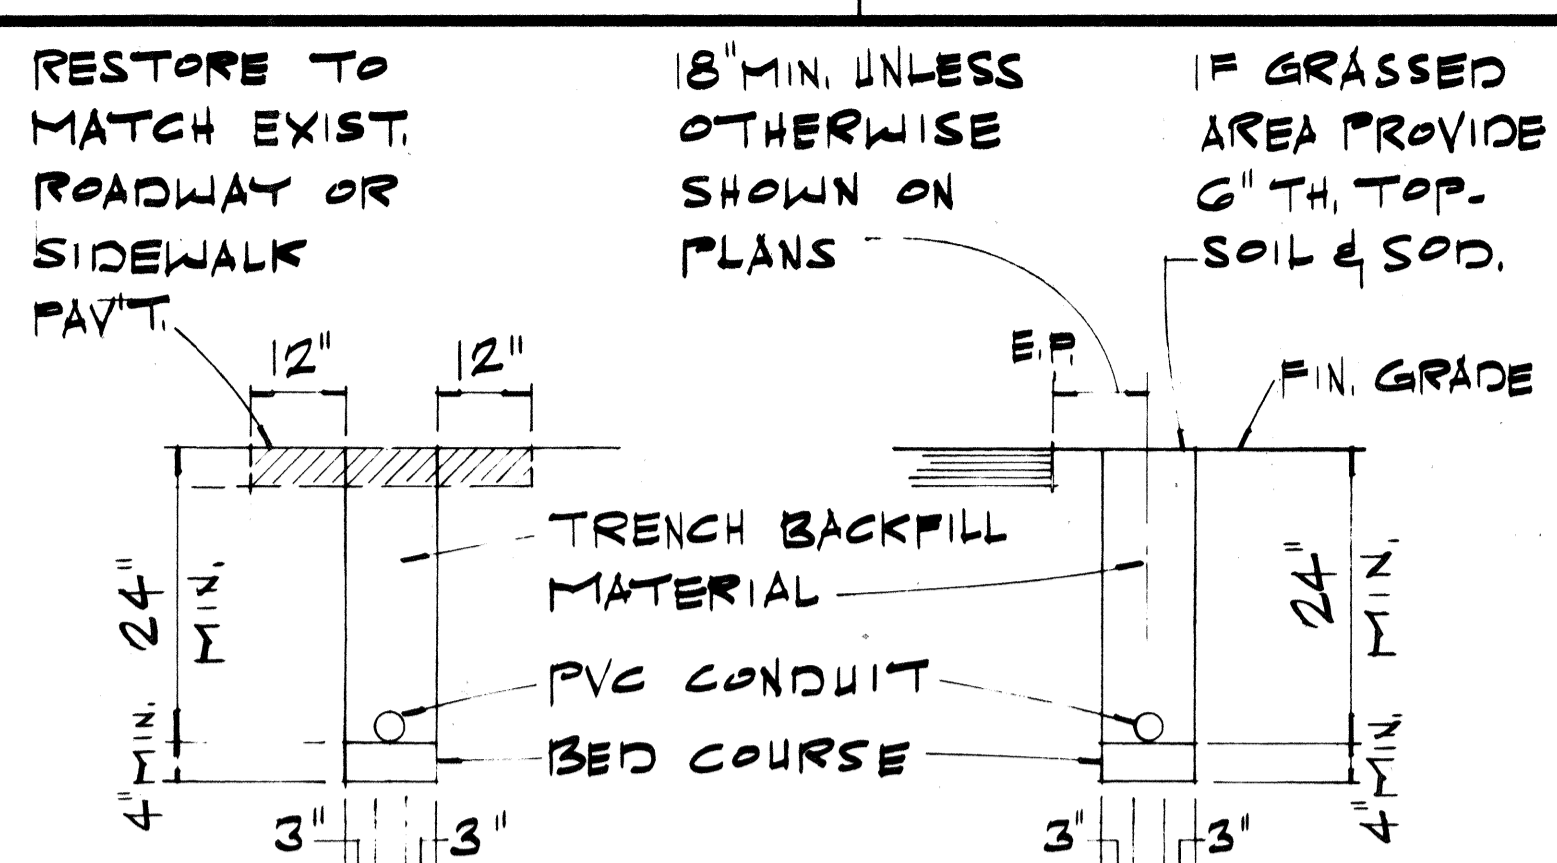


TYPICAL DUCT SECTION DETAIL
SCALE: 1/2" = 1'-0"
NOTE: FOR MULTIPLE CONDUIT LAYOUTS PROVIDE 3" CL. SPACING BETWEEN CONDUITS.

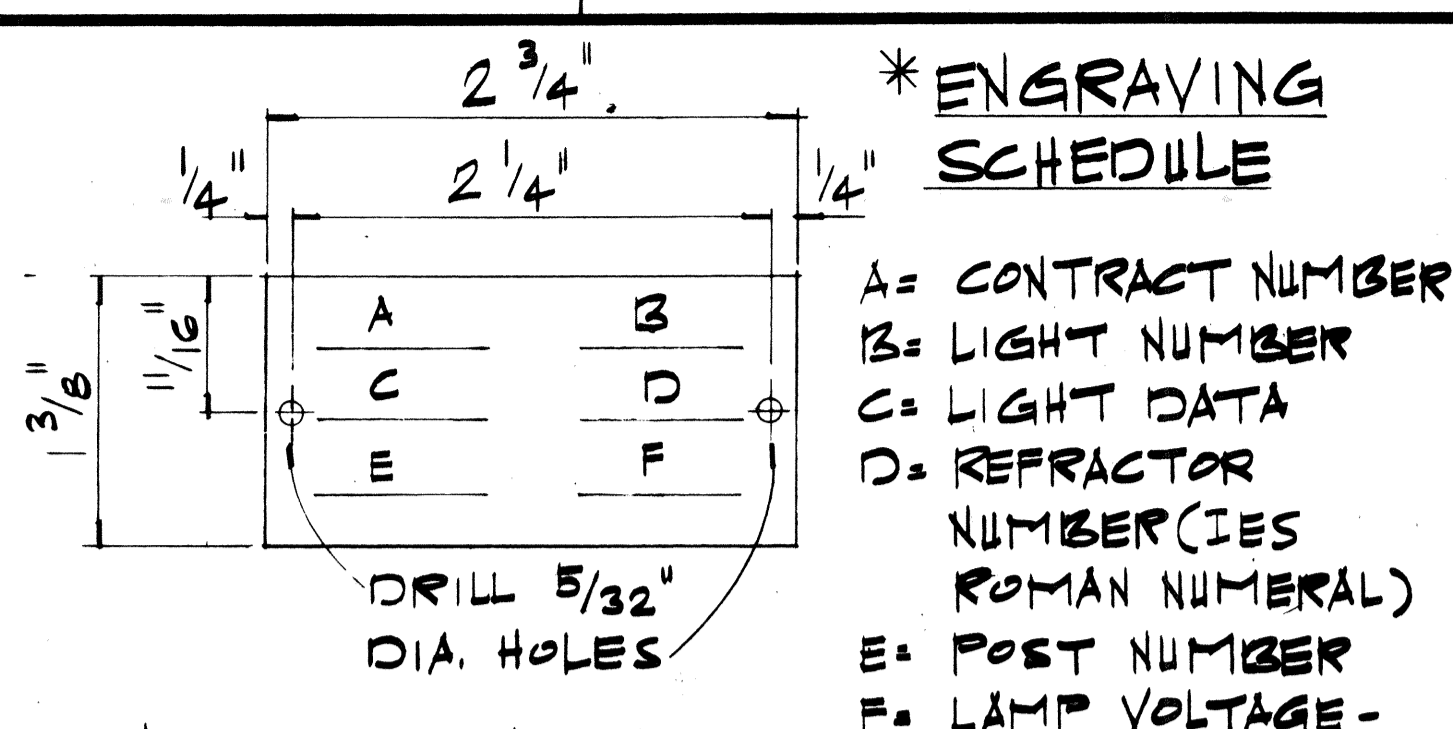


IDENTIFICATION TAG FOR MULTIPLE STREET LIGHTING
NOT TO SCALE * AS SHOWN ON PLANS
NOTE:
1. MAKE FROM 3-PLY LAMINATED PLASTIC (BLACK-WHITE-BLACK) W/ 1/5" HIGH COMMERCIAL GOTHIC LETTERS ENGRAVED.
2. ATTACH TO POLE W/ #7 CADMIUM PLATED SCREWS.


- GENERAL NOTES**
- ALL LUMINAIRES SHALL BE HIGH PRESSURE SODIUM TYPE W/ WATTAGE & IES TYPE LIGHT DISTRIBUTION AS SHOWN ON PLANS.
 - ALL SECONDARY CIRCUIT EXTENSIONS TO SERVICE SHALL BE PROVIDED BY CONTRACTOR. ALL CONNECTIONS MADE BY SUBJECT TO CHARGE SHALL BE PAID BY THE CONTRACTOR.
 - THE CONTRACTOR SHALL BE RESPONSIBLE FOR COORDINATING & INFORMING OF STREET LIGHT LOCATIONS ON PROJECT SITE PRIOR TO INSTALLATION OF SECONDARY CIRCUIT CONNECTION.
 - THE CONTRACTOR SHALL NOTIFY & COORDINATE WORK W/ THE STATE ELECTRICAL MAINTAINANCE SECTION, ADD. PH.# 72 HOURS IN ADVANCE OF COMMENCING INSTALLATION OF STREET LIGHT SYSTEM.
 - THE CONTRACTOR SHALL LOCATE & VERIFY EXISTING STREET LIGHT SECONDARY VOLTAGE BEFORE ORDERING LIGHTING EQUIPMENT.

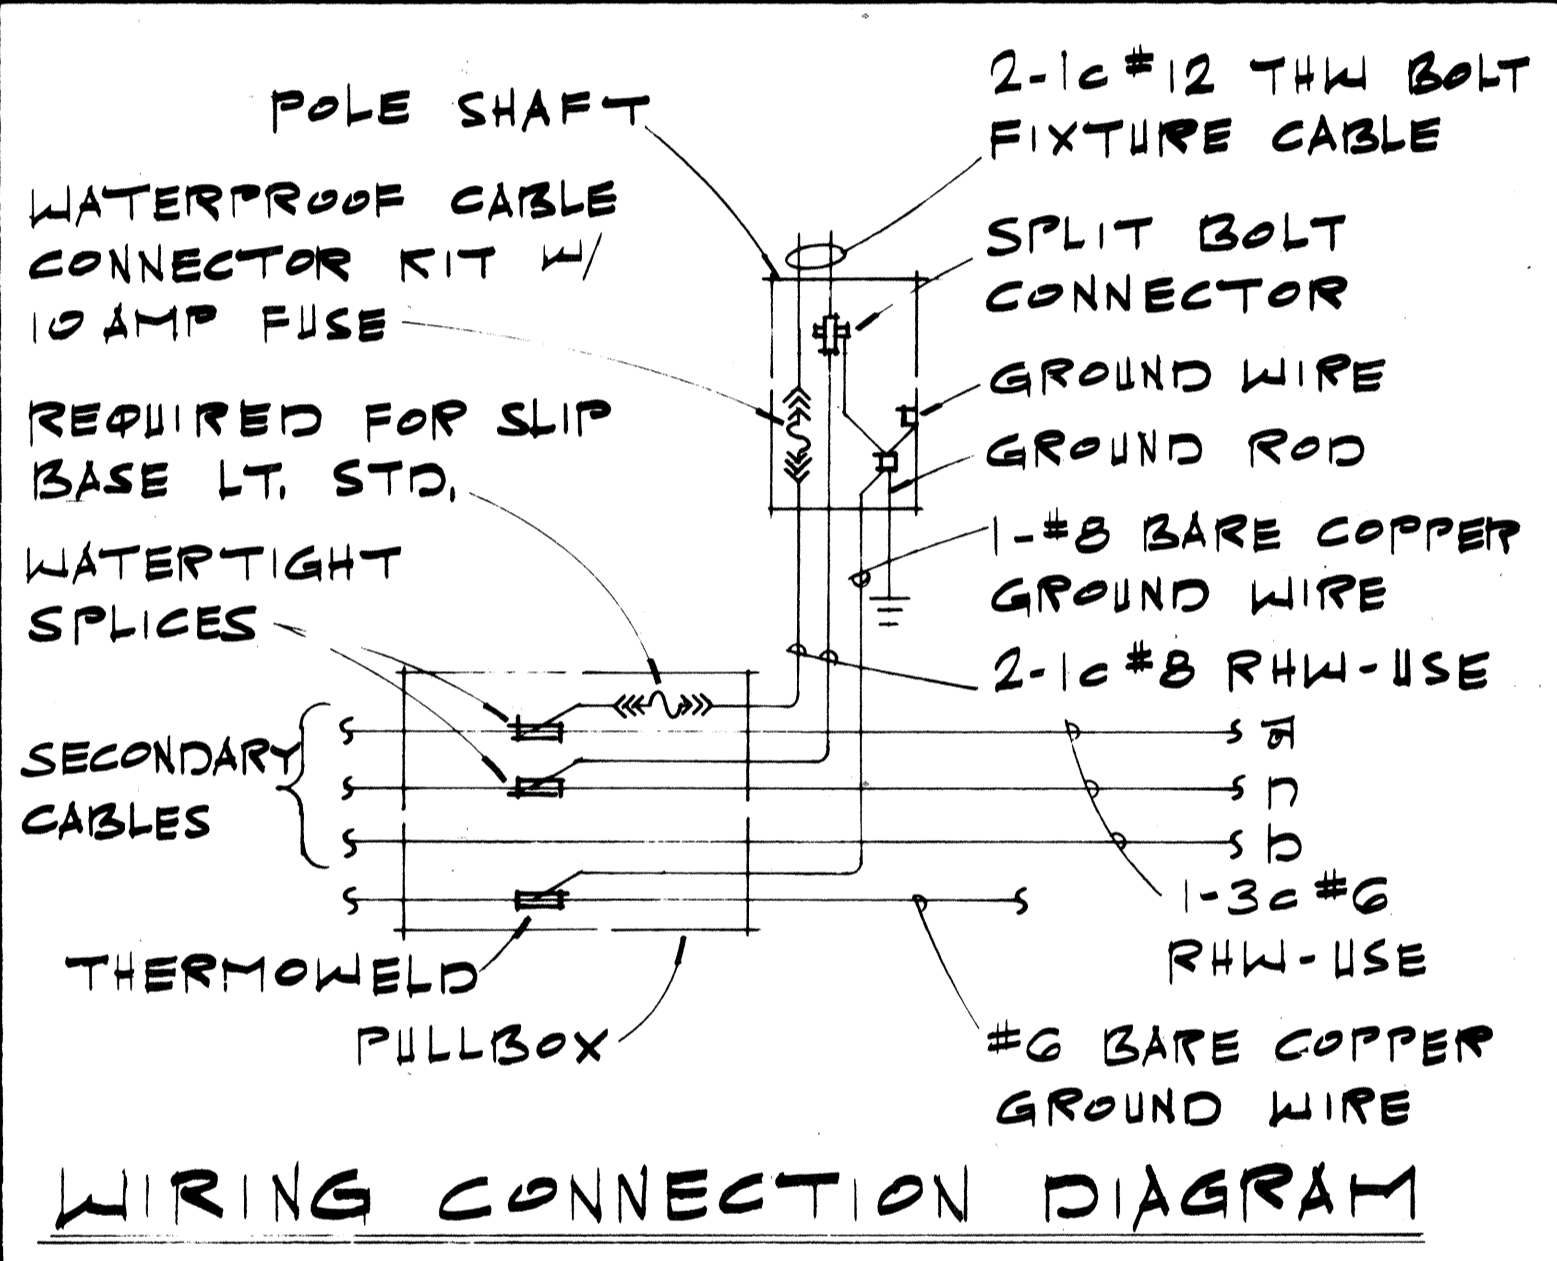

WIRING CONNECTION DIAGRAM

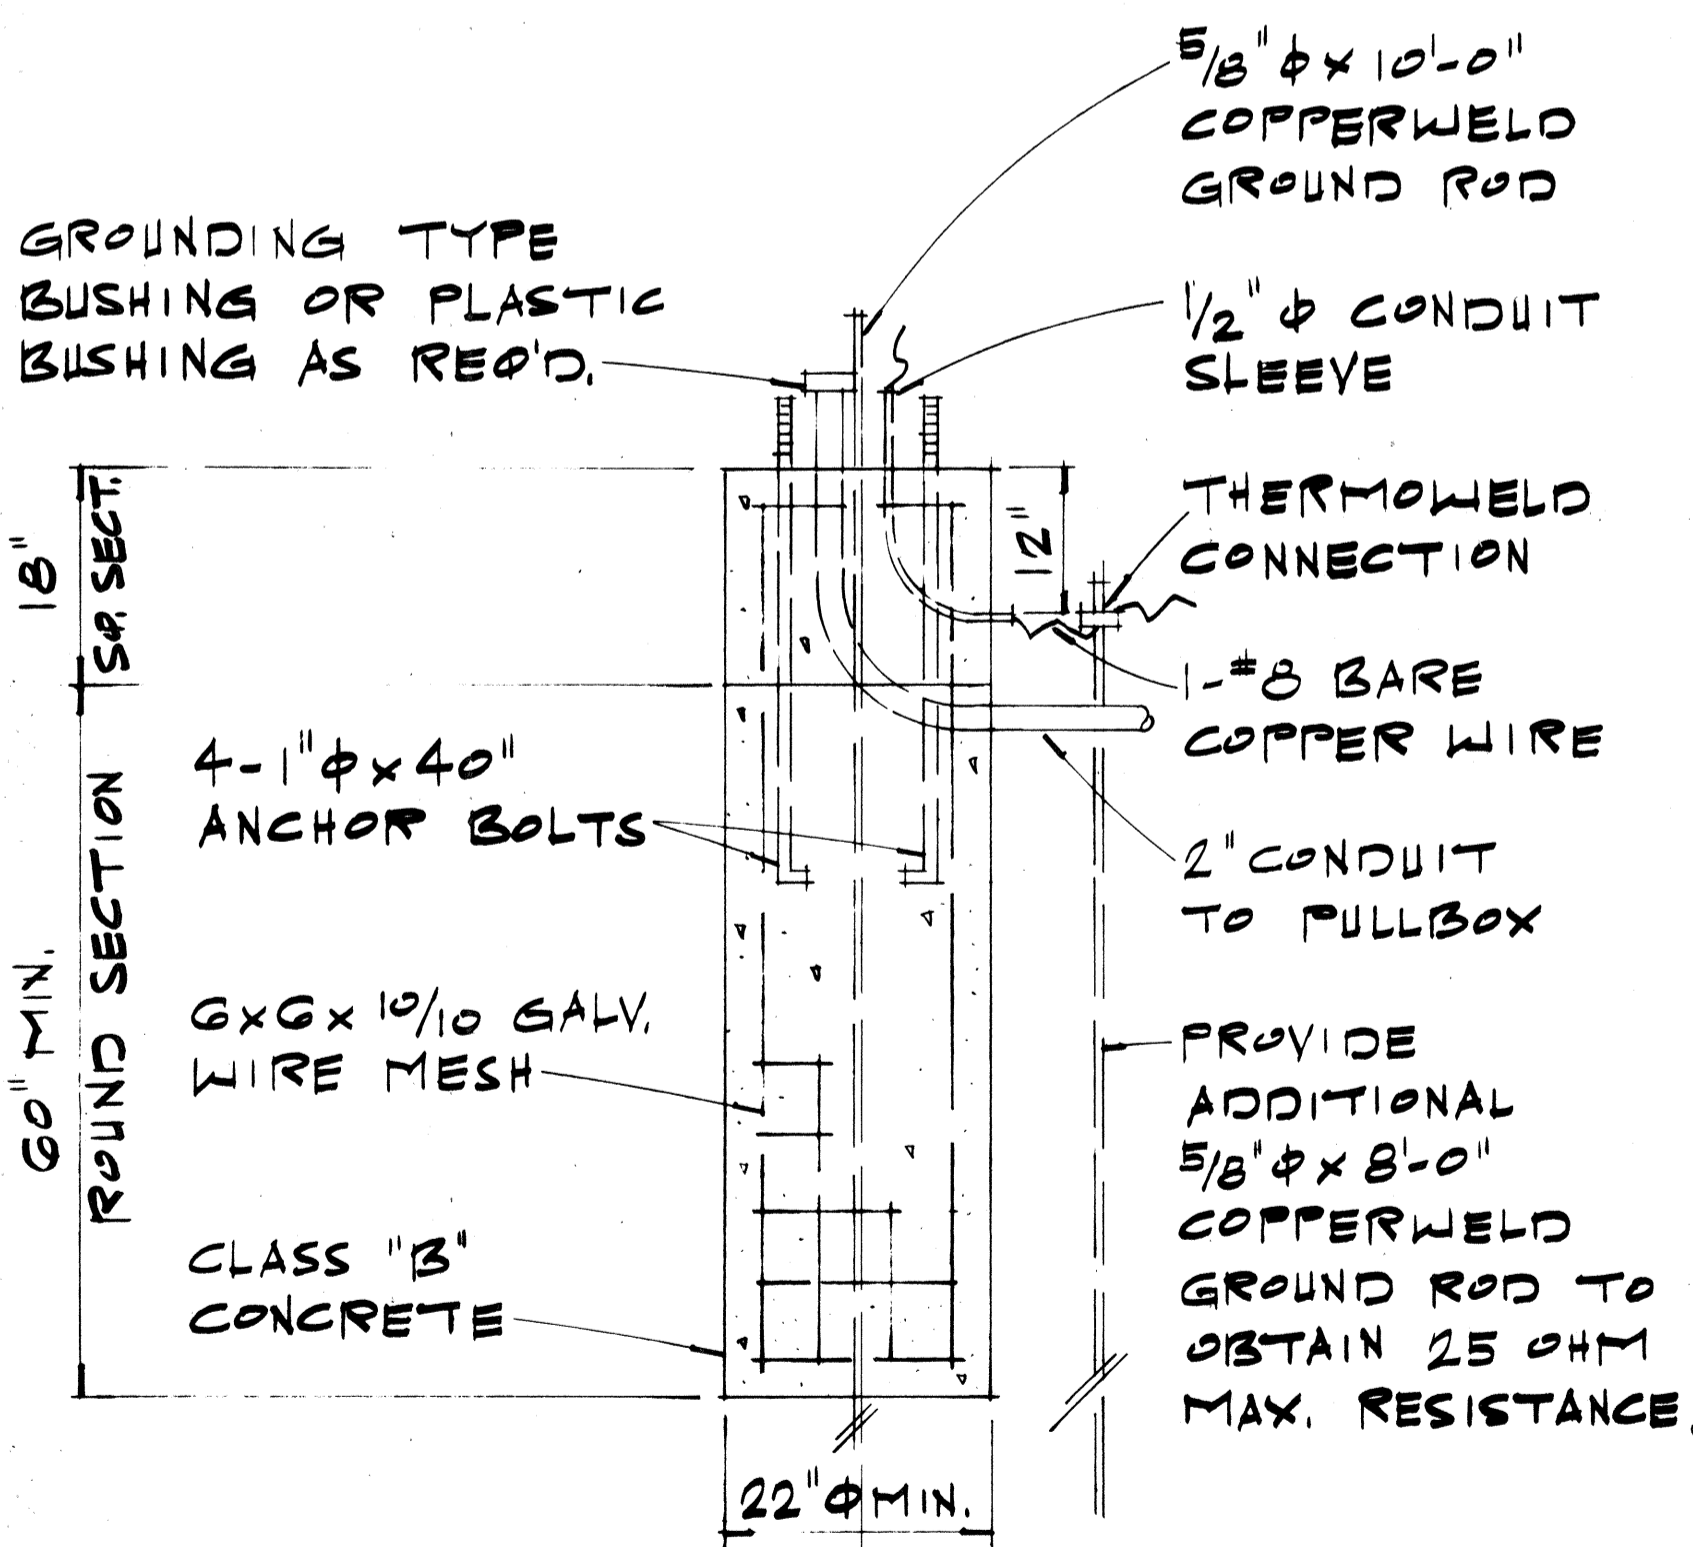


CONCRETE BASE DETAIL
SCALE: 3/4" = 1'-0"

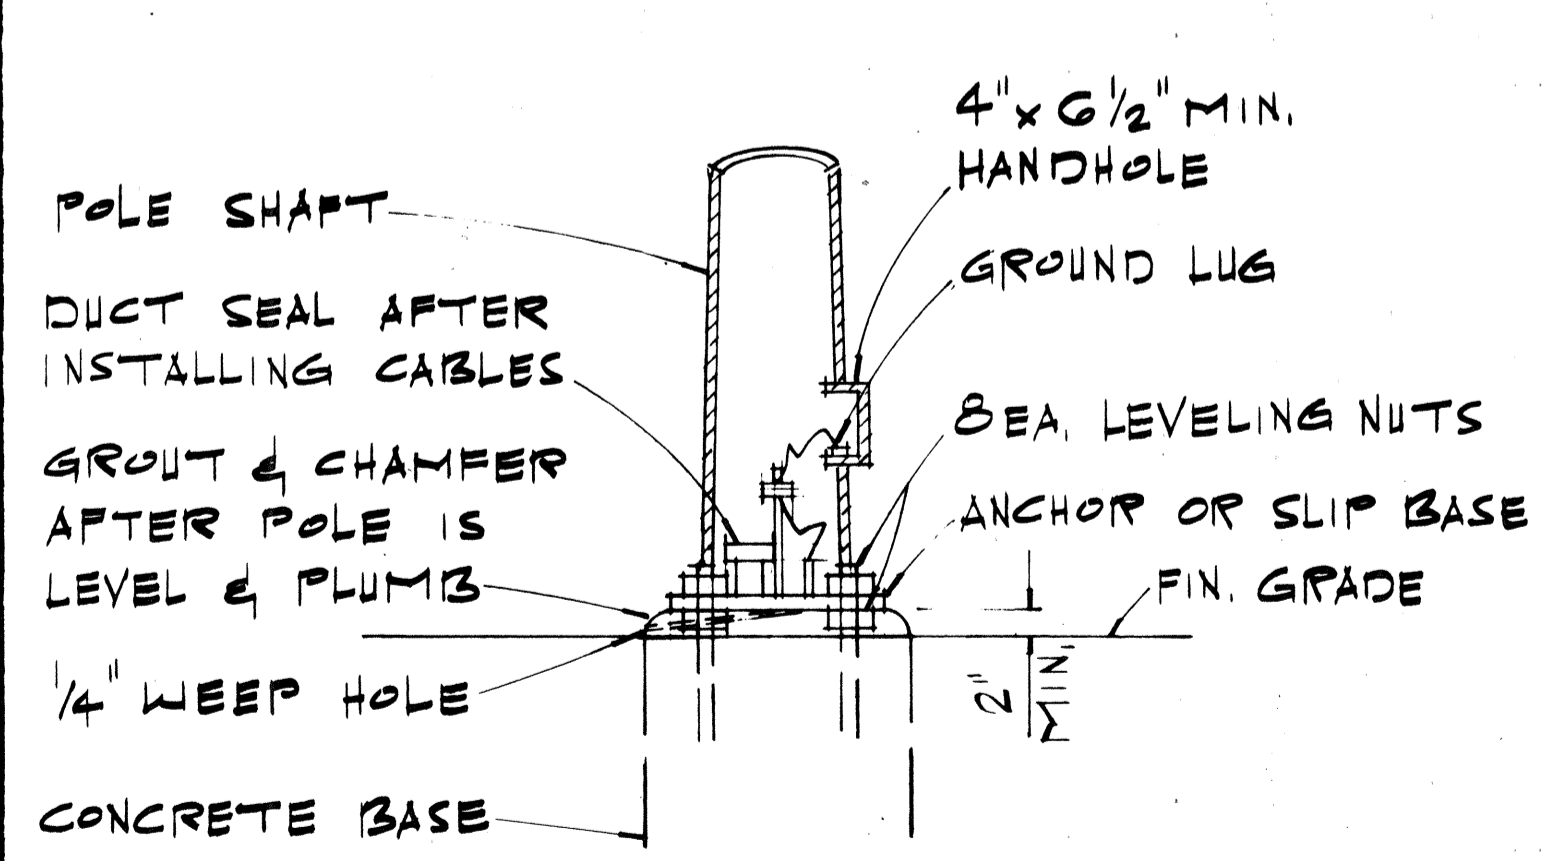


POLE MOUNTING DETAIL
SCALE: 3/4" = 1'-0"

DATE: _____
SURVEY PLOTTED BY: _____
ORIGINAL PLAN: _____
DRAWN BY: _____
TRACED BY: _____
NOTE BOOK: _____
QUANTITIES BY: _____
CHECKED BY: _____
No. _____

STATE OF HAWAII
DEPARTMENT OF TRANSPORTATION
LAND TRANSPORTATION FACILITIES DIVISION
TYPICAL DETAILS
HIGHWAY LIGHTING LUMINAIRE
MOUNTED ON METAL POLE
F.A.I. PROJ. NO. IR-HI-1 (193)
SCALE: AS SHOWN
SHEET No. T14 OF 19 SHEETS

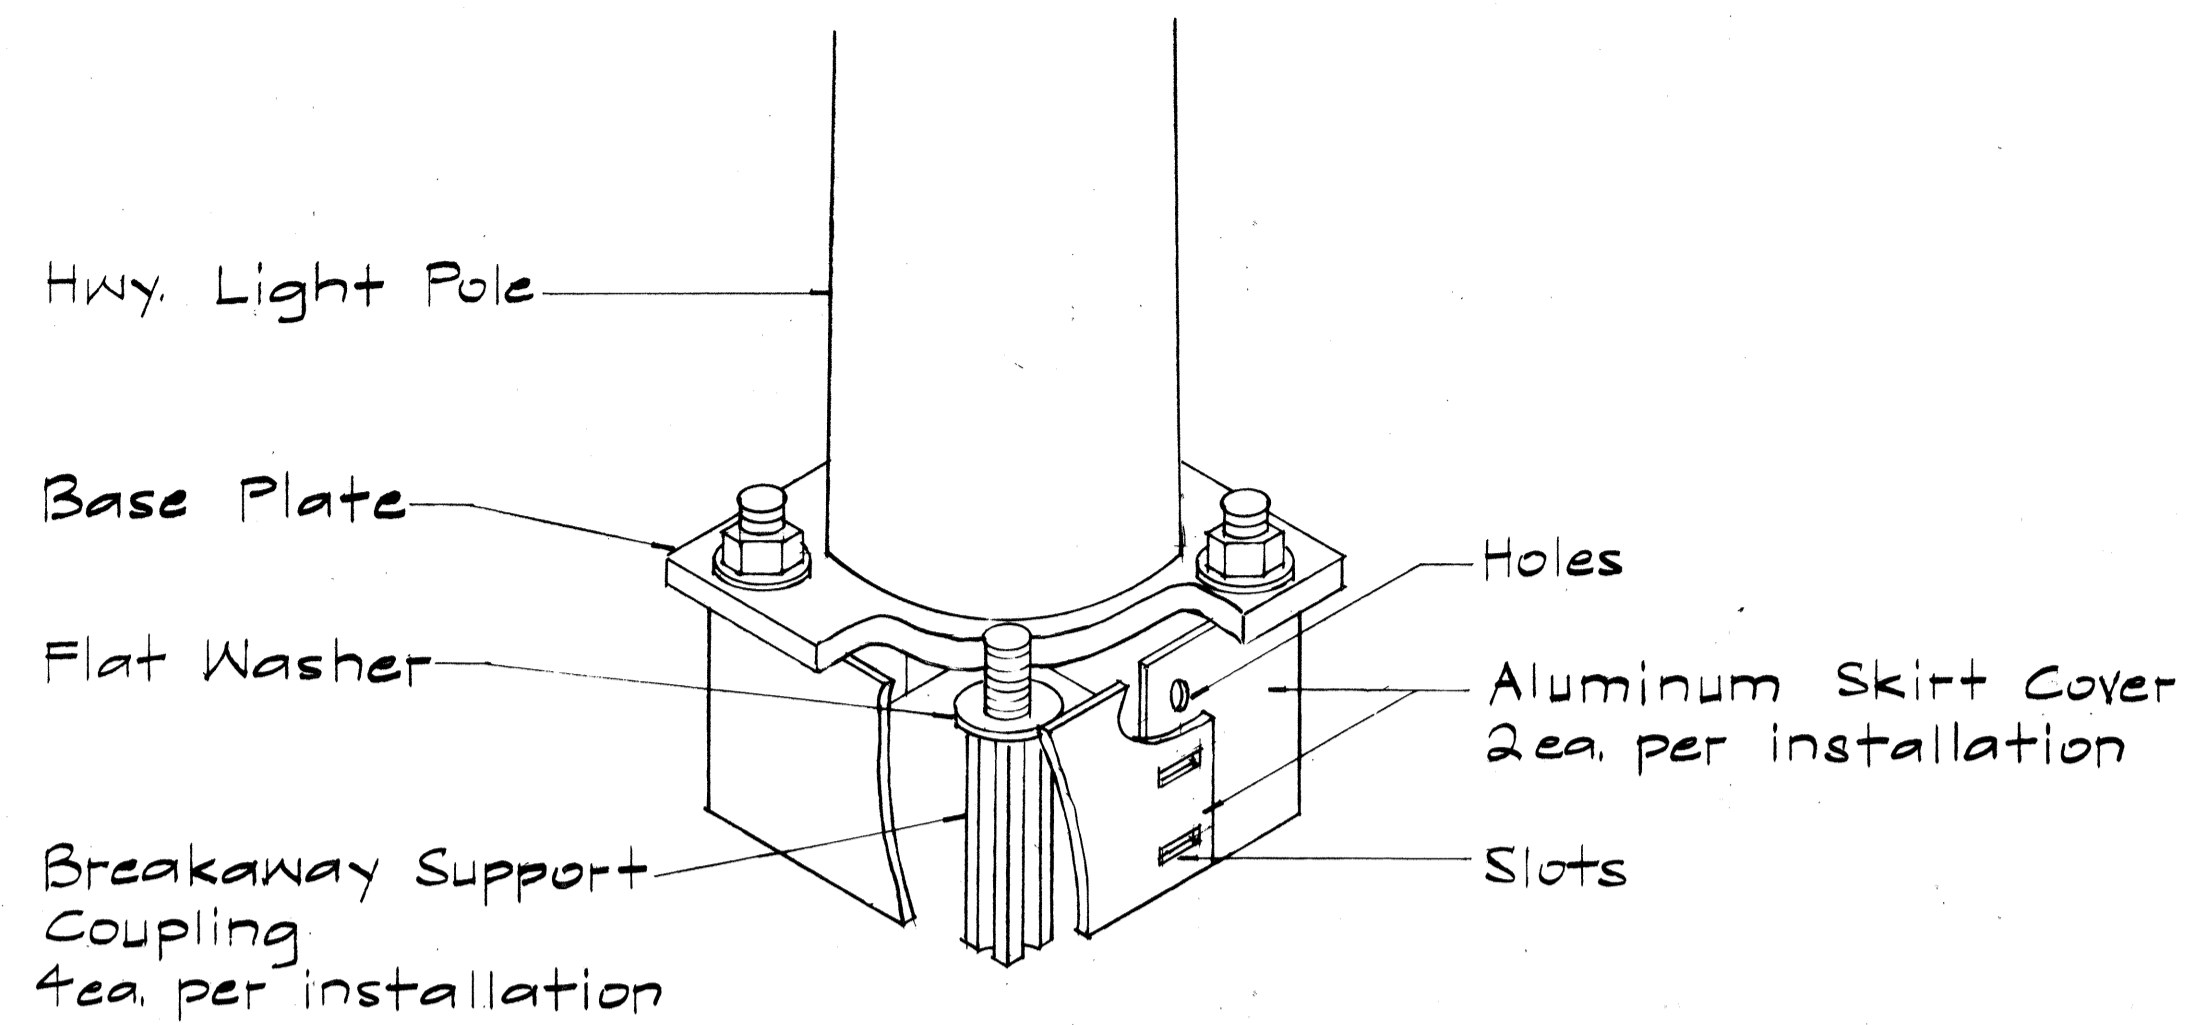


SKIRT COVER DETAIL

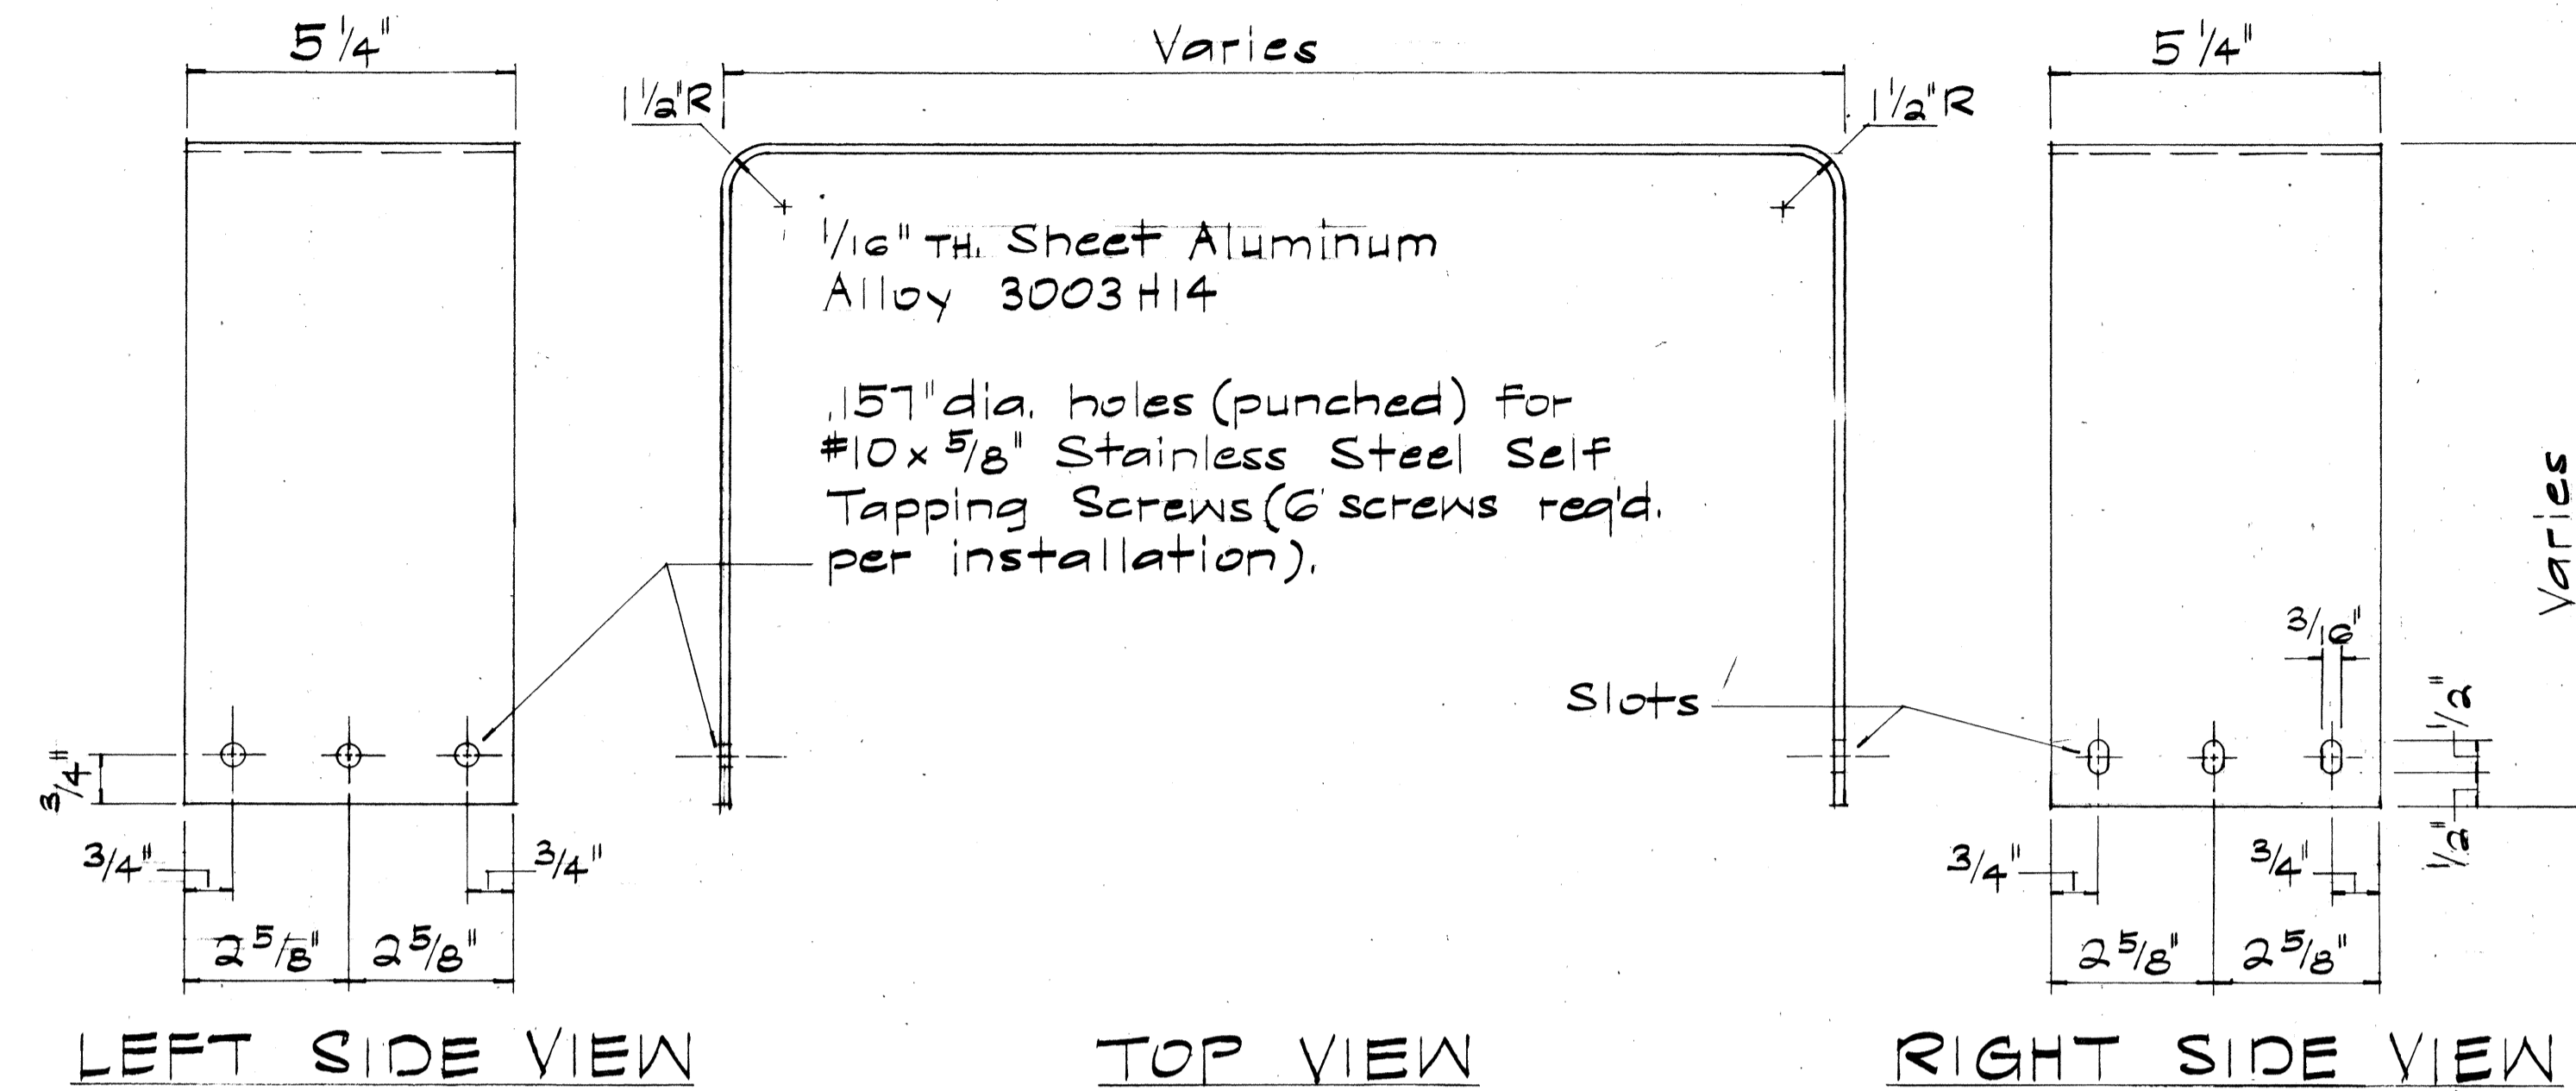

SKIRT COVER FOR BREAKAWAY SUPPORT COUPLING

Not to Scale

SECTION "B-B"

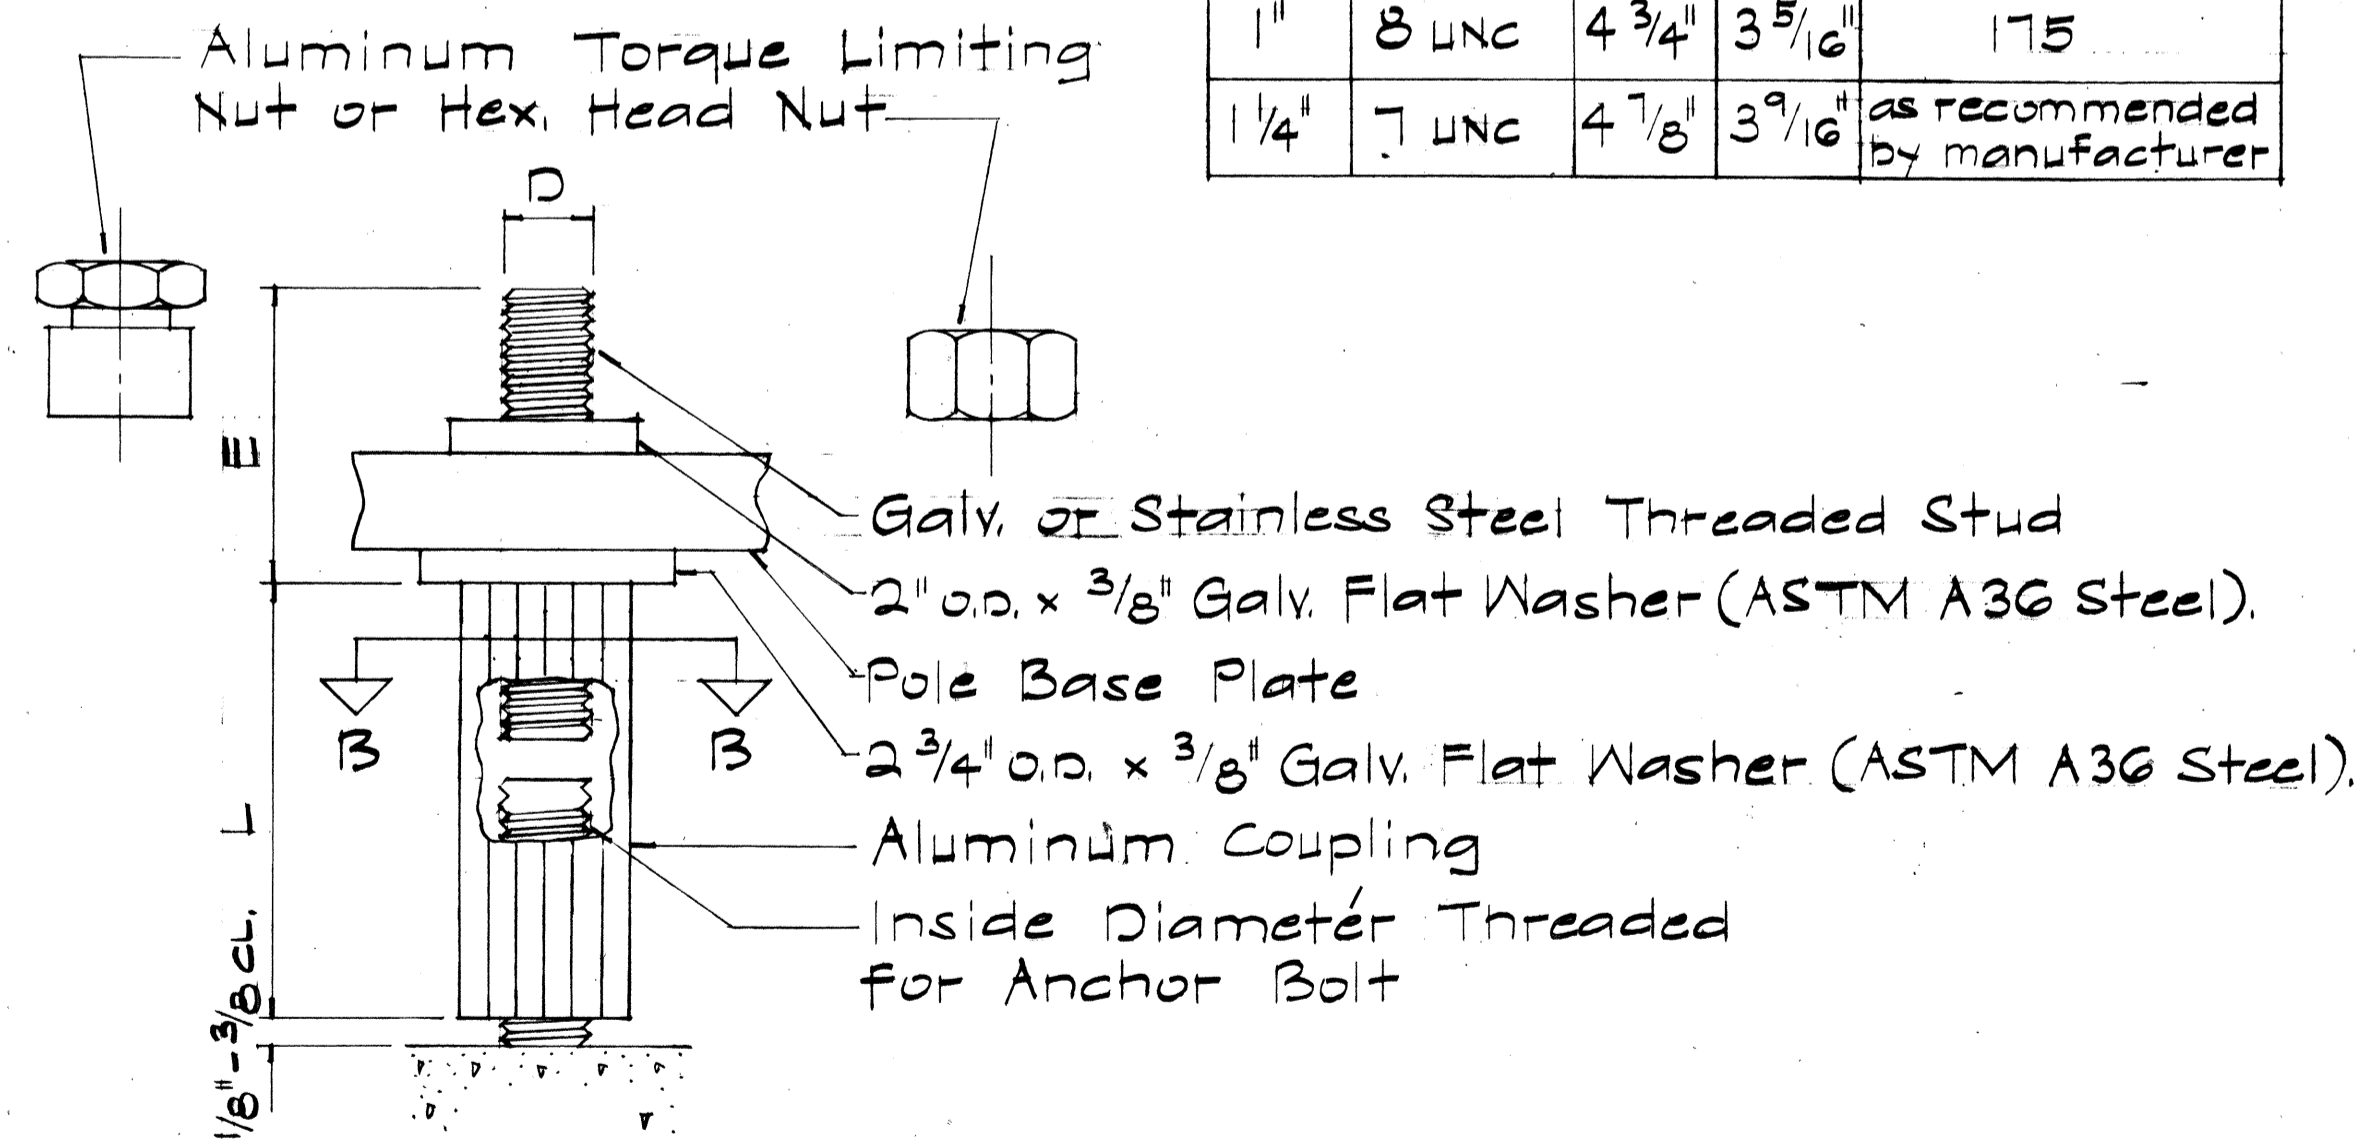


DETAIL "A"
Not to Scale

BREAKAWAY SUPPORT COUPLING

Scale: As Shown

DIMENSION SCHEDULE				
D	THREAD	L	E	NUT TORQUE ± 25 FT. LBS.
1"	8 UNC	4 3/4"	3 5/16"	175
1/4"	7 UNC	4 7/8"	3 9/16"	as recommended by manufacturer

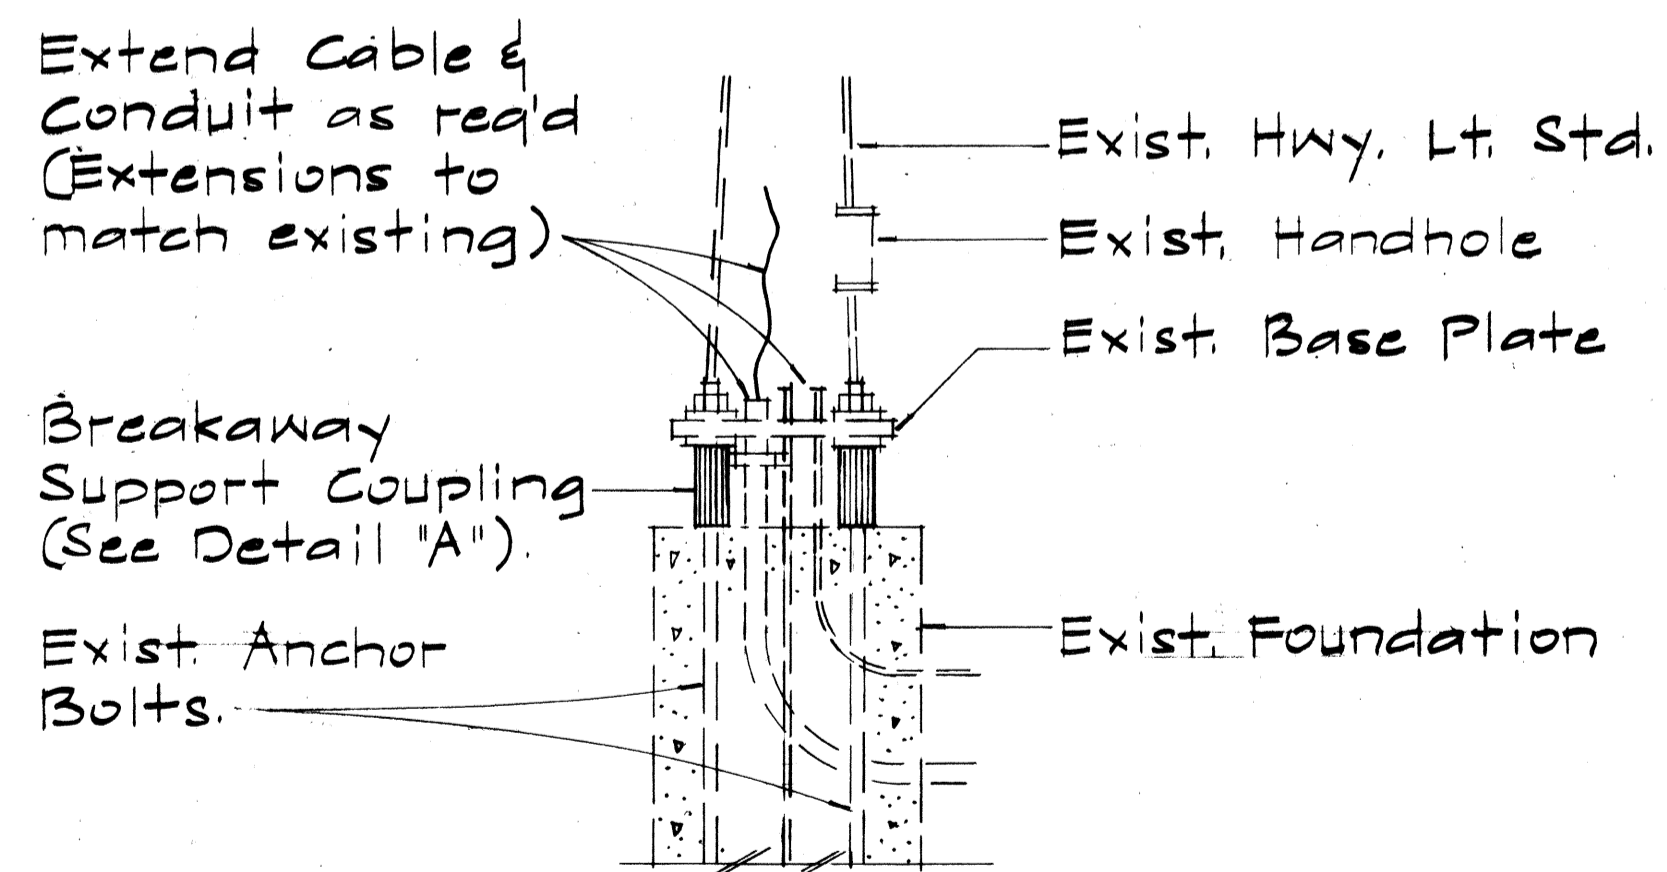

MOUNTING DETAIL

Scale: 3/4" = 1'-0"







GENERAL NOTES:

- Contractor shall verify size of exist. anchor bolts & base plates prior to ordering couplings & skirt covers.
- Breakaway support coupling shall conform to the applicable requirements of AASHTO standards & shall be fabricated from either die cast aluminum alloy 380 according to ASTM B385, or extruded from alloy 2024-T8511 according to ASTM B221.
- Hex. nut shall meet the requirements of ASTM A563 grade A, and ANSI B18.2.2.
- Torque nut shall be fabricated from aluminum alloy and grooved to separate at the specified torque.
- Threaded stud shall meet the requirements of ASTM A 675 grade 90 or AISI stainless steel.

STATE OF HAWAII
DEPARTMENT OF TRANSPORTATION
LAND TRANSPORTATION FACILITIES DIVISION
TYPICAL DETAILS
BREAKAWAY SUPPORT COUPLING & SKIRT COVER
FAI. PROJ. NO. IR-HI-1 (193)
Scale: As Shown
SHEET NO. 15 OF 19 SHEETS

DATE: _____
SURVEY PLOTTED BY: _____
DRAWN BY: _____
DESIGNED BY: _____
NOTE BOOK QUANTITIES BY: _____
CHECKED BY: _____
No. _____

FED. ROAD DIST. NO.	STATE	FED. AID PROJ. NO.	FISCAL YEAR	SHEET NO.	TOTAL SHEETS
HAWAII	HAW.	IR-11-1(193)	1986	53	62

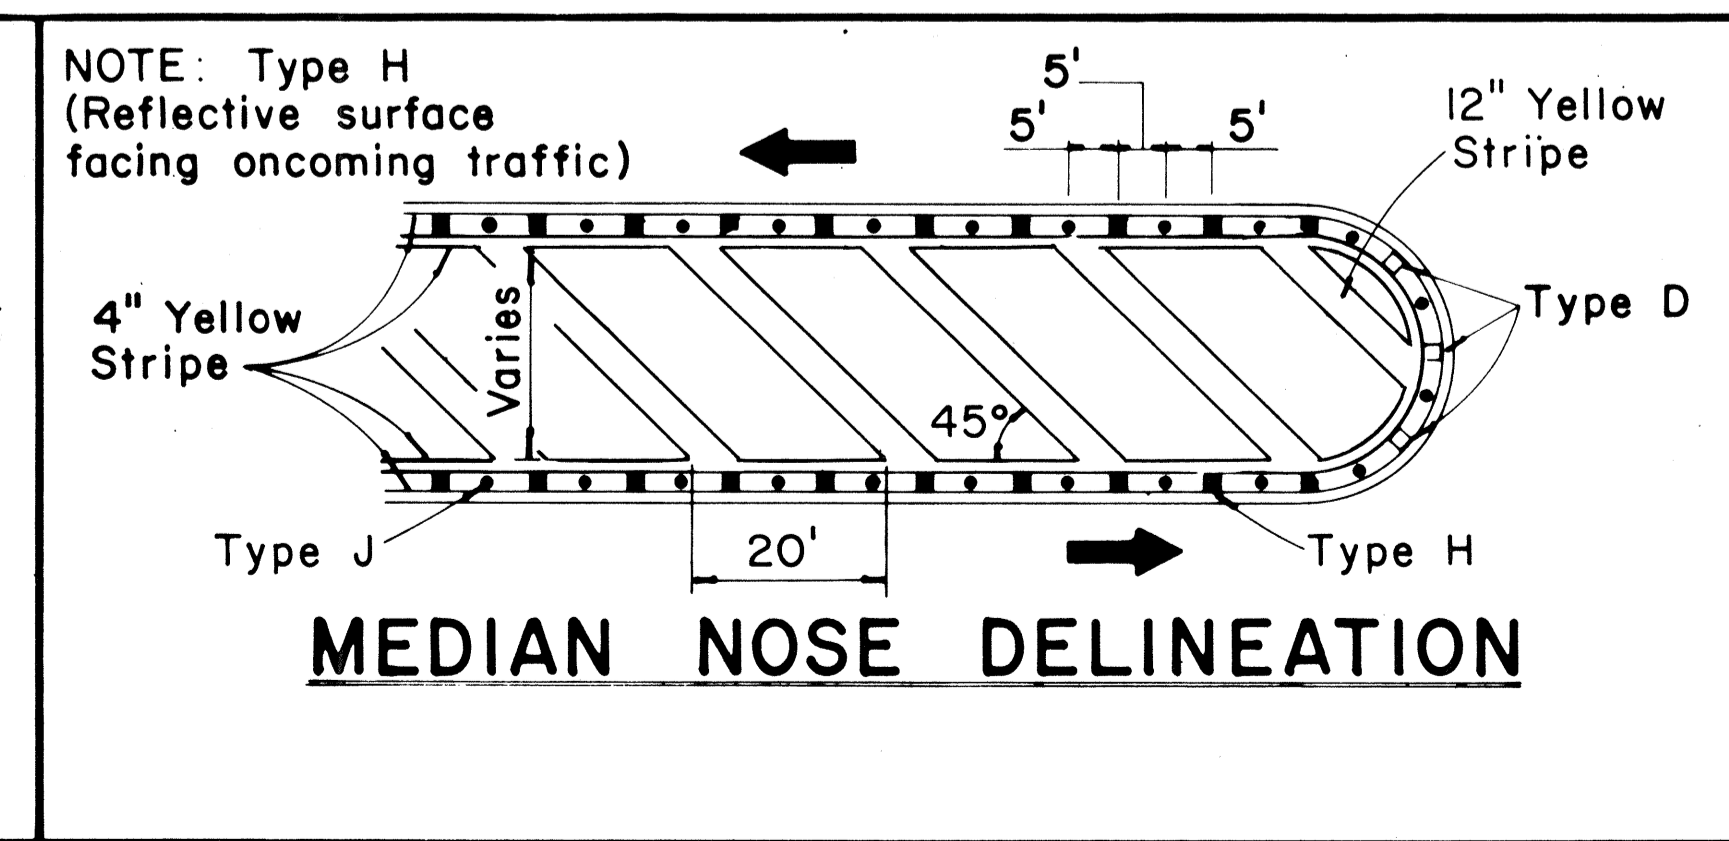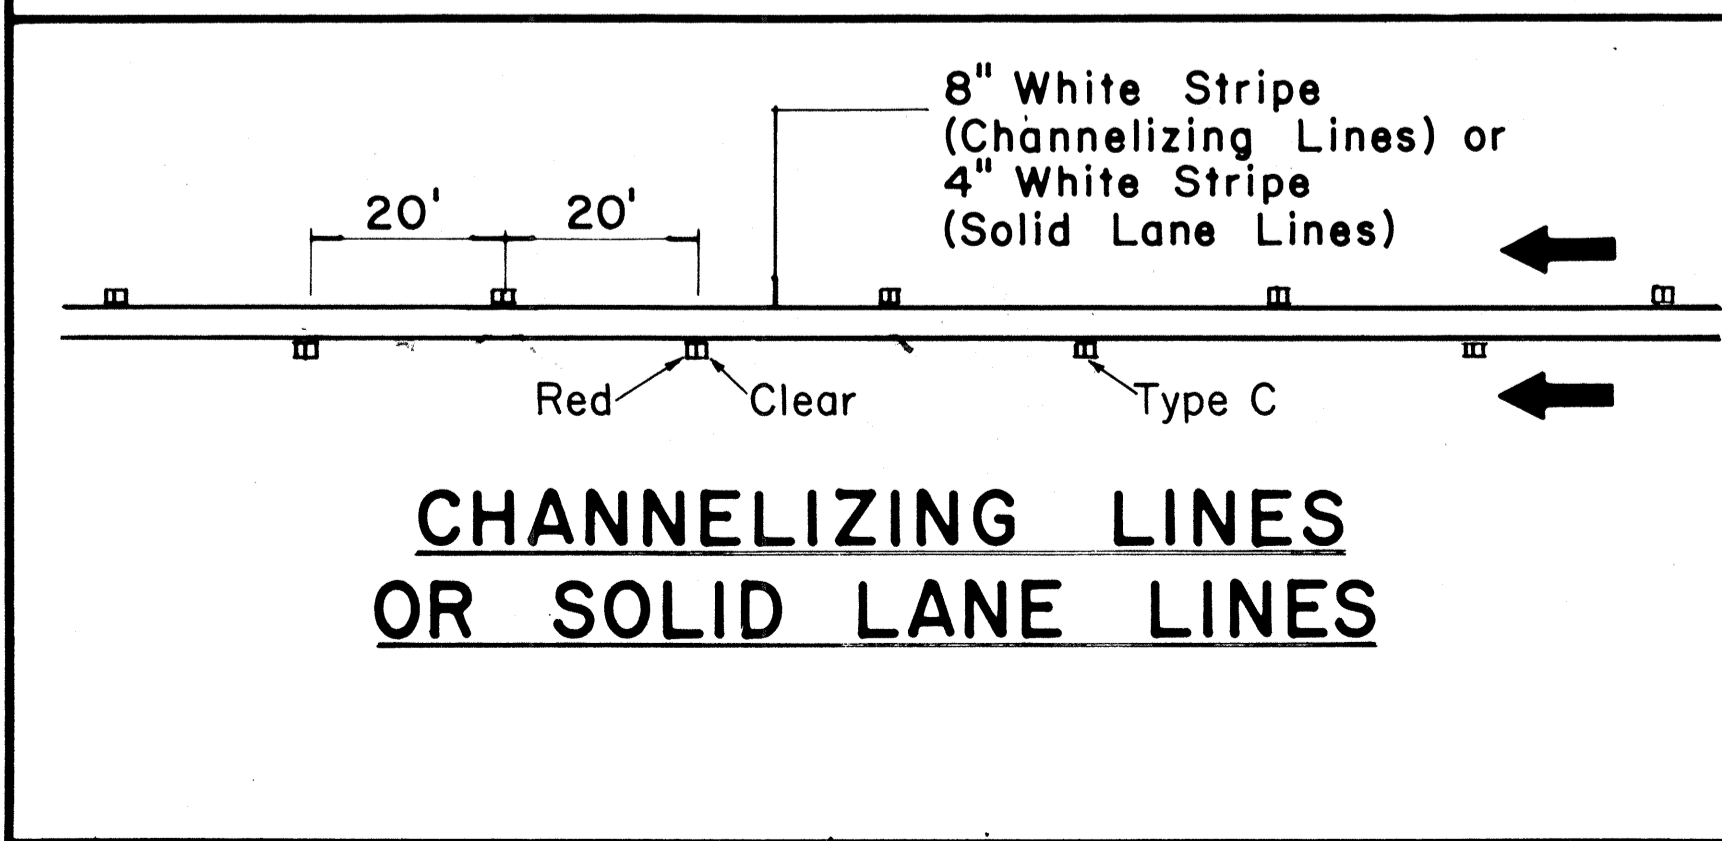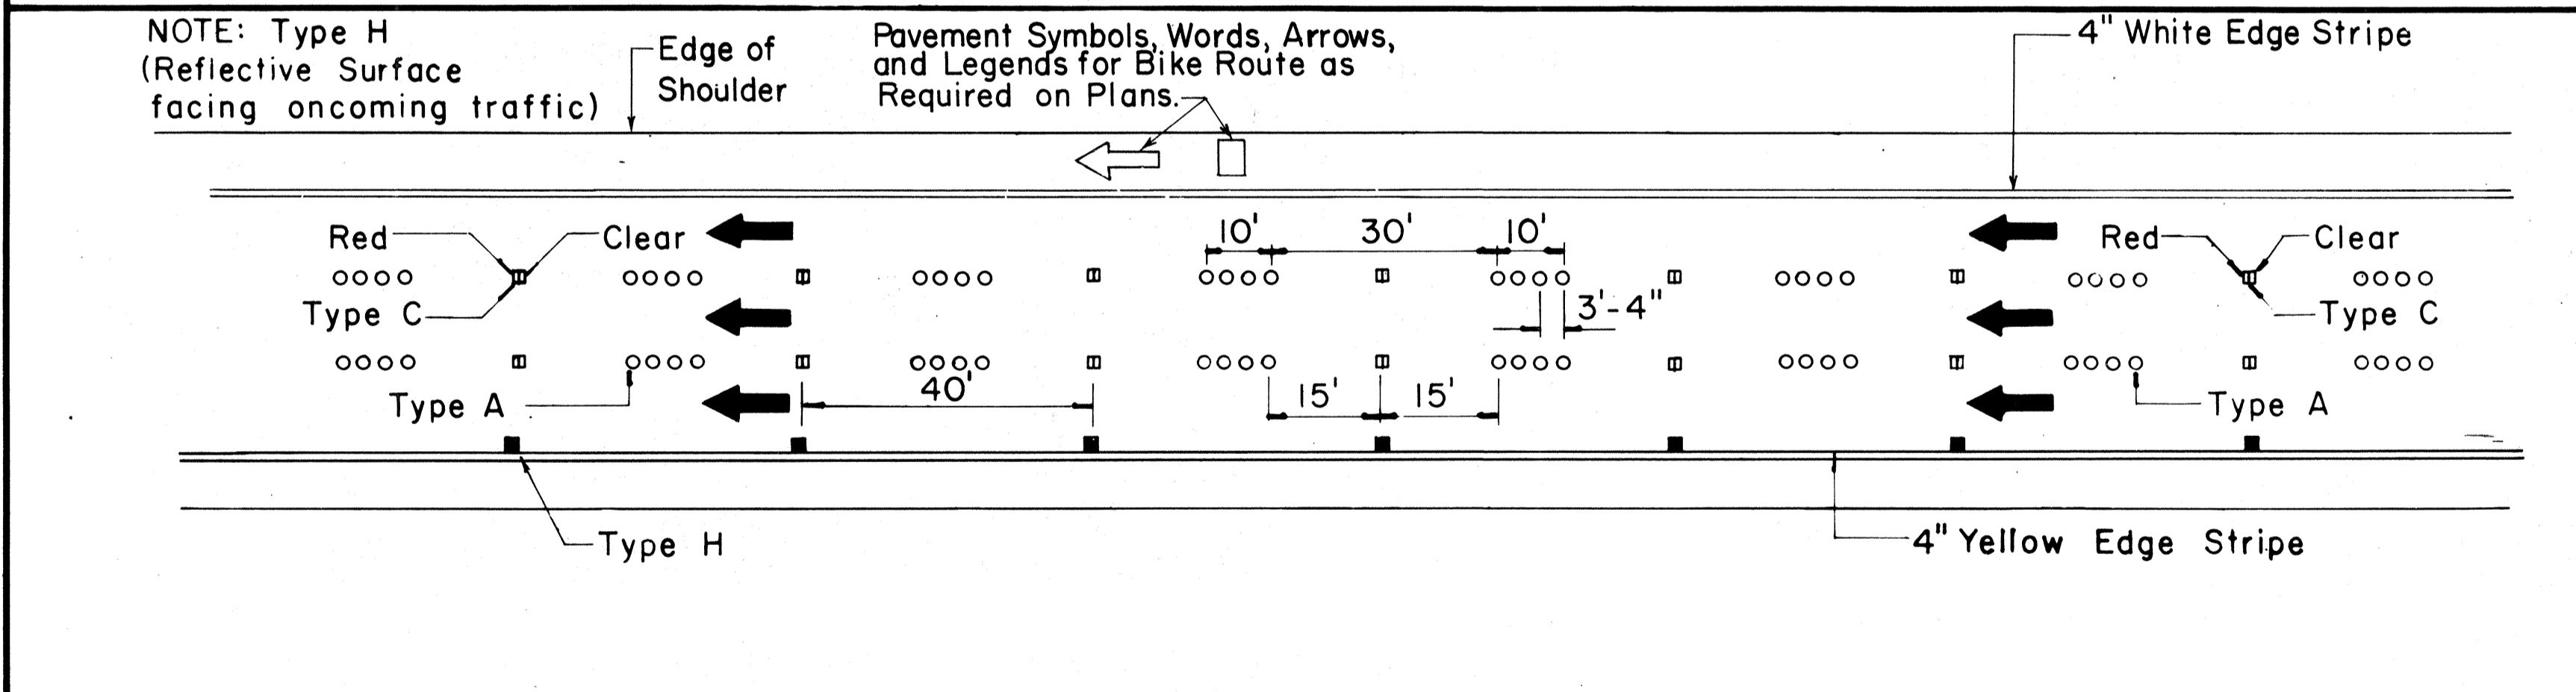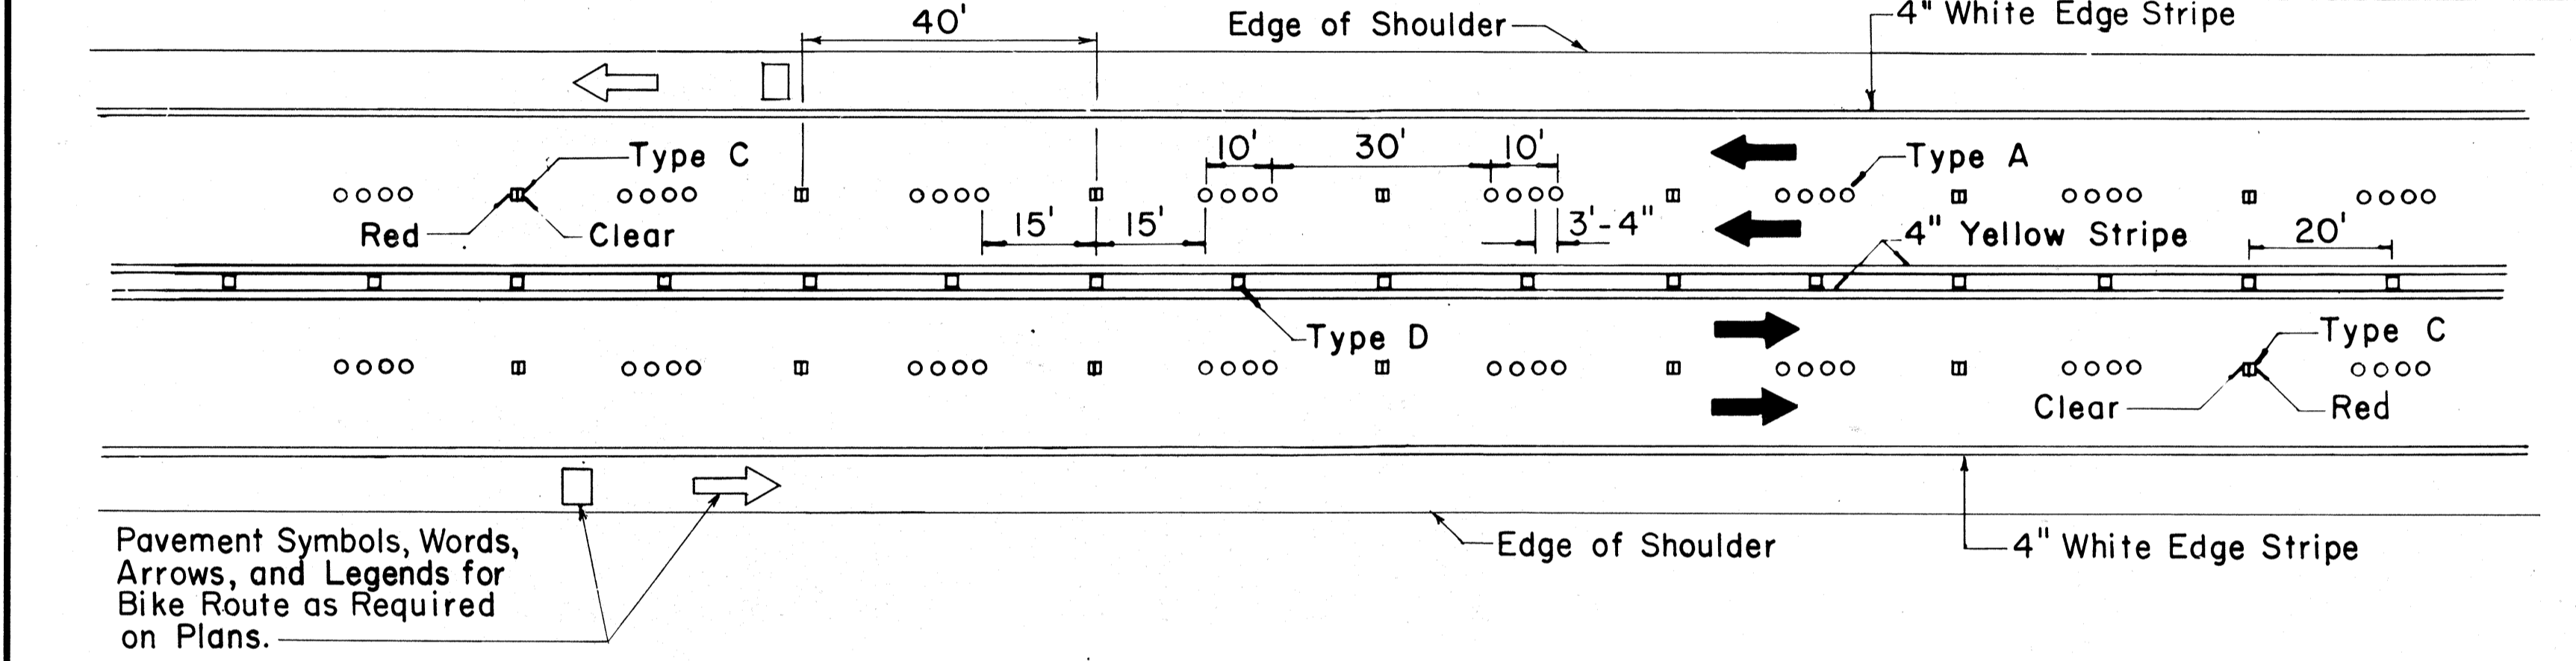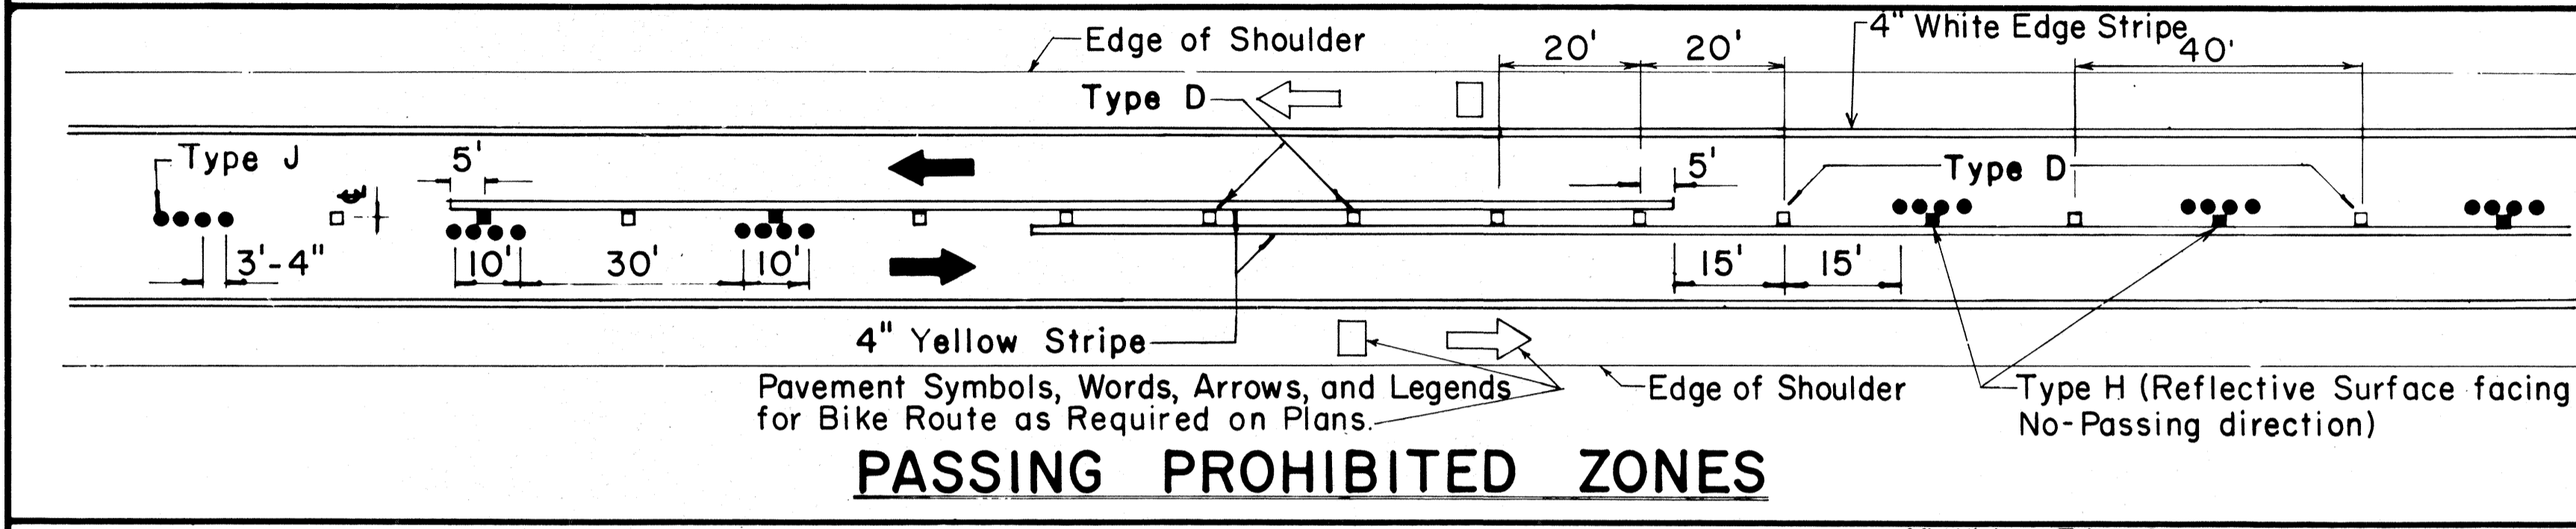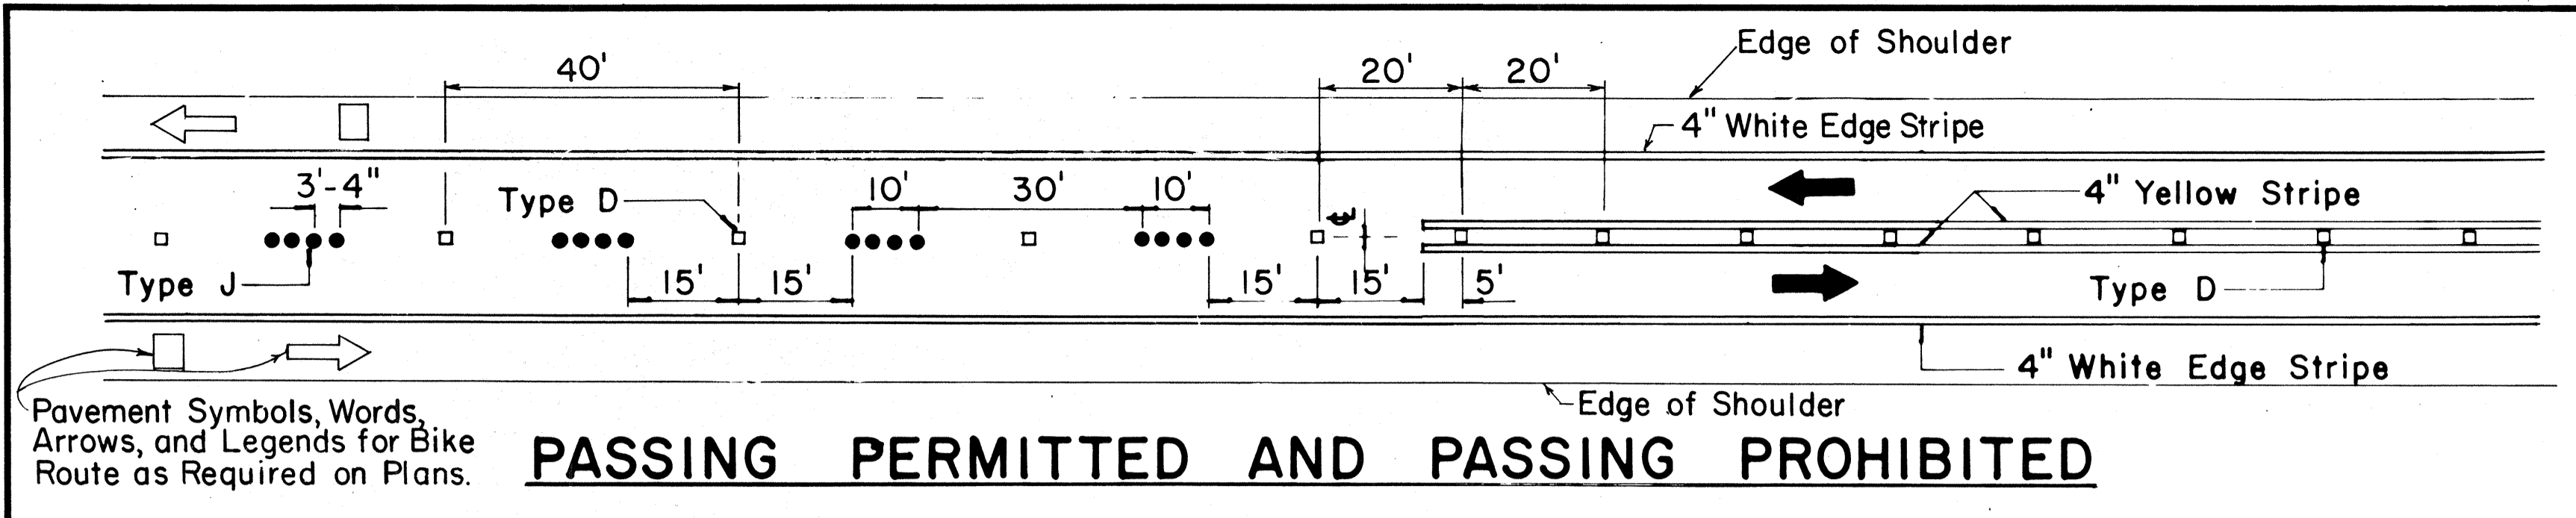


TWO - LANE


MULTI - LANE

DIVIDED HIGHWAY AND FREEWAY


MISCELLANEOUS

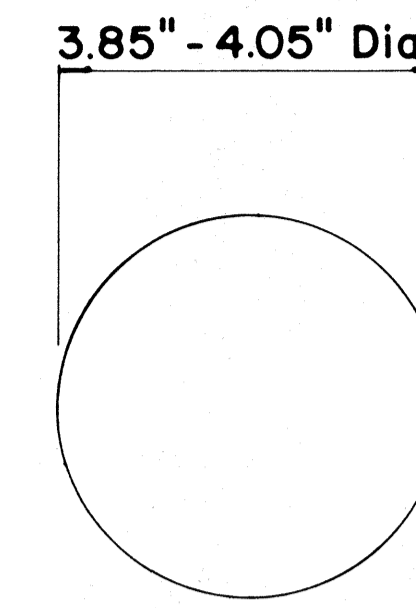


TYPE A
NON-REFLECTIVE WHITE MARKER

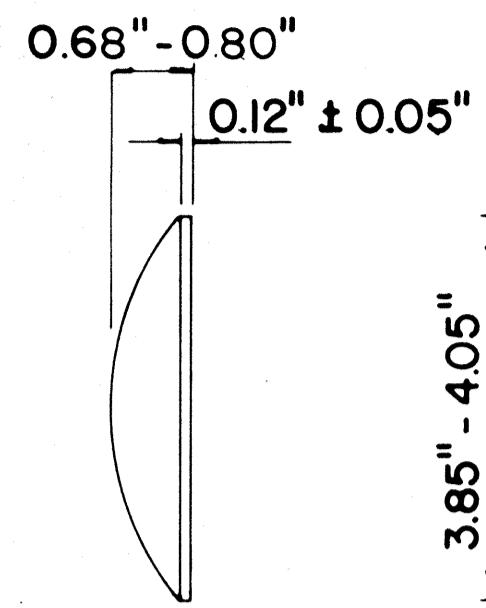


TYPE J
NON-REFLECTIVE YELLOW MARKER

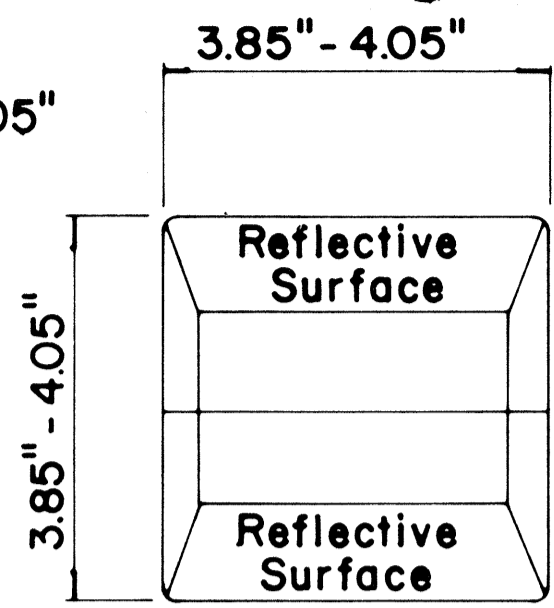


TYPE C
RED-CLEAR REFLECTIVE MARKER

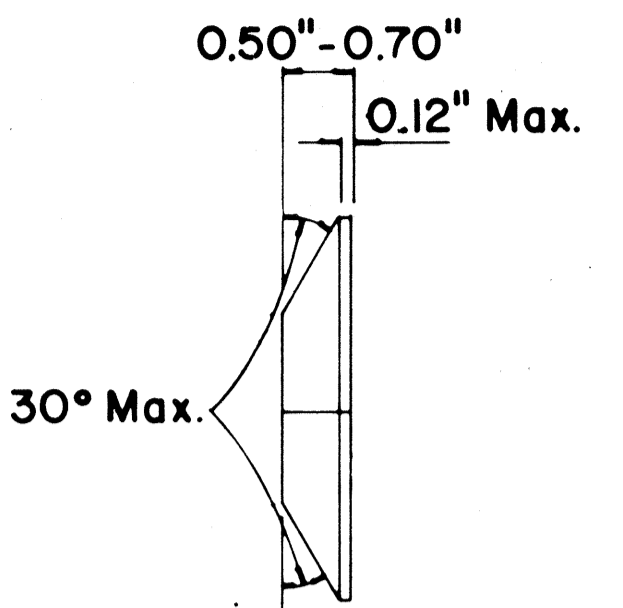

TYPE H
ONE-WAY YELLOW REFLECTIVE MARKER

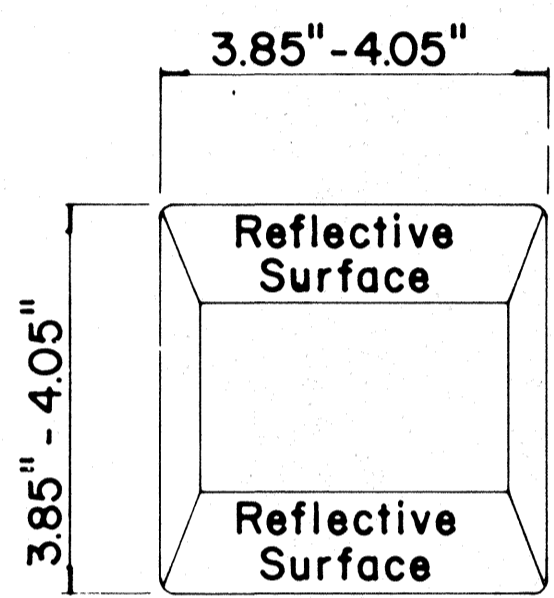

TYPE D
TWO-WAY YELLOW REFLECTIVE MARKER

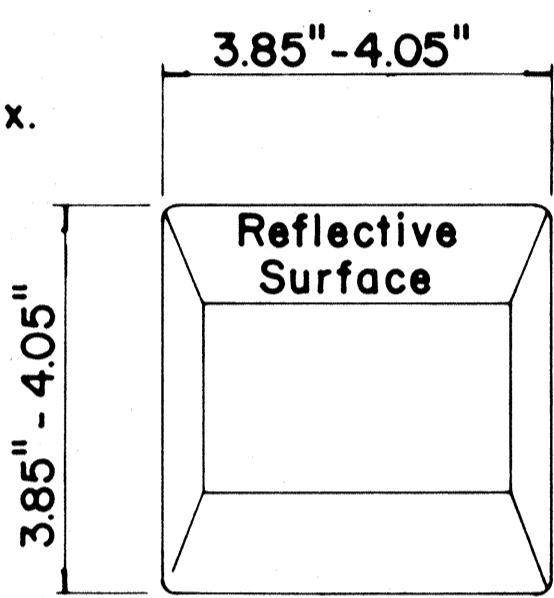

TYPE H
ONE-WAY YELLOW REFLECTIVE MARKER

GENERAL NOTES

1. Pavement marking and striping shall conform to the latest "Manual on Uniform Traffic Control Devices for Streets and Highways," and as amended.
2. Layout and installation of pavement marking and striping shall be done by the Contractor. The Contractor shall check the layouts with the Engineer prior to performing work.
3. Edge lines shall not be continued through intersections and shall not be broken for driveways unless otherwise shown or directed.

LEGEND

- Type A
- Type C
- Type D
- ▣ Type H
- Type J

APPROVAL RECOMMENDED:
Erick Tanaka 7/21/78
 TRAFFIC ENGINEER DATE

APPROVED:
Robert J. Zakeich 1/24/78
 ASSISTANT CHIEF, ENGINEERING DATE

No.	REVISION	APPROVED BY	DATE
1	Supersedes DT 300 approved 11/18/71.	H.T.	1/24/78
2	Delete Type A Markers from Bike Route Delineation.	H.T.	10/15/79
3	Added General Note 3. Revised left edge stripe.	J.D.	9-28-83
4	Revised Channelizing Lines or Solid Lane Lines.	E.T.	9/18/85



STATE OF HAWAII
 DEPARTMENT OF TRANSPORTATION
 HIGHWAYS DIVISION

STANDARD DETAILS
RAISED PAVEMENT MARKERS
AND STRIPING

Not to Scale July 1978
 SHEET No. 116 OF 19 SHEETS DT 300







SURVEY PLANNED BY: _____ DATE: _____
 DESIGNED BY: _____
 NOTE BOOK: _____
 QUANTITIES BY: _____
 CHECKED BY: _____

FED. ROAD DIST. NO.	STATE	FED. AID PROJ. NO.	FISCAL YEAR	SHEET NO.	TOTAL SHEETS
HAWAII	HAW.	IR-11-1(198)	1986	54	62

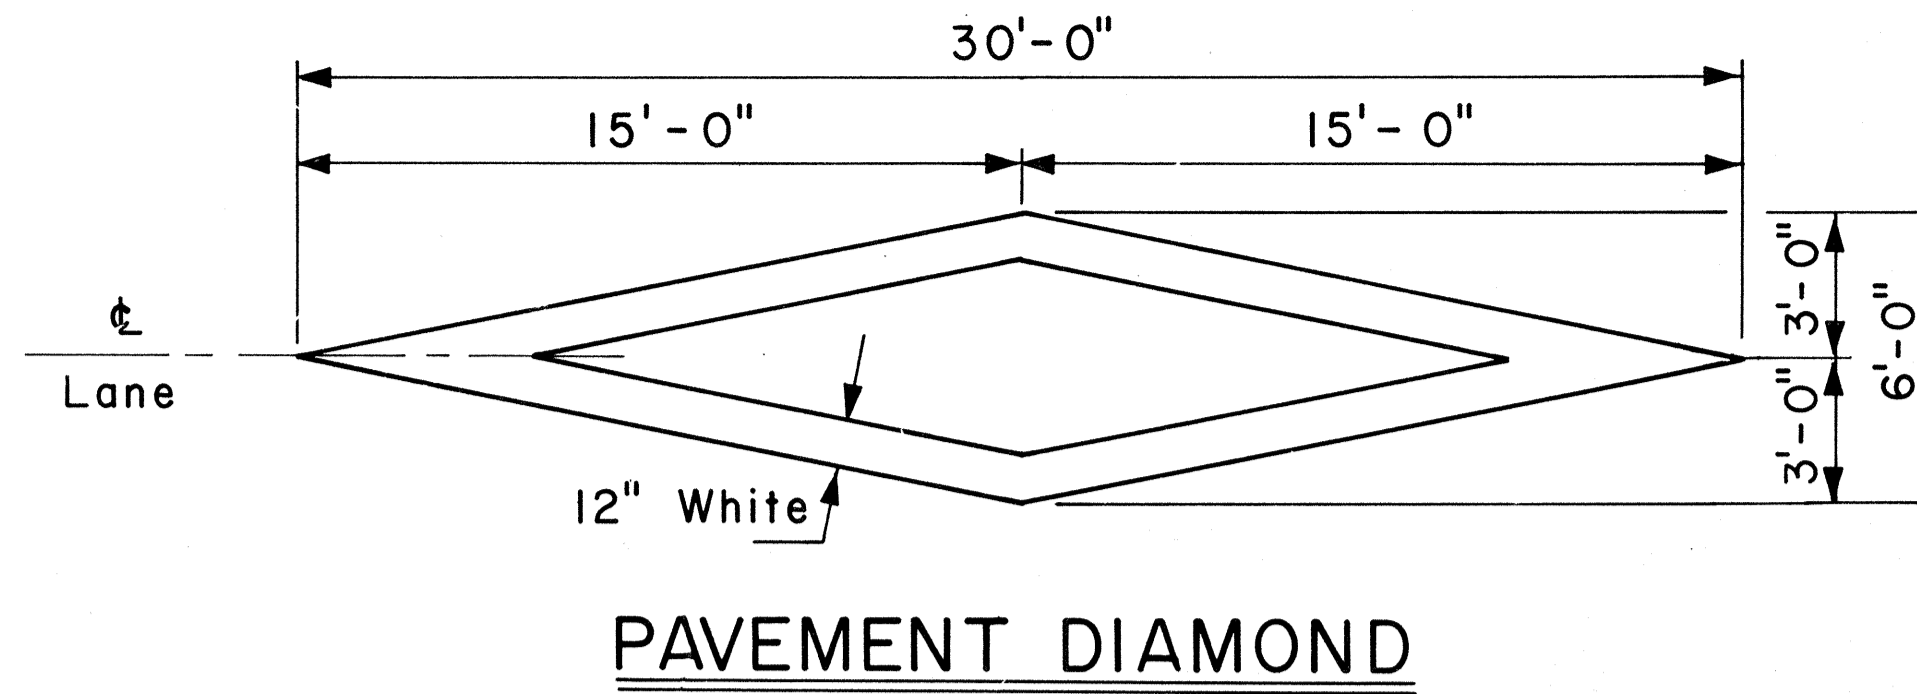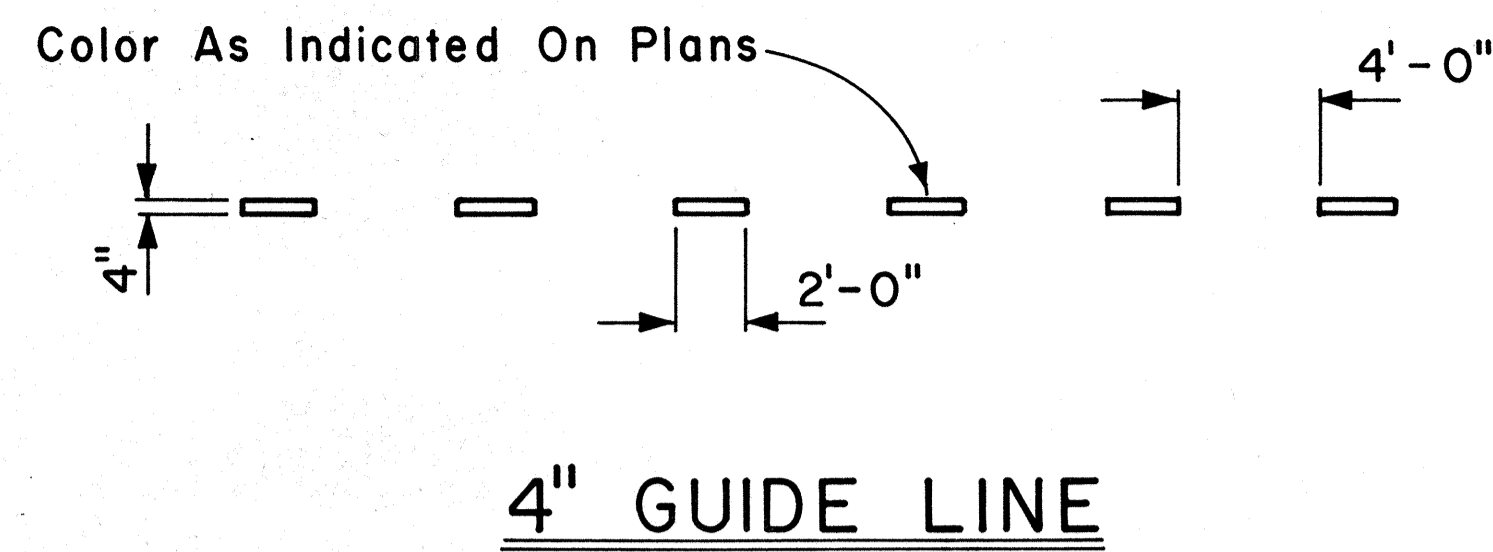

GENERAL NOTES:

1. Pavement marking and striping shall conform to the latest edition of the "Manual on Uniform Traffic Control Devices for Streets and Highways," by the FHWA, and as amended.
2. Layout of pavement markings and striping shall be done by the Contractor. The Contractor shall check layout of markings and striping with the Engineer prior to performing work.
3. For additional pavement marking details, see sheet DT 300.

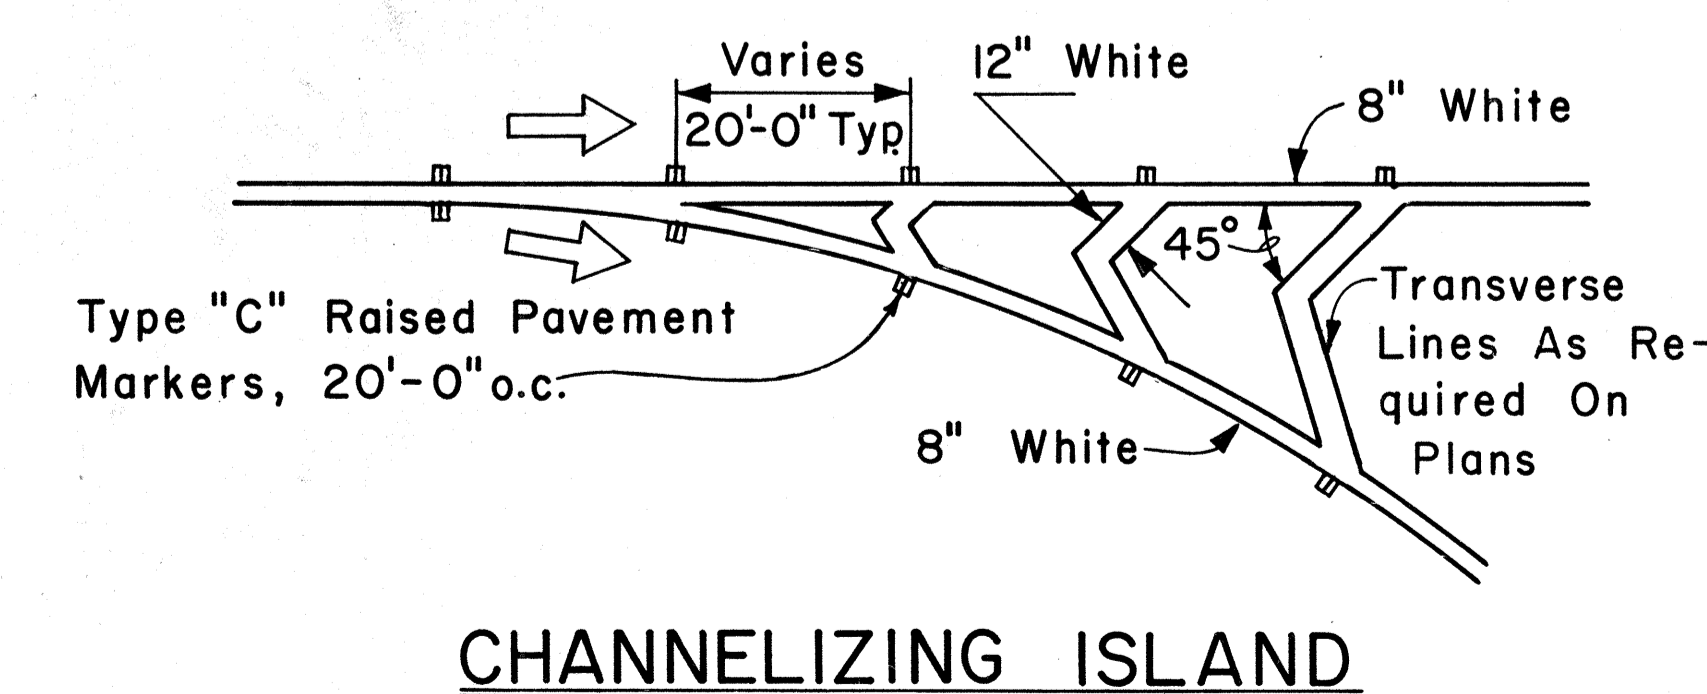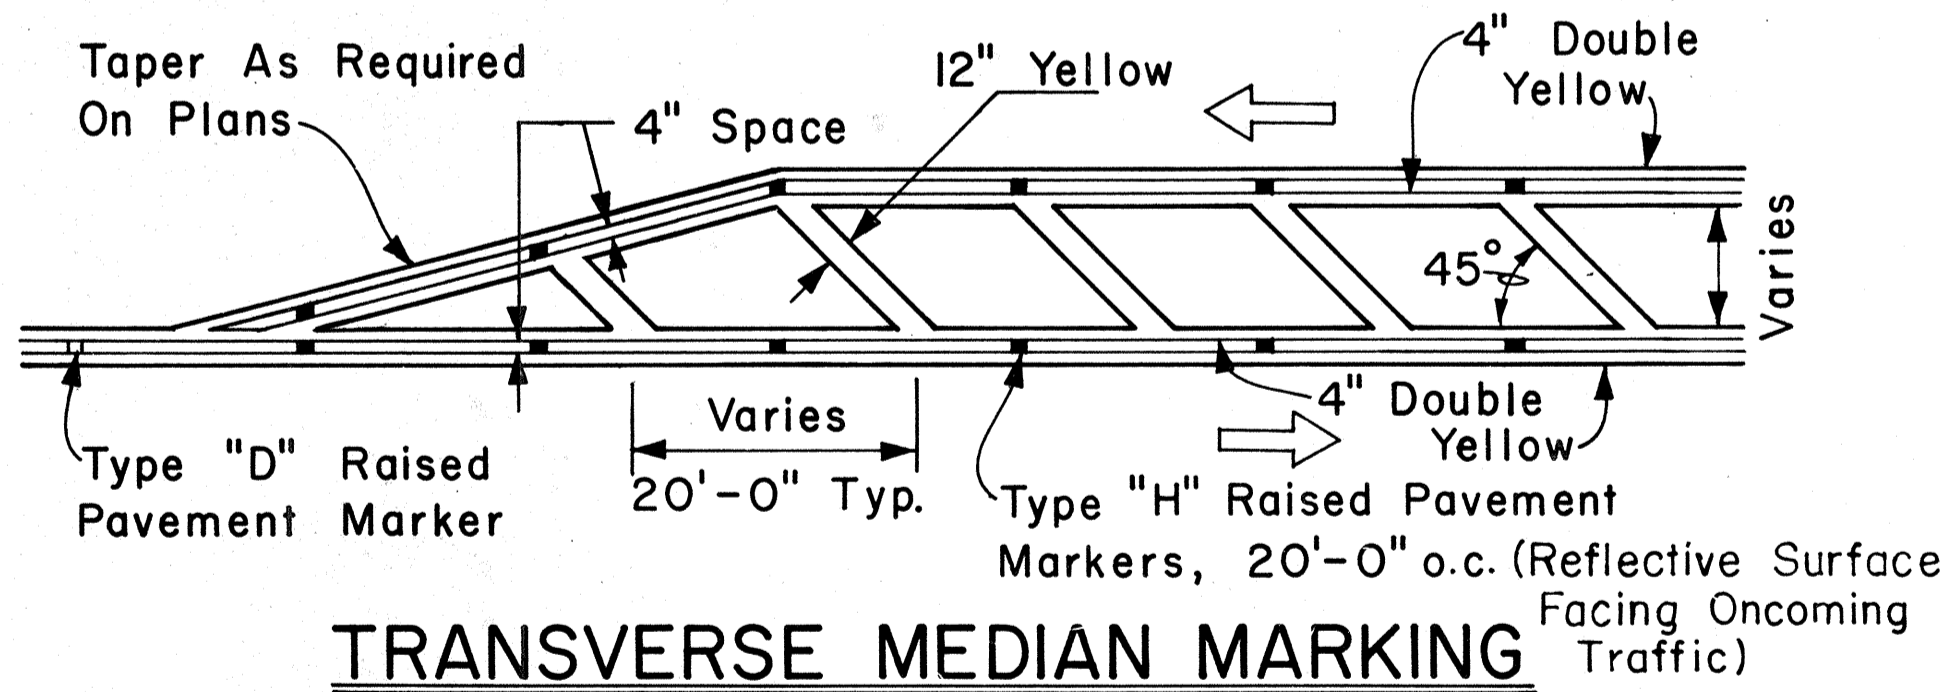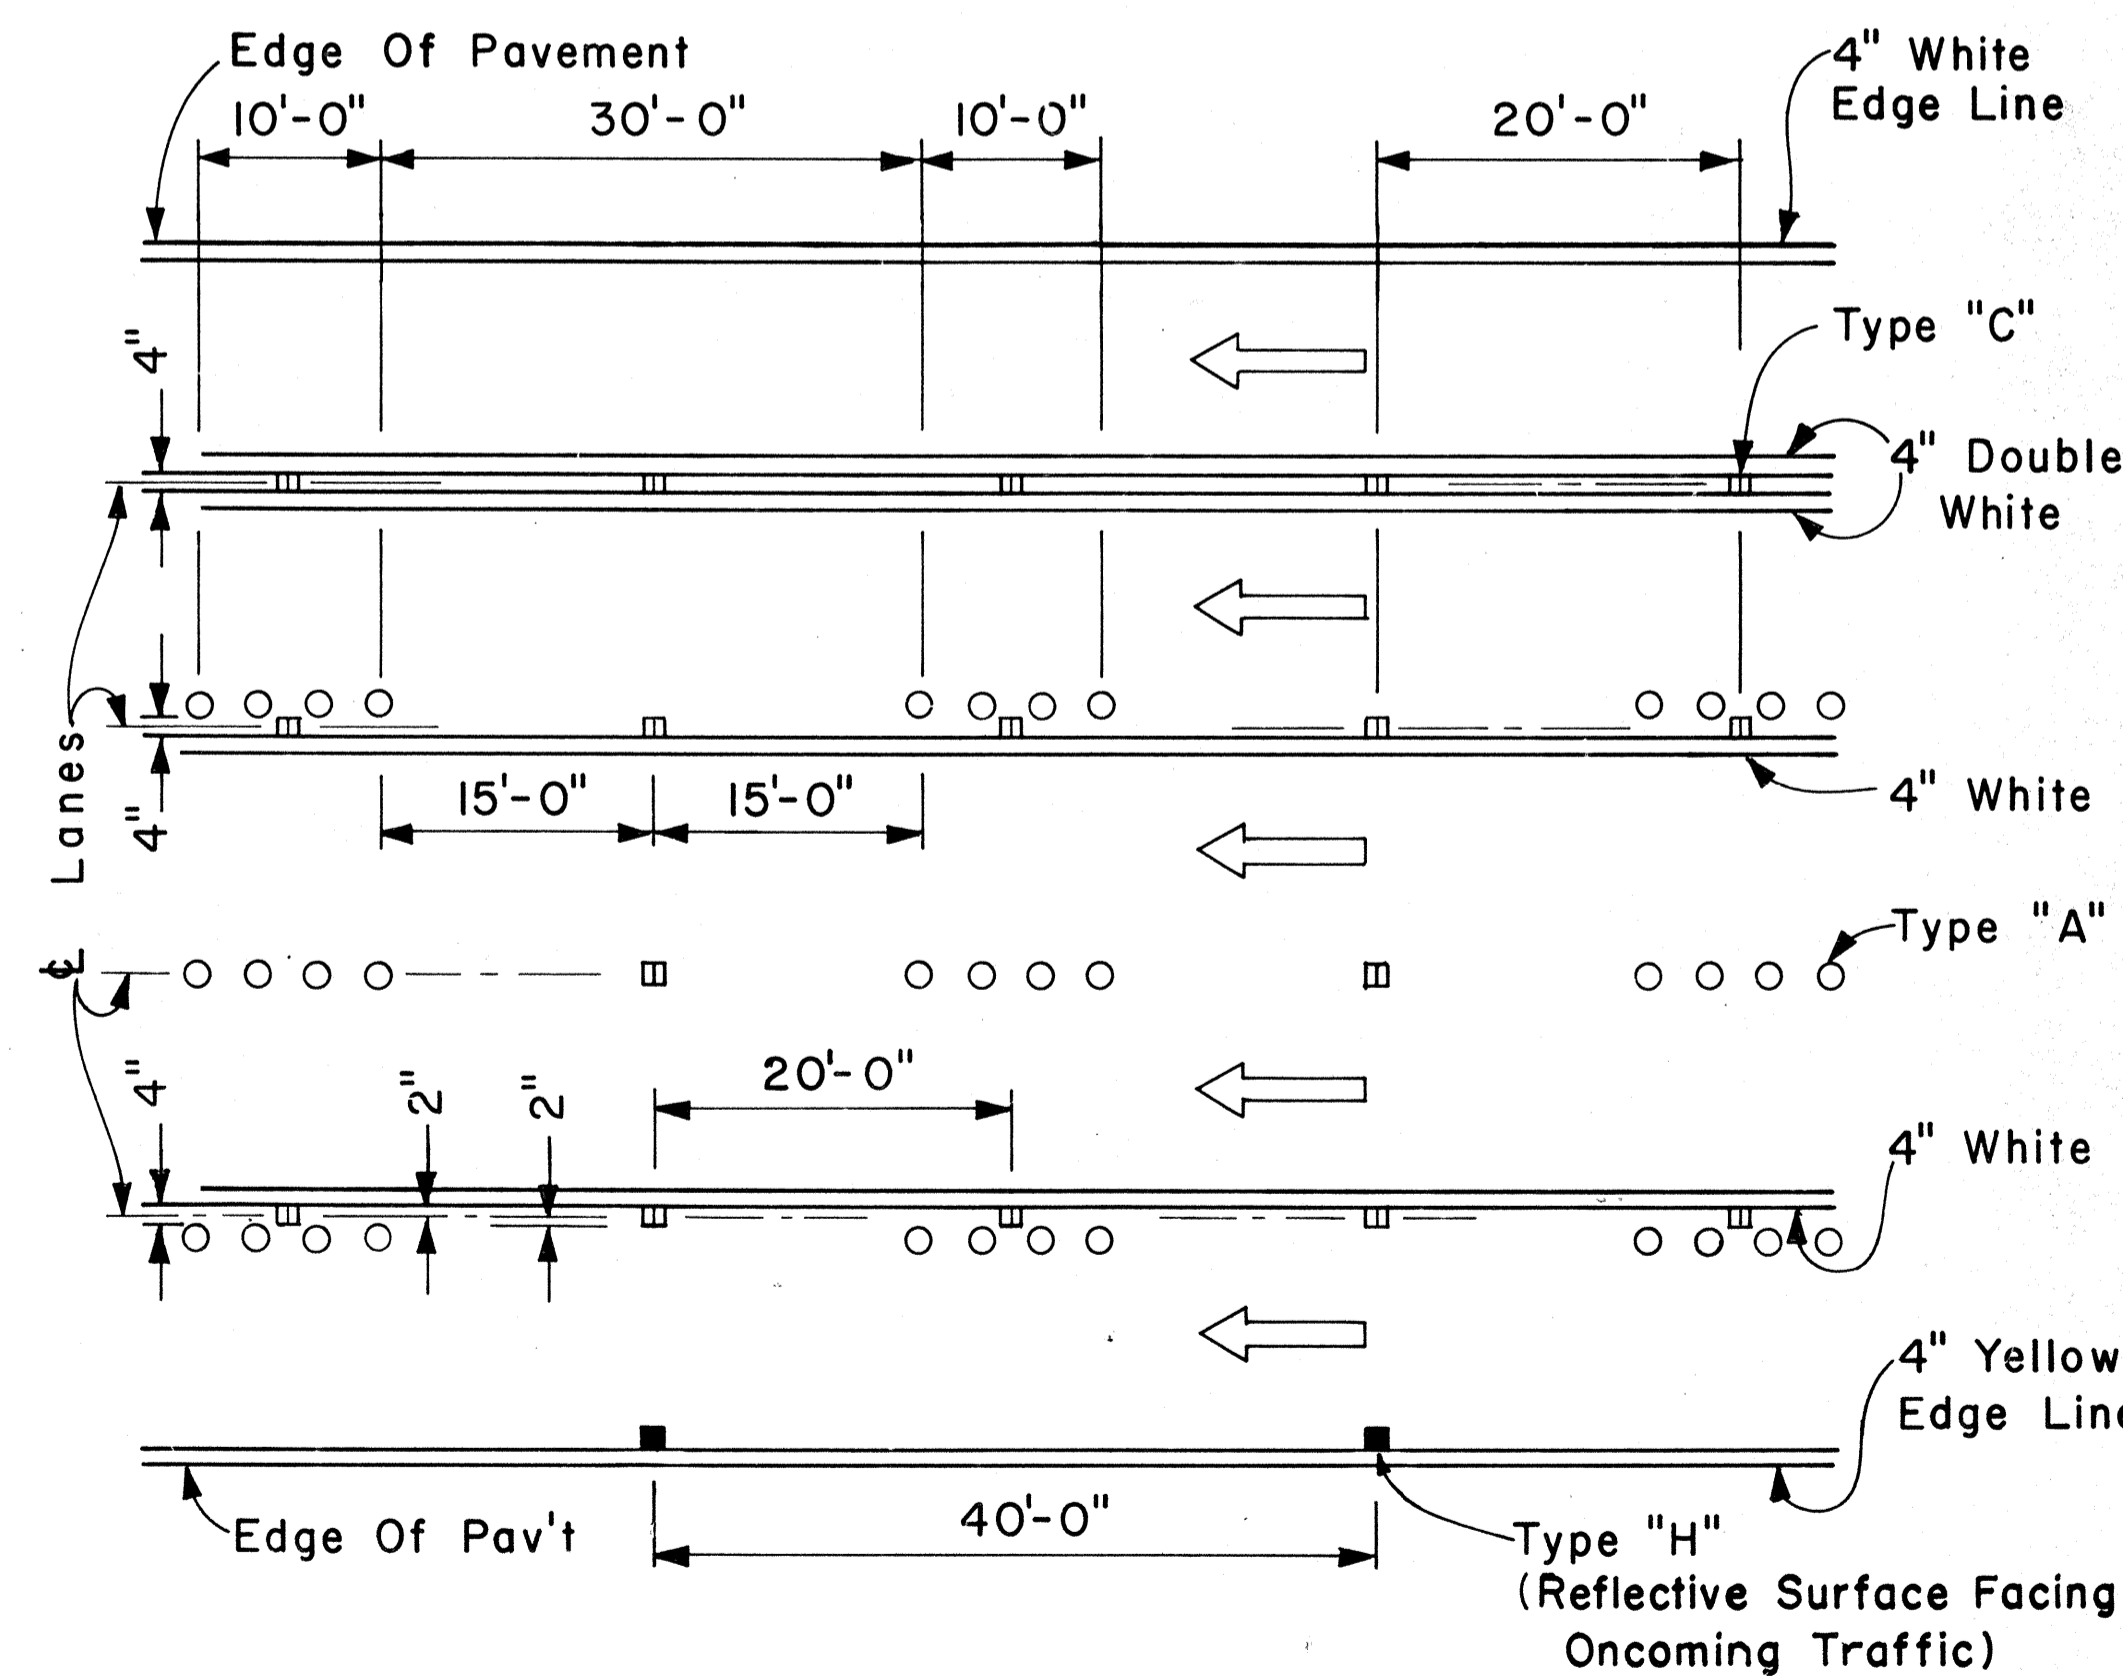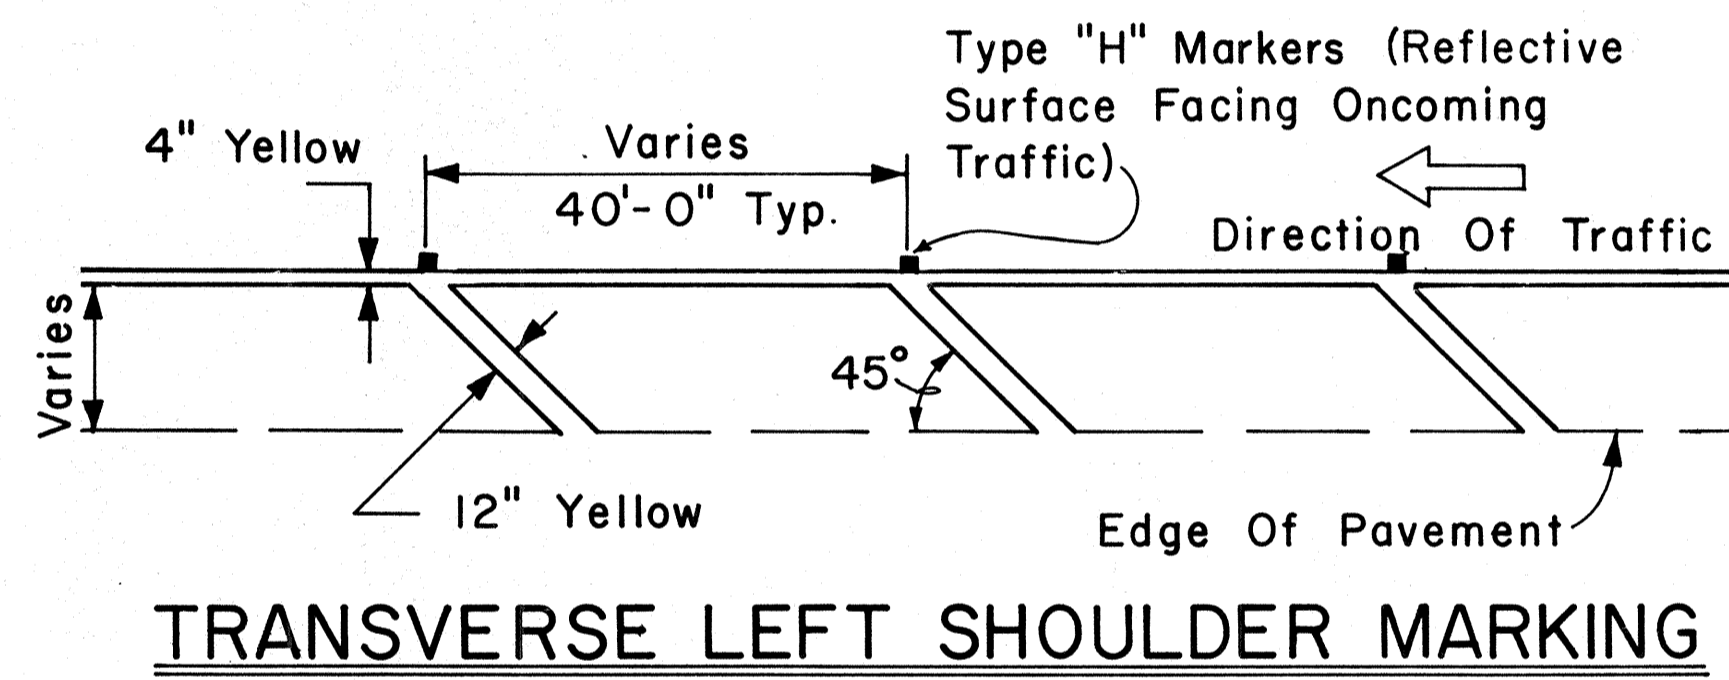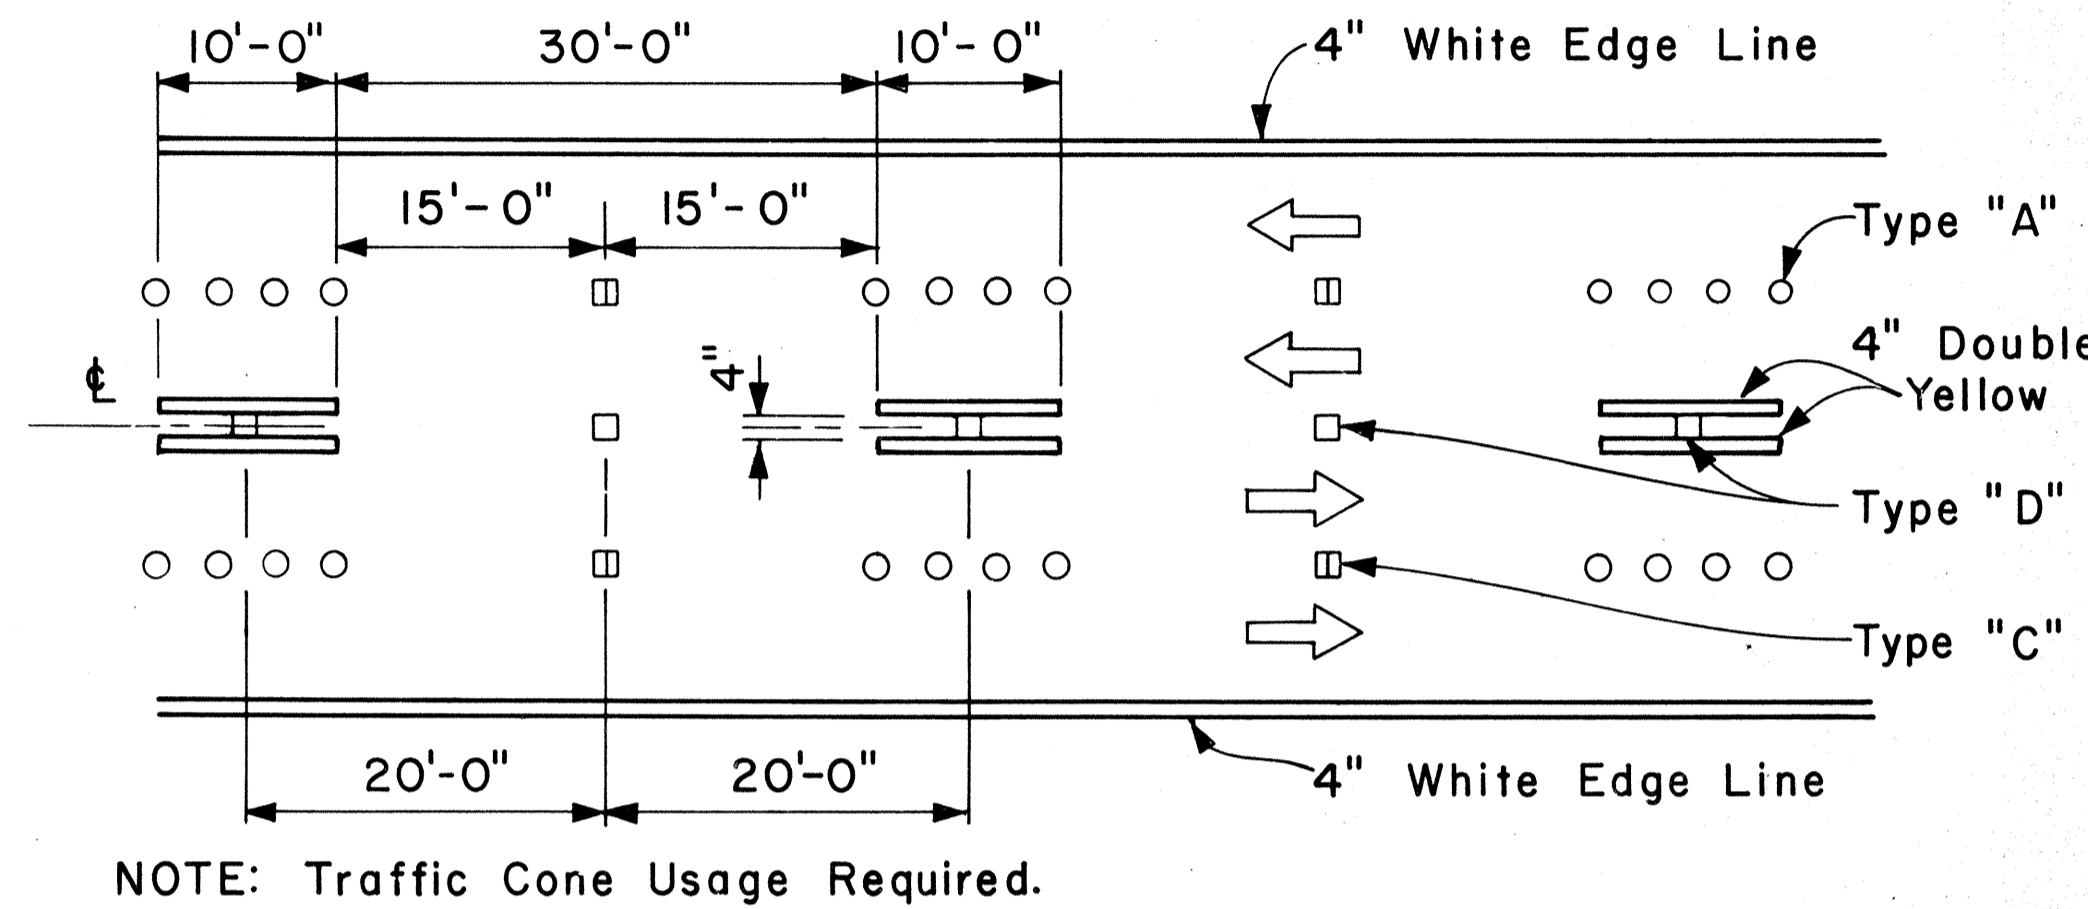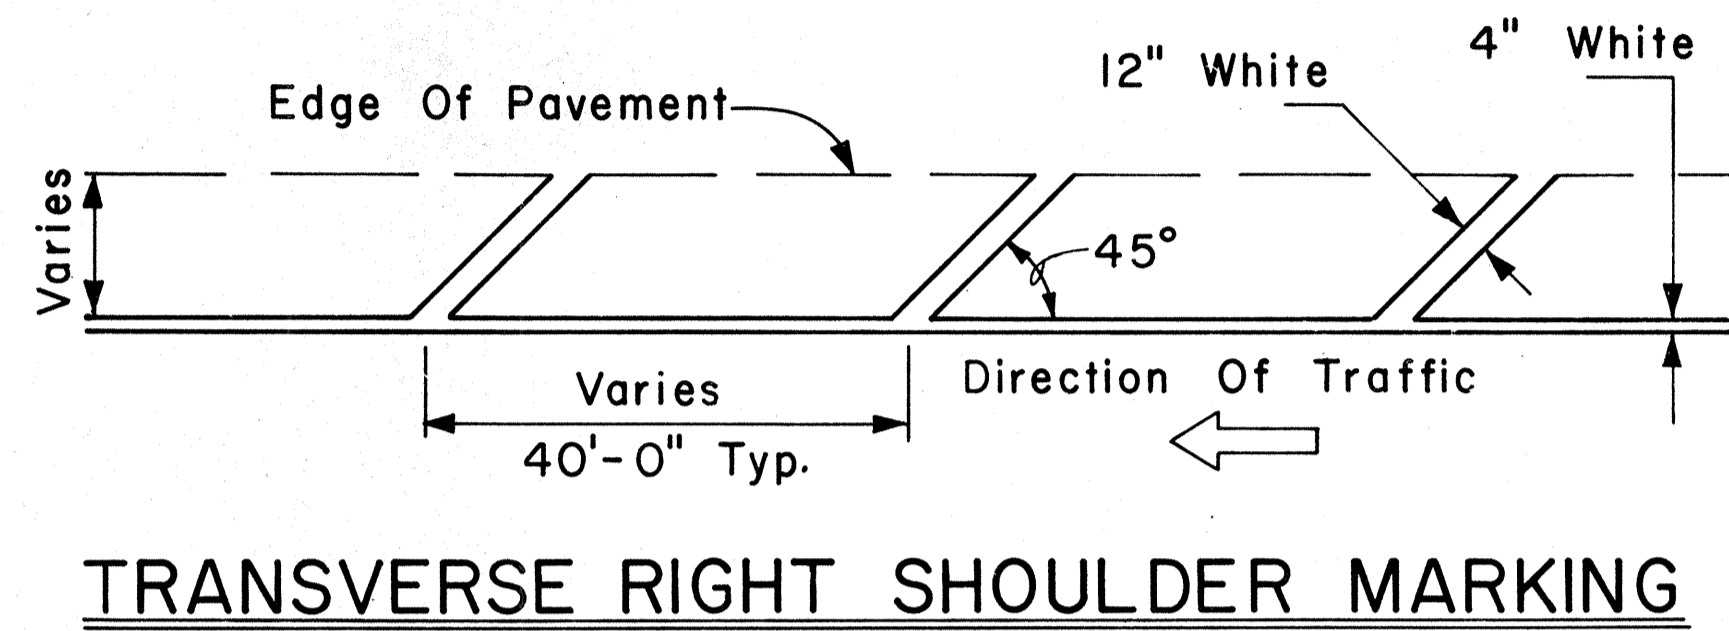

APPROVAL RECOMMENDED: E. T. Tanaka 5/2/78
TRAFFIC ENGINEER DATE

APPROVED: Robert Z. Zabelew 5/2/78
ASSISTANT CHIEF, ENGINEERING DATE

NO.	REVISION	APPROVED BY	DATE
1	Revised Transverse left Shoulder Marking, Channelizing Island & Lane Change Restriction Zones.	E.T.	7/18/85

STATE OF HAWAII
DEPARTMENT OF TRANSPORTATION
HIGHWAYS DIVISION

STANDARD DETAILS

MISCELLANEOUS
PAVEMENT MARKINGS

Scale: Not to Scale Date: April, 1978

SHEET NO. 17 OF 19 SHEETS DT 302





ORIGINAL PLAN
DESIGNED BY
NOTE BOOK
CHECKED BY

FED. ROAD DIST. NO.	STATE	FED. AID PROJ. NO.	FISCAL YEAR	SHEET NO.	TOTAL SHEETS
HAWAII	HAW.	IR-HI-1(123)	1986	55	62

GENERAL NOTES:

1. Pavement Markings and Striping shall conform to the latest edition of the "Manual on Uniform Traffic Control Devices for Streets and Highways," by the FHWA, and as amended.
2. Layout of Pavement Markings and Striping shall be done by the Contractor. The Contractor shall check layout of markings and striping with the Engineer prior to performing work.
3. For additional details, see sheet DT 300.

TAPERED DECELERATION LANE
 PARALLEL DECELERATION LANE
 TAPERED ACCELERATION LANE
 PARALLEL ACCELERATION LANE
 TYPICAL ROADWAY EXIT MARKINGS
 TYPICAL ROADWAY ENTRANCE MARKINGS

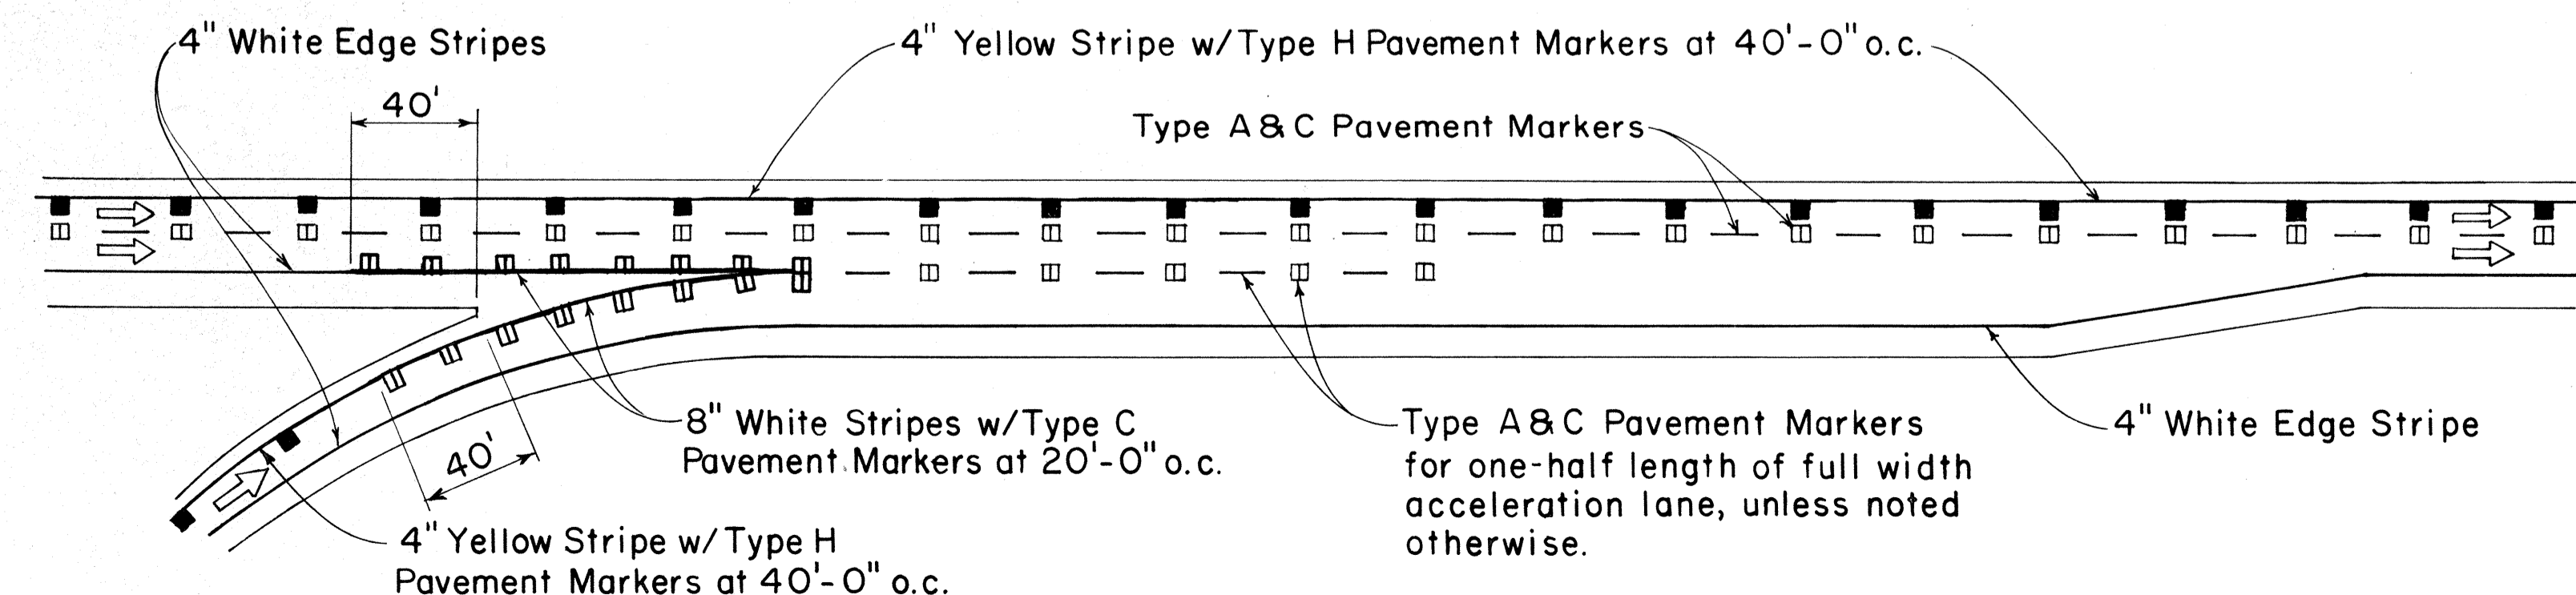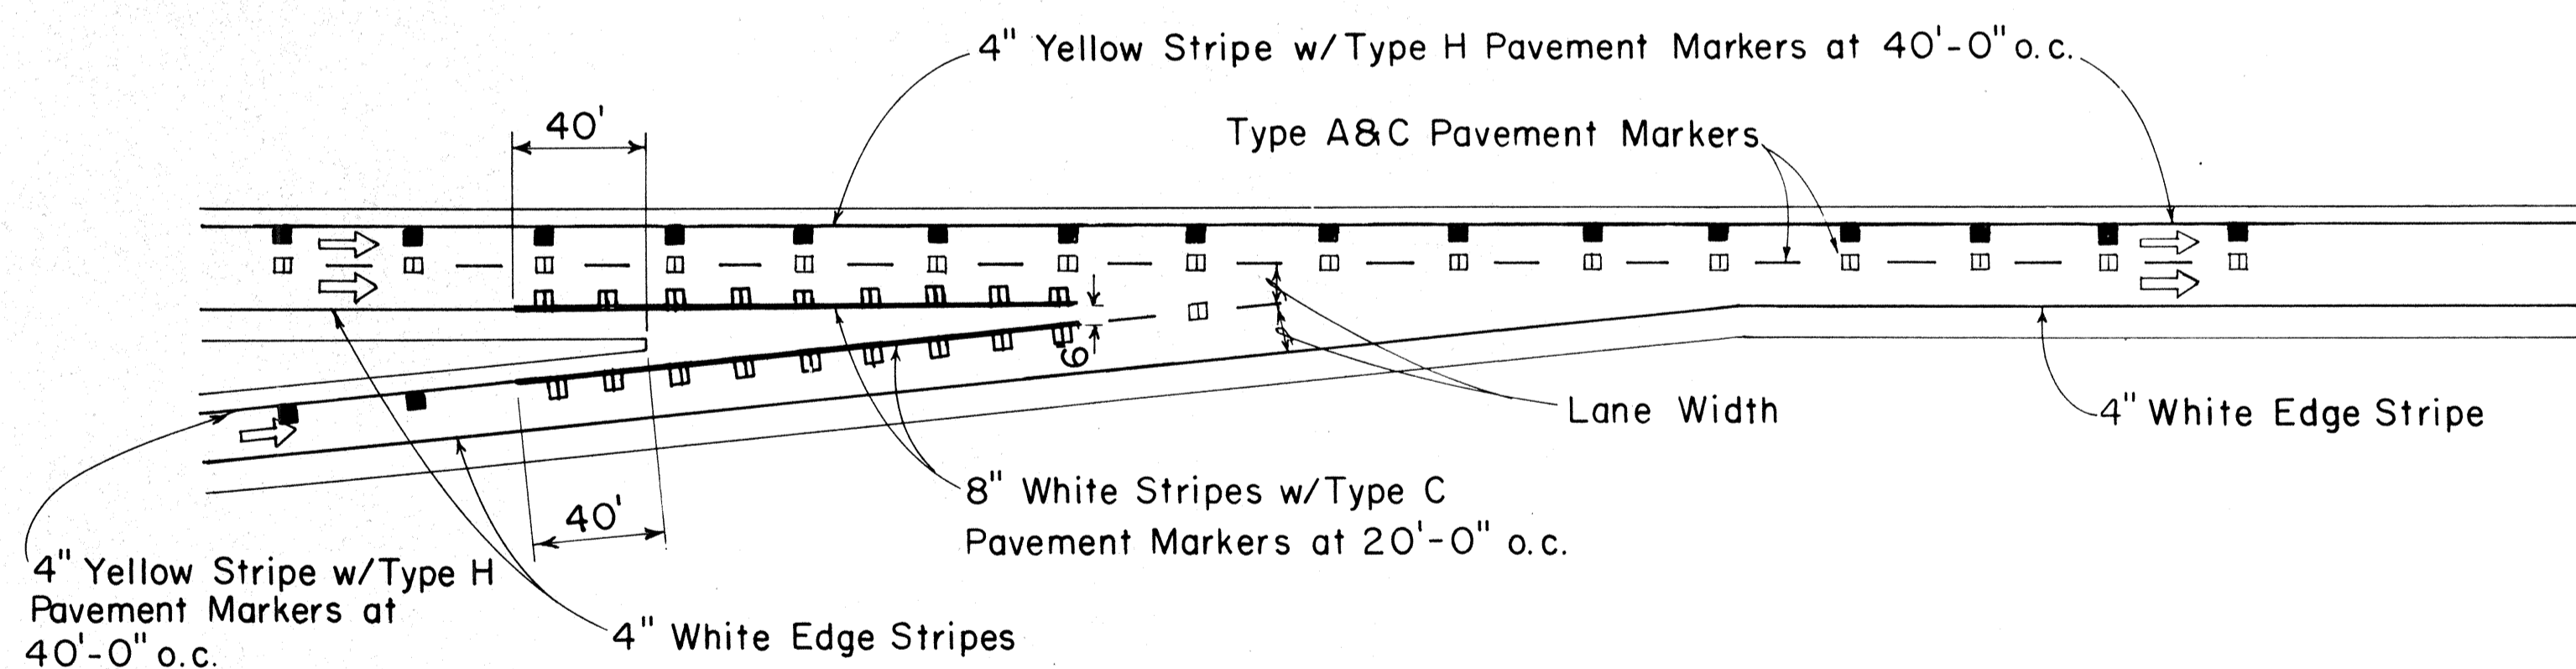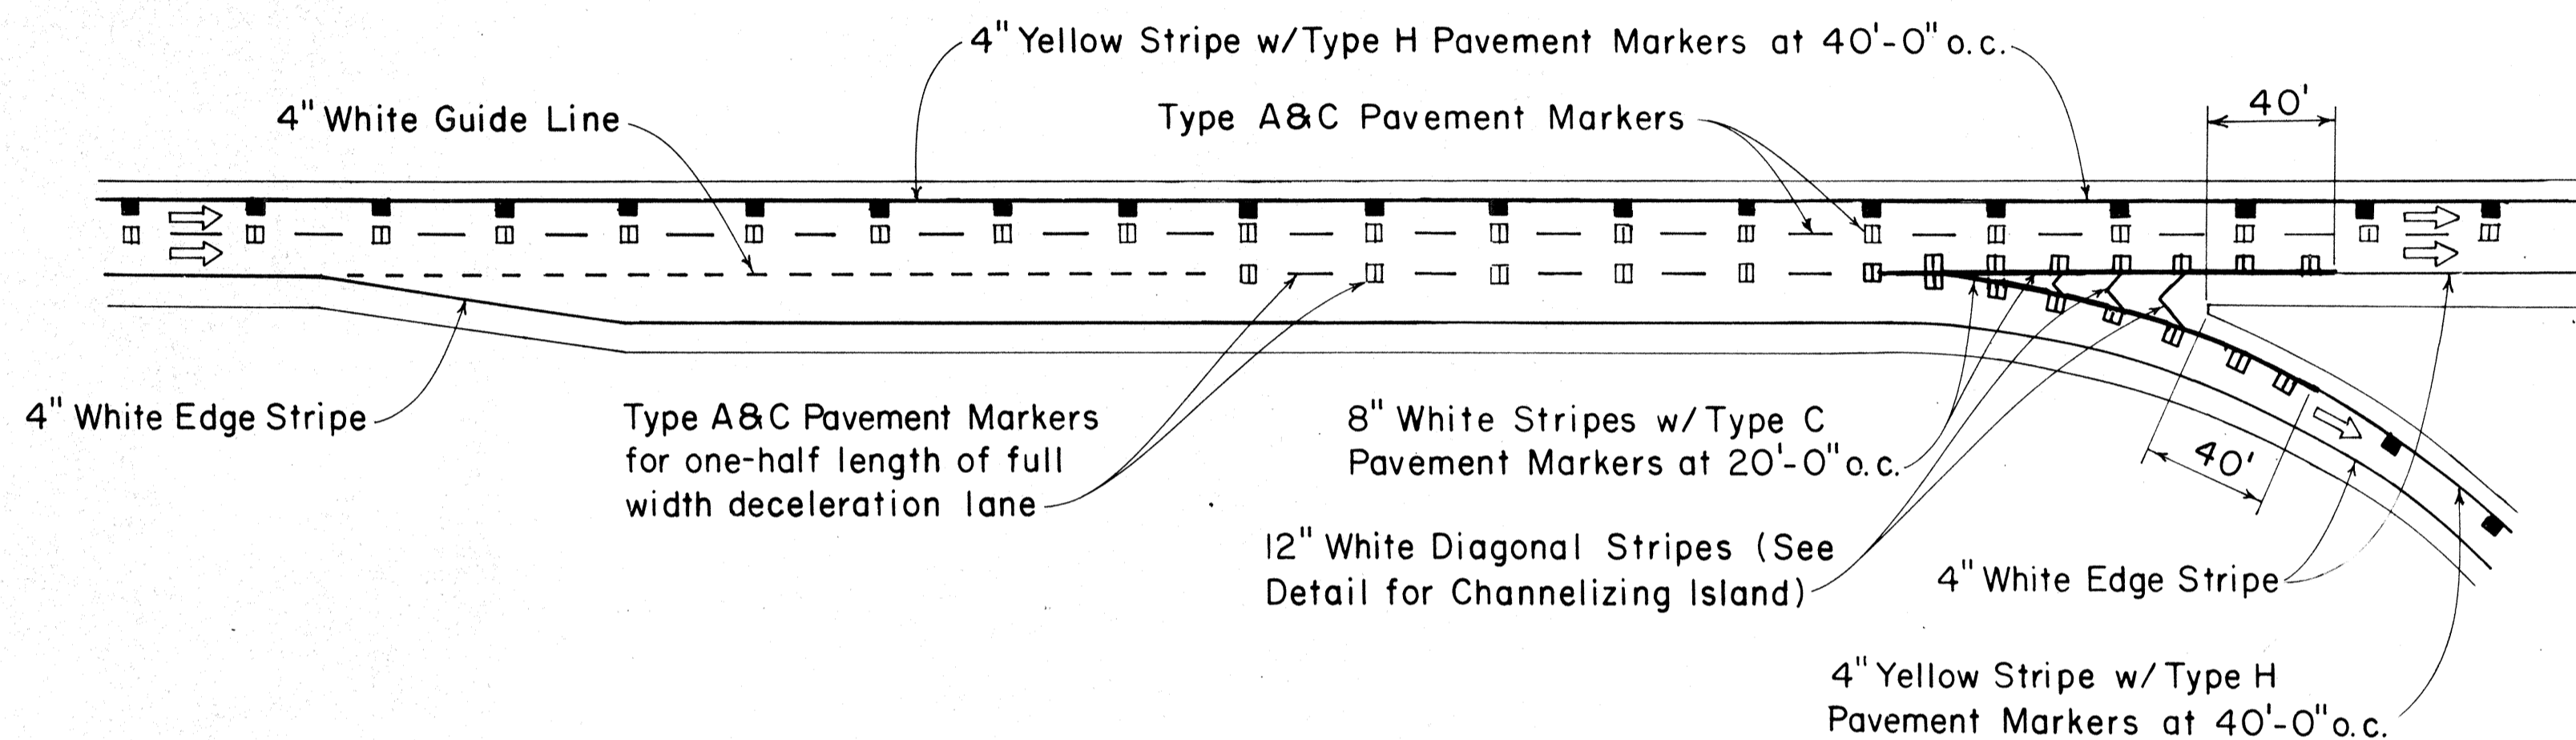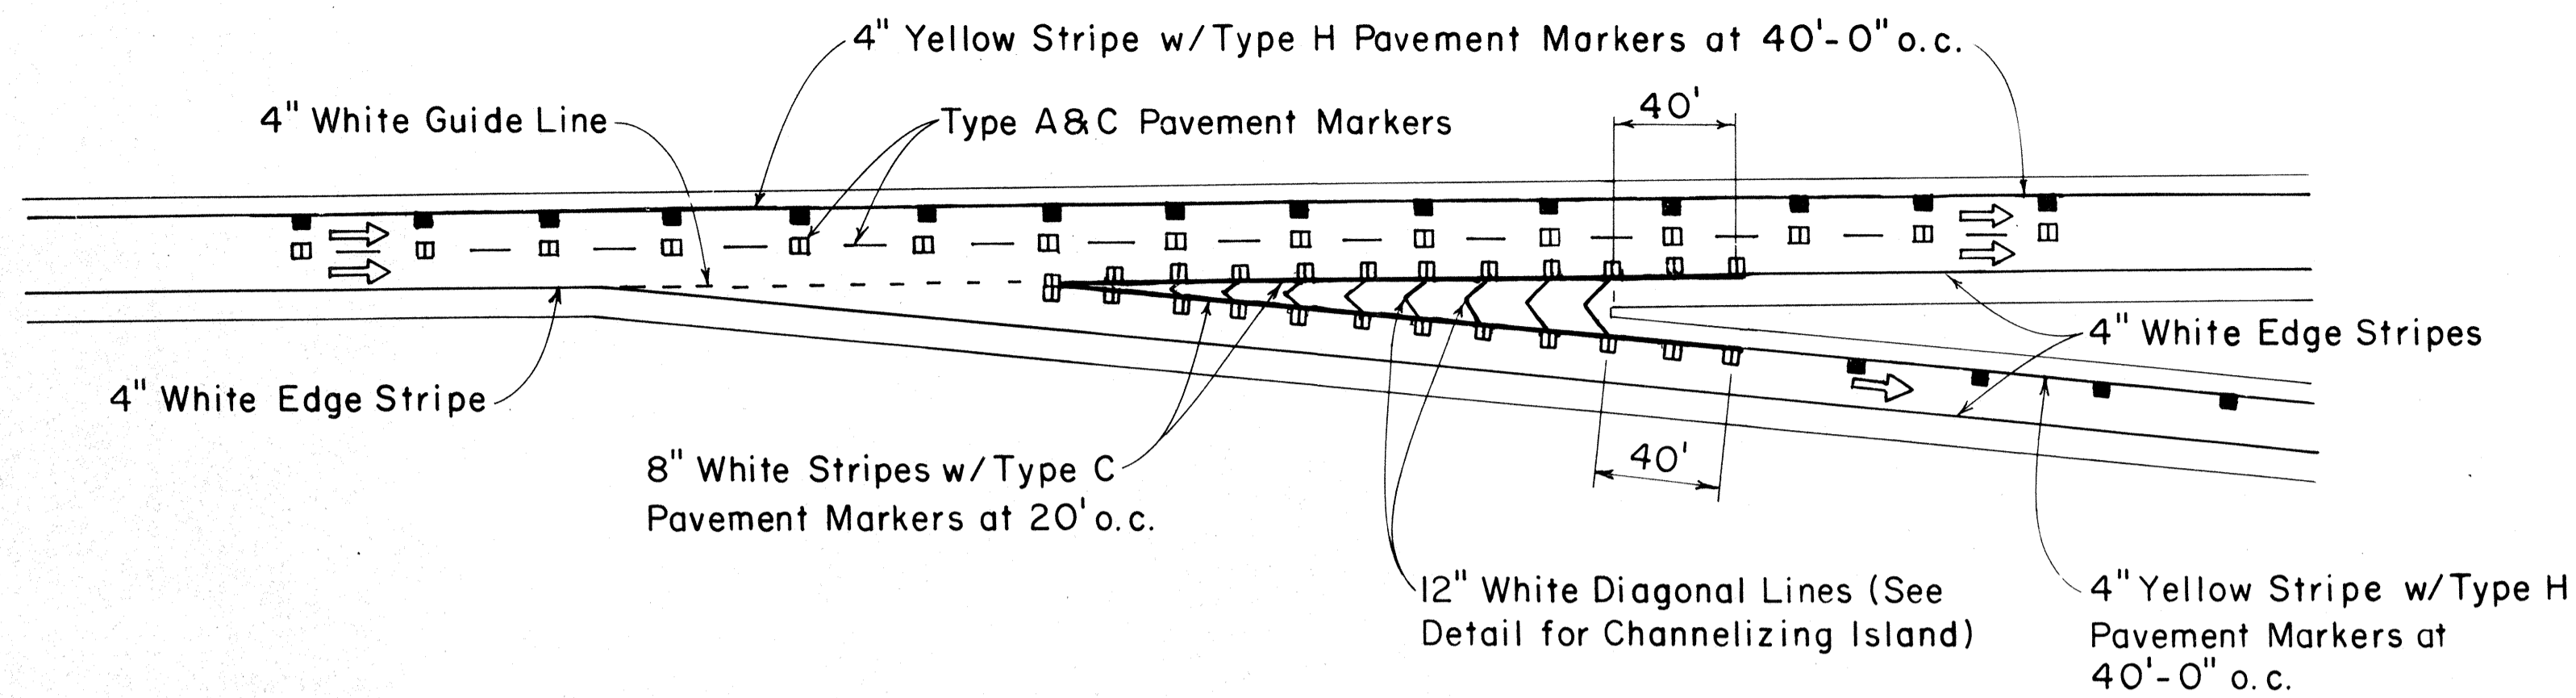

ORIGINAL PLAN	SURVEY PLOTTED BY	DATE
NOTE BOOK	DRAWN BY	" " " "
NO.	DESIGNED BY	" " " "
	CHECKED BY	" " " "

NO.	REVISION	APPROVED BY	DATE
1	Revised Typical Roadway Entrance Markings and Typical Roadway Exit Markings.	E.T.	7/12/85

APPROVAL RECOMMENDED:
Ericki Tanaka 7/21/78
 TRAFFIC ENGINEER DATE


APPROVED:
Harold S. Rakeishi 7/24/78
 ASSISTANT CHIEF, ENGINEERING DATE

STATE OF HAWAII
 DEPARTMENT OF TRANSPORTATION
 HIGHWAYS DIVISION


STANDARD DETAILS
MISCELLANEOUS
PAVEMENT MARKINGS

Not to Scale July 1978
 SHEET No. T18 OF 19 SHEETS DT 304


FED. ROAD DIST. NO.	STATE	FED. AID PROJ. NO.	FISCAL YEAR	SHEET NO.	TOTAL SHEETS
HAWAII	HAW.	[R-H-1(193)	1986	56	62

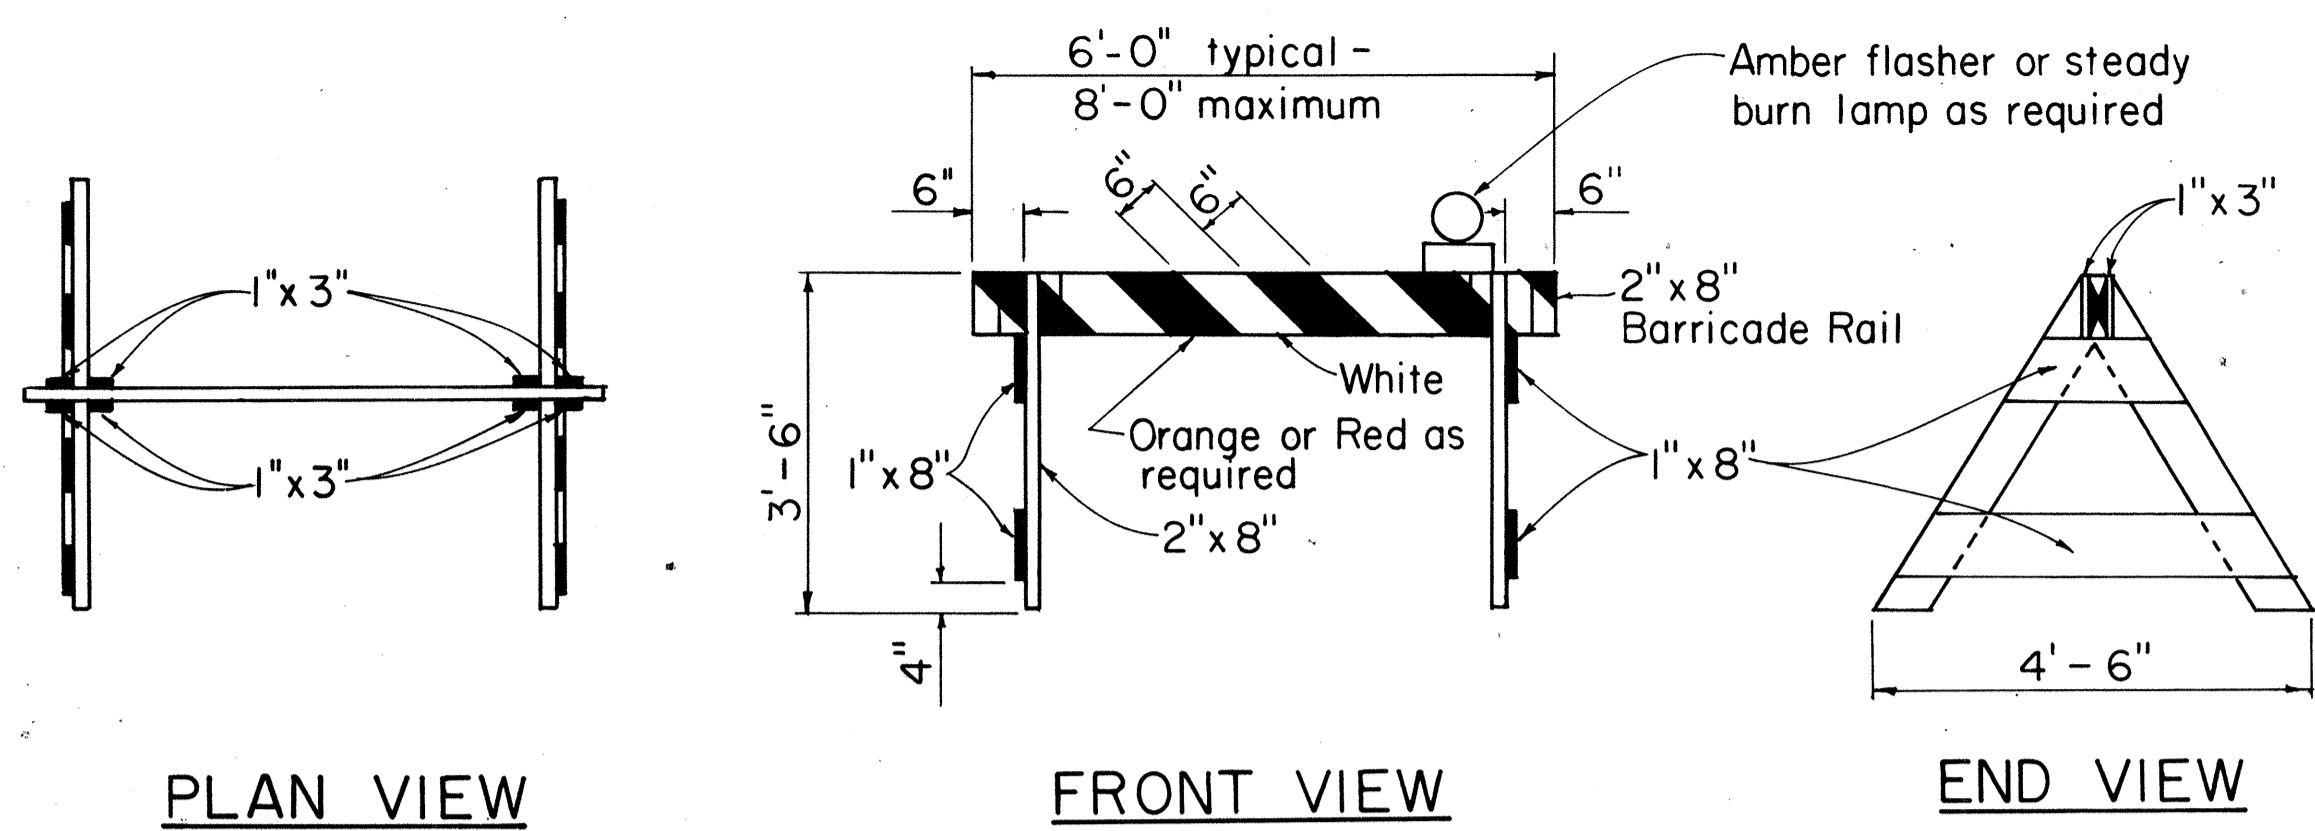

TYPE I BARRICADE
Scale: 1/2" = 1'-0"

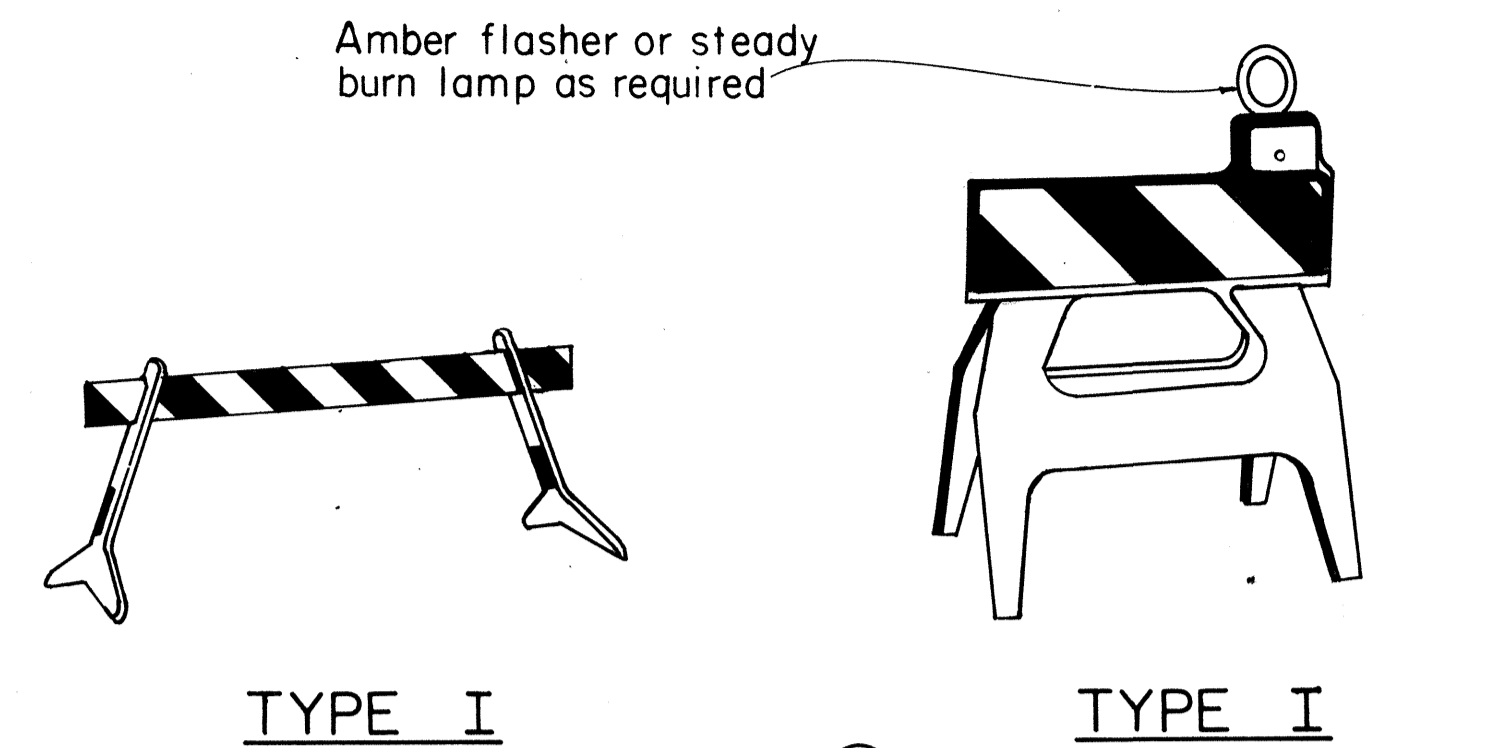


TYPE I

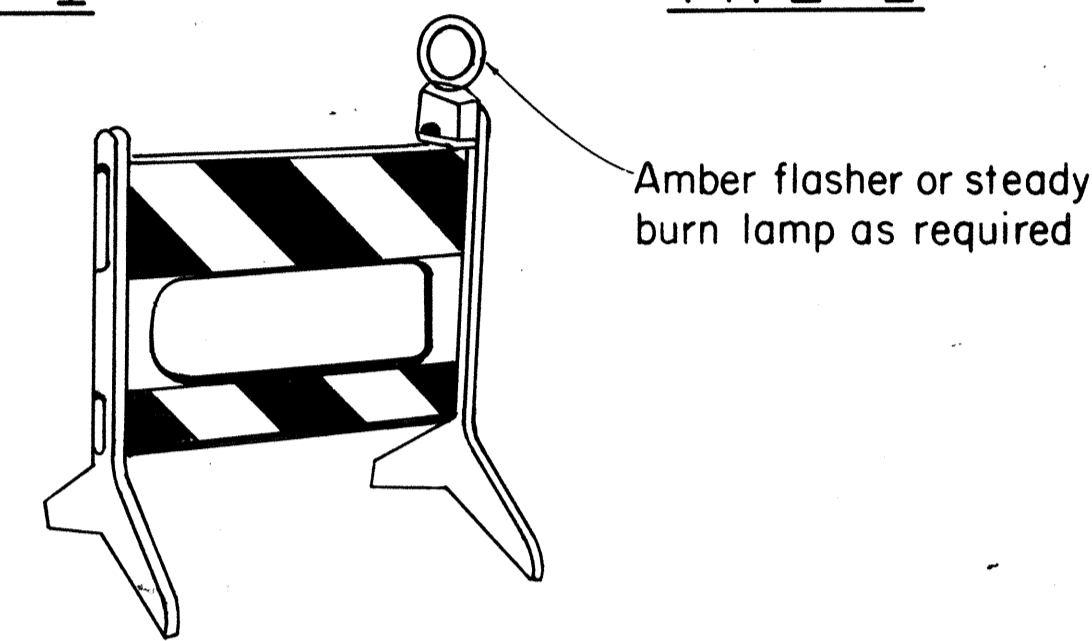

TYPE II


PLASTIC MOLDED BARRICADE OPTIONS*
Not to Scale

* Shop Drawings must be submitted for approval.

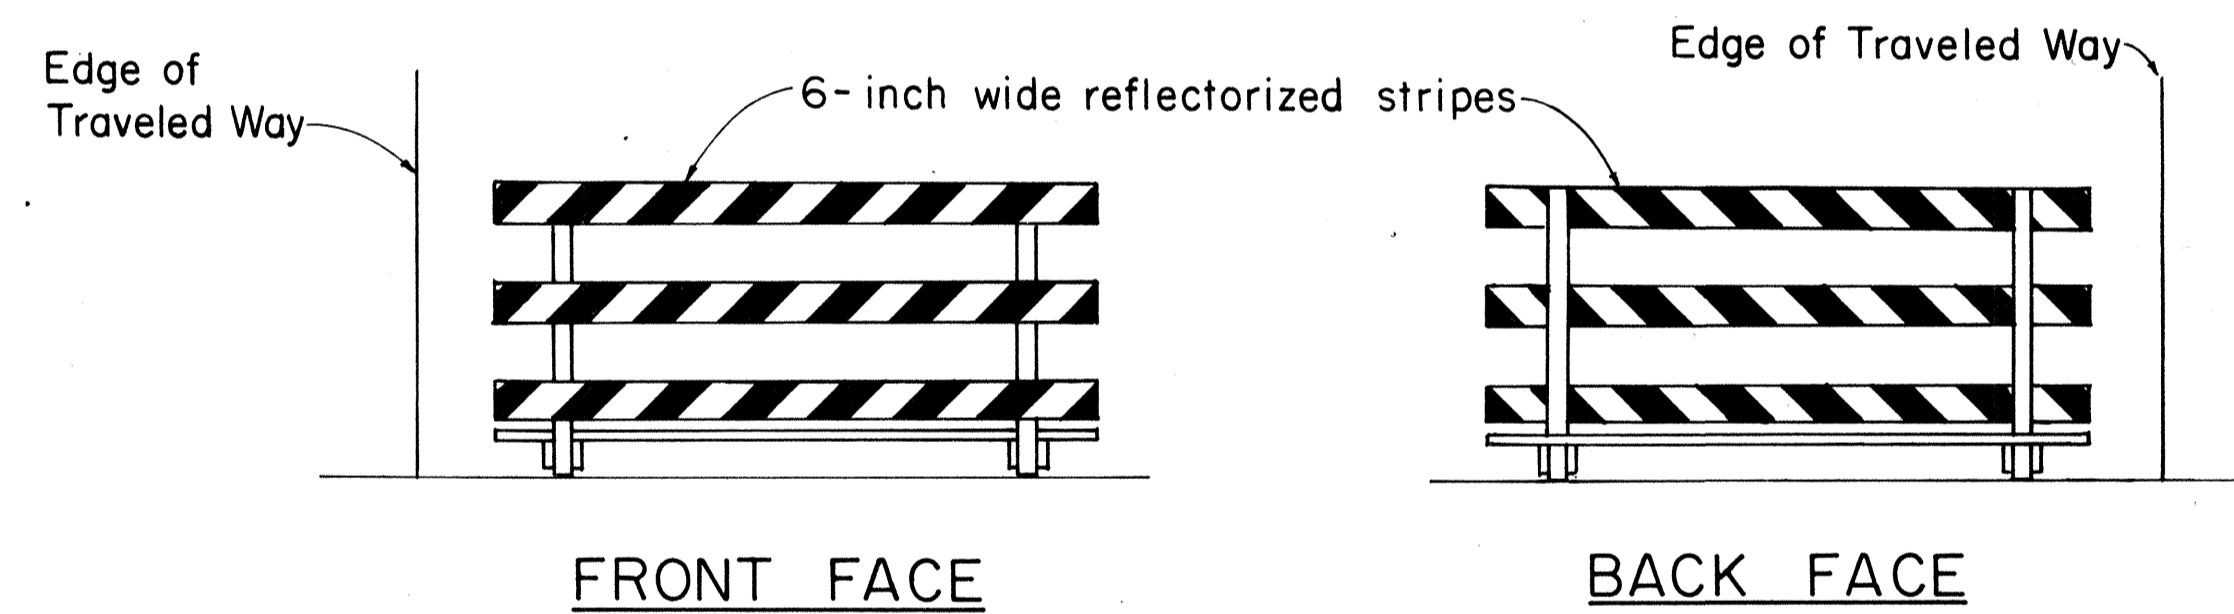


TYPICAL BARRICADE STRIPING DETAILS**
Not to Scale

** Similar for Types I & II

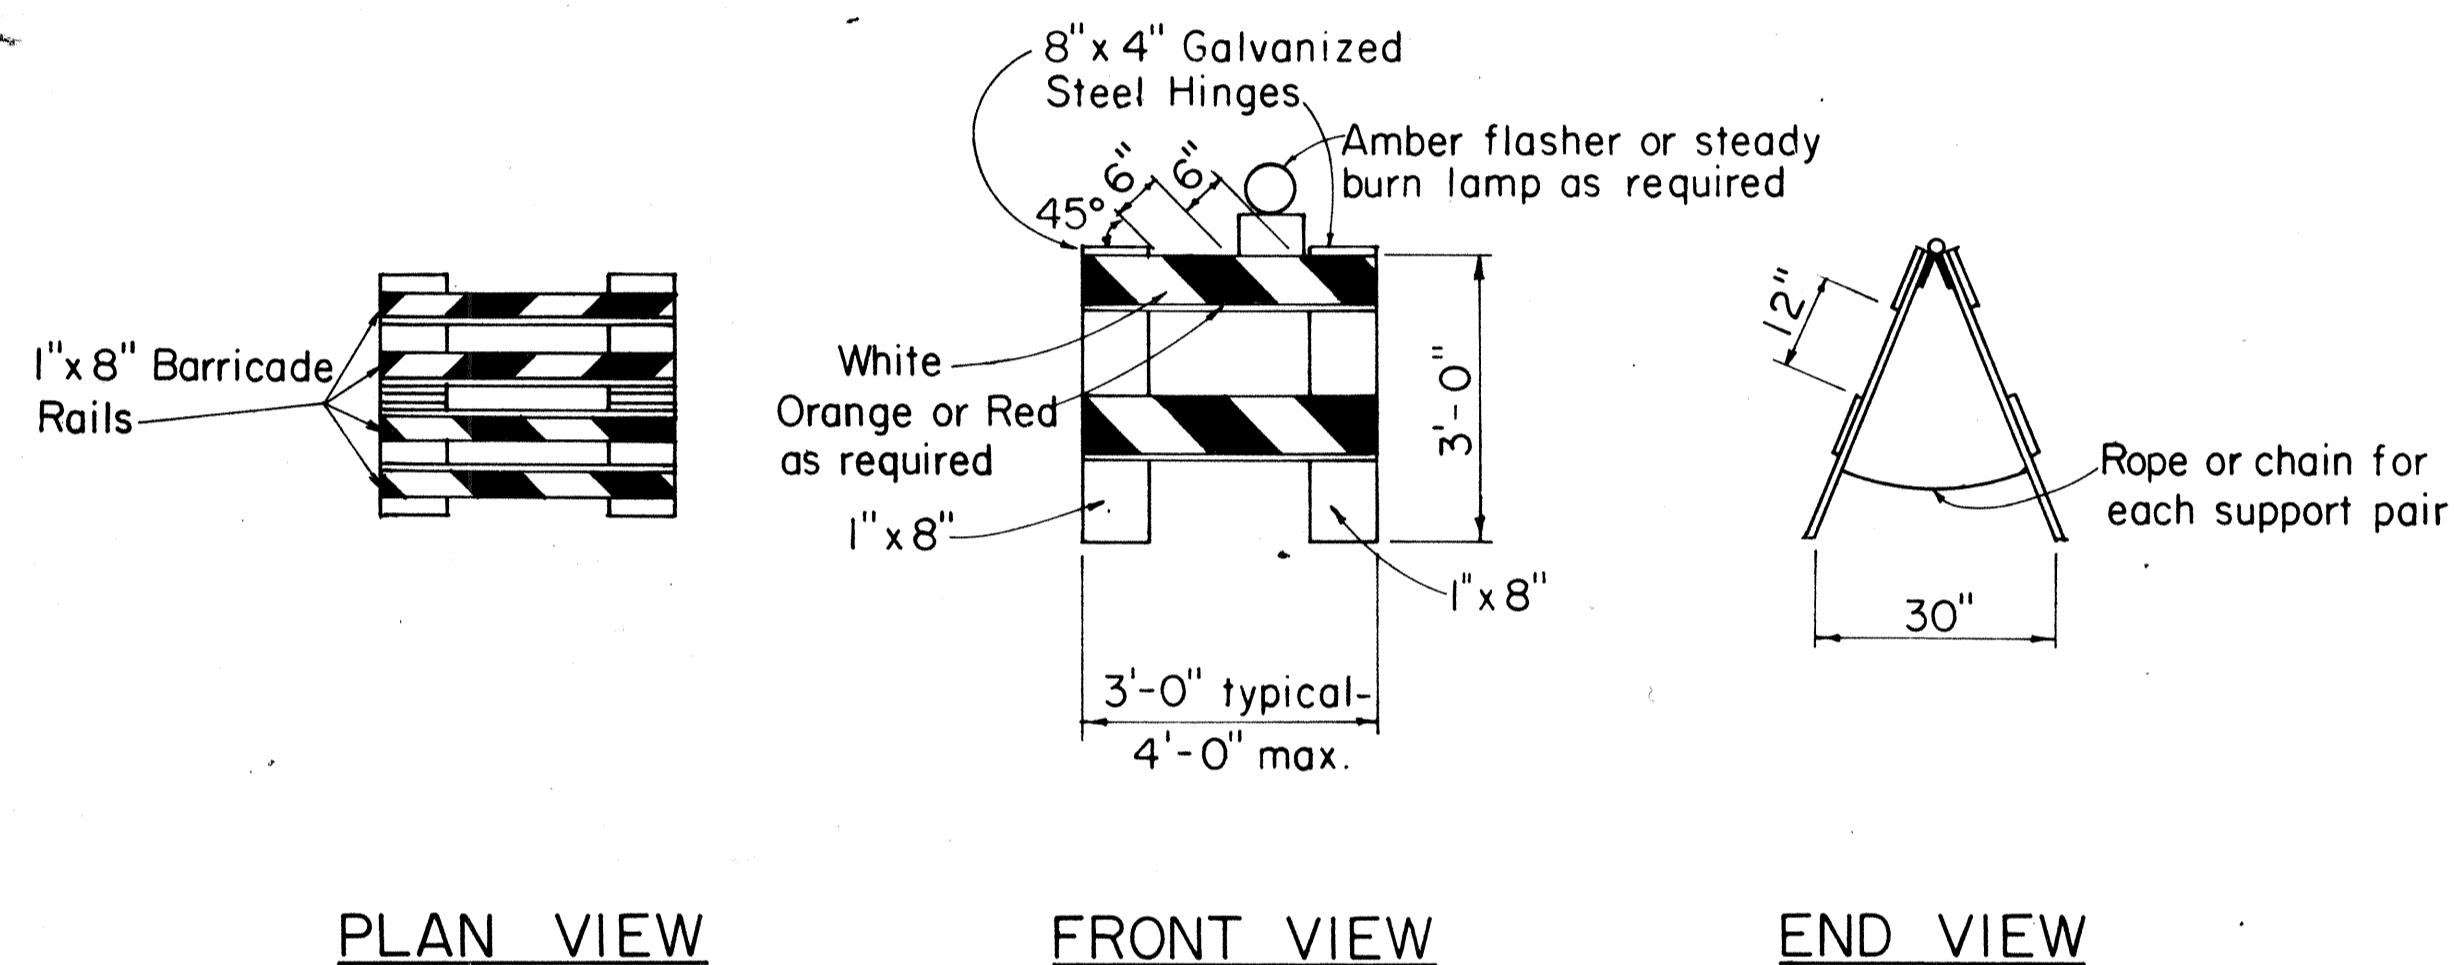

TYPE II BARRICADE
Scale: 1/2" = 1'-0"

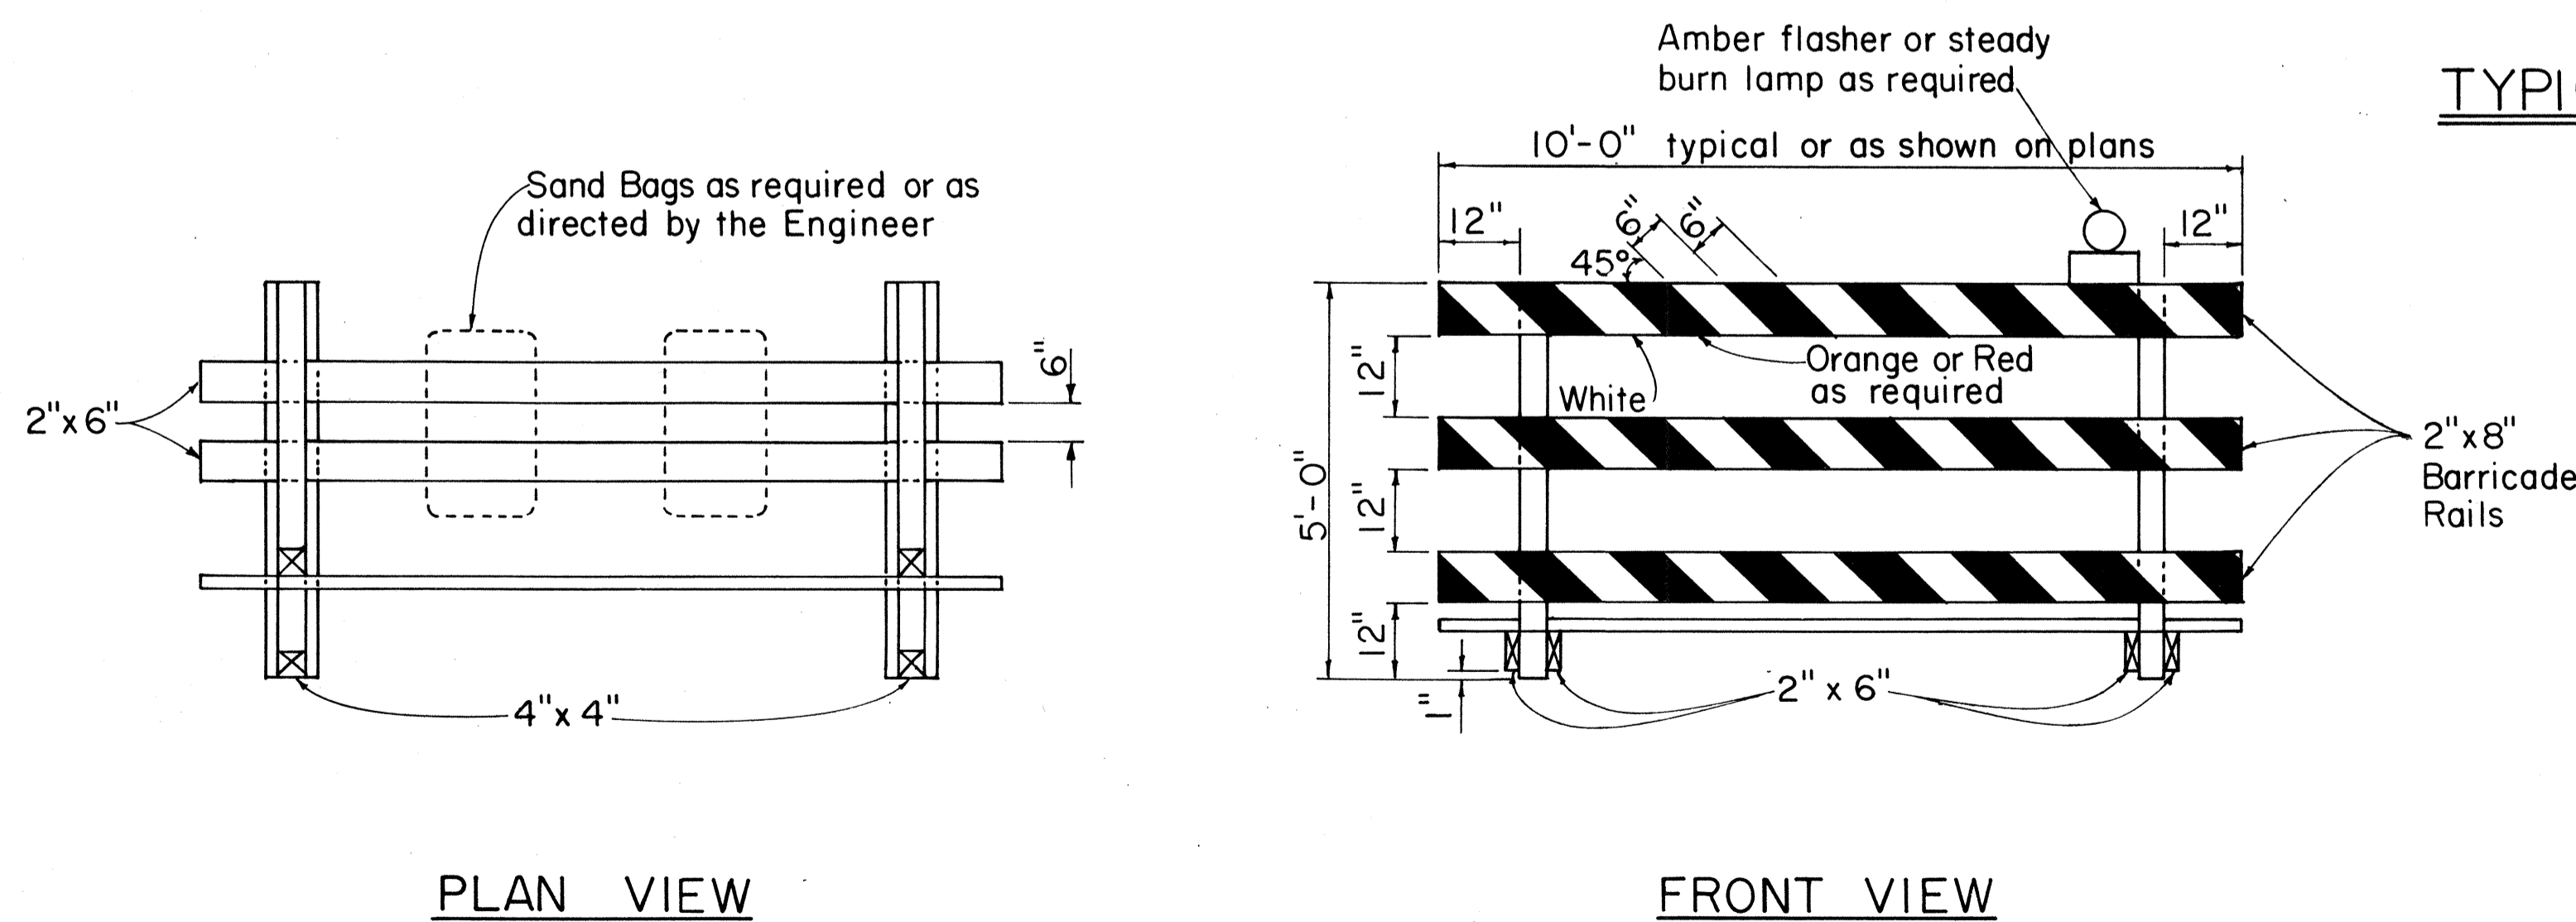

TYPE III BARRICADE
Scale: 1/2" = 1'-0"

GENERAL NOTES

1. The front and back faces of each barricade rail shall be reflectorized with stripes sloping downward toward the same side (traveled way) of each barricade.
2. Contractor may submit alternate barricade designs for approval.
3. Sandbags or other approved weights shall not be placed on top of any striped rail.
4. The Contractor is directed to Section 626.

SURVEY PLOTTED BY	DATE
DRAWN BY	
TRACED BY	
QUANTITIES BY	
CHECKED BY	
ORIGINAL PLAN	
NOTE BOOK	
No.	

APPROVAL RECOMMENDED:
Eiichi Tanaka 10/21/81
TRAFFIC ENGINEER DATE

APPROVED:
Harriet S. Sato 10/23/81
ASSISTANT CHIEF, ENGINEERING DATE

NO.	REVISION	APPROVED BY	DATE
1	Supersedes DT 800 Approved 12/30/69	H.T.	10/23/81

STATE OF HAWAII
DEPARTMENT OF TRANSPORTATION
HIGHWAYS DIVISION

STANDARD DETAILS

BARRICADES

SCALE: As Shown
SHEET No. 119 OF 19 SHEETS DT 800