
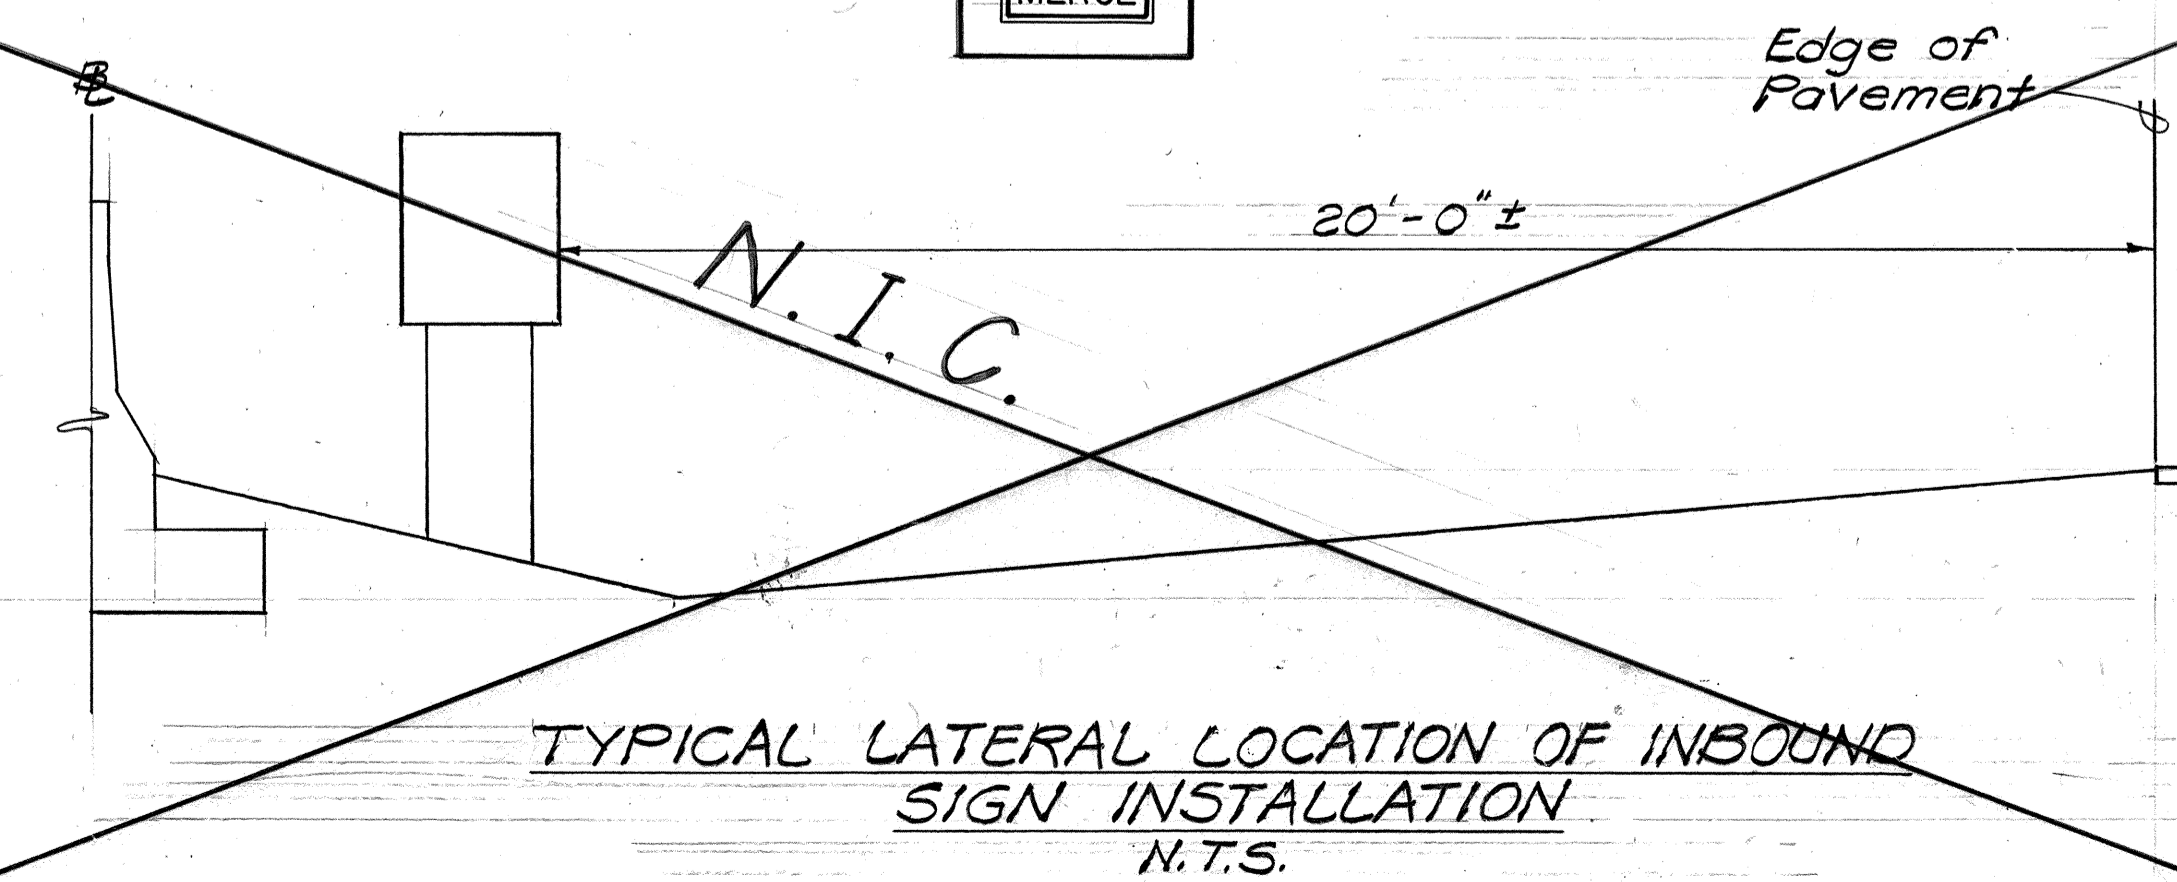
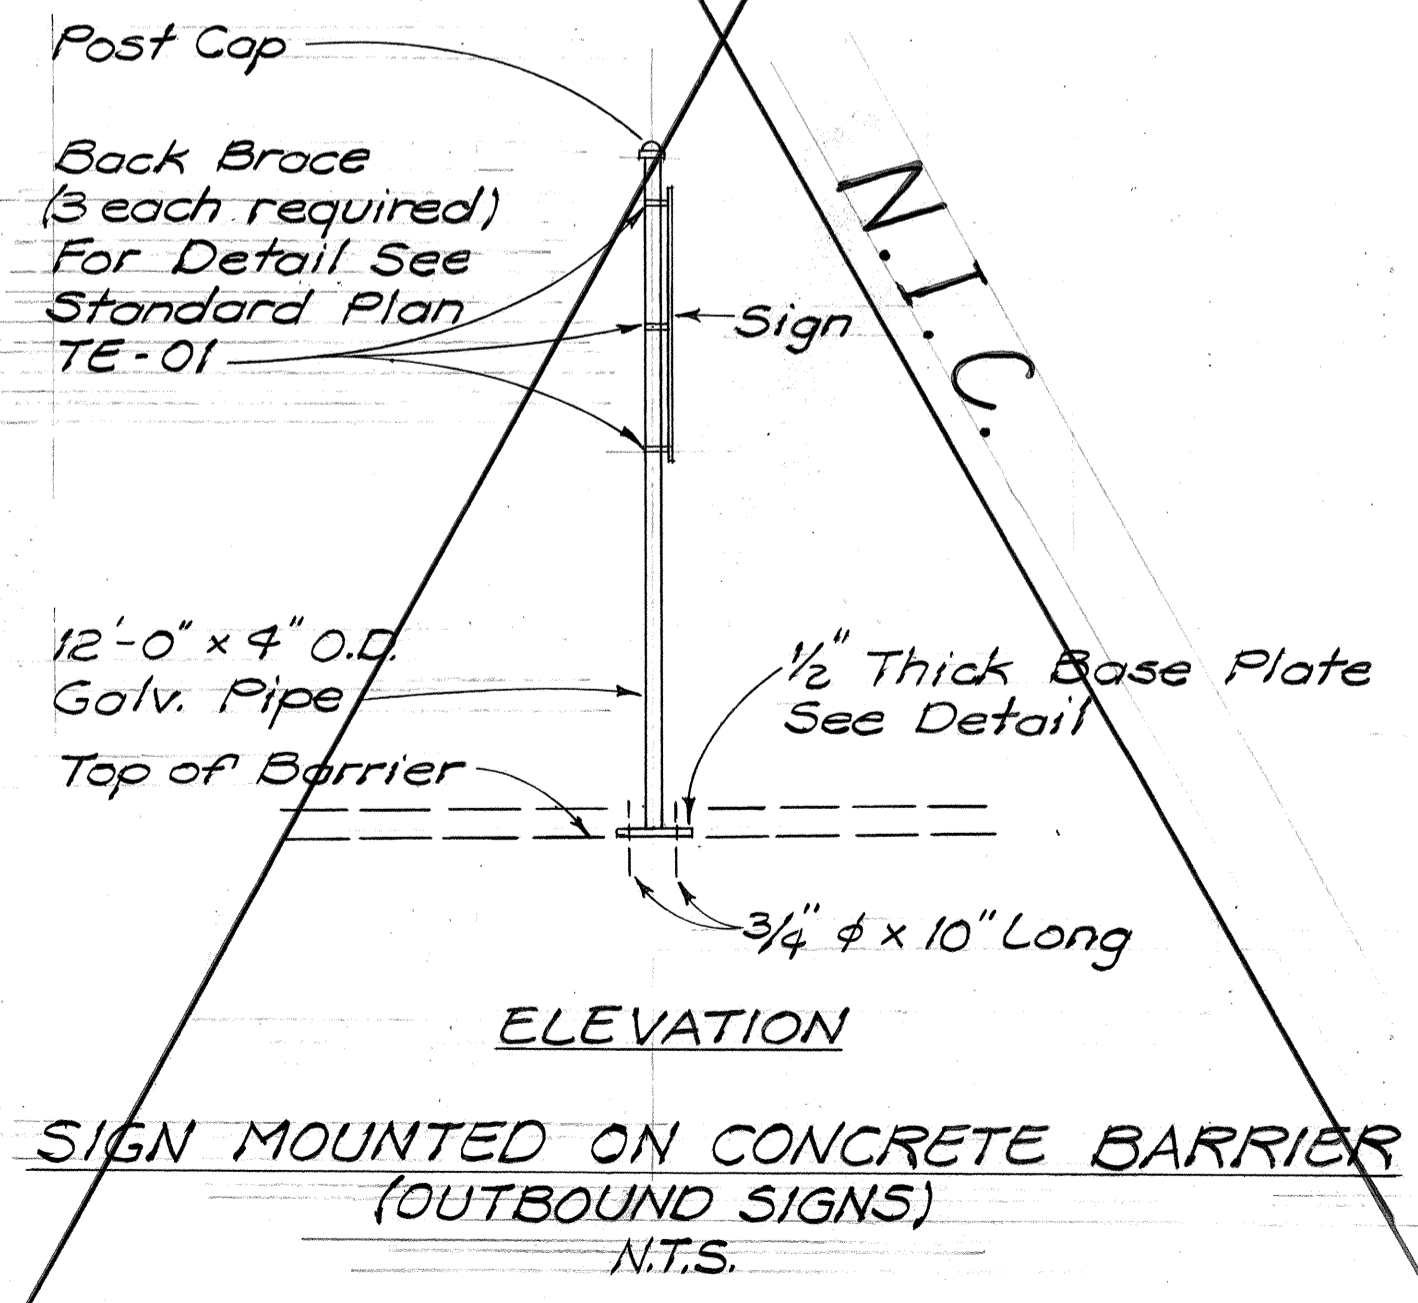
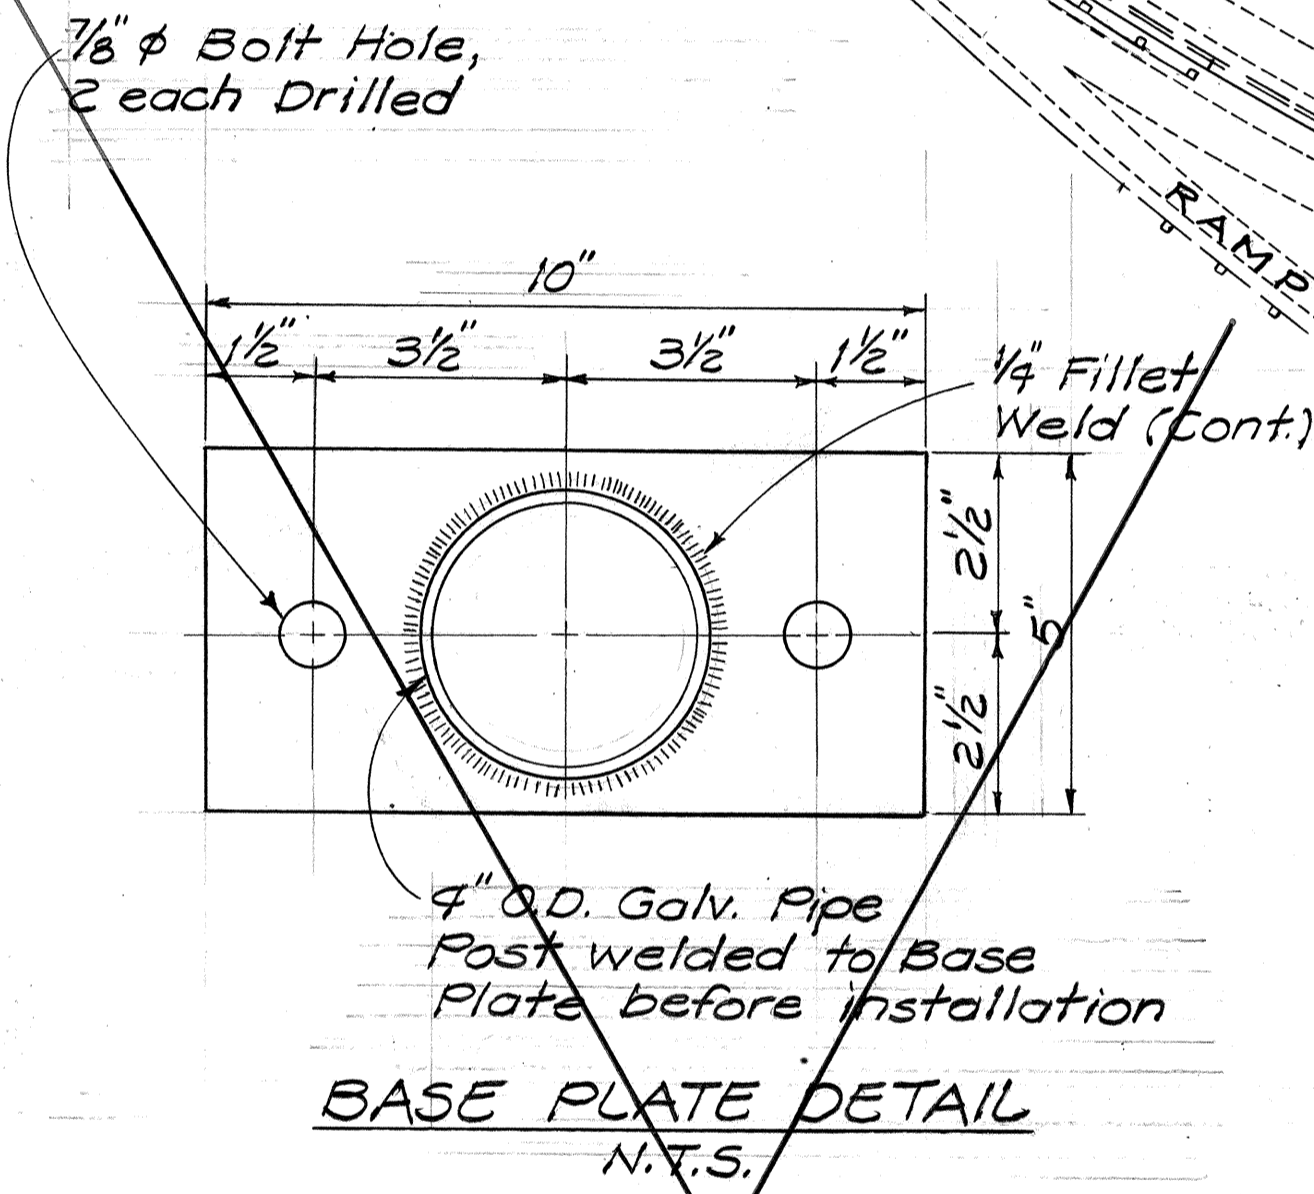


CURVE DATA			
	B1	B1-A	SPIRAL
Δ	31° 40' 30"	62° 23' 00"	D 2° 50'
Δ/2	15° 50' 15"	31° 11' 30"	θs 4° 15'
R	1,809.34'	2,022.20'	Ls 300.00'
T	514.27'	1,224.29'	LT 200.00'
C	987.57'	2,094.61'	ST 100.00'
L	1,000.26'	2,201.76'	Es 343.89'
SE		0.078 Ft./ft.	

FED. ROAD DIST. NO.	STATE	FED. AID PROJ. NO.	FISCAL YEAR	SHEET NO.	TOTAL SHEETS
HAWAII	HAW.	IR-HI-1(189)	1986	78	99

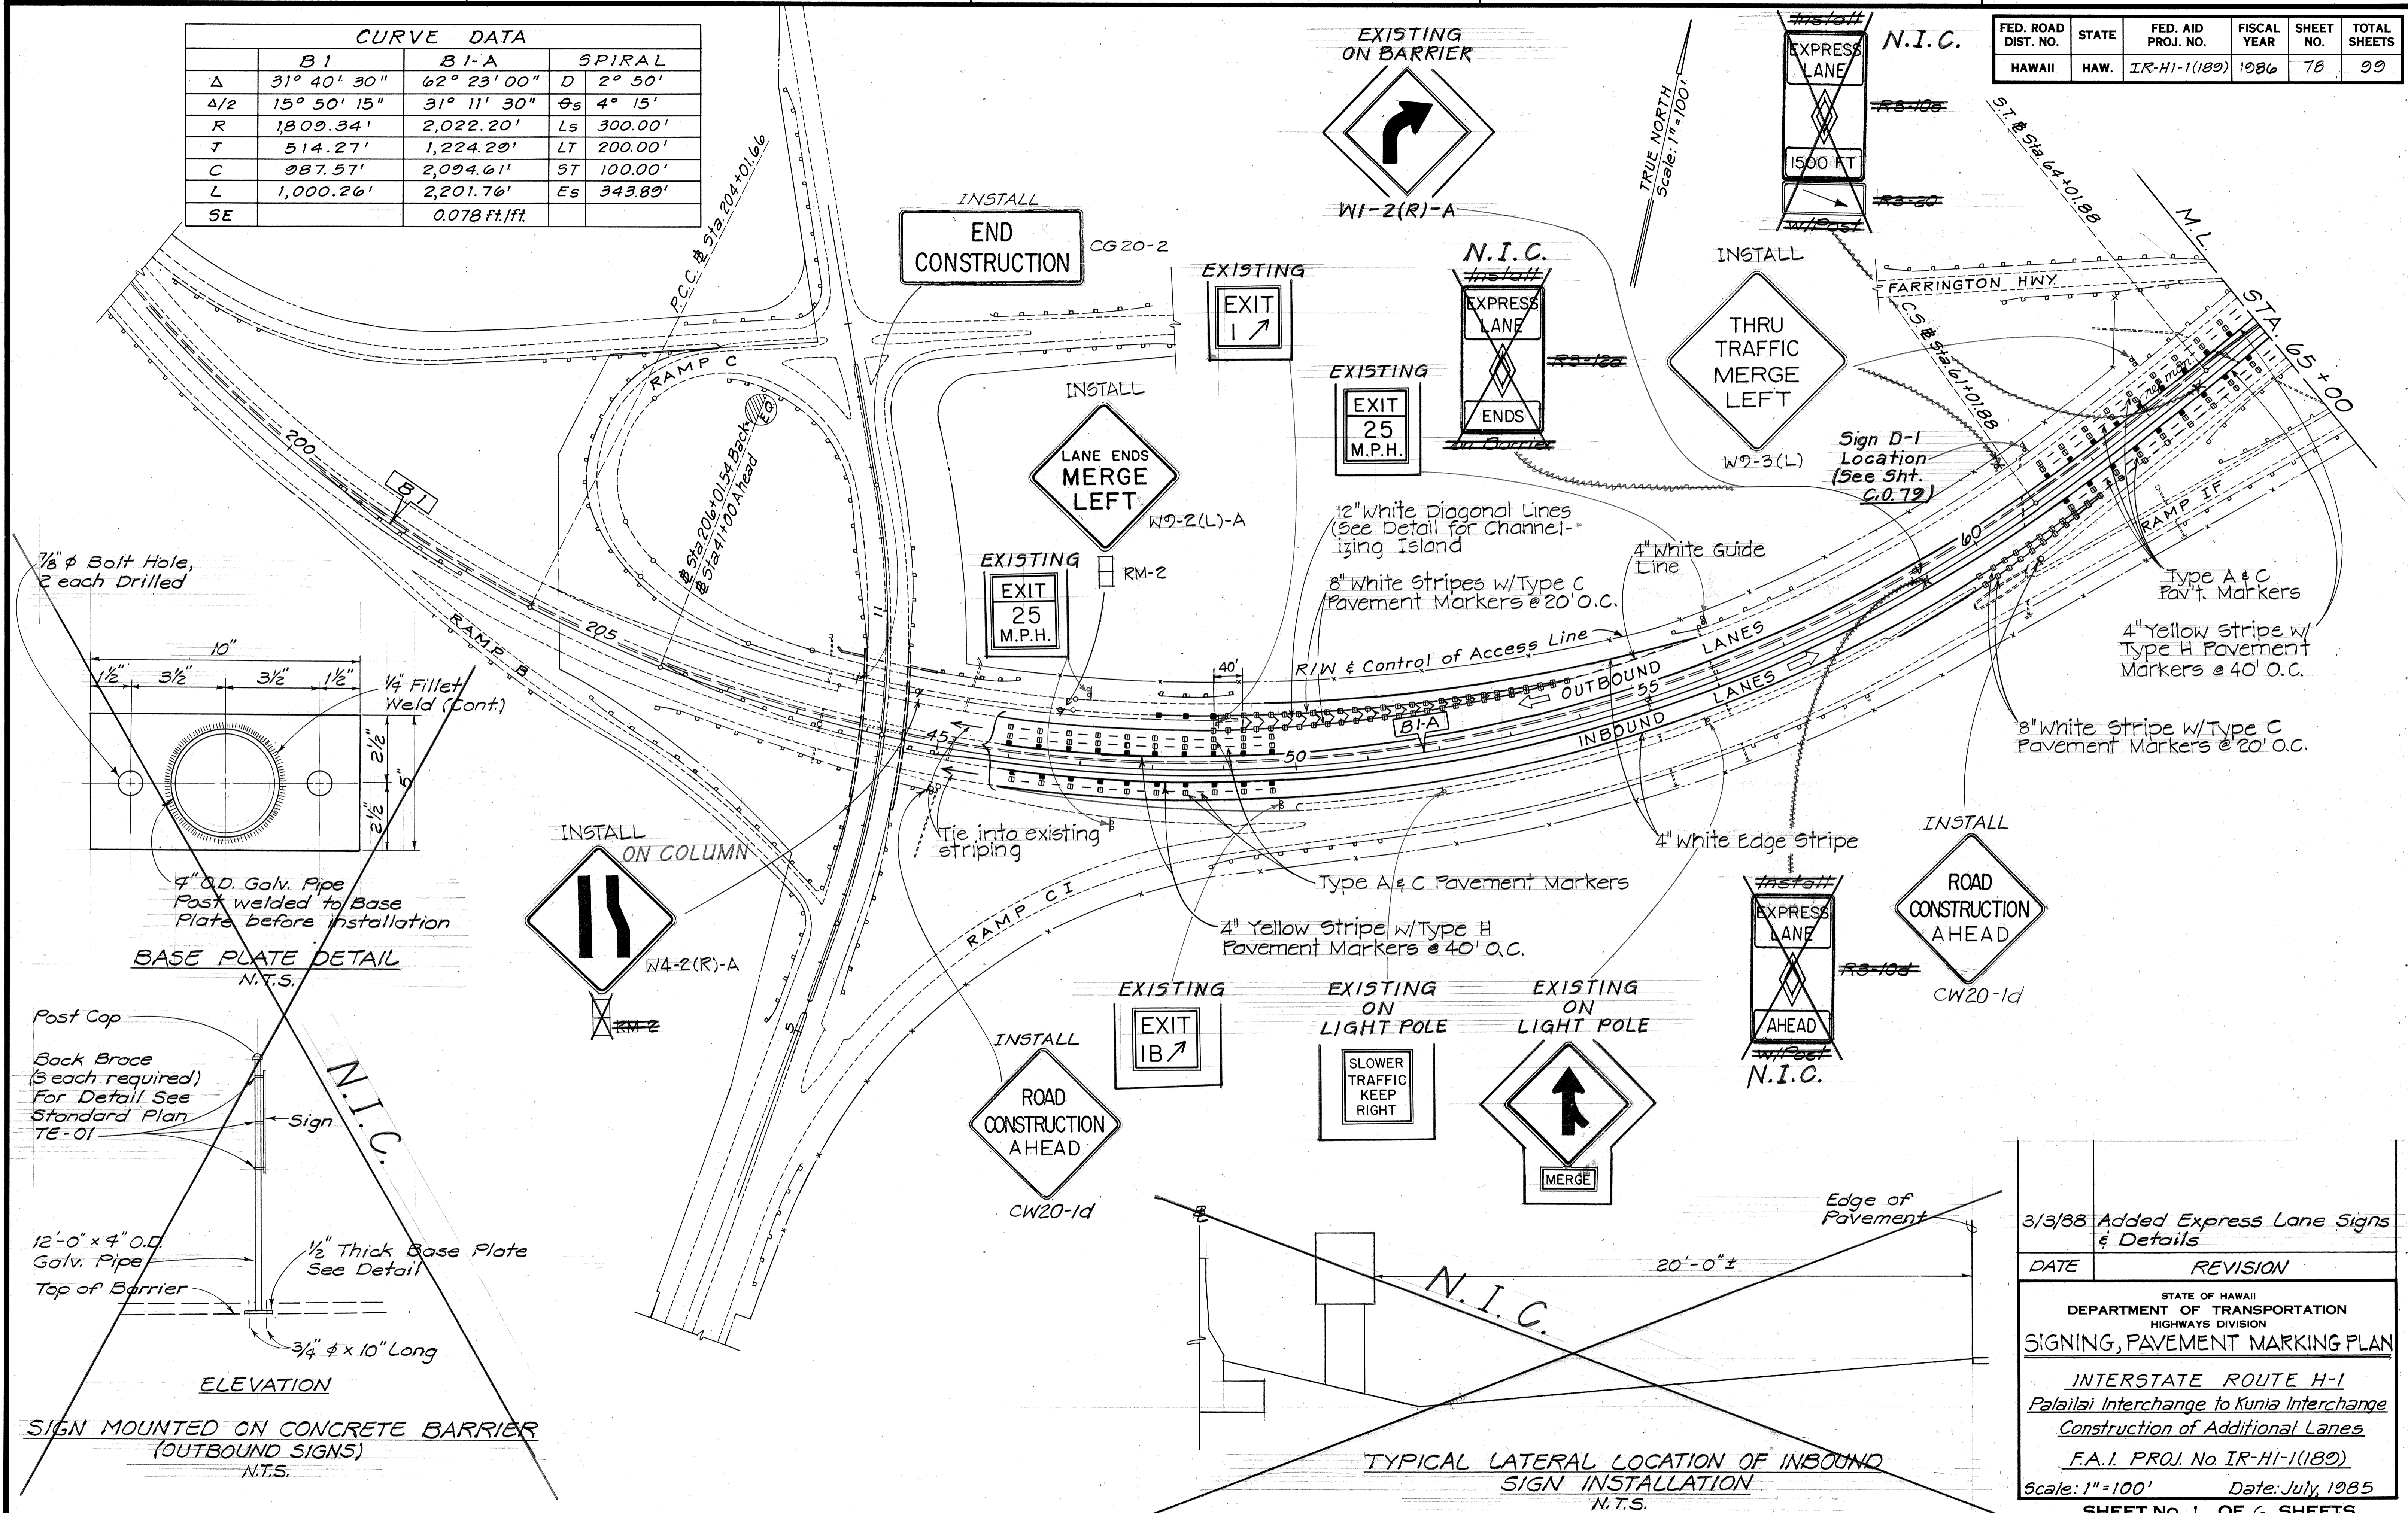



DATE	REVISION
3/3/88	Added Express Lane Signs & Details

STATE OF HAWAII  
DEPARTMENT OF TRANSPORTATION  
HIGHWAYS DIVISION  
**SIGNING, PAVEMENT MARKING PLAN**  
*INTERSTATE ROUTE H-1  
Palailai Interchange to Kunia Interchange  
Construction of Additional Lanes*  
F.A.I. PROJ. No IR-HI-1(189)  
Scale: 1"=100' Date: July, 1985  
SHEET No. 1 OF 6 SHEETS

FED. ROAD DIST. NO.	STATE	FED. AID PROJ. NO.	FISCAL YEAR	SHEET NO.	TOTAL SHEETS
HAWAII	HAW.	IR-HI-1(189)	1986	79	99

CURVE DATA B2

Δ	6° 50' 00"
Δ/2	3° 25' 00"
R	10,000.00'
T	597.03'
L	1,192.64'
C	1,191.93'
SE	0.015 ft/ft

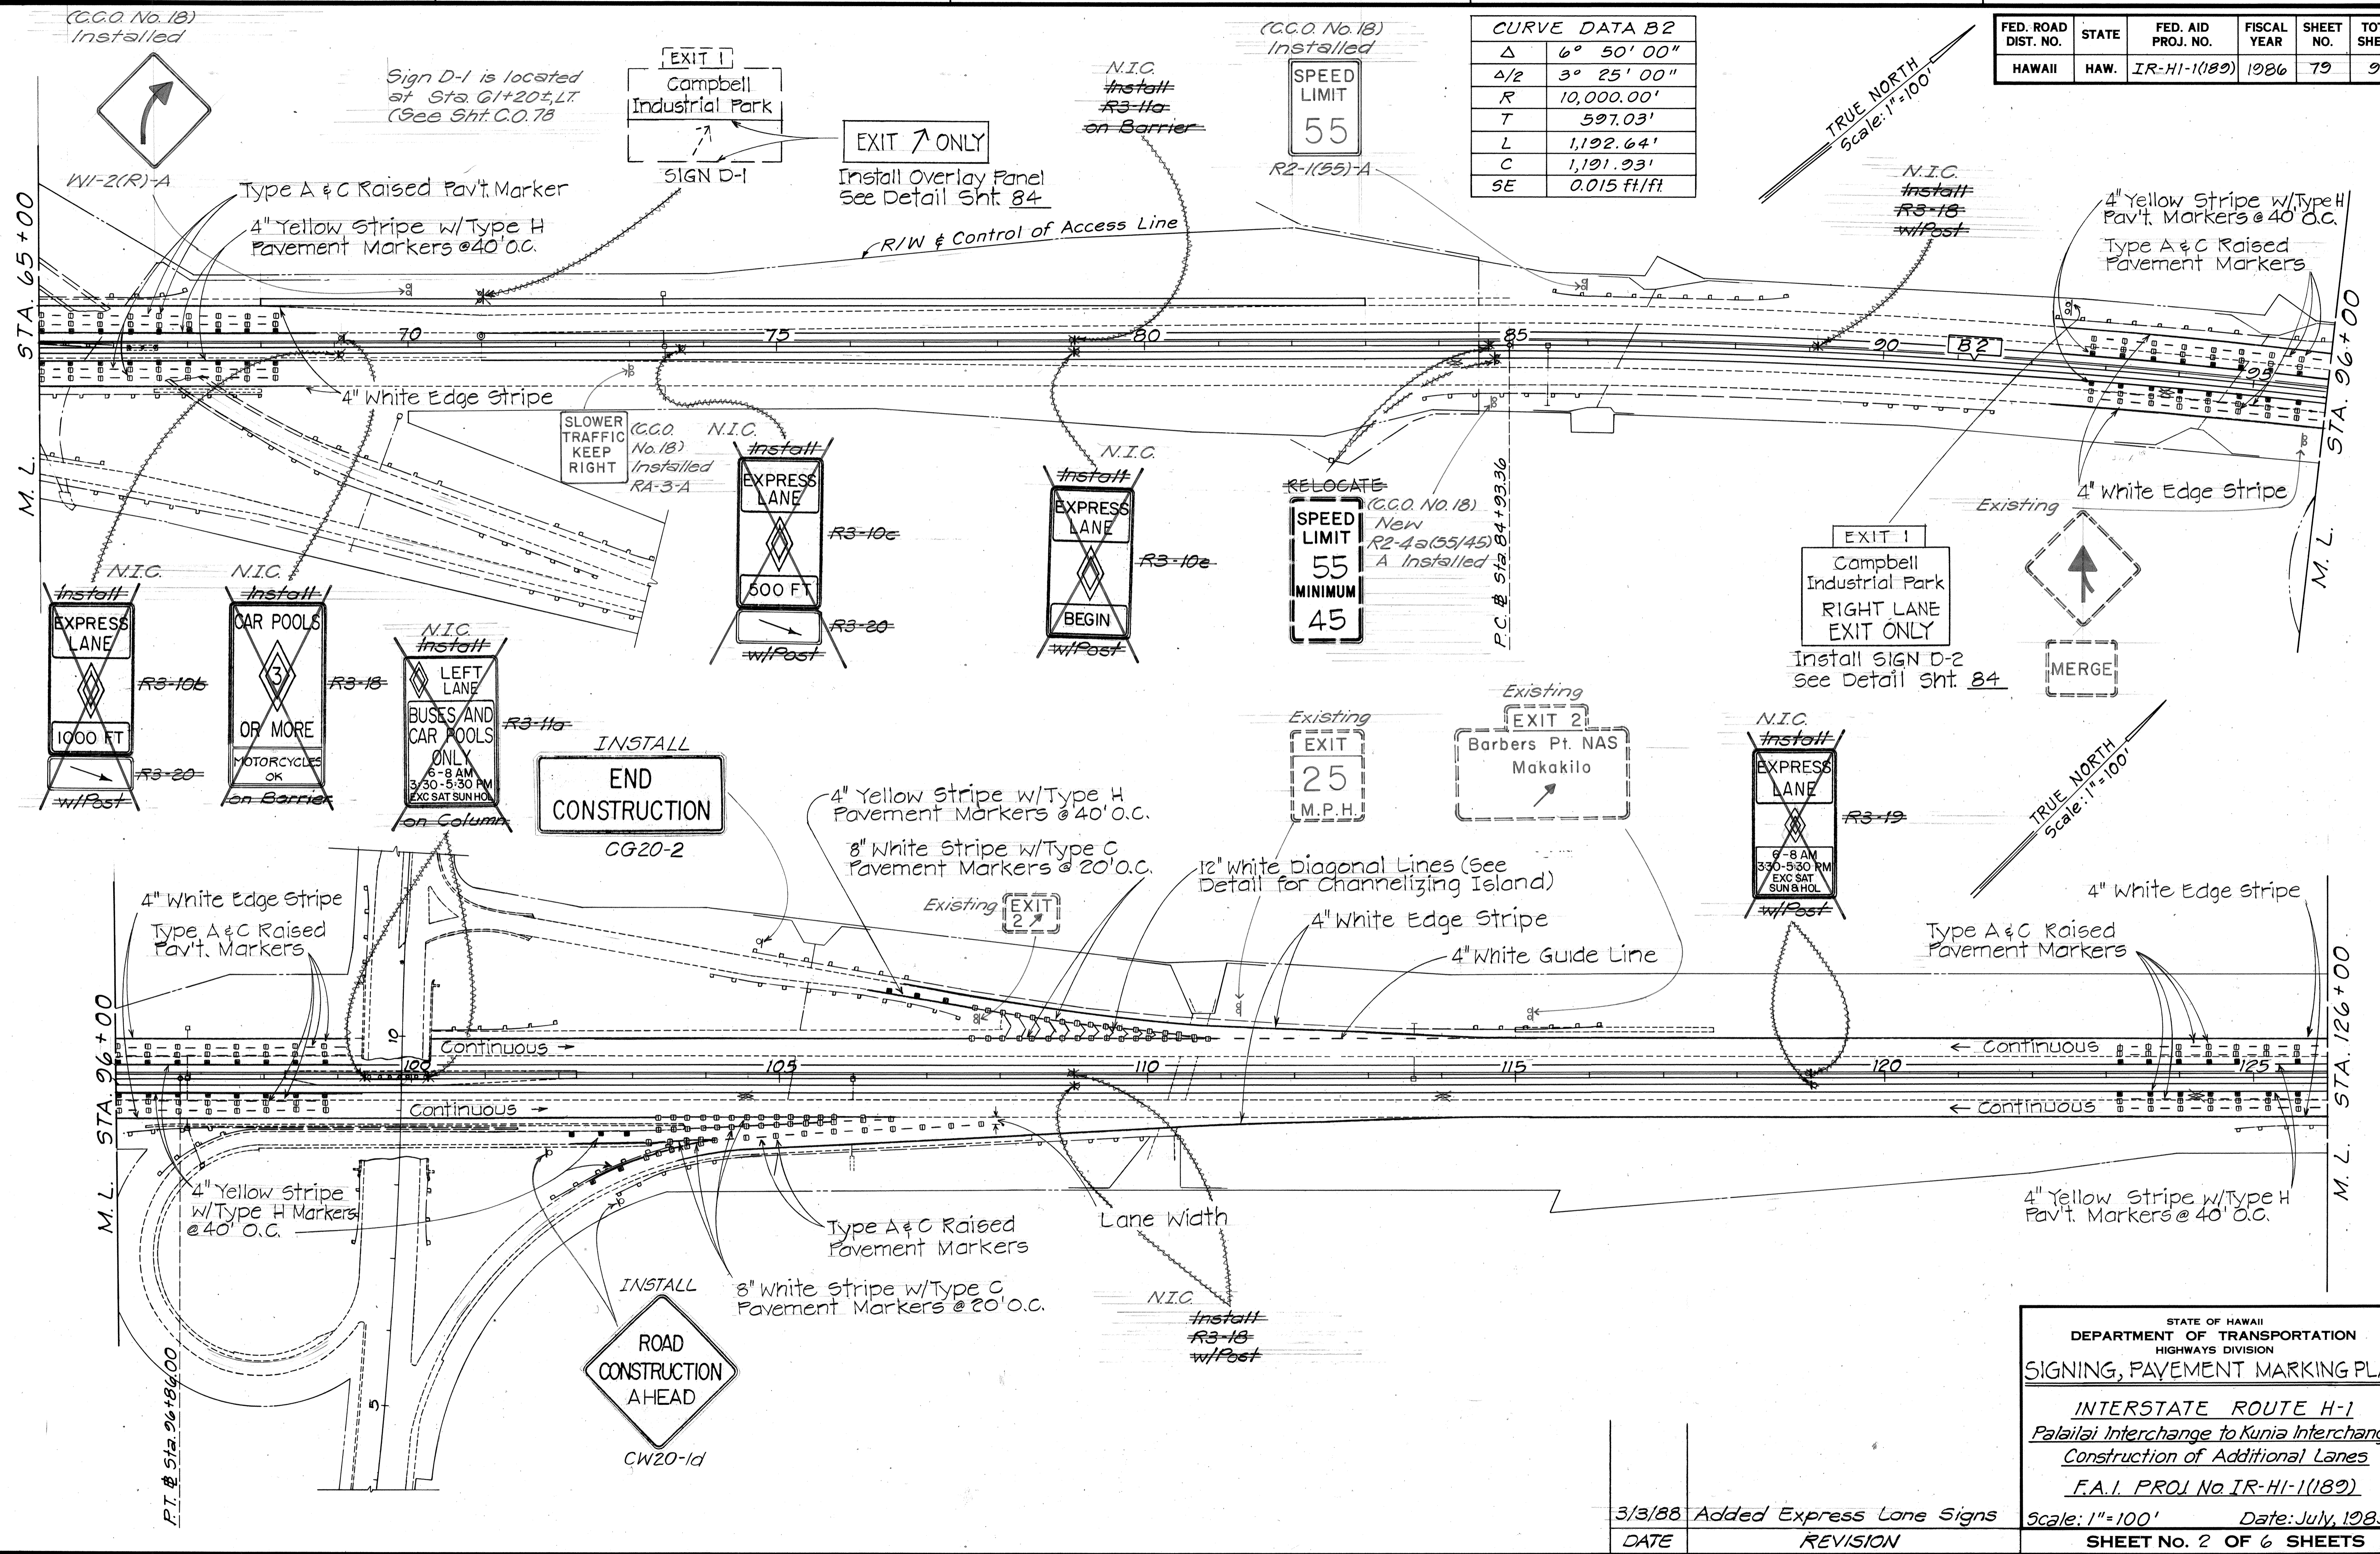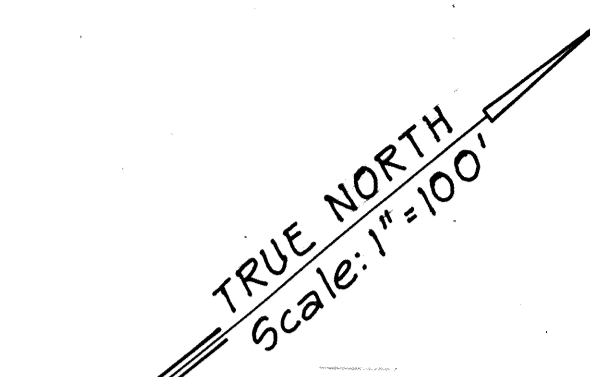

DATE	
SURVEY PLOTTED BY	
ORIGINAL PLAN	
DRAWN BY	
DESIGNED BY	
CHECKED BY	
NO.	

3/3/88	Added Express Lane Signs
DATE	REVISION



STATE OF HAWAII  
DEPARTMENT OF TRANSPORTATION  
HIGHWAYS DIVISION

**SIGNING, PAVEMENT MARKING PLAN**

*INTERSTATE ROUTE H-1  
Palailai Interchange to Kunia Interchange  
Construction of Additional Lanes  
F.A.I. PROJ No IR-HI-1(189)*

Scale: 1"=100'      Date: July, 1985  
SHEET NO. 2 OF 6 SHEETS

FED. ROAD DIST. NO.	STATE	FED. AID PROJ. NO.	FISCAL YEAR	SHEET NO.	TOTAL SHEETS
HAWAII	HAW.	IR-HI-1(189)	1986	80	99

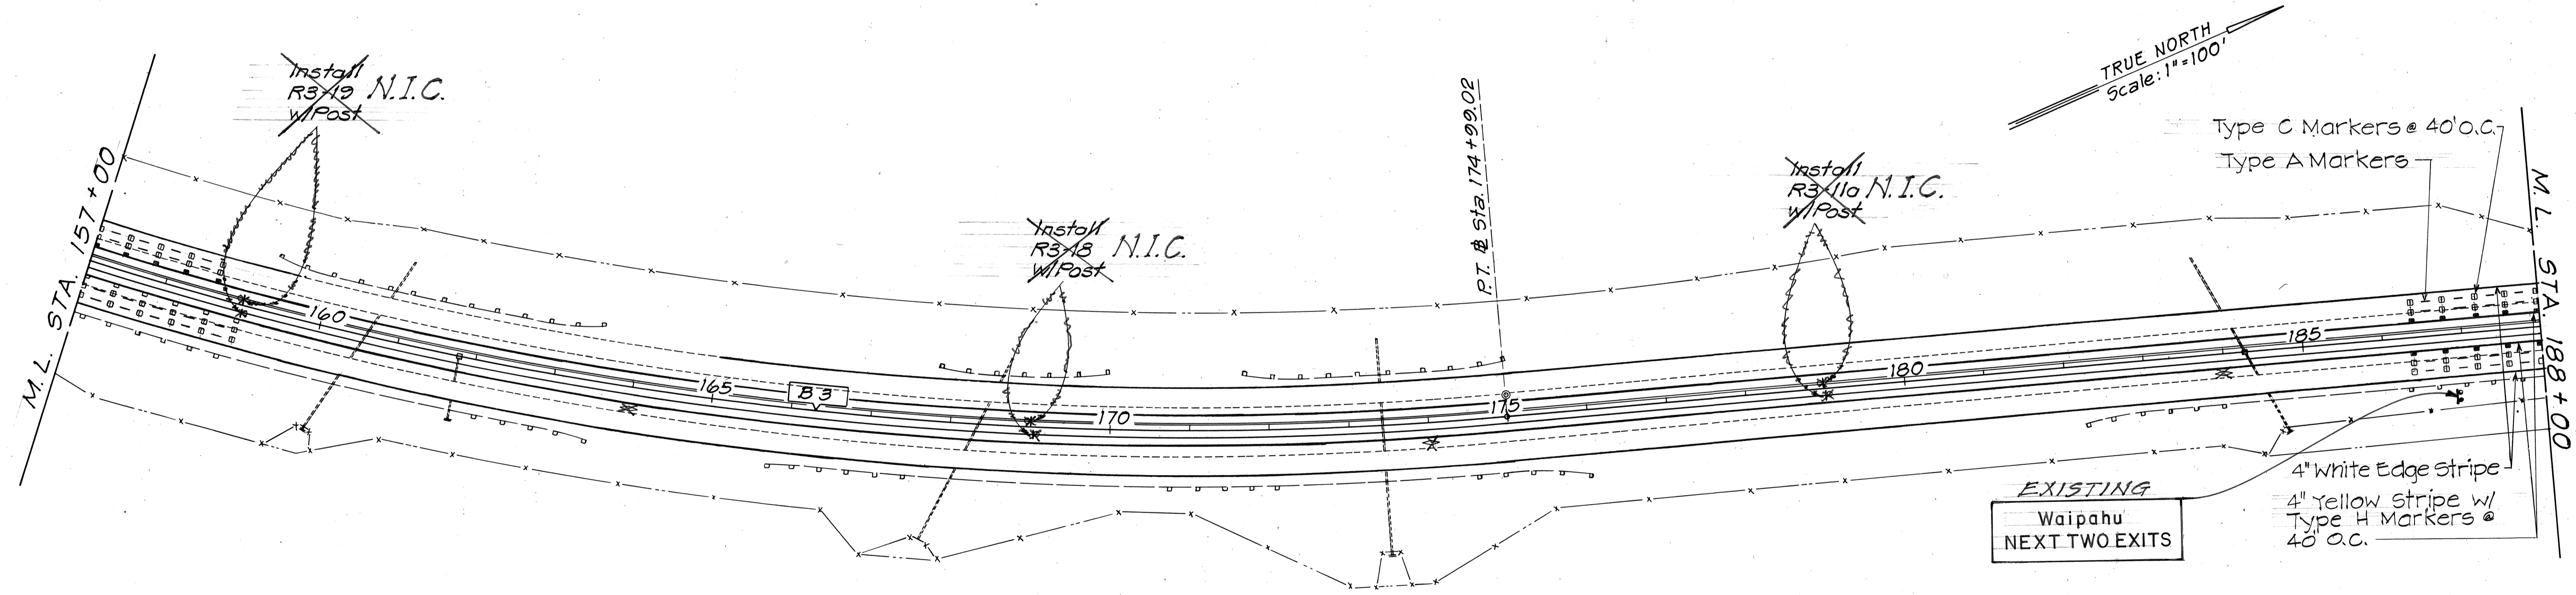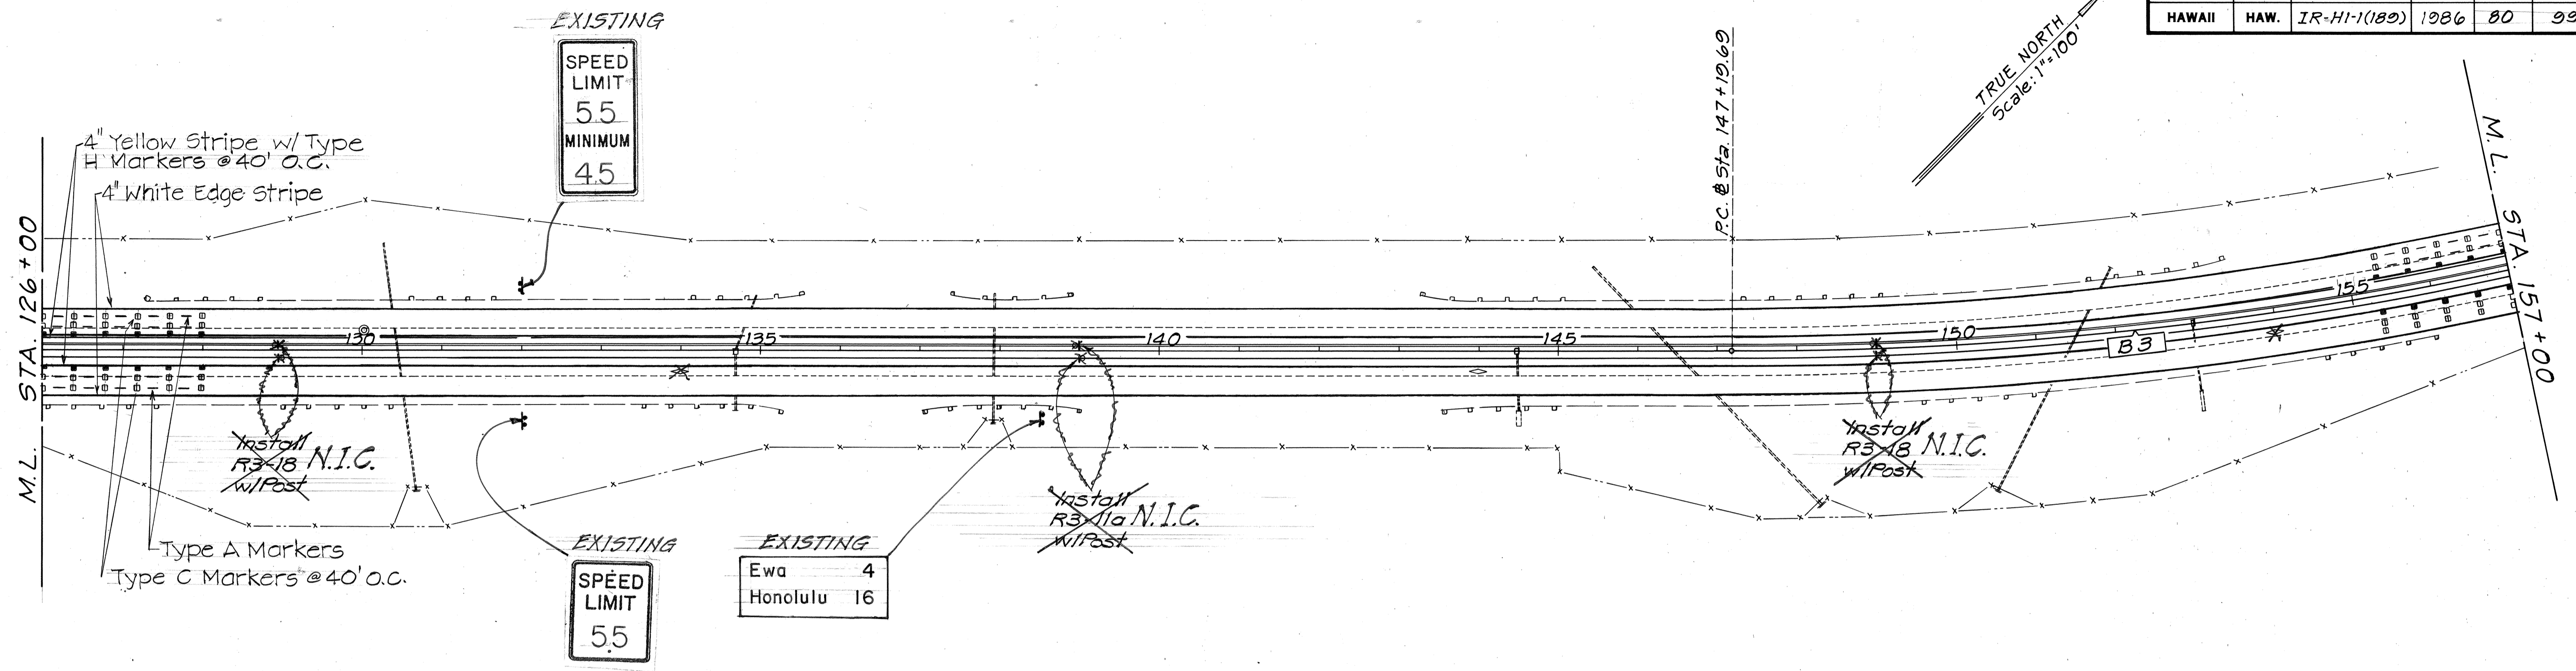

SURVEY PLOTTED BY	DATE
DRAWN BY	
DESIGNED BY	
QUANTITIES BY	
CHECKED BY	
ORIGINAL PLAN	
NOTE BOOK	
NO.	

Δ	34° 44' 30"
Δ/2	17° 22' 15"
R	4,583.66'
T	1,433.87'
L	2,779.33'
C	2,736.95'
SE	0.035 Ft./Ft.

3/3/88	Added Express Lane Signs
DATE	REVISION

STATE OF HAWAII  
DEPARTMENT OF TRANSPORTATION  
HIGHWAYS DIVISION

**SIGNING, PAVEMENT MARKING PLAN**

*INTERSTATE ROUTE H-1  
Palailai Interchange to Kunia Interchange  
Construction of Additional Lanes*

F.A.I. PROJ. No. IR-HI-1(189)

Scale: 1"=100' Date: July, 1985

SHEET NO. 3 OF 6 SHEETS

CURVE DATA B4			
CIRCULAR		SPIRAL	
Δ	28° 04' 30"	Δ	35° 34' 30"
Δ/2	14° 02' 15"	Dc	2° 30' 00"
R	2,291.83'	θs	3° 45' 00"
T	573.01'	Ls	300.00'
L	1,123.00'	Ts	885.78'
C	1,111.80'	Es	116.77'





EXISTING  
EXIT 2  
Barbers Pt. N.A.S.  
Makakilo  
1 1/2 MILES

(C.C.O. NO. 18)  
INSTALLED

SPEED LIMIT  
55  
MINIMUM  
45

FED. ROAD DIST. NO.	STATE	FED. AID PROJ. NO.	FISCAL YEAR	SHEET NO.	TOTAL SHEETS
HAWAII	HAW.	IR-HI-1(182)	1986	81	99

Contract Change Order No. 17

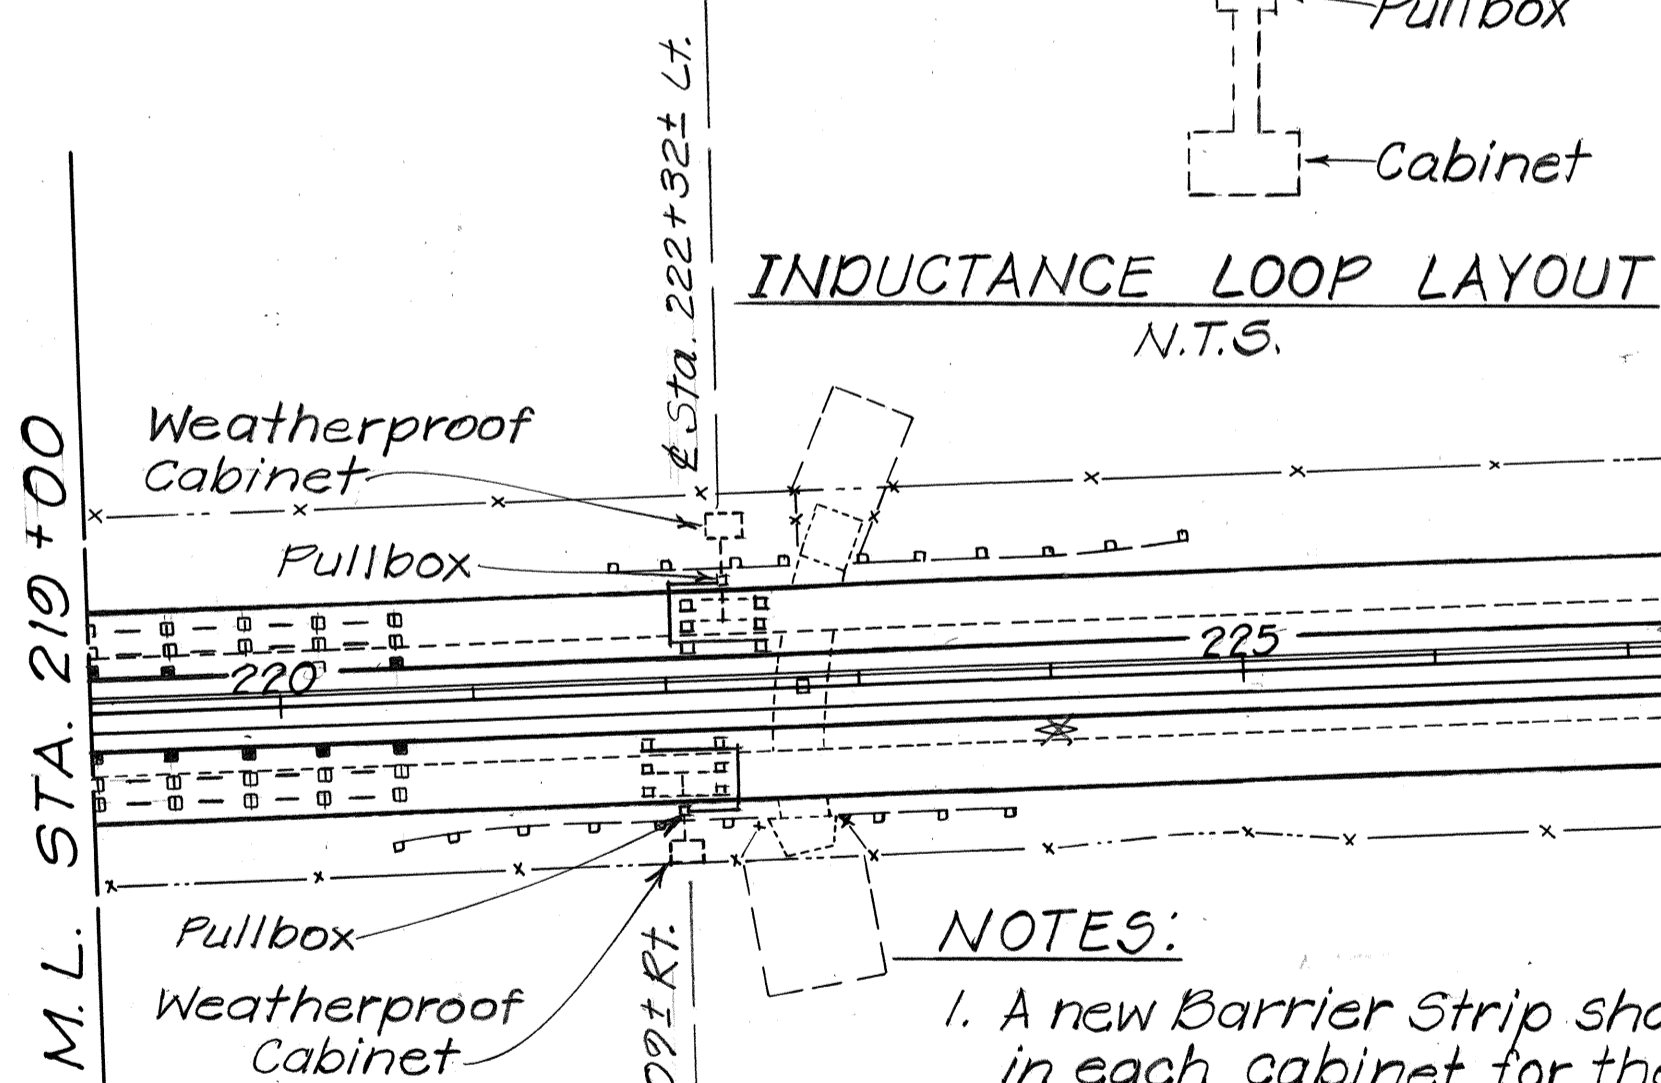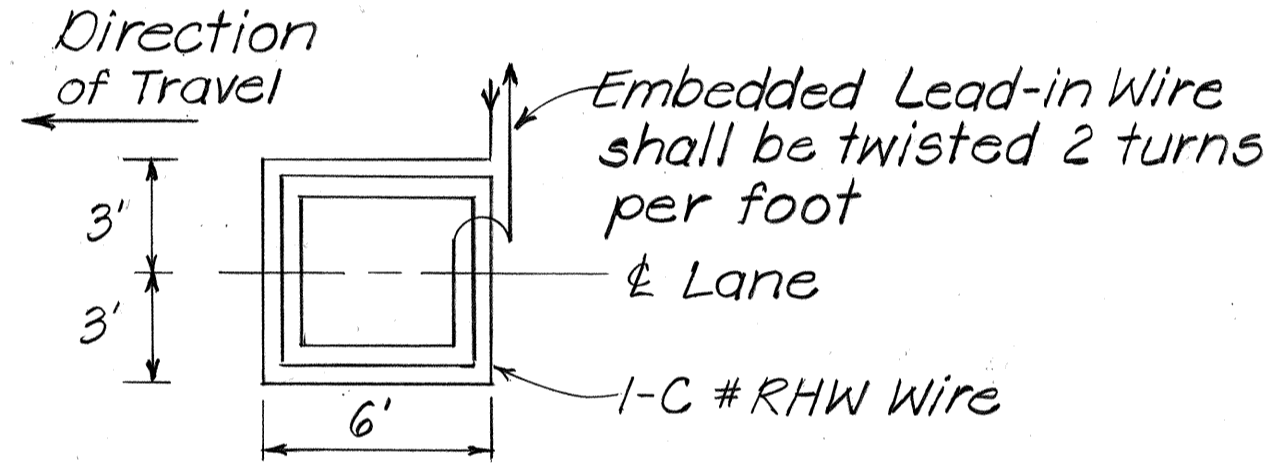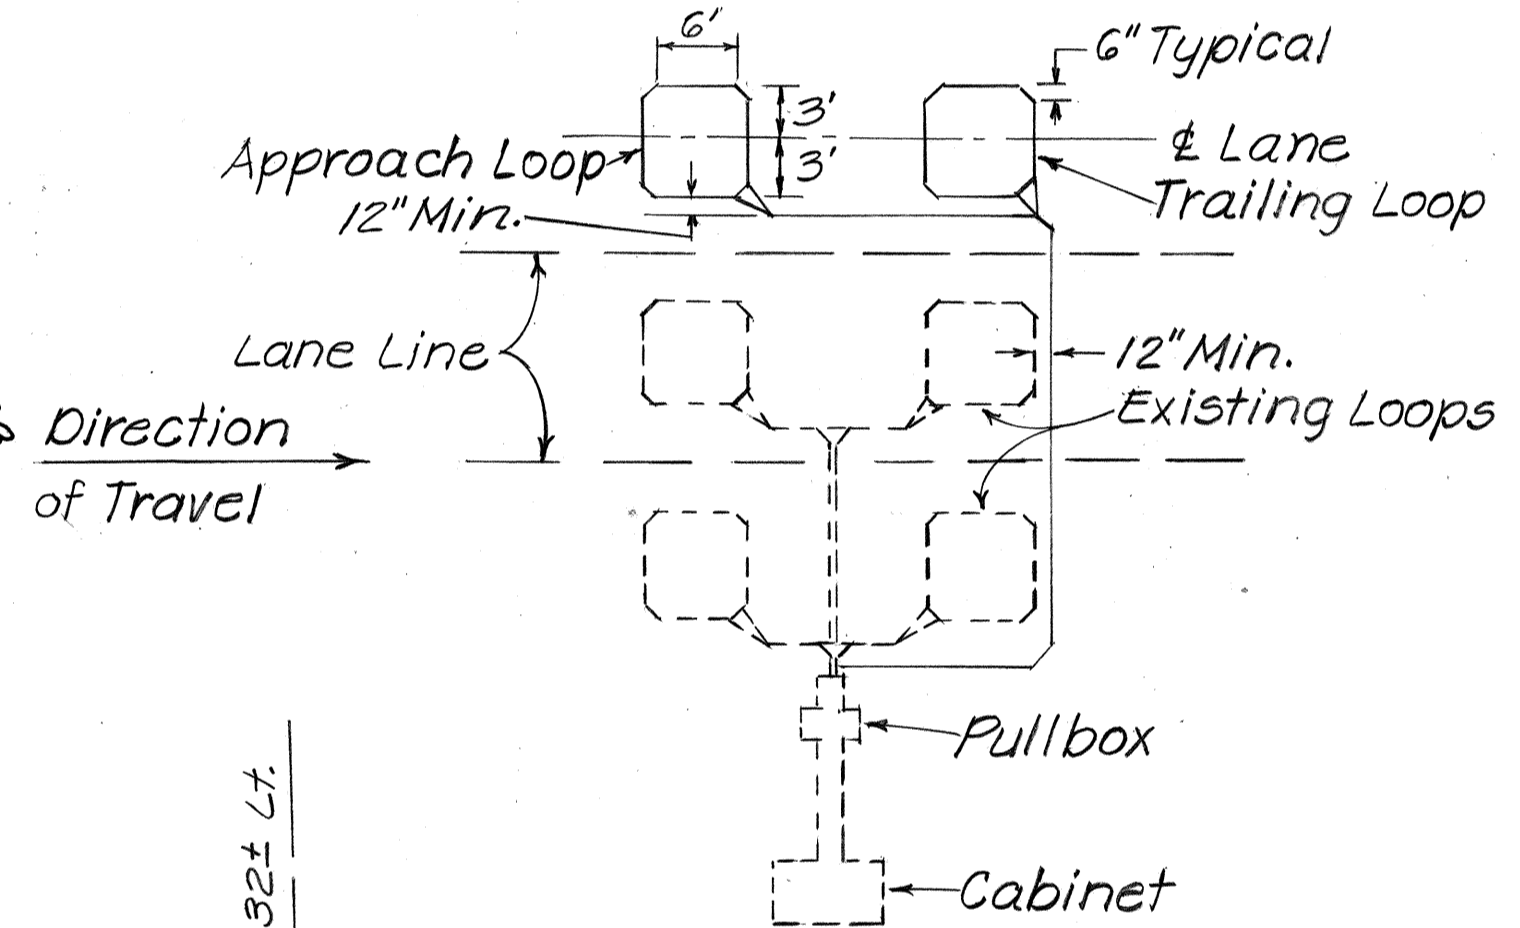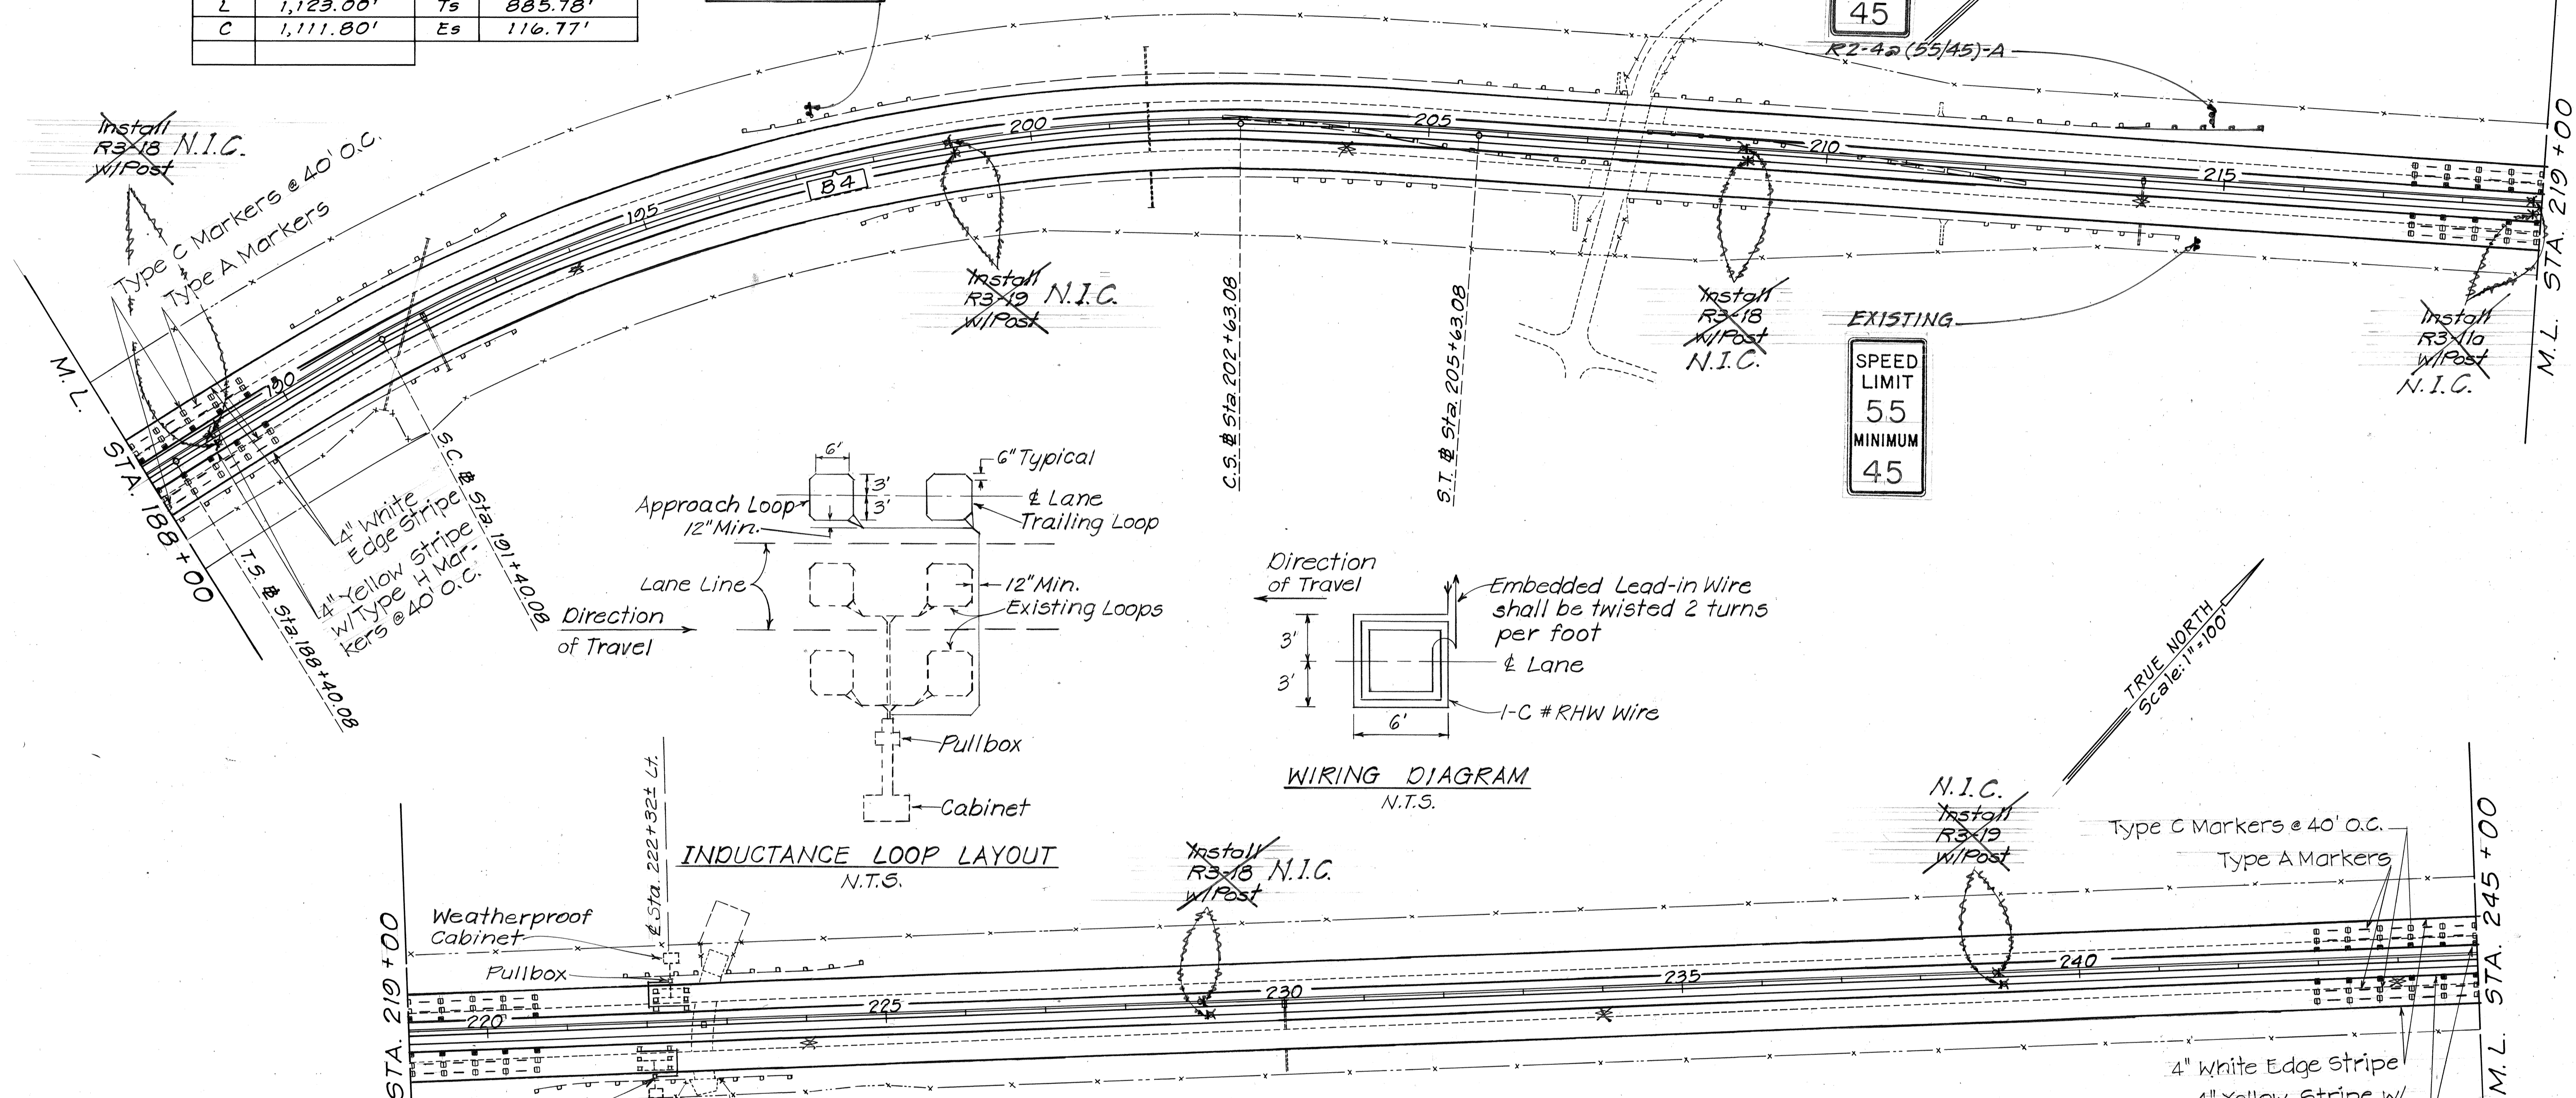

NOTES:

1. A new Barrier Strip shall be installed and labelled in each cabinet for the new inductance loop.
2. In each cabinet, the Contractor shall label the new inductance loop cable to differentiate what lane it is from and whether it is an approach or trailing cable. The approach cable is the first cable encountered in the direction of travel. The new lane, which is farthest from the cabinet, shall be labelled #1 and each lane approaching the cabinet shall be re-numbered in successive numerical order, one number per lane, i.e. #1 approach and #1 trailing.
3. New and existing loops shall not be spliced together.
4. Existing pullbox and cabinet shall be used. Contractor shall be responsible for any damage to existing cables and connections.
5. New conduits, if necessary, shall be steel or PVC Schedule 80.
6. Engineer will conduct test of all existing loops, inbound and outbound lanes prior to any work being performed. Upon completion of work, the Engineer will conduct tests to insure that the inductance loops have not been disturbed. Testing will be conducted by HWY-T. Contractor to notify HWY-T at 548-7467 at least 48 hrs. prior to work or after completion to allow for testing.

DATE	REVISION
6/13/86	Added Loop detector notes, details, and DT405
	C.C.O. No. 17

DATE	REVISION
3/3/88	Added Express Lane Signs

STATE OF HAWAII  
DEPARTMENT OF TRANSPORTATION  
HIGHWAYS DIVISION

**SIGNING, PAVEMENT MARKING PLAN**

INTERSTATE ROUTE H-1  
Palailai Interchange to Kunia interchange  
Construction of Additional Lanes


F.A.I. PROJ. No. IR-HI-1(182)  
Scale: 1"=100' Date: July, 1985  
SHEET NO. 4 OF 6 SHEETS

DATE: \_\_\_\_\_  
SURVEY PLOTTED BY: \_\_\_\_\_  
DRAWN BY: \_\_\_\_\_  
DESIGNED BY: \_\_\_\_\_  
CHECKED BY: \_\_\_\_\_  
NOTE BOOK NO. \_\_\_\_\_

FED. ROAD DIST. NO.	STATE	FED. AID PROJ. NO.	FISCAL YEAR	SHEET NO.	TOTAL SHEETS
HAWAII	HAW.	IR-HI-1(189)	1986	82	99

CURVE DATA		
	B5	B6
Δ	21° 02' 30"	8° 23' 30"
Δ/2	10° 31' 15"	4° 11' 45"
R	4,583.66'	6,500.00'
T	851.26'	476.85'
L	1,683.33'	952.00'
C	1,673.89'	951.15'
SE	0.035 ft./ft.	0.025 ft./ft.

TRUE NORTH  
Scale: 1"=100'

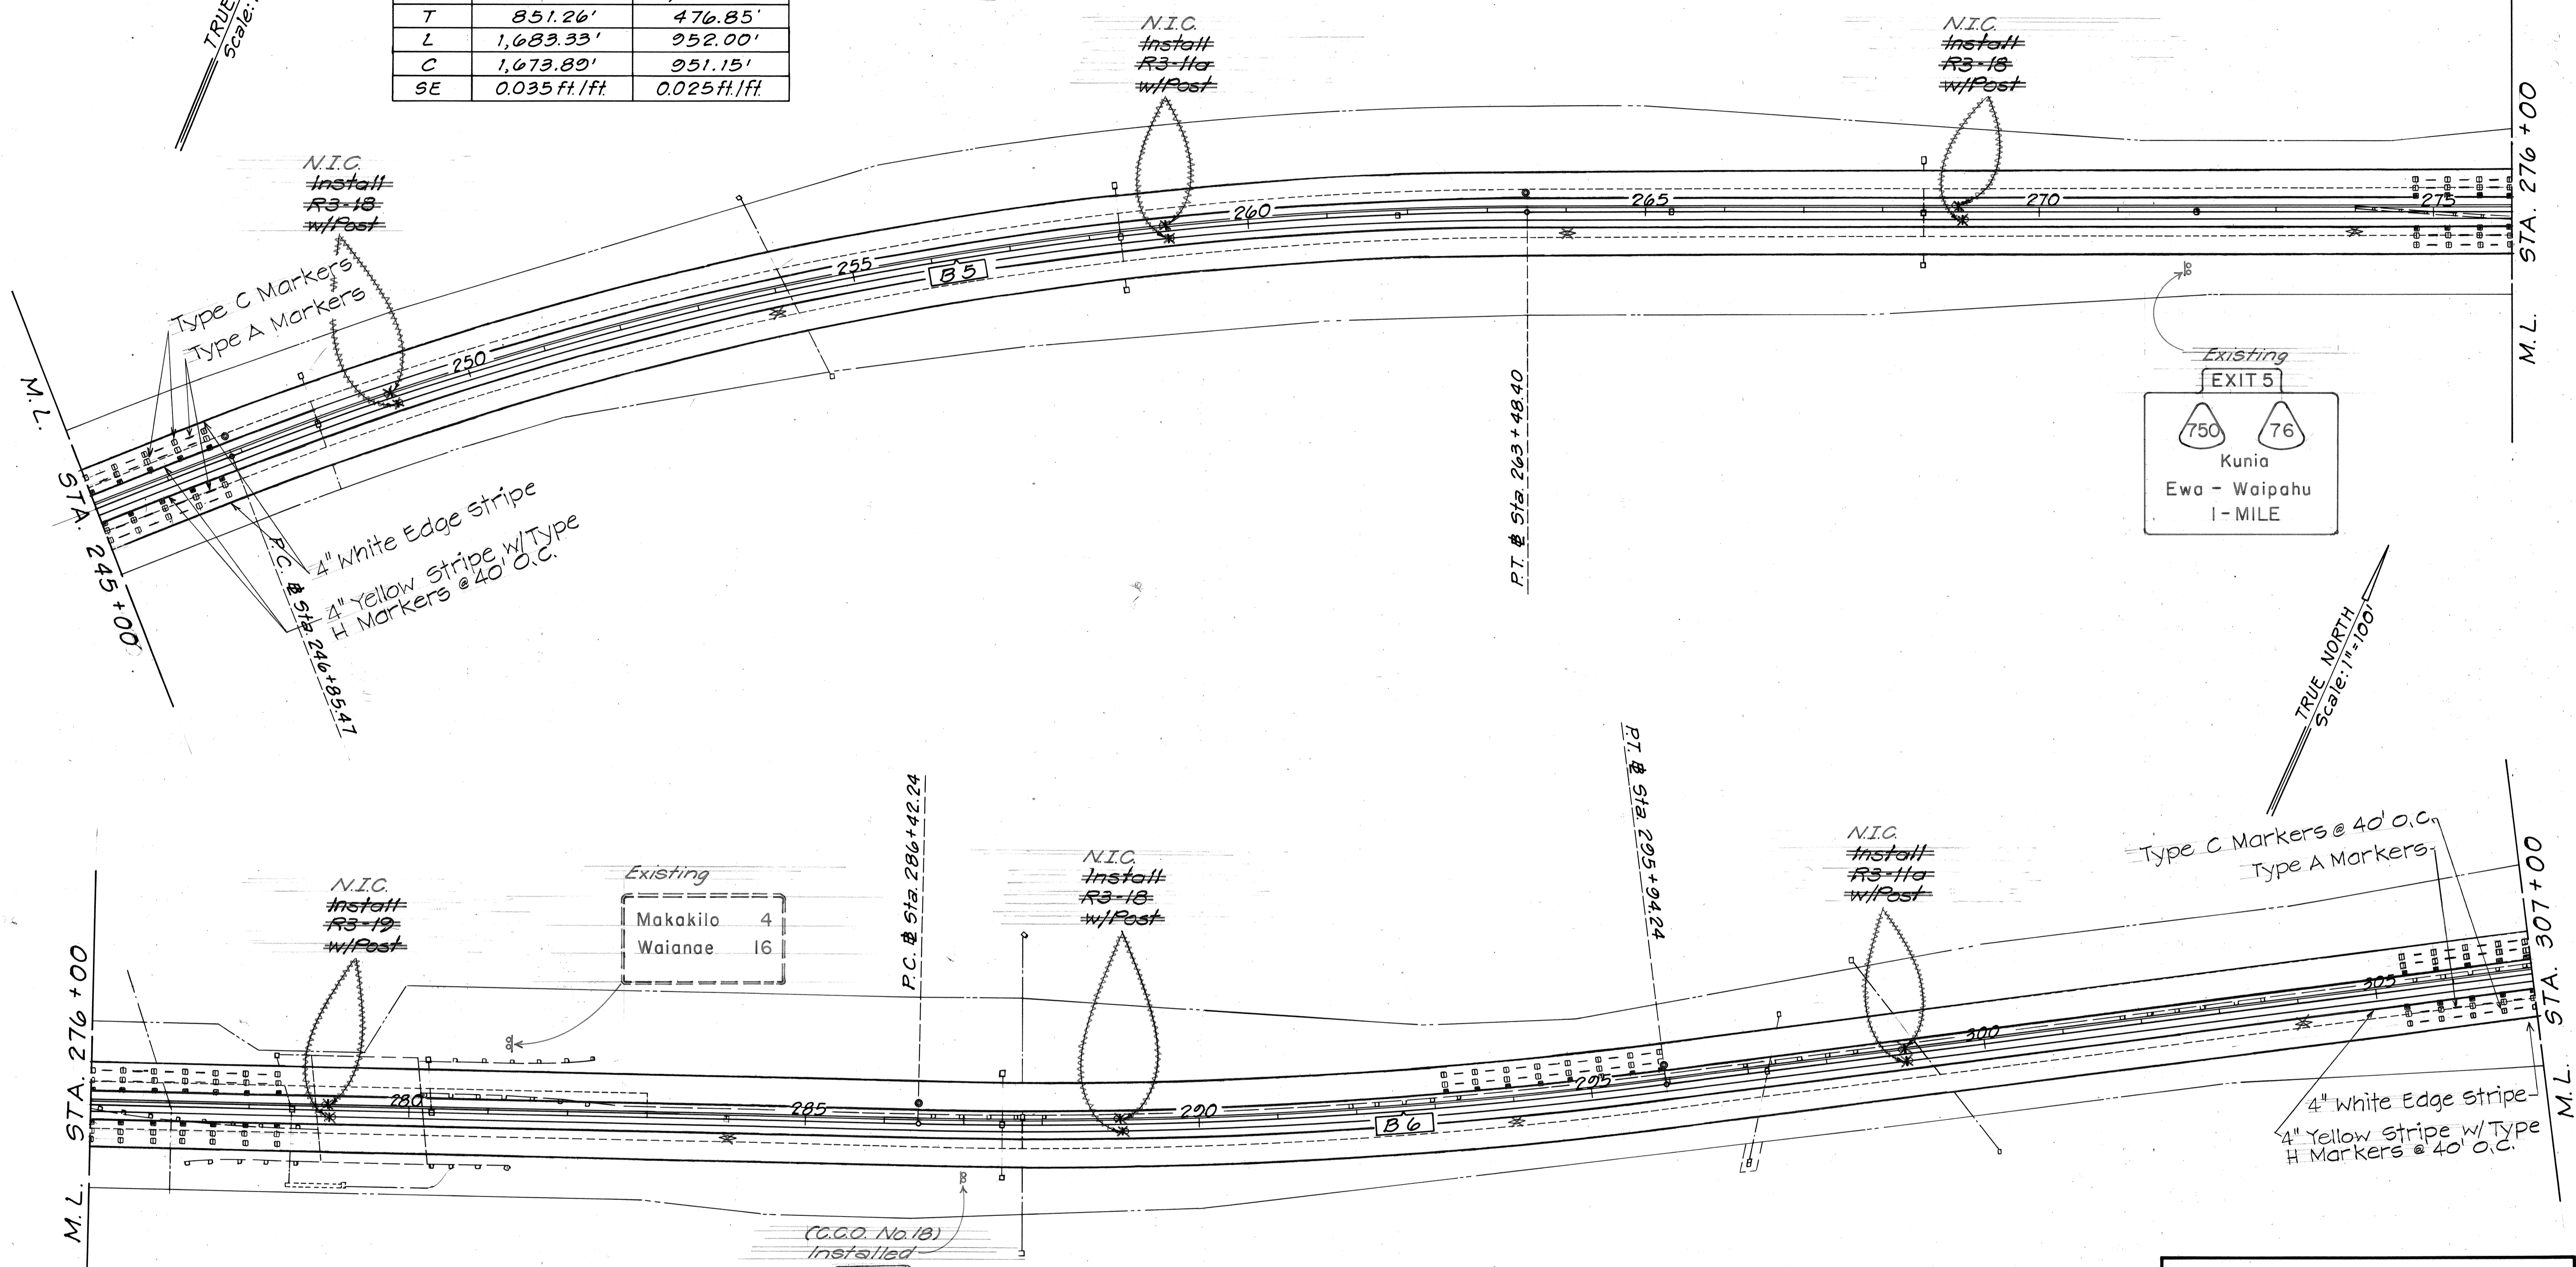

SURVEY PLOTTED BY	DATE
DRAWN BY	
TRACED BY	
QUANTITIES BY	
CHECKED BY	
ORIGINAL PLAN	No.
NOTE BOOK	

STATE OF HAWAII  
DEPARTMENT OF TRANSPORTATION  
HIGHWAYS DIVISION  
**SIGNING, PAVEMENT MARKING PLAN**  
*INTERSTATE ROUTE H-1  
Palailai Interchange to Kunia Interchange  
Construction of Additional Lanes*  
F.A.I. PROJ. No. IR-HI-1(189)  
Scale: 1"=100' Date: July, 1985  
SHEET No. 5 OF 6 SHEETS

DATE	REVISION
3/3/88	Added Express Lane Signs



FED. ROAD DIST. NO.	STATE	FED. AID PROJ. NO.	FISCAL YEAR	SHEET NO.	TOTAL SHEETS
HAWAII	HAW.	IR-HI-1(189)	1986	83	99

ADDITIONAL SIGNS FOR OUTBOUND LANES

- ~~Sta. 324+00 (Median) - R3-10c (500 FT.)~~
- ~~R3-20~~
- ~~Sta. 329+00 (Median) - R3-10b (1000 FT.)~~
- ~~R3-20~~
- ~~Sta. 334+00 (Median) - R3-10a (1500 FT.)~~
- ~~R3-20~~
- ~~Sta. 339+00 (Median) - R3-10d (AHEAD)~~

N. I. C.


EXISTING      EXISTING      EXISTING

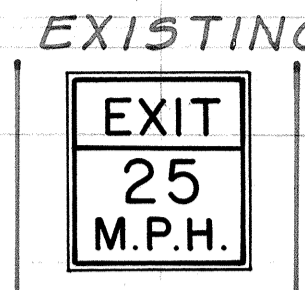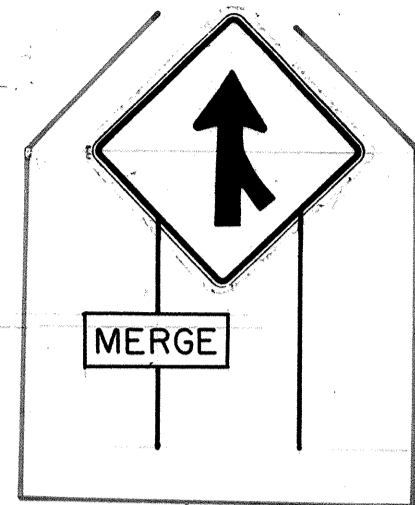

TRUE NORTH  
Scale: 1"=100'


GENERAL NOTES

1. Remove and replace all existing regulatory and warning signs at location shown on plans or as directed by the Engineer.
2. Existing pavement markers, striping and markings not incorporated into the final traffic pattern shall be removed as directed by the Engineer.
3. For additional Pavement Marking details, see Standard Detail Sheets DT 300, DT 302, and DT 304.
4. All striping will be either tape or thermoplastic extrusion except for 4" edge stripe.
5. Channelizing Island detail as shown on legend supersedes detail shown on Standard Detail DT 300 and DT 302.
6. All overlay panels shall conform to Section G21 of the Special Provisions and the latest editions and amendments of the following FHWA Publications:
  - a. "Manual on Uniform Traffic Control Devices for Streets and Highways (MUTCD)"
  - b. "Standard Highway Signs."
  - c. "Standard Alphabets for Highway Signs."
7. Overlay panels shall be installed on the existing sign panels with 1/8" blind rivets with a maximum spacing of 1'-0" O.C.
8. Details of Type C and Type H Markers on Plan Sht. shall be deleted and replaced with details of Type CL and Type HL Markers as shown on this sheet. All references to Type C and Type H Markers in the plans shall mean Type CL and Type HL Markers.

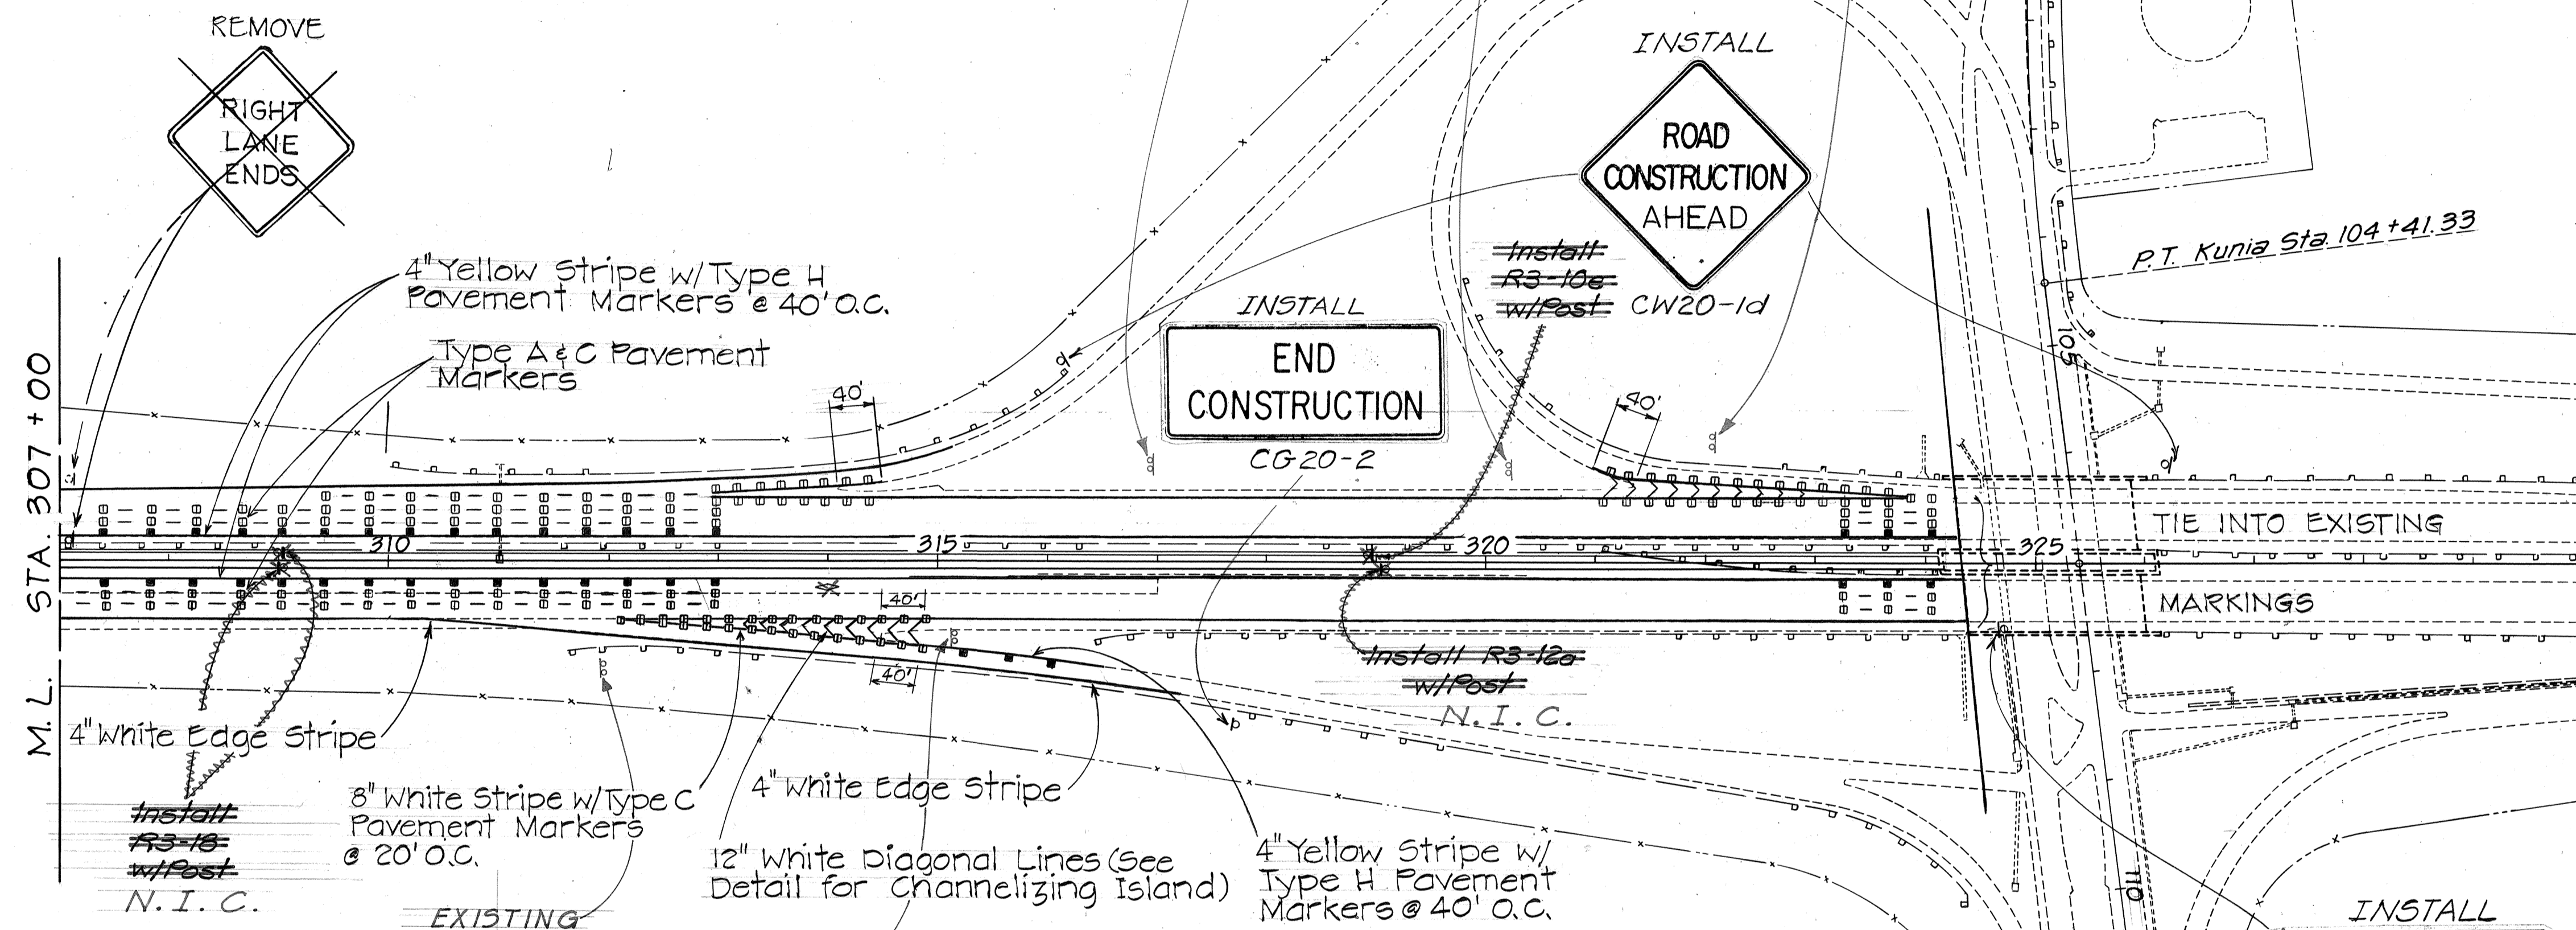


LEGEND

- Type C Pavement Marker
- 4 each Type A Pavement Marker
- 8" White Stripe (Tape w/Type C Pavement Markers @ 20' O.C.)
- 4" Yellow Edge Stripe (Paint) w/Type H Pavement Markers @ 40' O.C.
- 4" White Guide Line
- 4" White Edge Stripe (Paint)
- 8" White Stripe (Tape)
- 12" White Stripe (Tape)
- Type C Pavement Markers @ 20' O.C.
- Channelizing Island

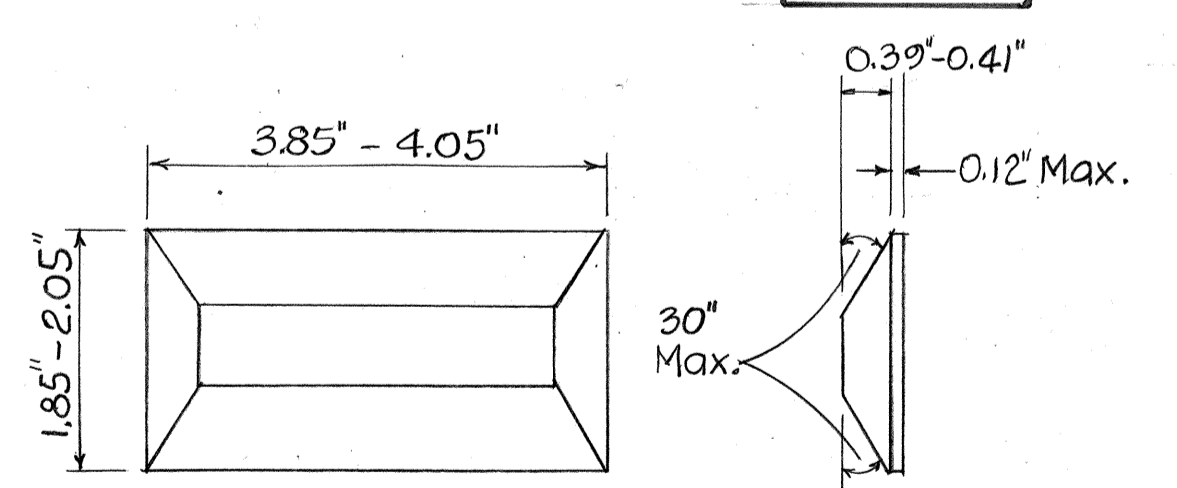

TYPE CL, TYPE HL MARKERS  
RED-CLEAR REFLECTIVE MARKER (CL)  
or  
ONE-WAY YELLOW REFLECTIVE MARKER (HL)

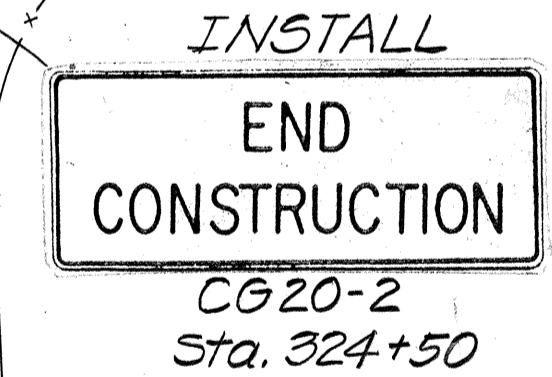

DATE	REVISION
3/3/88	Added Express Lane Signs
2/11/87	Revised Striping of Outbound Lanes between H-1 Off Ramp to Kunia Rd. and On Ramp from Kunia Rd.

STATE OF HAWAII  
DEPARTMENT OF TRANSPORTATION  
HIGHWAYS DIVISION  
**SIGNING, PAVEMENT MARKING PLAN**

*INTERSTATE ROUTE H-1  
Palailai Interchange to Kunia Interchange  
Construction of Additional Lanes*


F.A.I. PROJ. No. IR-HI-1(189)

Scale: 1"=100'      Date: July, 1985


SHEET NO. 6 OF 6 SHEETS

SURVEY PLOTTED BY: \_\_\_\_\_ DATE: \_\_\_\_\_  
 DRAWN BY: \_\_\_\_\_  
 DESIGNED BY: \_\_\_\_\_  
 CHECKED BY: \_\_\_\_\_  
 ORIGINAL PLAN NO. \_\_\_\_\_  
 NOTE BOOK NO. \_\_\_\_\_

FED. ROAD DIST. NO.	STATE	FED. AID PROJ. NO.	FISCAL YEAR	SHEET NO.	TOTAL SHEETS
HAWAII	HAW.	1-HI-1(189)	1986	84	99

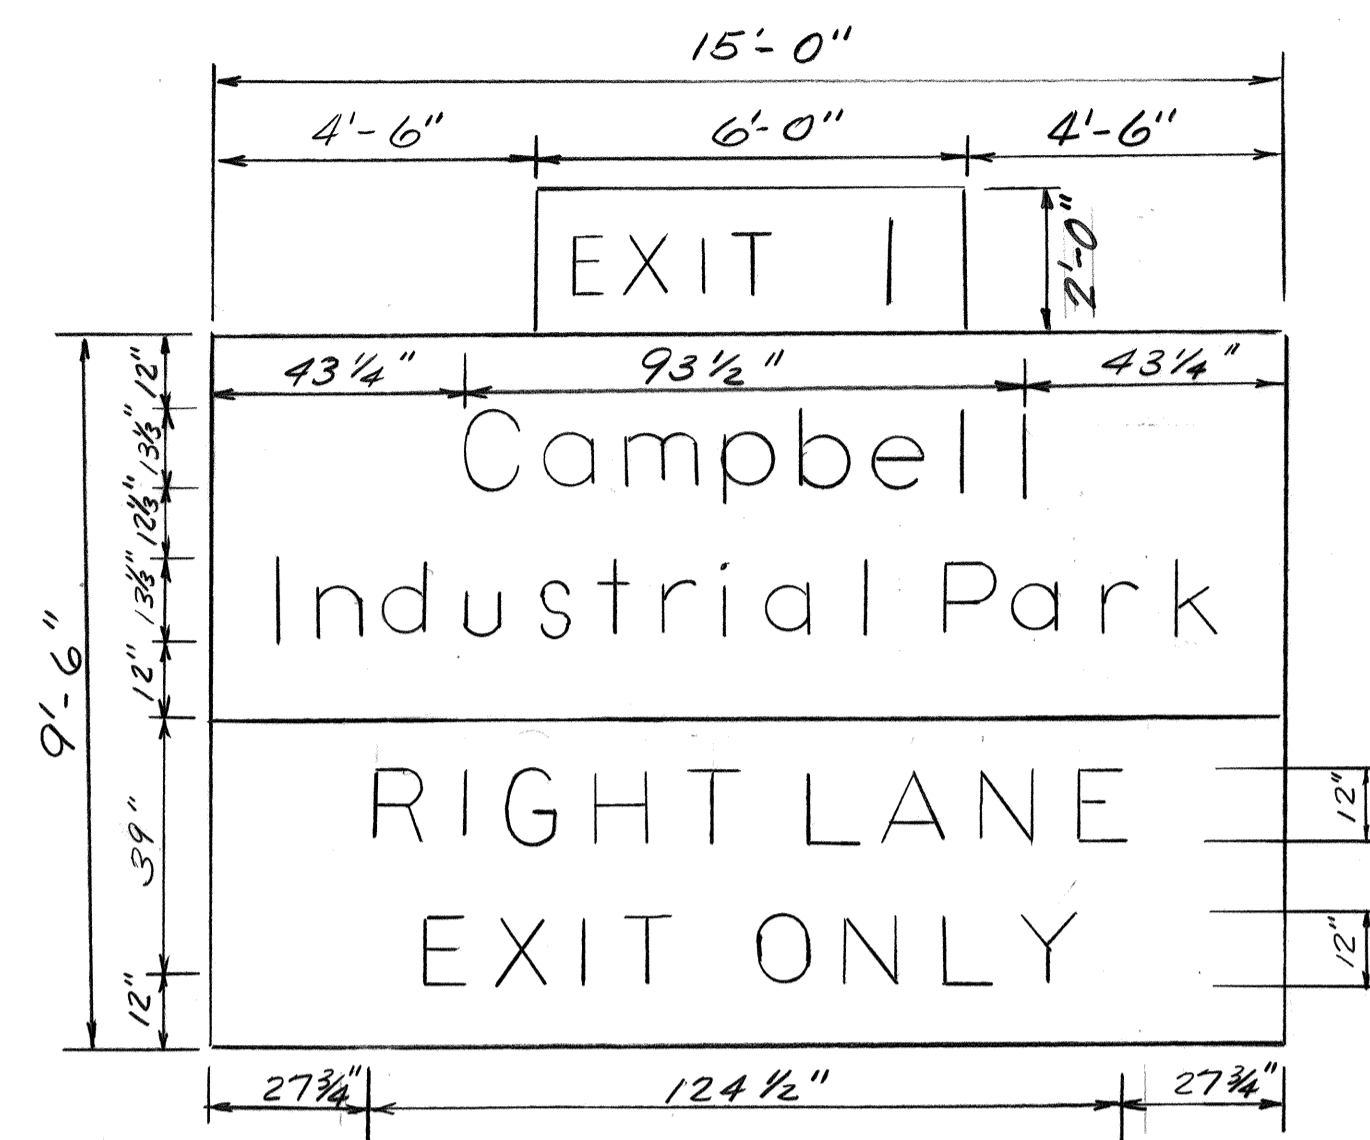


DESTINATION SIGN D-2  
3/8" = 1'-0"

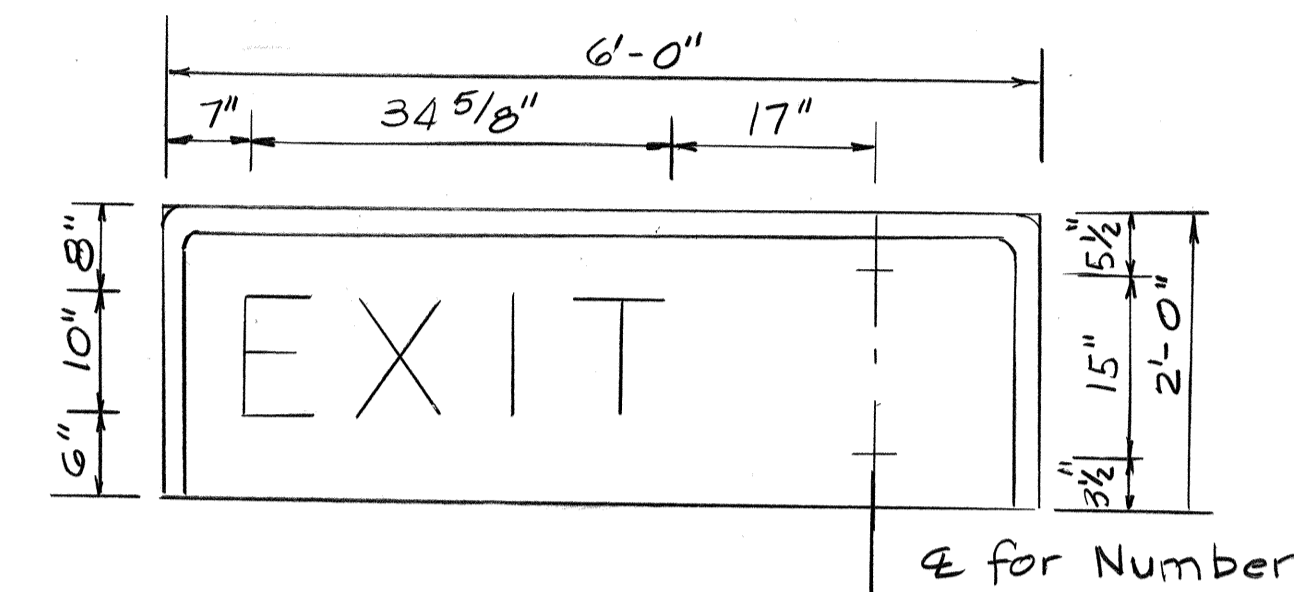


EXIT NUMBER PANEL  
SINGLE NUMBER

GENERAL NOTES

1. Sign messages shall be lettered according to "Standard Alphabets for Highway Signs", Bureau of Public Roads, 1966. Use Modified Series "E" capital letters and numerals unless otherwise specified.
2. All Guide Signs shall have borders.
3. Arrows, borders and route markers shall conform with details as shown on plans.
4. The special panel reading "EXIT ONLY" or "RIGHT LANE EXIT ONLY" shall have black legends on a yellow high intensity reflective sheeting background mounted on a flat aluminum cut-out.
5. Design of Exit Number Panels shall conform to all plans and specifications for either Destination or Expressway sign to which the Exit Number Panel will be attached.

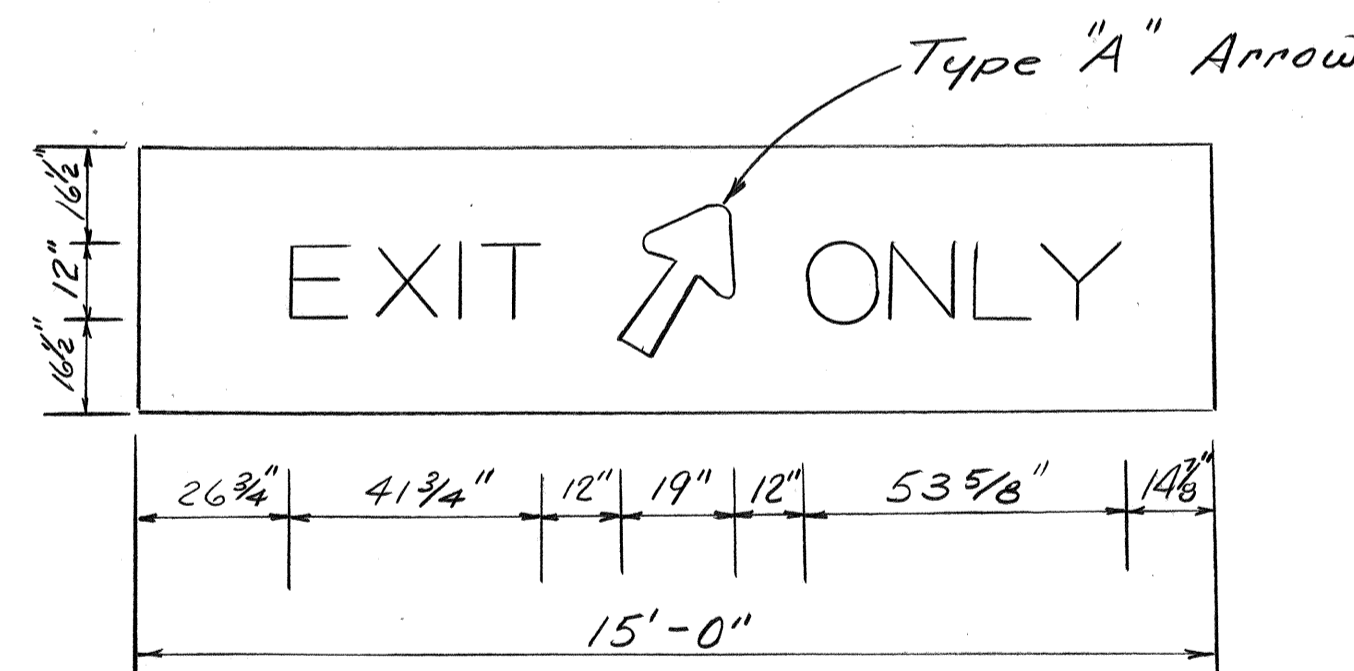

OVERLAY SIGN D-1  
3/8" = 1'-0"

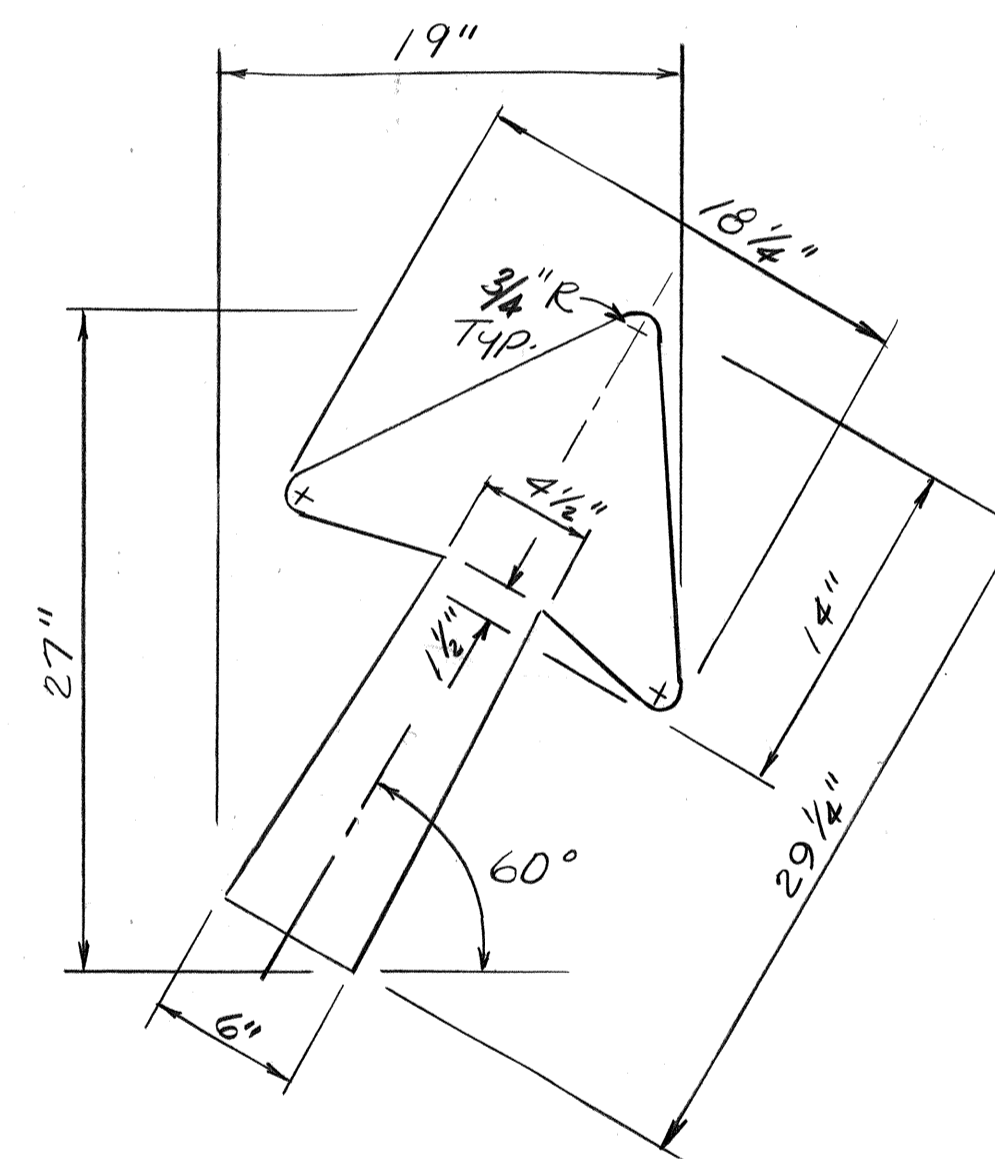

TYPE "A" DIAGONAL  
ARROW DETAIL  
n.t.s.

SURVEY PLOTTED BY	DATE
DRAWN BY	
TRACED BY	
QUANTITIES BY	
CHECKED BY	
ORIGINAL PLAN	
NOTE BOOK	
No.	

STATE OF HAWAII  
DEPARTMENT OF TRANSPORTATION  
HIGHWAYS DIVISION

**SIGN PANEL LAYOUT**

INTERSTATE ROUTE H-1  
Palailai Interchange to Kunia Interchange  
Construction of Additional Lanes


F.A.I. Proj. No. IR-HI-1(189)  
Scale: As Noted Date: Aug. 1985

SHEET NO. OF SHEETS


FED. ROAD DIST. NO.	STATE	FED. AID PROJ. NO.	FISCAL YEAR	SHEET NO.	TOTAL SHEETS
HAWAII	HAW.	IR-HI-1(189)	1986	85	99

**GENERAL NOTES**






- Signs shall be placed in conformance with positions shown and described in the "Manual on Uniform Traffic Control Devices for Streets and Highways", 1978, Part II, Section 2A-21, as amended, and as supplemented herein.
- Sign 48" and wider or larger than 10 sq. ft. in area shall be mounted on two or more sign posts except as noted below.
- Signs 48" and wider or larger than 10 sq. ft. in area may be mounted on objects other than sign posts (i.e. on highway lighting poles) as follows:
  - Signs 48" and wider but less than 10 sq. ft. in area shall be mounted with a minimum of two sets of band bracket and back braces.
  - Signs larger than 10 sq. ft. and less than 28 sq. ft. in area shall be mounted with a minimum of two sets of band brackets and back braces.
  - Signs larger than 28 sq. ft. in area shall be mounted with a minimum of three sets of band bracket and back braces.
- All parking restriction signs with arrows shall be mounted 45° to the line of traffic flow.
- Sign posts shall extend 3 1/2" above each sign, where required, for attachment of City and County street name signs.
- (R) or (L) indicates right or left and shown on the plans.
- \* See plans for special details of signs along bikeways.
- \*\* 8. The minimum lateral distances shown are guidelines and shall be exceeded whenever possible. The Contractor shall place signs at the maximum practical lateral distance from the edge of the traveled way up to 30 feet and shall utilize protected locations whenever possible. Final locations of all signs shall be approved by the Engineer.
- Signs in medians shall be placed at midpoint of median up to a maximum distance of 30 feet from the edge of traveled way. When appropriate, signs for opposing directions shall be placed back to back.
- Anchor bases shall be installed for all signpost installations, unless otherwise shown or directed. See sheets DT 100A and DT 100B.

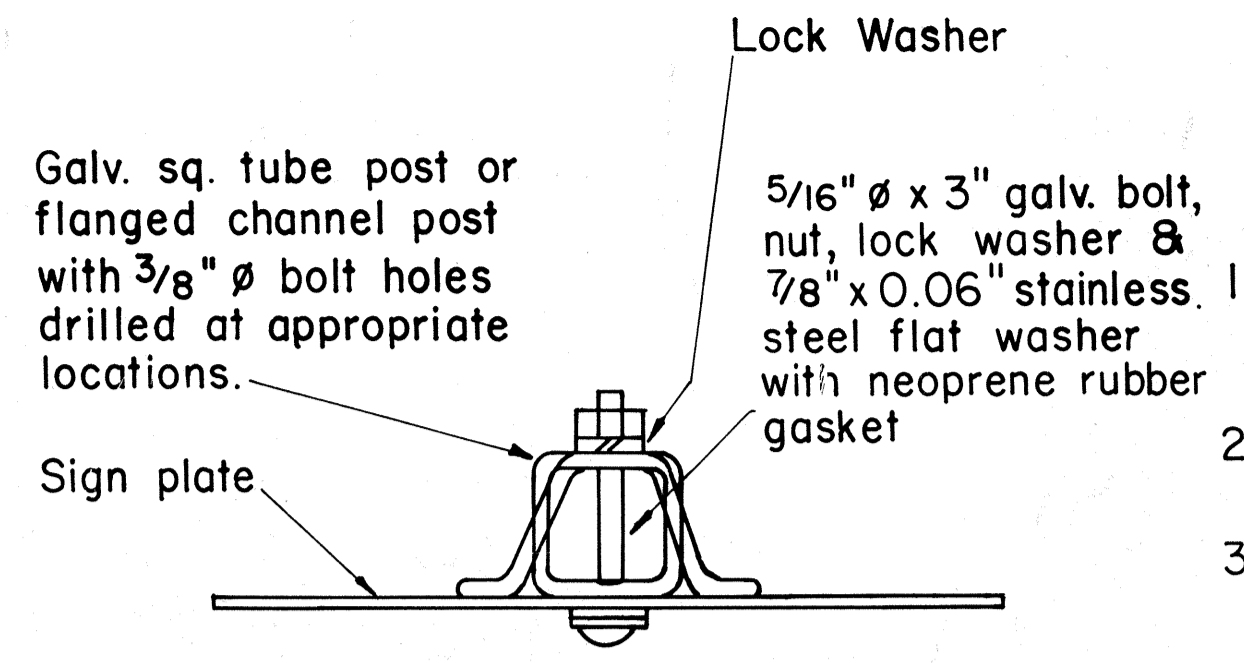

**GALVANIZED SQUARE TUBE OR FLANGED CHANNEL POST**

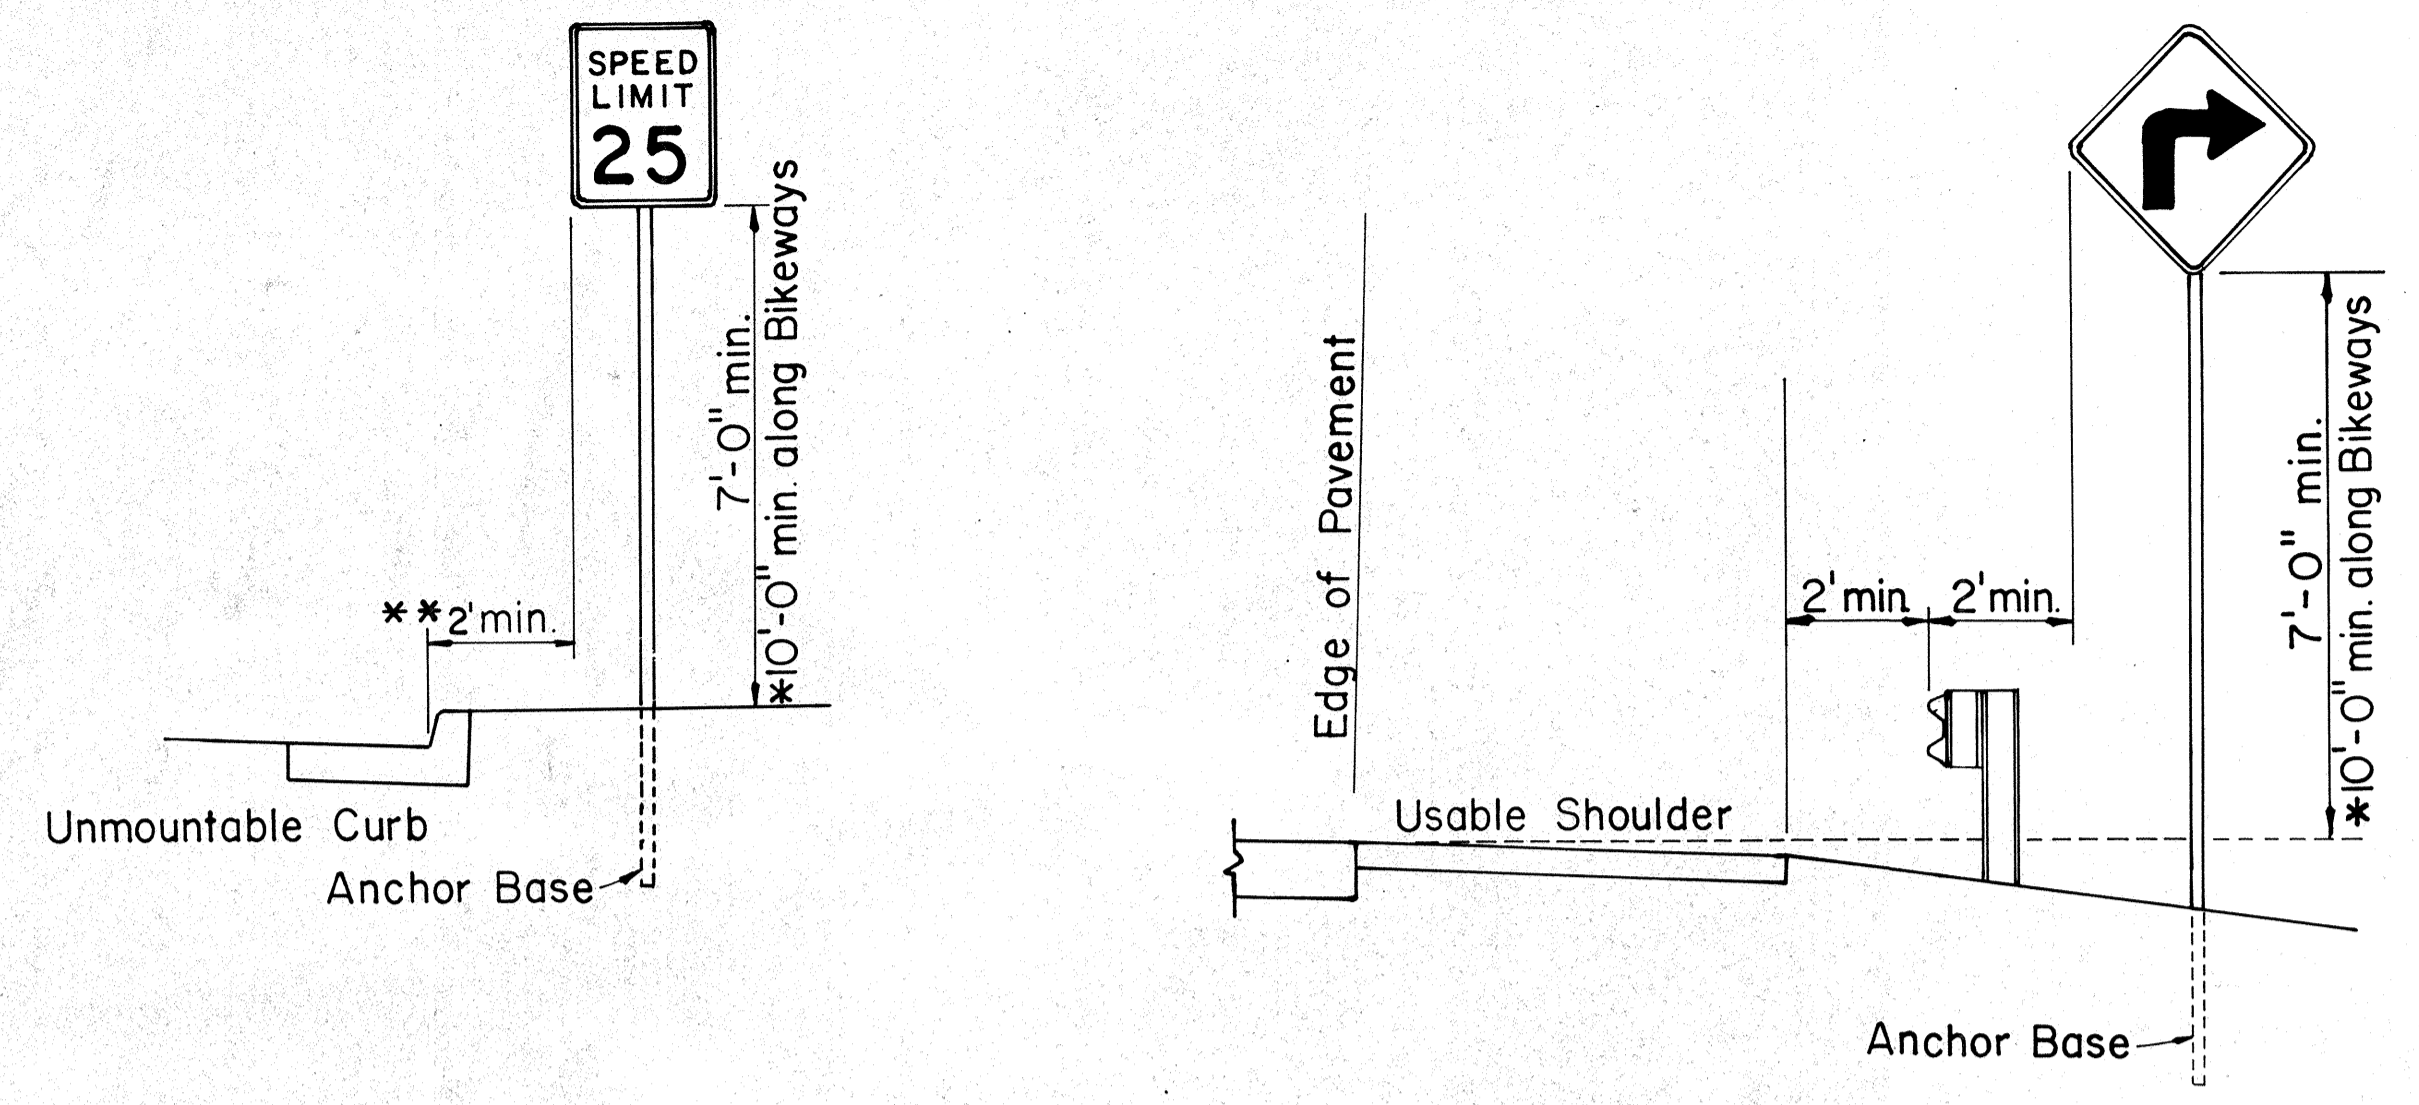

**ROADSIDE ASSEMBLY RURAL DISTRICT**

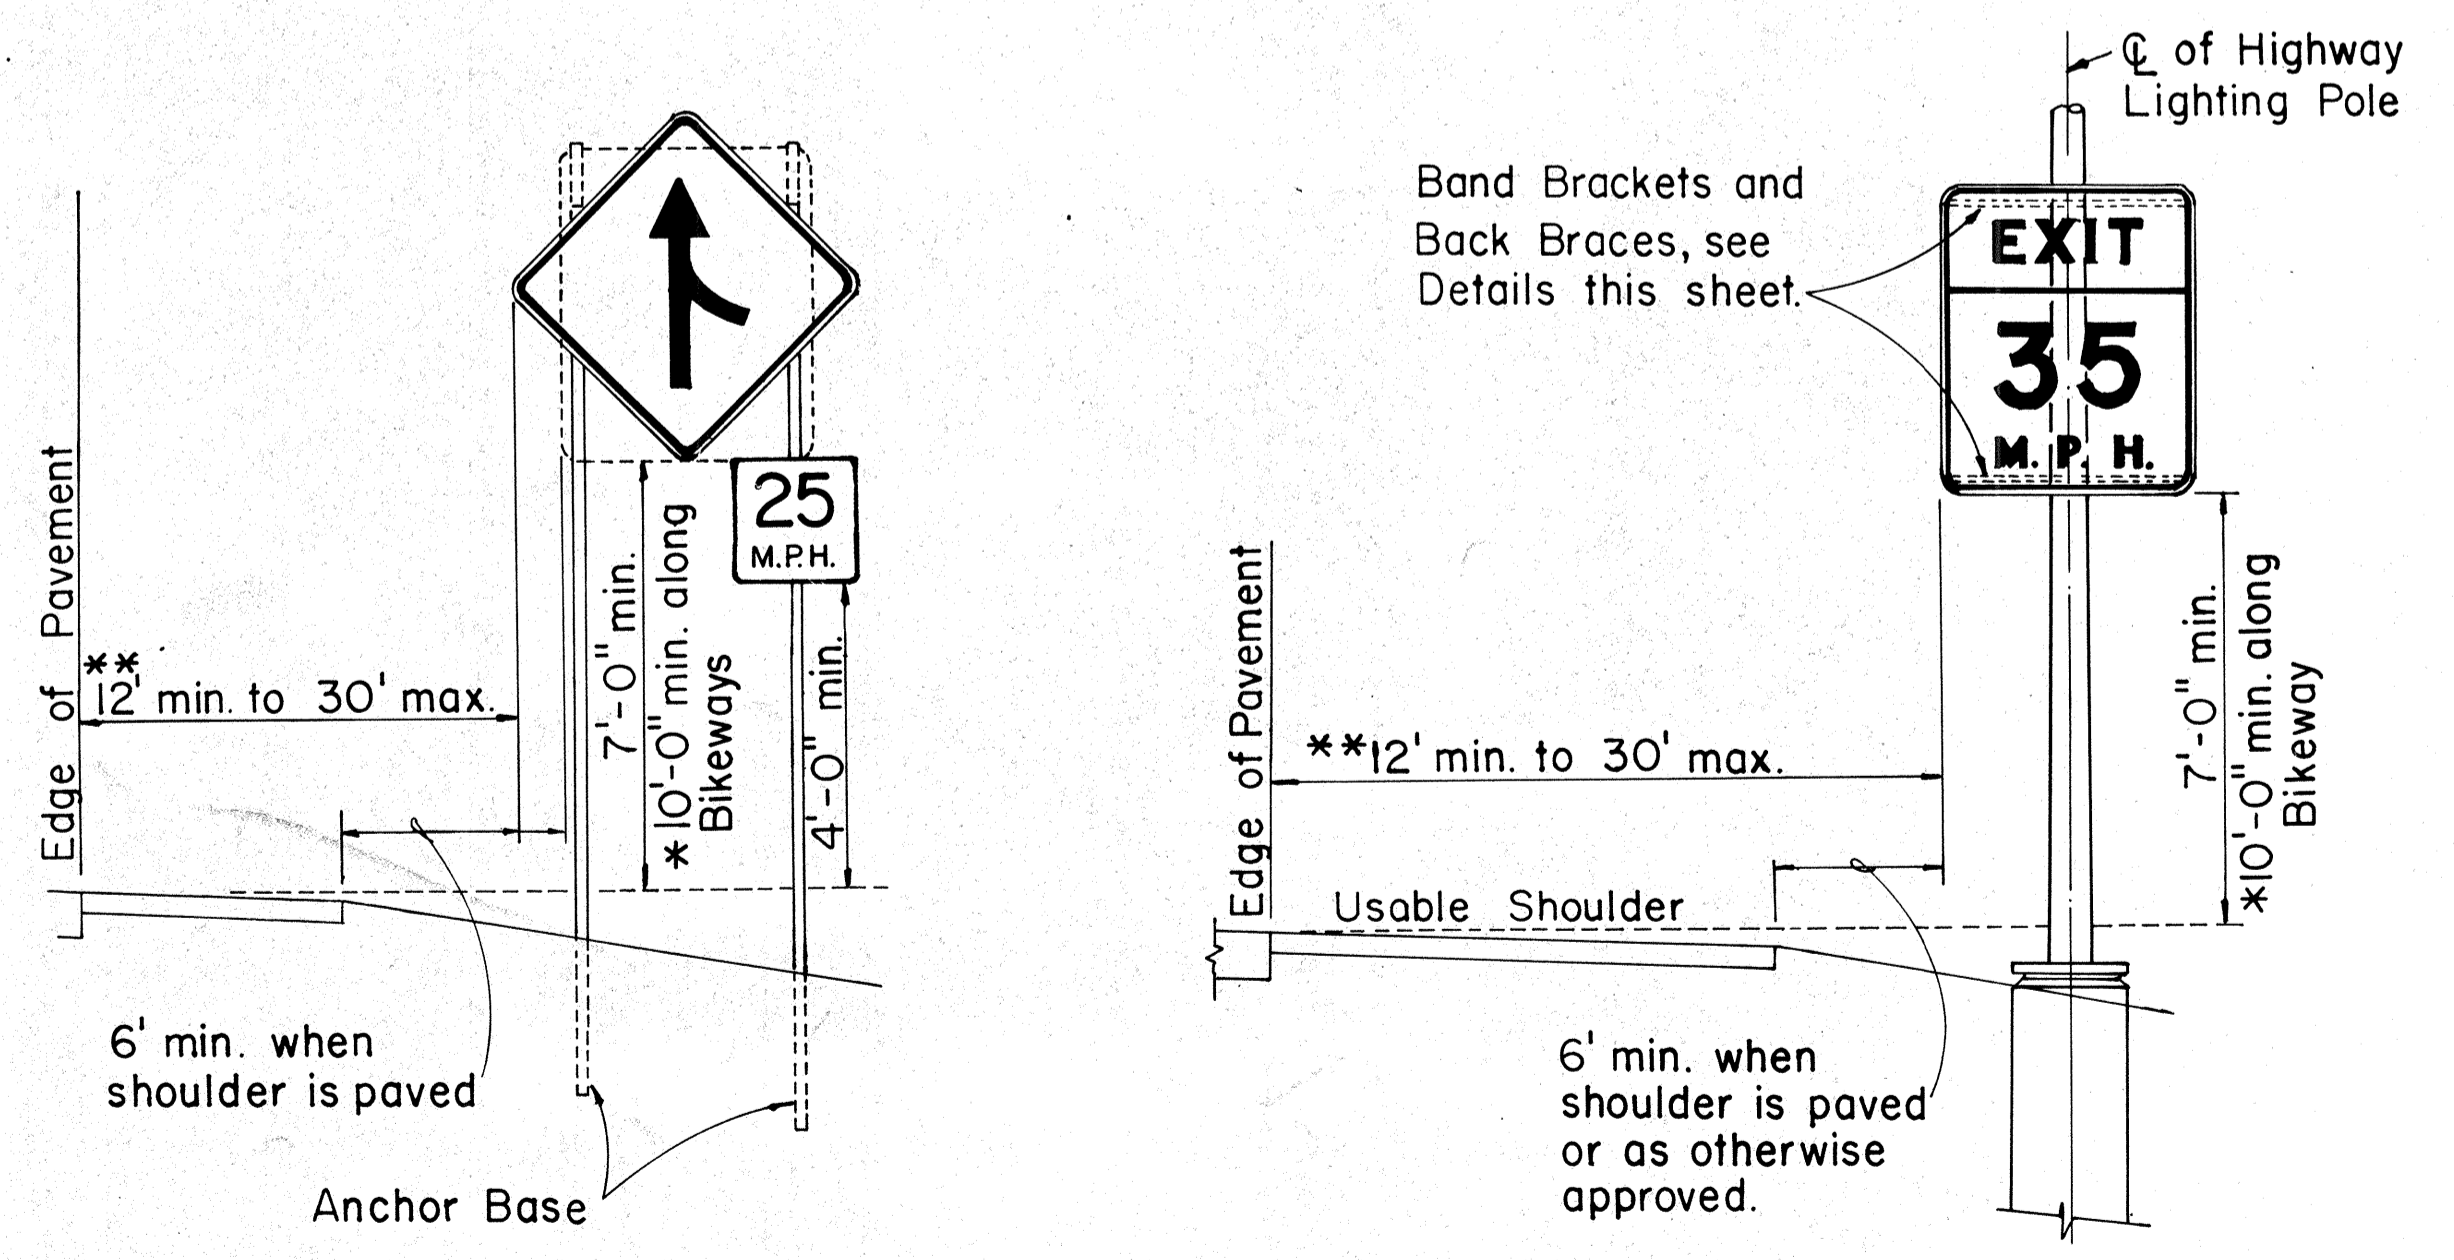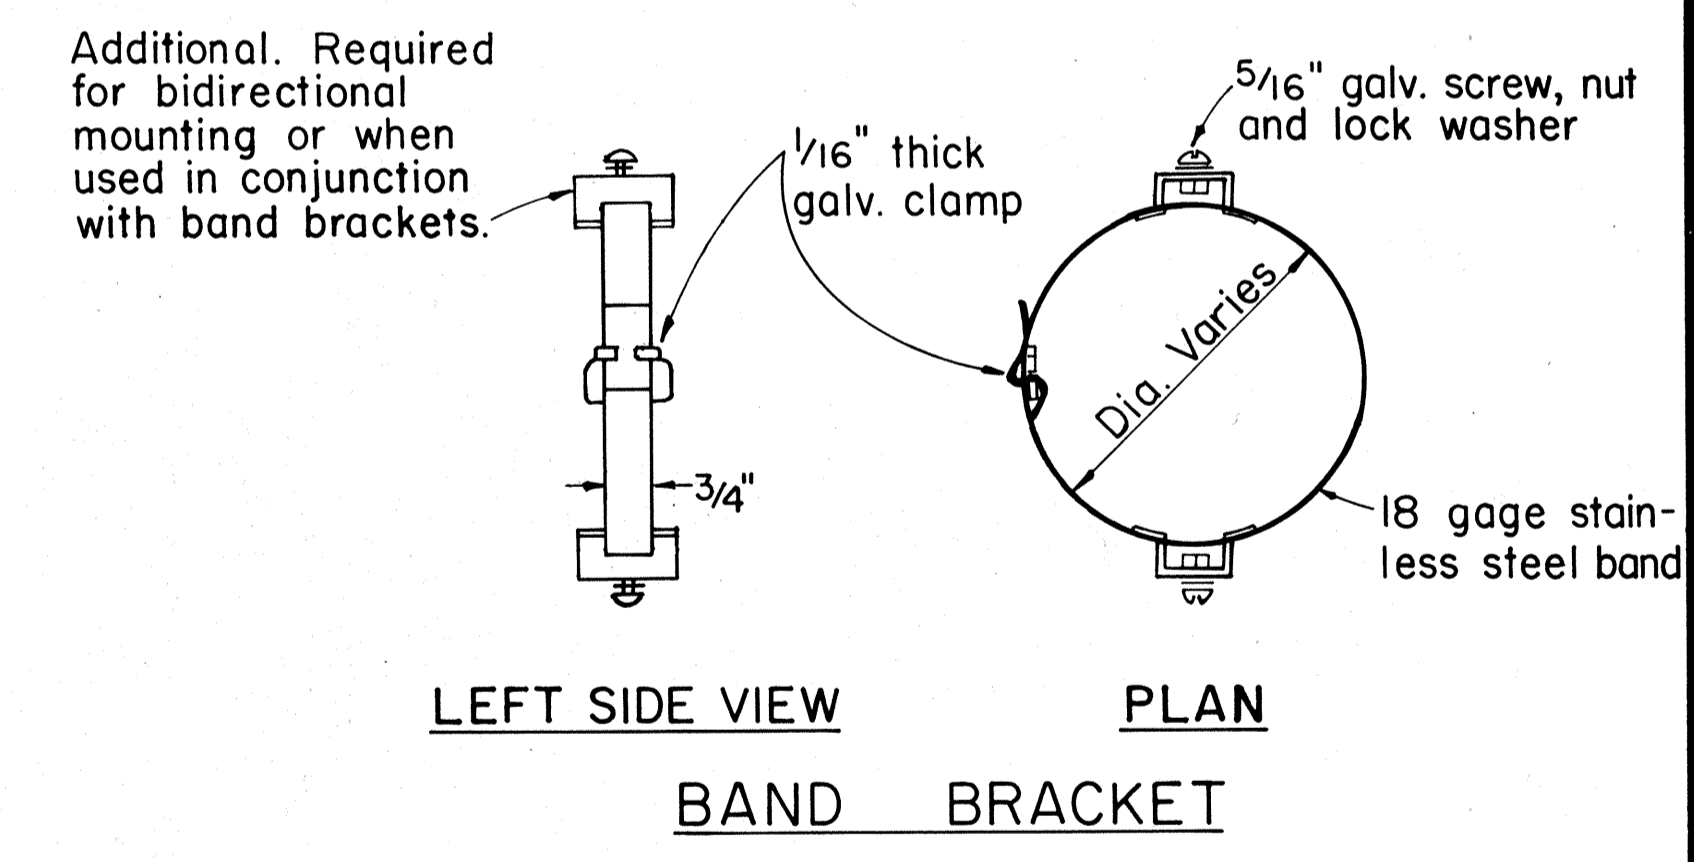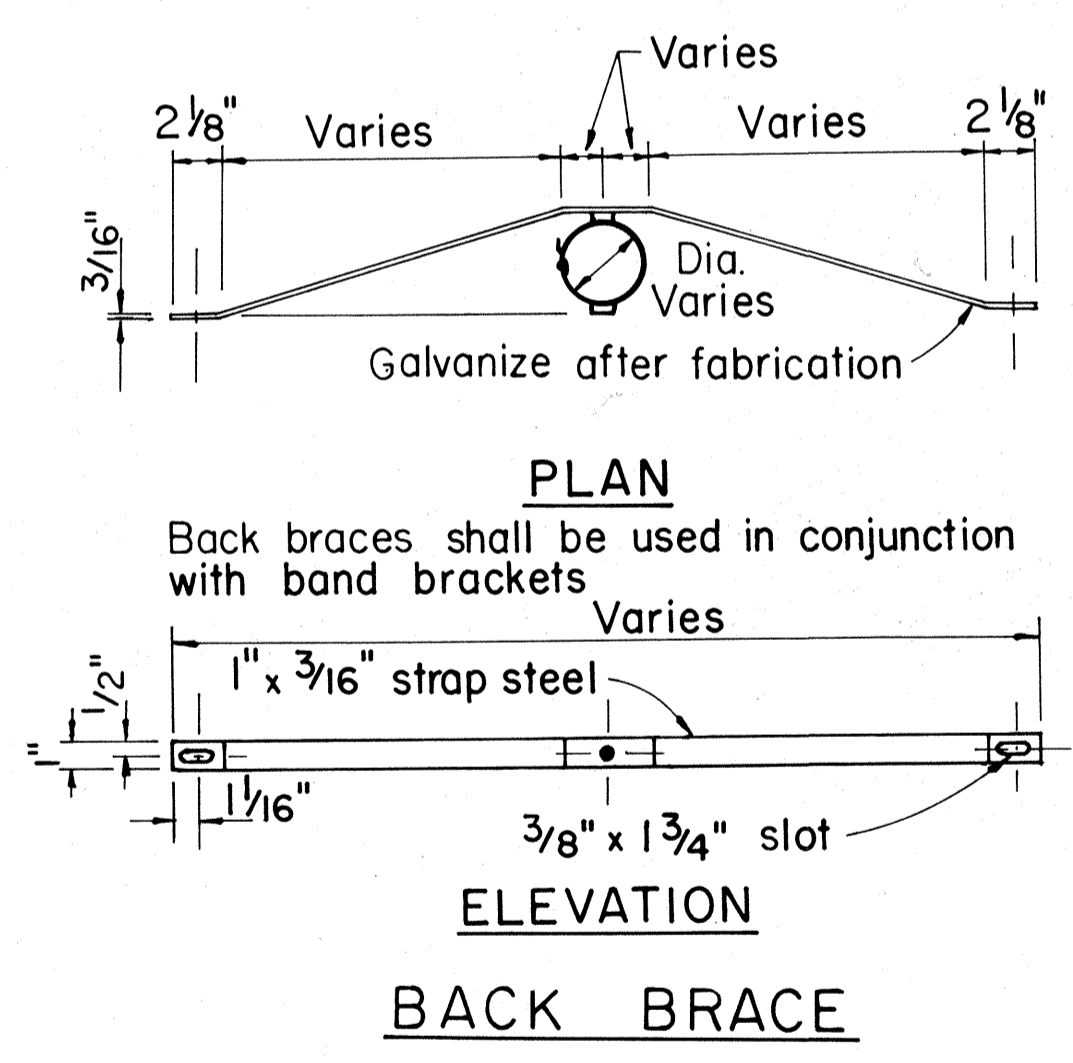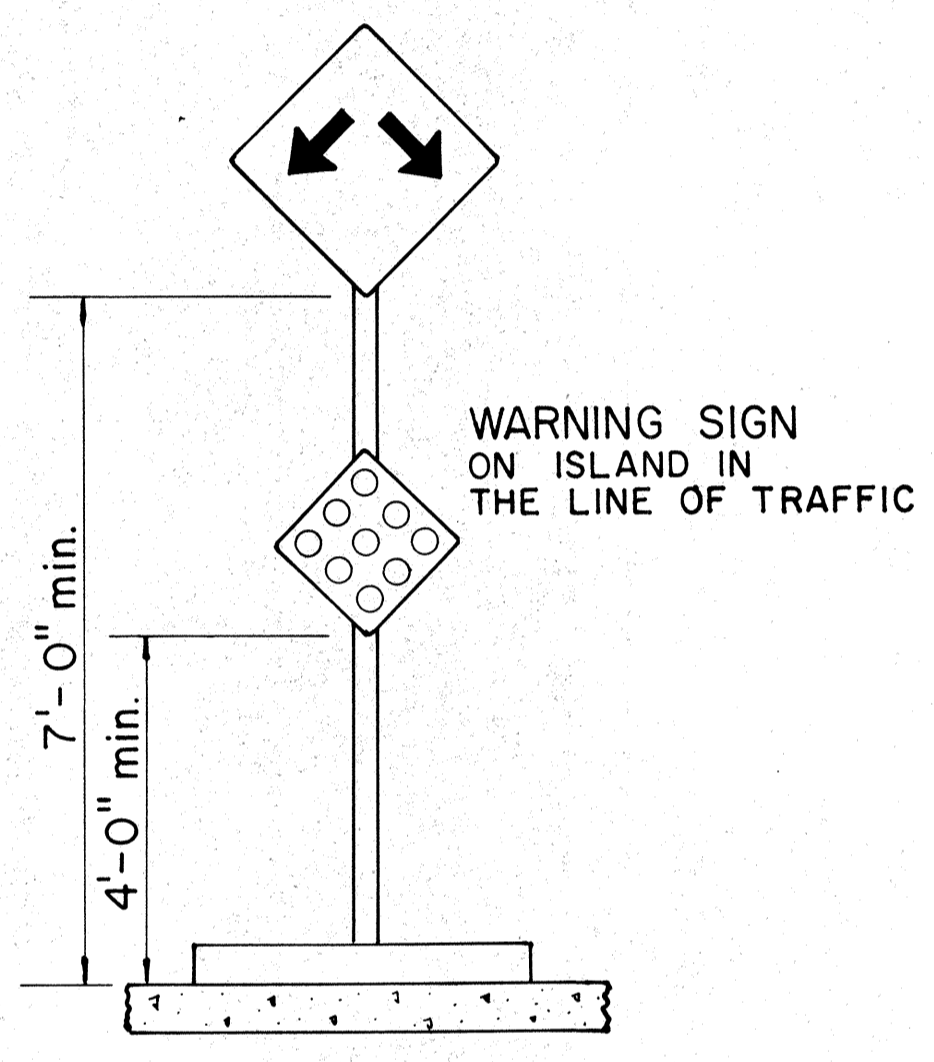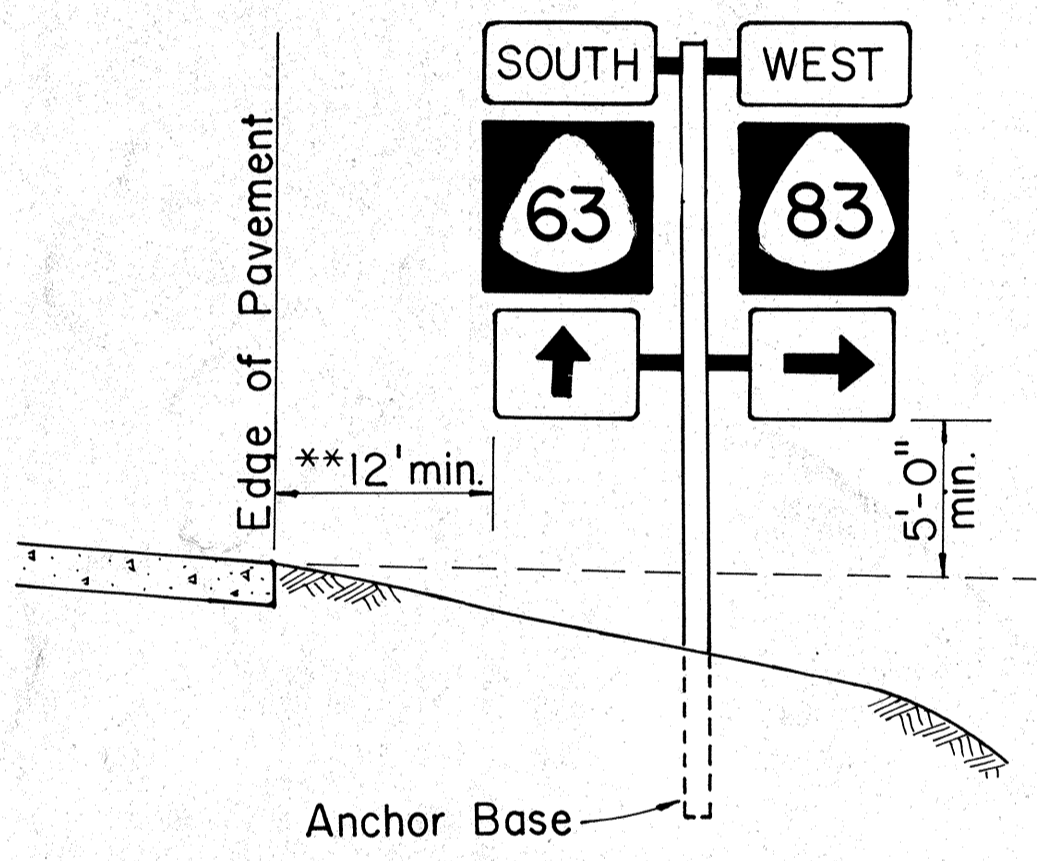

**TYPICAL MOUNTING DETAILS**

NO.	REVISION	APPROVED BY	DATE
1	Supersedes Sht. DT 100 approved 11/15/77	[Signature]	10-18-83

APPROVAL RECOMMENDED:  
*Eiichi Tanaka* 10/14/83  
 TRAFFIC ENGINEER DATE

APPROVED:  
*S. Fujiyama* 10-18-83  
 ASSISTANT CHIEF, ENGINEERING DATE

STATE OF HAWAII  
 DEPARTMENT OF TRANSPORTATION  
 HIGHWAYS DIVISION

**STANDARD DETAILS**

**MISCELLANEOUS SIGN DETAILS**

Not to Scale: Oct. 1983  
 SHEET NO. OF SHEETS DT 100

DATE	
SURVEY PLOTTED BY	
DRAWN BY	
DESIGNED BY	
QUANTITIES BY	
CHECKED BY	
ORIGINAL PLAN	
NOTE BOOK	
No.	

**HEIGHT AND LATERAL LOCATION OF SIGNS TYPICAL INSTALLATION**

FED. ROAD DIST. NO.	STATE	FED. AID PROJ. NO.	FISCAL YEAR	SHEET NO.	TOTAL SHEETS
HAWAII	HAW.	IR-HI-1(100)	1986	86	99

A or A <sub>1</sub>	C	C <sub>1</sub>
36"	6"	-
48"	9"	19"
60"	12"	24"

NOTE: Frame stiffeners are required when D is greater than 24". See Gen. Note 4.

### GENERAL NOTES

- Sign posts and base posts shall be flanged channel type structural steel conforming to ASTM A 499 and galvanized in accordance with ASTM A 123.  
NOMINAL DIMENSIONS:  
2.50 lbs./ft. - 3.125" x 1.562"  
4.00 lbs./ft. - 3.500" x 1.750"
- Retainer - Spacer Strap shall be AISI 1020 steel and galvanized in accordance with ASTM A 123.
- Retainer and Connector Bolts shall be 5/16 - 18 UNC x 1.75" long hex. head, integral flange conforming to ASTM A 354 Grade BC. Nuts shall be 5/16 - 18 UNC hex. head, integral flange conforming to ASTM A 563 Grade D. All bolts and nuts shall be cadmium plated per Federal spec. QQP 416 B, Class 2, Type 2.
- All accessories, fittings and stiffener details (as required) shall be submitted to Engineer for approval 20 days prior to installation.
- For additional details see sht. DT 100.
- Basic formulas for use with the windload charts:  
Factor = A x B x H  
Therefore, if sign area (A x B) is known,  
Maximum H =  $\frac{\text{Factor}}{\text{sign area (A x B)}}$   
and if H is known,  
Maximum sign area (A x B) =  $\frac{\text{Factor}}{H}$

APPROVAL RECOMMENDED:

*Eichi Tanaka* 9/21/82  
TRAFFIC ENGINEER DATE


APPROVED:

ASSISTANT CHIEF, ENGINEERING DATE

STATE OF HAWAII  
DEPARTMENT OF TRANSPORTATION  
HIGHWAYS DIVISION

STANDARD DETAILS  
GALVANIZED FLANGED CHANNEL  
SIGN POST MOUNTING

Scale: As Shown Date: Sept. 1982  
SHEET No. OF SHEETS DT 100A

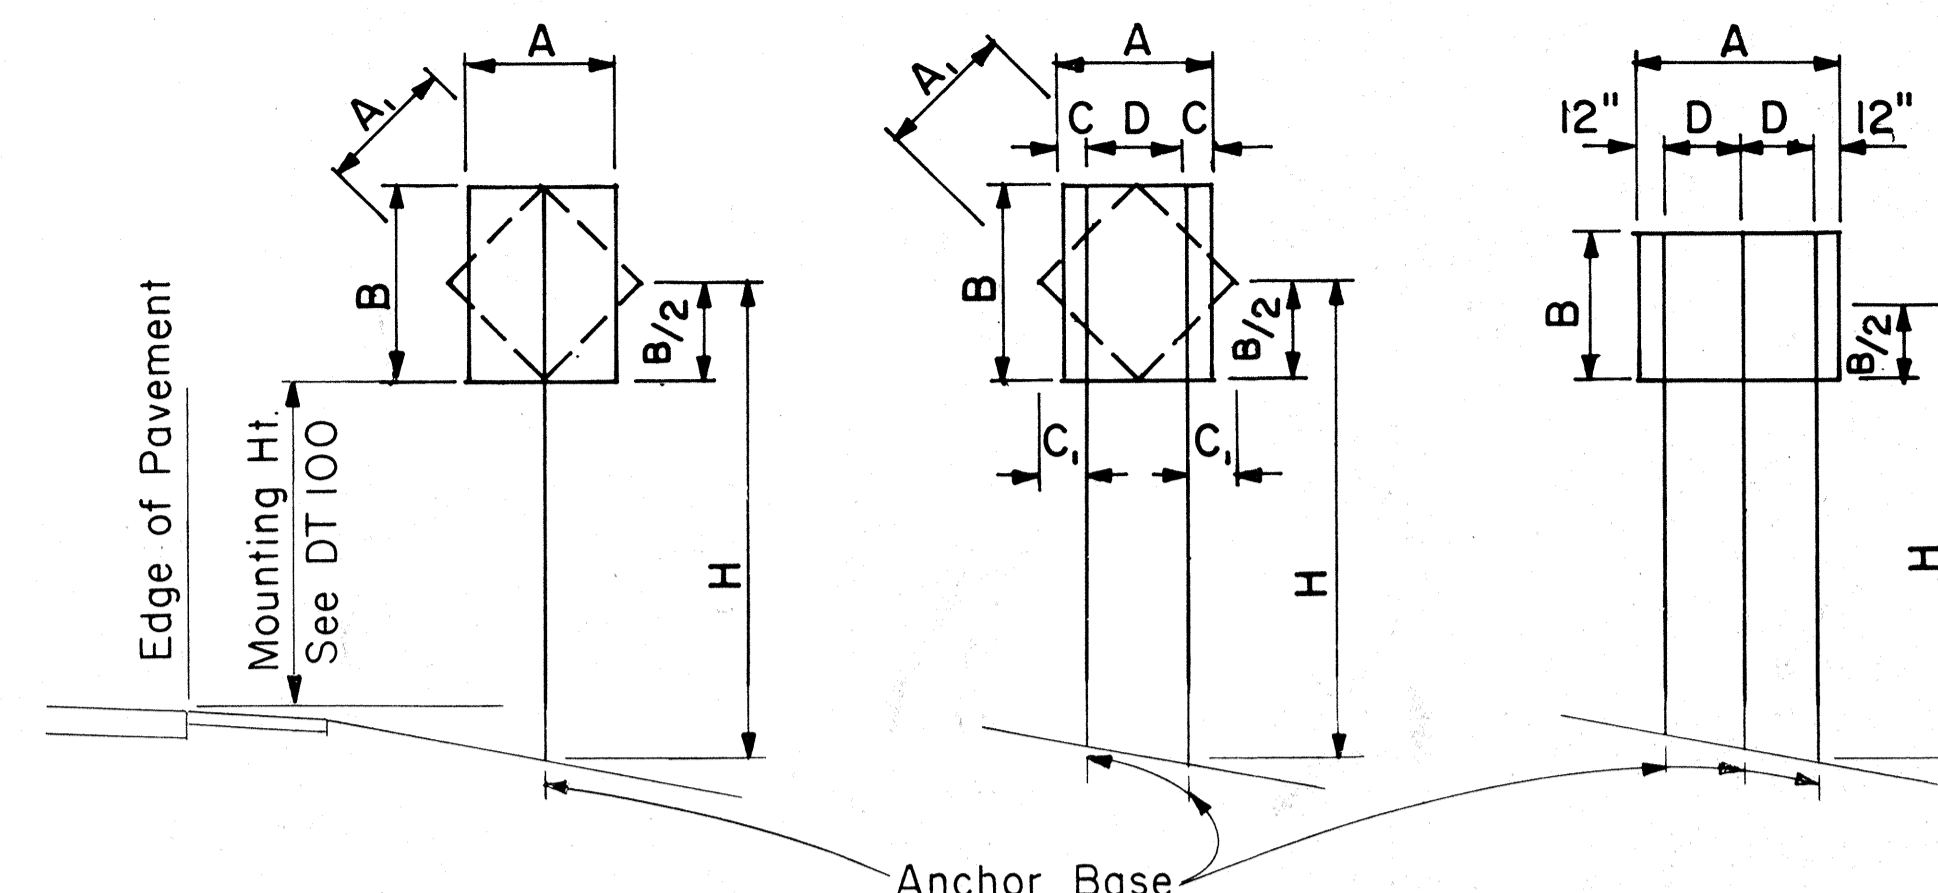

**1-POST** Sign area 10 sq. ft. and less  
**2-POST** Sign area greater than 10 sq. ft. or A=48"-60"  
**3-POST** A= greater than 60"

### TYPICAL INSTALLATION

Not to Scale

#### FLANGED CHANNEL: 1-POST INSTALLATION

Post Size	A x B x H (Factor)	H = Ground Level to Midpoint (ft.)						A x B (Area, sq. ft.)
		7	8	9	10	11	12	
2.50 lbs./ft.	57	8.14	7.13	6.33	5.70	5.18	4.75	A x B (Area, sq. ft.)
4.00 lbs./ft.	112	-	-	-	-	-	9.33	

#### FLANGED CHANNEL: 2-POST INSTALLATION


Post Size	A x B x H (Factor)	H = Ground Level to Midpoint (ft.)						A x B (Area, sq. ft.)
		7	8	9	10	11	12	
2.50 lbs./ft.	124	17.71	15.50	13.77	12.40	11.27	10.33	A x B (Area, sq. ft.)
4.00 lbs./ft.	241	34.43	30.13	26.78	24.10	21.91	20.08	

#### FLANGED CHANNEL: 3-POST INSTALLATION

Post Size	A x B x H (Factor)	H = Ground Level to Midpoint (ft.)						A x B (Area, sq. ft.)
		7	8	9	10	11	12	
2.50 lbs./ft.	187	26.71	23.38	20.78	18.70	17.00	15.58	A x B (Area, sq. ft.)
4.00 lbs./ft.	362	51.71	45.25	40.22	36.20	32.91	30.17	


### WINDLOAD CHARTS

NO.	REVISION	APPROVED BY	DATE

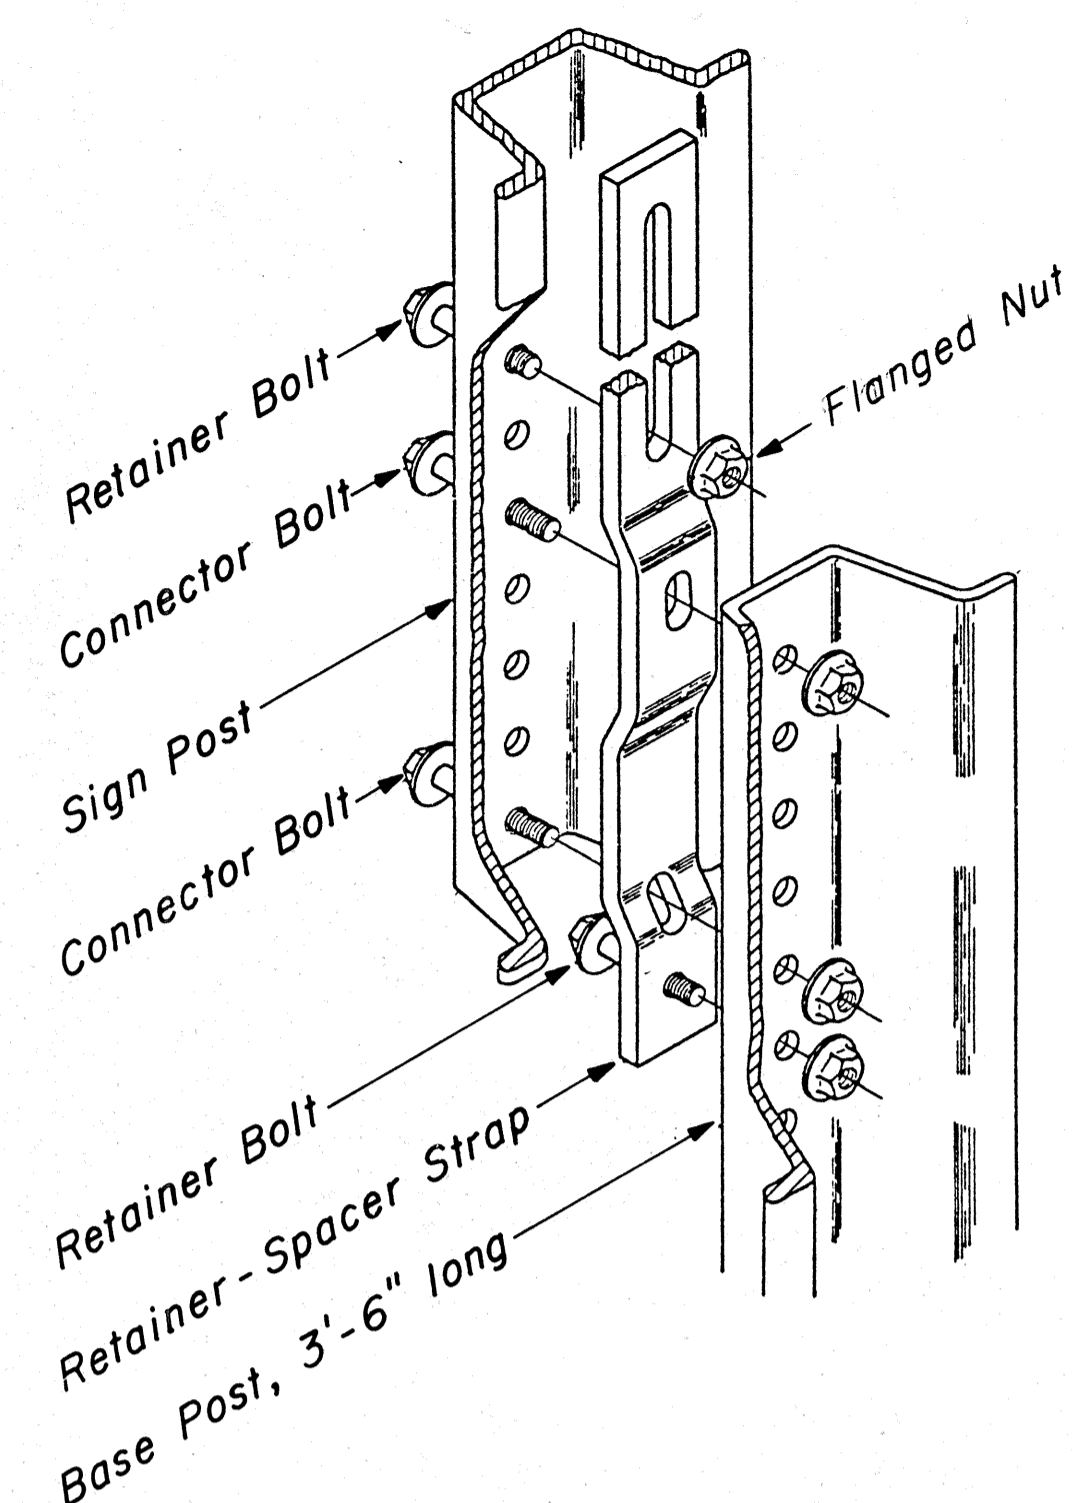

### CONNECTION DETAIL

Not to Scale

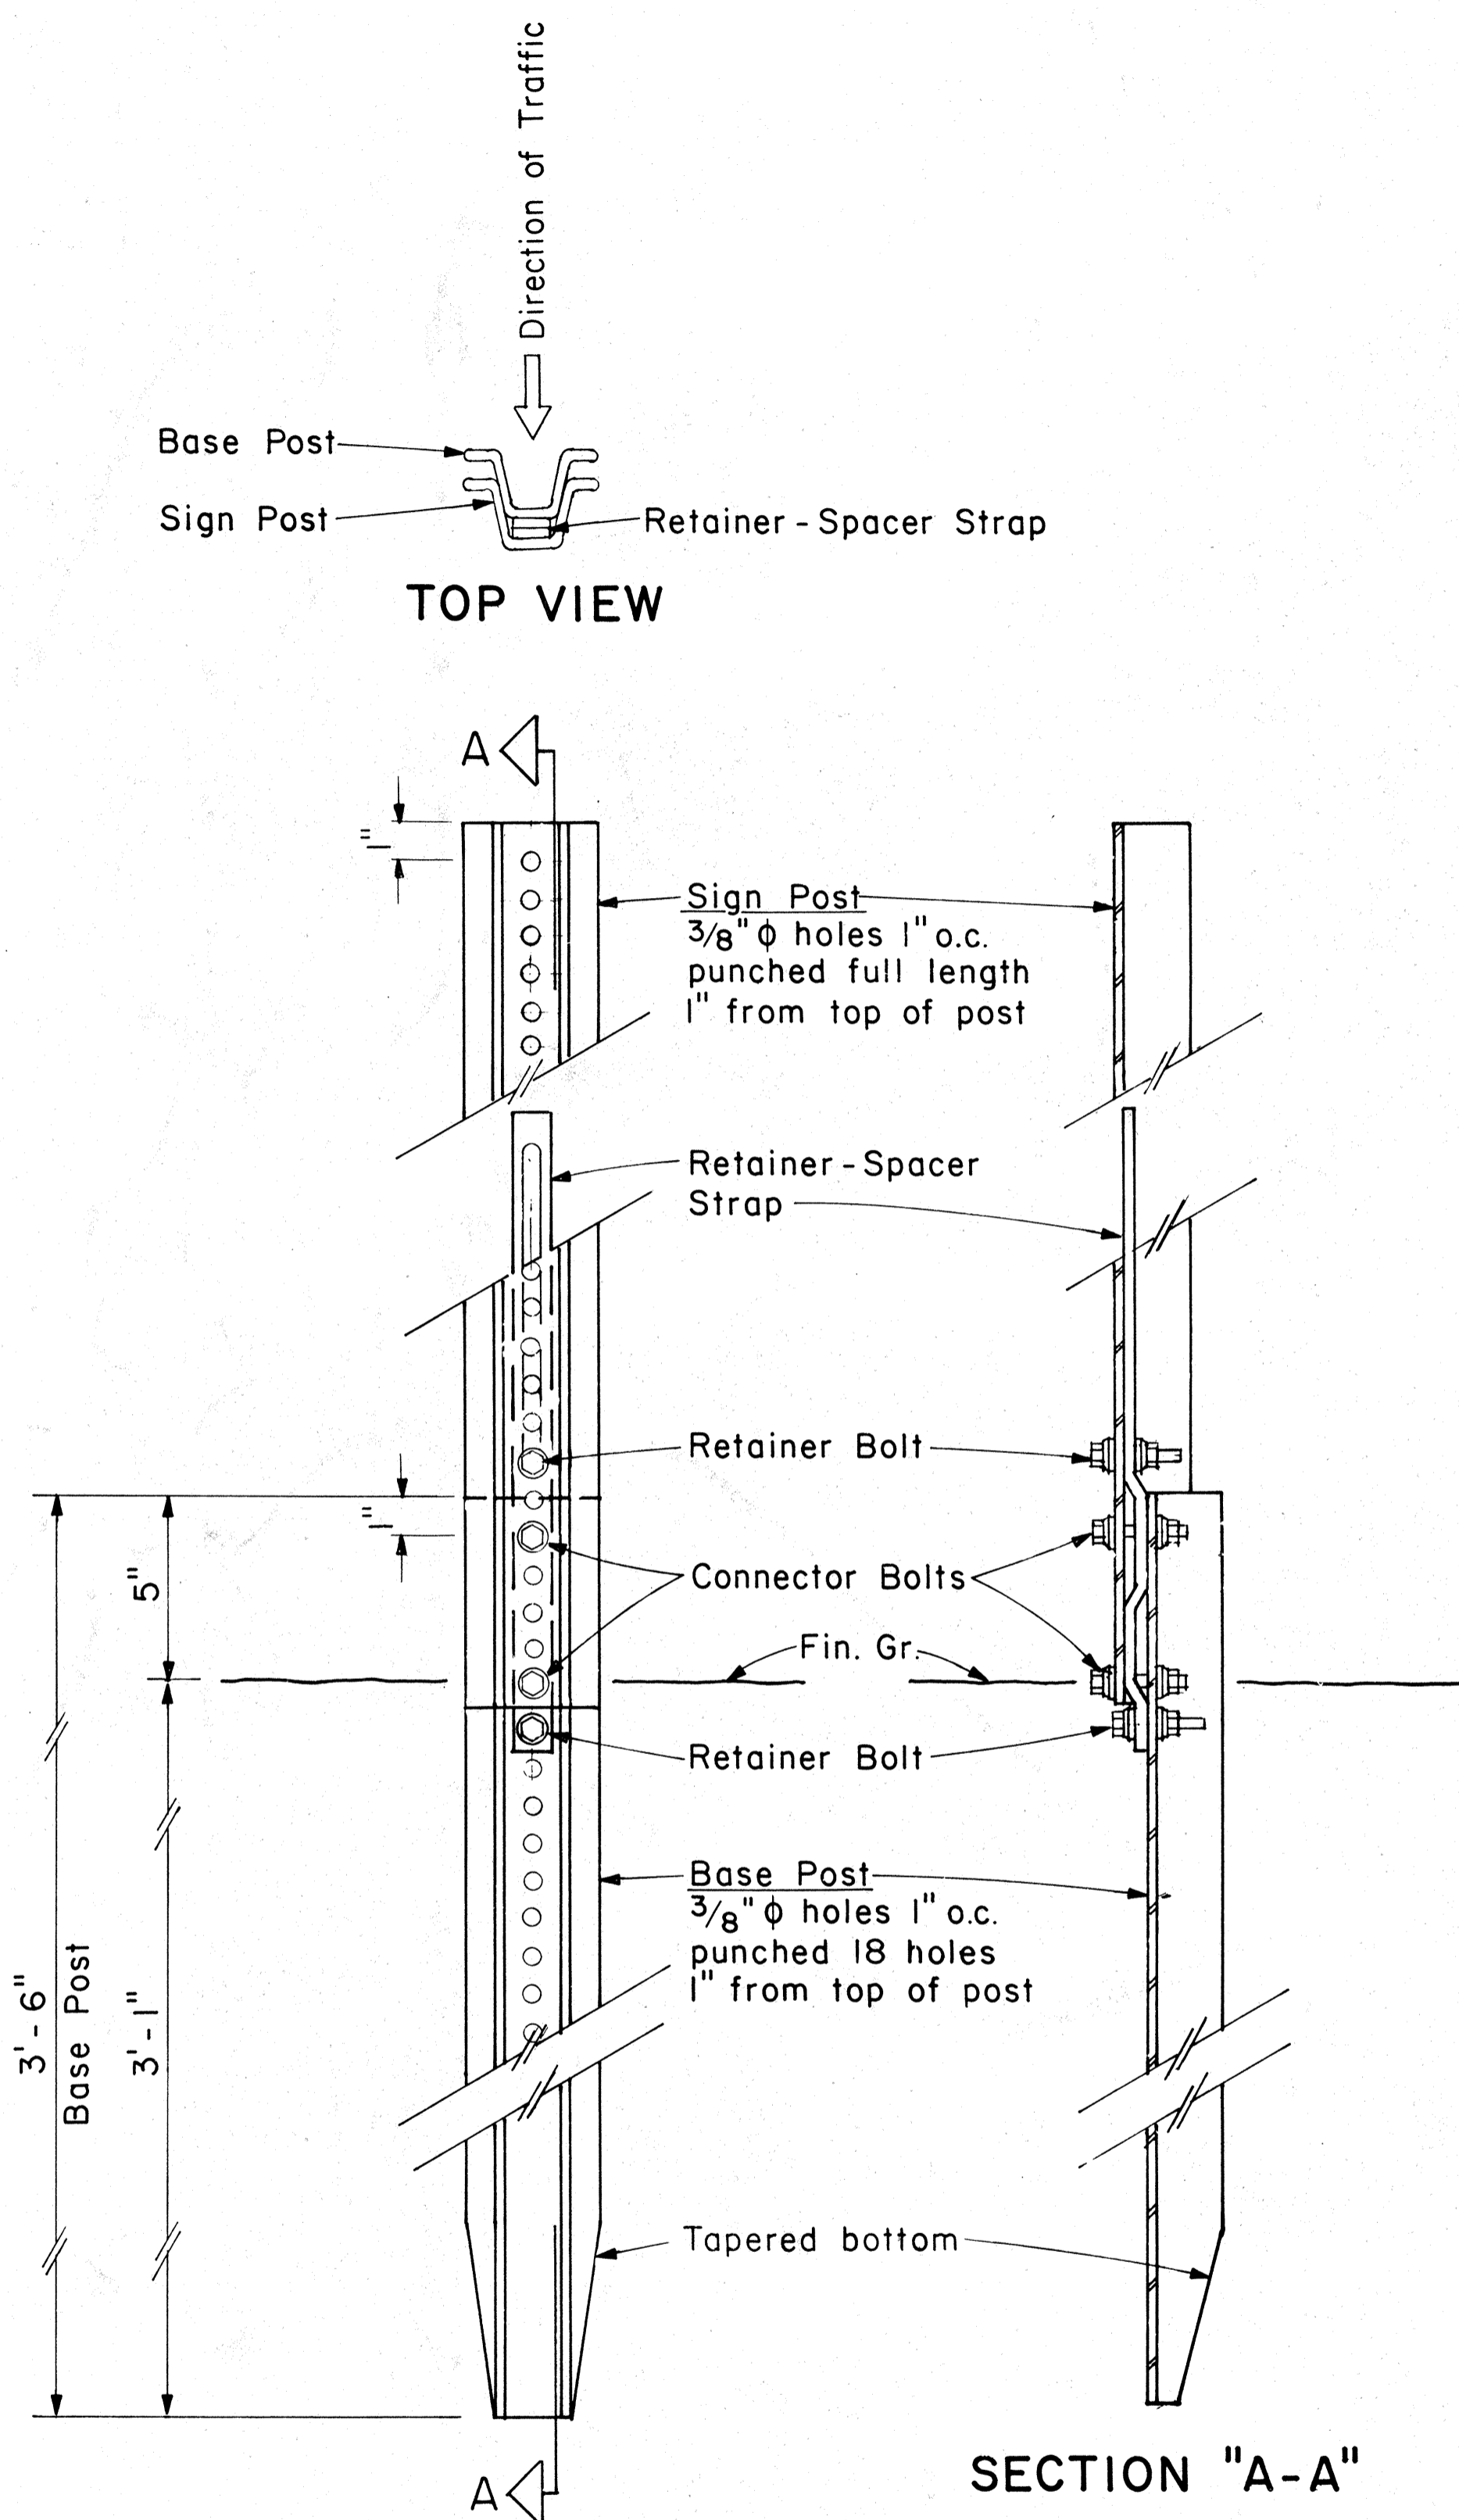


BACK VIEW

SECTION "A-A"

### ANCHOR BASE DETAIL

Scale: 3" = 1'-0"

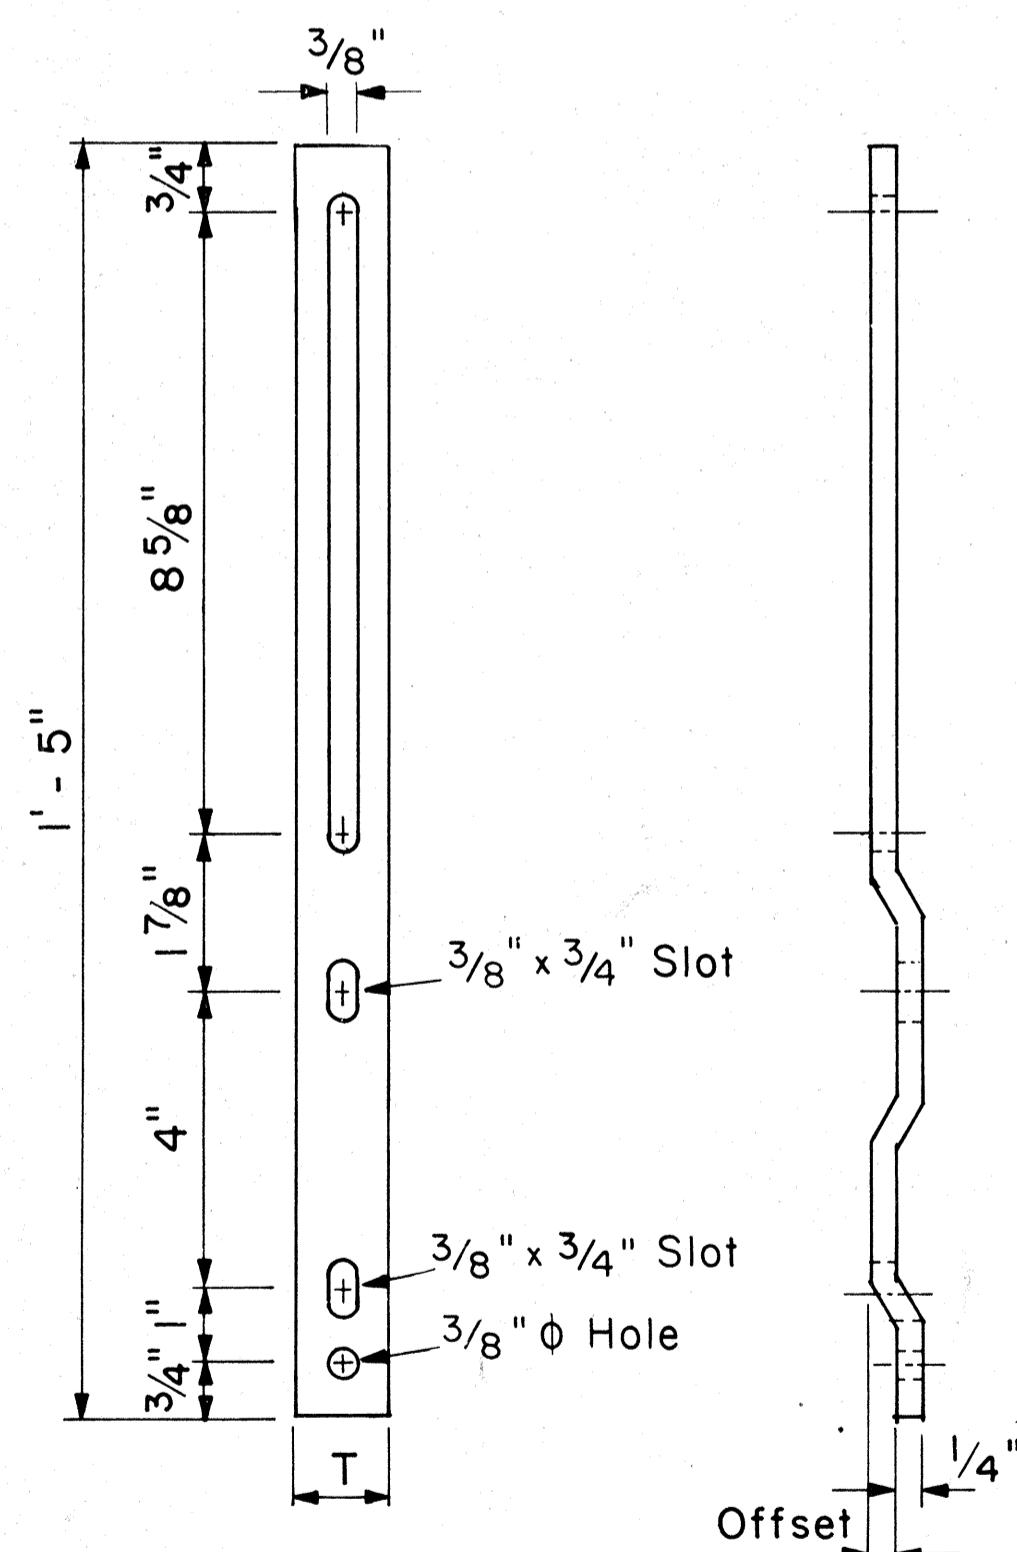

### RETAINER-SPACER STRAP

Not to Scale

#### RETAINER-SPACER STRAP


Post Size	T	Offset
2.50 lbs./ft.	1.00"	0.145"
4.00 lbs./ft.	1.12"	0.280"

ORIGINAL PLAN  
NO. 100  
DATE: 9/21/82  
DESIGNED BY: E. TANAKA  
CHECKED BY: J. HARRIS


FED. ROAD DIST. NO.	STATE	FED. AID PROJ. NO.	FISCAL YEAR	SHEET NO.	TOTAL SHEETS
HAWAII	HAW.	IR-HI-1(189)	1986	87	99

### GENERAL NOTES

- Square tube sign posts shall conform to Subsection 713.11(C) Square Tube Posts of the Specifications.
- All accessories, fittings and stiffener details (as required) shall be submitted to Engineer for approval 20 days prior to installation.
- Square tube posts shall be perforated with  $\frac{7}{16}$ "  $\phi$  holes, 1" o.c., 4 sides, along entire length of post.
- All posts shall be 12 gage unless otherwise specified or shown on the plans.
- For additional details see sht. DT 100.
- Basic formulas for use with the windload charts:  
 $Factor = A \times B \times H$   
Therefore, if sign area (A x B) is known,  
 $Maximum\ H = \frac{Factor}{sign\ area(A \times B)}$   
and if H is known,  
 $Maximum\ sign\ area(A \times B) = \frac{Factor}{H}$

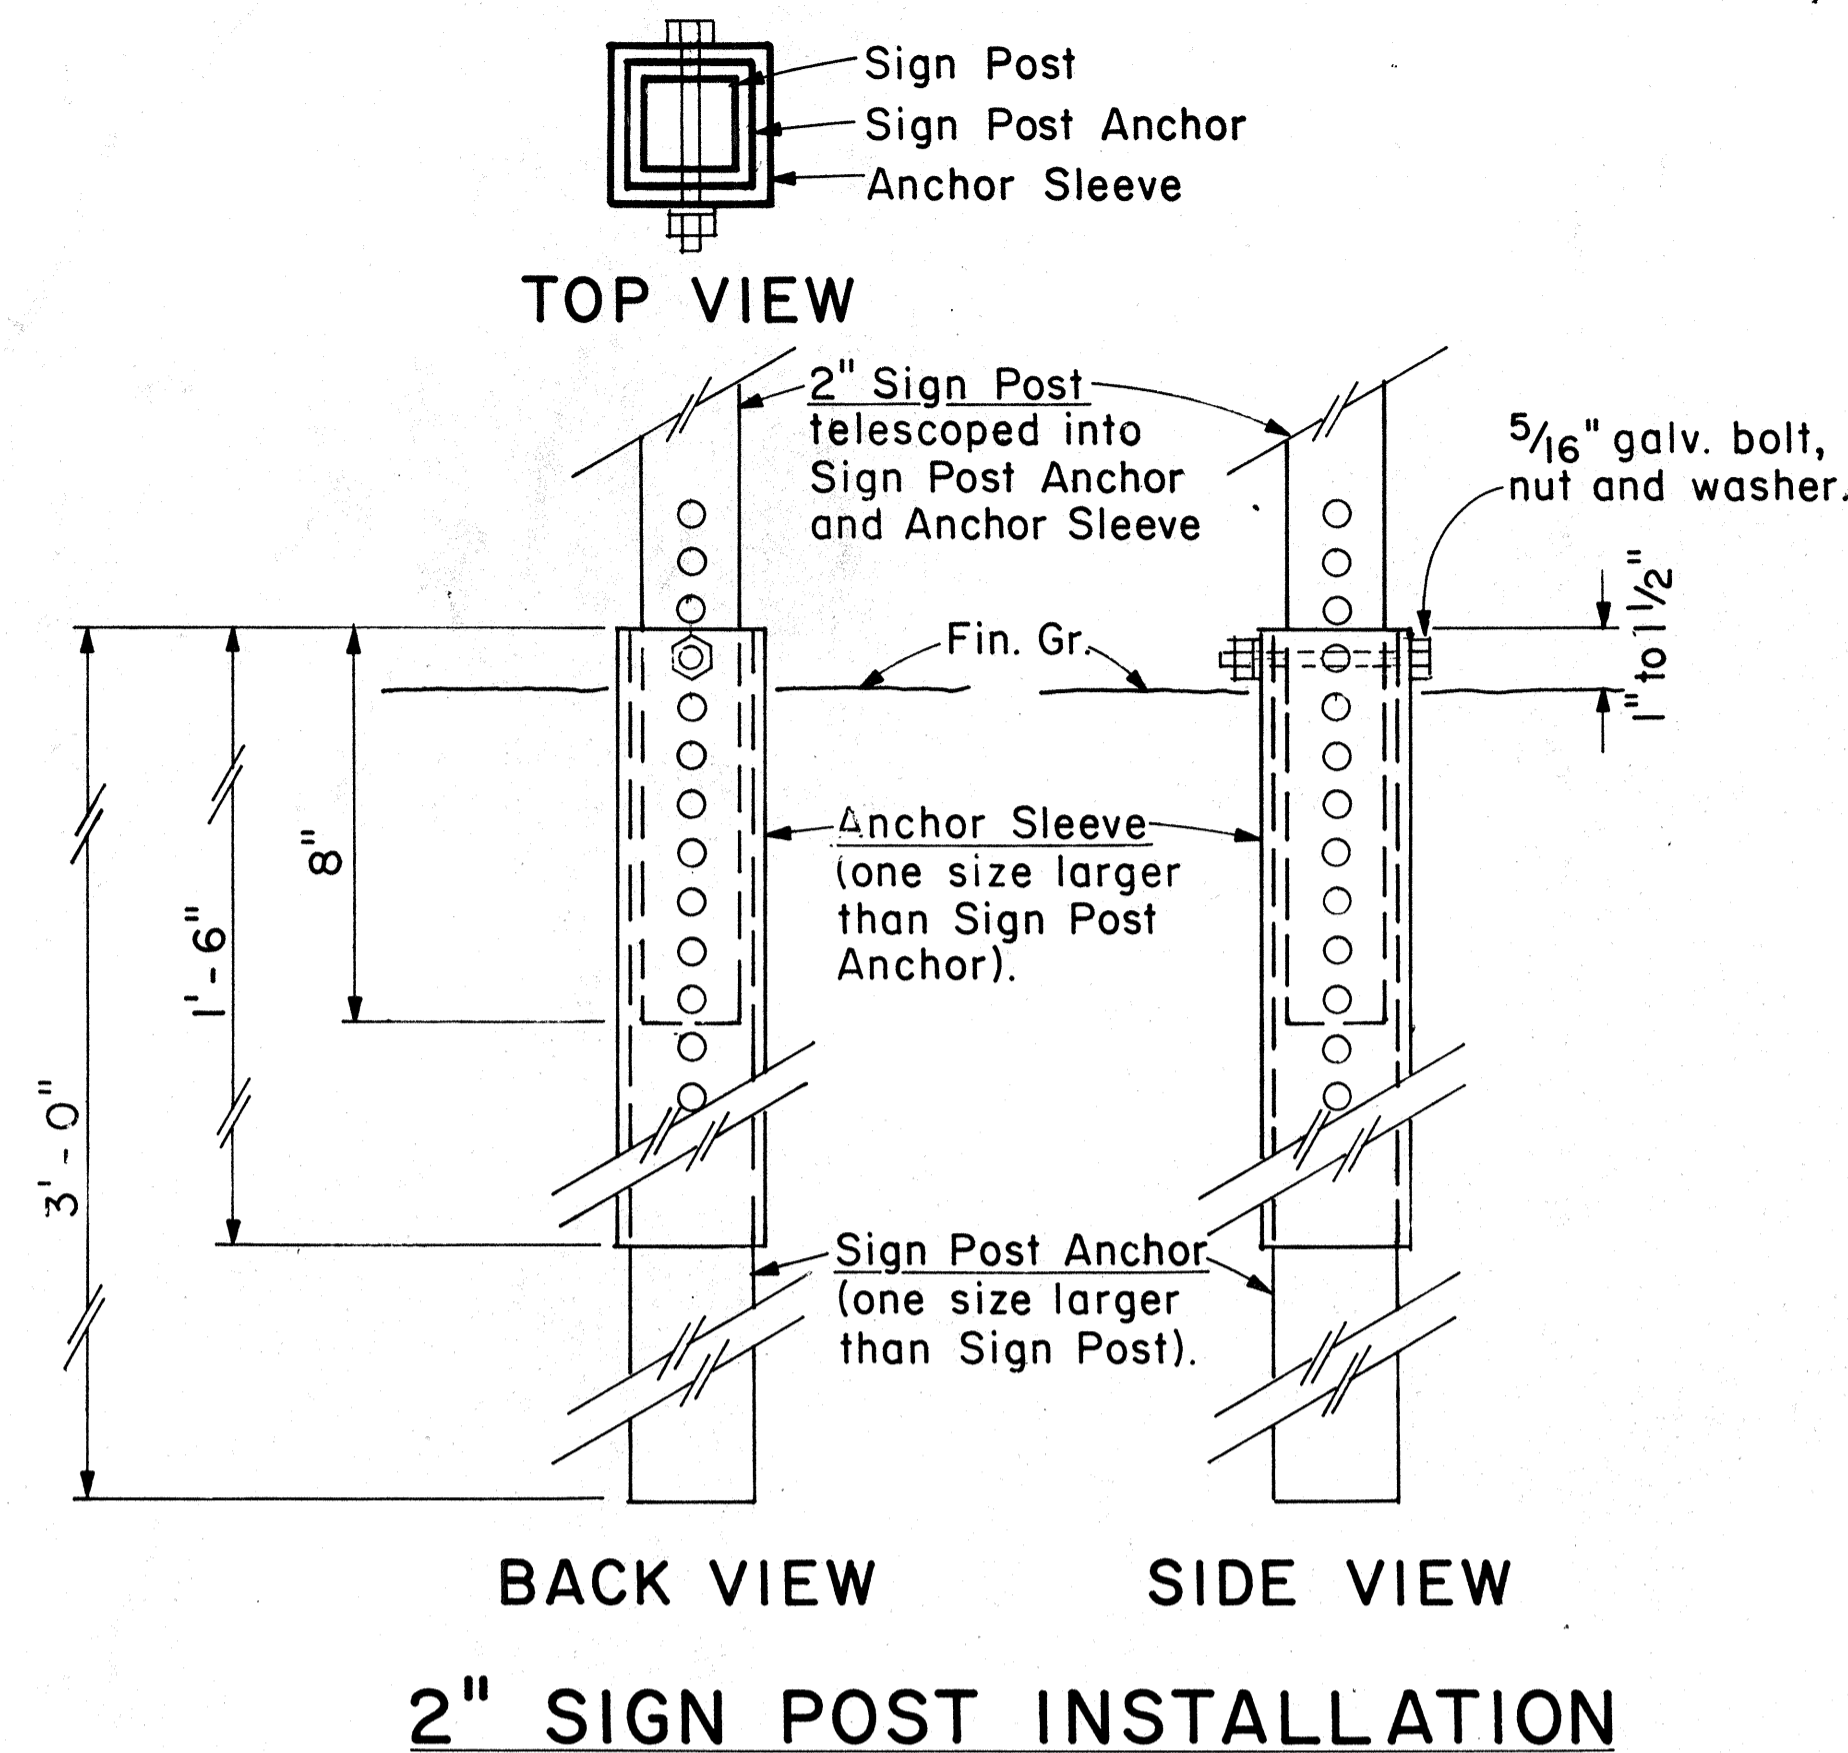

2" SIGN POST INSTALLATION

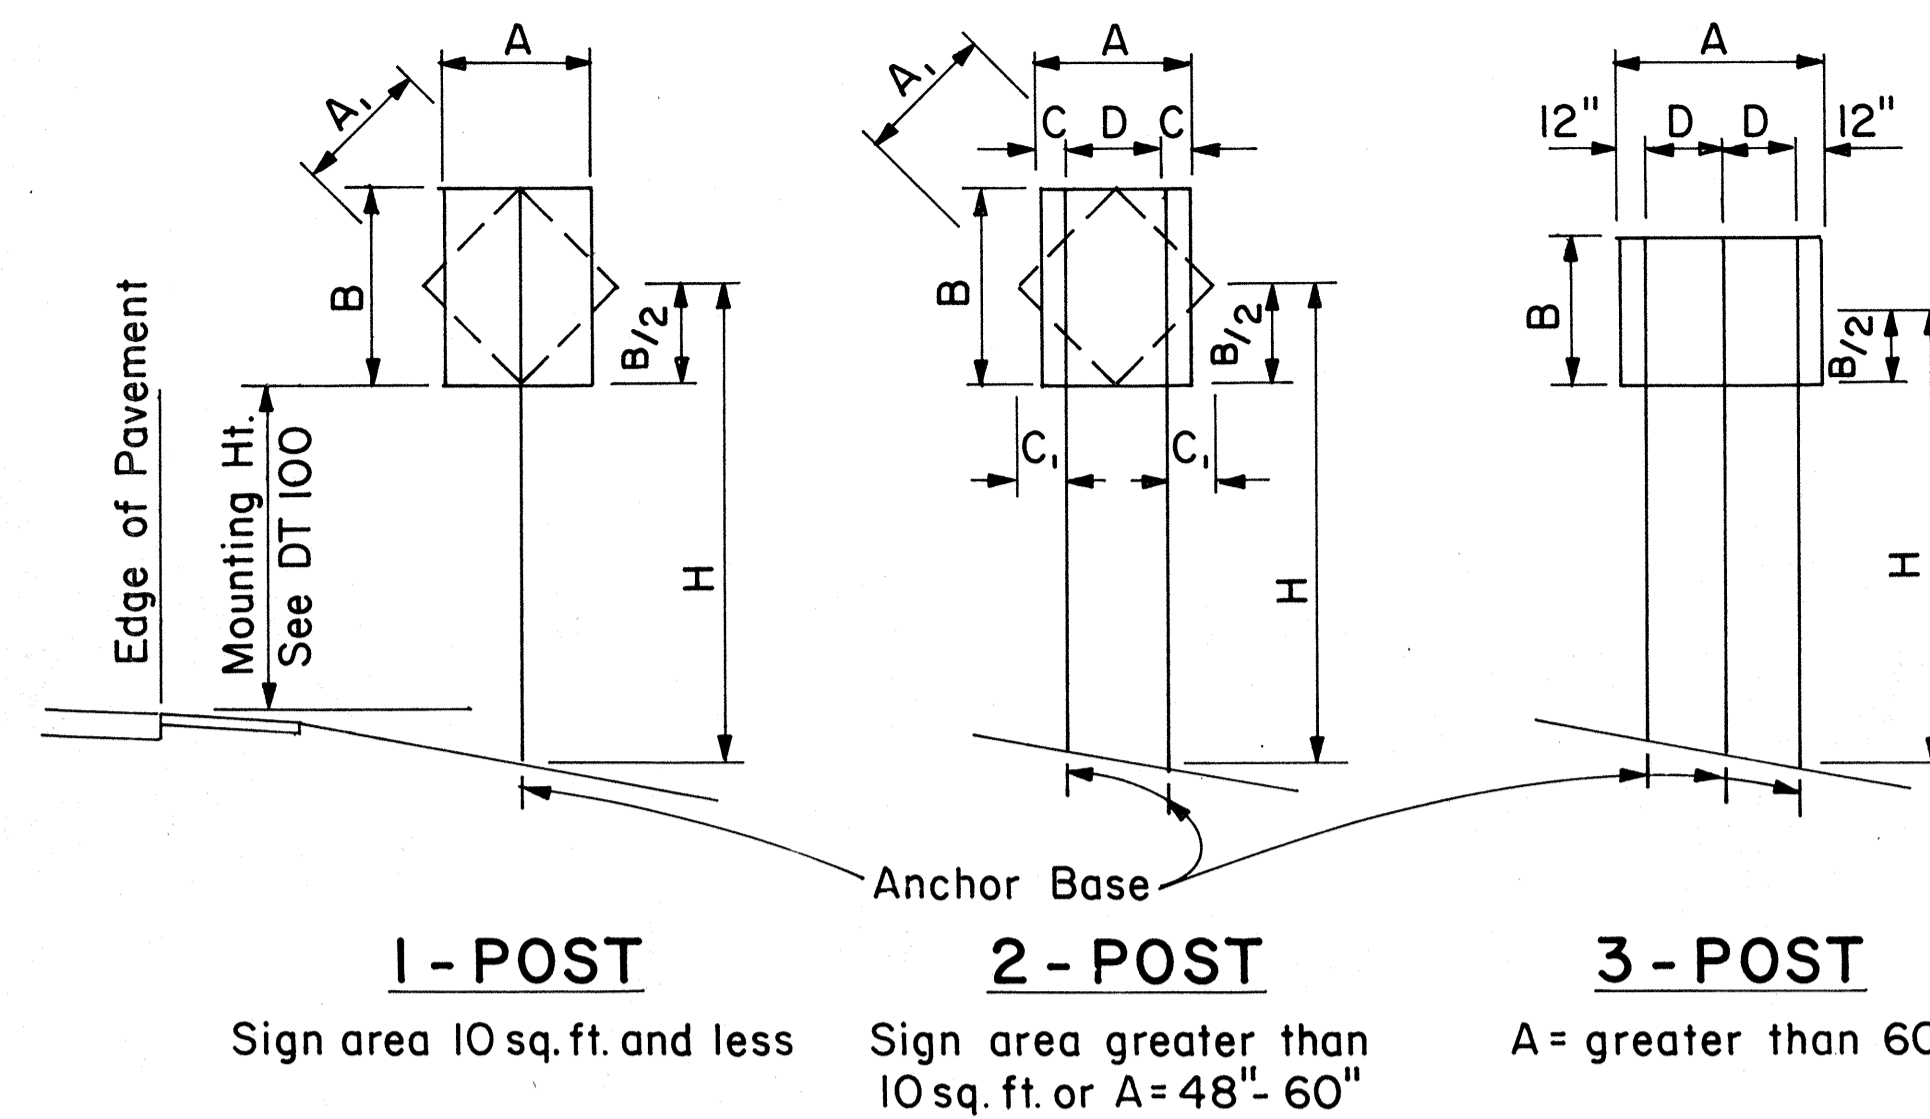

**1 - POST** Sign area 10 sq. ft. and less  
**2 - POST** Sign area greater than 10 sq. ft. or A = 48" - 60"  
**3 - POST** A = greater than 60"

### TYPICAL INSTALLATION

Not to Scale

SQUARE TUBE: 1- POST INSTALLATION							
Post Size	AxBxH (Factor)	H = Ground Level to Midpoint (ft.)					
		7	8	9	10	11	12
2"	62	8.8	7.7	6.8	6.1	5.6	4.8
2 1/2"	107	-	-	-	-	9.6	8.8

A x B (Area, sq. ft.)


SQUARE TUBE: 2- POST INSTALLATION							
Post Size	AxBxH (Factor)	H = Ground Level to Midpoint (ft.)					
		7	8	9	10	11	12
2"	122	17.4	15.2	13.5	12.2	11.0	10.1
2 1/2"	212	30.2	26.5	23.5	21.1	19.2	17.6
2 1/2", 10 ga.	260	37.0	32.0	28.6	26.0	23.5	21.5

A x B (Area, sq. ft.)

SQUARE TUBE: 3- POST INSTALLATION							
Post Size	AxBxH (Factor)	H = Ground Level to Midpoint (ft.)					
		7	8	9	10	11	12
2"	183	26.0	22.8	20.3	18.2	16.6	15.2
2 1/2"	318	45.4	39.5	35.2	31.5	28.8	26.5
2 1/2", 10 ga.	388	55.0	48.5	43.0	38.5	35.0	32.0

A x B (Area, sq. ft.)

### WINDLOAD CHARTS

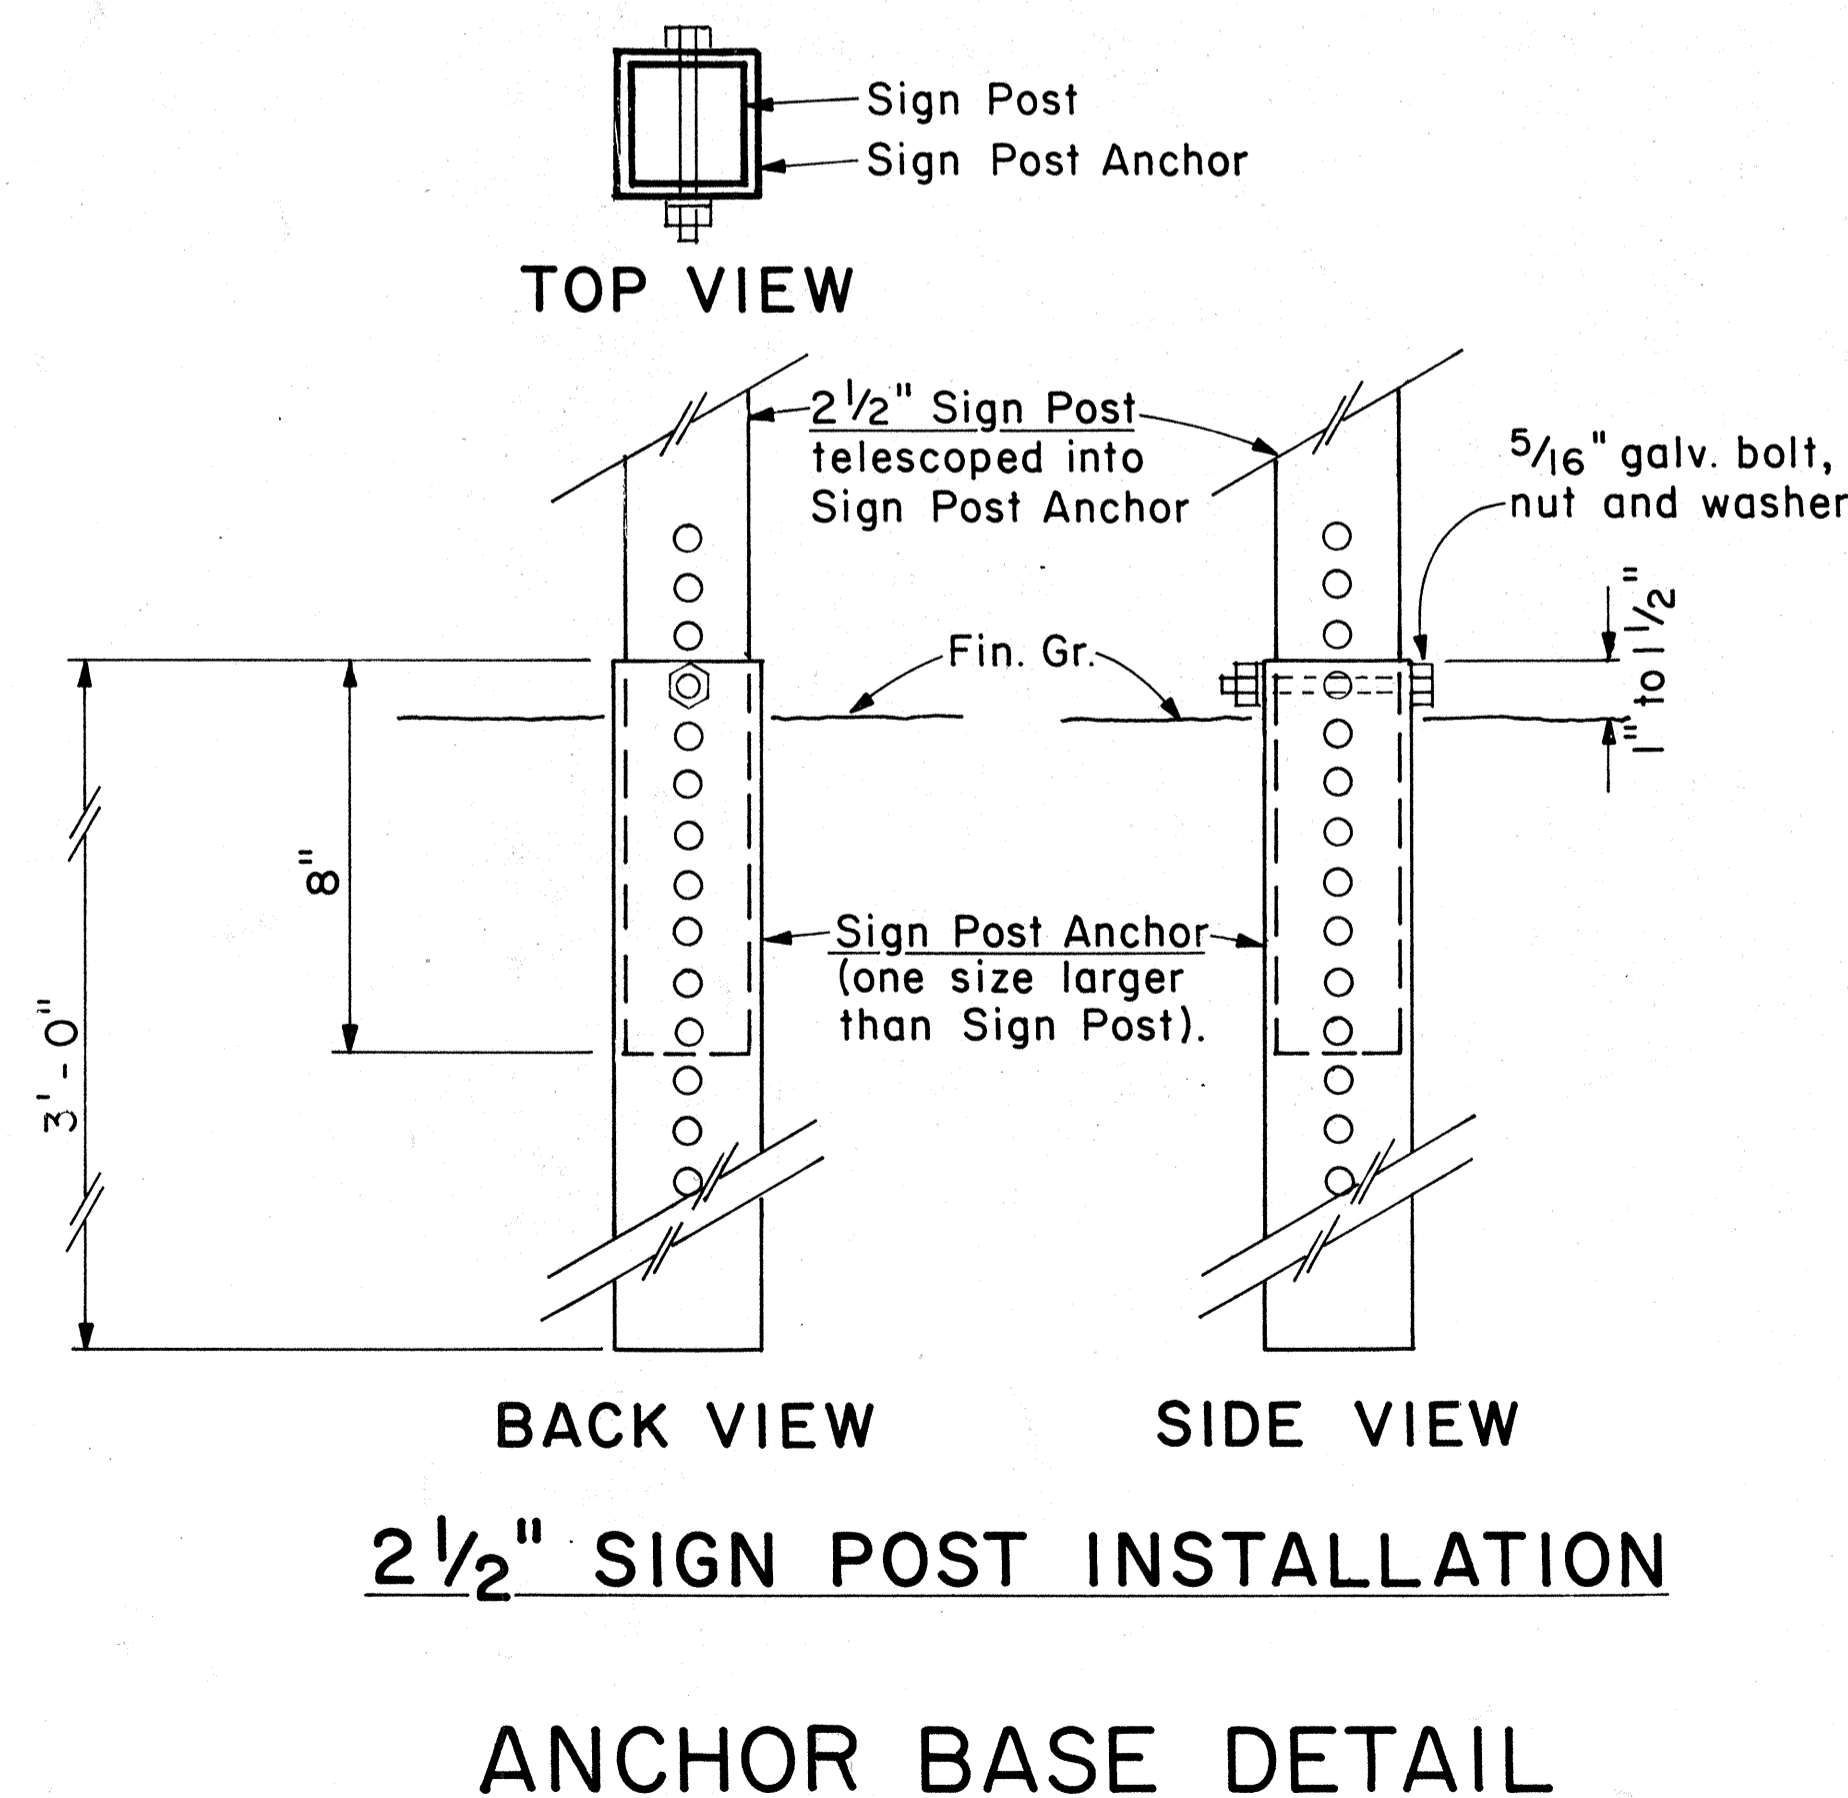

2 1/2" SIGN POST INSTALLATION

### ANCHOR BASE DETAIL

Scale: 3" = 1'-0"

A or A <sub>1</sub>	C	C <sub>1</sub>
36"	6"	-
48"	9"	19"
60"	12"	24"

NOTE: Frame stiffeners are required when D is greater than 24". See Gen. Note 2.

APPROVAL RECOMMENDED:

*Eishi Tanaka* 9/2/82  
TRAFFIC ENGINEER DATE

APPROVED:

*Robert Sakaiishi* 9/20/82  
ASSISTANT CHIEF, ENGINEERING DATE

NO.	REVISION	APPROVED BY	DATE


STATE OF HAWAII  
DEPARTMENT OF TRANSPORTATION  
HIGHWAYS DIVISION

STANDARD DETAILS  
GALVANIZED SQUARE TUBE  
SIGN POST MOUNTING


Scale: As Shown Date: Sep: 1982

DATE: \_\_\_\_\_  
SURVEY PLOTTED BY: \_\_\_\_\_  
DRAWN BY: \_\_\_\_\_  
TRACED BY: \_\_\_\_\_  
DESIGNED BY: \_\_\_\_\_  
CHECKED BY: \_\_\_\_\_  
ORIGINAL PLAN No. \_\_\_\_\_  
NOTE BOOK No. \_\_\_\_\_

FED. ROAD DIST. NO.	STATE	FED. AID PROJ. NO.	FISCAL YEAR	SHEET NO.	TOTAL SHEETS
HAWAII	HAW.	1R-HI-1 (189)	1986	88	99

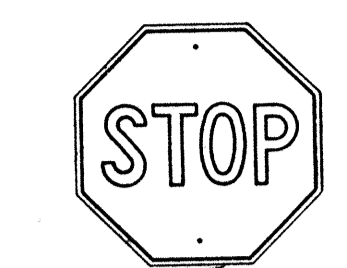


R1-1 30" x 30"  
R1-1-A 36" x 36"  
4-WAY  
R1-3 12" x 6"  
R1-3-A 18" x 9"

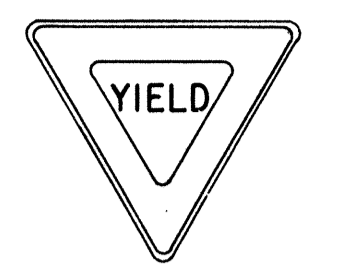


R1-2 36" x 36" x 36"  
R1-2-A 48" x 48" x 48"



R2-1(50) 24" x 30"  
R2-1(50)-A 48" x 60"

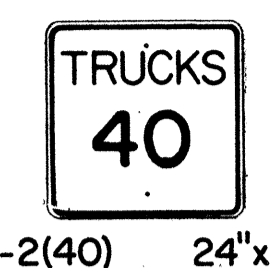

R2-2(40) 24" x 24"  
R2-2(40)-A 48" x 48"

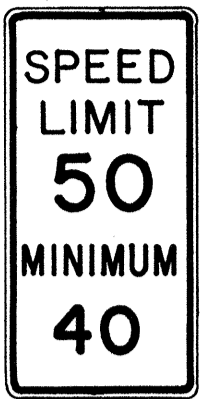

R2-4a(50/40) 24" x 48"  
R2-4a(50/40)-A 48" x 96"




R2-5b(30) 24" x 30"  
R2-5b(30)-A 48" x 60"



R3-1 24" x 24"  
24" x 18"  
R3-1-A 48" x 48"  
48" x 36"



R3-2 24" x 24"  
24" x 18"  
R3-2-A 48" x 48"  
48" x 36"

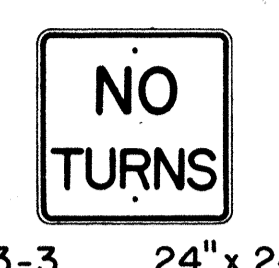


R3-3 24" x 24"  
R3-3-A 48" x 48"



R3-4 24" x 24"  
24" x 18"  
R3-4-A 48" x 48"  
48" x 36"



R3-5(L) 30" x 36"  
R3-5(L)-A 48" x 60"

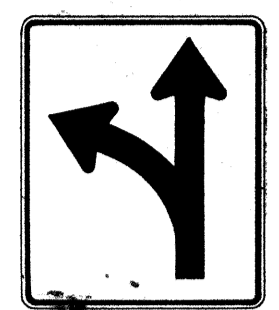


R3-6(L) 30" x 36"  
R3-6(L)-A 48" x 60"



R3-7(R) 30" x 30"  
R3-7(R)-A 48" x 48"



R3-8(L) 30" x 30"  
R3-8(L)-A 36" x 36"  
R3-8(L)-B 48" x 48"

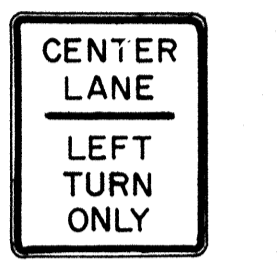

R3-9 24" x 30"




R4-1 24" x 30"  
R4-1-A 48" x 60"



R4-2 24" x 30"  
R4-2-A 48" x 60"




R4-3 24" x 30"  
R4-3-A 48" x 60"

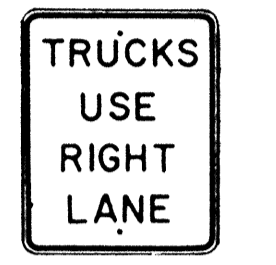


R4-5 24" x 30"  
R4-5-A 48" x 60"




R4-6(500) 24" x 30"  
R4-6(500)-A 48" x 60"

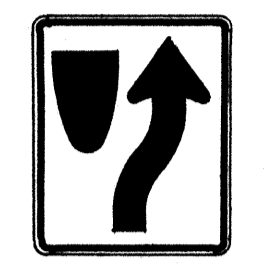

R4-7 24" x 30"  
24" x 18"  
R4-7-A 48" x 60"

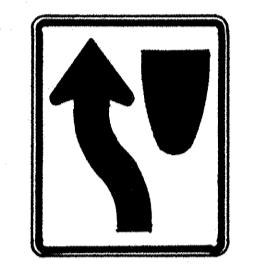


R4-8 24" x 30"  
24" x 18"  
R4-8-A 48" x 60"

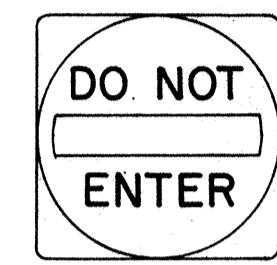

R5-1 30" x 30"  
R5-1-A 48" x 48"



R5-2 24" x 24"  
24" x 18"

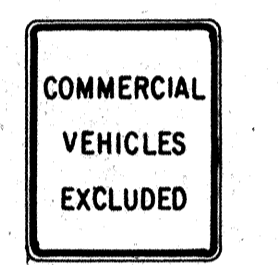


R5-4 24" x 30"  
R5-4-A 48" x 60"



R5-6 24" x 24"  
24" x 18"



R5-9 36" x 24"

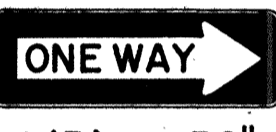


R6-1(R) 36" x 12"



R6-2(R) 18" x 24"




R7-1 12" x 18"  
R7-1-A 24" x 30"

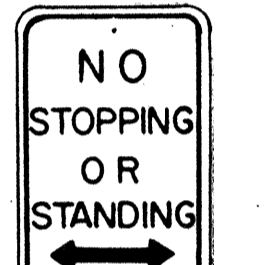

R7-4 12" x 18"  
R7-4-A 24" x 30"



R7-107(R) 12" x 18"

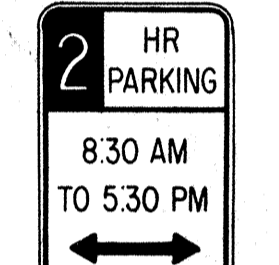

R7-108 12" x 18"



R7-201 12" x 6"  
R7-201-A 24" x 12"



R8-1 24" x 30"  
R8-1-A 48" x 60"



R8-2 24" x 30"  
R8-2-A 48" x 60"



R8-3 24" x 30"  
R8-3-A 48" x 48"




R8-4 30" x 24"  
R8-4-A 48" x 36"



R8-5 24" x 30"  
R8-5-A 48" x 60"



R8-6 24" x 30"  
R8-6-A 48" x 60"

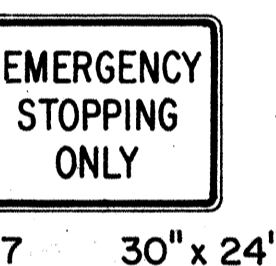

R8-7 30" x 24"  
R8-7-A 48" x 36"



R9-1 18" x 24"



R9-2 12" x 18"



R9-3 12" x 18"




R9-4 18" x 24"




R10-1 12" x 18"




R10-2 12" x 18"

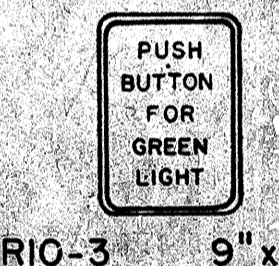

R10-3 9" x 12"

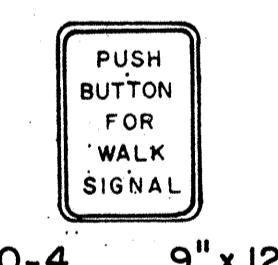


R10-4 9" x 12"

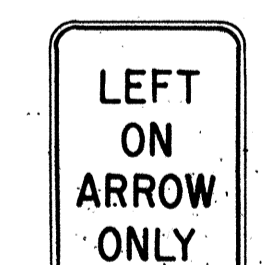

R10-5 24" x 30"




R10-6 24" x 36"

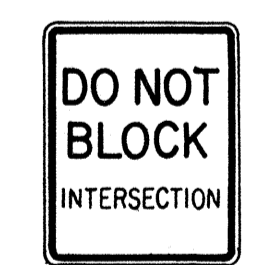


R10-7 24" x 30"



R10-8 24" x 30"

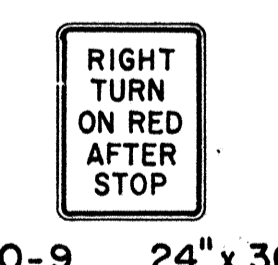

R10-9 24" x 30"

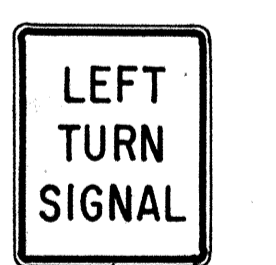


R10-10 24" x 30"




R11-1 24" x 30"



R11-2 48" x 30"

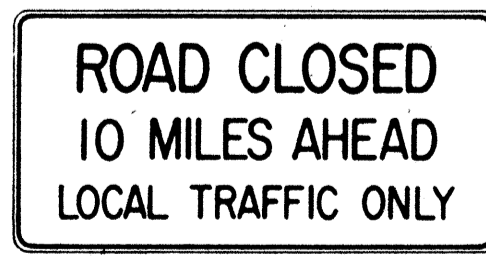

R11-3(10) 60" x 30"

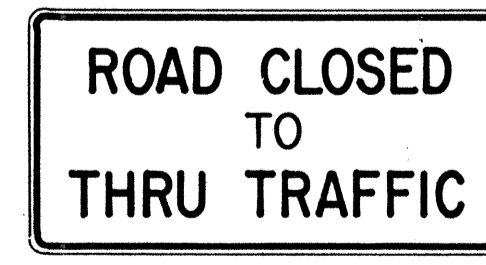

R11-4 60" x 30"



R12-1(10) 24" x 30"

**GENERAL NOTES**

1. Sign details shall conform to the latest editions of FHWA publications "Manual on Uniform Traffic Control Devices for Streets and Highways," "Standard Alphabets for Highway Signs," and "Standard Highway Signs," and as amended.
2. All regulatory signs shall be reflectorized unless otherwise specified.
3. All regulatory signs shall have 3/8" bolt holes drilled at appropriate locations.
4. Numerals in ( ) indicates numerals to be inserted for sign message. (R) or (L) indicates right or left.
5. All signs shall be erected without educational plaques unless called for in the plans.

APPROVAL RECOMMENDED:  
*Eusiki Tanaka* 3/17/72  
TRAFFIC ENGINEER DATE

APPROVED:  
*Robert DeSoto* 3-20-72  
ASSISTANT CHIEF, ENGINEERING DATE


NO.	REVISION	APPROVED BY	DATE
1	Supersedes Sht. DT 101 Approved 12-30-69	H.T.	2/20/72
2	Revised General Note 1	H.T.	10/14/74
3	Added General Note 5	H.T.	4/9/75
4	Revised Signs and General Note 1	E.T.	9/18/85

STATE OF HAWAII  
DEPARTMENT OF TRANSPORTATION  
HIGHWAYS DIVISION


**STANDARD DETAILS**  
**REGULATORY SIGNS**

NOT TO SCALE  
SHEET No. OF SHEETS DT 101


DATE: \_\_\_\_\_  
DESIGNED BY: \_\_\_\_\_  
CHECKED BY: \_\_\_\_\_  
QUANTITIES BY: \_\_\_\_\_  
NOTE BOOK: \_\_\_\_\_  
ORIGINAL PLAN: \_\_\_\_\_

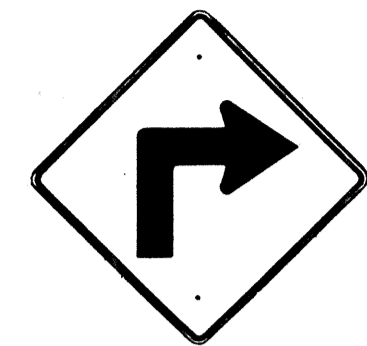


W1-1(R) 30"x30"  
W1-1(R)-A 48"x48"

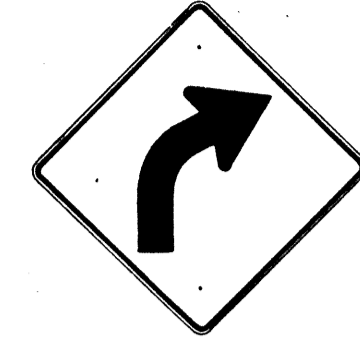


W1-2(R) 30"x30"  
W1-2(R)-A 48"x48"

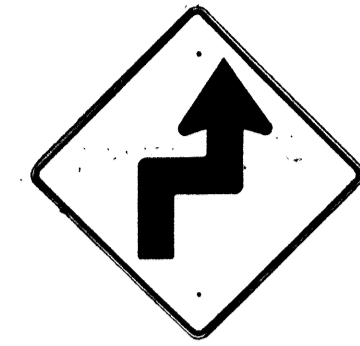


W1-3(R) 30"x30"  
W1-3(R)-A 48"x48"

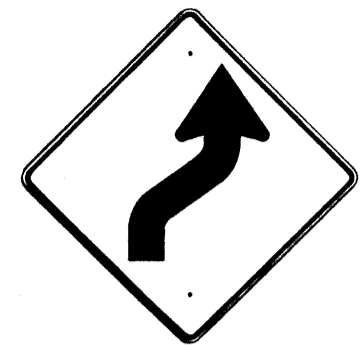


W1-4(R) 30"x30"  
W1-4(R)-A 48"x48"

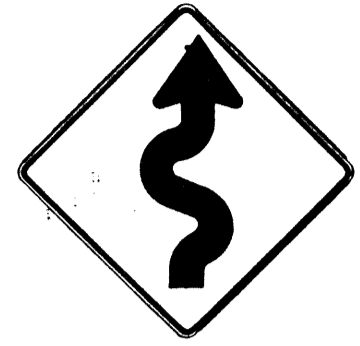


W1-5(R) 30"x30"  
W1-5(R)-A 48"x48"

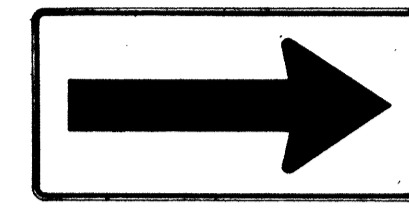


W1-6 48"x24"

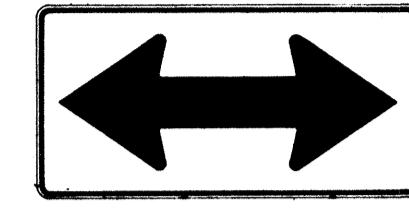


W1-7 48"x24"

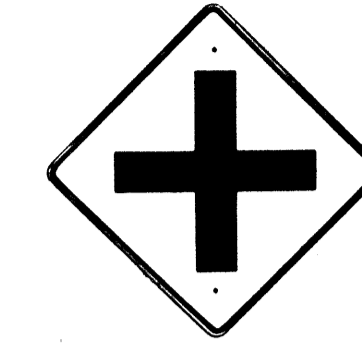


W2-1 30"x30"  
W2-1-A 48"x48"

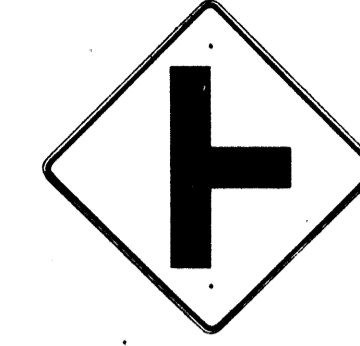


W2-2 30"x30"  
W2-2-A 48"x48"

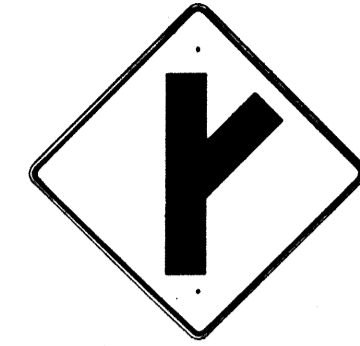

W2-3(R) 30"x30"  
W2-3(R)-A 48"x48"

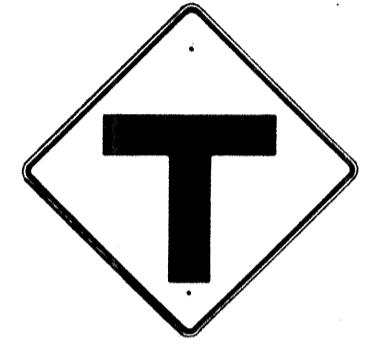

W2-4 30"x30"  
W2-4-A 48"x48"

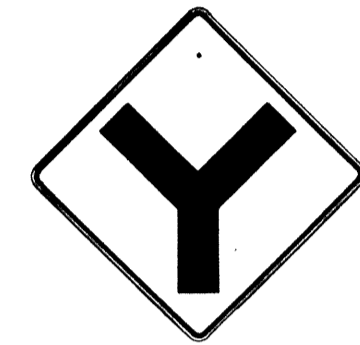


W2-5 30"x30"  
W2-5-A 48"x48"



W3-1 30"x30"  
W3-1-A 36"x36"




W3-2 30"x30"  
W3-2-A 36"x36"

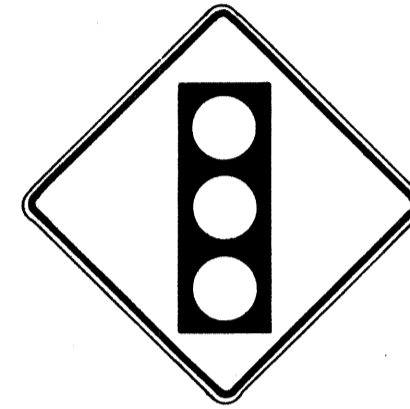

W3-3 36"x36"  
24"x18"



W4-1(R) 30"x30"  
24"x18"  
W4-1(R)-A 48"x48"  
24"x18"

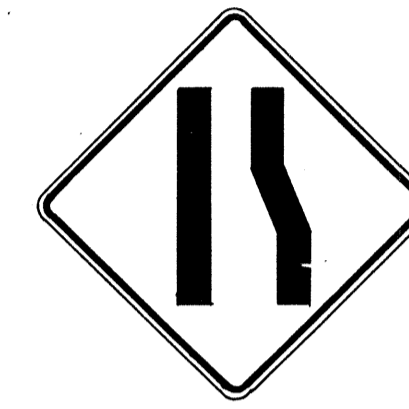

W4-2(R) 36"x36"  
W4-2(R)-A 48"x48"



W5-1 36"x36"  
W5-1-A 48"x48"



W5-2 30"x30"  
W5-2-A 36"x36"



W5-3 36"x36"  
W5-3-A 48"x48"



W6-1 36"x36"  
24"x18"  
W6-1-A 48"x48"  
24"x18"



W6-2 36"x36"  
24"x18"  
W6-2-A 48"x48"  
24"x18"



W6-3 30"x30"  
24"x18"  
W6-3-A 36"x36"  
24"x18"  
W6-3-B 48"x48"  
24"x18"



W7-1 30"x30"  
24"x18"  
W7-1-A 48"x48"  
24"x18"



W7-2 24"x18"



W8-1 30"x30"  
W8-1-A 36"x36"  
W8-1-B 48"x48"



W8-2 30"x30"  
W8-2-A 36"x36"  
W8-2-B 48"x48"



W8-3 30"x30"  
W8-3-A 36"x36"



W8-4 30"x30"  
W8-4-A 36"x36"



W8-5 30"x30"  
24"x18"  
W8-5-A 36"x36"  
24"x18"



W9-1(R) 30"x30"  
W9-1(R)-A 36"x36"  
W9-1(R)-B 48"x48"



W9-2(L) 36"x36"  
W9-2(L)-A 48"x48"



W10-1 36" Diameter



W11-1 30"x30"  
24"x18"  
W11-1-A 36"x36"  
24"x18"  
W11-1-B 48"x48"  
24"x18"




W11A-2 30"x30"  
24"x18"  
W11A-2-A 36"x36"  
24"x18"  
W11A-2-B 48"x48"  
24"x18"



W11-4 30"x30"  
24"x18"  
W11-4-A 36"x36"  
24"x18"  
W11-4-B 48"x48"  
24"x18"




W11-5 30"x30"  
24"x18"  
W11-5-A 36"x36"  
24"x18"  
W11-5-B 48"x48"

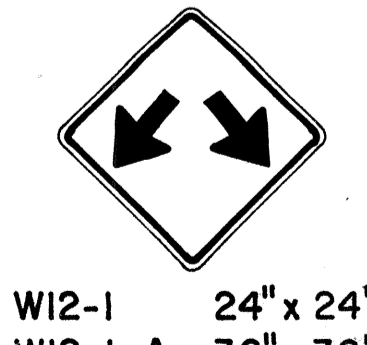


W12-1 24"x24"  
W12-1-A 36"x36"  
W12-1-B 48"x48"




W12-2(12'-6") 36"x36"  
24"x18"  
W12-2(12'-6") 48"x48"

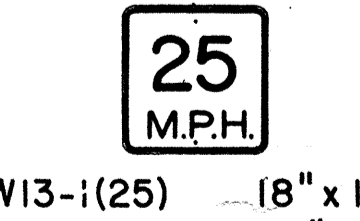

W13-1(25) 18"x18"  
W13-1(25)-A 24"x24"

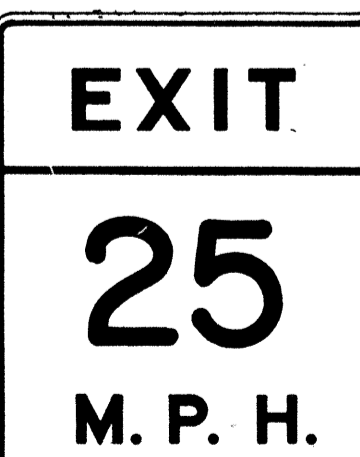

W13-2(25) 48"x60"

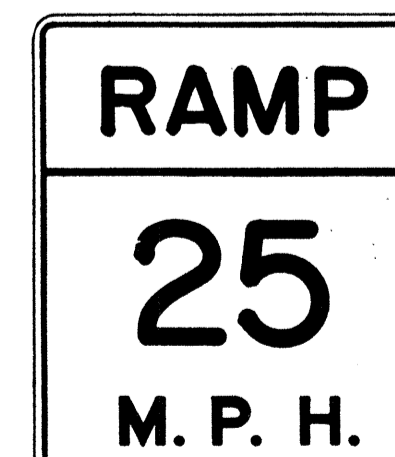

W13-3(25) 48"x60"



W14-1 30"x30"  
W14-1-A 36"x36"



W14-3 36"x48"x48"  
W14-3-A 48"x64"x64"

### GENERAL NOTES

- Sign details shall conform to the latest editions of FHWA publications, "Manual on Uniform Traffic Control Devices for Streets and Highways", "Standard Alphabet for Highway Signs", and "Standard Highway Signs", and as amended.
- All warning signs shall be reflectorized unless otherwise specified.
- All warning signs shall have 3/8" bolt holes drilled at appropriate locations.
- Numerals in ( ) indicates numerals to be inserted for sign message. (R) or (L) indicates right or left.
- Signs prefixed with "CW" on the plans shall indicate orange and black construction signs, and shall be reflectorized.

APPROVAL RECOMMENDED:  
*Erik Tanaka* 3/17/72  
TRAFFIC ENGINEER DATE

APPROVED:  
*Walter Robinson* 3-20-72  
ASSISTANT CHIEF, ENGINEERING DATE

NO.	REVISION	APPROVED BY	DATE
1	Supersedes Sht. DT 102 Approved 12-30-69	H.T.	3/20/72
2	Revised General Note 1	H.T.	10/16/74
3	Revised General Note 5	M.H.	9-16-75
4	Revised General Note 5	H.T.	9-14-76
5	Added Note 1	H.T.	11-7-79
6	Revised Signs & General Note 1	E.T.	9/18/85

STATE OF HAWAII  
DEPARTMENT OF TRANSPORTATION  
HIGHWAYS DIVISION

**STANDARD DETAILS**  
**WARNING SIGNS**

NOT TO SCALE

DATE: \_\_\_\_\_  
DRAWN BY: \_\_\_\_\_  
DESIGNED BY: \_\_\_\_\_  
CHECKED BY: \_\_\_\_\_  
No. \_\_\_\_\_

FED. ROAD DIST. NO.	STATE	FED. AID PROJ. NO.	FISCAL YEAR	SHEET NO.	TOTAL SHEETS
HAWAII	HAW.	1R-HI-1 (189)	1986	90	99

**General Notes**

- Sign details shall conform to the latest editions of the following FHWA publications:
  - "Standard Alphabets for Highway Signs," and as amended.
  - "Standard Highway Signs," and as amended.
  - "Manual on Uniform Traffic Control Devices for Streets and Highways," and as amended.
- All signs shall be reflectorized with reflective sheeting, unless otherwise specified.
- All signs shall have 3/8" bolt holes drilled at appropriate locations.
- Numerals in ( ) indicate numerals to be inserted for sign message. (R) or (L) indicates right or left.
- Signs prefixed with "CW" on the plans shall indicate orange and black construction signs, and shall be reflectorized with reflective sheeting.
- All signs shall be erected without educational plaques unless called for in the plans.

APPROVAL RECOMMENDED:  
Eishi Tanaka 5/2/78  
 TRAFFIC ENGINEER DATE

APPROVED:  
Andrew Z. Dakeishi 5/3/78  
 ASSISTANT CHIEF, ENGINEERING DATE

NO.	REVISION	APPROVED BY	DATE
1	Supersedes Sht. DT 103 approved 3/20/72	H.T.	5/2/78
2	Added General Note 6	H.T.	11/9/78
3	Revised Signs and added Sign W4-3	E.T.	9/18/85

STATE OF HAWAII  
 DEPARTMENT OF TRANSPORTATION  
 HIGHWAYS DIVISION

**STANDARD DETAILS**

MISCELLANEOUS SIGNS

NOT TO SCALE DATE: MAY, 1978  
 SHEET No. OF SHEETS DT 103

DATE: \_\_\_\_\_  
 SURVEY PLOTTED BY: \_\_\_\_\_  
 DRAWN BY: \_\_\_\_\_  
 CHECKED BY: \_\_\_\_\_  
 QUANTITIES BY: \_\_\_\_\_  
 NOTE BOOK No. \_\_\_\_\_

FED. ROAD DIST. NO.	STATE	FED. AID PROJ. NO.	FISCAL YEAR	SHEET NO.	TOTAL SHEETS
HAWAII	HAW.	1R-HI-1 (189)	1986	91	99



CW20-1a 48" x 48"



CW20-2d 48" x 48"



CW20-3b 48" x 48"



CW20-4d 48" x 48"



CW20-5d(L) 48" x 48"



CW21-1 30" x 30"



CW21-2 30" x 30"



CW20-7c 36" x 36"  
24" x 18"  
CW20-7c-A 48" x 48"  
24" x 18"



CW21-3 36" x 36"



CW21-4 36" x 36"



CW21-5 30" x 30"




CW21-6 30" x 30"



CW22-1b 48" x 48"




CW22-2 42" x 36"

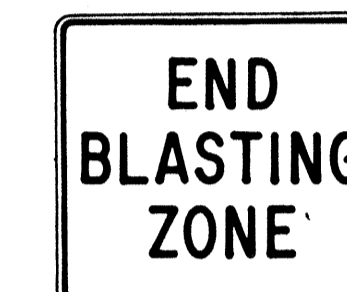

CW22-3 42" x 36"



CG20-1(5) 60" x 36"

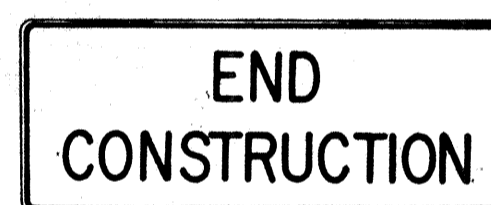


CG20-2 60" x 24"



CM4-9(R) 30" x 24"




CM4-10(R) 48" x 18"

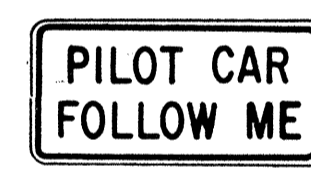

CG20-4 36" x 18"



CW23-1 36" x 36"

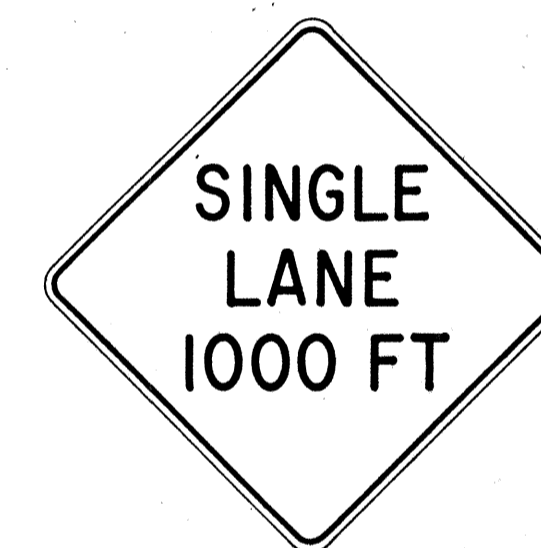

CW23-2b 48" x 48"



CW23-3(R) 48" x 48"

**GENERAL NOTES**

1. Sign details shall conform to the latest editions of FHWA publications "Manual on Uniform Traffic Control Devices for Streets and Highways," "Standard Alphabets for Highway Signs," and "Standard Highway Signs," and as amended.
2. All construction signs shall be reflectorized.
3. All construction signs shall have 3/8" bolt holes drilled at appropriate locations.
4. Numerals in ( ) indicates numerals to be inserted for sign message. (R) or (L) indicates right or left.
5. For "CW" series signs, suffixes a,b,c and d are as follows:  
a-1500 FT, b-1000 FT,  
c-500 FT and d-AHEAD.

APPROVAL RECOMMENDED:  
*Erich Tanaka* 3/21/72  
TRAFFIC ENGINEER DATE

APPROVED:  
*Hubert R. Salsich* 2/23/72  
ASSISTANT CHIEF, ENGINEERING DATE

NO.	REVISION	APPROVED BY	DATE
1	Supersedes Sht. DT 104 Approved 12-30-69	H.T.	3/25/72
2	Revised General Note 1	H.T.	10/10/74
3	Revised General Note 2	H.T.	9-16-75
4	Revised General Note 2 and sign CG20-1(5)	H.T.	9-14-76
5	Revised General Note 1 and sign CW20-7c	E.T.	9/10/85


STATE OF HAWAII  
DEPARTMENT OF TRANSPORTATION  
HIGHWAYS DIVISION

**STANDARD DETAILS**  
**CONSTRUCTION SIGNS**


NOT TO SCALE

DATE	_____
SURVEY PLOTTED BY	_____
DRAWN BY	_____
DESIGNED BY	_____
CHECKED BY	_____
ORIGINAL PLAN	_____
NOTE BOOK	_____
No.	_____

FED. ROAD DIST. NO.	STATE	FED. AID PROJ. NO.	FISCAL YEAR	SHEET NO.	TOTAL SHEETS
HAWAII	HAW.	IR-HI-1(189)	1986	92	99

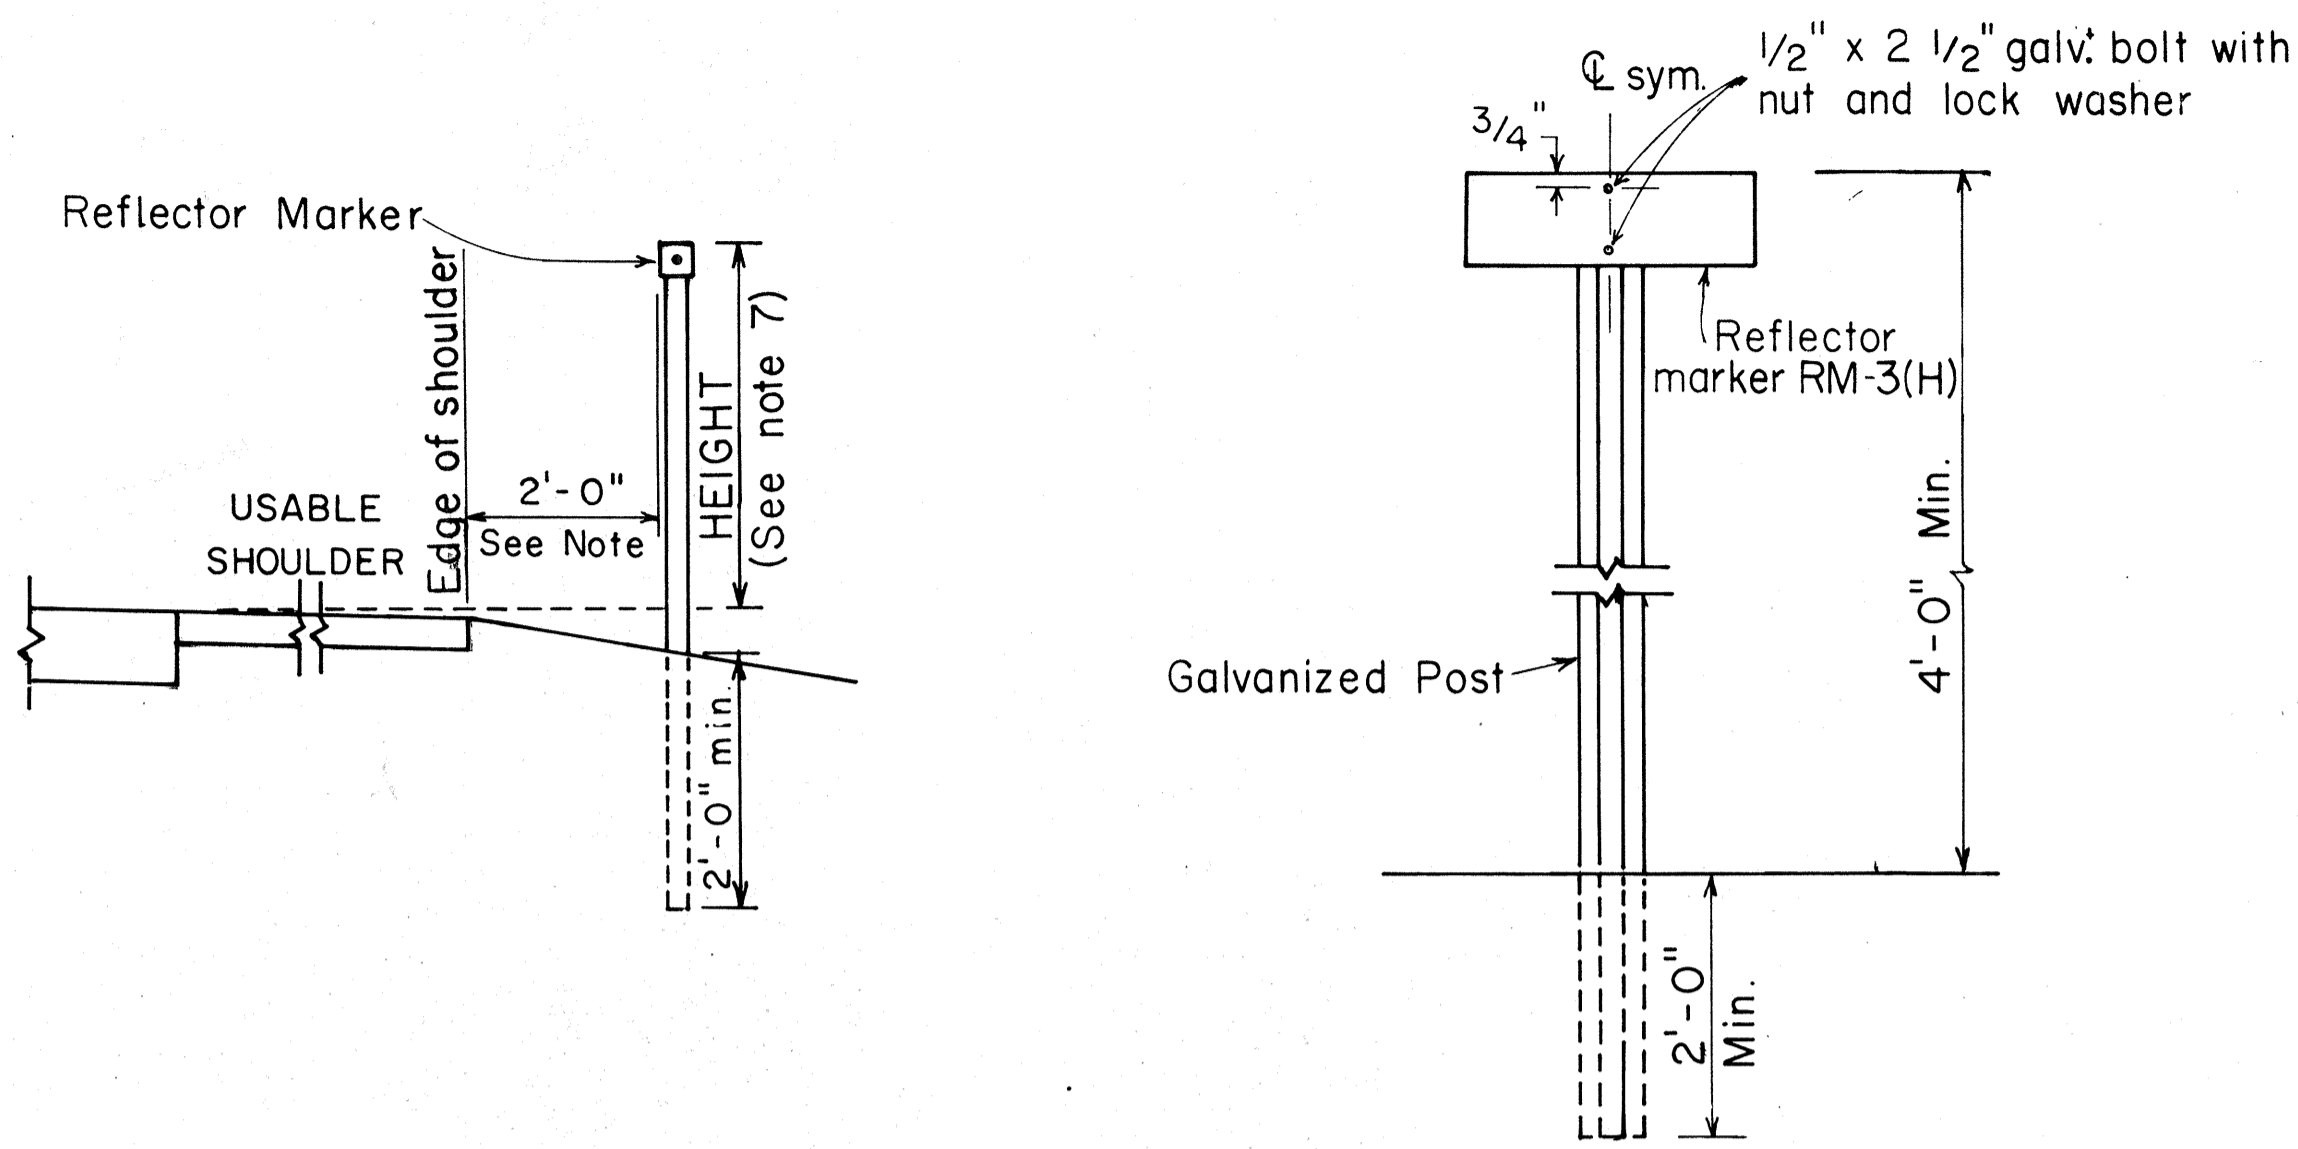

**REFLECTOR MARKER MOUNTING DETAIL**

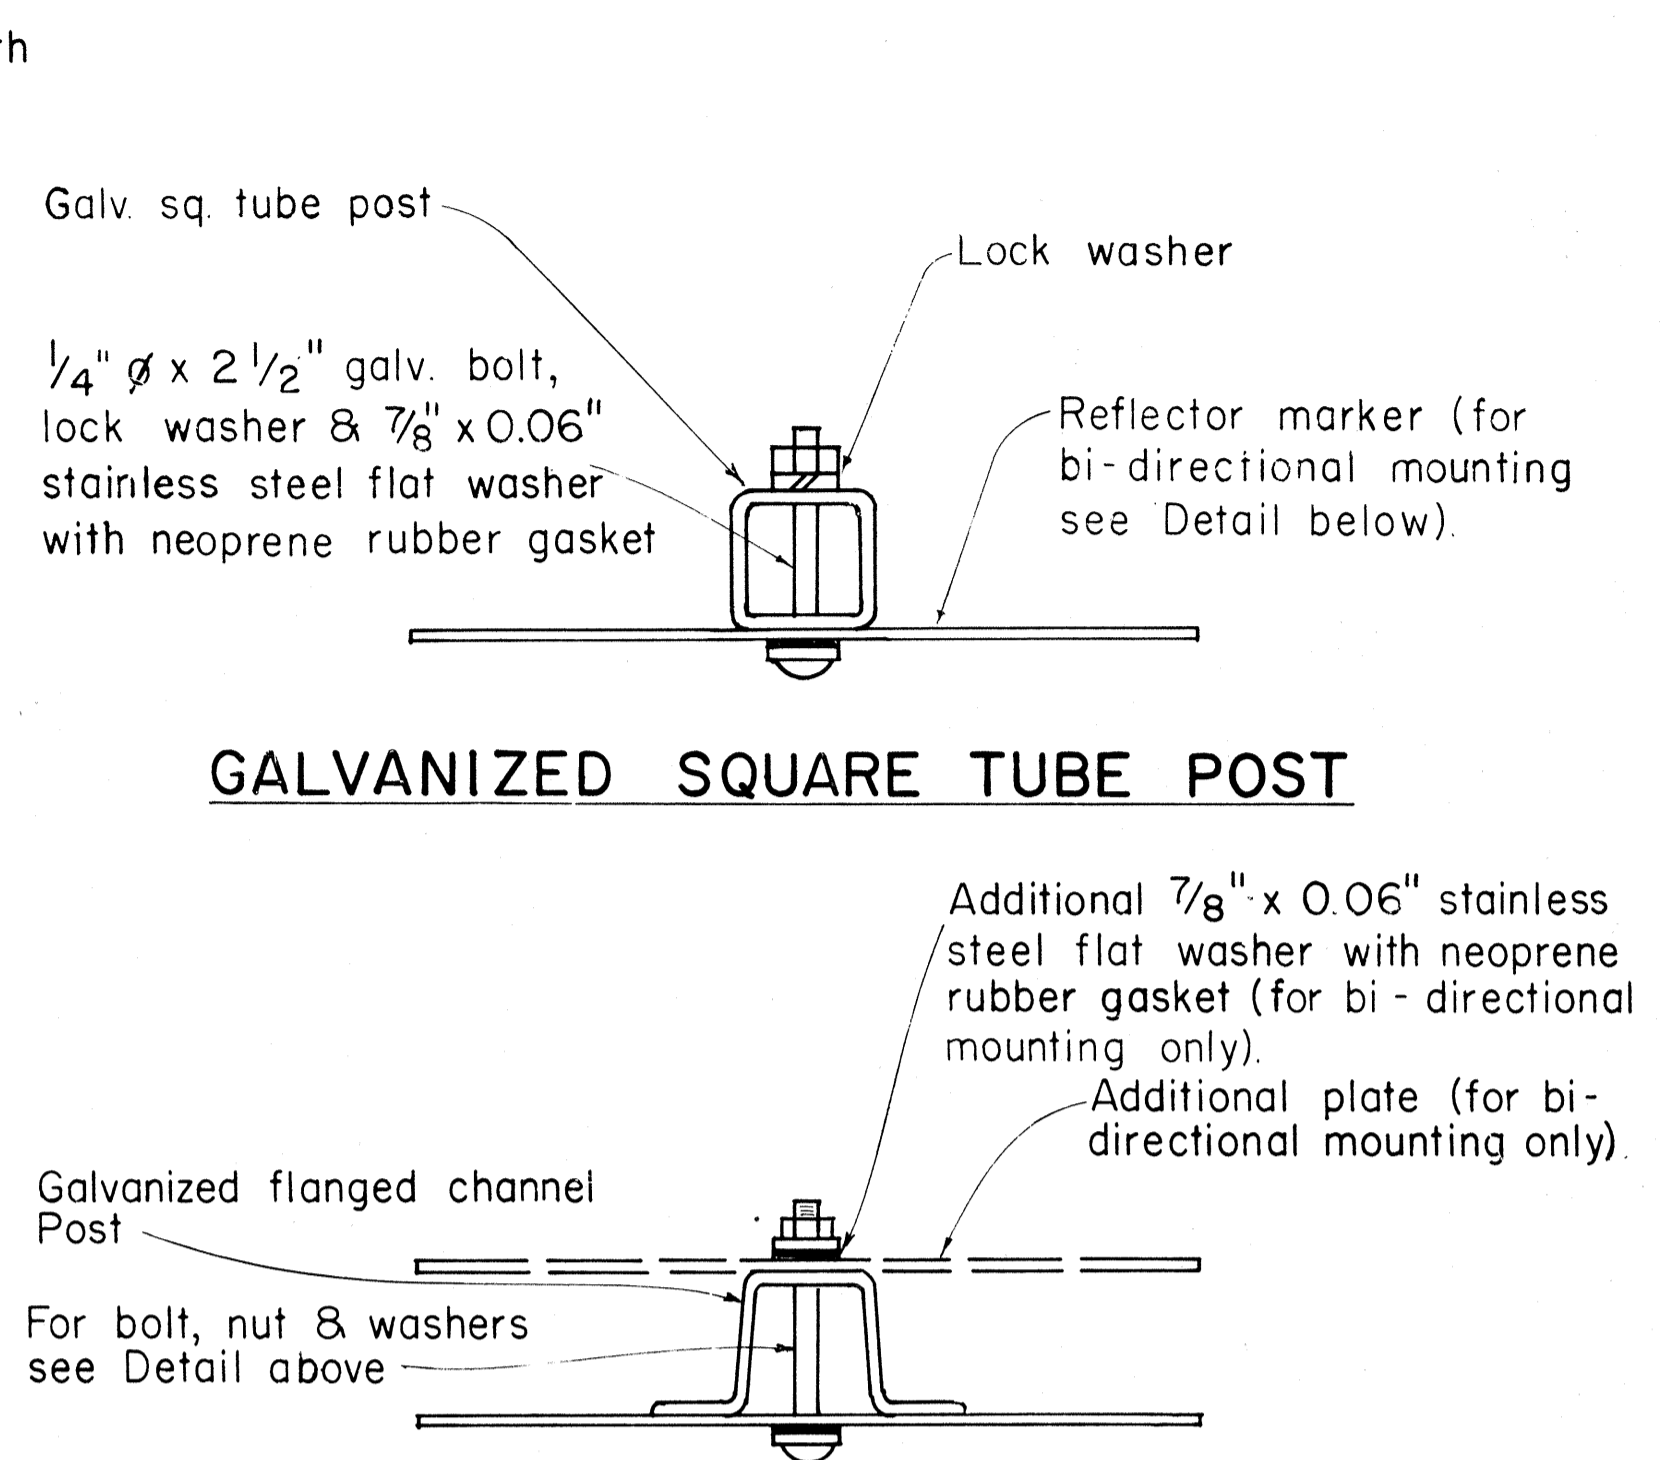


**GALVANIZED SQUARE TUBE POST**

**GALVANIZED FLANGED CHANNEL POST**

**TYPICAL MOUNTING DETAILS**

**GENERAL NOTES:**

1. Clearance markers (RM-3, RM-4) shall be installed with the edge of the marker in line with the inner edge of the obstruction.
2. (R) or (L) indicates right or left and shall be as shown on the plans.
3. Reflector markers RM-1 and RM-2 shall be:
  - a) Yellow if placed along the left edge of divided roadways, one-way roadways, and ramps in the direction of travel.
  - b) White if placed along the right edge of divided roadways, one-way roadways, and ramps in the direction of travel.
4. For RM-4, the stripes shall slope downward at an angle of 45° toward the side of the obstruction that traffic is to pass.
5. For reflector marker RM-9, reflective sheeting material may be used as an alternate.
6. (H) indicates horizontal mounting of reflector marker.
7. Height = 4'-0" min. for RM-1, RM-2 and RM-3.  
Height = 5'-6" min. for RM-4 and RM-9.
8. Final locations of reflector markers shall be approved by the Engineer.

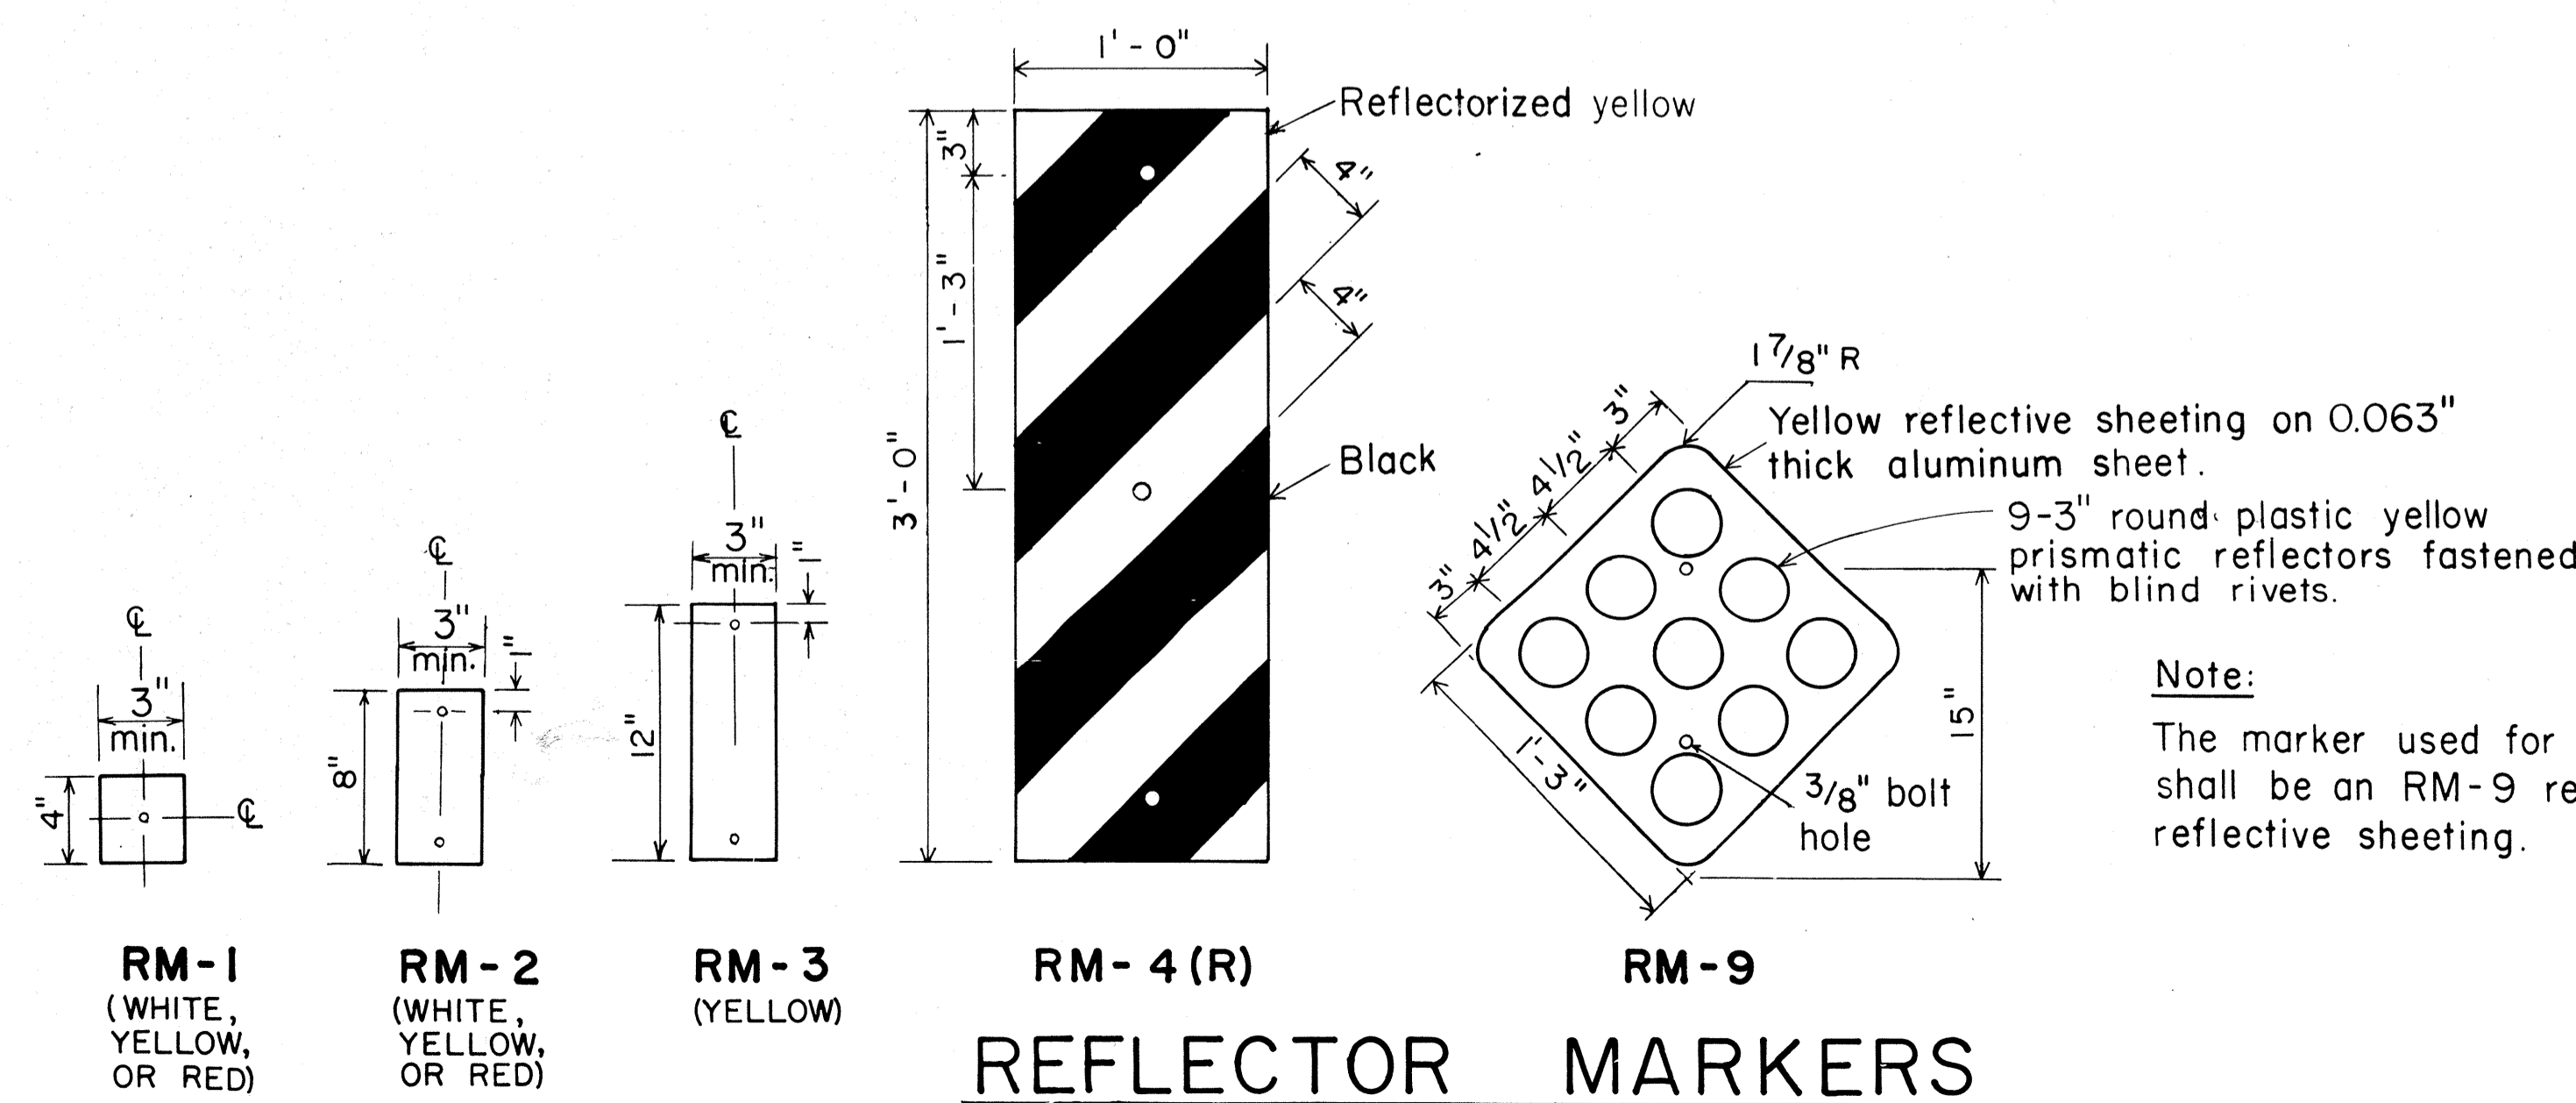

**REFLECTOR MARKERS**

**Note:**  
The marker used for the end of a roadway shall be an RM-9 reflectORIZED with red reflective sheeting.

APPROVAL RECOMMENDED:  
*Echie Tanaka* 11/1/77  
TRAFFIC ENGINEER DATE

APPROVED:  
*Herbert S. Sakai* 11/15/77  
ASSISTANT CHIEF, ENGINEERING DATE

NO.	REVISION	APPROVED BY	DATE
1	Revised Mounting Details	H.S.	4/25/80
2	Revised General Notes, Mounting Details and Reflector Markers.	p.d.	9-28-83
3	Eliminated White for RM-4	p.d.	1-30-85

STATE OF HAWAII  
DEPARTMENT OF TRANSPORTATION  
HIGHWAYS DIVISION

**STANDARD DETAILS**  
MISCELLANEOUS REFLECTOR MARKERS

Not to scale June, 1977





SHEET No. OF SHEETS DT 110

ORIGINAL PLAN	DATE
DRAWN BY	
TRACED BY	
DESIGNED BY	
CHECKED BY	
NOTE BOOK	
NO.	

FED. ROAD DIST. NO.	STATE	FED. AID PROJ. NO.	FISCAL YEAR	SHEET NO.	TOTAL SHEETS
HAWAII	HAW.	IR-HI-1(100)	1986	93	99

\* For moment calculations only. Post shall be from top of foundation to top of sign.  
 \*\* For fills with side slopes flatter than 4:1, Minimum Footing Depth shall be 4 1/2 feet.  
 \*\*\* All posts shall conform to ASTM A36

POST SIZE ***	MAXIMUM SIGN AREA	POST HEIGHT TOP OF FOUNDATION TO CENTER OF SIGN *	DIMENSIONS													ANCHOR BOLT DIA.	MINIMUM FOOTING DEPTH		BARS Z SIZE
			H	J	K	M	N	O	P	S	T	U	V	W	CUT		FILL**		
W6x12	70 sq. ft.	10'	14"	5"	24"	17 1/4"	1 5/8"	6"	1 1/4"	9"	6"	10"	2"	1"	1 1/8" ø	4 1/2'	4 1/2'	# 7	
W6x16	110 sq. ft.	13'							1 3/8"					1 1/4"		5'	5'	# 7	
W8x24	150 sq. ft.	16'	16 1/2"	6 3/4"	30"	20"	1 3/4"		1 1/2"	11 3/4"	6 1/2"		1 3/4"	1 1/2"	1 1/4" ø	5'	5 1/2'	# 8	
W8x28	170 sq. ft.	20'							1 1/2"					1 3/4"	1 3/8" ø	5 1/2'	6 1/2'	# 8	
W8x31	190 sq. ft.	20'	16 1/4"	6 7/8"			1 7/8"		1 5/8"	11 7/8"	6 1/4"		1 7/8"	1 1/2" ø	6'			# 8	
W10x33	230 sq. ft.	20'	20 1/4"	4 7/8"	24"					10 7/8"	8 1/4"	12"	2"		7'	7'		# 8	
W10x39	250 sq. ft.	20'													7'	7 1/2'		# 8	

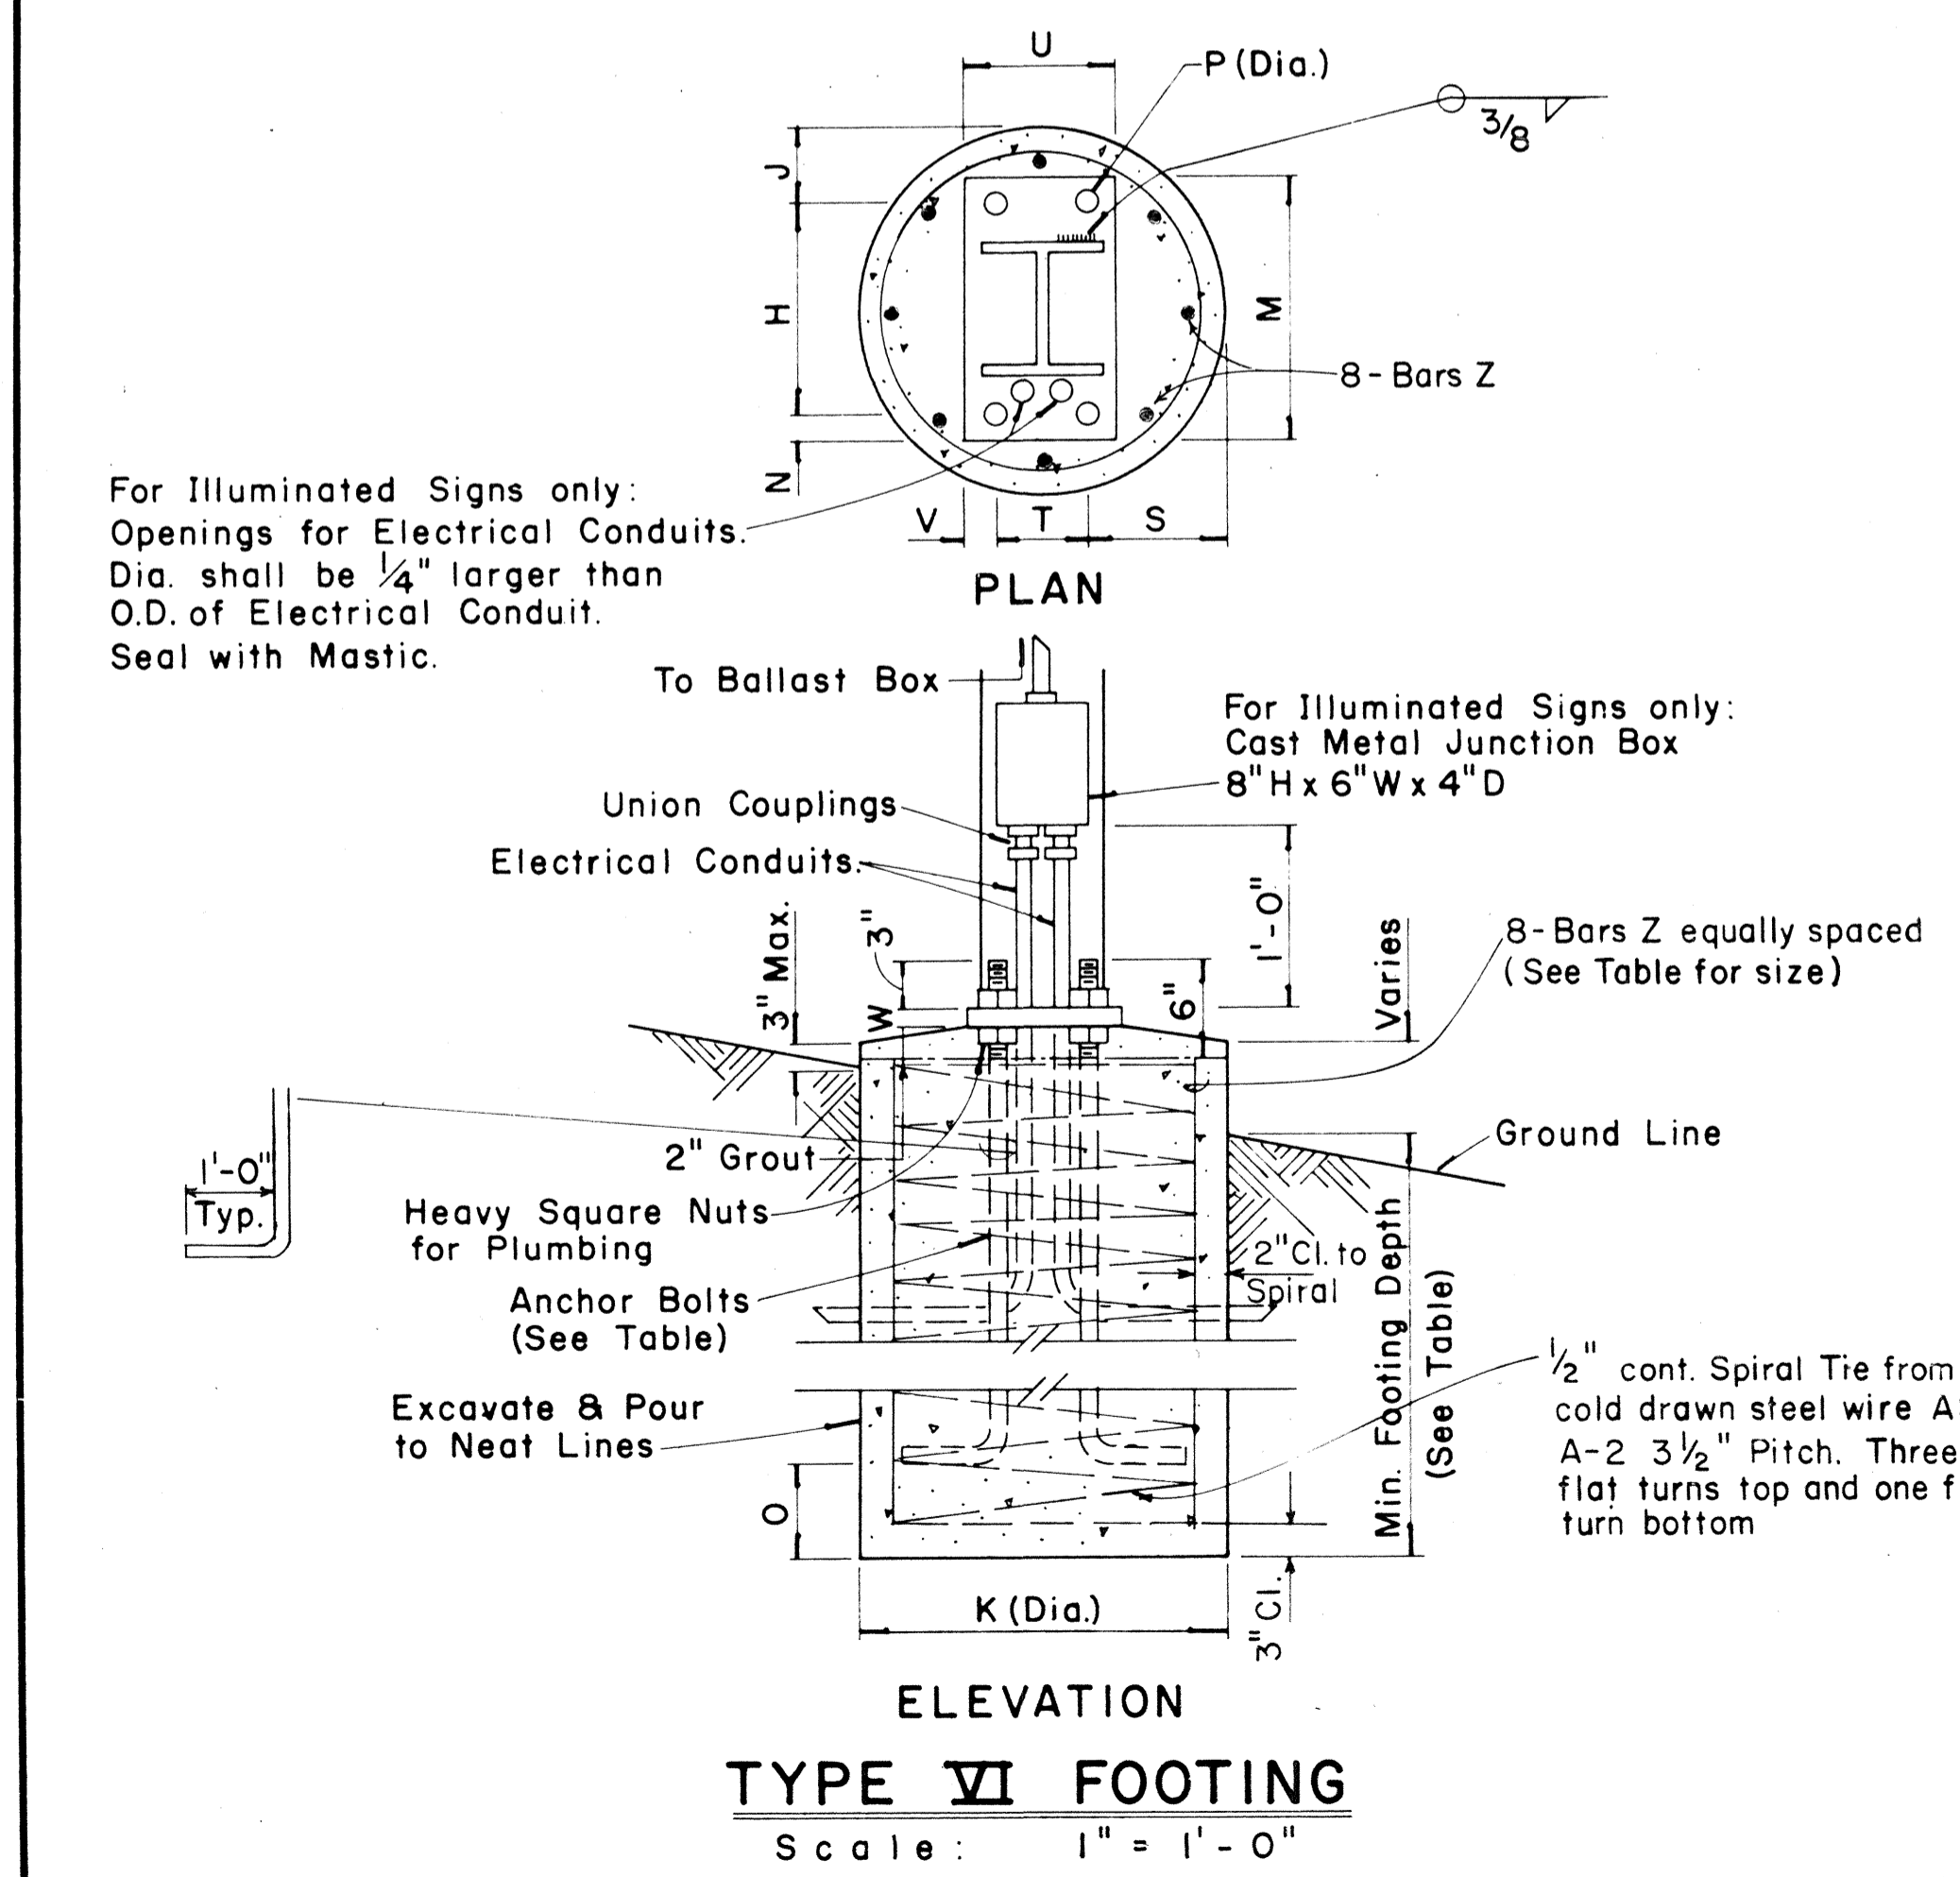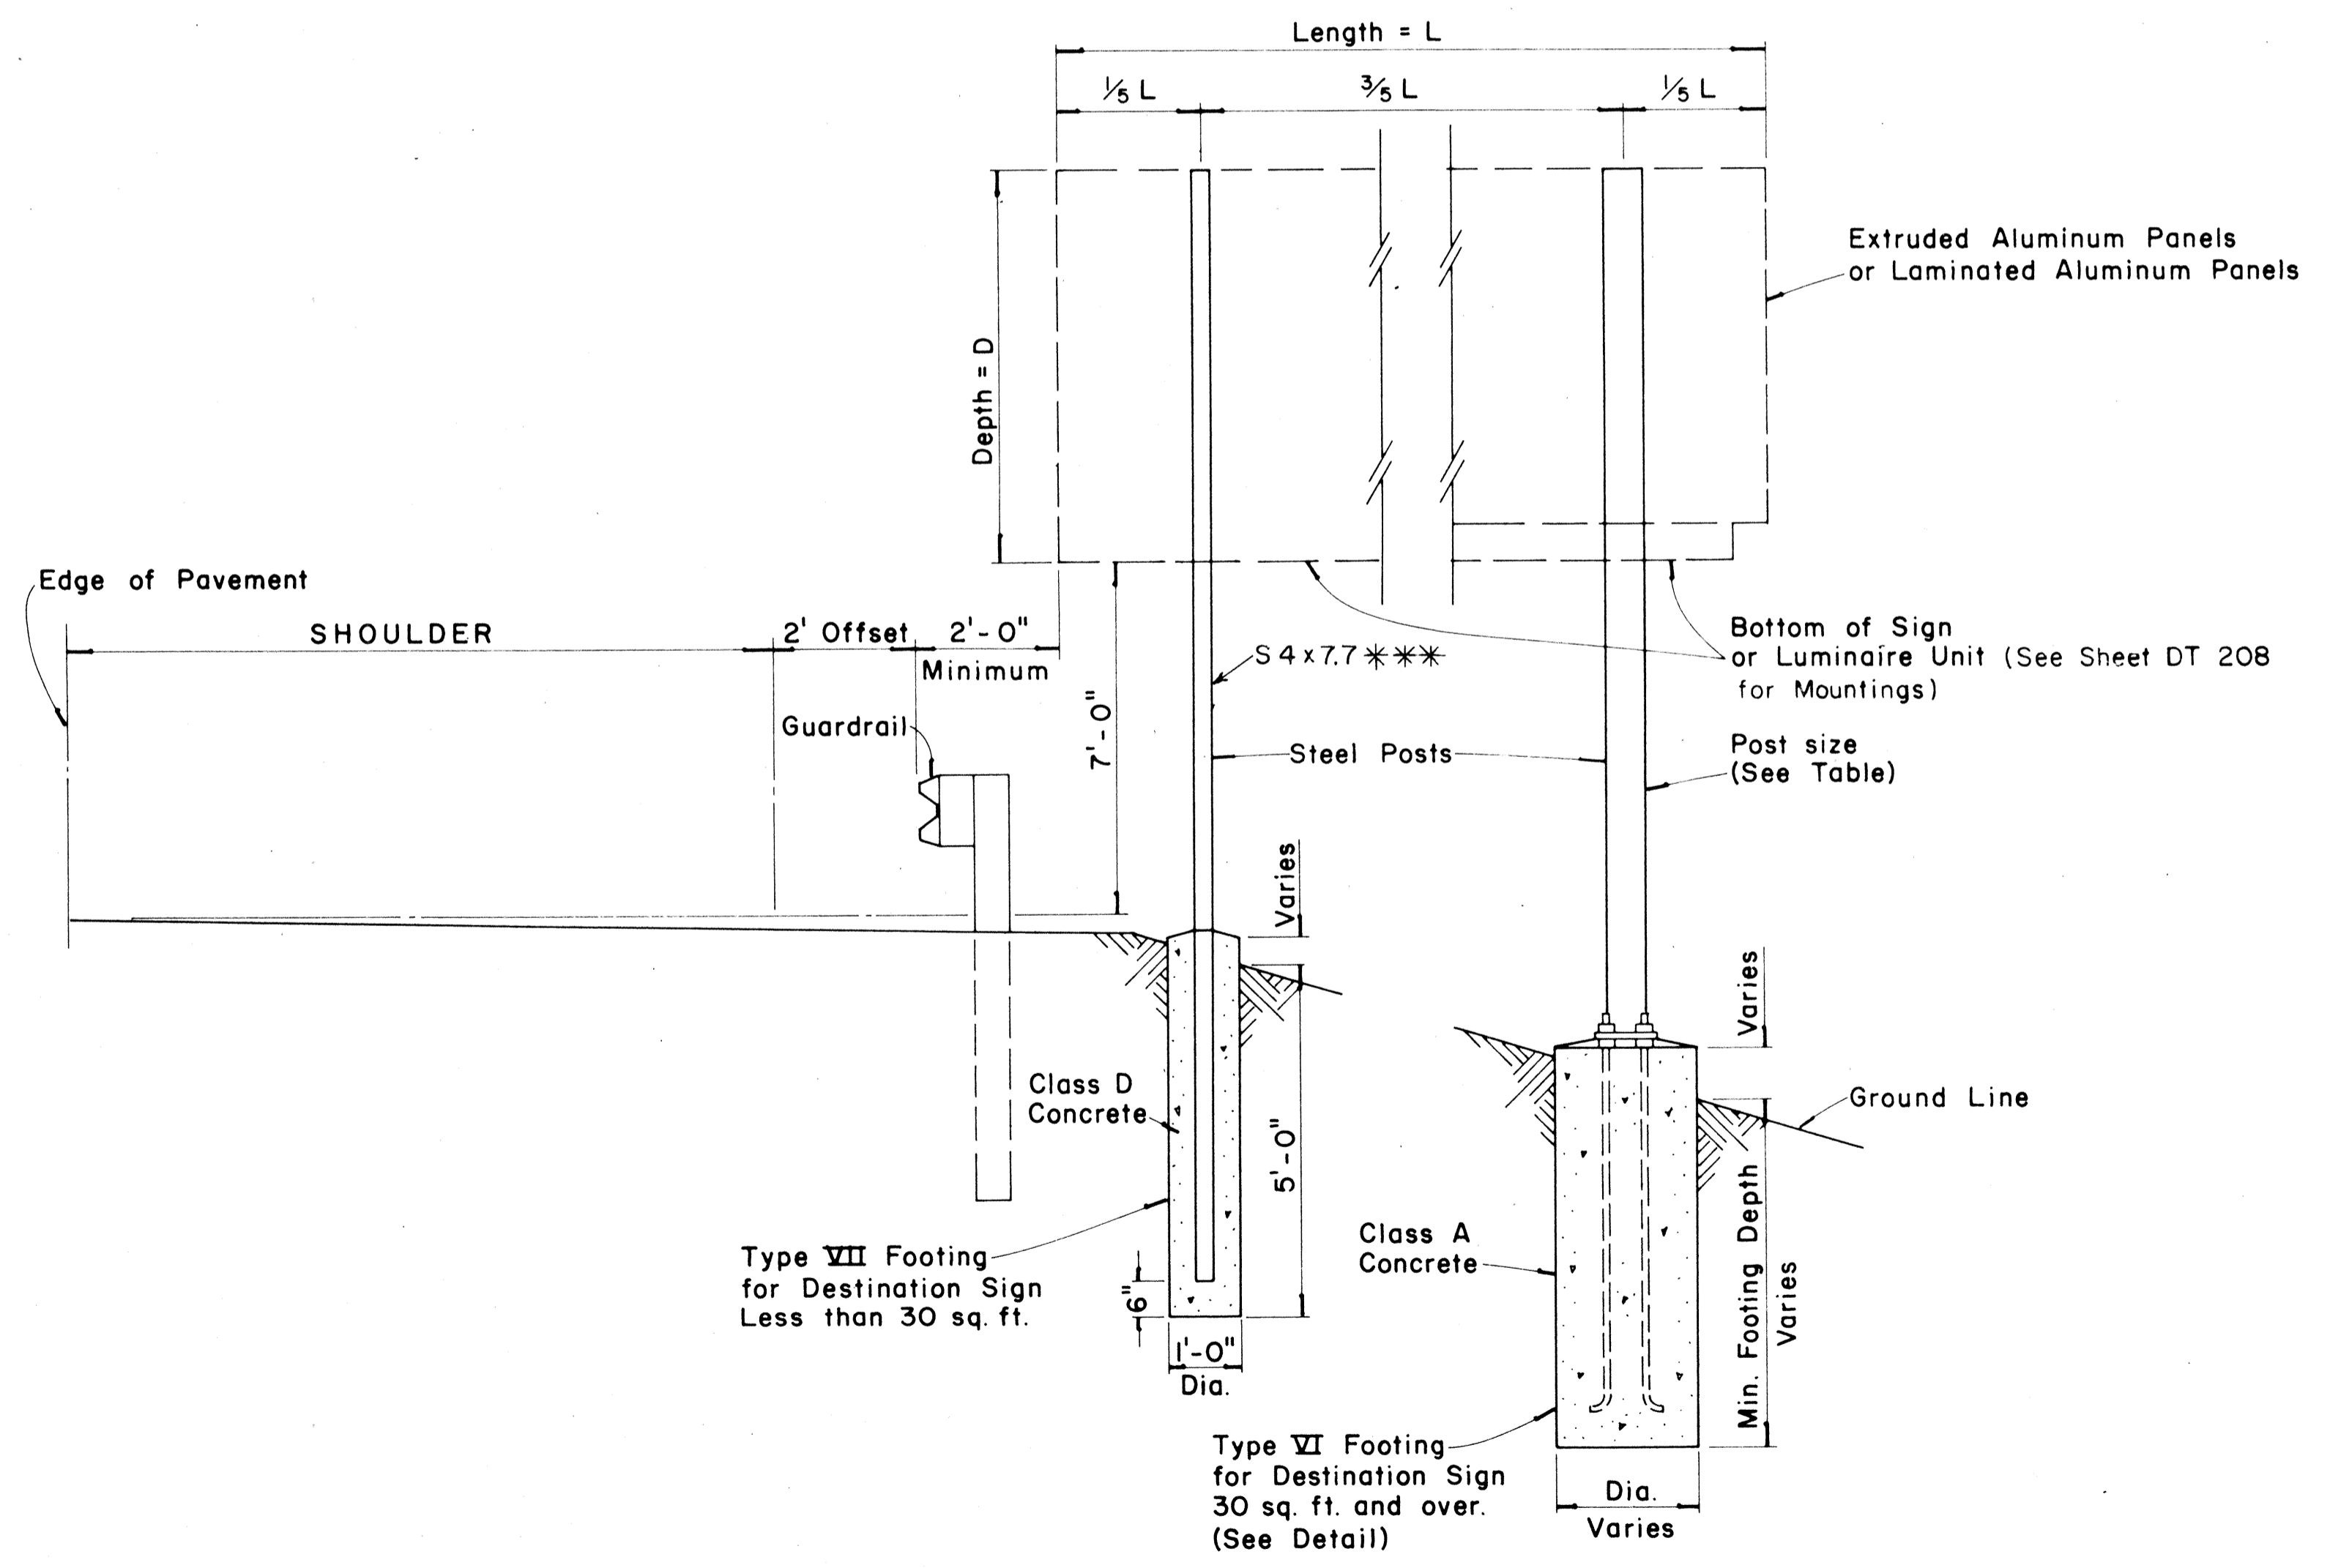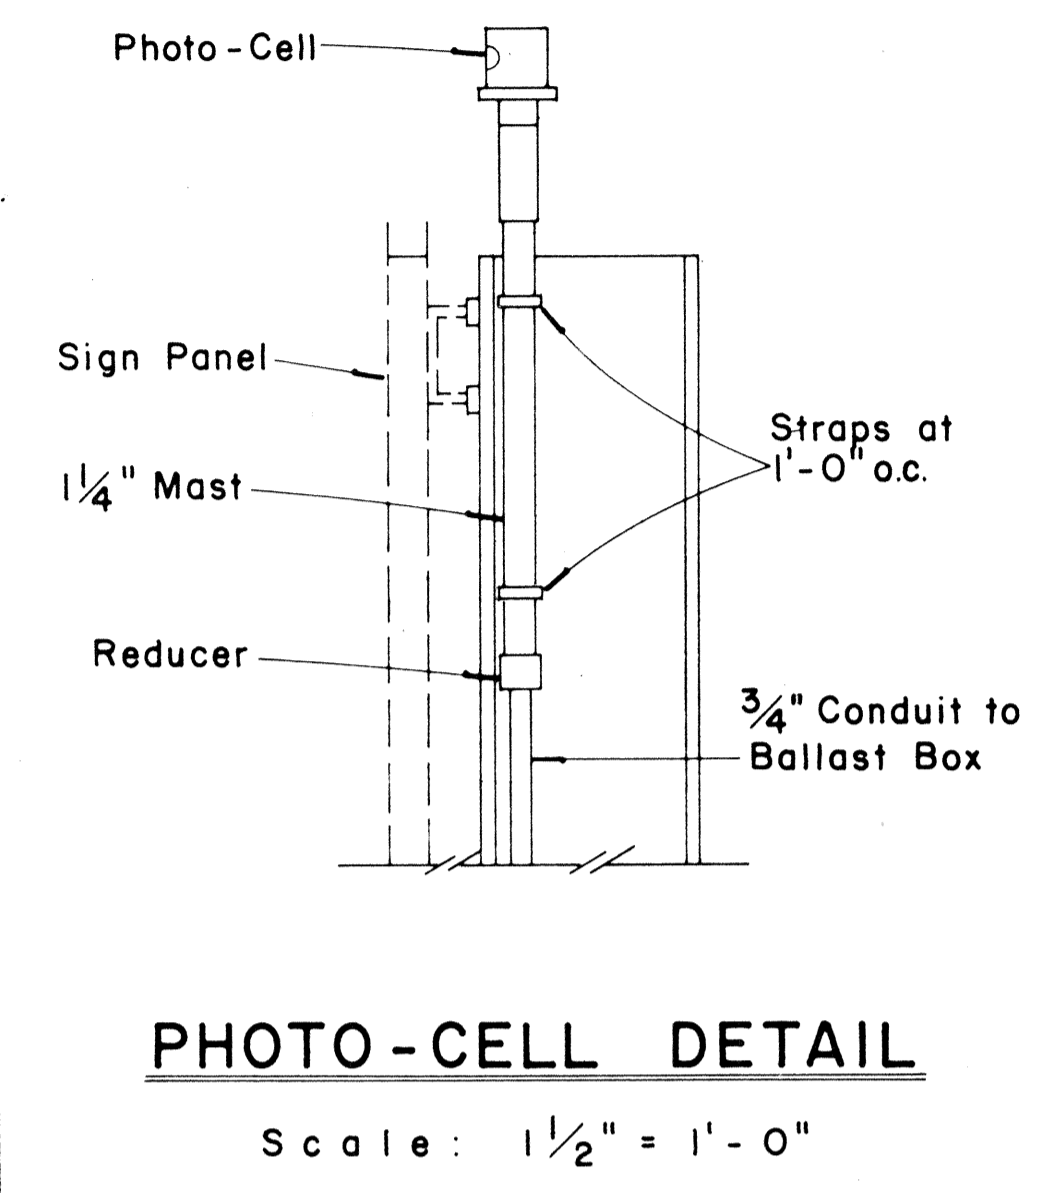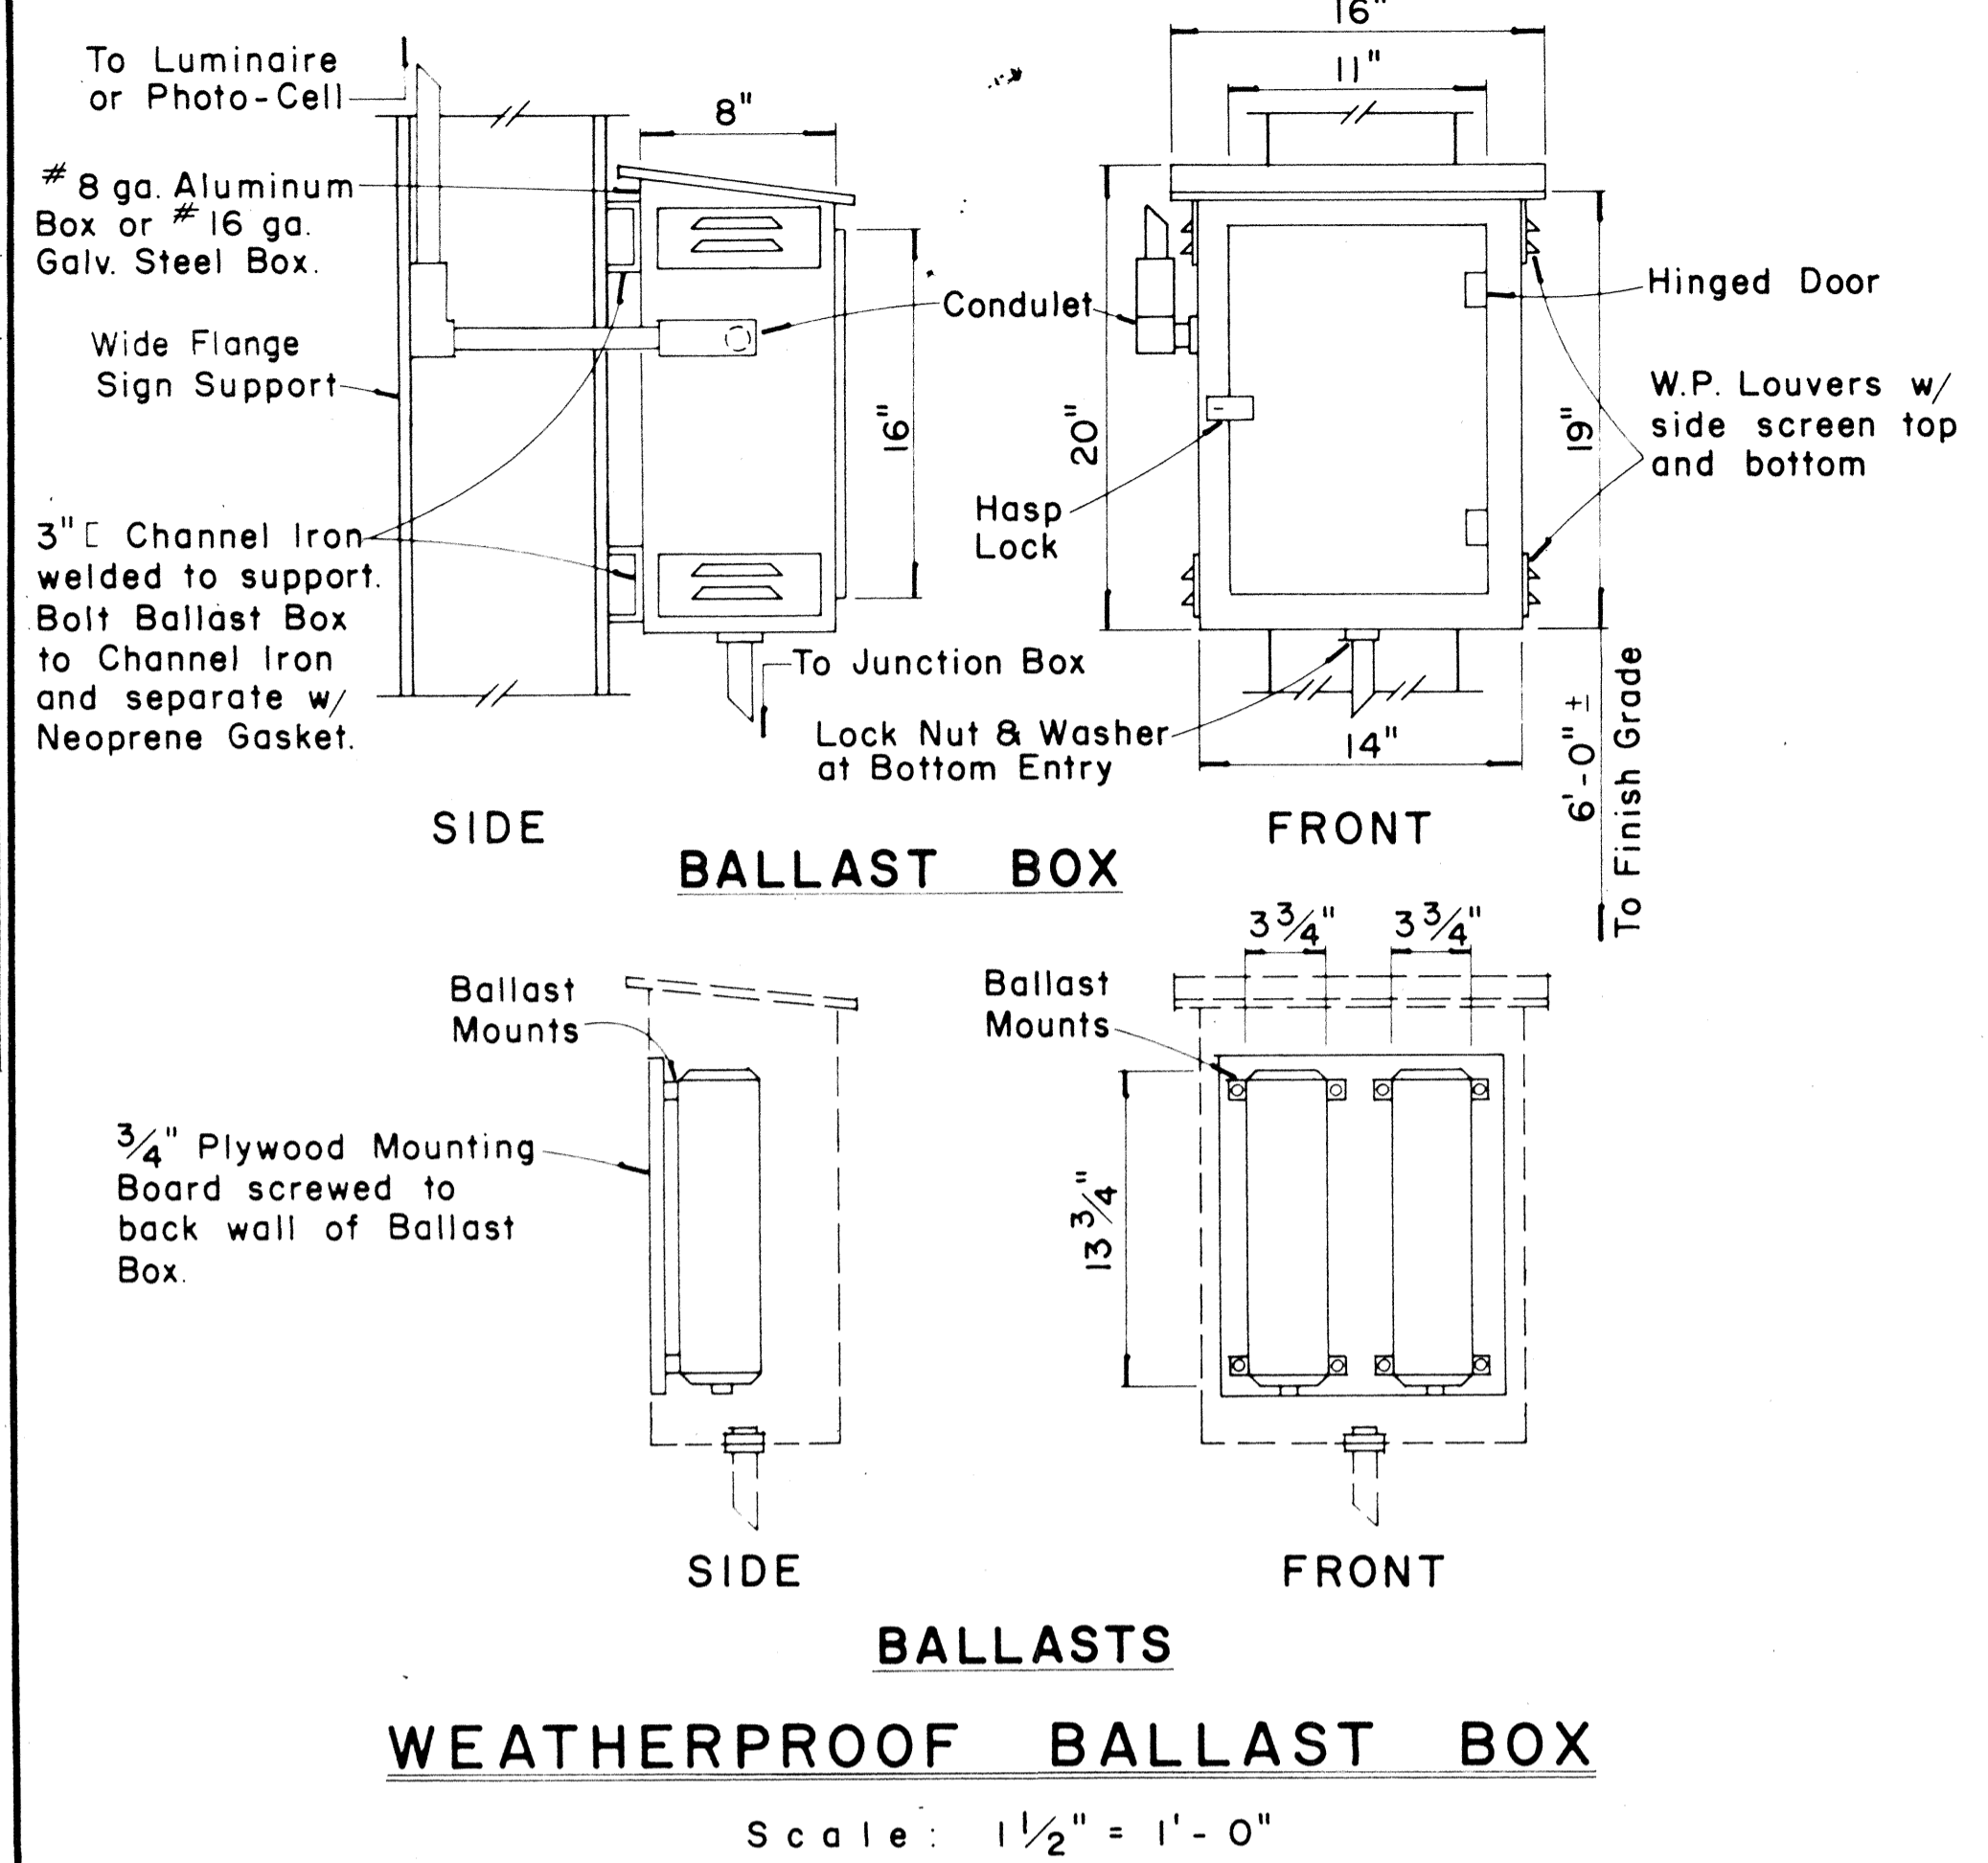

APPROVAL RECOMMENDED:  
*Eishi Tanaka* 12/29/69  
 TRAFFIC ENGINEER DATE

APPROVED:  
*John S. ...* 12-20-69  
 ASSISTANT CHIEF, ENGINEERING DATE

NO.	REVISION	APPROVED BY	DATE
1	Add note for luminaire mounting.	H.I.	6/3/85
2	Revised Data Table, Typical Expressway Sign, Ballasts and Footing	Jim C	10/21/85

STATE OF HAWAII  
 DEPARTMENT OF TRANSPORTATION  
 HIGHWAYS DIVISION





STANDARD DETAILS  
 DESTINATION & GROUND MOUNTED  
 EXPRESSWAY SIGN

Scale: As Shown  
 SHEET No. OF SHEETS DT 203





DATE  
 SURVEY PLANNED BY  
 DRAWN BY  
 TRACED BY  
 CHECKED BY  
 NOTE BOOK  
 No.

FED. ROAD DIST. NO.	STATE	FED. AID PROJ. NO.	FISCAL YEAR	SHEET NO.	TOTAL SHEETS
HAWAII	HAW.	IR-HH(189)	1986	94	99

Post Size	Bolt Size & Torque	BASE CONNECTION DATA TABLE										FUSE PLATE DATA TABLE								FOUNDATION DATA						
		A	B	C	D	E	t <sub>1</sub>	t <sub>2</sub>	W	R	F	G	H	J	K	L	N	d <sub>1</sub>	t <sub>3</sub>	Bolt Dia.	Wt. of each Fuse #	Stub Length	Stub Projection	Footing Diameter	Bars V Size	
W6x9	5/8" φ x 2 3/4" Torque = 450"#	5"	2"	1 1/4"	2 3/4"	1 1/8"	3/4"	1/2"	1/4"	1 1/32"	3 5/8"	2"	1 1/8"	4"	2 1/4"	7/8"	1/2"	9/16"	1/4"	1/2" φ	1.09#	2'-0"	3"	2'-0"	#7	
W6x12											3 3/4"	2"	1 1/8"	4"	2 1/4"	7/8"	5/8"	1 1/16"	3/8"	5/8" φ	1.60#	2'-0"	3"	2'-0"	#7	
W6x16											4 1/2"	2 1/2"	1 1/4"	6"	3 1/2"	1 1/4"	3/4"	1 3/16"	1/2"	3/4" φ	3.75#	2'-6"	3"	2'-0"	#7	
W8x18											4 1/2"	2 1/2"	1 1/4"	5 1/4"	2 3/4"	1 1/4"	3/4"	1 3/16"	1/2"	3/4" φ	3.27#	2'-6"	3"	2'-0"	#7	
W8x21	3/4" φ x 3 1/2" Torque = 750"#	6"	2 1/4"	1 3/8"	3 1/2"	1 1/4"	1"	3/4"	5/16"	1 3/32"	4 7/8"	2 1/2"	1 1/2"	5 1/4"	2 3/4"	1 1/4"	7/8"	1 5/16"	9/16"	7/8" φ	3.93#	3'-0"	2 1/2"	2'-0"	#8	
W10x22											5 3/8"	3"	1 1/2"	5 3/4"	2 3/4"	1 1/2"	7/8"	1 5/16"	9/16"	7/8" φ	4.75#	3'-0"	2 1/2"	2'-0"	#9	
W10x26											5 3/8"	3"	1 1/2"	5 3/4"	2 3/4"	1 1/2"	7/8"	1 5/16"	9/16"	7/8" φ	4.79#	3'-0"	2 1/2"	2'-0"	#10	
W12x30											5 3/8"	3"	1 1/2"	6 1/2"	3 1/2"	1 1/2"	7/8"	1 5/16"	9/16"	7/8" φ	5.42#	3'-0"	2 1/2"	2'-0"	#11	
S3x5.7	1/2" φ x 2 1/2" Torque = 200"#	SEE DETAIL "A"										3 1/8"	1 1/2"	1 1/8"	2 5/8"	1 1/2"	9/16"	1/2"	9/16"	1/4"	1/2" φ	0.64#	1'-6"	3 1/2"	1'-6"	#5
S4x7.7		3 1/8"	1 1/2"	1 1/8"	2 5/8"	1 1/2"	9/16"	1/2"	9/16"	1/4"	1/2" φ	0.64#	1'-6"	3 1/2"	1'-6"	#5										

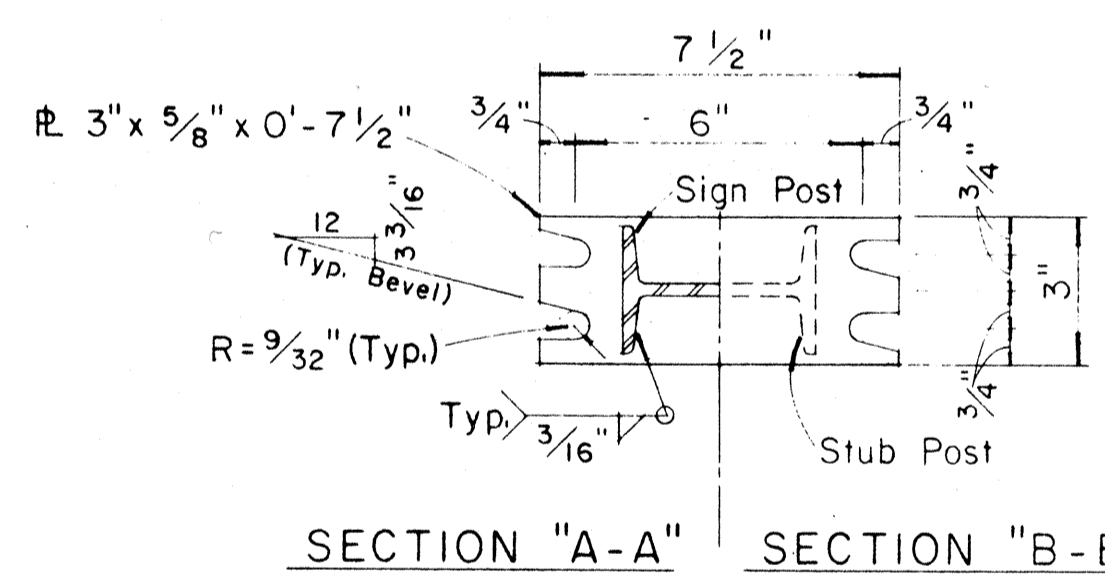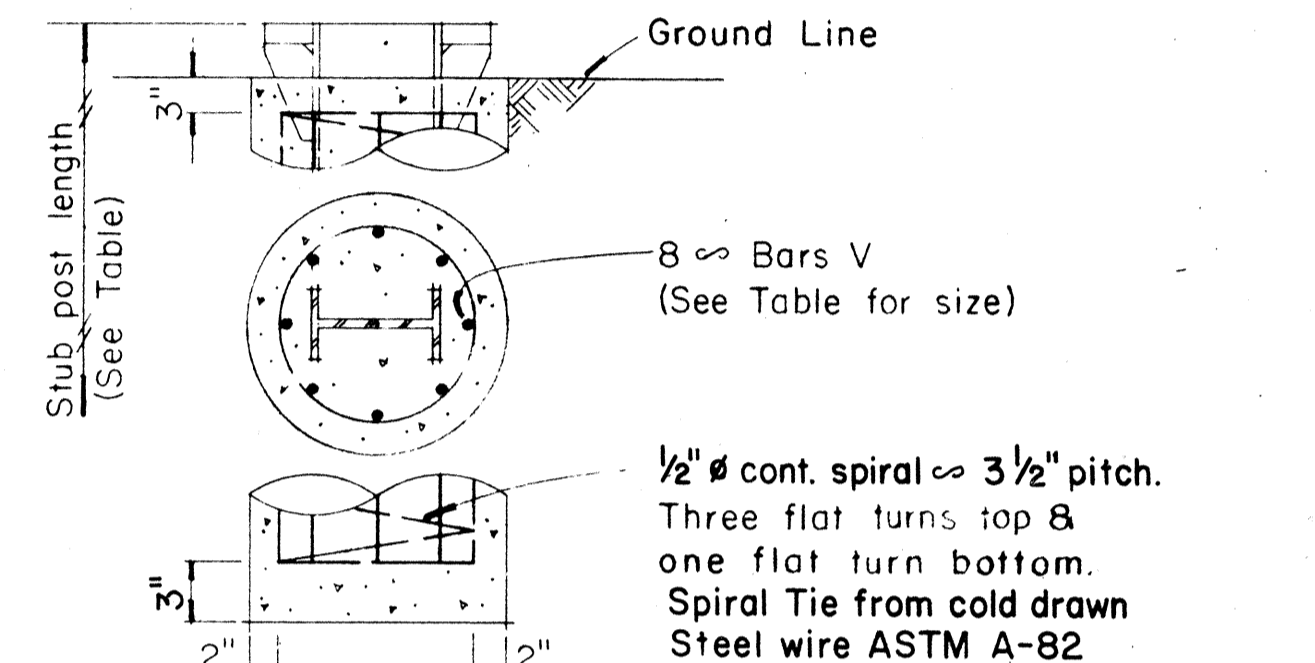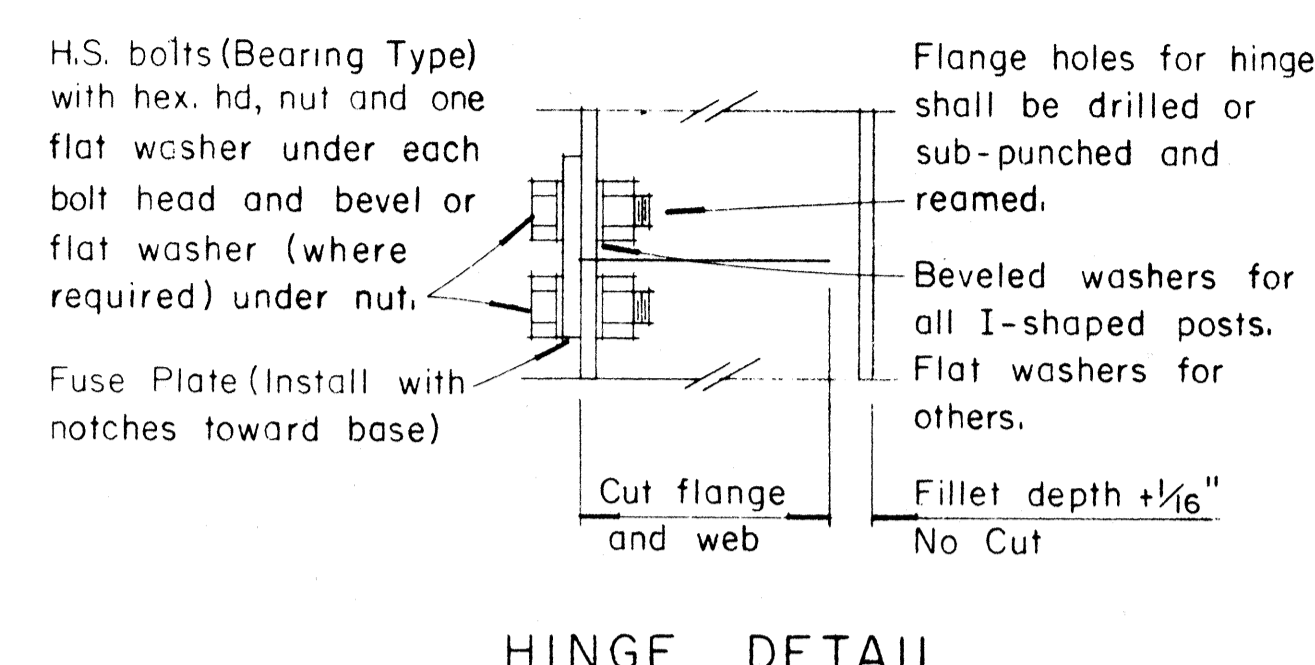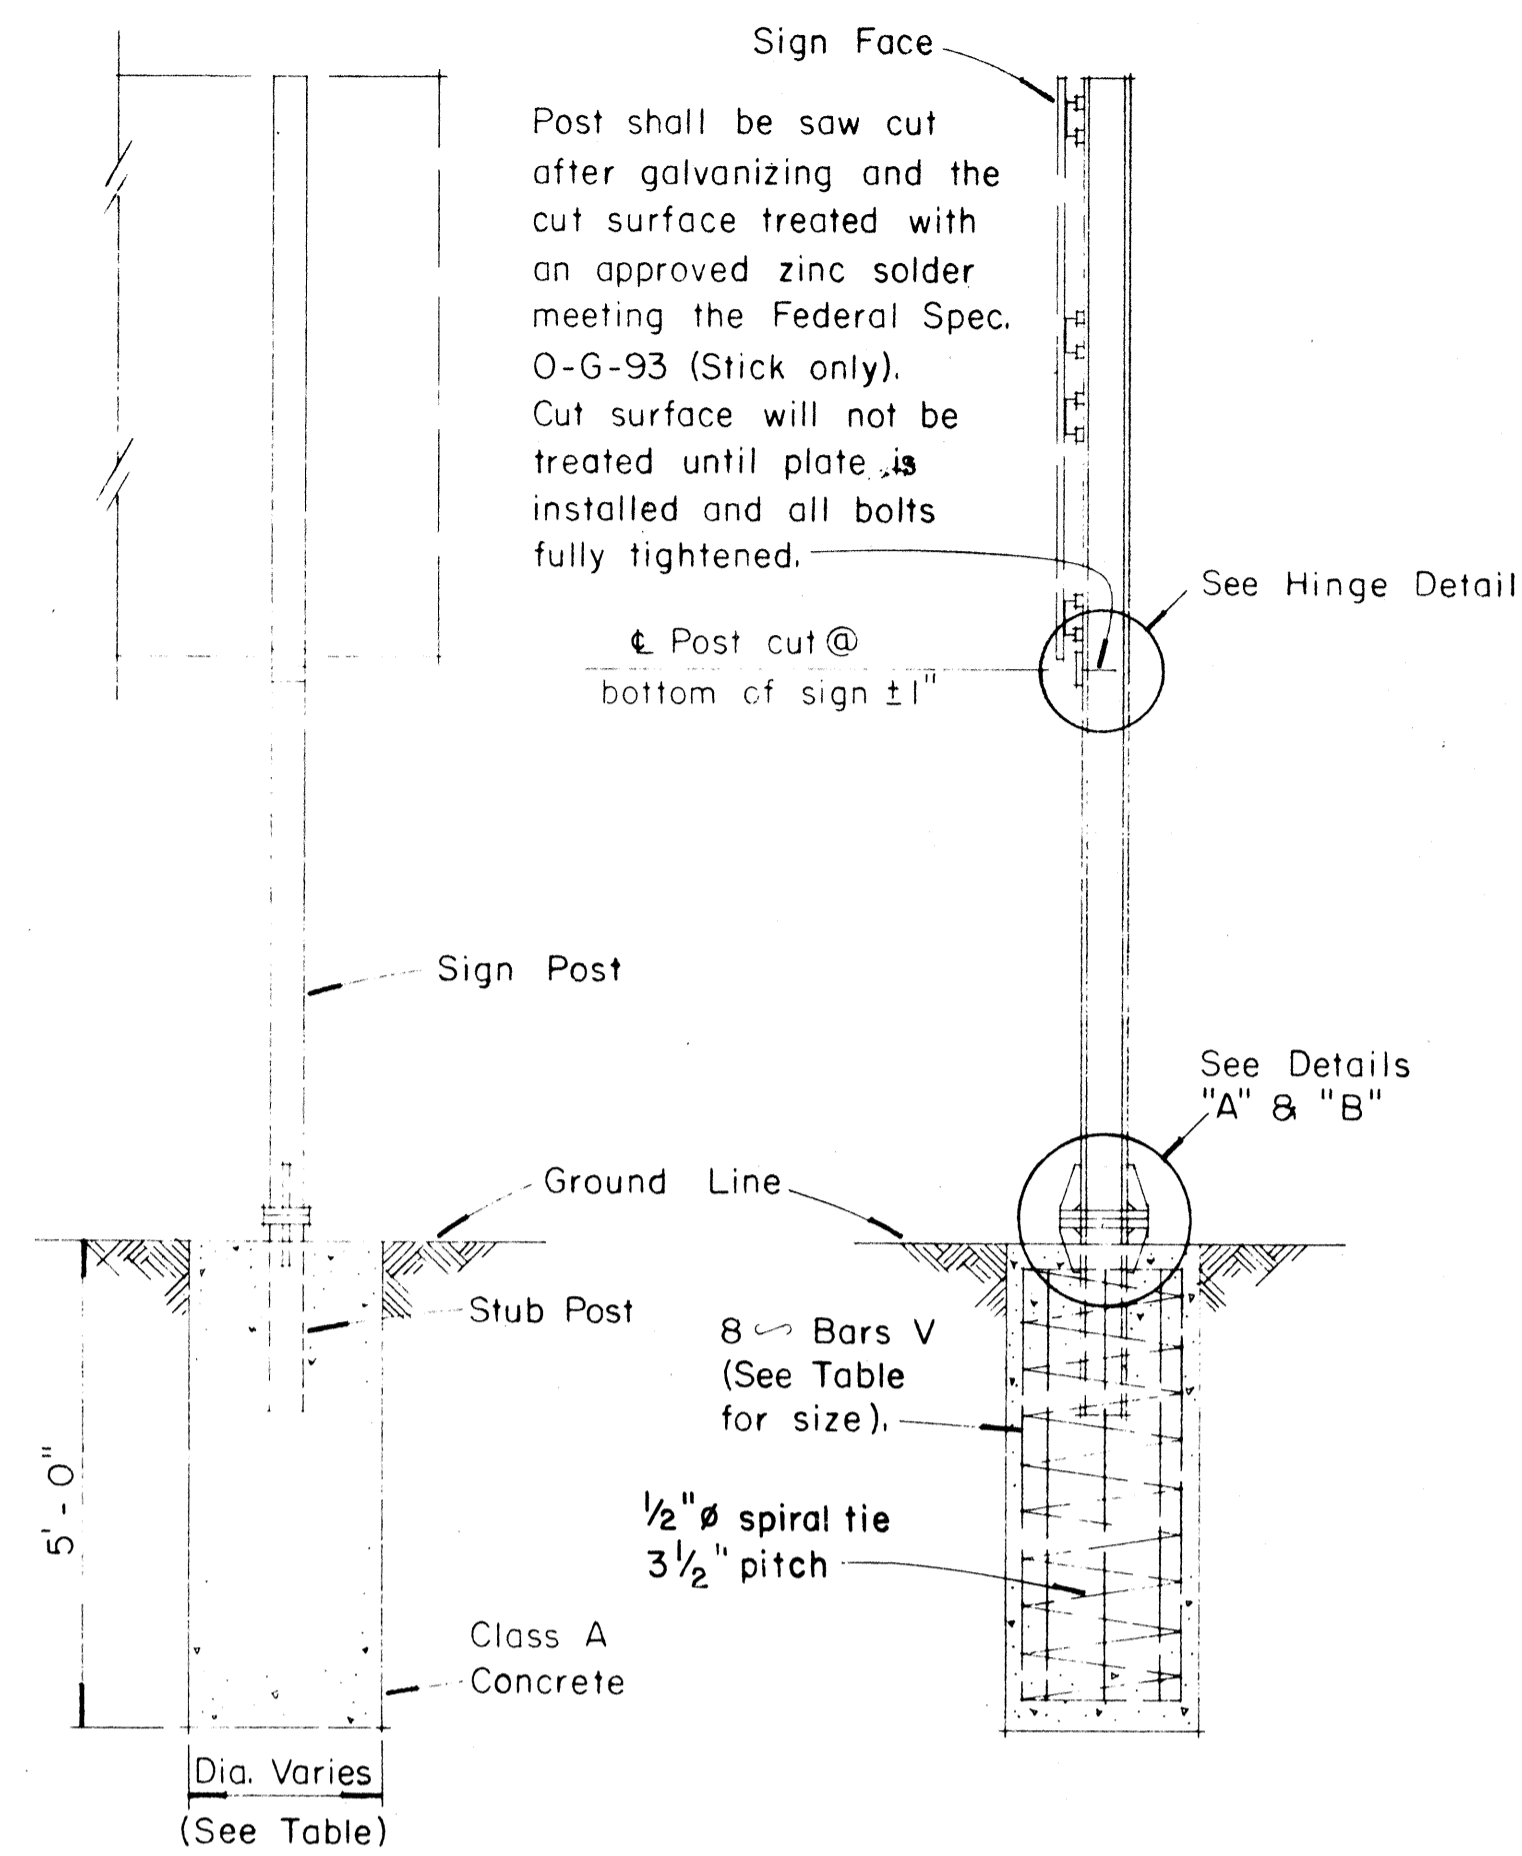

NOTE:  
Sections shown are for installations on right shoulder and in gore. Reverse plate slot bevels for installations on left shoulder.

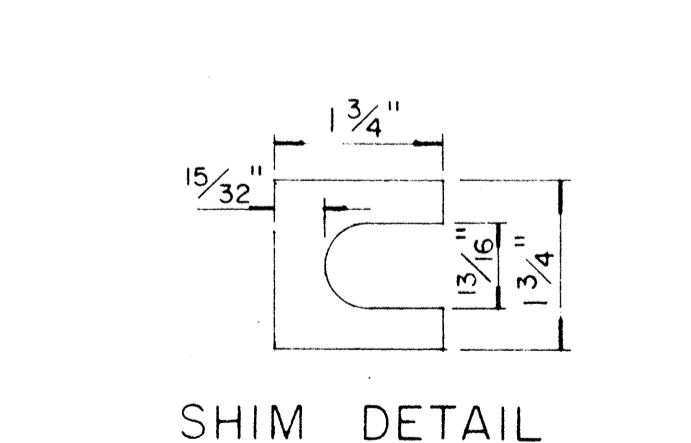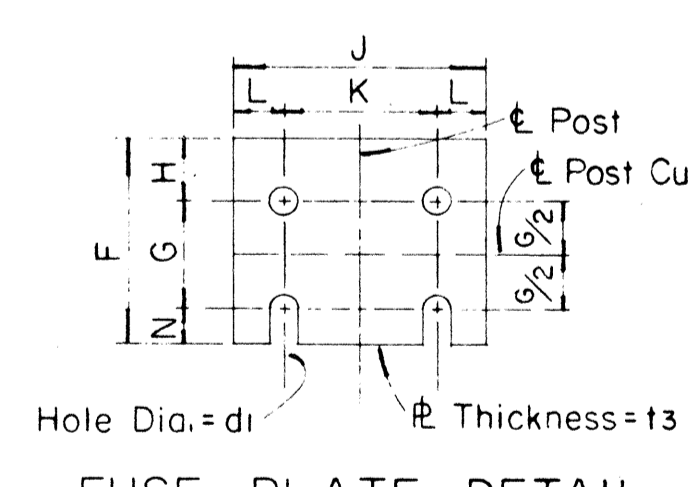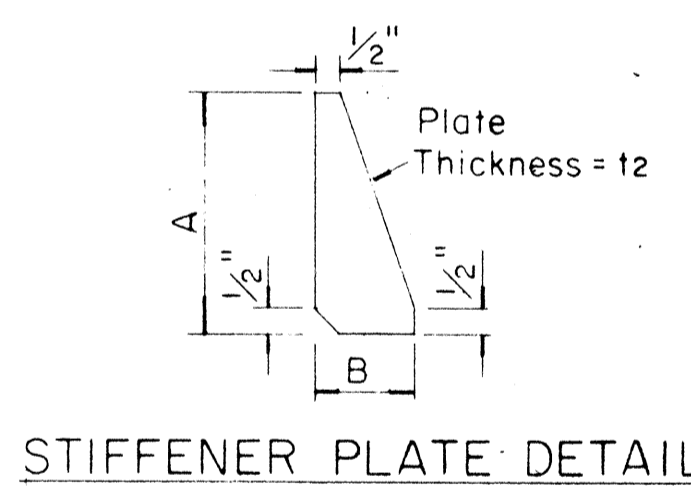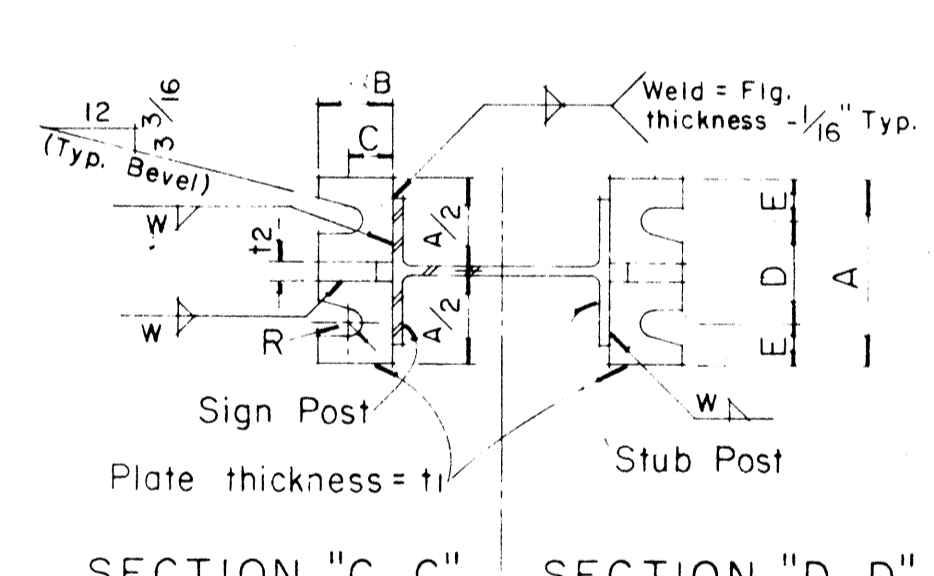

Furnish 2-0.012" ± thick and 2-0.032" ± thick shims per post. Shims shall be fabricated from brass shim stock or strip conforming to ASTM -B36.

GENERAL NOTES

- Design shall conform with AASHTO Specifications for the design and Construction of Structural Supports for Highway Signs, Luminaires and Traffic Signals.
- Materials and Fabrication shall conform to the requirements of the Standard Specifications and Special Provisions.
- All holes shall be drilled. All plate cuts shall preferably be saw cuts, however; flame cutting will be permitted provided all edges are ground. Metal projecting beyond the plane of the plate face will not be tolerated.
- Tighten the high strength bolts in the base connection only to the torque shown, do not overtighten. All bolts other than high strength bolts shall conform to ASTM A 307, Class A.
- All structural steel, bolts, nuts and washers shall be galvanized as per the Standard Specifications and Special Provisions. Structural steel to be galvanized after fabrication except as noted.
- Structural steel shall conform to the requirements of ASTM A 441.
- Galvanize all of the post projecting above the concrete plus 6 inches minimum.
- All friction fuse bolts shall be tightened in the shop following a method approved by the Engineer. Tightening shall be to such a degree as to obtain the following minimum residual tension in each bolt:
 

Bolt Size	Min. Tension	Bolt Size	Min. Tension
1/2" φ	12050 Lbs.	3/4" φ	28400 Lbs.
5/8" φ	19200 Lbs.	7/8" φ	36050 Lbs.
- Supplemental Sign shall not be installed below the Breakaway Hinges.

APPROVAL RECOMMENDED:  
*Erich Tanaka*  
TRAFFIC ENGINEER  
DATE: 12/29/69

APPROVED:  
*John J. [Signature]*  
ASSISTANT CHIEF, ENGINEERING  
DATE: 12-30-69


NO.	REVISION	APPROVED BY	DATE
1	Added General Note No. 9	H.T.	6/3/80
2	Revised description of Post Size and Foundation Detail.	J.T.M.C.	10/21/85

STATE OF HAWAII  
DEPARTMENT OF TRANSPORTATION  
HIGHWAYS DIVISION


**STANDARD DETAILS**  
**BREAK-AWAY SIGN SUPPORTS**  
**FOR**  
**GROUND MOUNTED GUIDE SIGNS**

Not to Scale

SURVEY PLOTTED BY: \_\_\_\_\_  
 DRAWN BY: \_\_\_\_\_  
 CHECKED BY: \_\_\_\_\_  
 QUANTITIES BY: \_\_\_\_\_  
 NO. \_\_\_\_\_

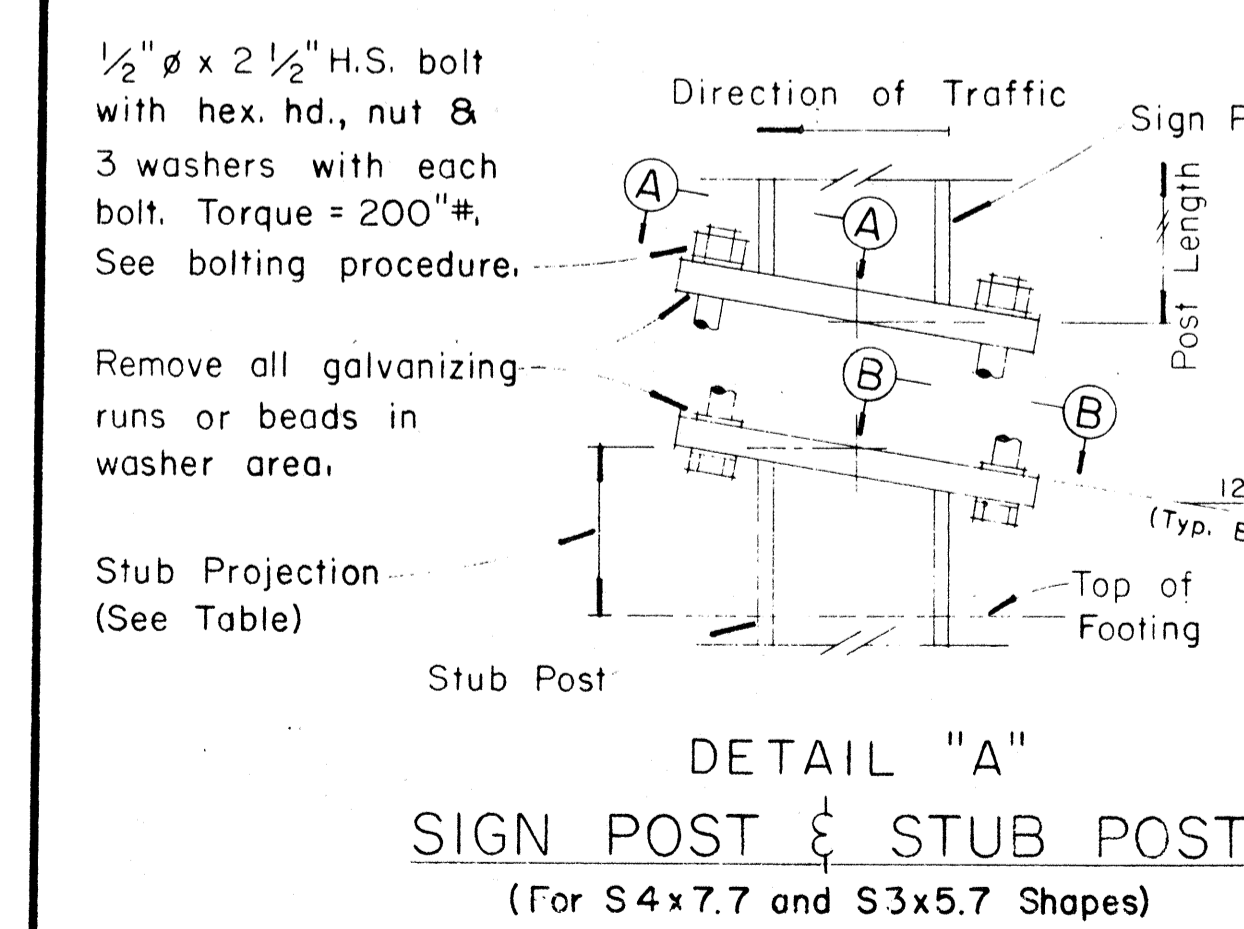

PROCEDURE FOR ASSEMBLY OF BASE CONNECTION:  
 1. Assemble post to stub with bolts and with one flat washer on each bolt between plates.  
 2. Shim as required to plumb post.  
 3. Tighten all bolts the max. possible with 12" to 15" wrench to bed washers & shims and to clean bolt threads then loosen each bolt in turn & retighten bolts in systematic order to prescribed torque. (See Table)  
 4. Burr threads at junction with nut using a center punch to prevent nut loosening.

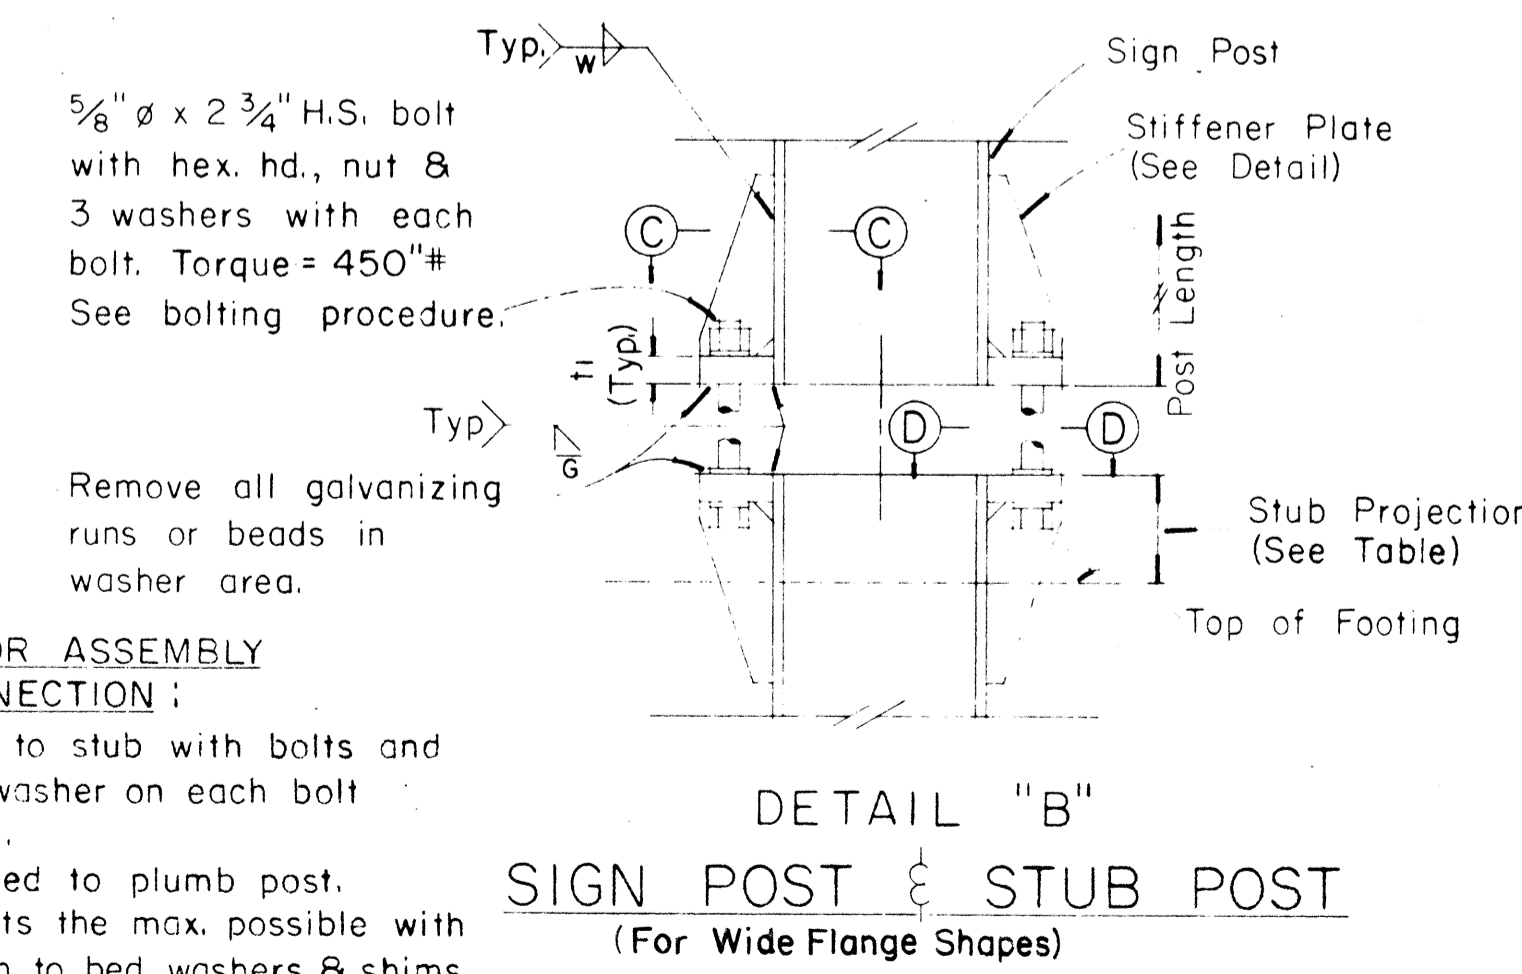


(For Wide Flange Shapes)

FED. ROAD DIST. NO.	STATE	FED. AID PROJ. NO.	FISCAL YEAR	SHEET NO.	TOTAL SHEETS
HAWAII	HAW.	IR-HI-1(189)	1986	95	99


(GROUND MOUNTED SIGNS)  
SUPPORT SPACING TABLE

PANEL THICK.	LENGTH OF SIGN		OVERHANG		SUPPORT SPACING
	A	NO. OF SUPPORTS	B	C	
1"	6'-0"	2	12"	48"	
1"	6'-6"	2	15"	48"	
1"	7'-0"	2	15"	54"	
1"	7'-6"	2	18"	54"	
1"	8'-0"	2	18"	60"	
1"	8'-6"	2	20"	62"	
1"	9'-0"	2	22"	64"	
1"	9'-6"	2	23"	68"	
1"	10'-0"	2	24"	72"	
1"	10'-6"	2	24"	78"	
1"	11'-0"	2	24"	84"	
1"	11'-6"	2	27"	84"	
1"	12'-0"	2	30"	84"	
1"	12'-6"	2	30"	90"	
1"	13'-0"	2	30"	96"	
1"	13'-6"	2	30"	102"	
1"	14'-0"	2	30"	108"	
1"	14'-6"	2	36"	102"	
1"	15'-0"	2	36"	108"	
2.5"	15'-6"	2	36"	114"	
2.5"	16'-0"	2	39"	114"	
2.5"	16'-6"	2	39"	120"	
2.5"	17'-0"	2	39"	126"	
2.5"	17'-6"	2	42"	126"	
2.5"	18'-0"	2	42"	132"	
2.5"	18'-6"	2	45"	132"	
2.5"	19'-0"	2	45"	138"	
2.5"	19'-6"	2	45"	144"	
2.5"	20'-0"	2	48"	144"	
2.5"	20'-6"	2	48"	150"	
2.5"	21'-0"	2	51"	150"	
2.5"	21'-6"	2	51"	156"	
2.5"	22'-0"	2	51"	162"	
2.5"	22'-6"	2	54"	162"	
2.5"	23'-0"	2	54"	168"	
2.5"	23'-6"	2	54"	174"	
2.5"	24'-0"	2	57"	174"	

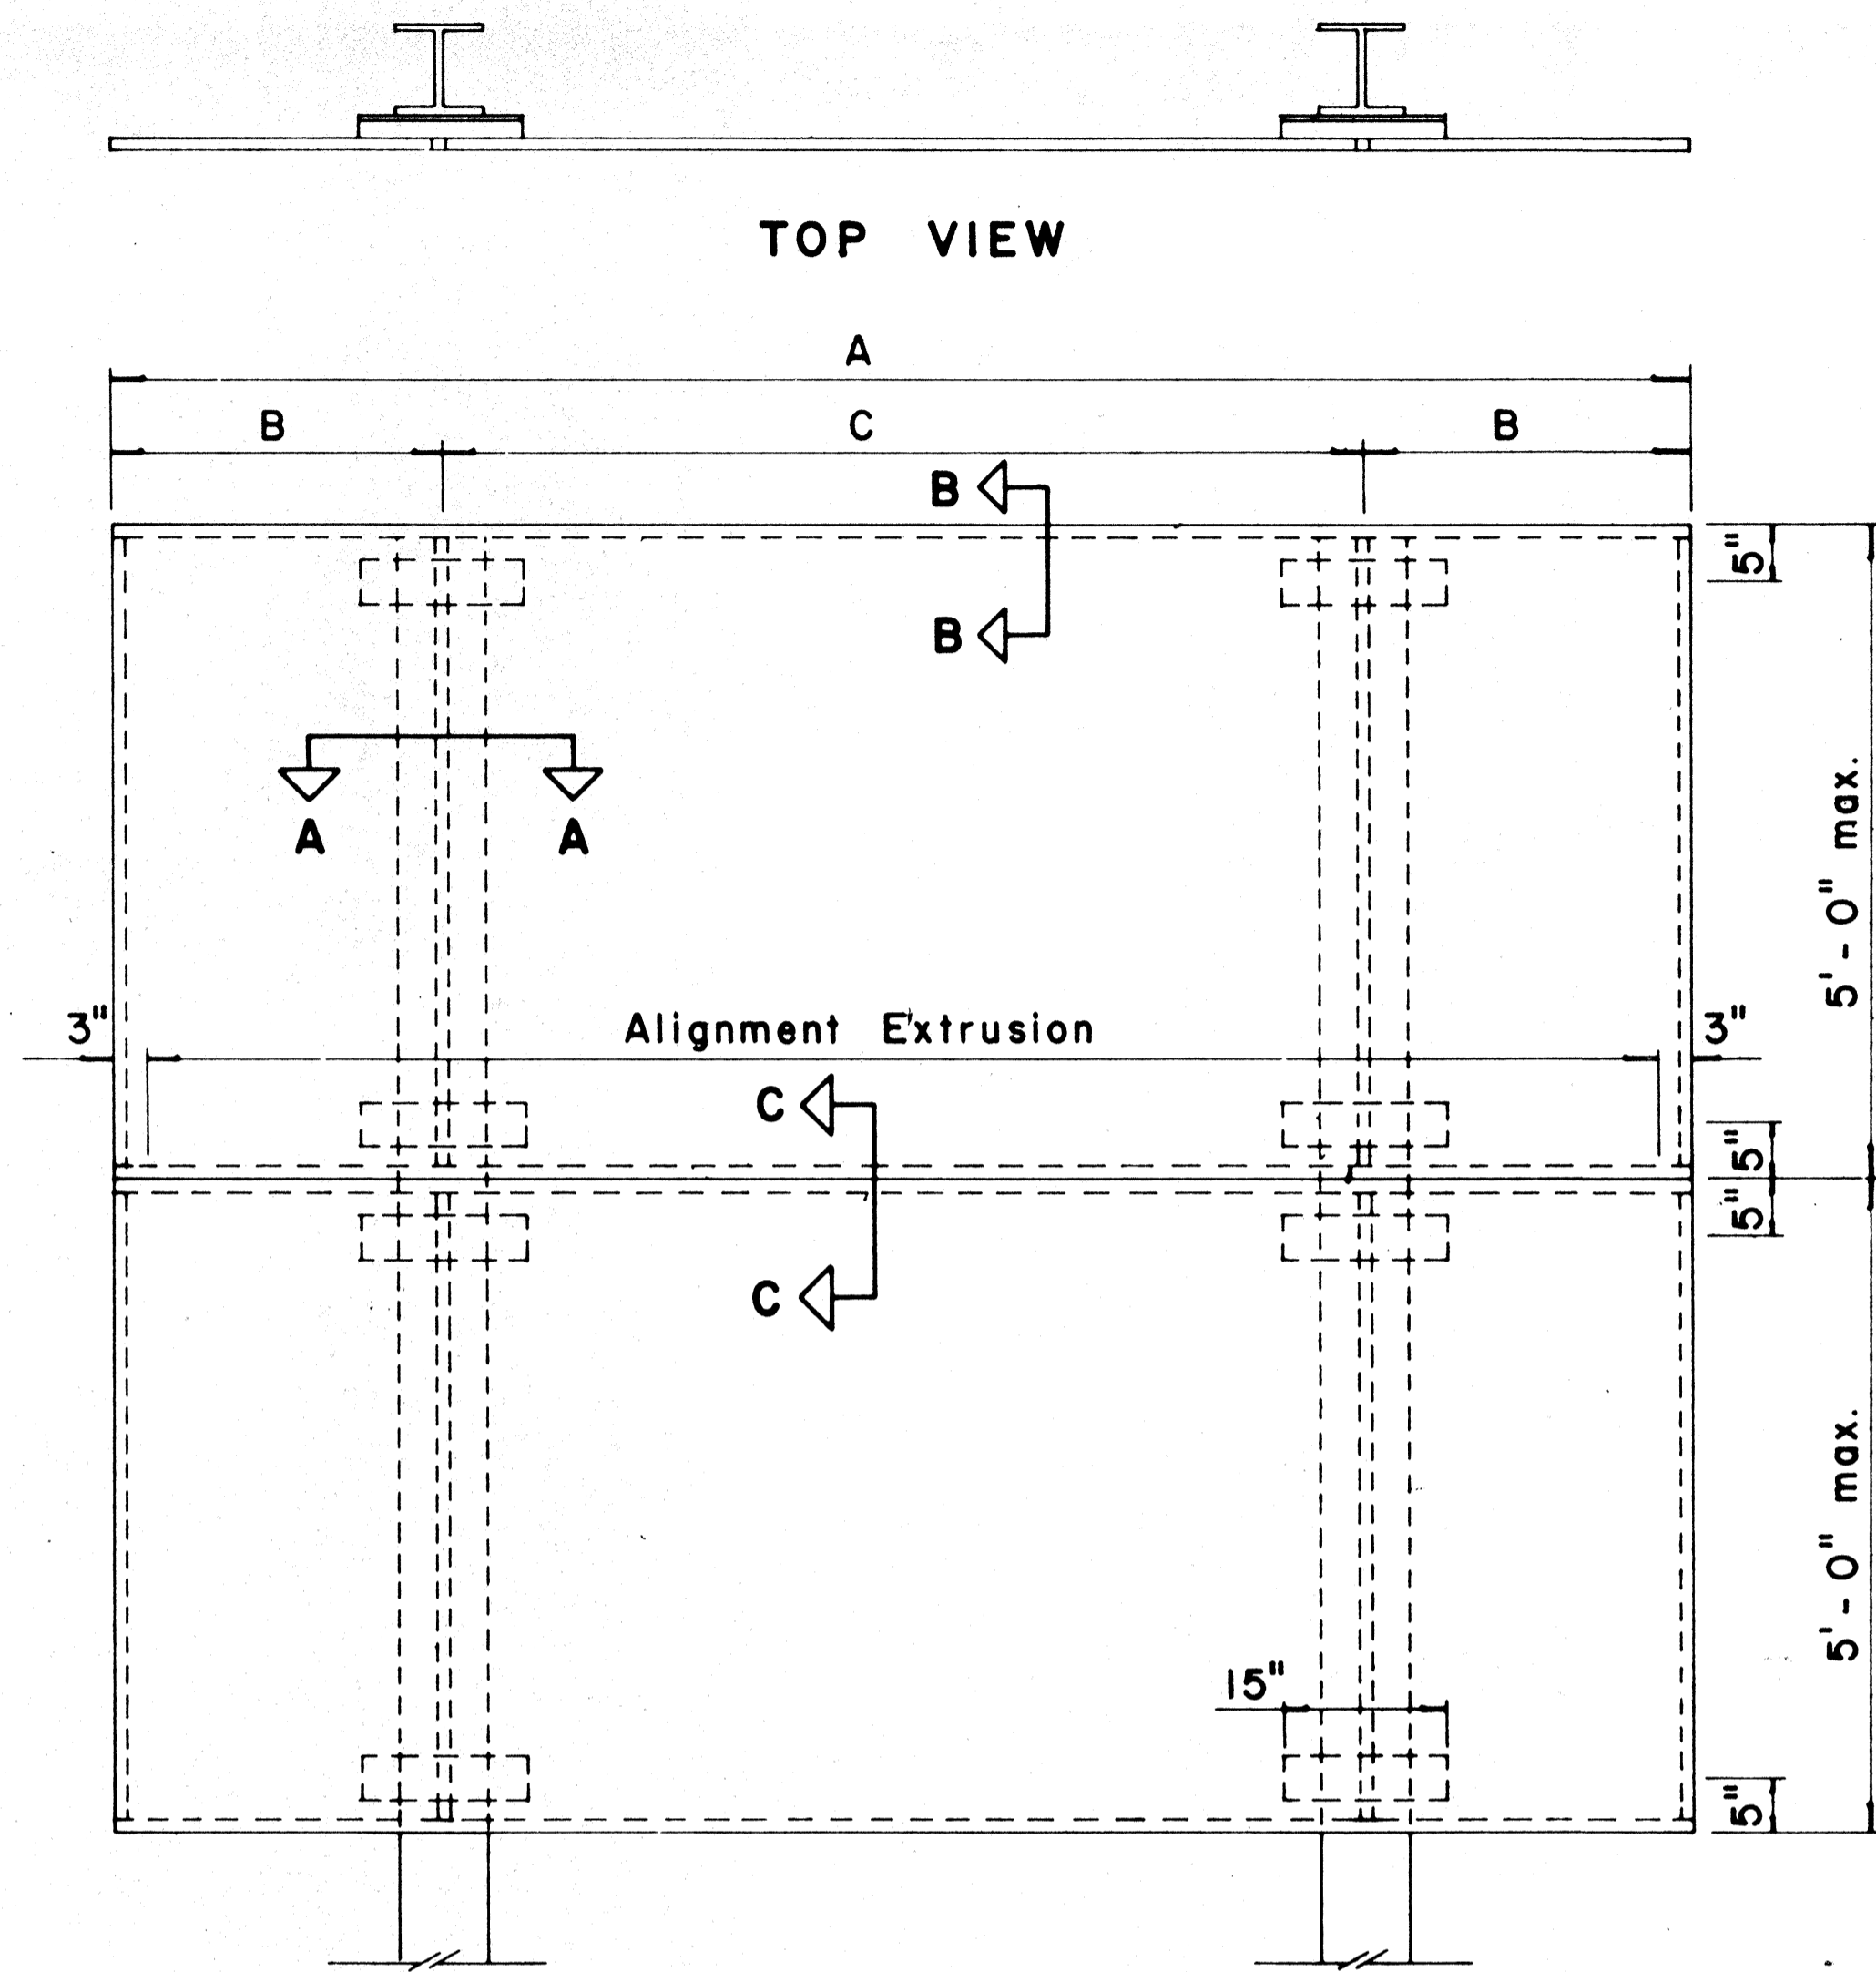


TYPICAL SIGN ASSEMBLY

Scale:  $\frac{3}{4}$ " = 1' - 0"

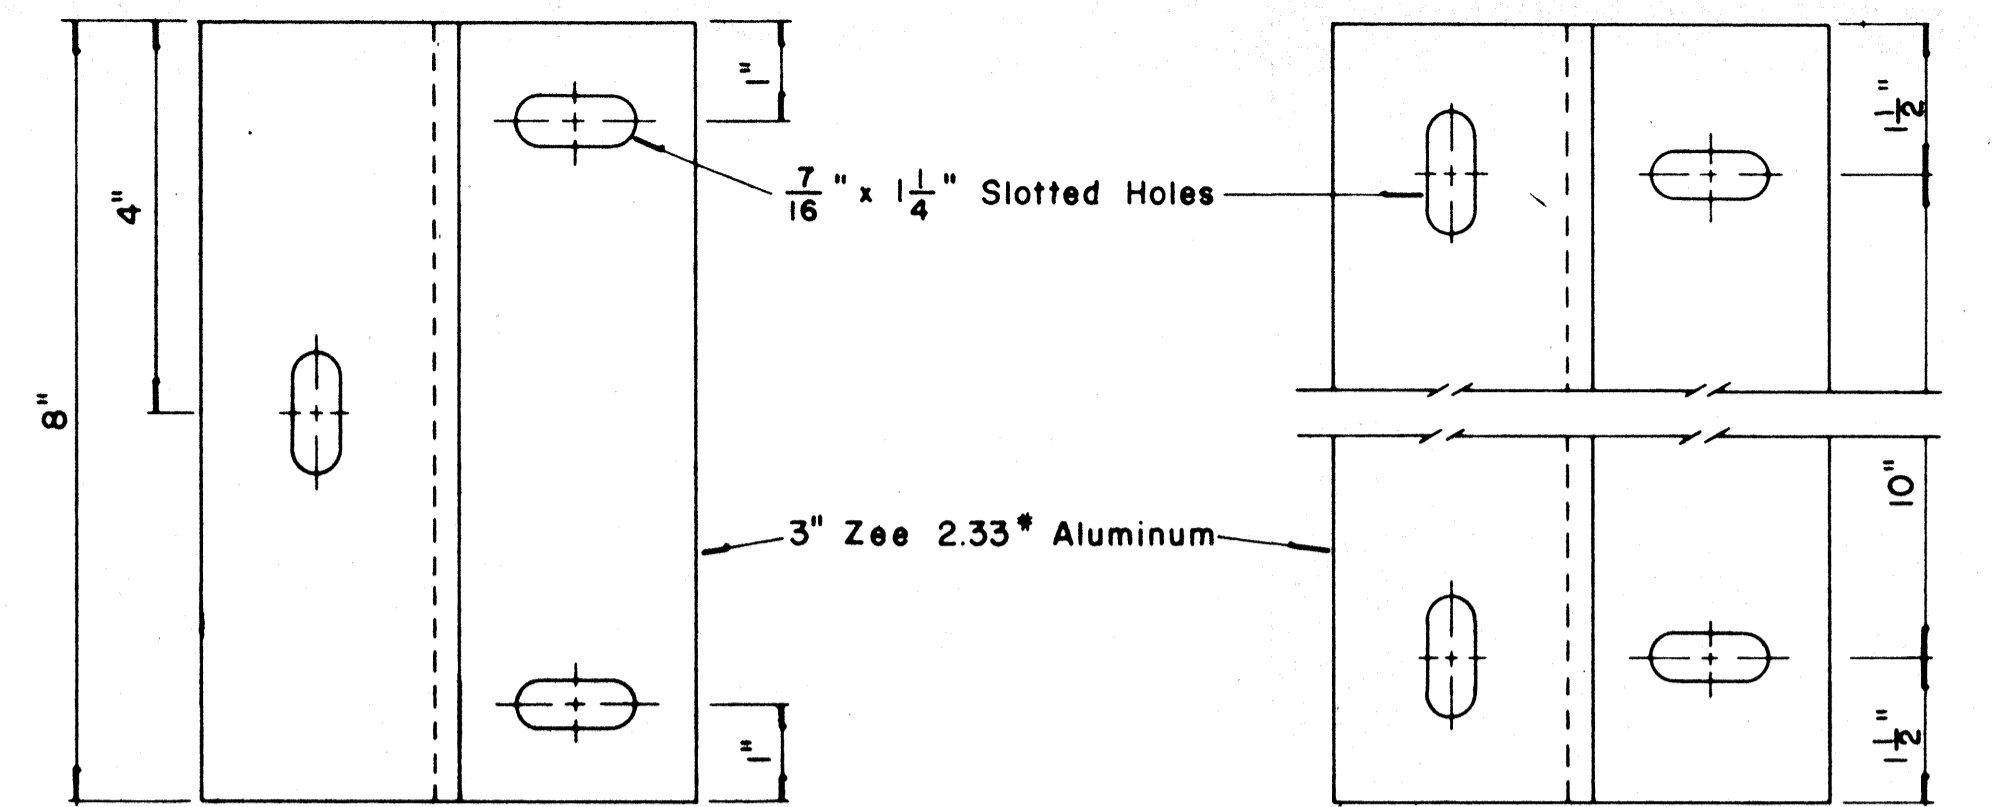


ZEE MOUNTING DETAILS

Scale:  $\frac{1}{2}$ " = 1"

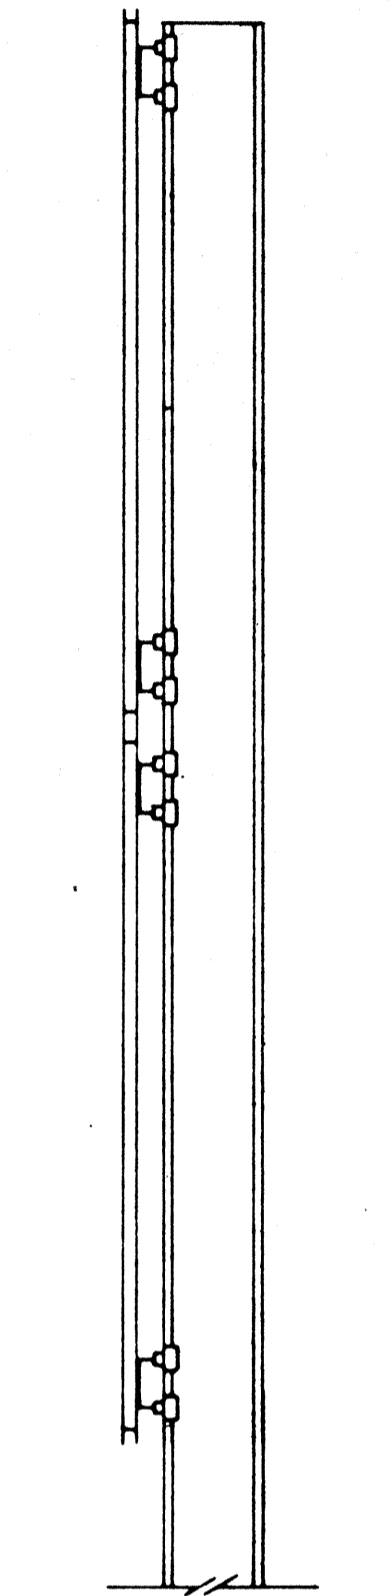


SIDE VIEW

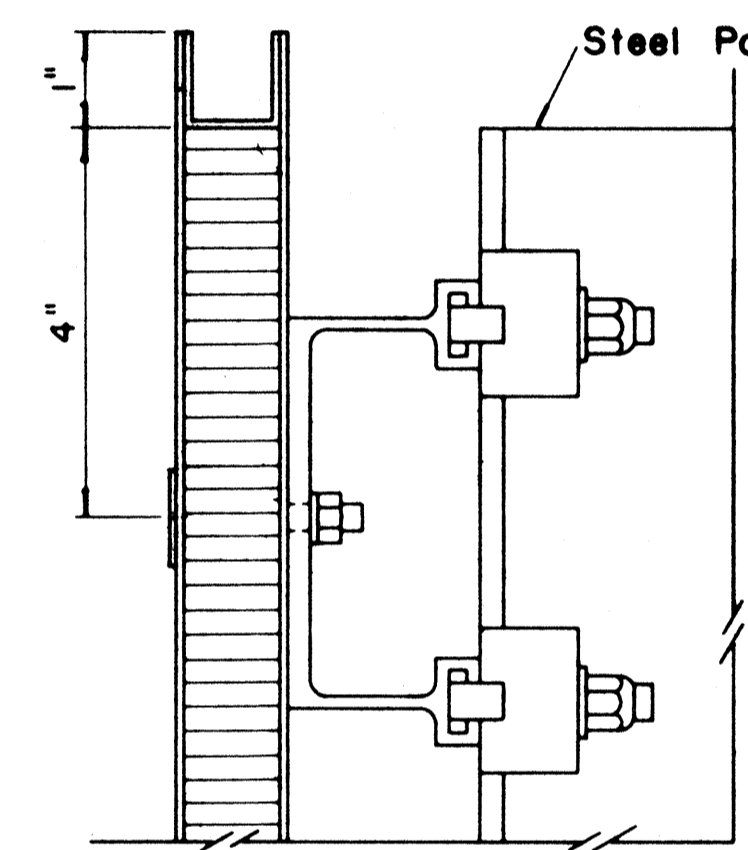


SECTION "B-B"

Scale:  $\frac{1}{2}$ " = 1"

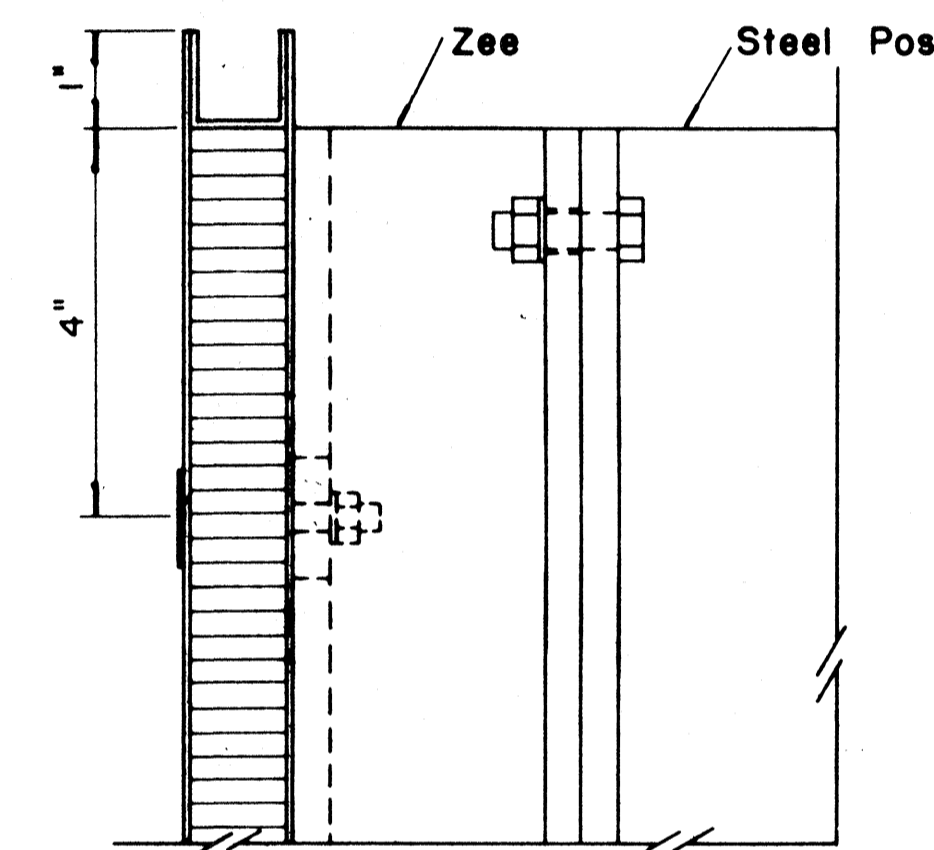


SECTION "B-B" (Alternate)

Scale:  $\frac{1}{2}$ " = 1"

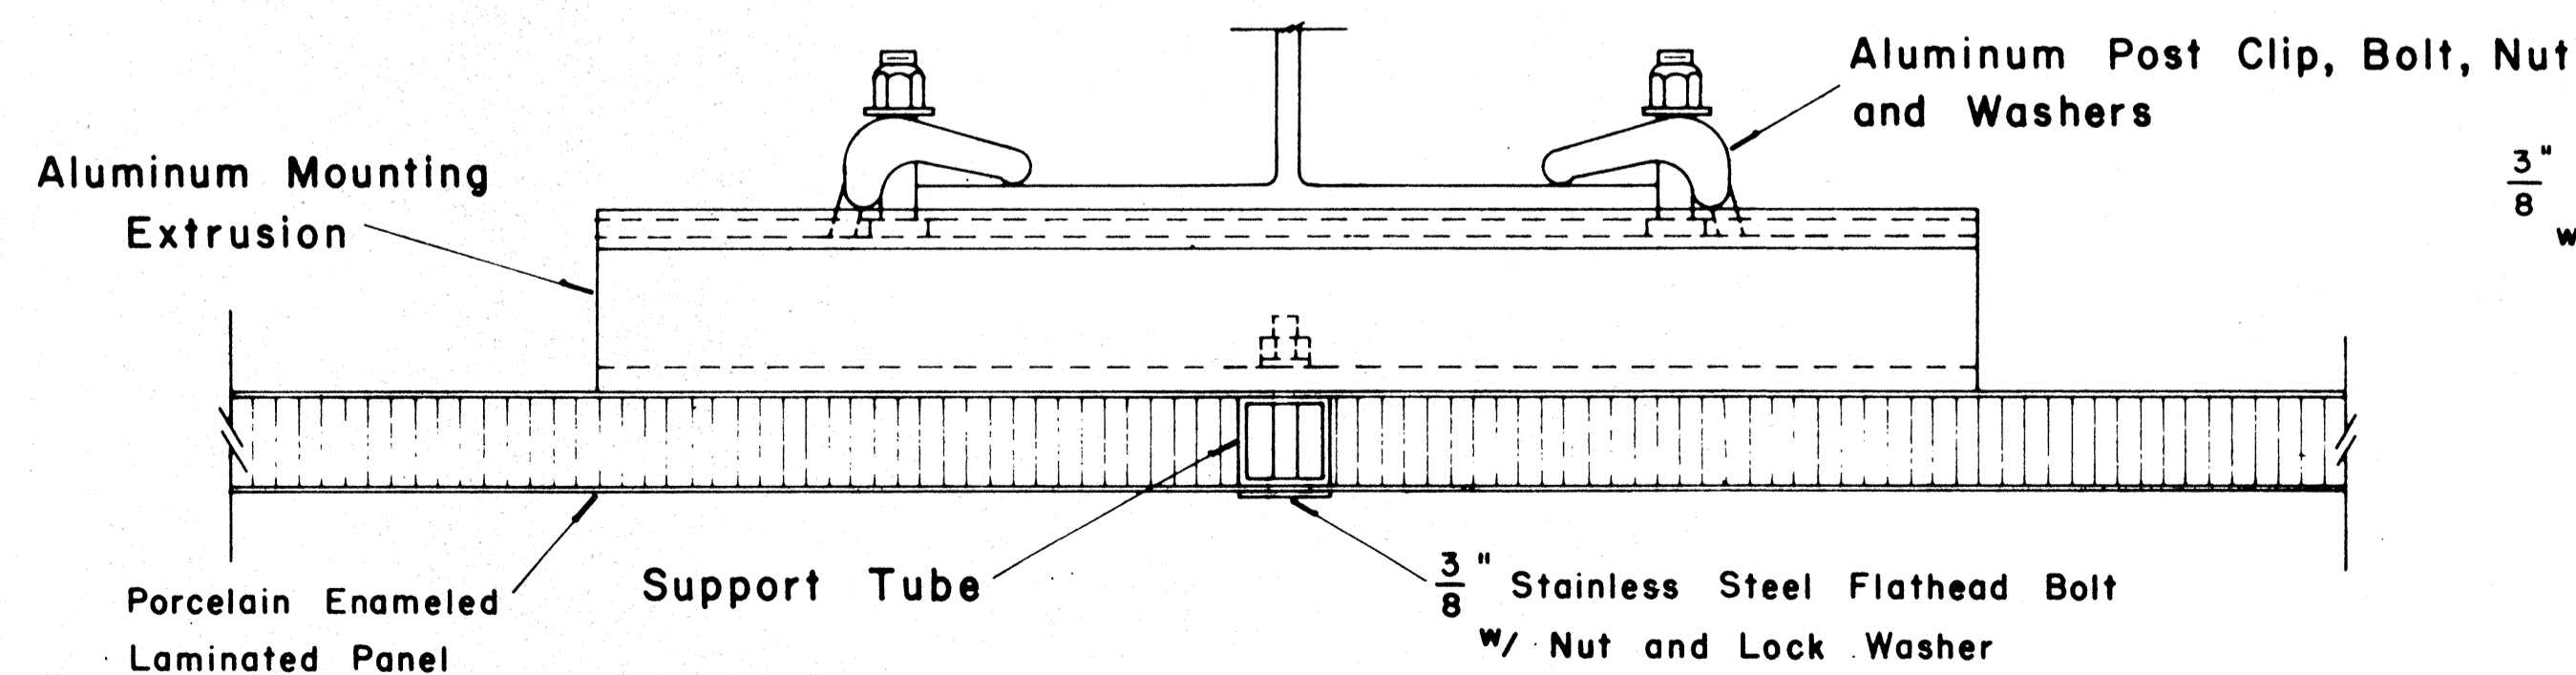

SECTION "A-A"

Scale:  $\frac{1}{2}$ " = 1"

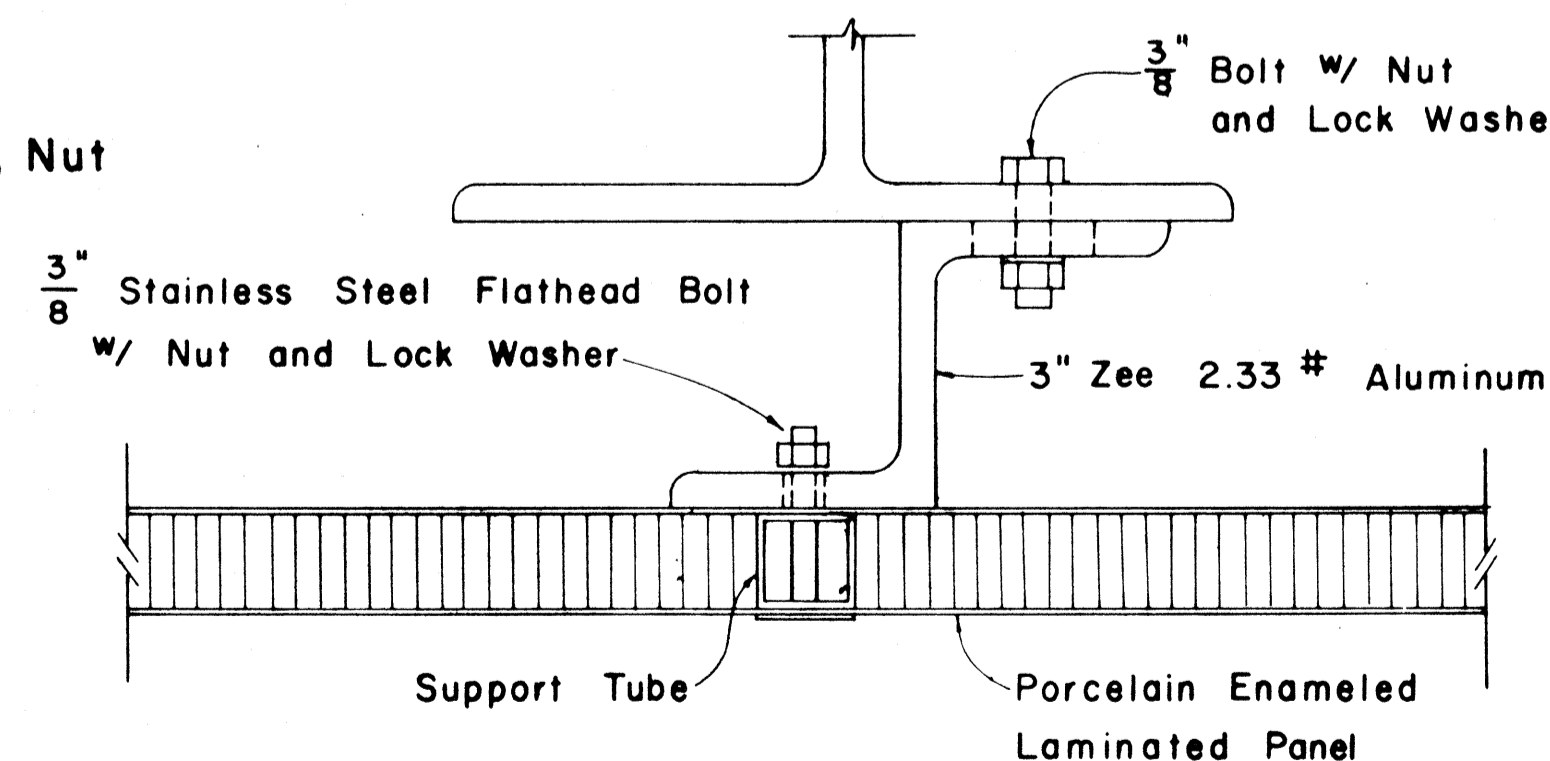

SECTION "A-A" (Alternate)

Scale:  $\frac{1}{2}$ " = 1"

APPROVAL RECOMMENDED:


*Eischi Tanaka*  
TRAFFIC ENGINEER

12/29/69  
DATE

APPROVED:

*John J. Smith*  
ASSISTANT CHIEF, ENGINEER

12-30-69  
DATE

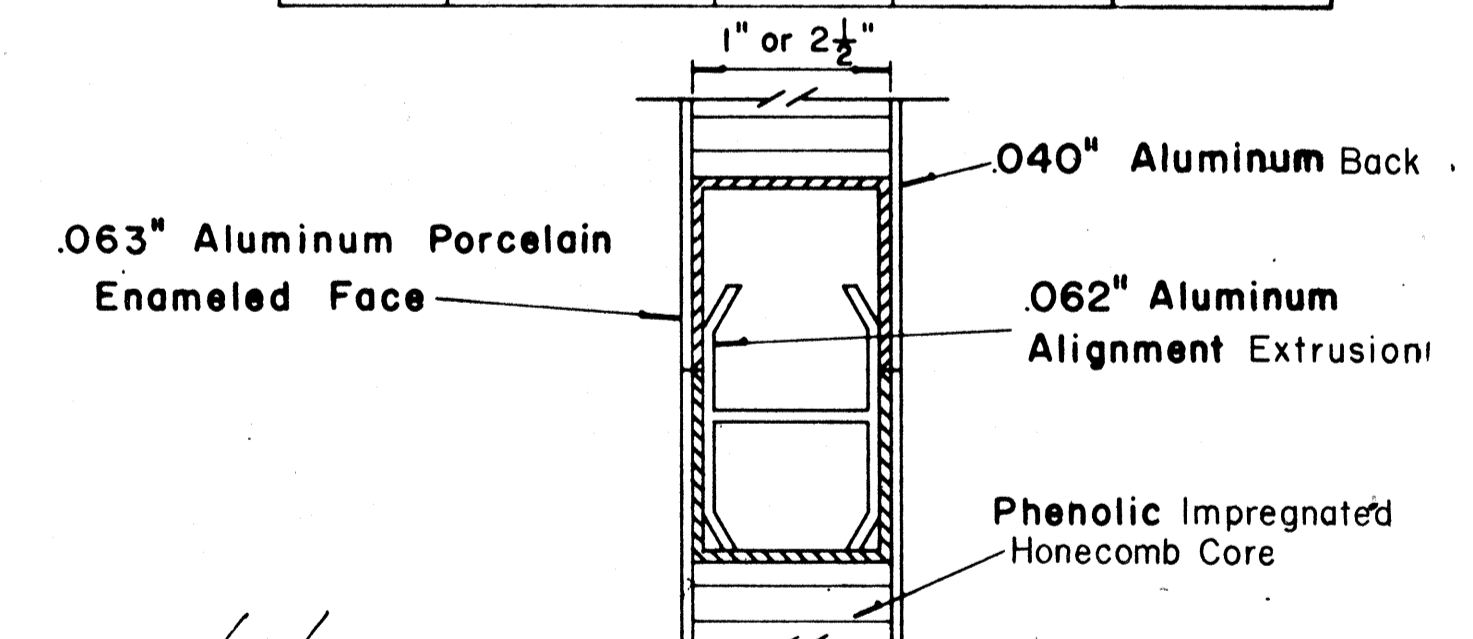

CLOSURE DETAIL SECTION "C-C"

FULL SCALE

NO.	REVISION	APPROVED BY	DATE


STATE OF HAWAII  
DEPARTMENT OF TRANSPORTATION  
LAND TRANSPORTATION FACILITIES DIVISION  
**STANDARD DETAILS**  
LAMINATED ALUMINUM  
SIGN PANELS  
(GROUND MOUNTED)  
Scale: As Shown

SHEET No. OF SHEETS DT 206

DATE: \_\_\_\_\_  
SURVEY PLOTTED BY: \_\_\_\_\_  
ORIGINAL PLANS: \_\_\_\_\_  
DRAWN BY: \_\_\_\_\_  
NOTE BOOK: \_\_\_\_\_  
DESIGNED BY: \_\_\_\_\_  
CHECKED BY: \_\_\_\_\_  
No. \_\_\_\_\_

FED. ROAD DIST. NO.	STATE	FED. AID PROJ. NO.	FISCAL YEAR	SHEET NO.	TOTAL SHEETS
HAWAII	HAW.	IR-HH(180)	1986	96	99

MARKER SIZE	MULTIPLY DIMENSIONS BY	NUMERAL SIZE	
		2 Digit - Series D	3 Digit - Series C
21"	1.3	8"	
32"	2.0	12"	
42"	2.63	16"	

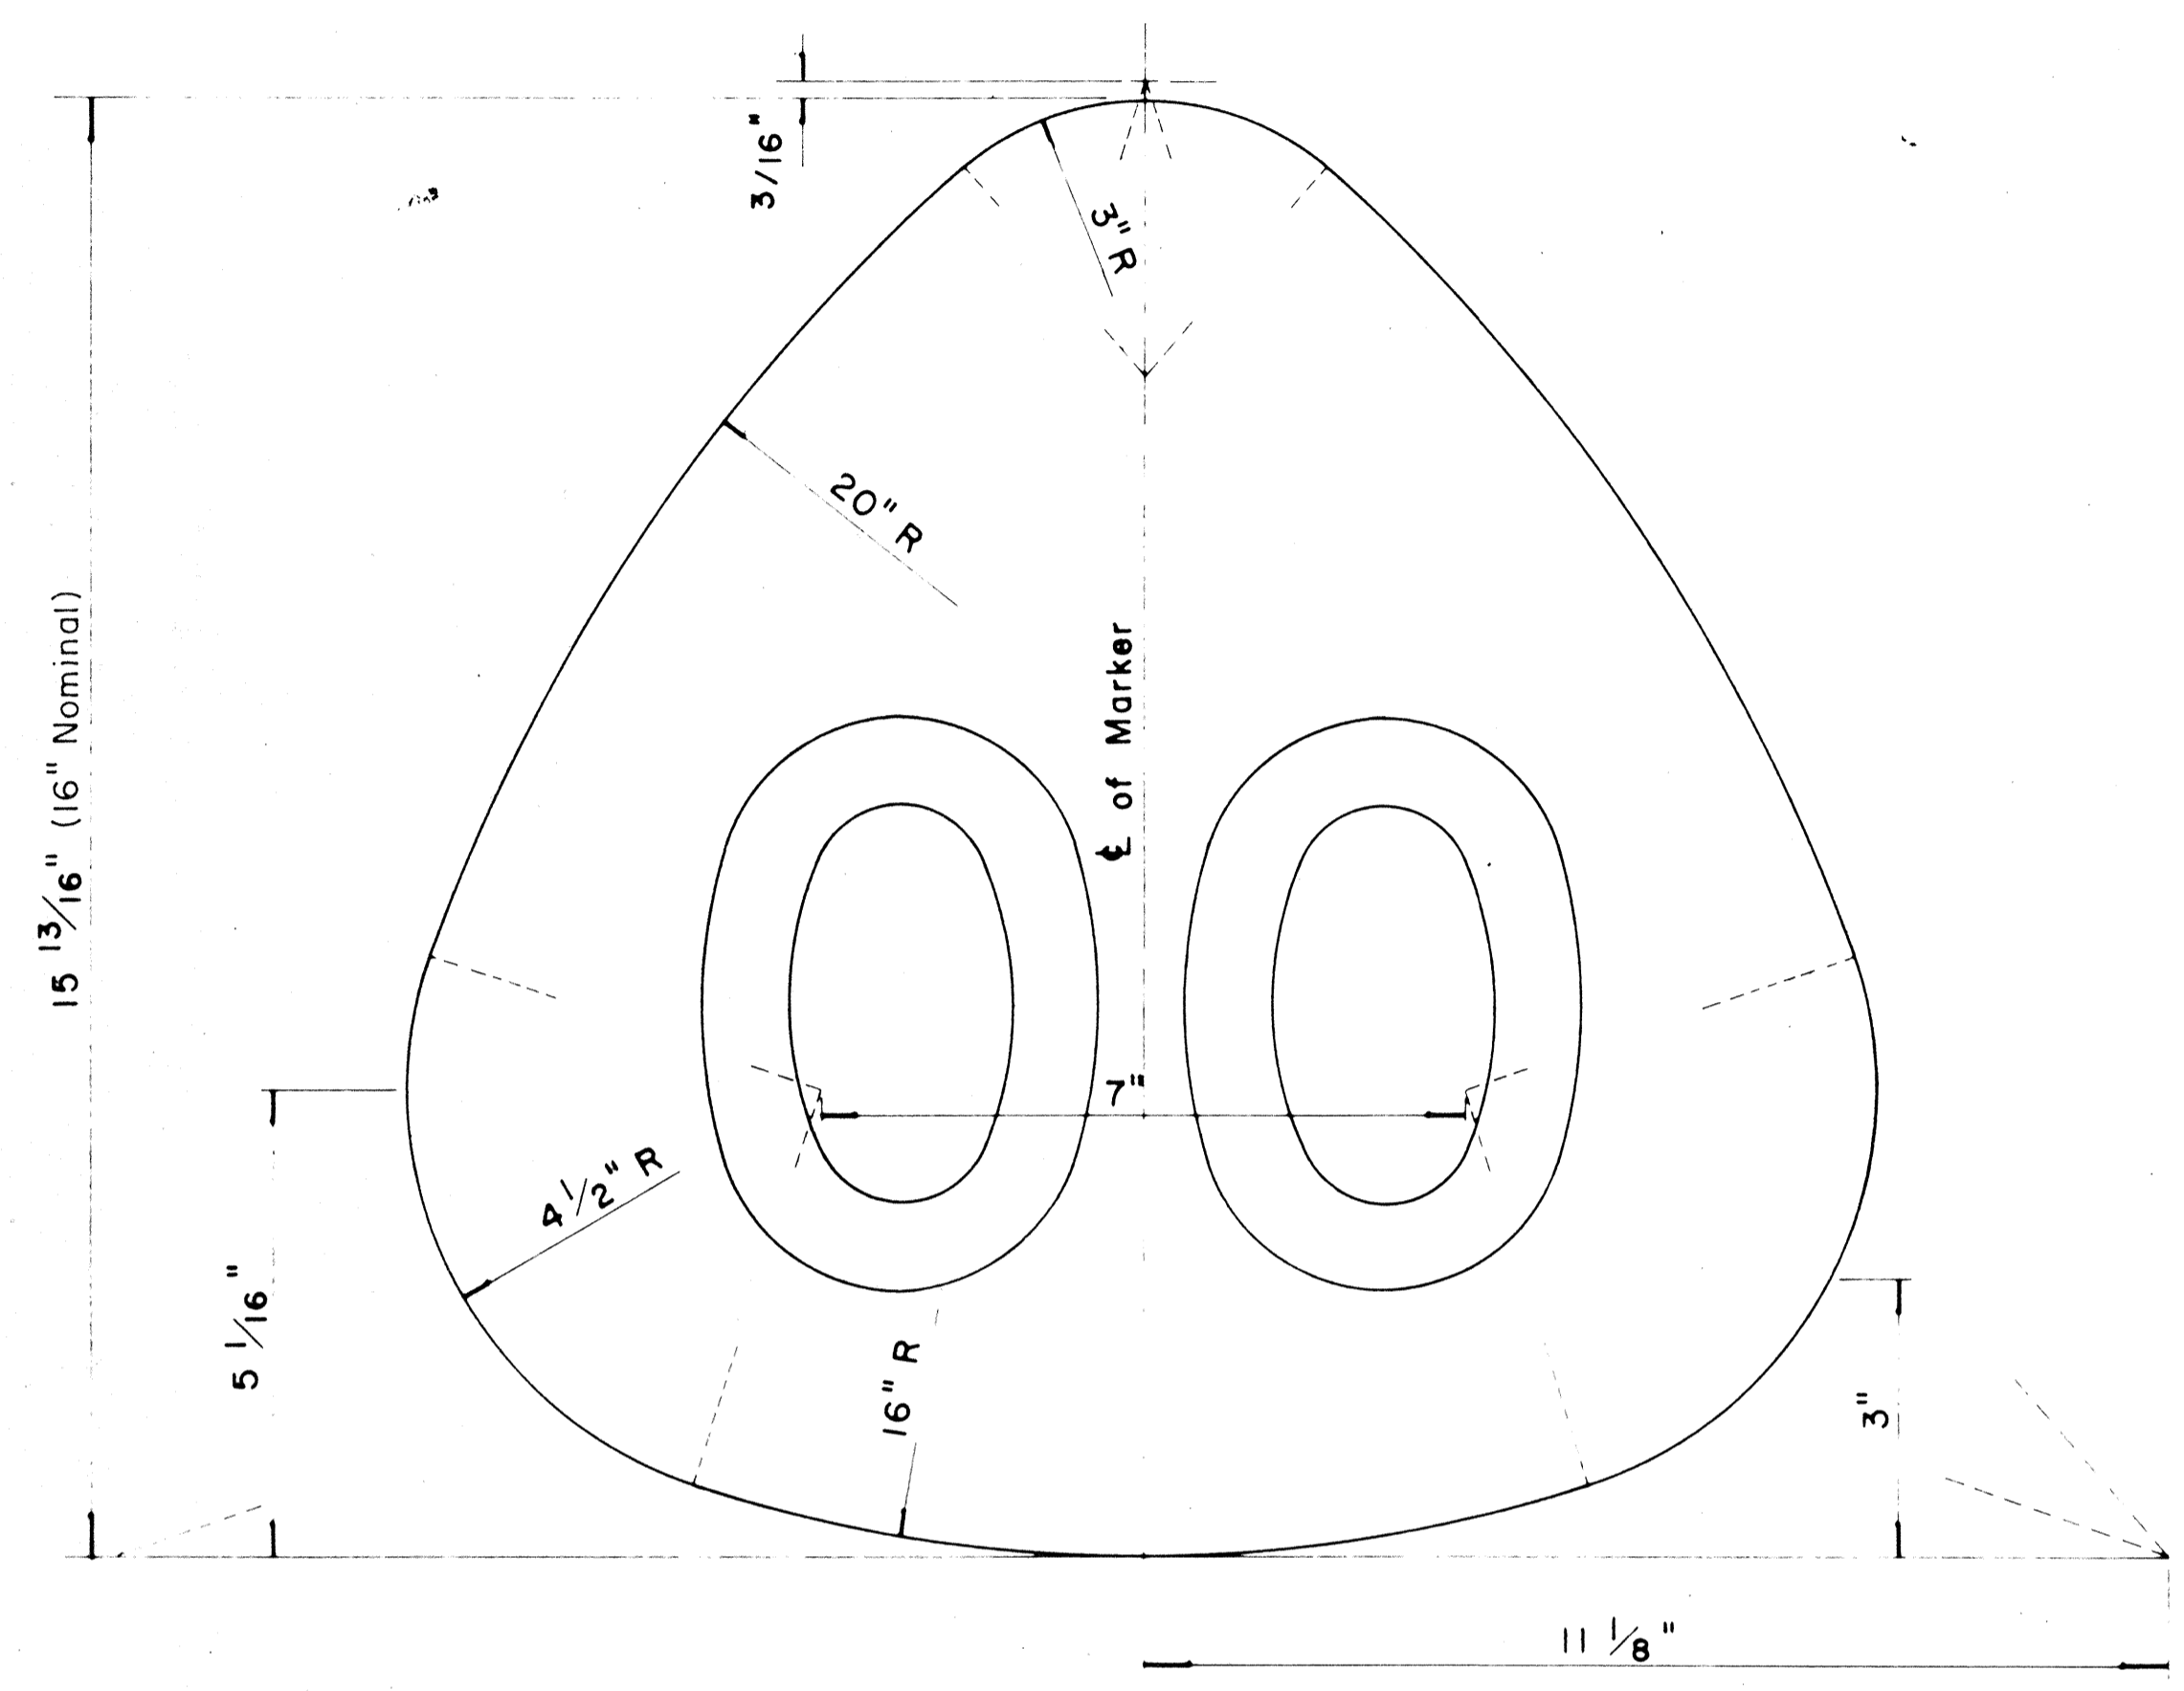


**STATE ROUTE MARKER  
FOR GUIDE SIGNS**

Scale: Half Size

**NOTE:**

1. State Route Markers on Guide signs shall have black numerals on a white reflectorized background mounted on a flat aluminum cut-out.
2. Numerals shall conform to the FHWA publication "Standard Alphabets for Highway Signs," 1966.
3. Cut-outs shall be fastened on sign panel with aluminum blind rivets. See Standard Specifications.

RADII FOR SIGNS		
Least Dimension of Sign	W	R
2' - 0" to 4' - 6"	2"	3"
4' - 9" to 5' - 6"	2"	6"
5' - 9" to 7' - 6"	2"	9"
7' - 9" and greater	2"	12"

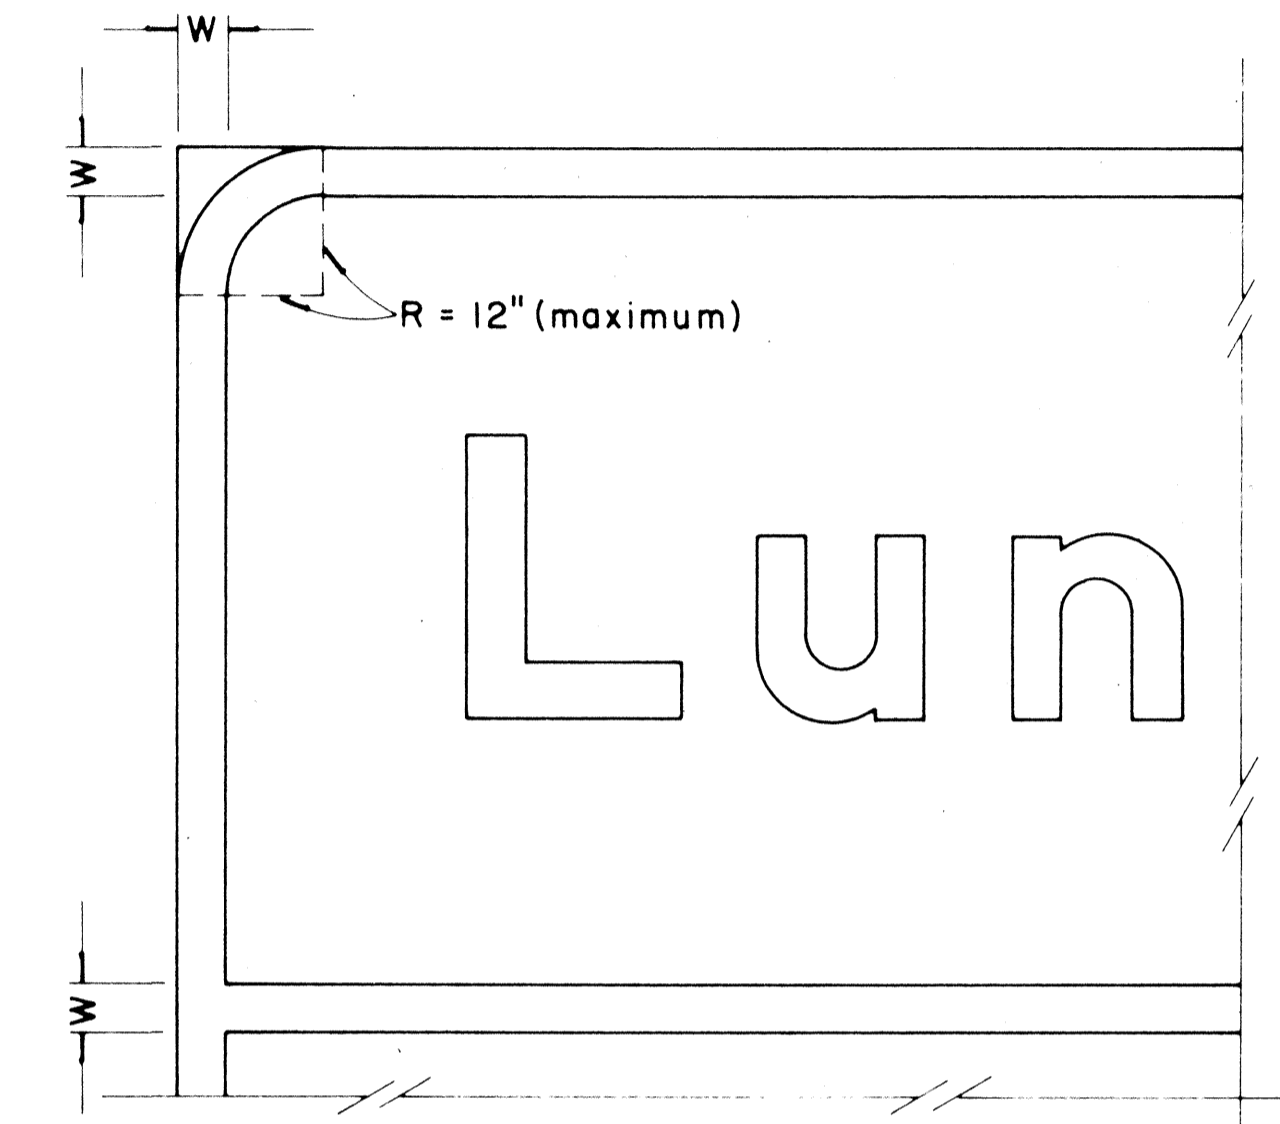

**BORDER DETAIL  
FOR GUIDE SIGNS**

Not to Scale

**NOTE:**

1. Area outside corner radius need not be trimmed.
2. All borders shall be white reflectorized cut-outs.
3. All Guide signs shall have borders.

APPROVAL RECOMMENDED:

*Euchi Tanaka* 4/11/72  
TRAFFIC ENGINEER DATE

APPROVED:

*Julius S. Sakai* 4/12/72  
ASSISTANT CHIEF, ENGINEERING DATE







NO	REVISION	APPROVED BY	DATE
1	Supersedes Sht. DT 209 Approved 12-30-69	H.C.	4/12/72
2	Revised Notes and Schedules	H.C.	9-14-76

STATE OF HAWAII  
DEPARTMENT OF TRANSPORTATION  
LAND TRANSPORTATION FACILITIES DIVISION  
**STANDARD DETAILS**  
**STATE ROUTE MARKER  
AND BORDER DETAIL  
FOR GUIDE SIGNS**

Scale: As Shown  
SHEET No. OF SHEETS DT 209

DATE	_____
DESIGNED BY	_____
CHECKED BY	_____
DRIVEN BY	_____
PLANNED BY	_____
ORIGINAL PLAN	_____
NOTE BOOK	_____
No.	_____

FED. ROAD DIST. NO.	STATE	FED. AID PROJ. NO.	FISCAL YEAR	SHEET NO.	TOTAL SHEETS
HAWAII	HAW.	IR-HI-1(189)	1986	97	99

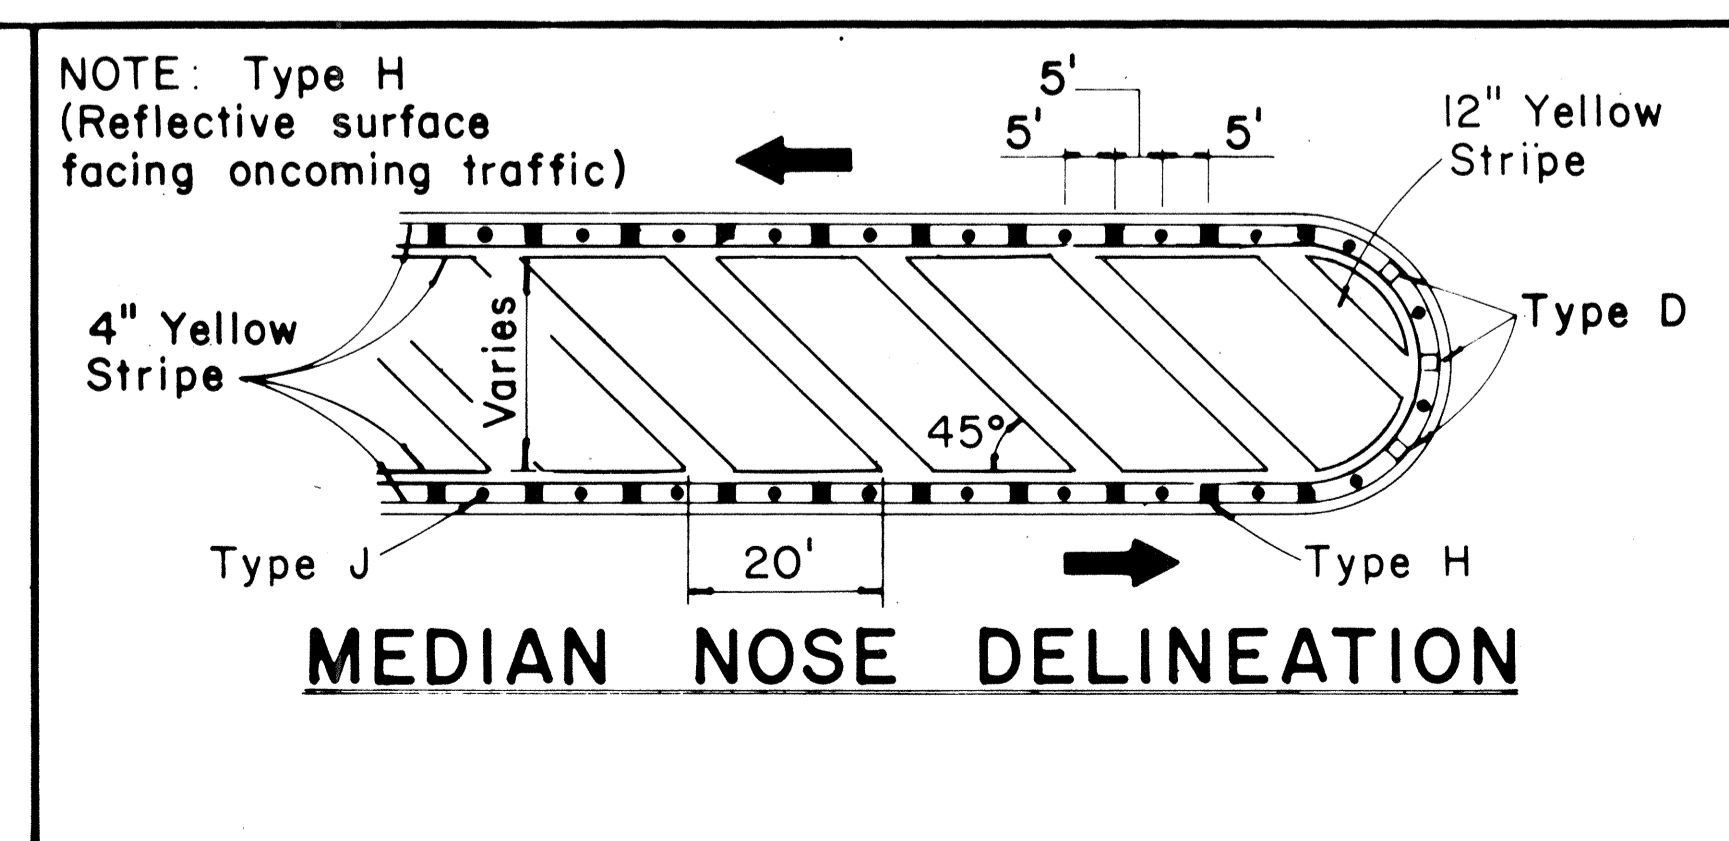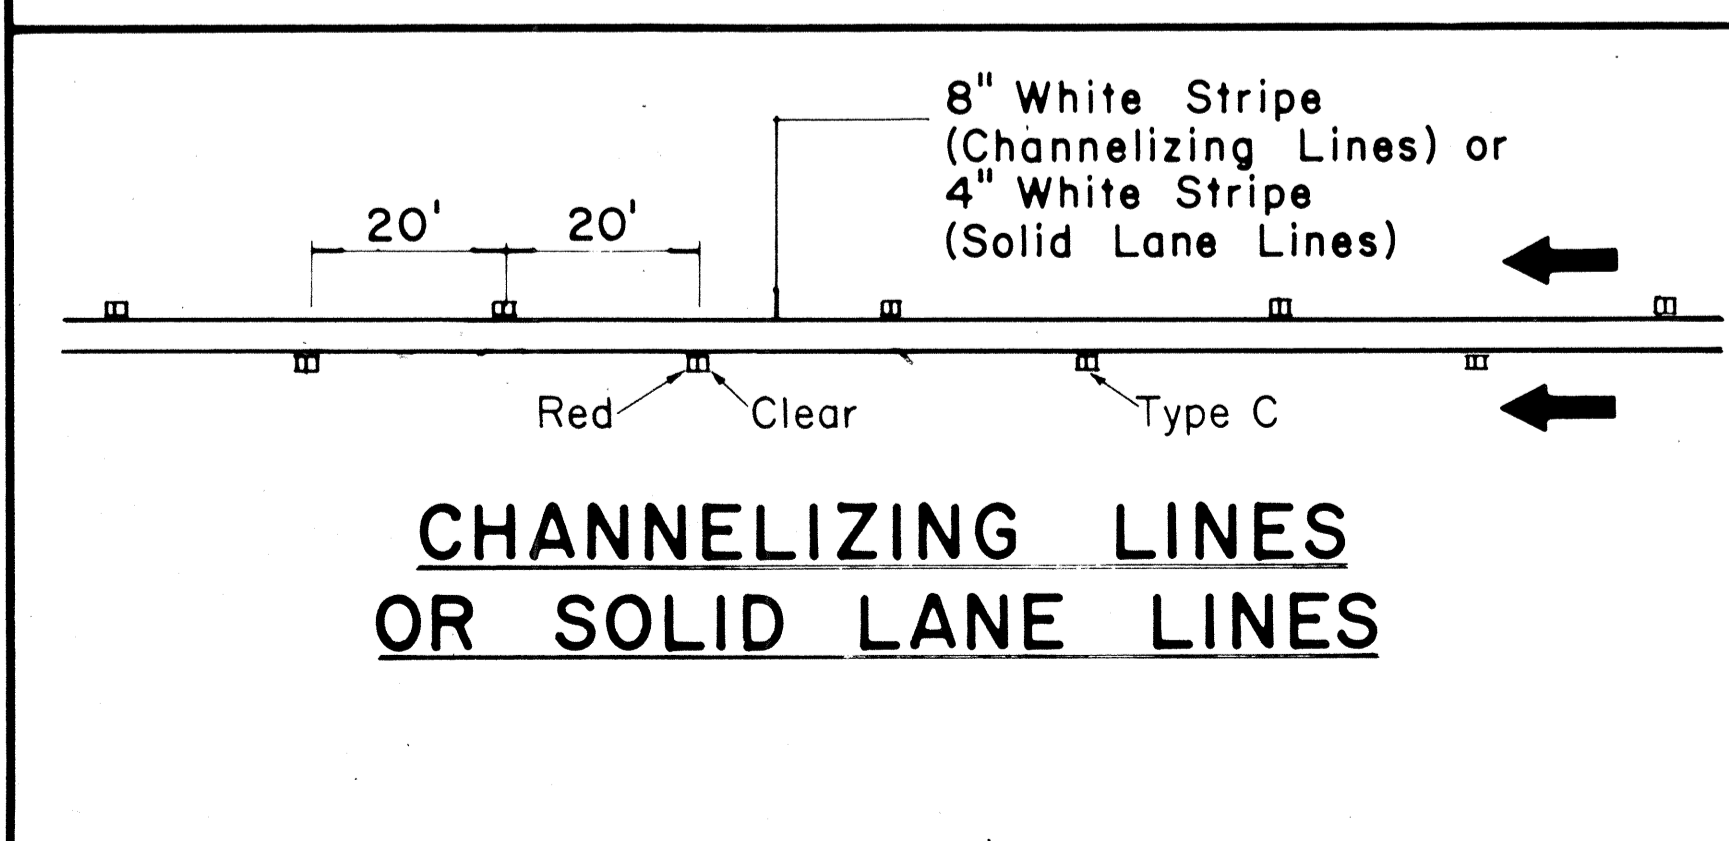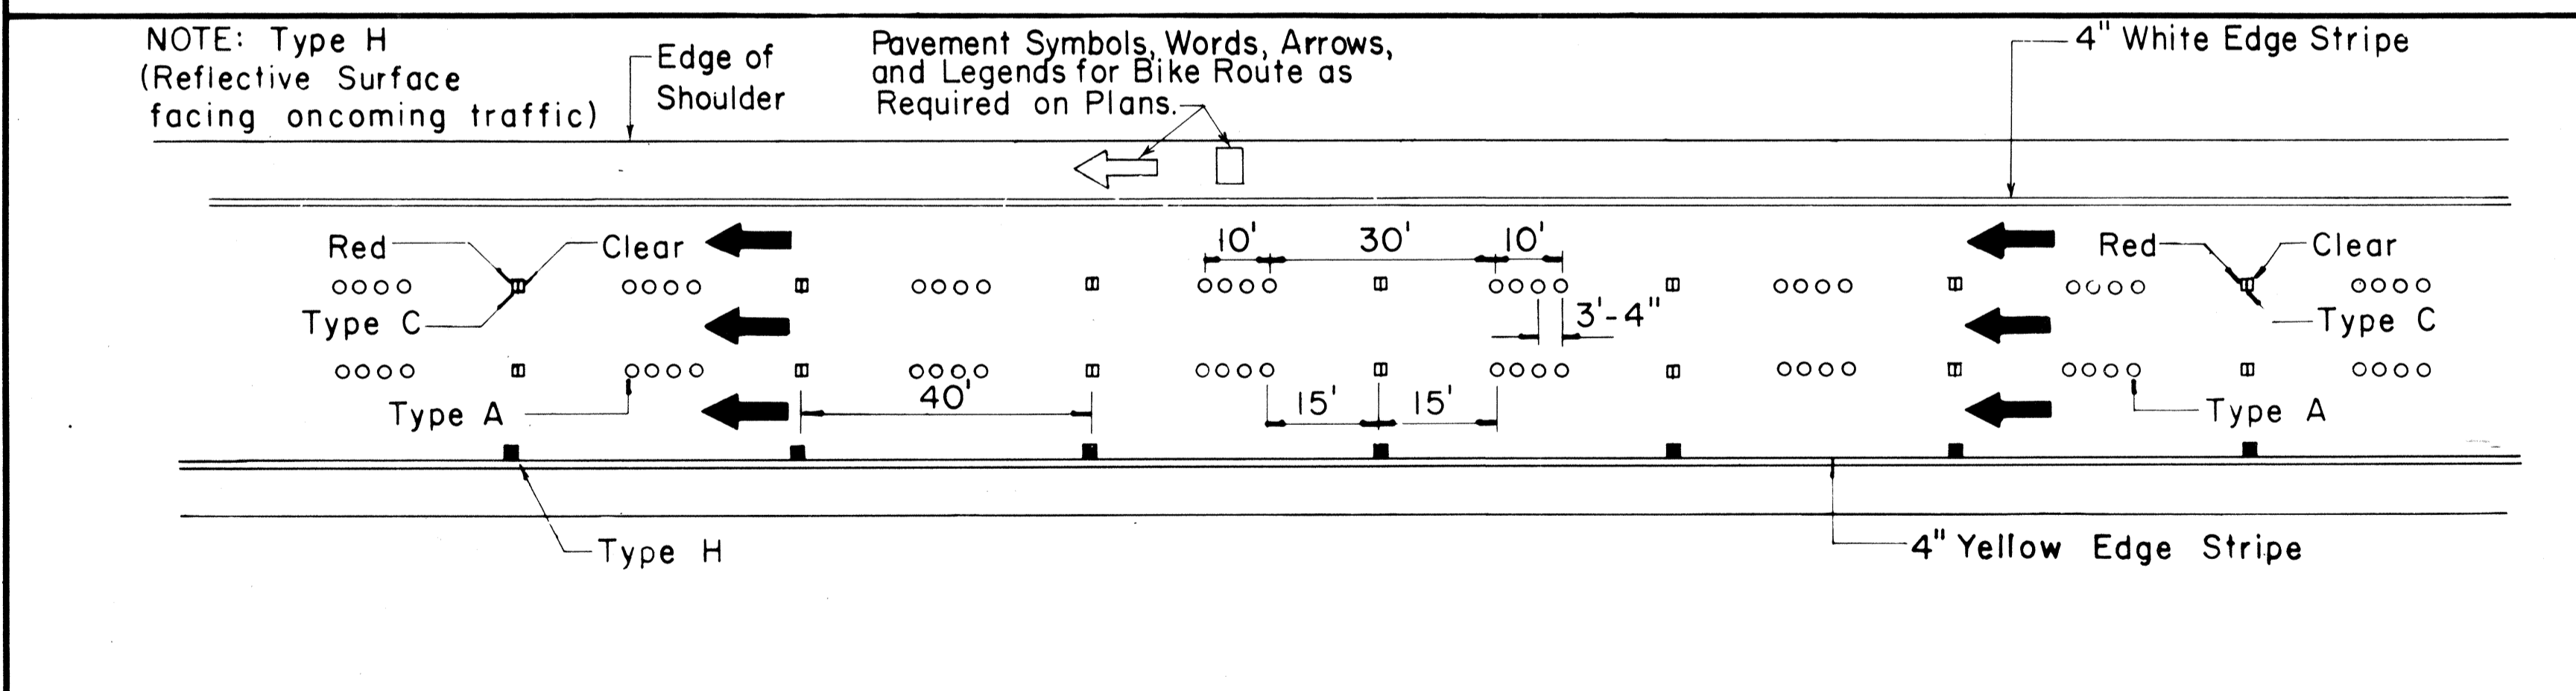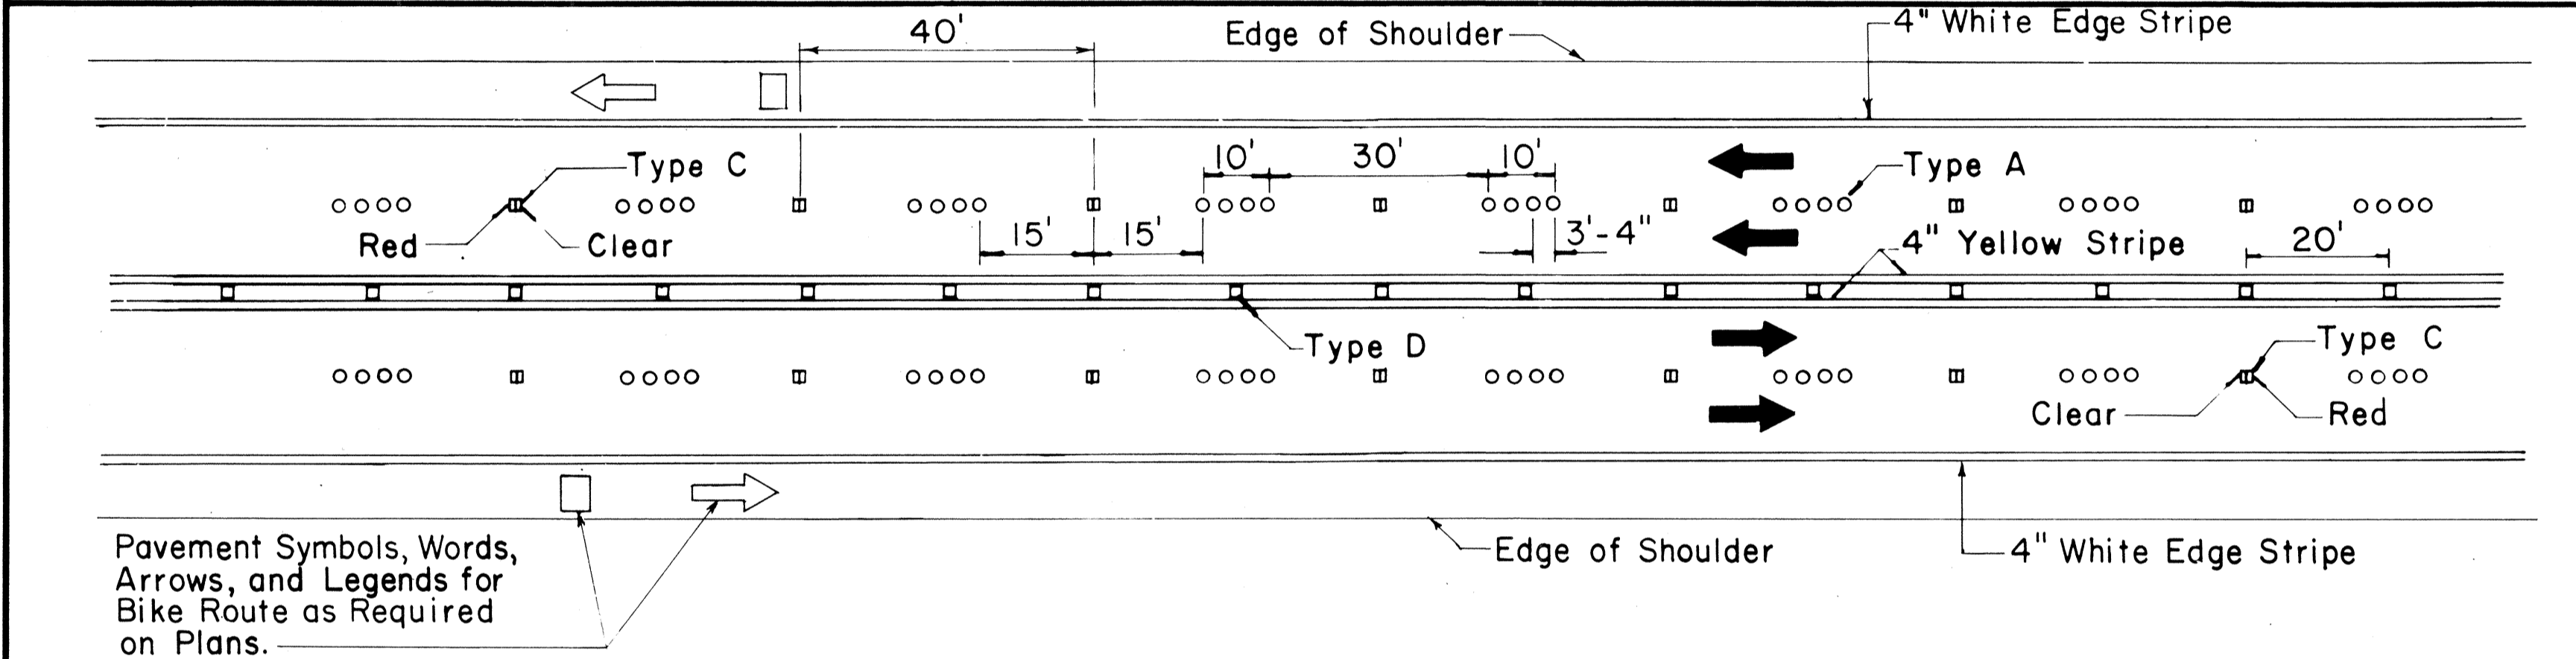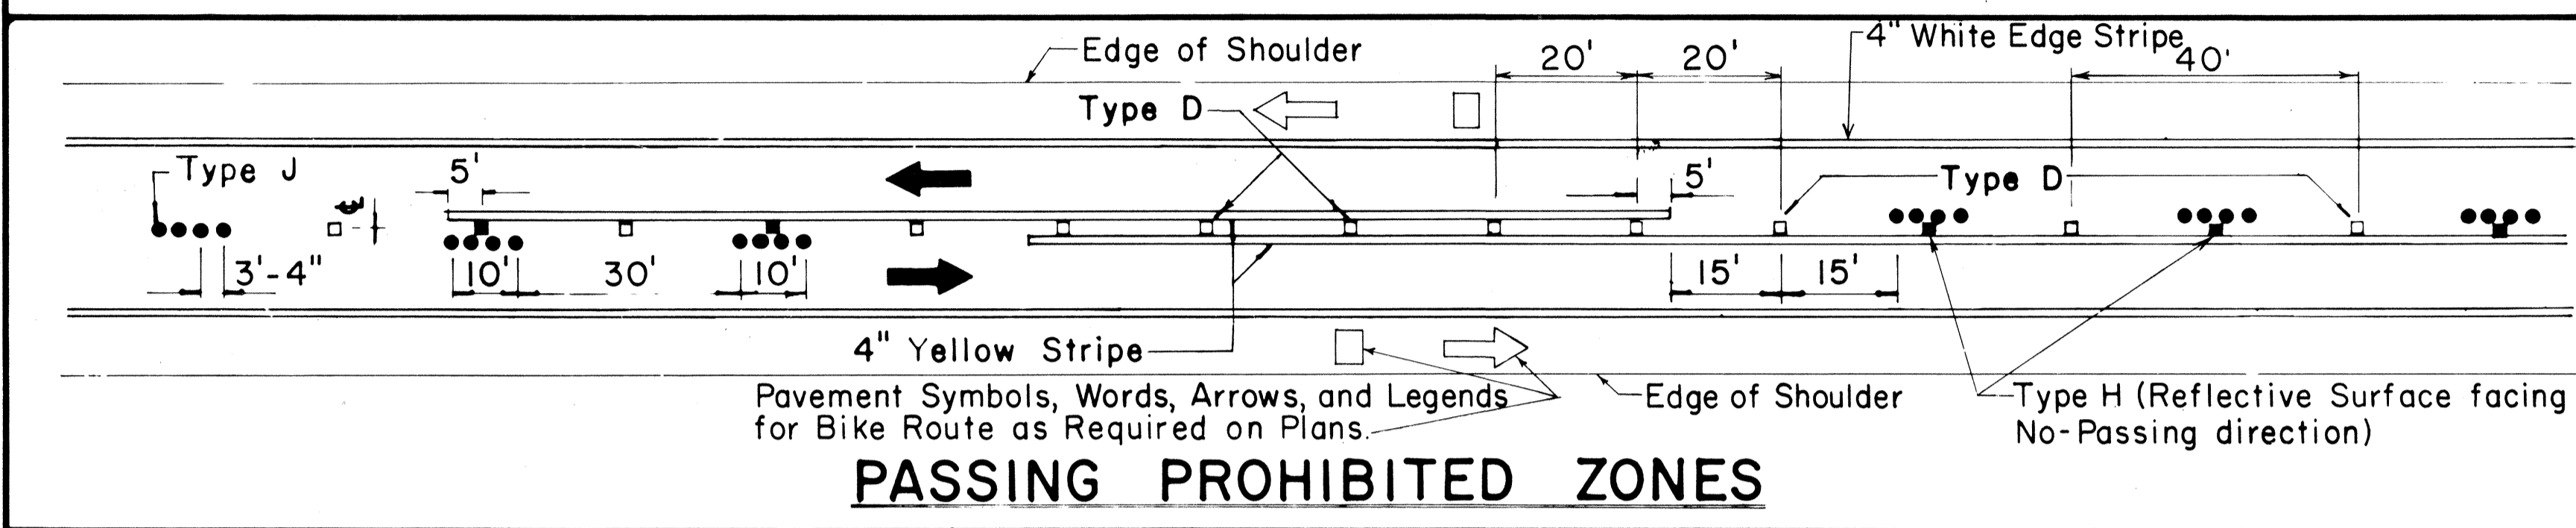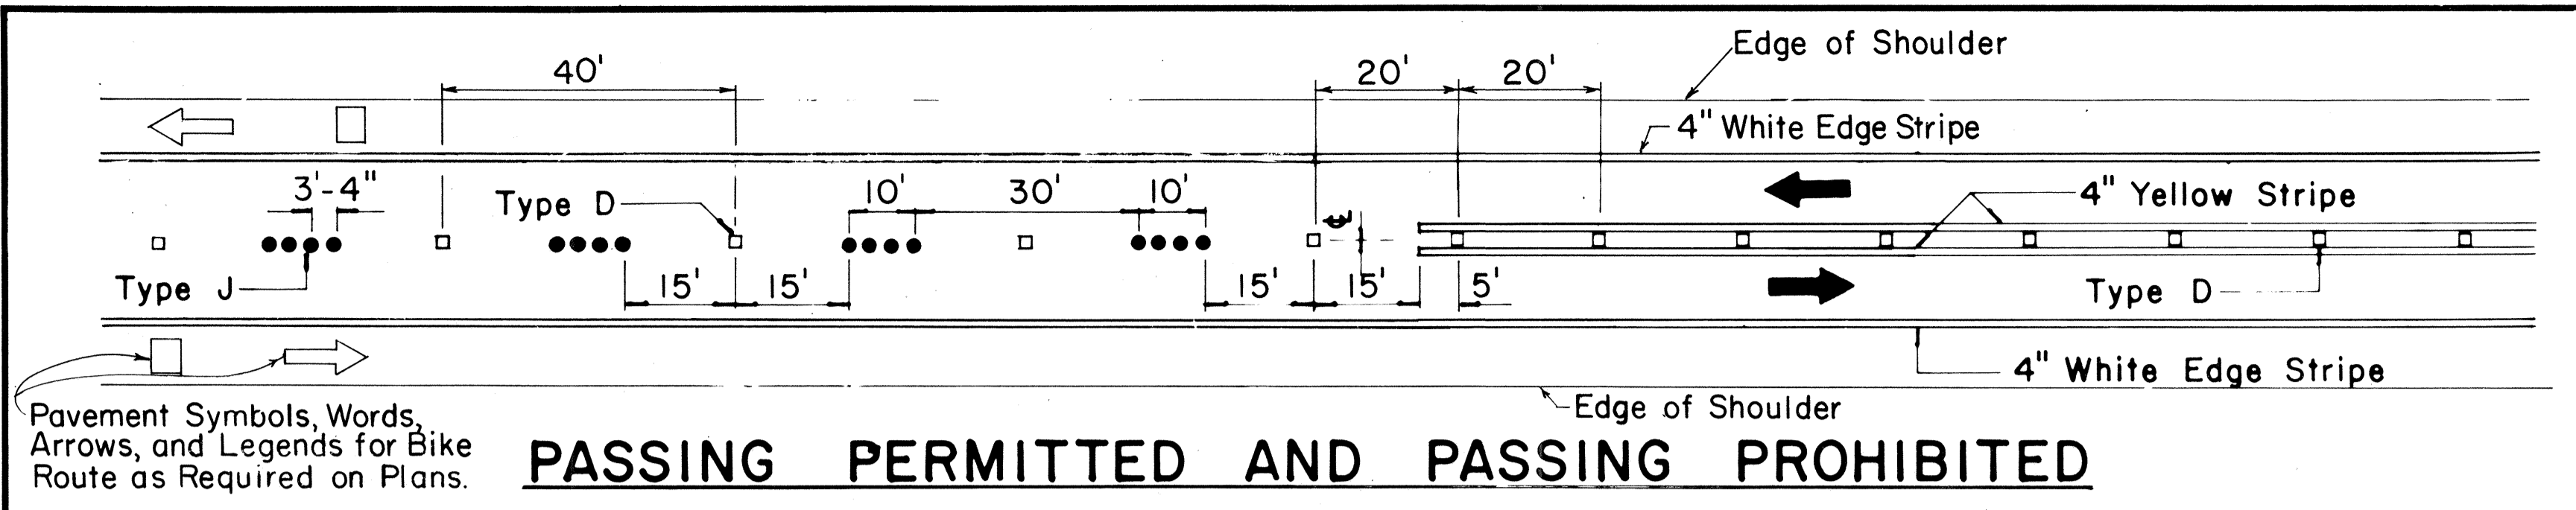


TWO - LANE

MULTI - LANE


DIVIDED HIGHWAY AND FREEWAY

MISCELLANEOUS

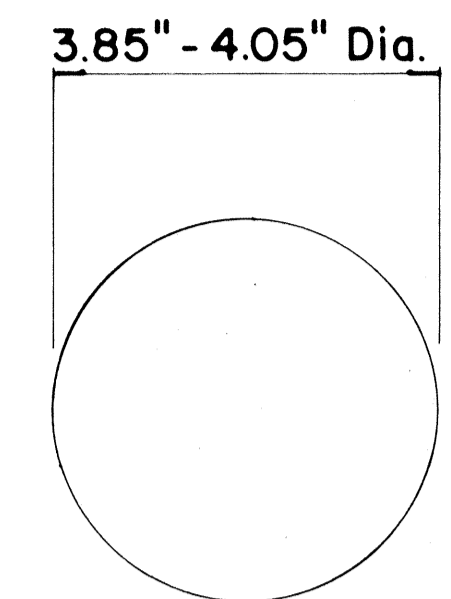


**TYPE A**  
NON-REFLECTIVE WHITE MARKER

**TYPE J**  
NON-REFLECTIVE YELLOW MARKER

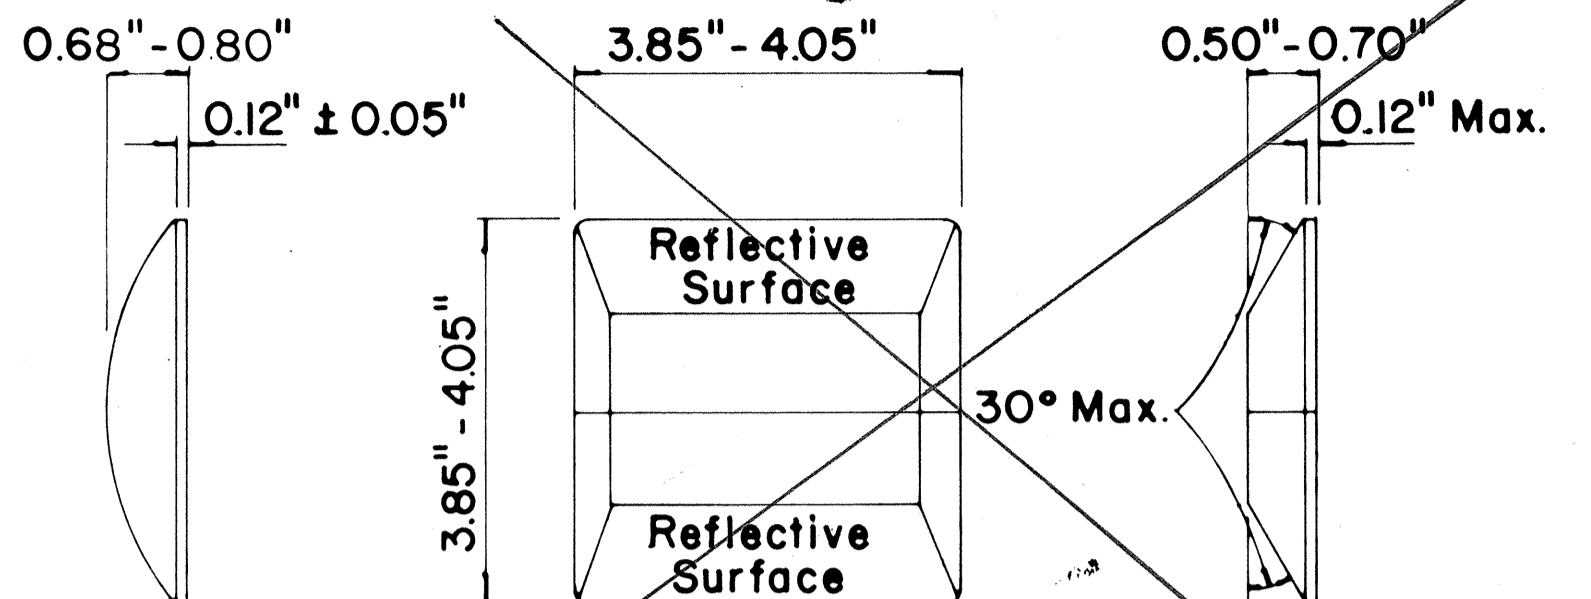


**TYPE C**  
RED-CLEAR REFLECTIVE MARKER

~~DELETE TYPE C AND TYPE H,  
REPLACE WITH TYPE CL AND TYPE HL.  
SEE PLAN SHT. 83, NOTE 8.~~

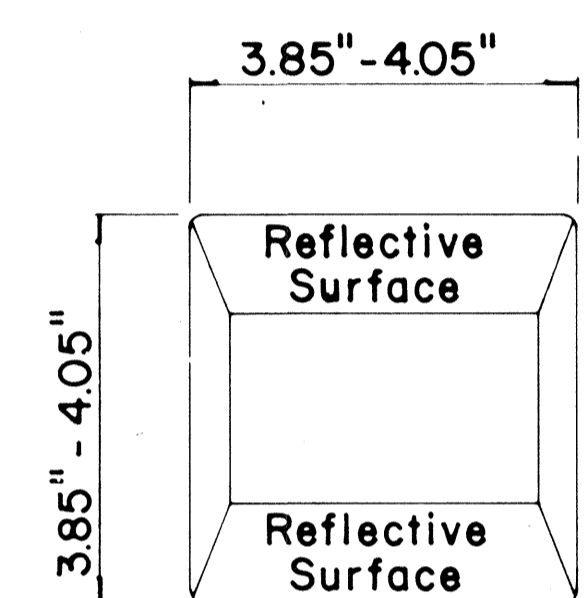

**TYPE D**  
TWO-WAY YELLOW REFLECTIVE MARKER

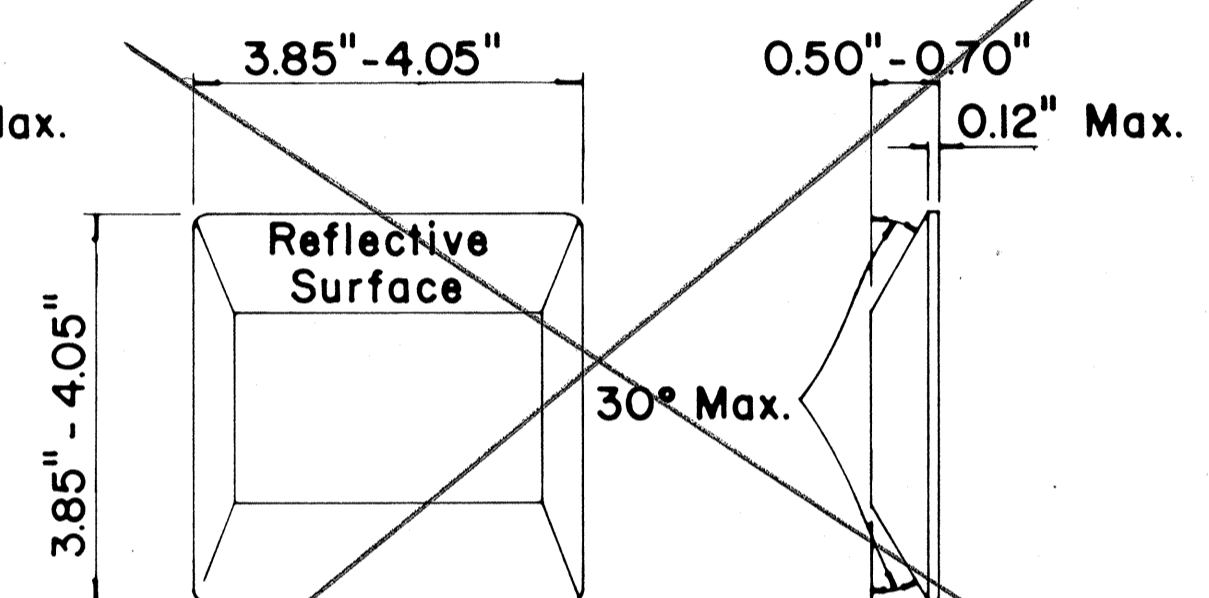

**TYPE H**  
ONE-WAY YELLOW REFLECTIVE MARKER

**GENERAL NOTES**

- Pavement marking and striping shall conform to the latest "Manual on Uniform Traffic Control Devices for Streets and Highways," and as amended.
- Layout and installation of pavement marking and striping shall be done by the Contractor. The Contractor shall check the layouts with the Engineer prior to performing work.
- Edge lines shall not be continued through intersections and shall not be broken for driveways unless otherwise shown or directed.

**LEGEND**

- Type A
- ◻ Type C
- ◻ Type D
- ◻ Type H
- Type J

APPROVAL RECOMMENDED:  
*Eiichi Tanaka* 7/21/78  
TRAFFIC ENGINEER DATE

APPROVED:  
*Herbert B. Zakiyan* 7/24/78  
ASSISTANT CHIEF, ENGINEERING DATE

No	REVISION	APPROVED BY	DATE
1	Supersedes DT 300 approved 11/18/71.	H.T.	7/24/78
2	Delete Type A Markers from Bike Route Delineation.	H.T.	10/15/79
3	Added General Note 3. Revised left edge stripe.	H.T.	9-28-83
4	Revised Channelizing Lines or Solid Lane Lines.	H.T.	9/18/85



STATE OF HAWAII  
DEPARTMENT OF TRANSPORTATION  
HIGHWAYS DIVISION

**STANDARD DETAILS**  
**RAISED PAVEMENT MARKERS**  
**AND STRIPING**

Not to Scale July 1978  
SHEET No. OF SHEETS DT 300






DATE: \_\_\_\_\_  
SURVEY PLOTTED BY: \_\_\_\_\_  
DRAWN BY: \_\_\_\_\_  
CHECKED BY: \_\_\_\_\_  
DESIGNED BY: \_\_\_\_\_  
NOTE BOOK No. \_\_\_\_\_

FED. ROAD DIST. NO.	STATE	FED. AID PROJ. NO.	FISCAL YEAR	SHEET NO.	TOTAL SHEETS
HAWAII	HAW.	1R-HI-1 (185)	1986	98	99

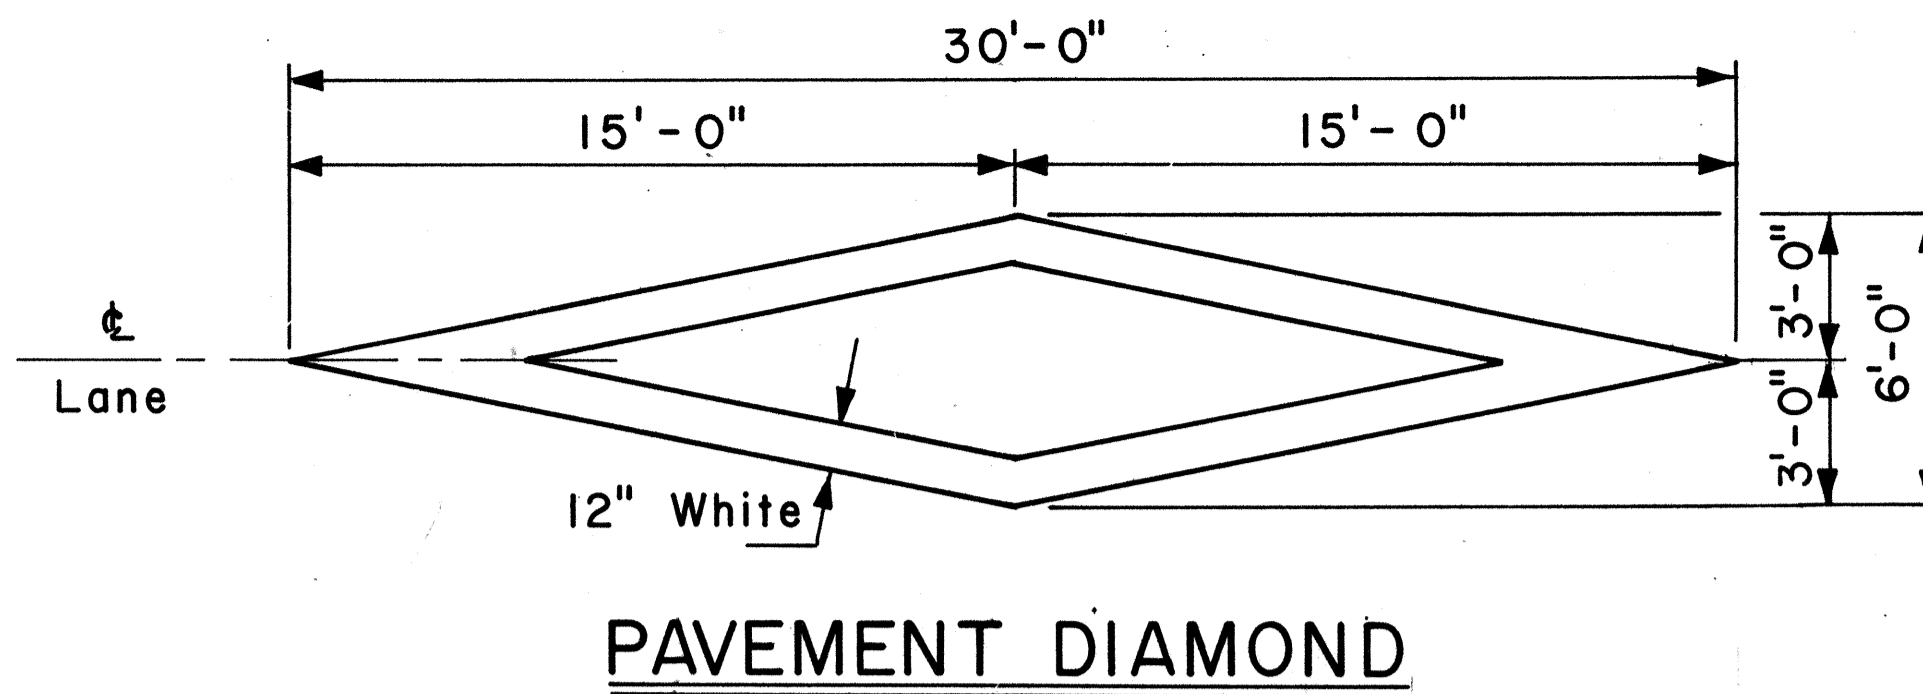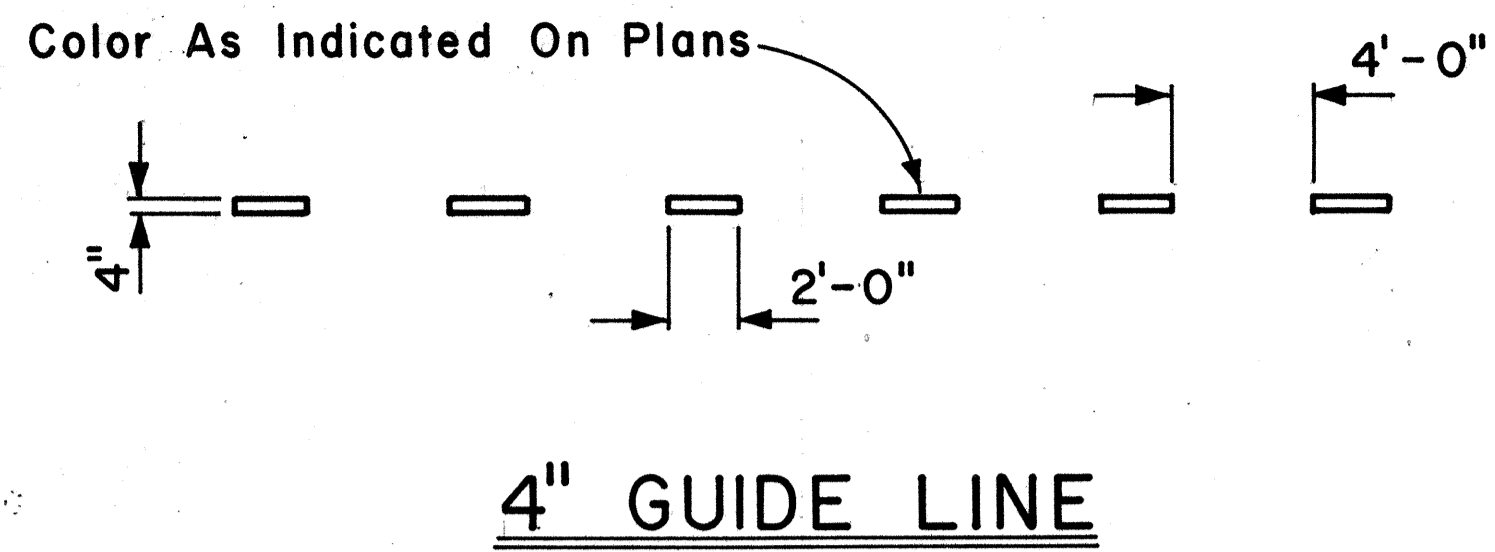

**GENERAL NOTES:**

1. Pavement marking and striping shall conform to the latest edition of the "Manual on Uniform Traffic Control Devices for Streets and Highways," by the FHWA, and as amended.
2. Layout of pavement markings and striping shall be done by the Contractor. The Contractor shall check layout of markings and striping with the Engineer prior to performing work.
3. For additional pavement marking details, see sheet DT 300.

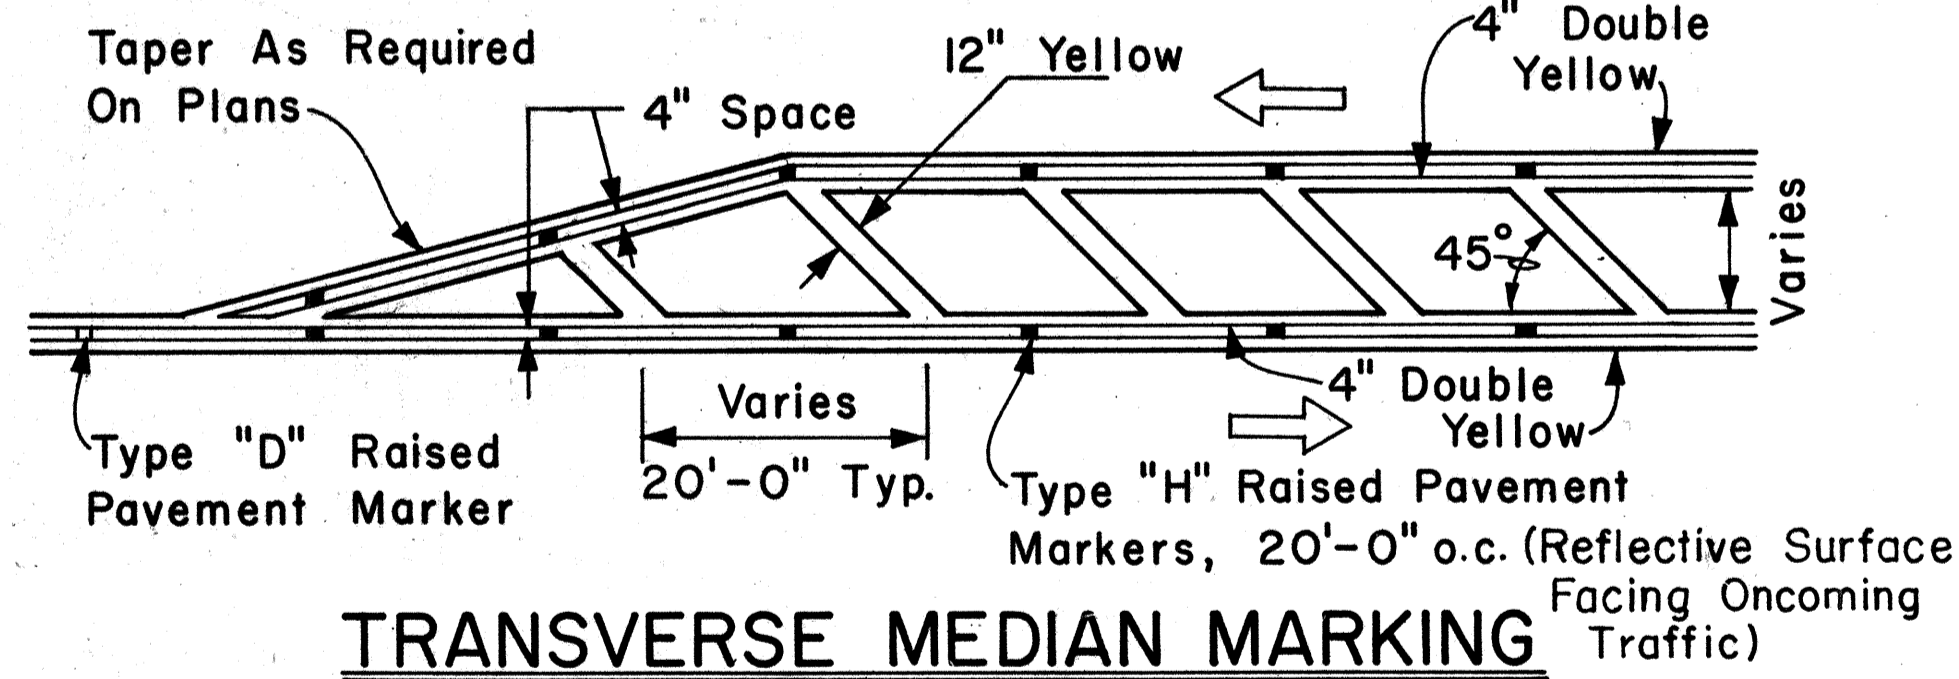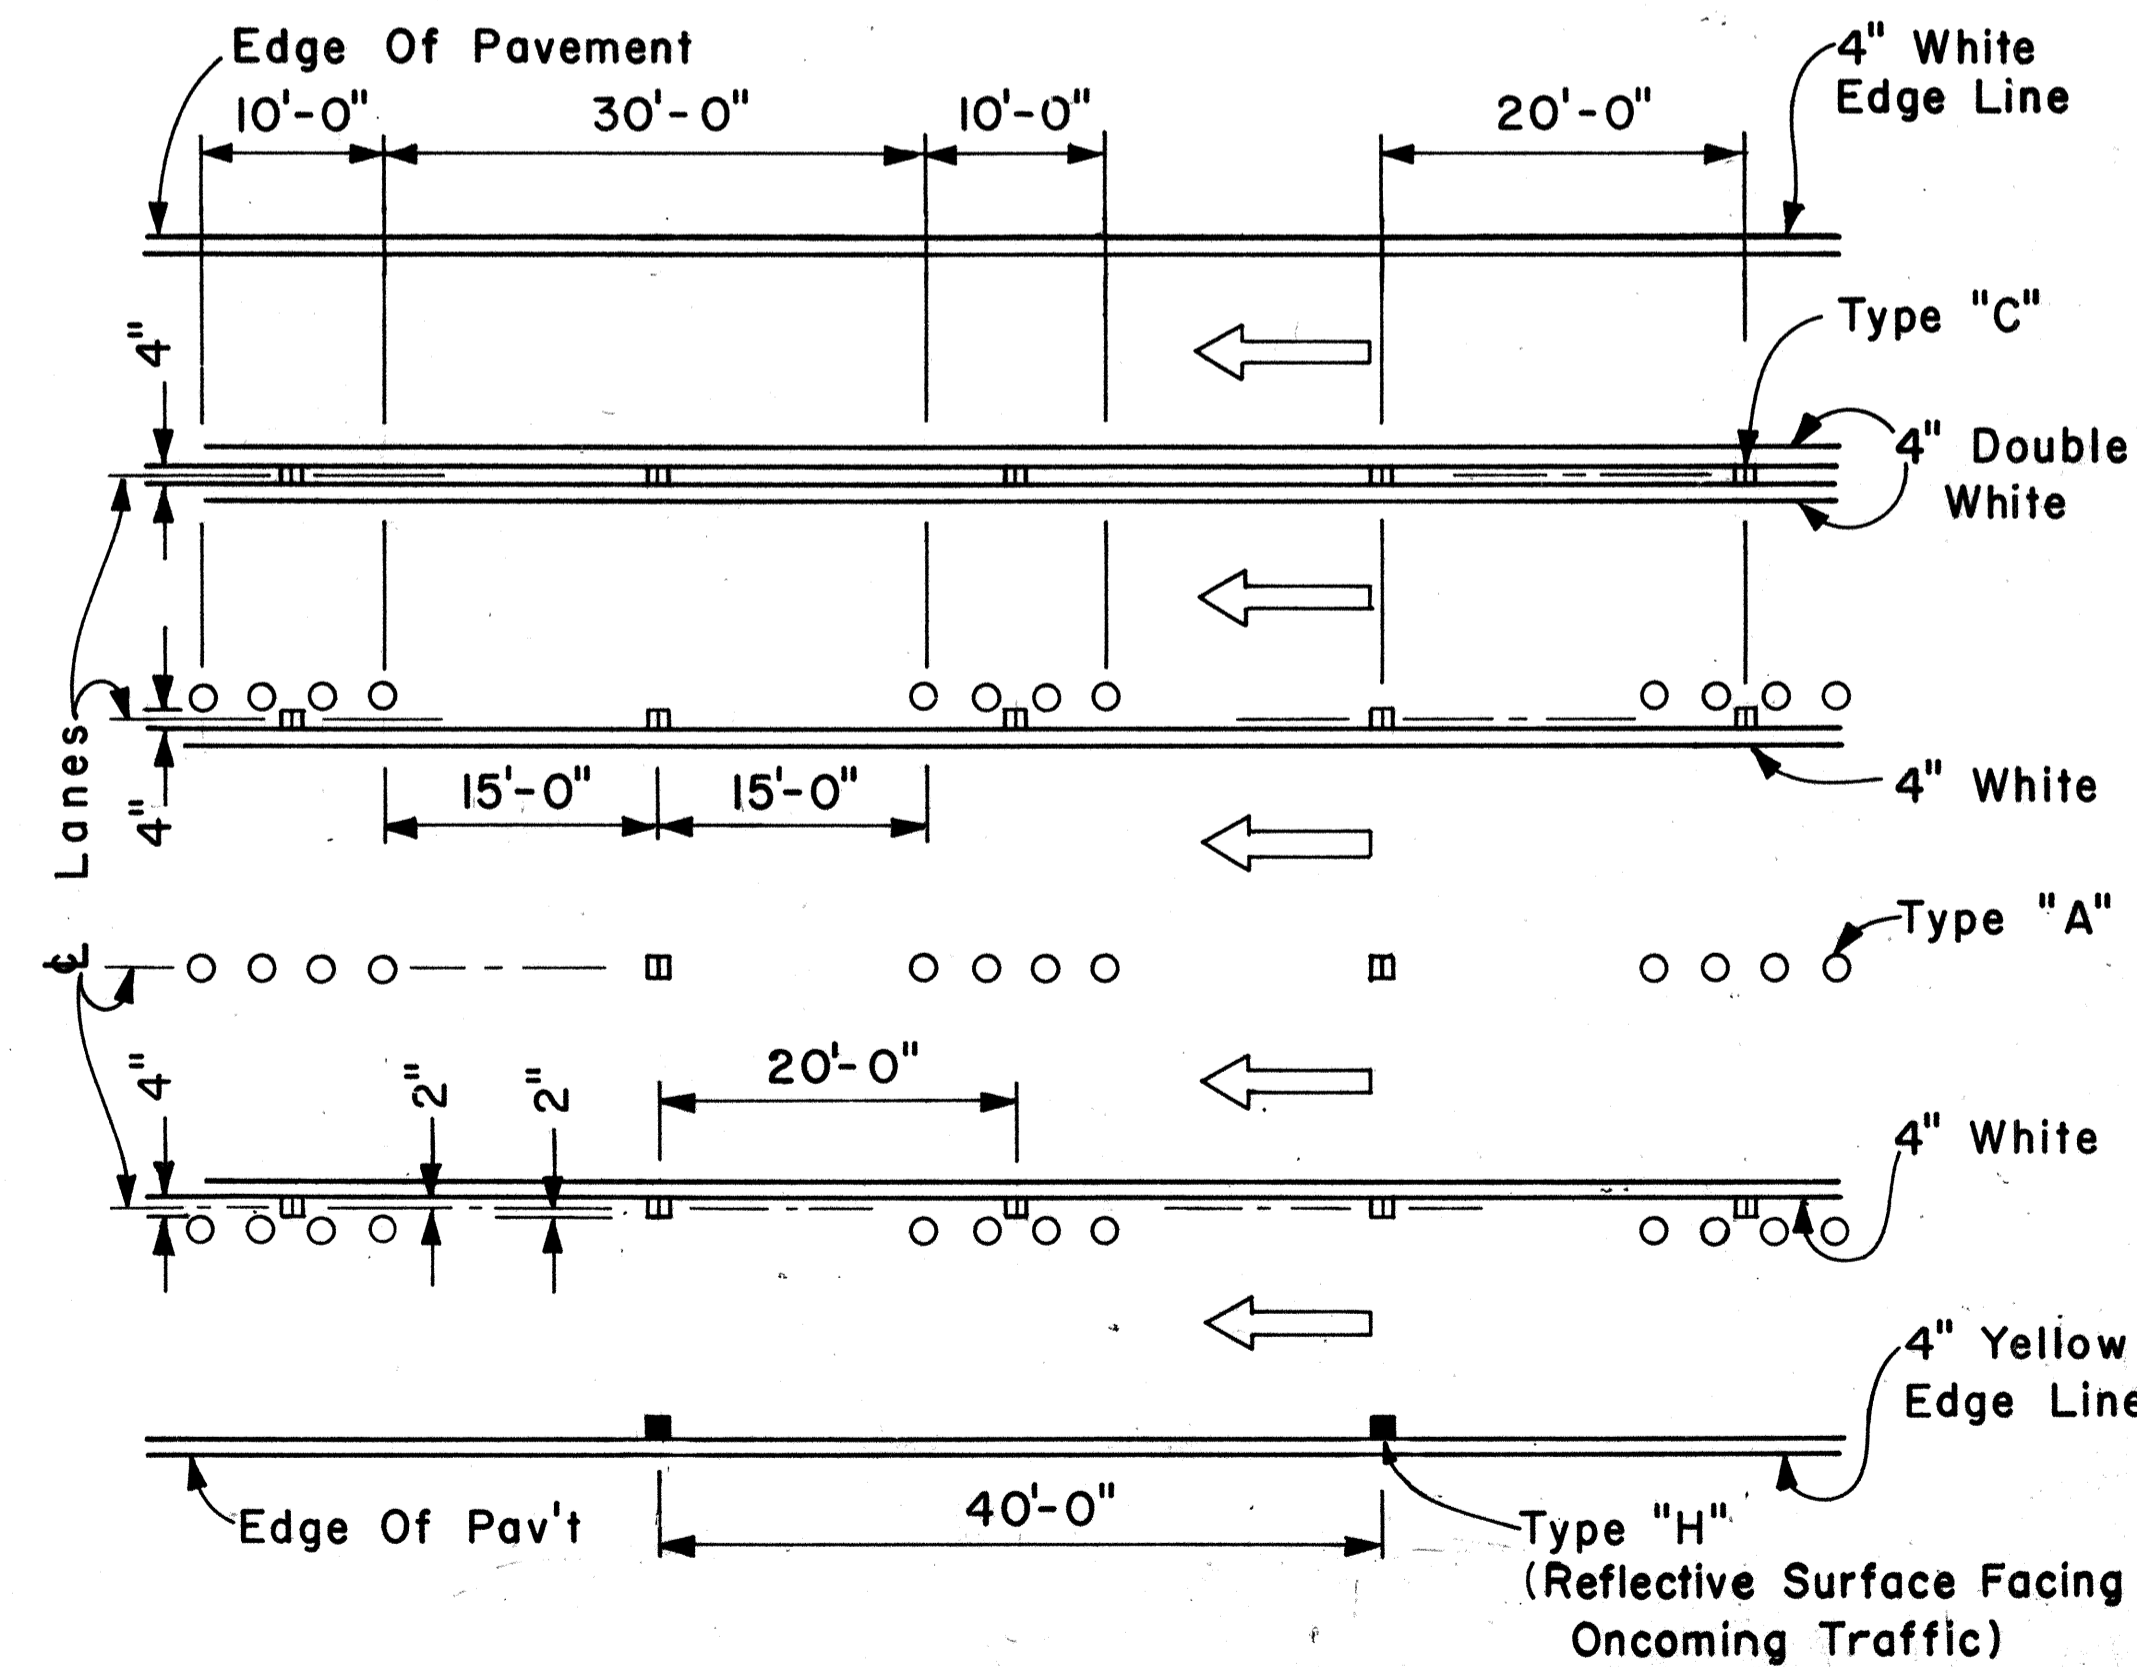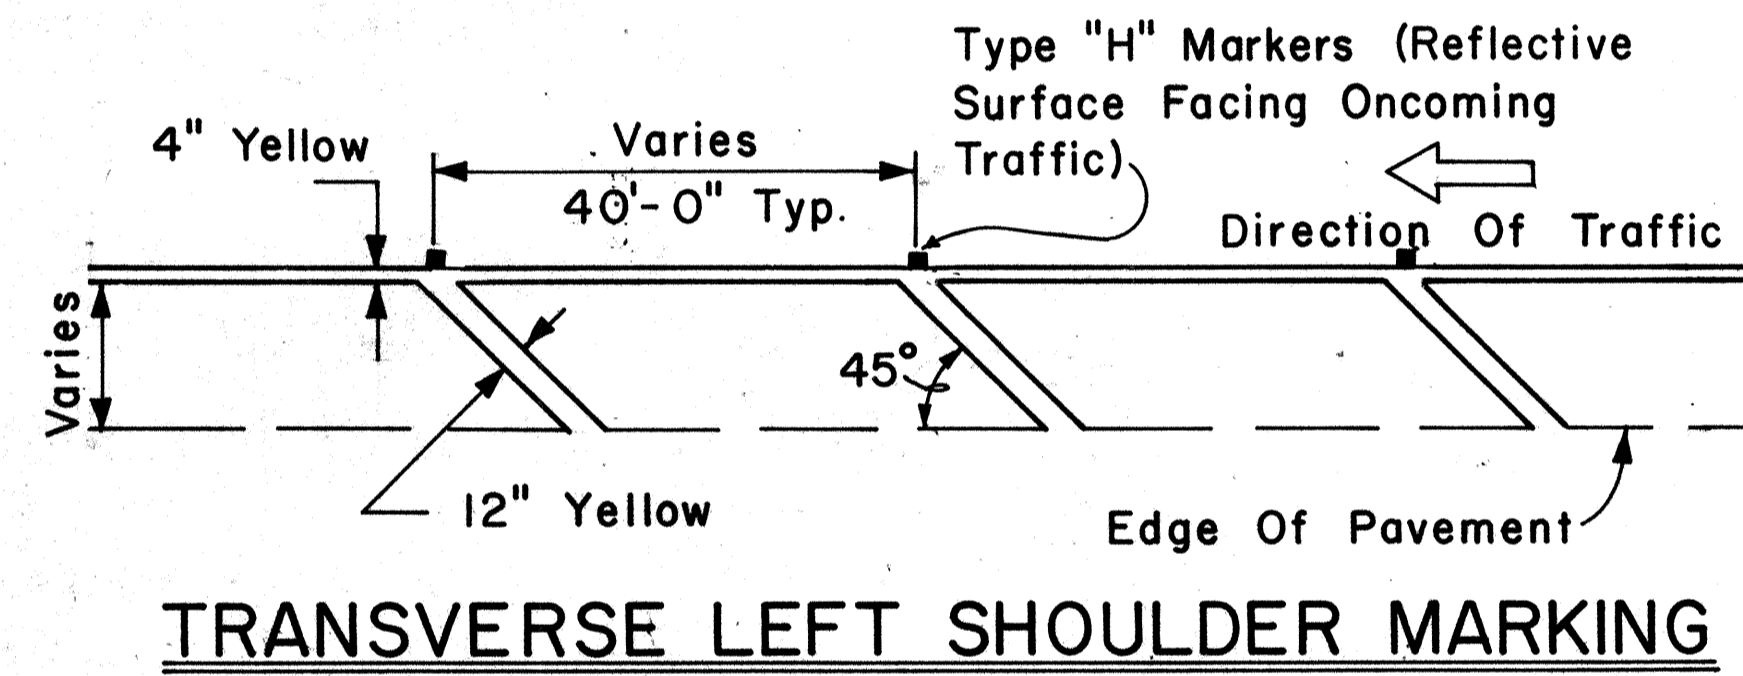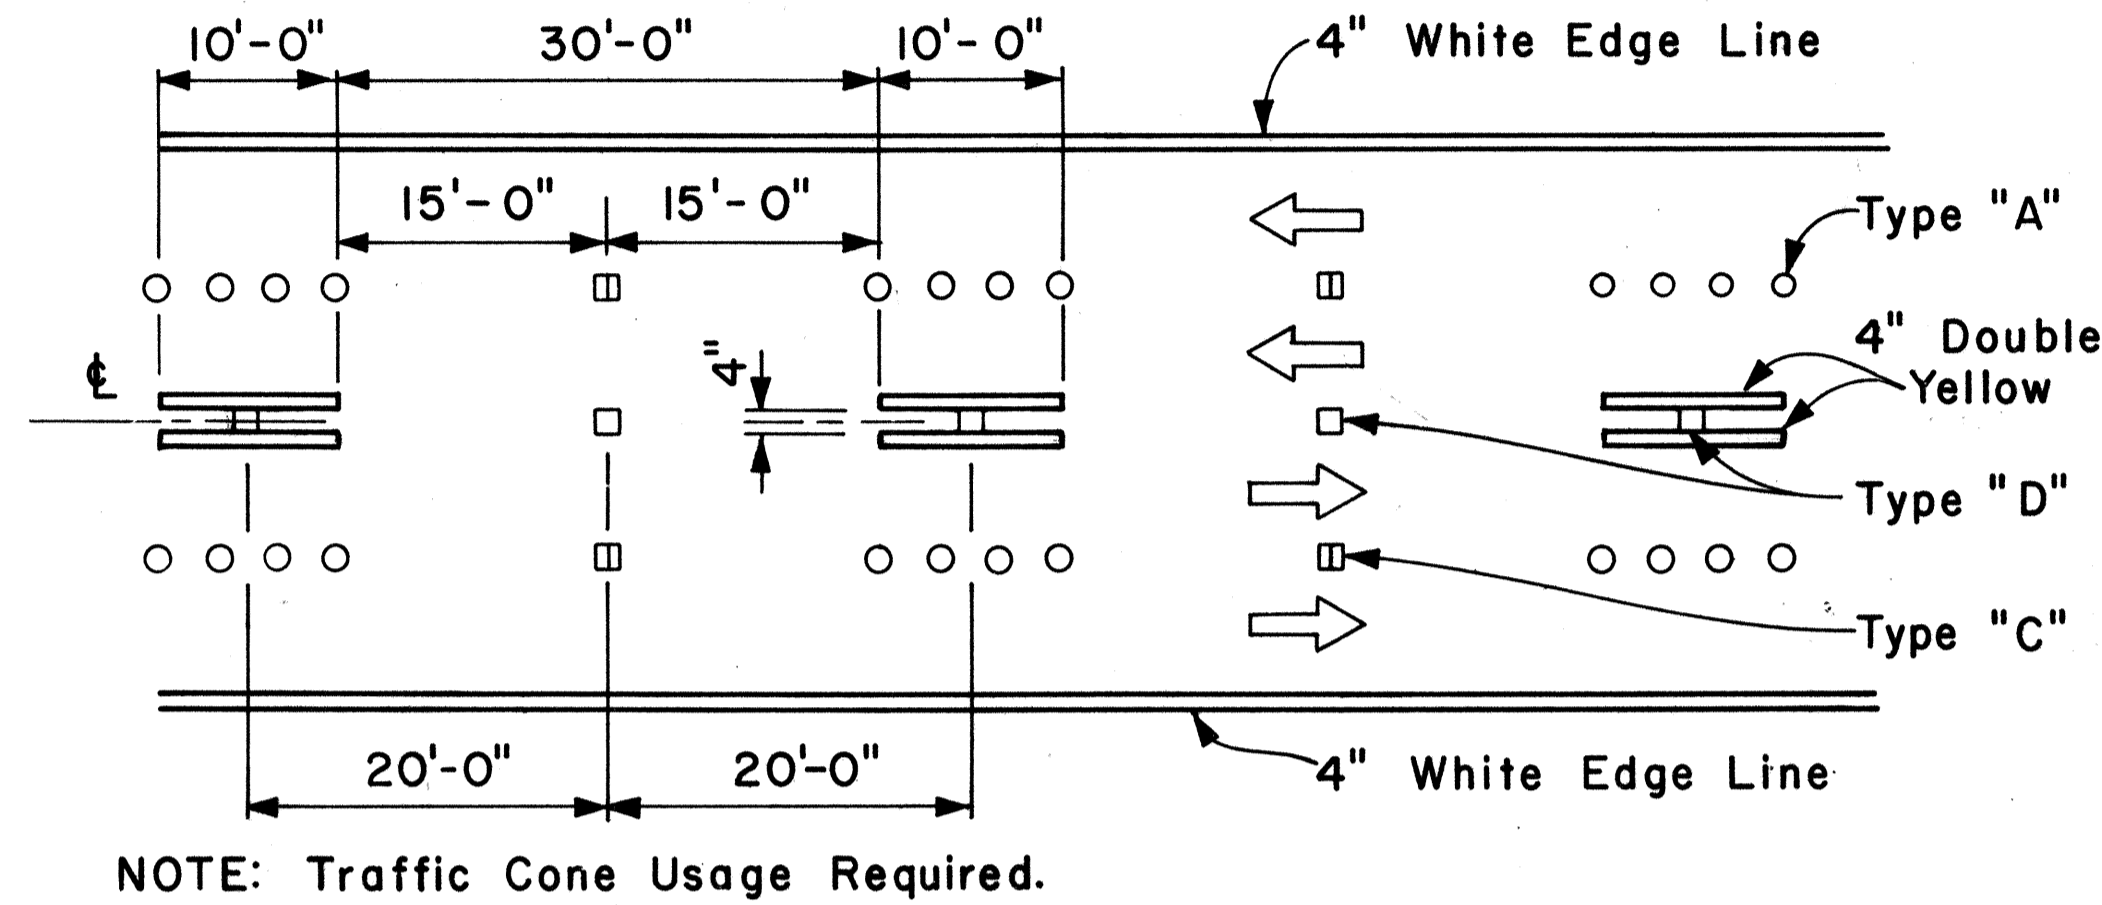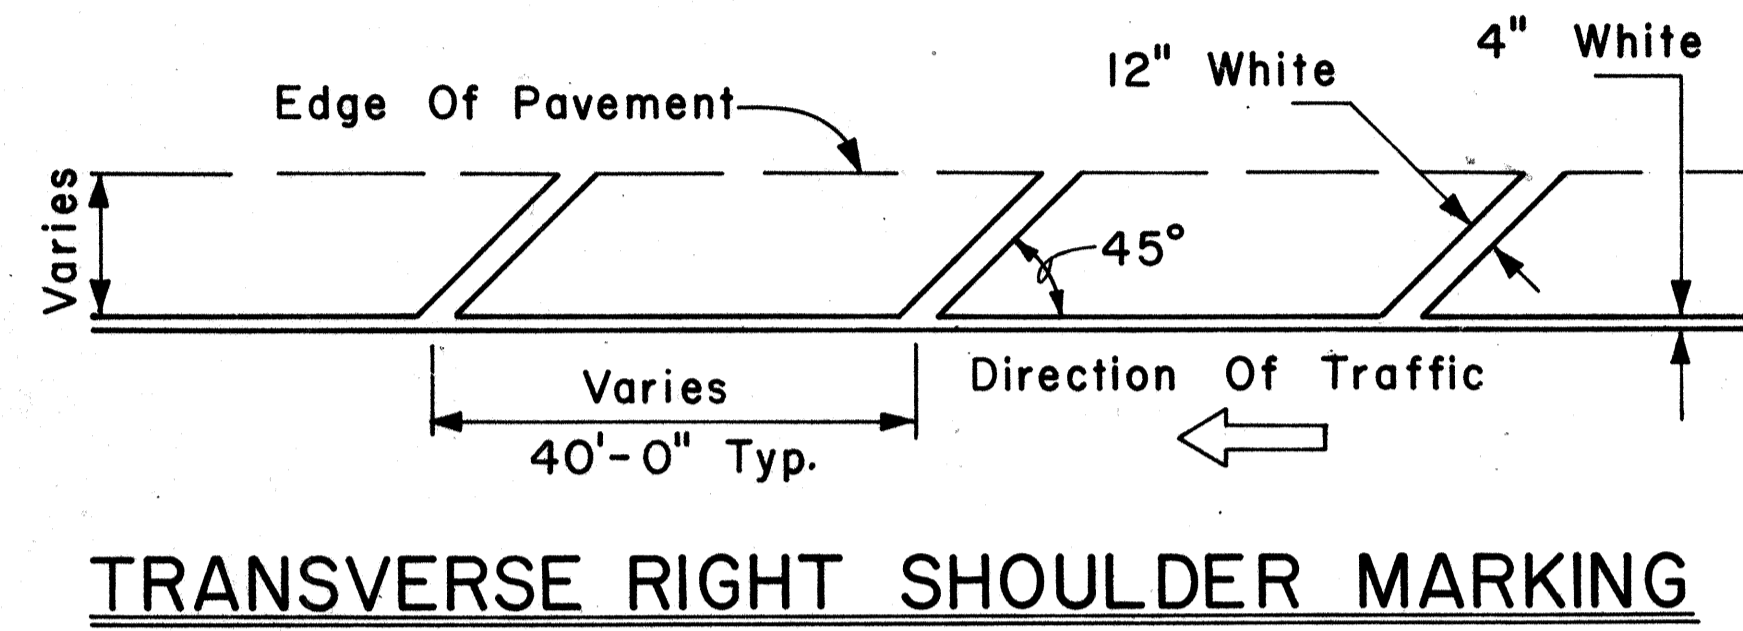

APPROVAL RECOMMENDED:  
*Eishi Tanaka* 5/2/78  
 TRAFFIC ENGINEER DATE

APPROVED:  
*Herbert S. Zaki* 5/3/78  
 ASSISTANT CHIEF, ENGINEERING DATE

NO.	REVISION	APPROVED BY	DATE
1	Revised Transverse left Shoulder Marking, Channelizing Island & Lane Change Restriction Zones.	E.T.	7/10/85


STATE OF HAWAII  
 DEPARTMENT OF TRANSPORTATION  
 HIGHWAYS DIVISION

**STANDARD DETAILS**

MISCELLANEOUS  
 PAVEMENT MARKINGS

Scale: Not to Scale Date: April, 1978

SHEET NO. OF SHEETS DT 302

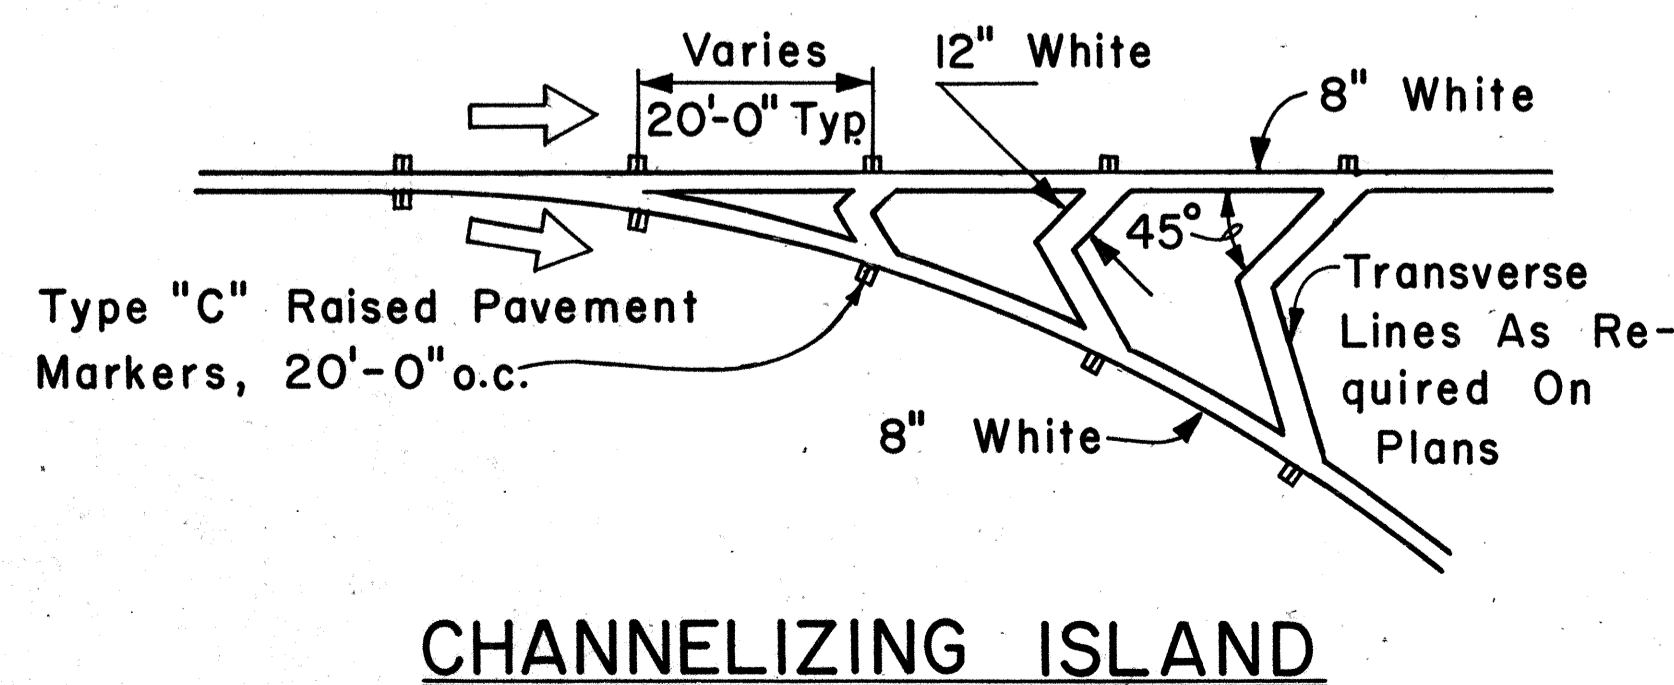


ORIGINAL SURVEY PLANNED BY DATE  
 DRAWN BY  
 CHECKED BY  
 NOTE BOOK DESIGNED BY  
 QUANTITIES BY  
 CHECKED BY

FED. ROAD DIST. NO.	STATE	FED. AID PROJ. NO.	FISCAL YEAR	SHEET NO.	TOTAL SHEETS
HAWAII	HAW.	1R-H-1 (189)	1980	99	99


**GENERAL NOTES:**

1. Pavement Markings and Striping shall conform to the latest edition of the "Manual on Uniform Traffic Control Devices for Streets and Highways", by the FHWA, and as amended.
2. Layout of Pavement Markings and Striping shall be done by the Contractor. The Contractor shall check layout of markings and striping with the Engineer prior to performing work.
3. For additional details, see sheet DT 300.

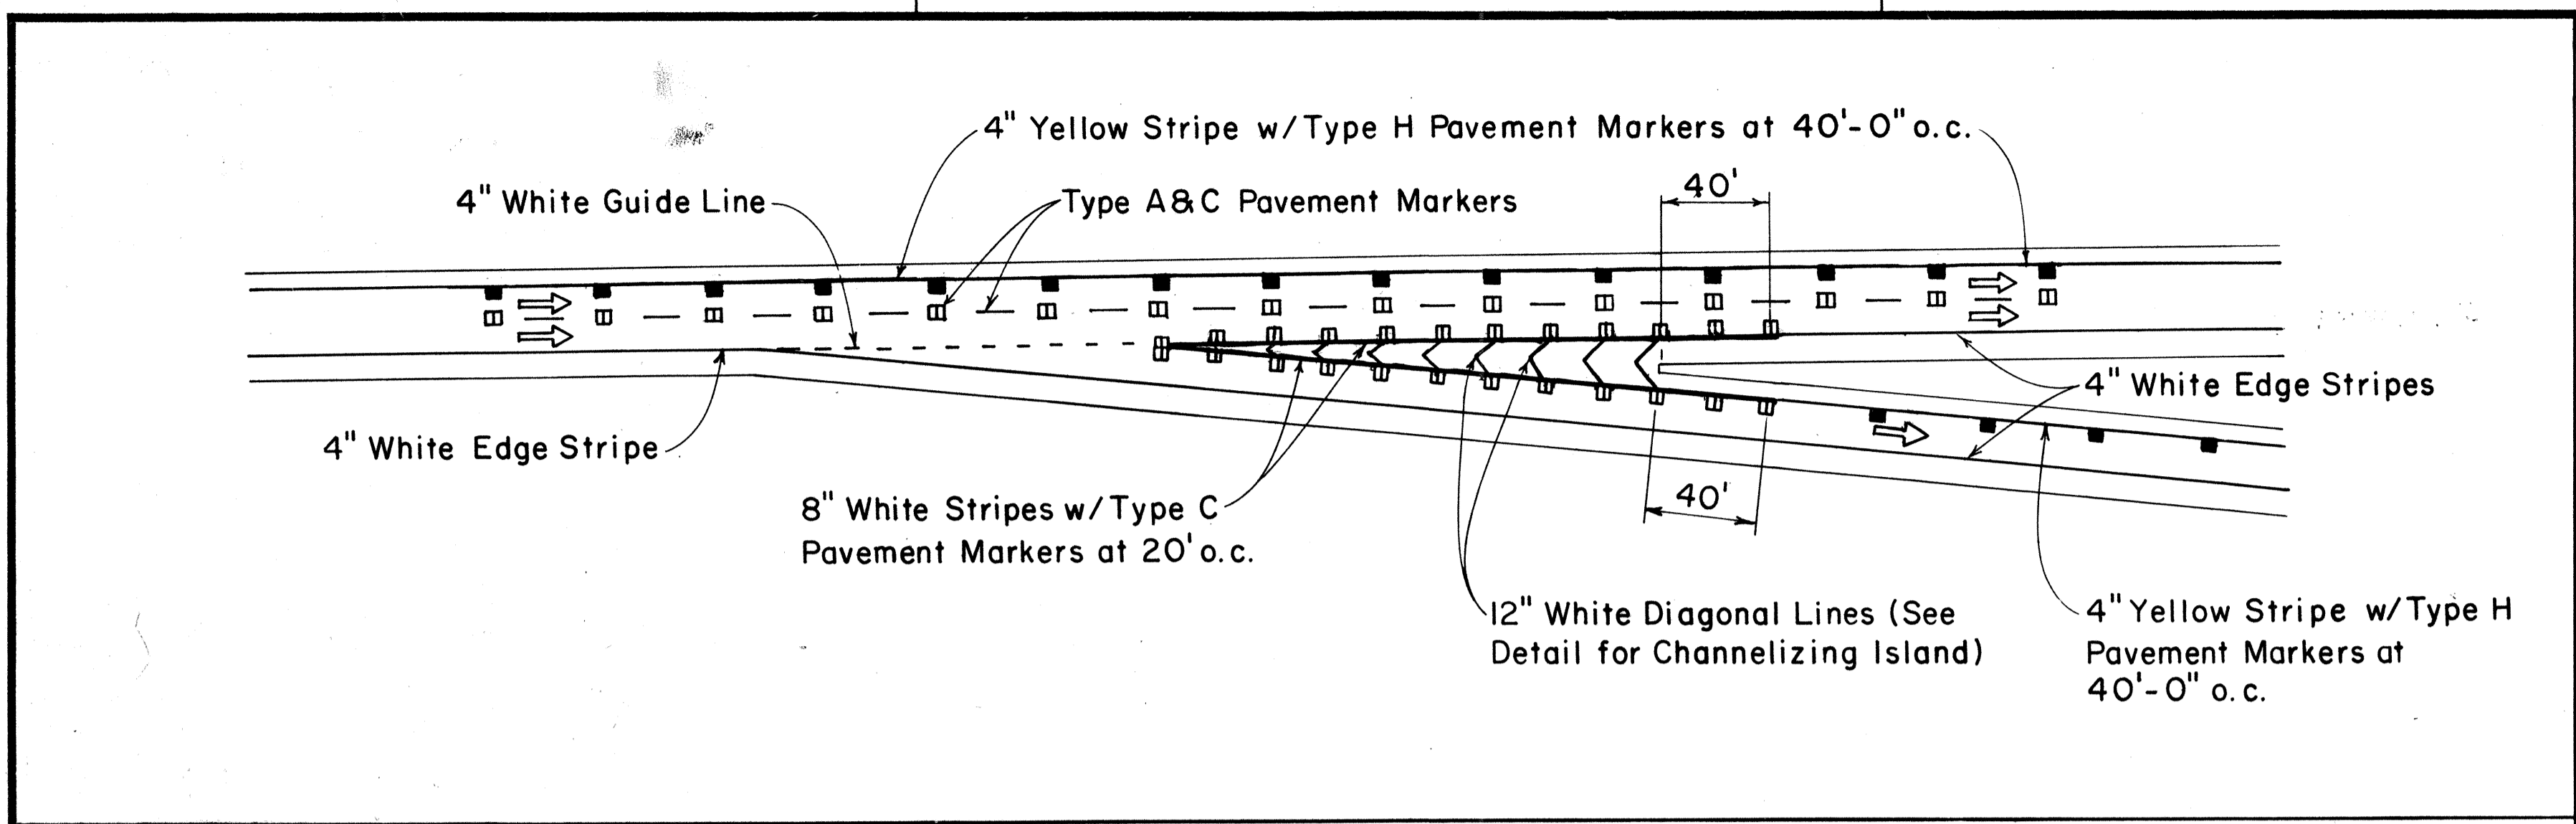


TAPERED DECELERATION LANE


TYPICAL ROADWAY EXIT MARKINGS

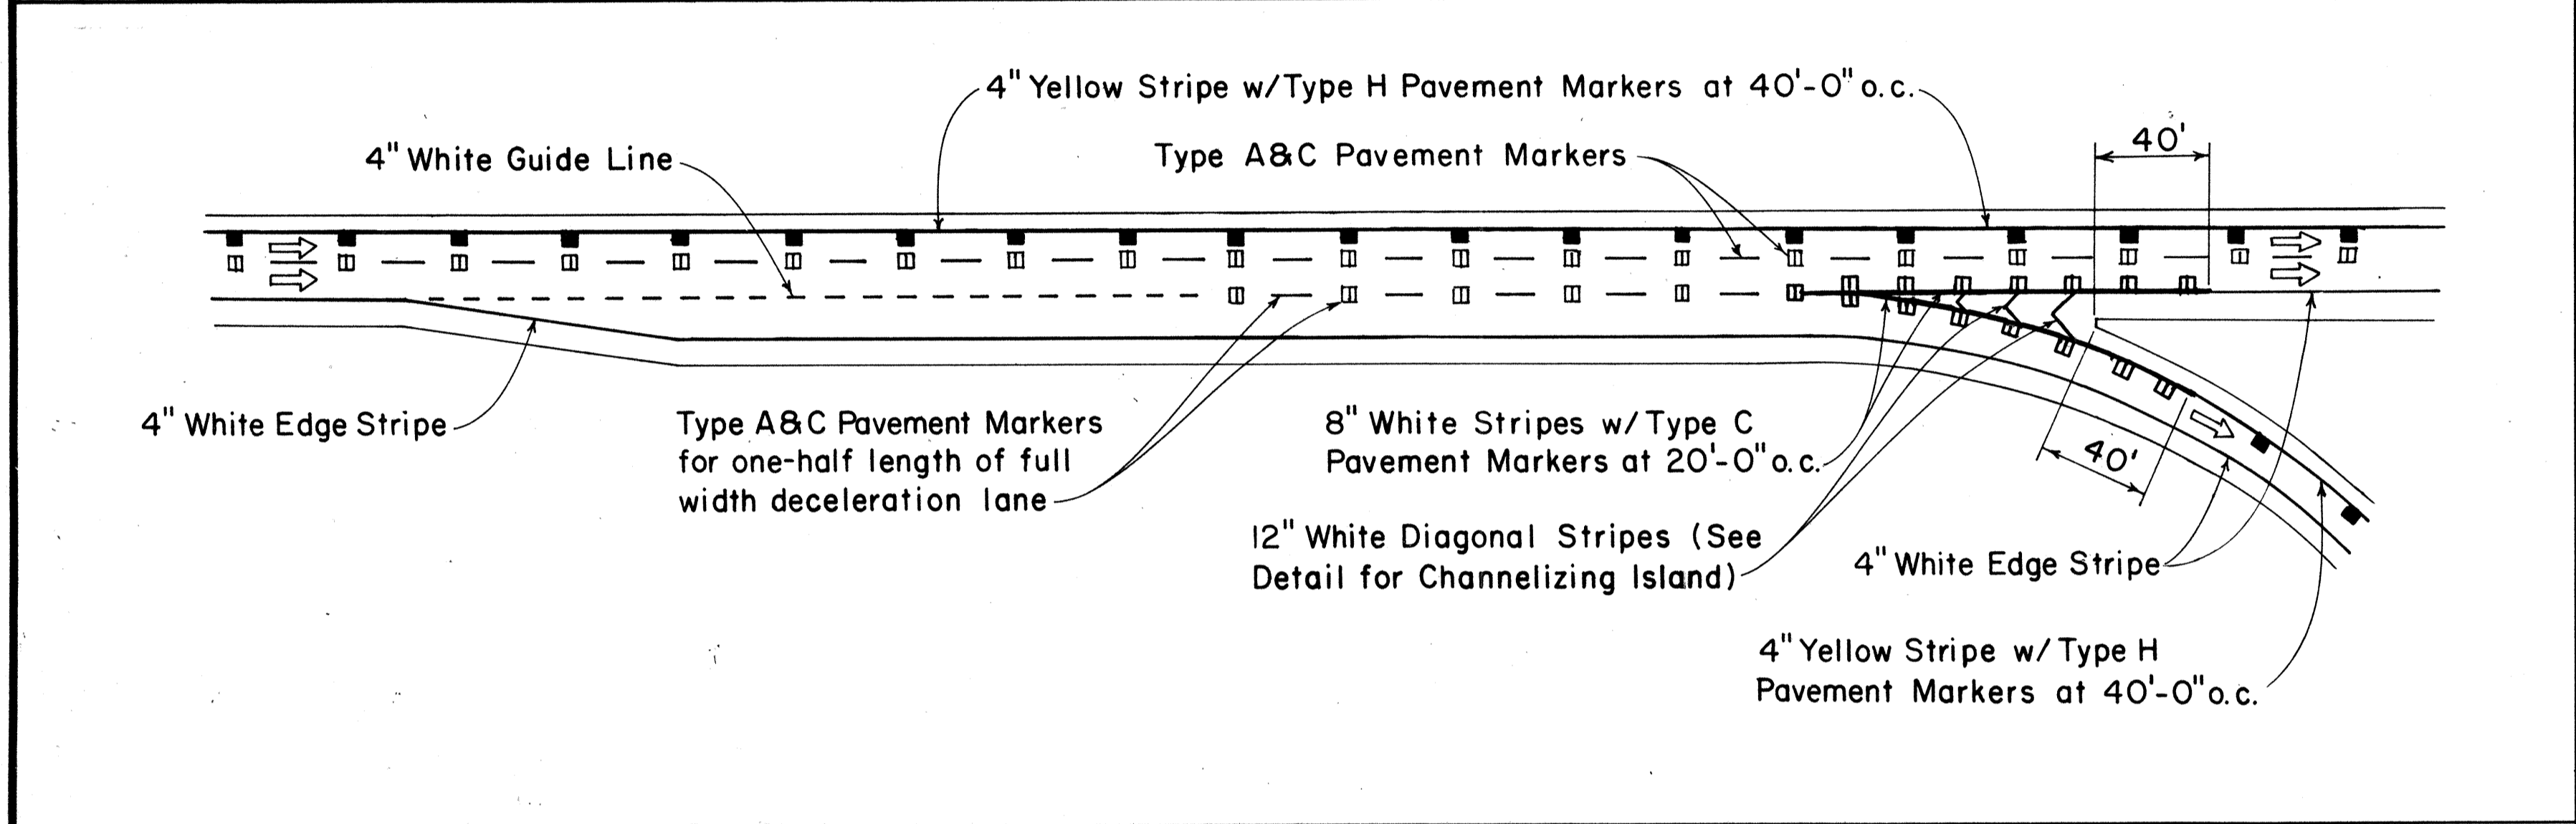

PARALLEL DECELERATION LANE

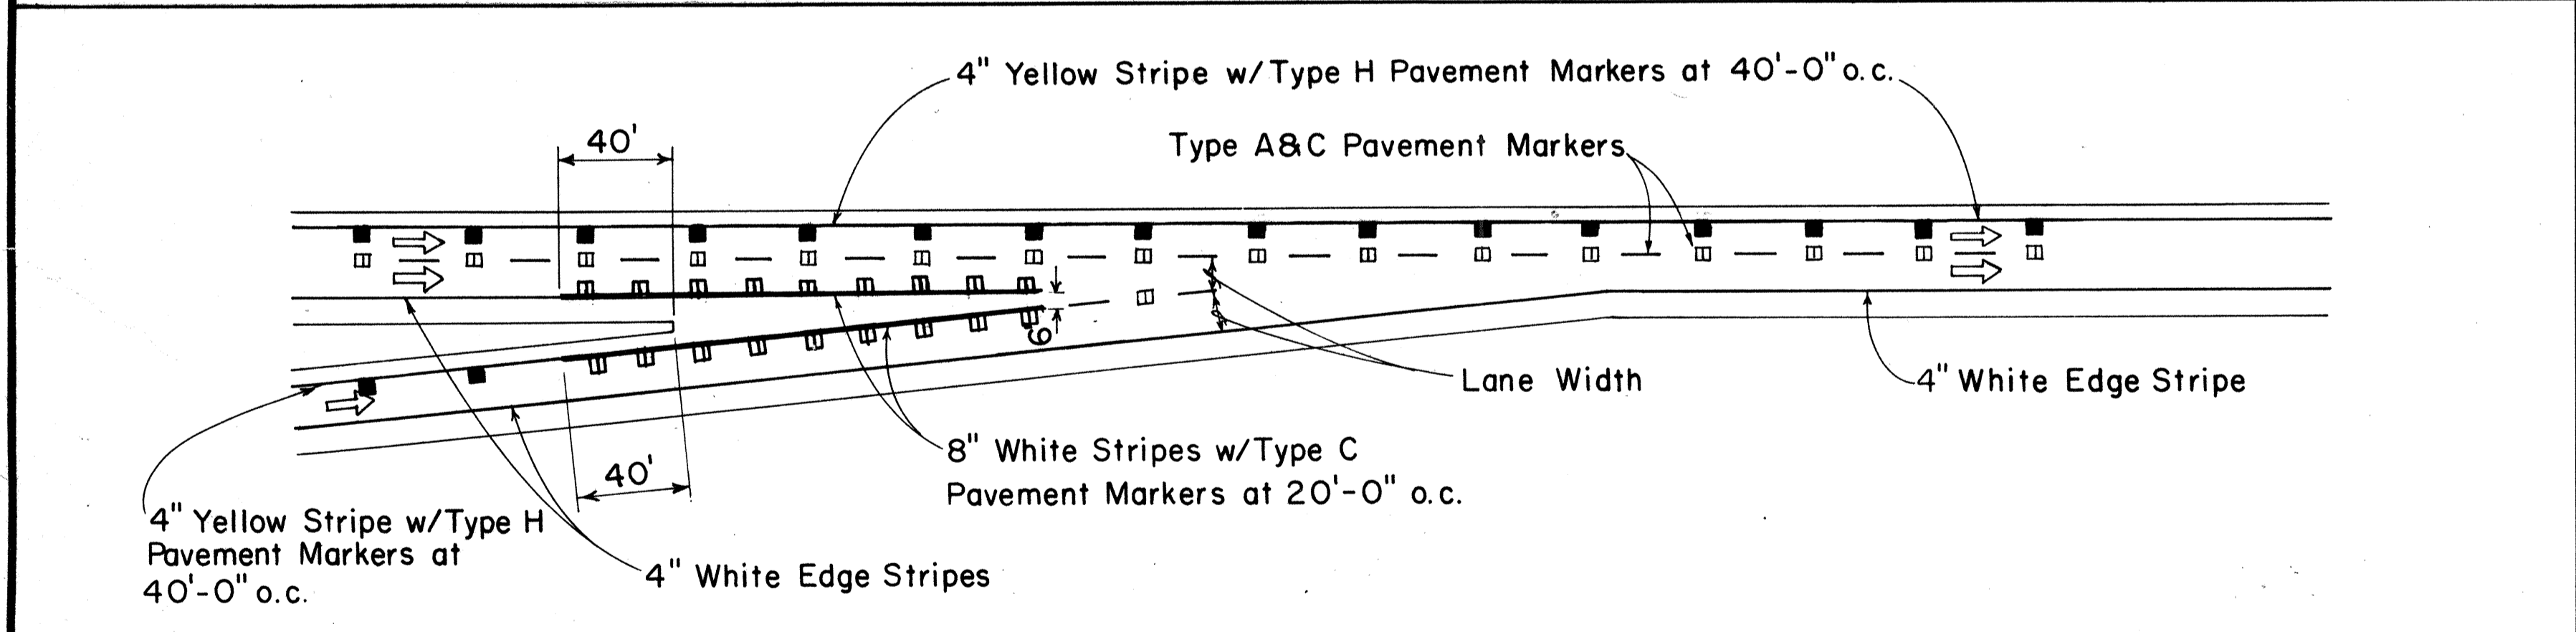

TAPERED ACCELERATION LANE

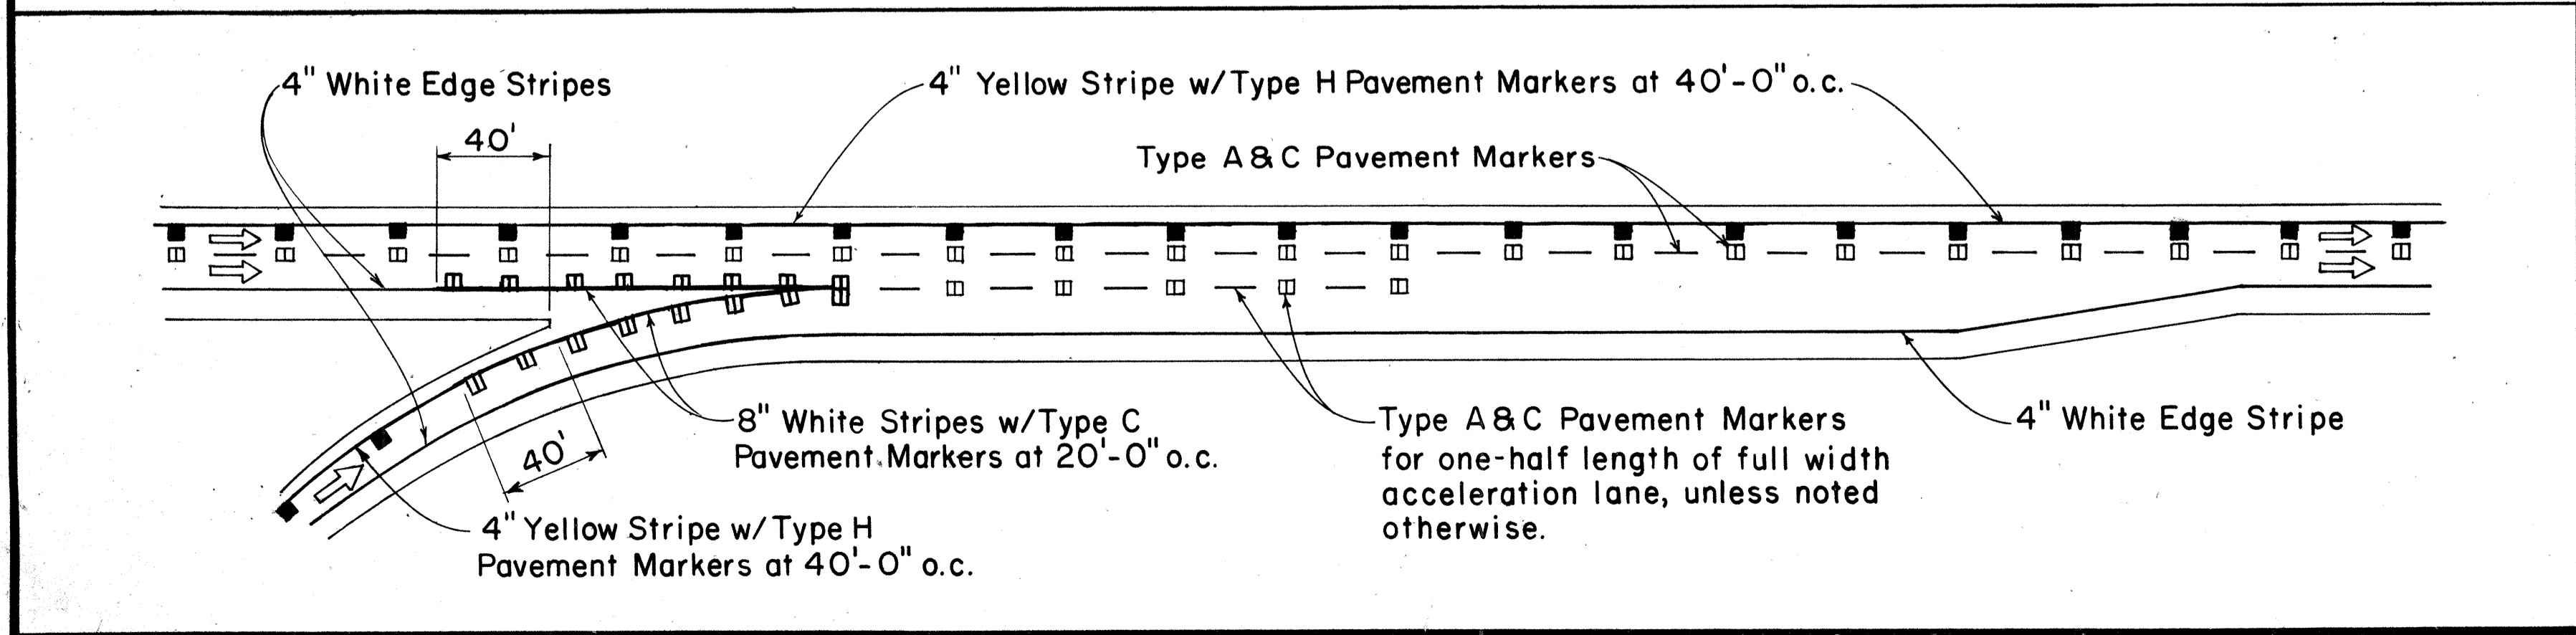

PARALLEL ACCELERATION LANE

DATE	_____
SURVEY PLOTTED BY	_____
DRAWN BY	_____
TRACED BY	_____
DESIGNED BY	_____
NOTE BOOK	_____
QUANTITIES BY	_____
CHECKED BY	_____

APPROVAL RECOMMENDED:  
*Eddie Tuma* 7/21/78  
 TRAFFIC ENGINEER DATE

APPROVED:  
*Robert S. Zakeishi* 7/24/78  
 ASSISTANT CHIEF, ENGINEERING DATE


NO.	REVISION	APPROVED BY	DATE
1	Revised Typical Roadway Entrance Markings and Typical Roadway Exit Markings.	E.T.	7/18/78

STATE OF HAWAII  
 DEPARTMENT OF TRANSPORTATION  
 HIGHWAYS DIVISION


**STANDARD DETAILS**  
**MISCELLANEOUS**  
**PAVEMENT MARKINGS**

Not to Scale July 1978  
 SHEET No. OF SHEETS DT 304


FED. ROAD DIST. NO.	STATE	FED. AID PROJ. NO.	FISCAL YEAR	SHEET NO.	TOTAL SHEETS
HAWAII	HAW.	1R-HI-1(89)	1986	C.O. 99 S-1	99

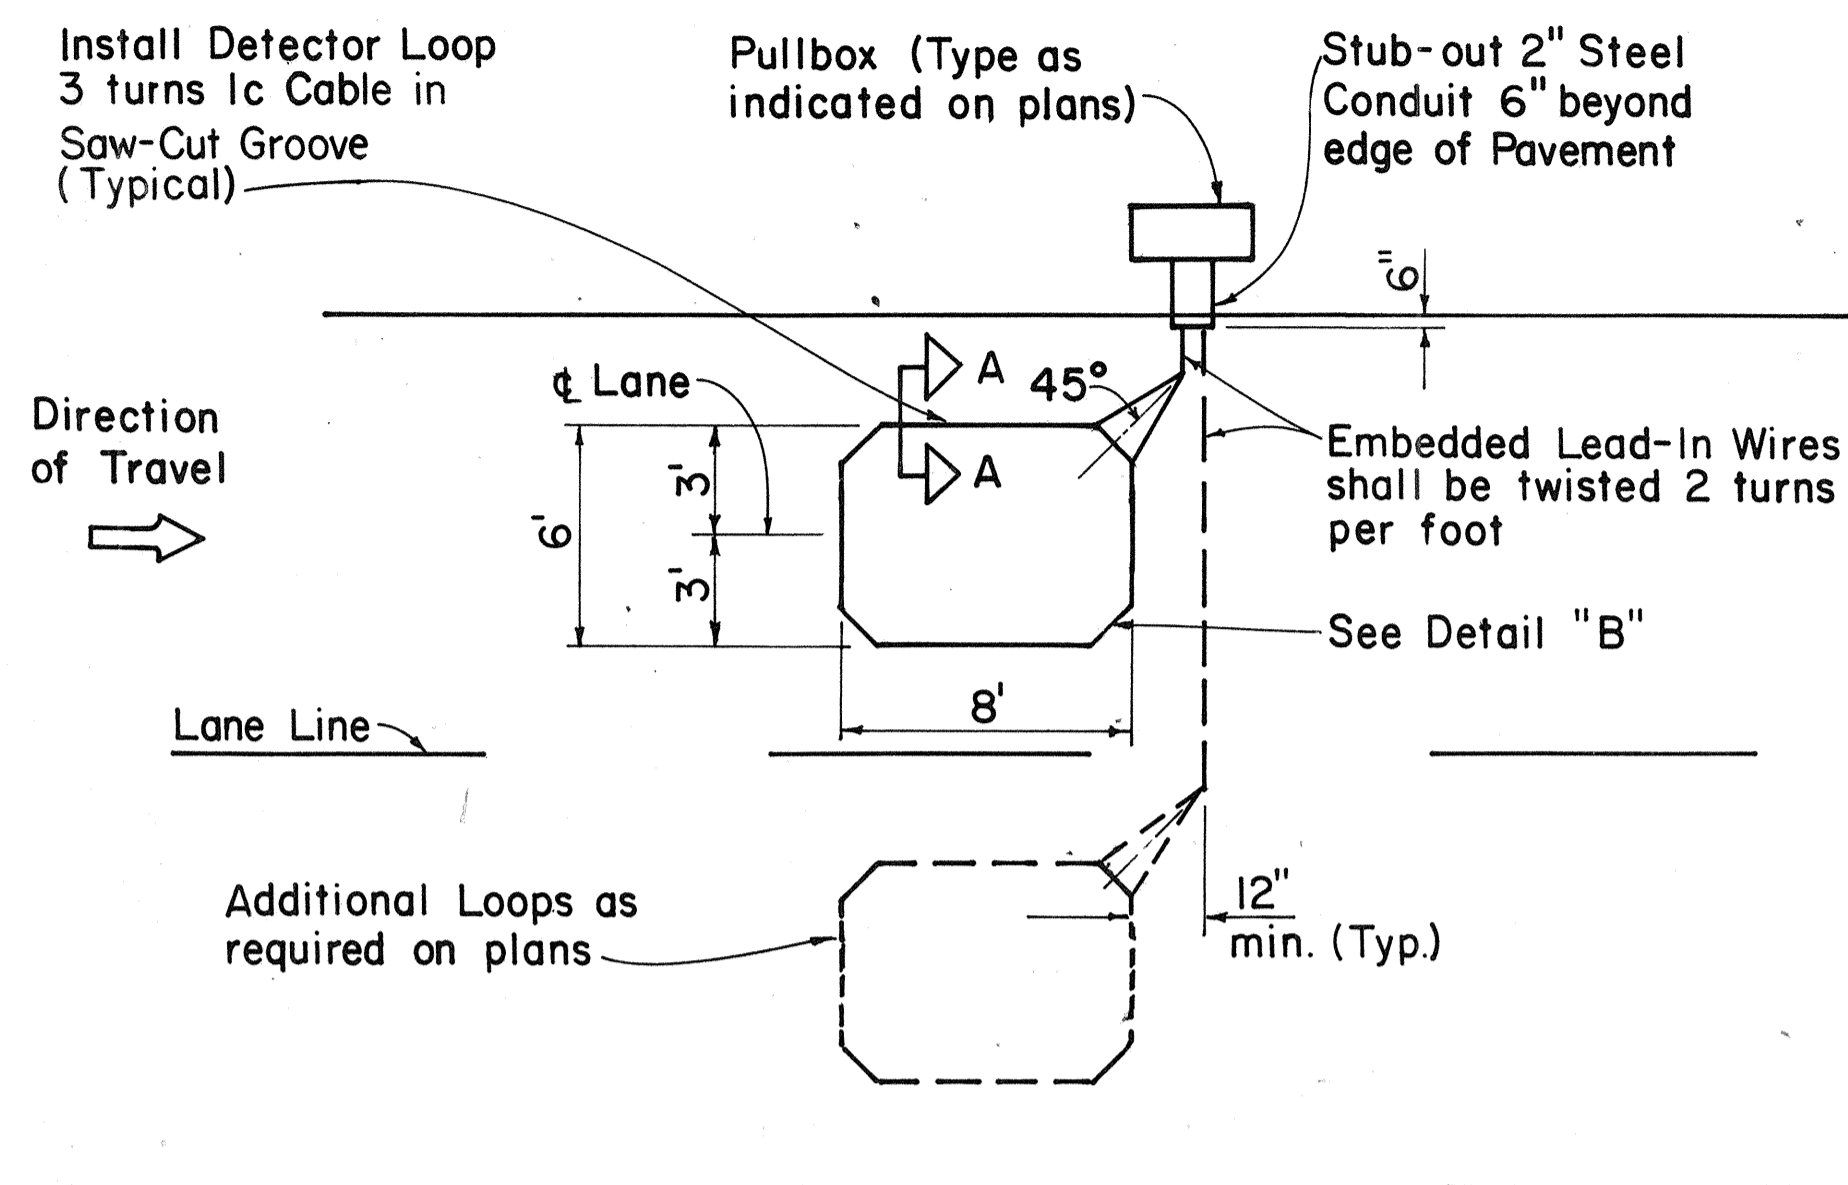

**SINGLE LOOP LAYOUT**

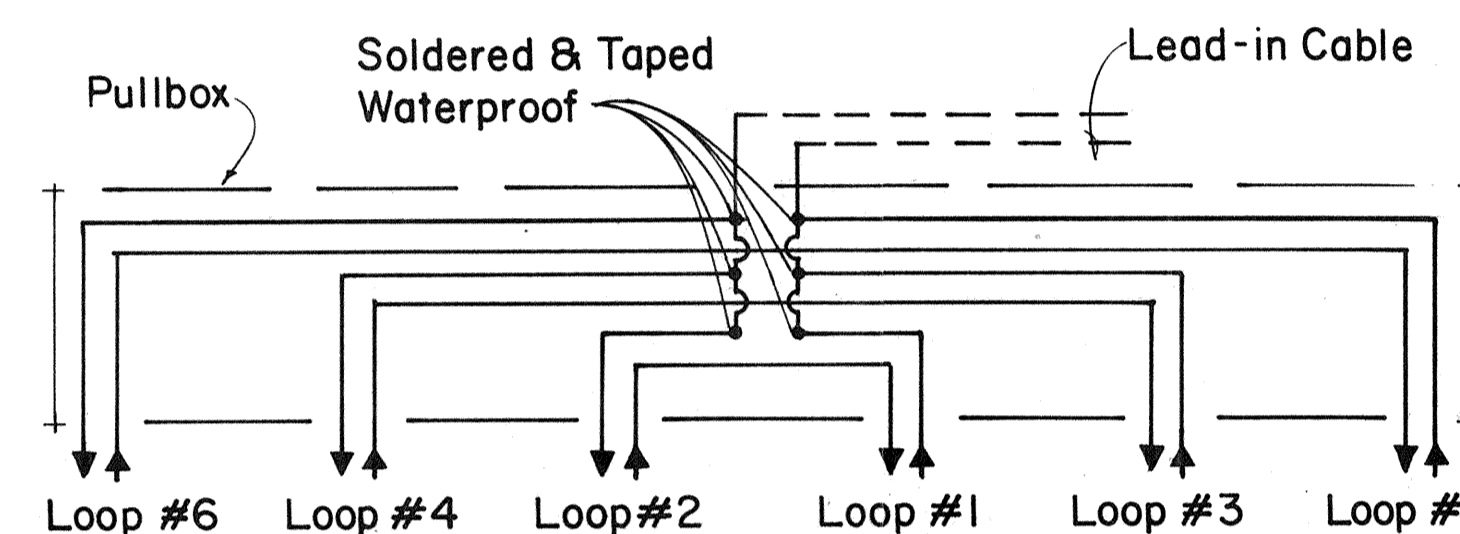


**TYPICAL SERIES-PARALLEL LOOP CONNECTION**

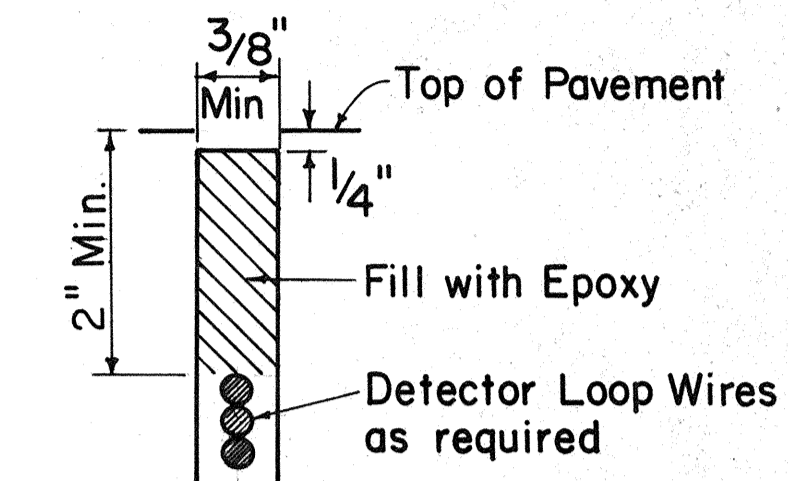


**DETECTOR LOOP SAW-CUT SECTION A-A (TYPICAL)**


Note: Back-Fill Over-Cuts with Epoxy

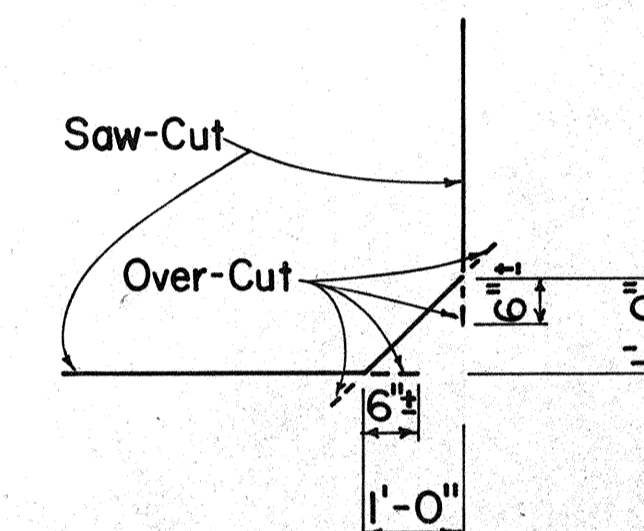

**DETAIL "B" SAW-CUT AT CORNERS**

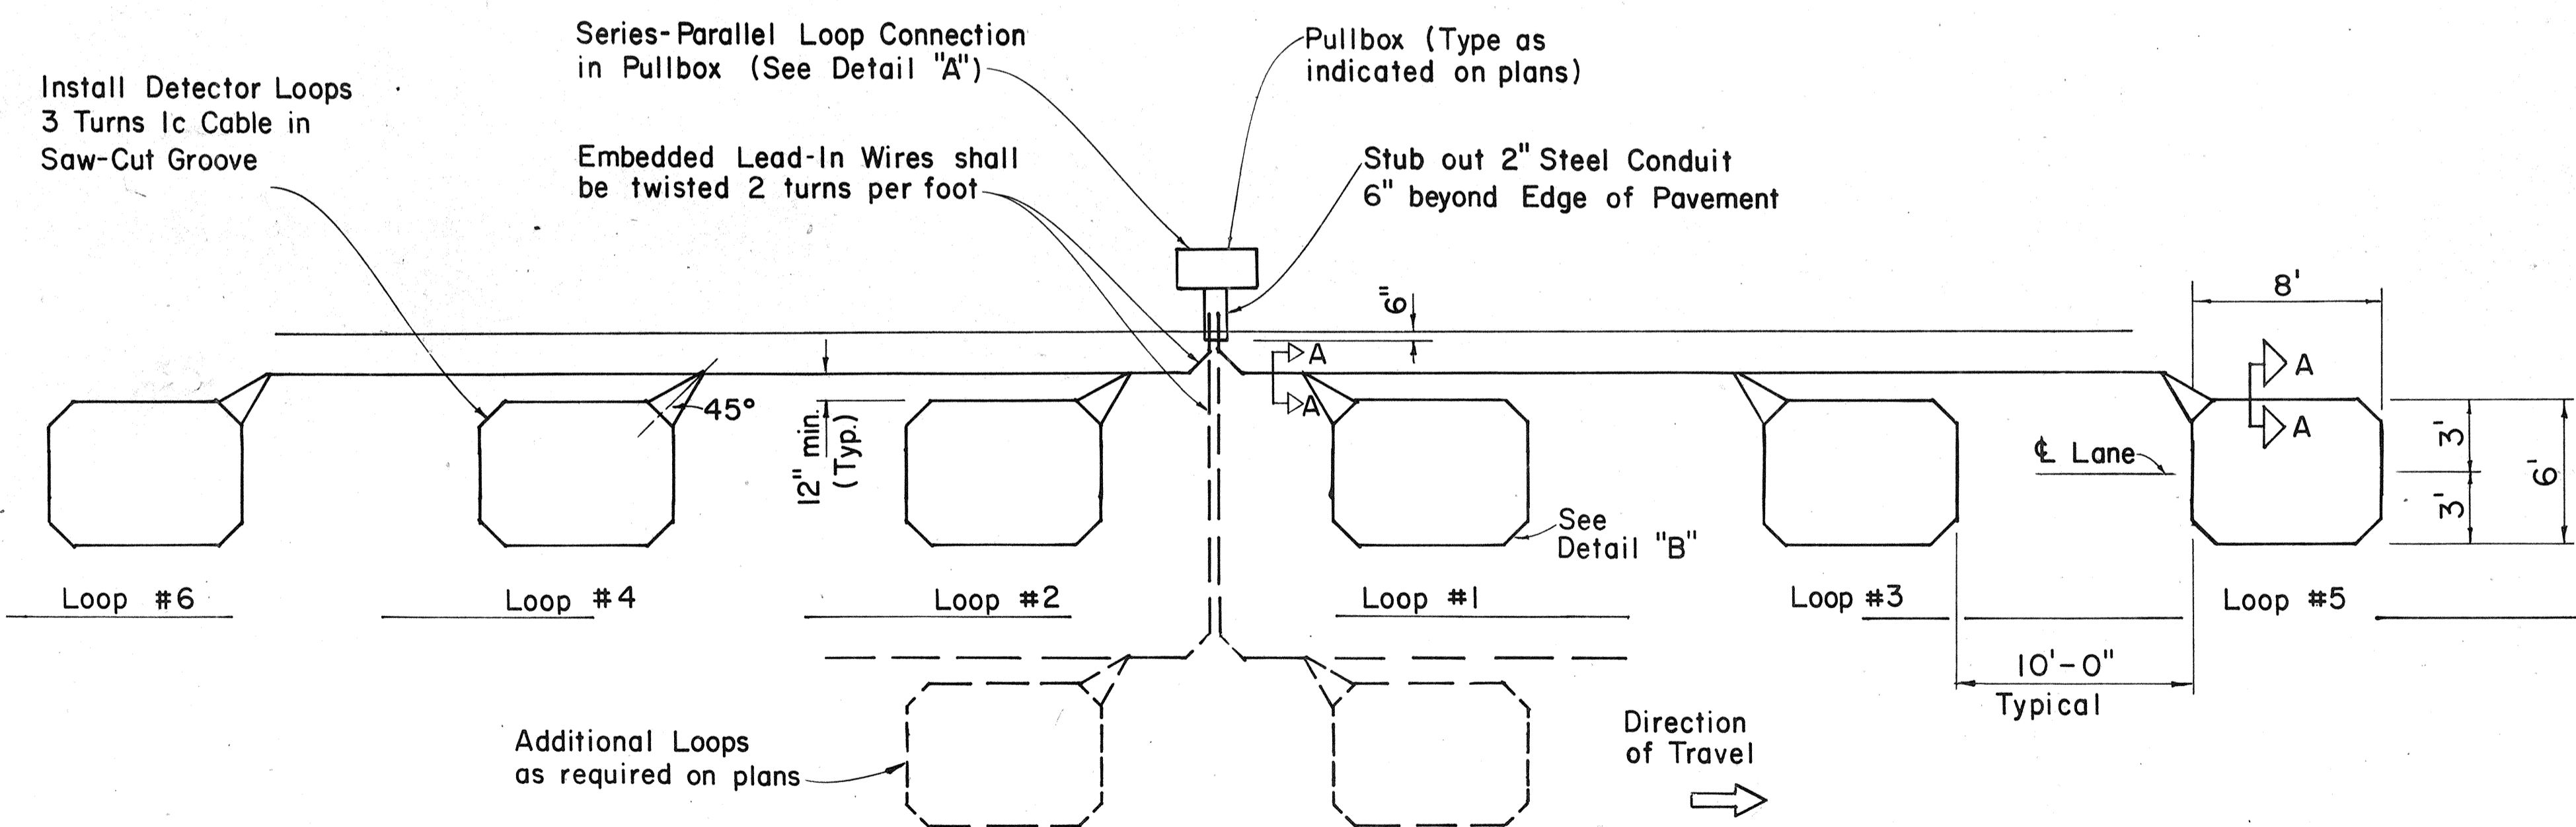

**MULTIPLE LOOP LAYOUT**

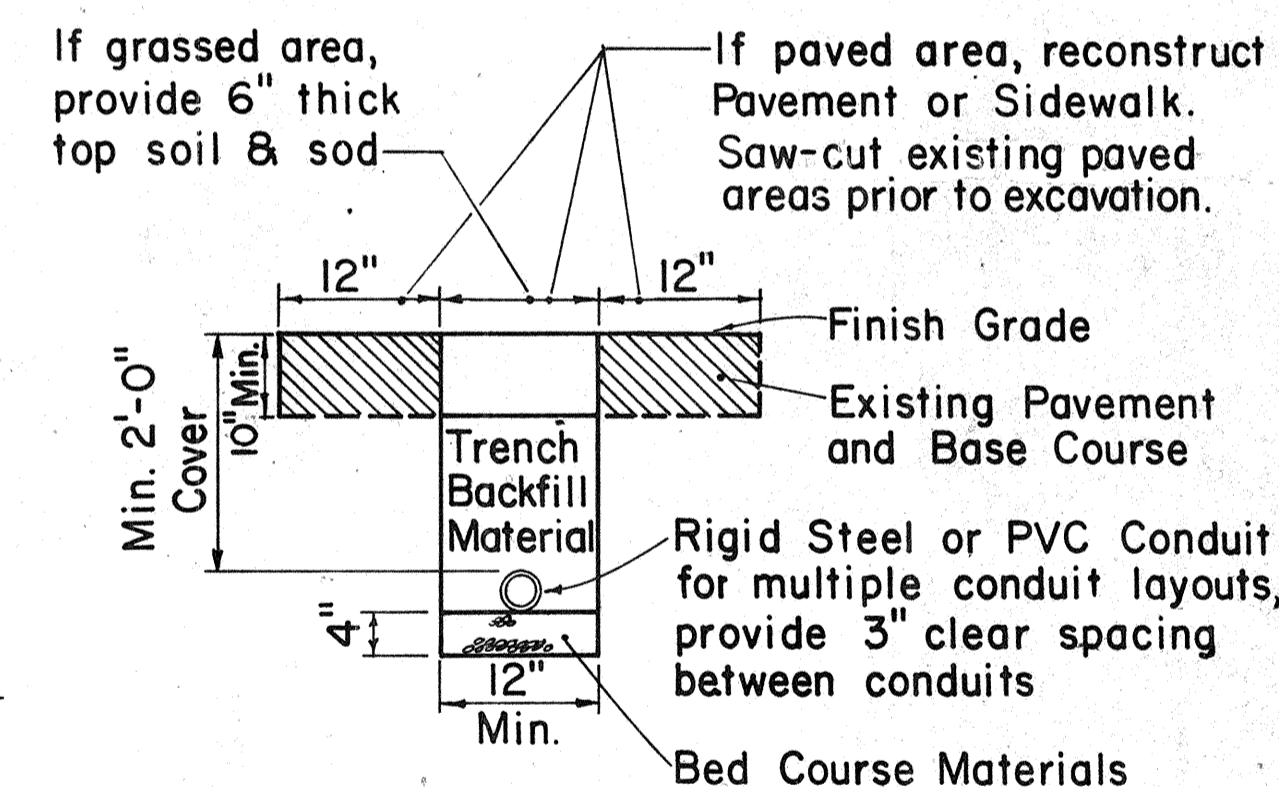

**TYPICAL TRENCH SECTION FOR CONDUIT**

NOTE:

- All conduits under roadways shall be steel or PVC schedule 80.

APPROVAL RECOMMENDED:

*Eiichi Tanaka* 9/26/80  
TRAFFIC ENGINEER DATE

APPROVED:

*Shobur Zafar* 9/30/80  
ASSISTANT CHIEF, ENGINEERING DATE

NO.	REVISION	APPROVED BY	DATE
1	Replaces Sht. DT 405 dated 3/5/76	H.I.	9/30/80
2	Revised Section A-A	H.I.	5/15/81
3	Revised Loop Design & Deleted Wiring Diagram	<i>[Signature]</i>	2-4-85
4	Revised Typical Section for conduit and note Deleted #14 from Loop Layout	E.T.	9/18/85

STATE OF HAWAII  
DEPARTMENT OF TRANSPORTATION  
HIGHWAYS DIVISION

**STANDARD DETAILS**

**LOOP DETECTORS**

Not to Scale

SHEET No. OF SHEETS DT 405

CONTRACT CHANGE ORDER NO. 17

DATE \_\_\_\_\_  
SURVEY PLOTTED BY \_\_\_\_\_  
DRAWN BY \_\_\_\_\_  
DESIGNED BY \_\_\_\_\_  
NOTE BOOK NO. \_\_\_\_\_  
QUANTITIES BY \_\_\_\_\_  
CHECKED BY \_\_\_\_\_  
No. \_\_\_\_\_