

STRUCTURAL NOTES

DESIGN SPECIFICATION:

AASHTO Standard Specifications for Highway Bridges (13th edition)
with 1984 Interim Specifications

DESIGN LIVE LOAD

HS-20-44
Interstate Loading

ALLOWABLE DESIGN STRESSES

Reinforced concrete : $f_c = 0.40 f'_c$
Reinforcing steel : $f_s = 20,000$ p.s.i. for Grade 40
Prestressed concrete: See Design Specifications
Structural steel : See Design Specifications

MATERIALS

Reinforced concrete : Class A unless noted otherwise
Class BD for bridge deck
Reinforcing steel : ASTM A615 Grade 40
Structural steel : ASTM A36, hot dipped galvanized after fabrication
Prestressed concrete: See Sht. Q2
Admixture in concrete : See Specifications for Road and Bridge
Construction (1985).

CONSTRUCTION METHODS

- See current edition (1985) of Hawaii Standard Specifications for Road and Bridge Construction and Special Provisions.
- Spread footings for Piers shall be excavated and poured neat against undisturbed ground. In case of over excavation, space between footing and ground shall be filled with concrete at the Contractor's expense and as directed by the Engineer. The minimum quality of the fill concrete shall be Class D.
- In general, top of concrete deck slab shall be constructed to follow the finish roadway vertical and horizontal curves and grades.
- Girder concrete seats and creep blocks shall be poured monolithically with the supporting structures. Top surfaces of concrete seats shall have a steel trowel finish, smooth, level (transversely) and true to grade, with deviation from a level plane not exceeding $1/16$ inch.
- Except as otherwise noted, all vertical dimensions are measured plumb.
- All items designated for removal shall be removed in such a manner as to preclude any damage to the existing structure. Large impacting or vibratory types of equipment will not be permitted in the removal operation, nor in drilling holes for dowels. Small vibratory tools approved by the Engineer, will be permitted.
- Where portion of concrete is to be removed, or saw cut is called for, the line of separation between the portions that is to remain & be removed, shall be saw cut to a minimum depth of $1 1/2$ inch or to the depth of the reinforcements.
- The Contractor shall be responsible for the protection of the existing and new structures from damage due to construction, and shall repair any damage at his expense, to the satisfaction of the Engineer.
- The contractor shall be responsible for the location of existing reinforcement by whatever means, including the use of scanning devices, in his drilling operations.

CONSTRUCTION METHODS (cont.)

- All existing reinforcing, that can be incorporated in the new work, shall be cleaned and utilized as required in the new work, as directed by the Engineer.
- Existing reinforcing, that cannot be incorporated in the new work, shall be removed to a minimum depth of one inch beneath finish surface, and the resultant depression patched with mortar.
- Deck concrete area, left exposed due to the removal of existing concrete, shall be ground smooth and grooved to extend the existing roadway grade.


GENERAL

- All items noted incidental will not be paid for separately.
- The contractor shall verify the location of all existing utility lines and notify the respective owners before commencing with work.
- The bottom of all elastomeric and preformed fabric bearing pads shall be secured to concrete seats, to prevent displacement, with adhesives approved by the Engineer.
- Except as otherwise noted on drawings, all exterior corners & re-entrant angles 90° or less in concrete work shall be chamfered $3/4" \times 3/4"$.
- For concrete finish see standard specifications and/or Special Provisions.
- Standard Detail Drawings refer to all structures in general except for modifications as may be required for special conditions. Per such modifications refer to corresponding detailed drawings.

FED. ROAD DIST. NO.	STATE	FED. AID PROJ. NO.	FISCAL YEAR	SHEET NO.	TOTAL SHEETS
HAWAII	HAW.	12-H1-1(189)	1986	52	99

INDEX

SHEET NO.	DESCRIPTION
51	INDEX, GENERAL STRUCTURAL NOTES & LOCATION PLAN
	<u>PALEHUA SEPARATION</u>
52	LAYOUT PLAN, LONGITUDINAL SECTION, & ESTIMATED QUANTITIES
53	ABUTMENT ① & ② - PLAN, ELEVATION, TYPICAL ABUTMENT SECTION, & TYPICAL STRUCTURE EXCAVATION DETAILS
54	ABUTMENT ① & ② - SECTIONS
55	NORMAL DECK SECTION, DECK FRAMING PLAN, BM "A" & "A" DETAILS
56	TYPICAL PRESTRESSED CONCRETE PLANKS
	<u>HONOULIULI STREAM BRIDGE</u>
57	LAYOUT PLAN, LONGITUDINAL SECTION & ESTIMATED QUANTITIES
58	ABUTMENT ① & ② - PLAN, ELEVATION, TYPICAL ABUTMENT SECTION, & TYPICAL STRUCTURE EXCAVATION DETAILS
59	ABUTMENT ① & ② - SECTIONS
510	PIER DETAILS
511	NORMAL DECK SECTION, DECK FRAMING PLAN & BEAM "B" DETAILS
512	BEAM "A" & "C" DETAILS
Q1	TYPICAL DETAILS - GIRDER CONCRETE SEAT & CREEP BLOCK DETAILS
Q2	TYPICAL DETAILS - PRESTRESSED GIRDER DETAILS
Q3	TYPICAL DETAILS - CONCRETE BRIDGE RAILING (2'-8" BARRIER TYPE)
Q4	TYPICAL DETAILS - METAL GUARD RAIL CONNECTION AT CONCRETE END POST
Q5	TYPICAL DETAILS - REPLACEMENT OF BRIDGE DECK JOINT SEALS DETAILS
P1	KUNIA I.C. STRUCTURE - REPLACEMENT OF INBOUND APPROACH BRIDGE RAIL
DB-100	STANDARD DETAILS - NOTES & MISCELLANEOUS DETAILS
	<u>REFERENCE PLANS</u>
01-03	EXISTING BRIDGE - PALEHUA SEPARATION
04-07	EXISTING BRIDGE - HONOULIULI STREAM BRIDGE

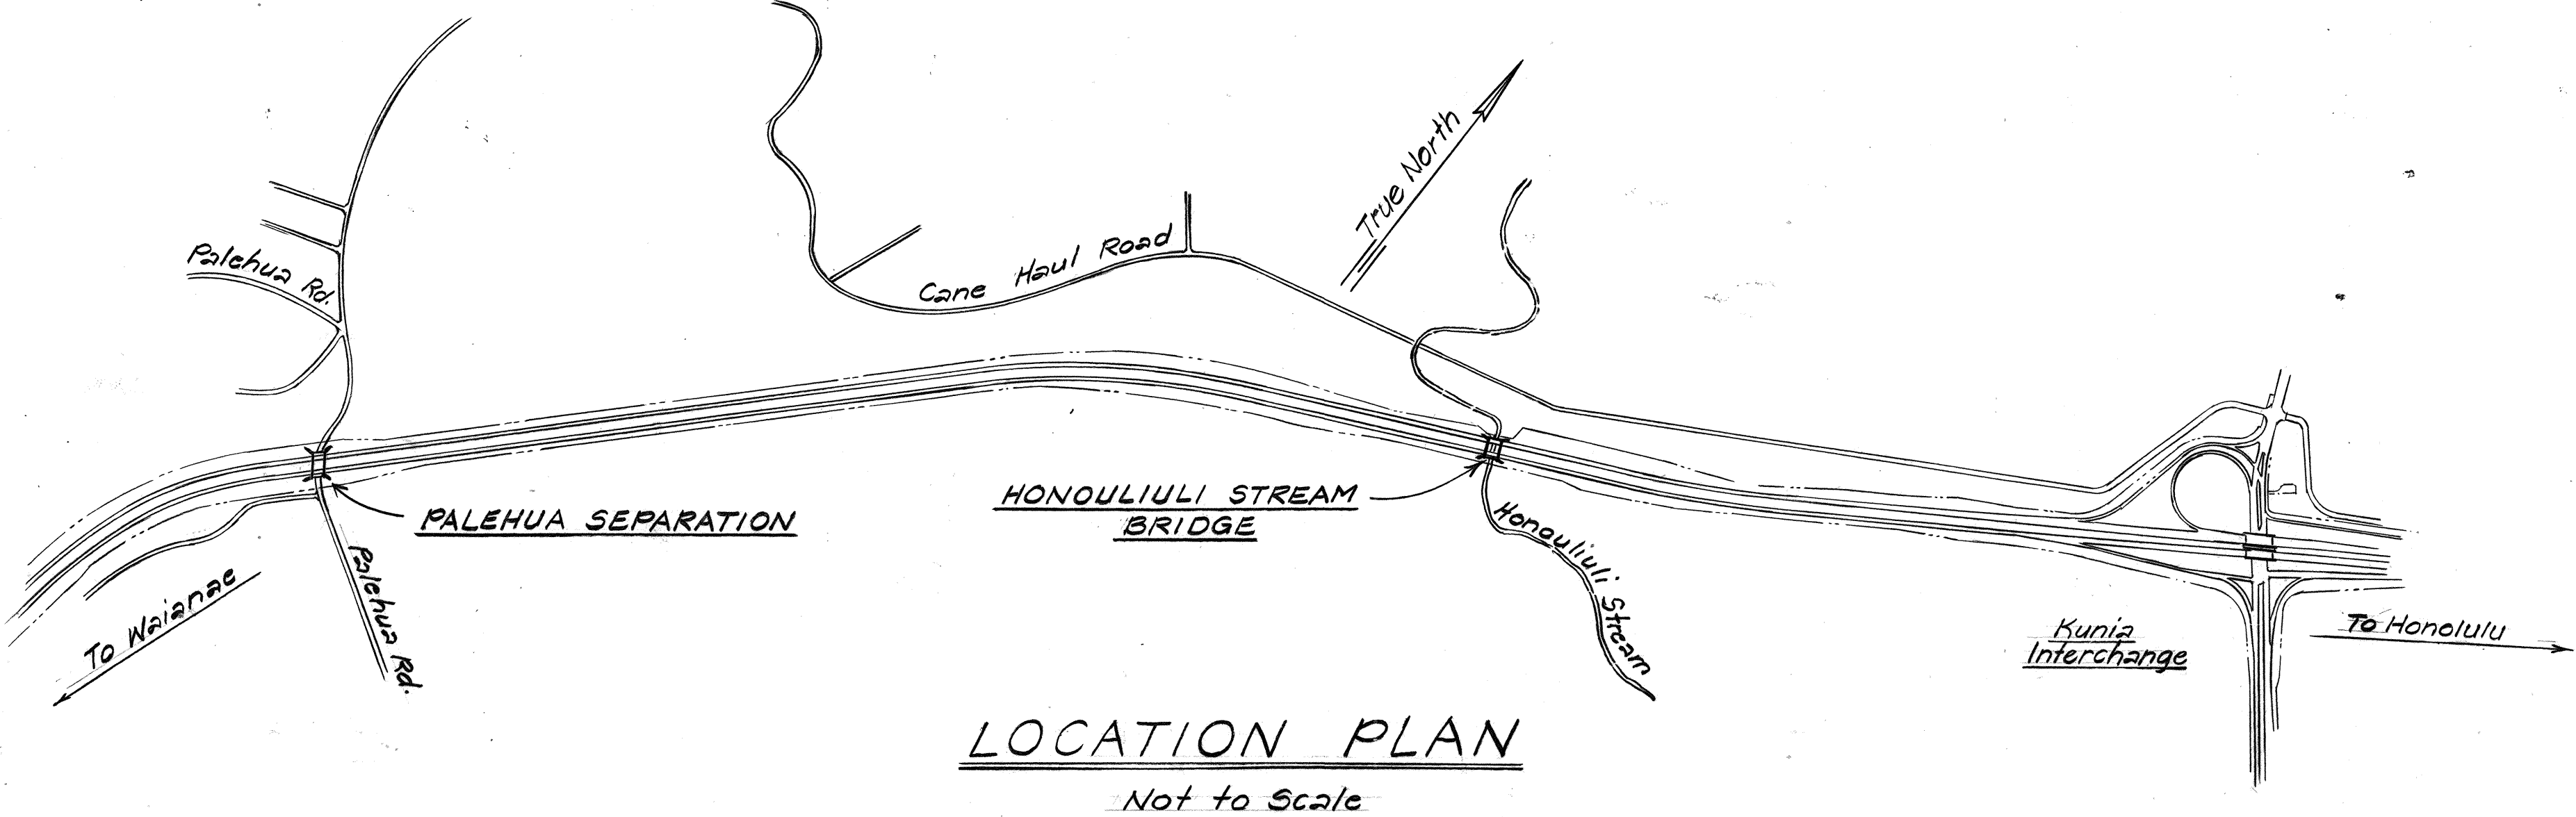

STATE OF HAWAII
DEPARTMENT OF TRANSPORTATION
HIGHWAYS DIVISION

**PALEHUA SEPARATION
HONOULIULI STREAM BRIDGE
WIDENING**

INDEX, NOTES, & LOCATION PLAN
INTERSTATE ROUTE H-1, PALAILAI I.C. TO
KUNIA I.C. CONSTRUCTION OF ADDITIONAL LANES
F.A.I. PROJ. NO. 12-H1-1(189)

Scale: As Shown Date: July 1985

SHEET No. 51 OF 12 SHEETS

The diagram illustrates the required screed grade for a new deck edge. It shows a cross-section with two vertical lines representing the bearing abutments, labeled "ε bearing Abut. #1" and "ε bearing Abut. #2". A horizontal line represents the existing deck edge. A curved line represents the screed grade, which is required to be 1/8 inch higher at the new edge of the deck. A vertical line segment labeled "1/8\" is shown at the new edge, indicating the required height. A horizontal line segment labeled "ε span" is shown between the two bearing abutments. Below the diagram, two numbered points are listed:

1. For use in determining screed grade during deck pour at new edge of deck.
2. Match grade at existing deck edge.


<u>ITEM NO.</u>	<u>ITEM</u>	<u>UNIT</u>	<u>QUANTITIES</u>
202.0441	Removal of portion of Palehua Separation	Lump Sum	(28 C.Y.)
206.6101	Structure excavation for Palehua Separation	Cu.Yd.	96 C.Y.
206.7201	Structure backfill for Palehua Separation	Cu.Yd.	42 C.Y.
206.8200	Filter material for structures	Cu.Yd.	10 C.Y.
503.1084	Deck joint seal (poured) - Palehua Separation	Lump Sum	(240 L.F.)
503.1200	Concrete in Palehua Separation	Lump Sum	(43 C.Y.)
503.1205	Concrete in footing for bridge railing	Lump Sum	(18 C.Y.)
503.1215	2-inch diameter drilled holes for dowels	Each	4 Ea.
504.7400 15	Prestressed concrete planks for structure	Lump Sum	(1,066 S.F.)
507.7600	Concrete bridge railing (2'-8" Barrier Type)	Lin Ft.	141 L.F.
602.0200	Reinforcing steel in Palehua Separation	Lump Sum	(5,000 Lbs.)
602.0205	Reinforcing steel in footing for bridge railing	Lump Sum	(1,100 Lbs.)

Exist. approach slab New approach slab

D $2'-0"$


5 x 2'-0" lg. dowels @ 2'-0" o.c.
set in 1'-0" deep x 1 1/4" holes
filled with epoxy.

Scale: $\frac{3}{4}" = 1'-0"$ (Highway Item)

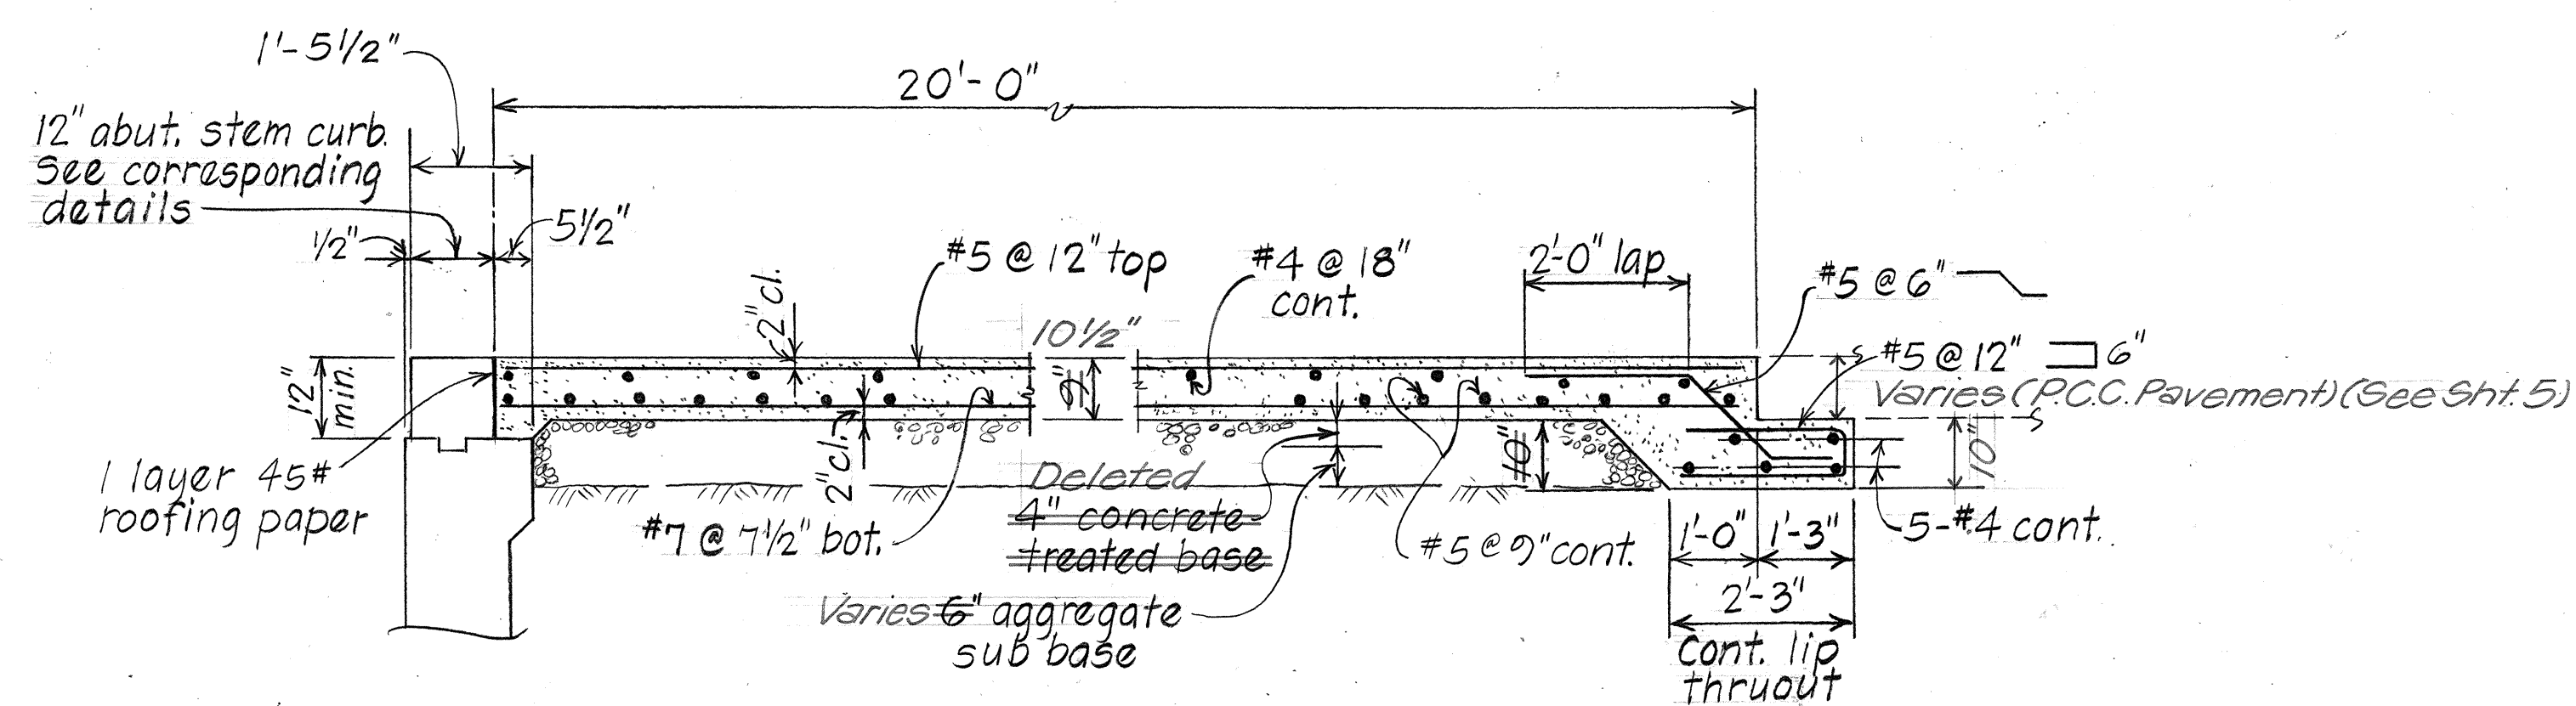

Scale: $\frac{1}{2}" = 1' - 0"$ (Highway Item)

ORIGINAL PLAN	SURVEY PLOTTED BY	DATE
	DRAWN BY	
	TRACED BY	
	DESIGNED BY	
	QUANTITIES BY	
	CHECKED BY	
No.		

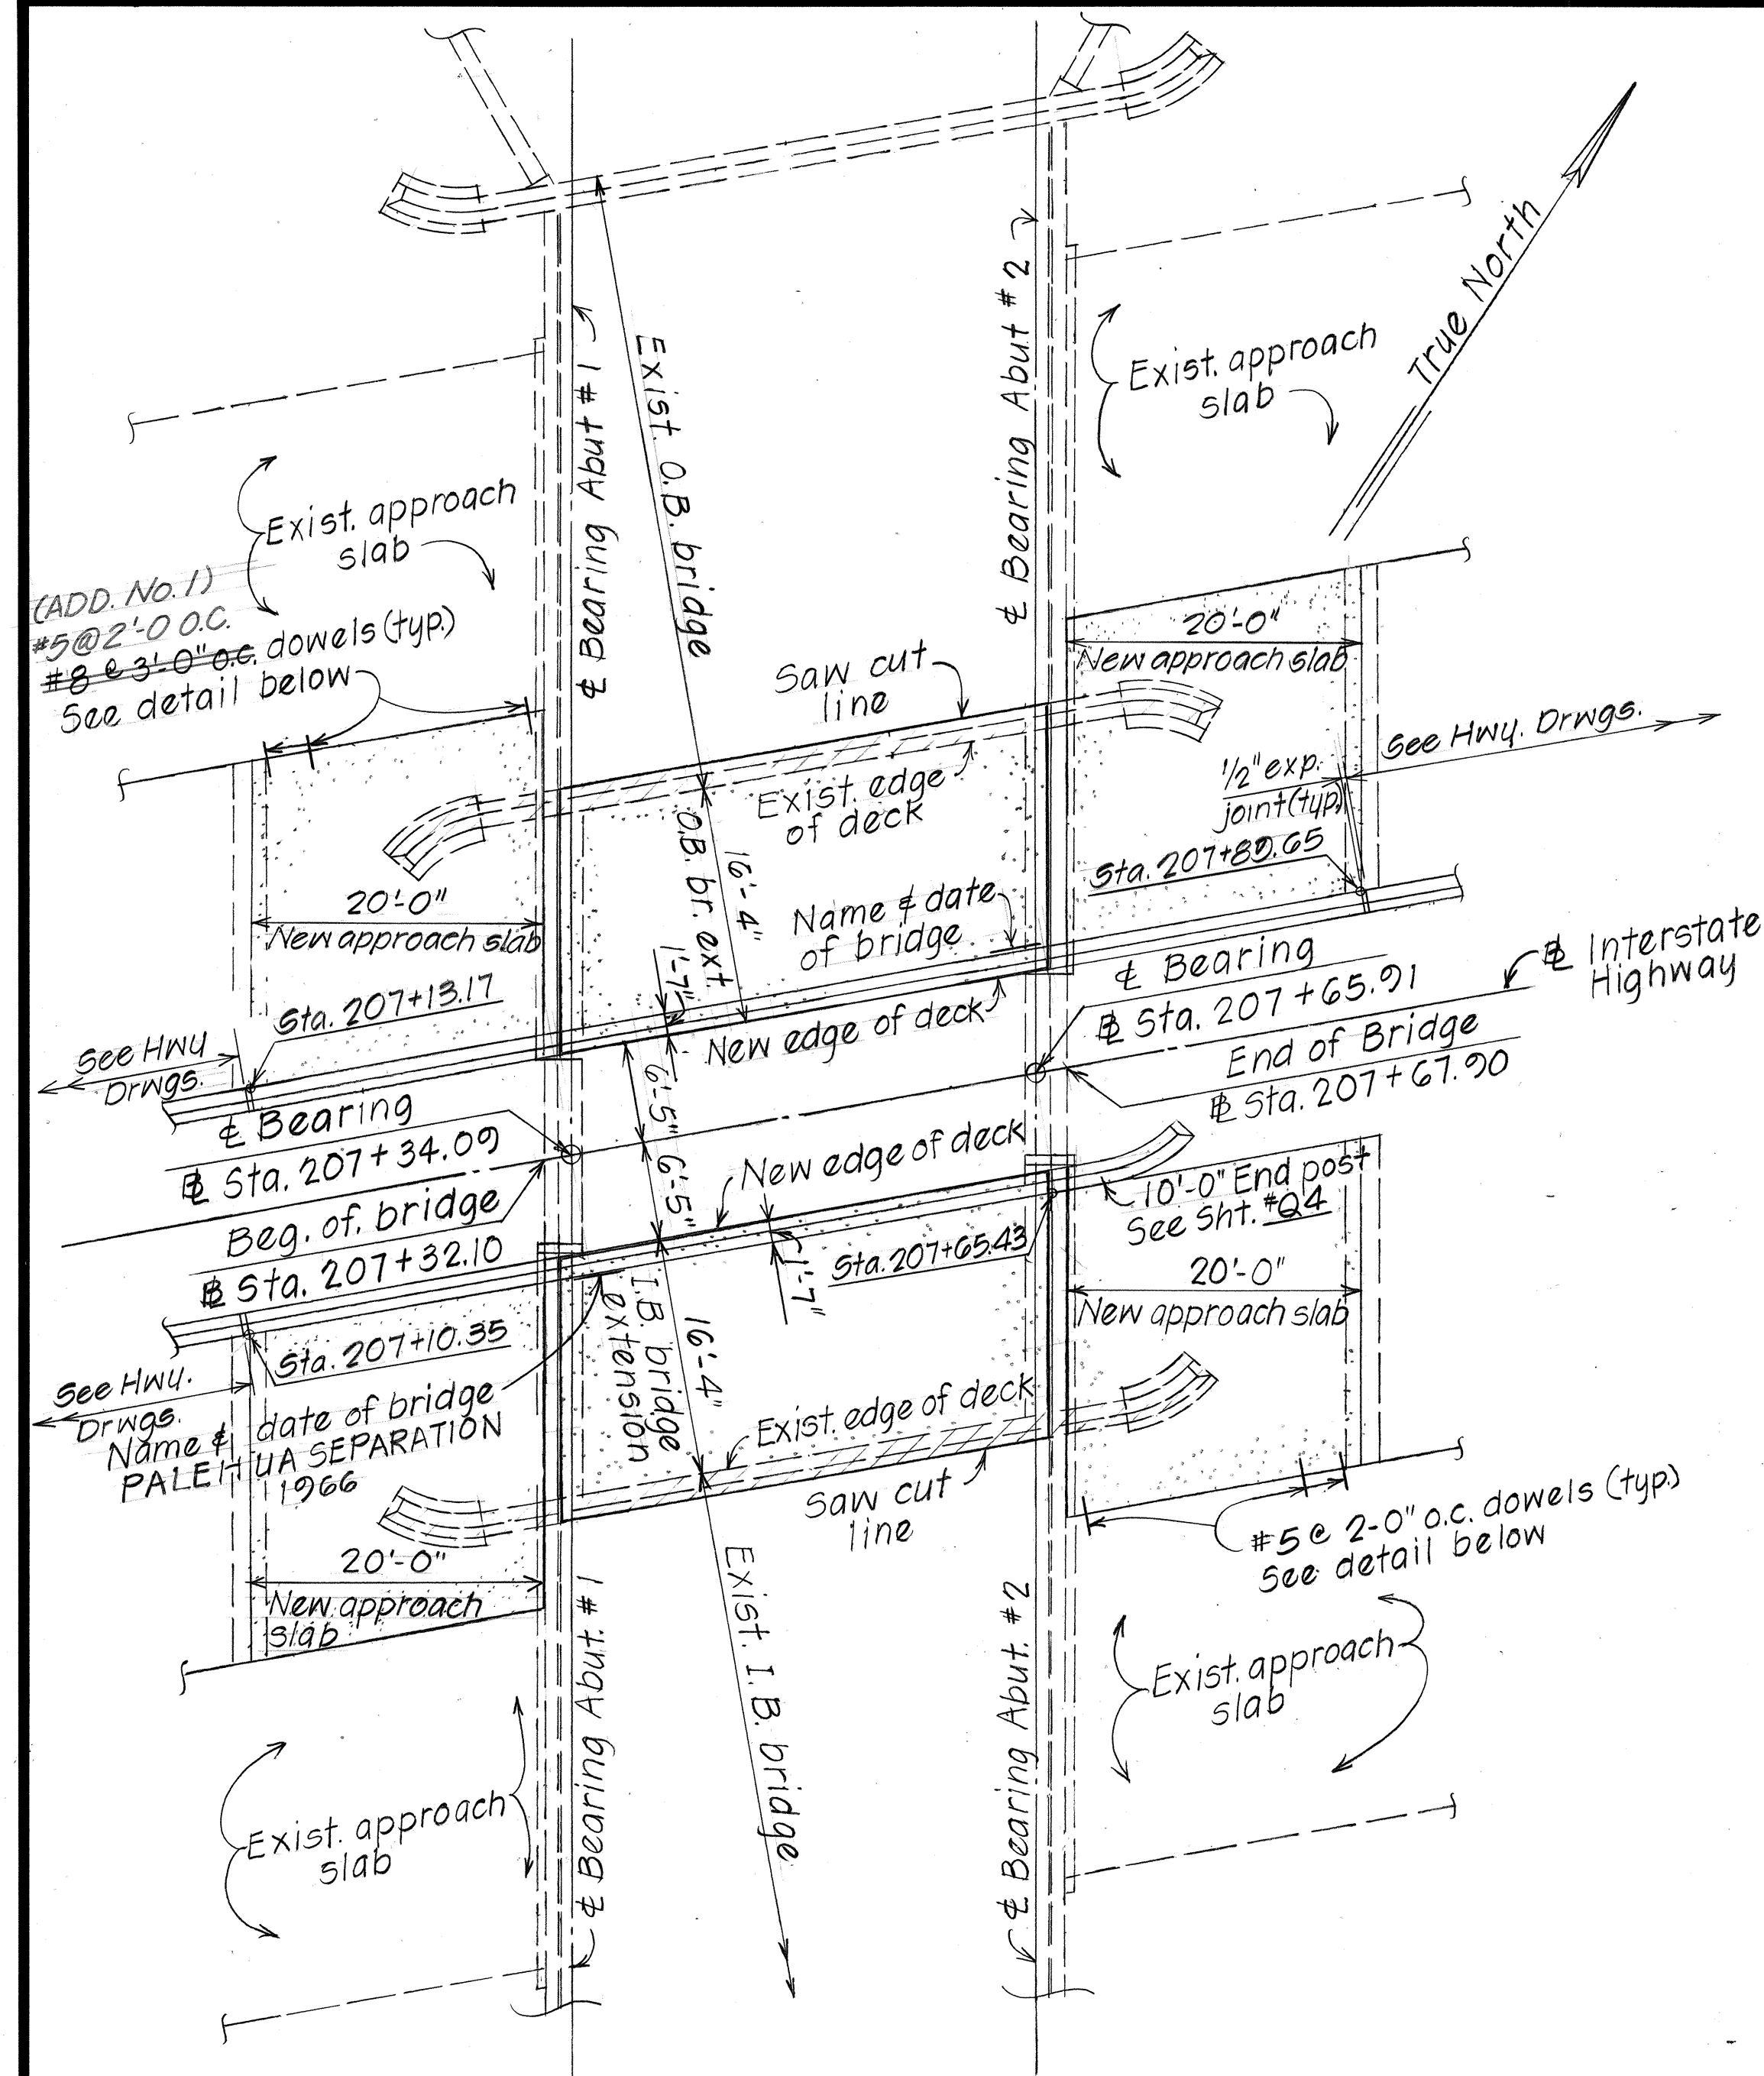

Hand-drawn cross-section diagram of a bridge structure. The diagram shows a central rectangular pier with a width of 31.82' at the top. The pier is labeled "Prestressed conc. plank" and "Ref. - Front face of wall". The top of the pier is labeled "Top of conc. deck slab & fin. grade". The pier is supported by two abutments, labeled "1" and "2", which are labeled "Abut. bearing". The pier is situated on "Palaehua Road". The diagram also shows "Fin. gr." (finished grade) on the right side. The pier is labeled "MEASURE" at the bottom.

LONGITUDINAL SECTION ALONG &
INBOUND OR OUTBOUND BRIDGE Scale: 1"=10'-0"

STATE OF HAWAII
DEPARTMENT OF TRANSPORTATION
HIGHWAYS DIVISION


PALEHUA SEPARATION WIDENING
LAYOUT PLAN, ESTIMATED QUANTITIES

INTERSTATE ROUTE H-1, PALAILAI I.C. TO
KUNIA I.C. CONSTRUCTION OF ADDITIONAL LANES
F.A.I. Proj. No. IR-HI-1(189)

Scale: As Shown Date: July 1985

SHEET No. 52 OF 12 SHEETS



FED. ROAD DIST. NO.	STATE	FED. AID PROJ. NO.	FISCAL YEAR	SHEET NO.	TOTAL SHEETS
HAWAII	HAW.	IR-HI-1(189)	1986	54	99

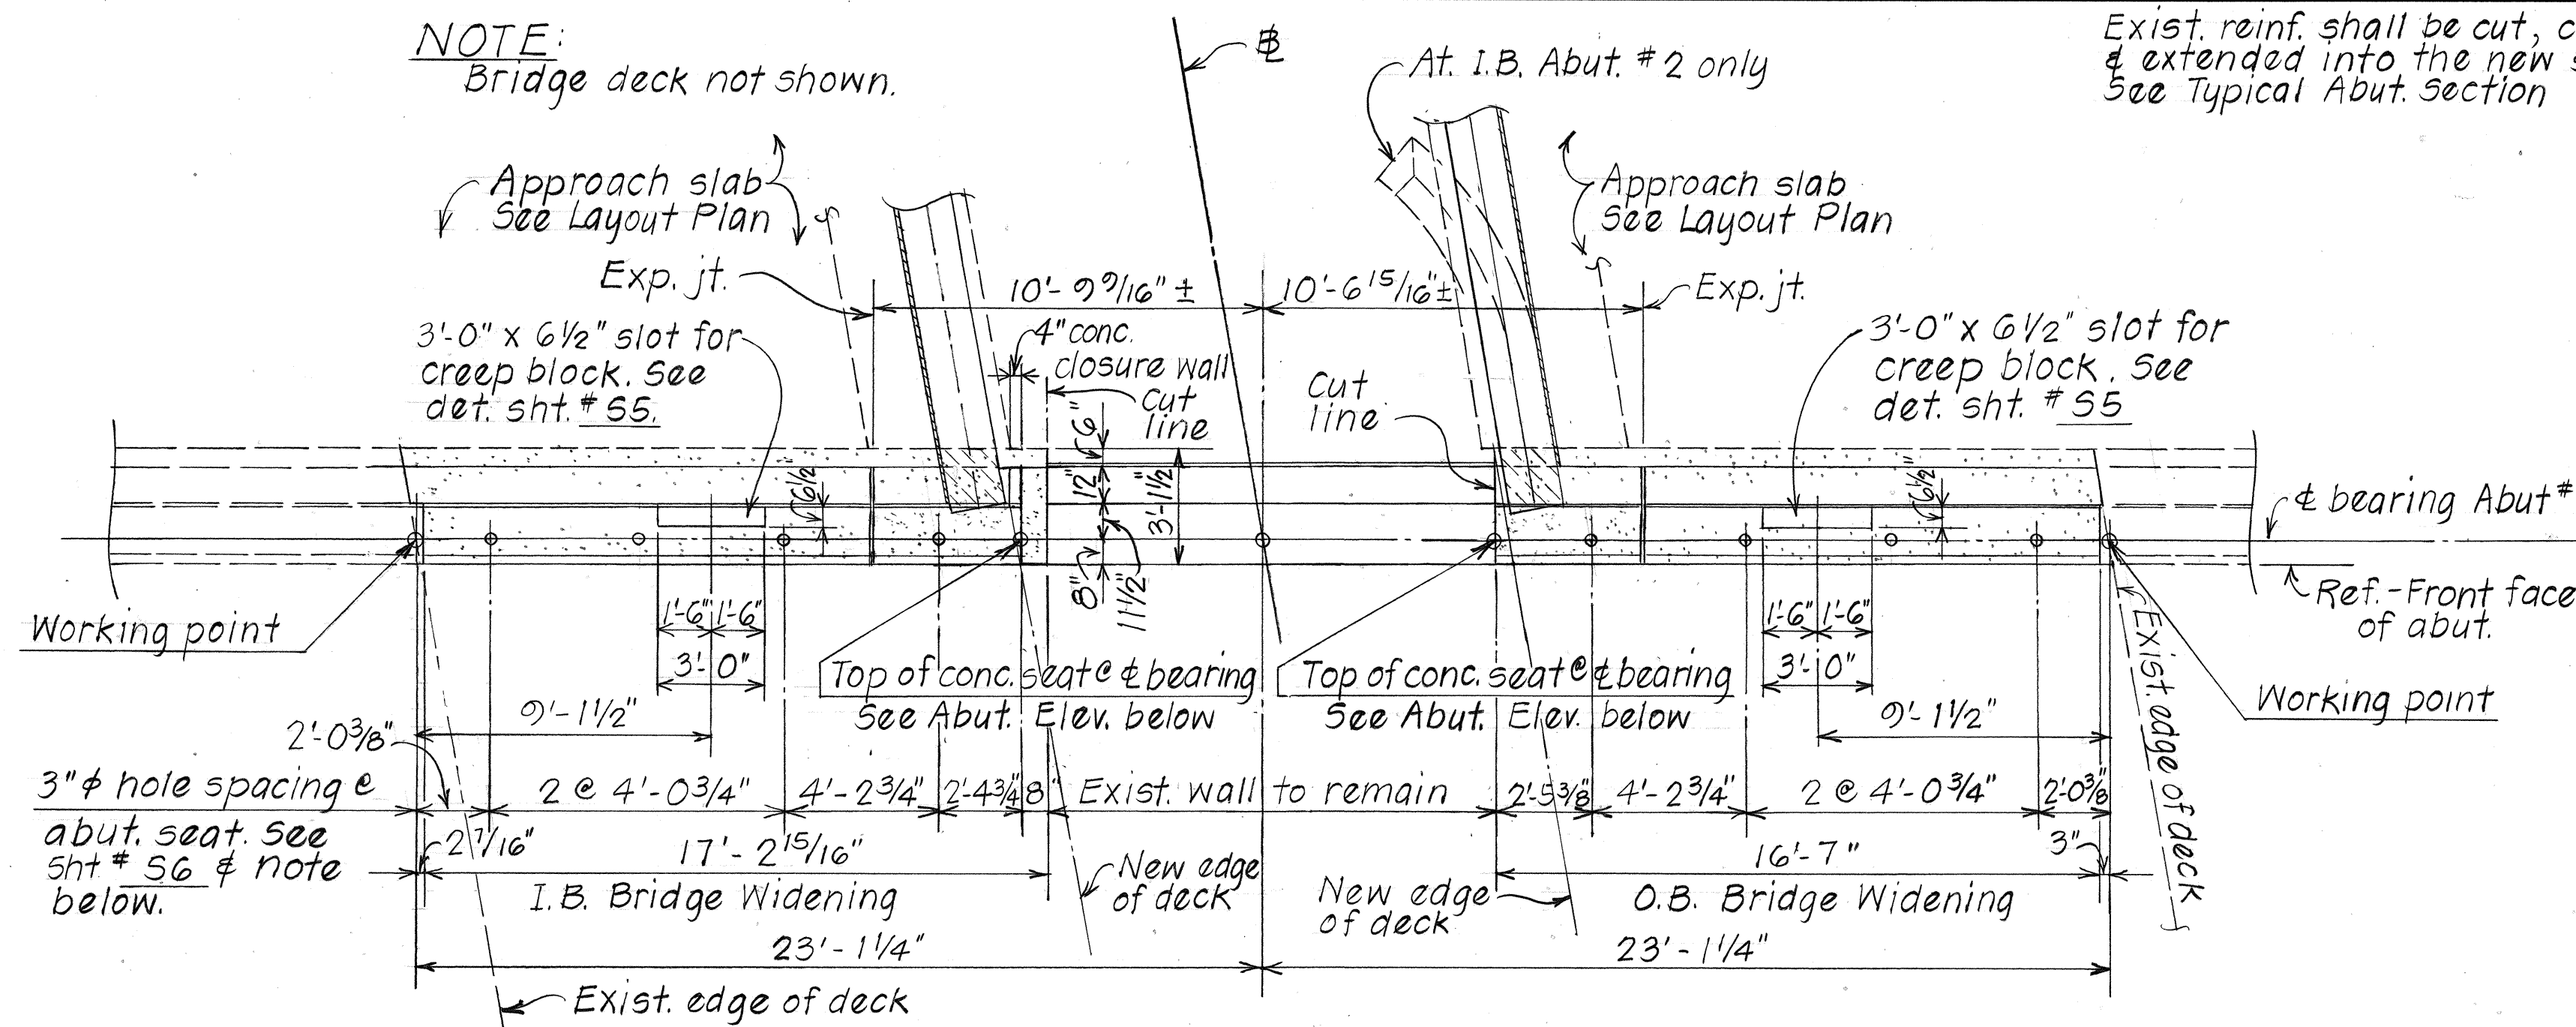


PLAN-ABUTMENT NO. 1

(ABUTMENT NO. 2 - 180° ROTATION WITH REVERSED TRAVELWAY)

Scale: 1/4" = 1'-0"

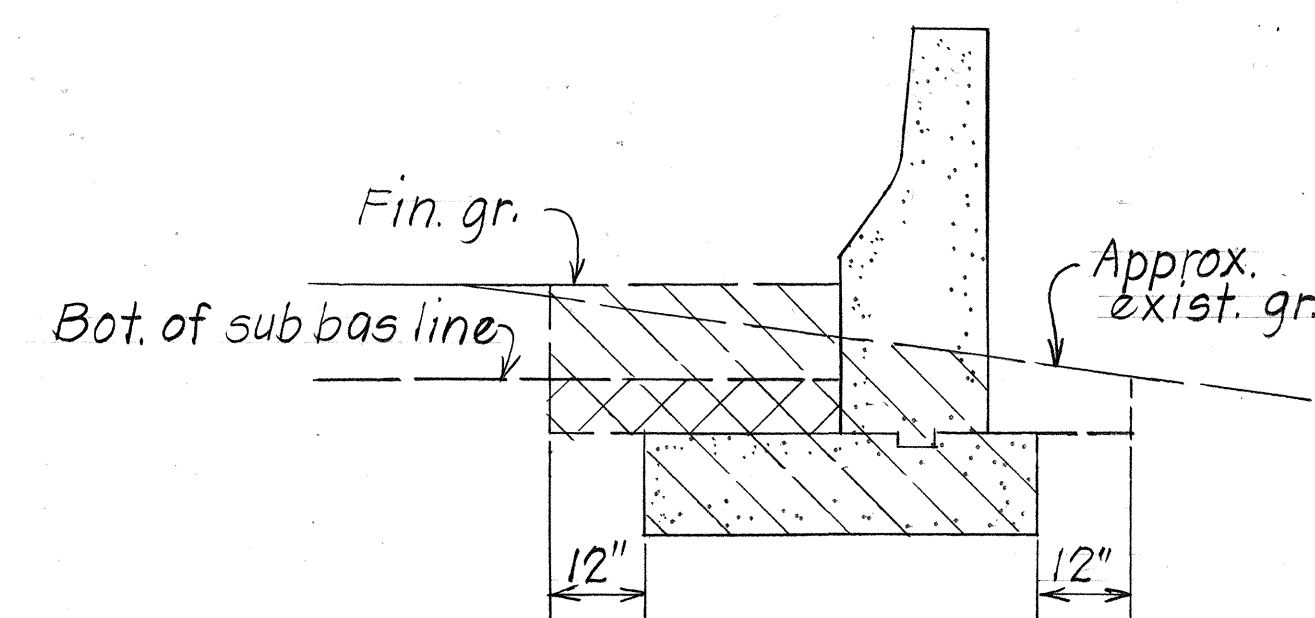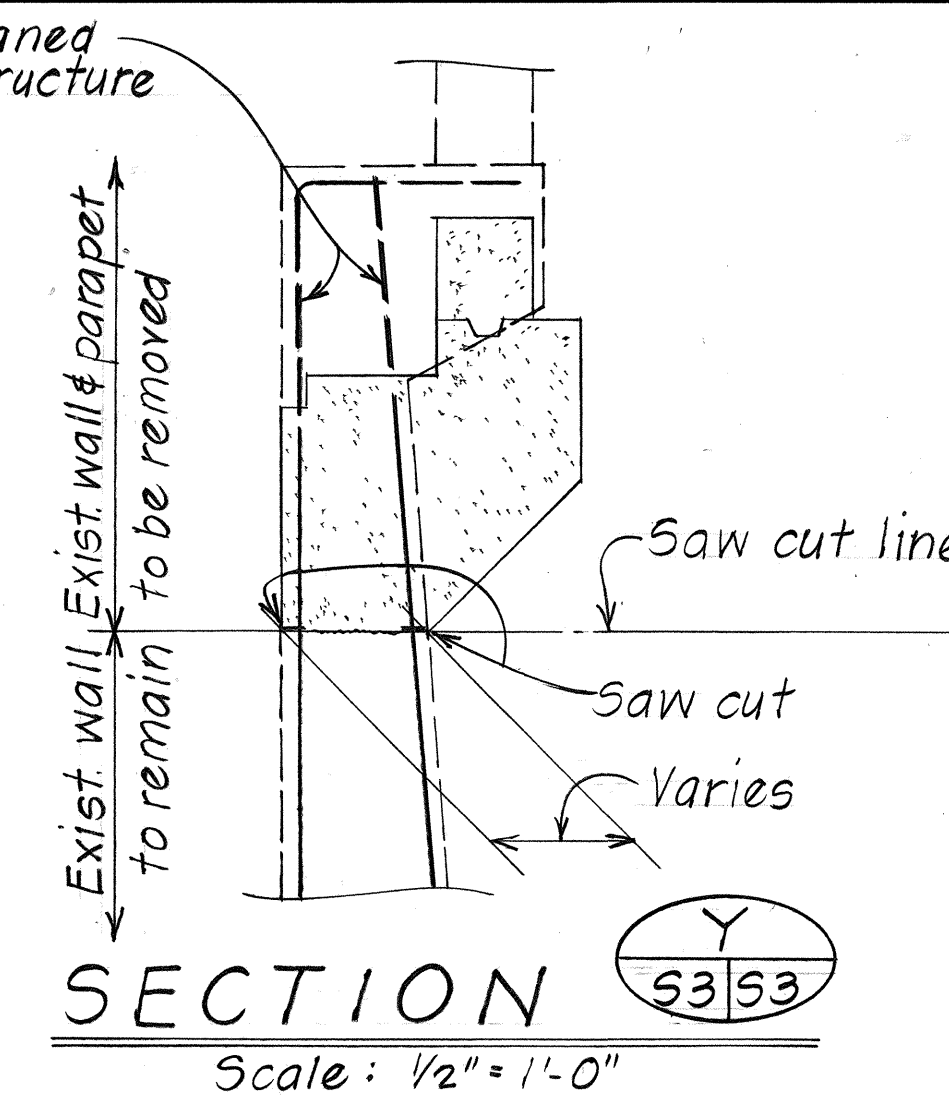


AT CONCRETE RAIL "RT-B"

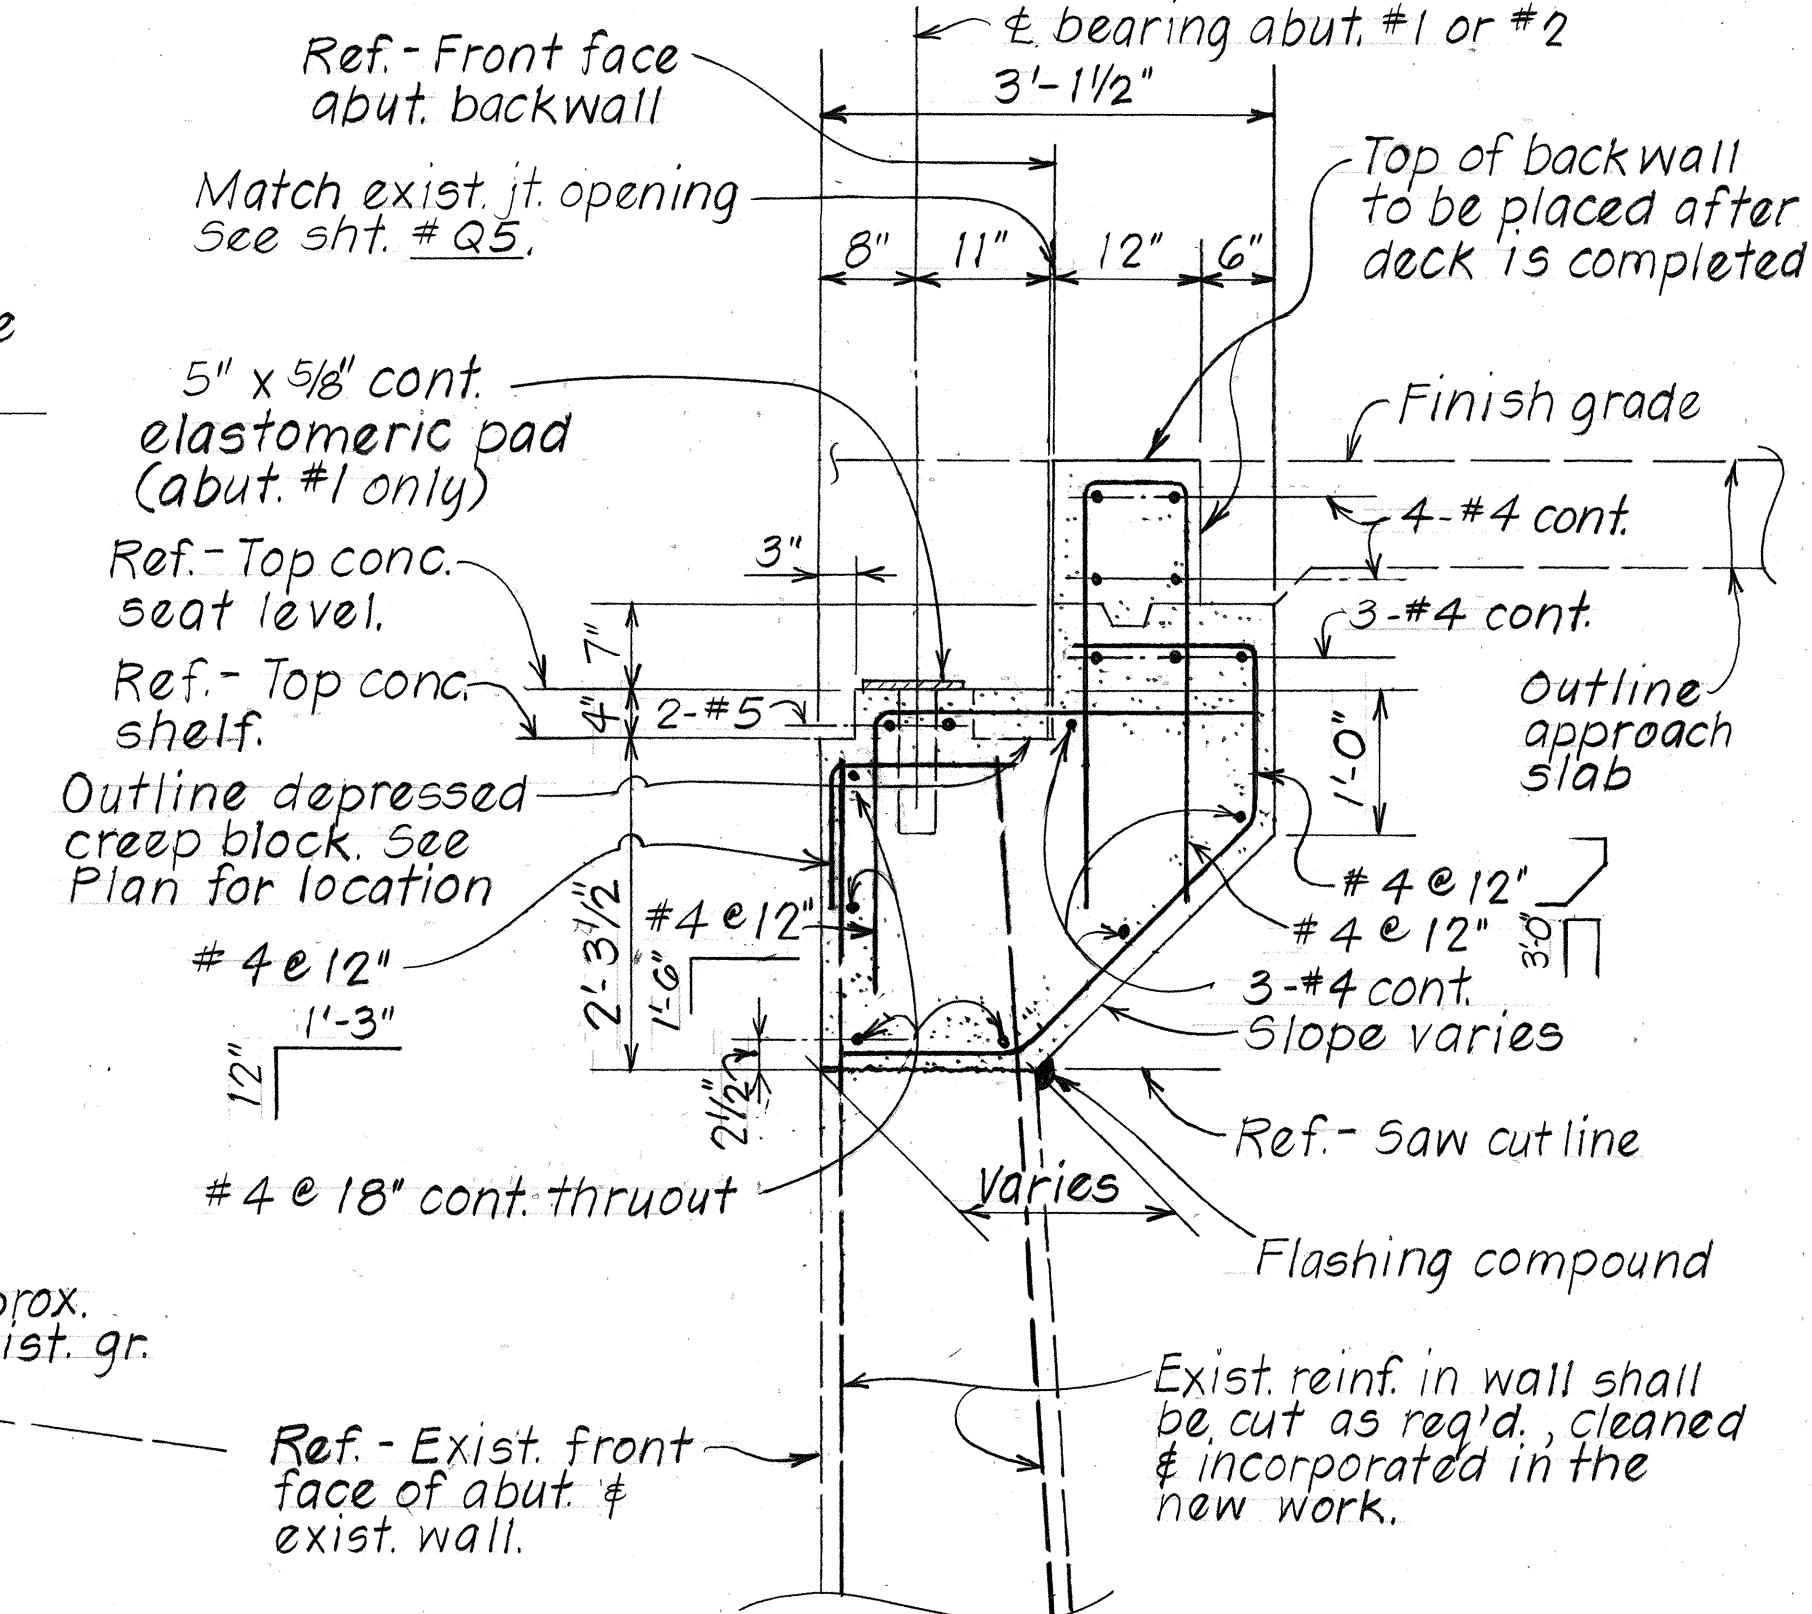

TYPICAL ABUT. SECT.


Scale: 3/4" = 1'-0"

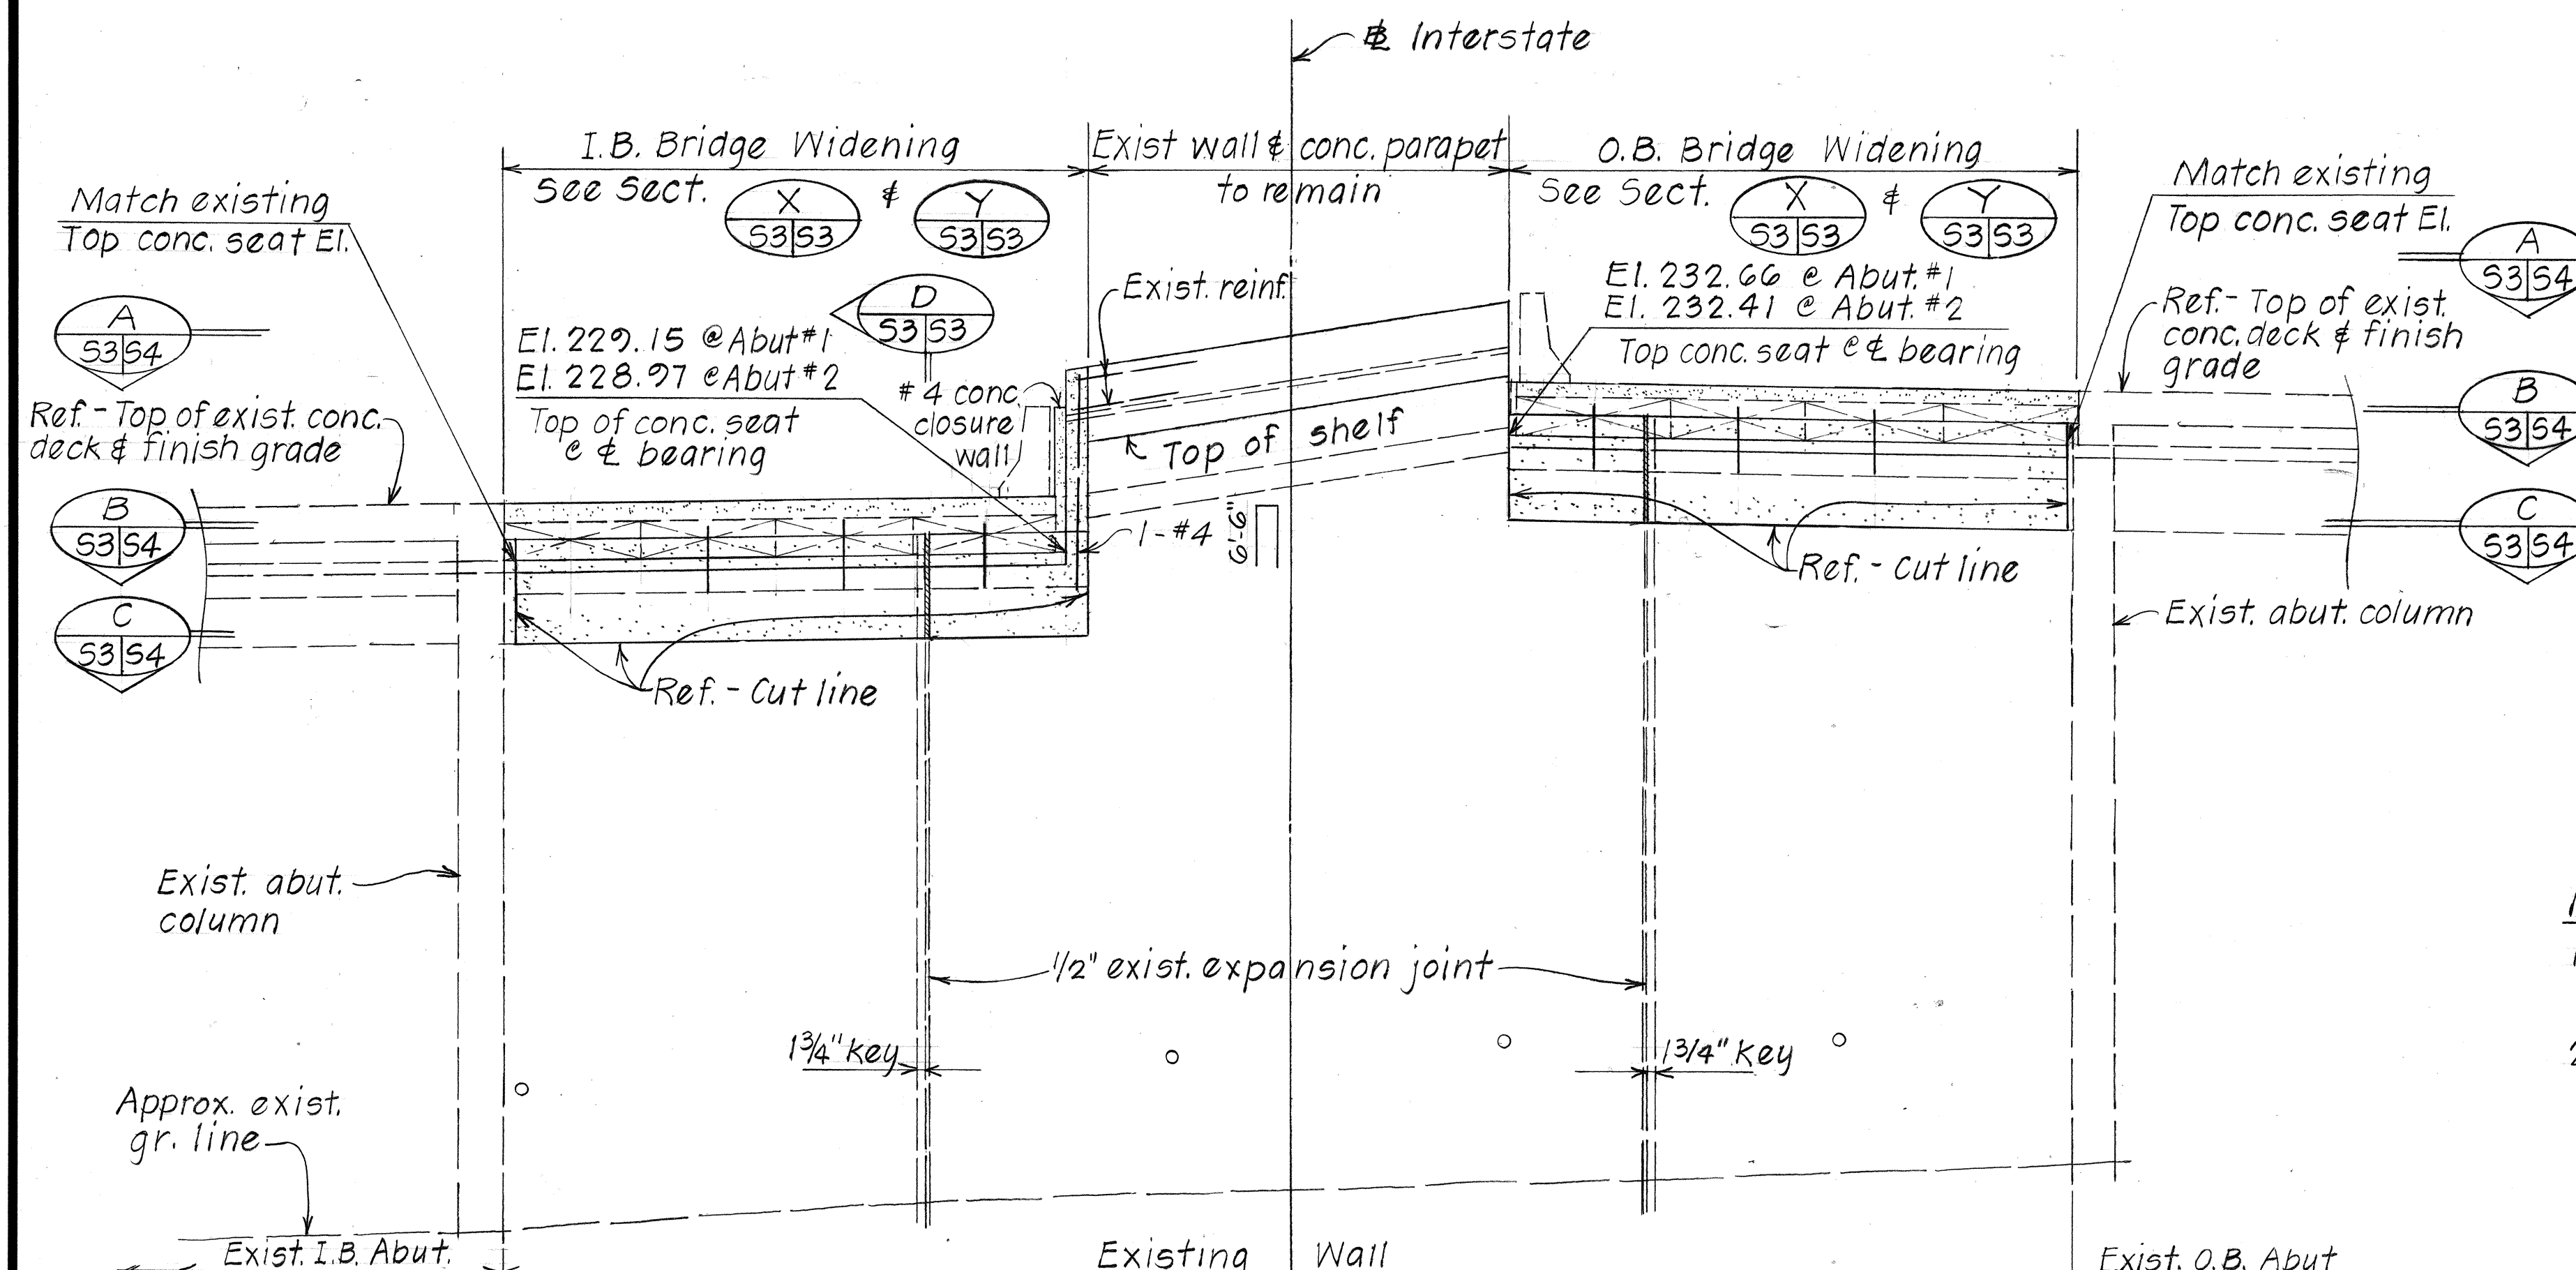

ELEVATION - ABUTMENT NO. 1

(ABUTMENT NO. 2 - MIRROR IMAGE)

Scale: 1/4" = 1'-0"

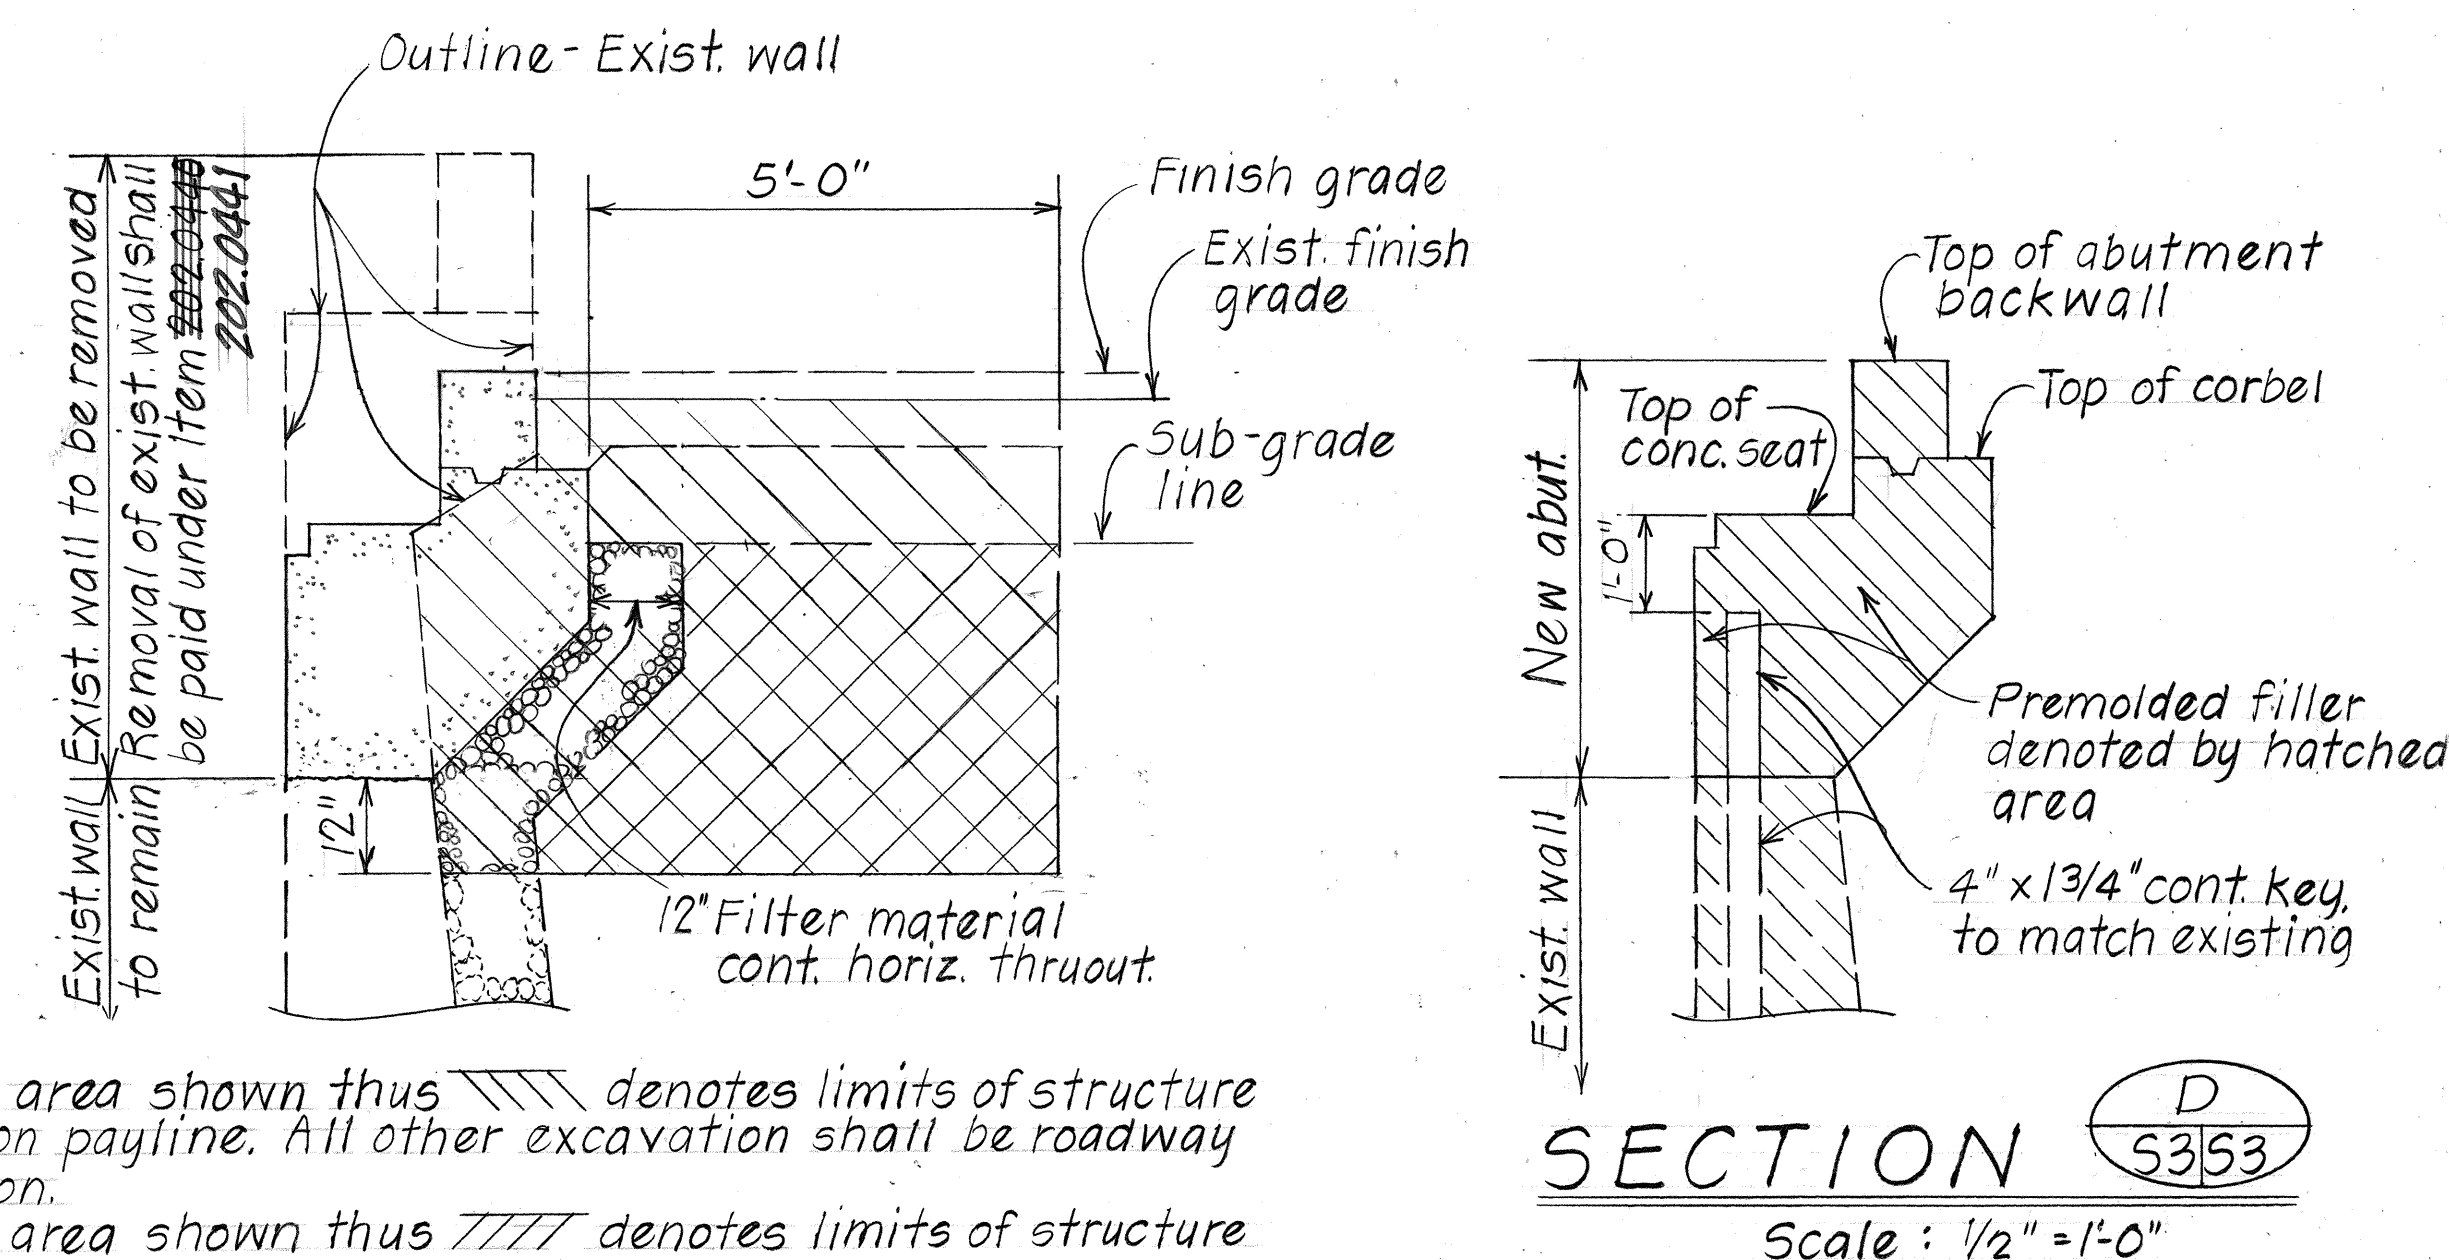

NOTES:

- Hatched area shown thus denotes limits of structure excavation payline. All other excavation shall be roadway excavation.
- Hatched area shown thus denotes limits of structure backfill.

TYP. STRUCTURAL EXC. & BACKFILL

PAY LIMITS DETAIL Scale: 1/2" = 1'-0"

STATE OF HAWAII
DEPARTMENT OF TRANSPORTATION
HIGHWAYS DIVISION
PALEHUA SEPARATION WIDENING
ABUTMENT ① & ② - PLAN & ELEVATION
TYPICAL ABUT. SECT., TYP. STRUCT. EXC. DETS
INTERSTATE ROUTE H-1, PALAILA I.C. TO
KUNIA I.C. CONSTRUCTION OF ADDITIONAL LANES
F.A.I. Proj. No. IR-HI-1(189)
Scale: As Shown Date: July 1985

SHEET NO. 53 OF 12 SHEETS

Hand-drawn cross-section diagram of a concrete wall and foundation. Key dimensions and labels include:

- Dimensions:**
 - Top width: 1'-6" (split into 7" and 2")
 - Wall height: 2'-8" (split into 1'-7" and 3'-10")
 - Foundation height: 1'-0"
 - Base width: 4'-0" (split into 4-#4 and 2-#4)
- Reinforcement:**
 - Vertical bars: #5 @ 9"
 - Horizontal bars: #4 @ 18"
 - Base bars: 4-#4 and 2-#4
- Materials/Details:**
 - 1/2" premoiled joint filler
 - Flashing compound #4 @ 18"
 - Conc. rail or end post
 - Optional - 2x4 construction joint
- Other Labels:**
 - Fin. gr. (Finish grade)
 - Exist. gr. line (Existing grade line)
 - Pay Item No. 507.7600
 - Typ. Det. sht. #Q3

expansion joint

Conc. bridge rail deck span
See sht. # Q3

Conc. rail Type "RT-B" or end post
See sht. # Q3
Section E 5454

Top of railing

2'-8"

45# composition roofing paper

1" premolded jt. filler


Bot. ftg.

Outline - Abut. Honouliuli Stream Bridge only.

STATE OF HAWAII
DEPARTMENT OF TRANSPORTATION
HIGHWAYS DIVISION

PALEHUA SEPARATION WIDENING
ABUTMENT ① & ② SECTIONS
INTERSTATE ROUTE H-1, PALAILAI I.C. TO
KUNIA I.C. CONSTRUCTION OF ADDITIONAL LANES
F.A.I. Proj. No. IR-HI-1(189)
Scale: As Shown Date: July 1985

SHEET No. 34 OF 12 SHEETS

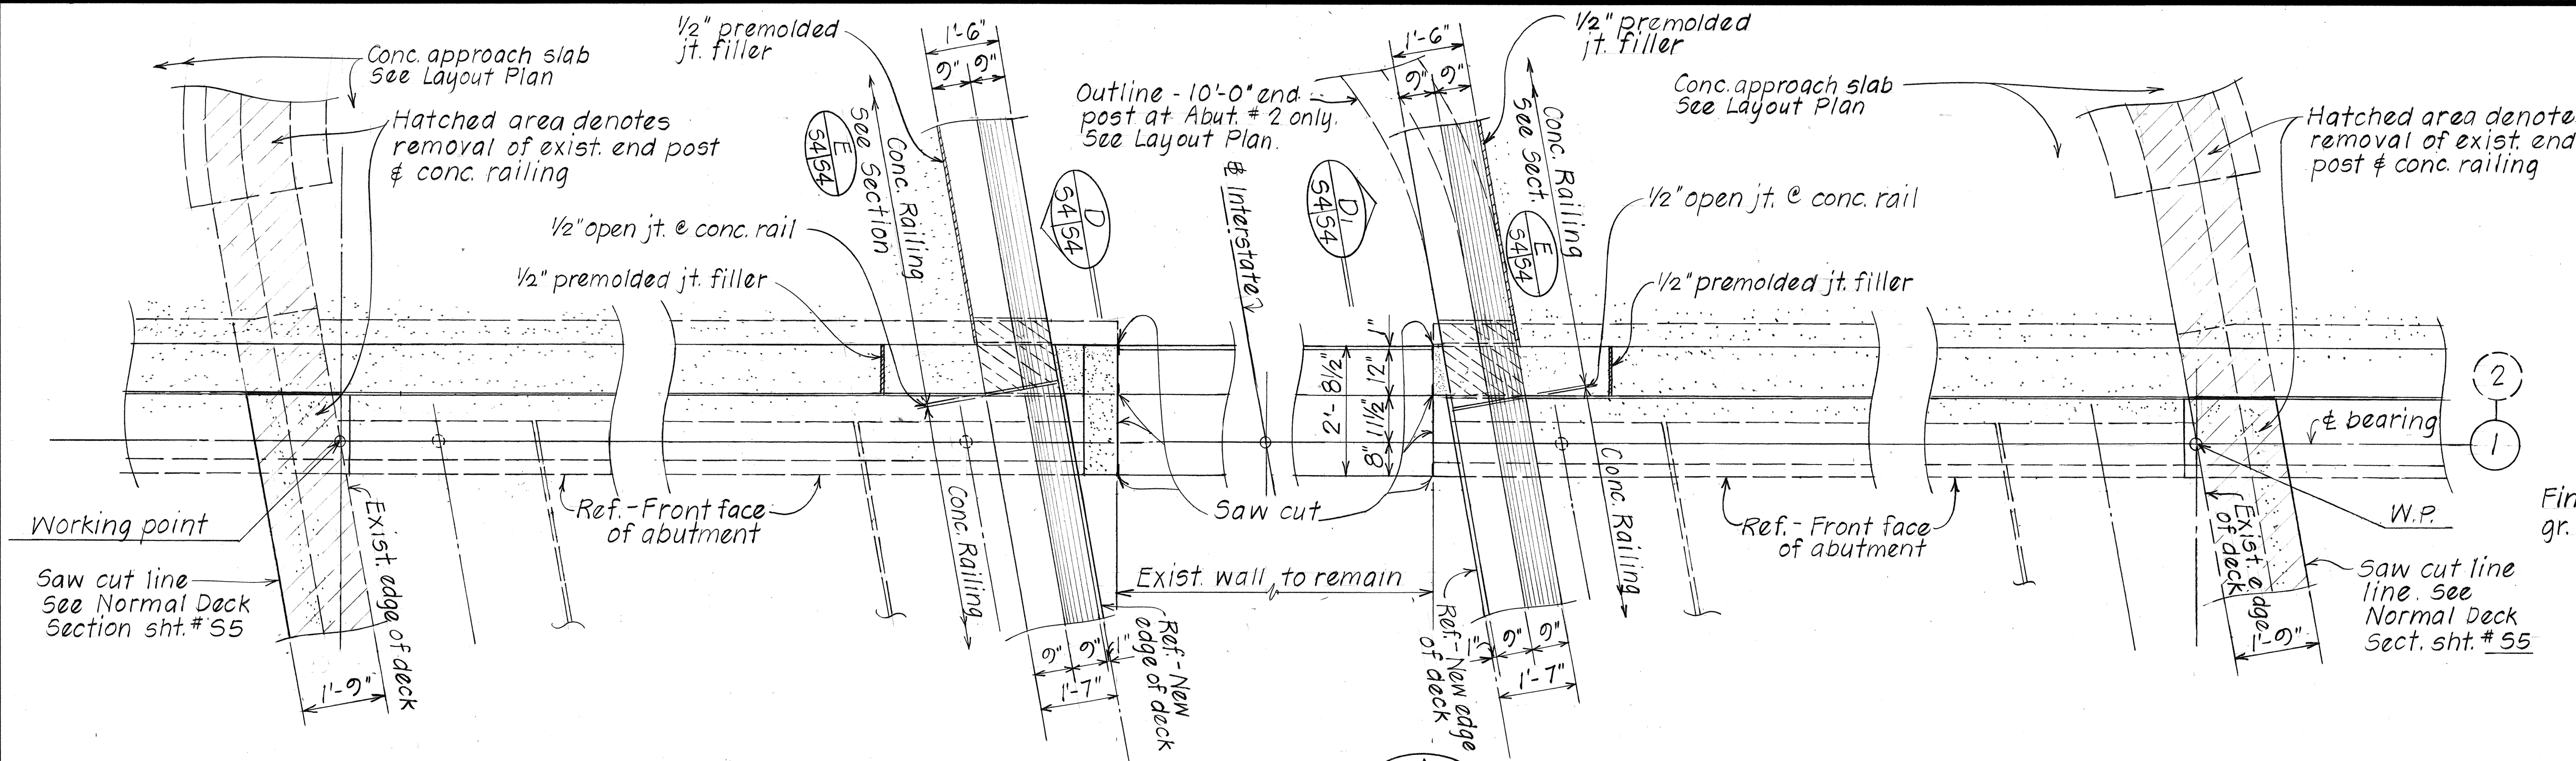[illegible]

Hand-drawn cross-section diagram of a bridge deck and abutment structure. The diagram shows two main sections of the bridge deck, each with a new abutment and existing abutment. Key features include:

- Existing reinf.**: Reinforcement bars in the existing structure.
- Saw cut**: Indicated by dashed lines.
- 2'-0" lap (typ)**: Typical lap length of reinforcement.
- 8" Varies**: Thickness of the deck.
- 10°**: Angle of the deck.
- Ref. - Front face of exist. wall & new abut.**: Reference line for the front face of the existing wall and new abutment.
- To match exist. exp. jt. below**: To match the existing expansion joint below.
- Working point**: Point of application of the working load.
- Exist. abut. to remain**: Existing abutment to remain.
- New abutment - See Plan**: New abutment to be constructed.
- Exist. wall to remain**: Existing wall to remain.
- Exist. edge of deck**: Existing edge of the deck.
- Exist. abut. to remain**: Existing abutment to remain.
- Scale: 1/2" = 1'-0"**: Scale of the drawing.
- SECTION C 53/54**: Section identifier.


SECTION

53	54
----	----


Scale: $\frac{1}{2}" = 1'-0"$

ORIGINAL PLAN	SURVEY PLOTTED BY _____ DATE <u>7/85</u>
NOTE BOOK	DRAWN BY <u>L.M.A</u>
	TRACED BY _____
	DESIGNED BY <u>M.Y.</u>
	QUANTITIES BY _____
No. _____	CHECKED BY <u>L.A., G.T.</u> <u>7/85</u>


FED. ROAD DIST. NO.	STATE	FED. AID PROJ. NO.	FISCAL YEAR	SHEET NO.	TOTAL SHEETS
HAWAII	HAW.	IR-HI-1(187)	1986	56	99

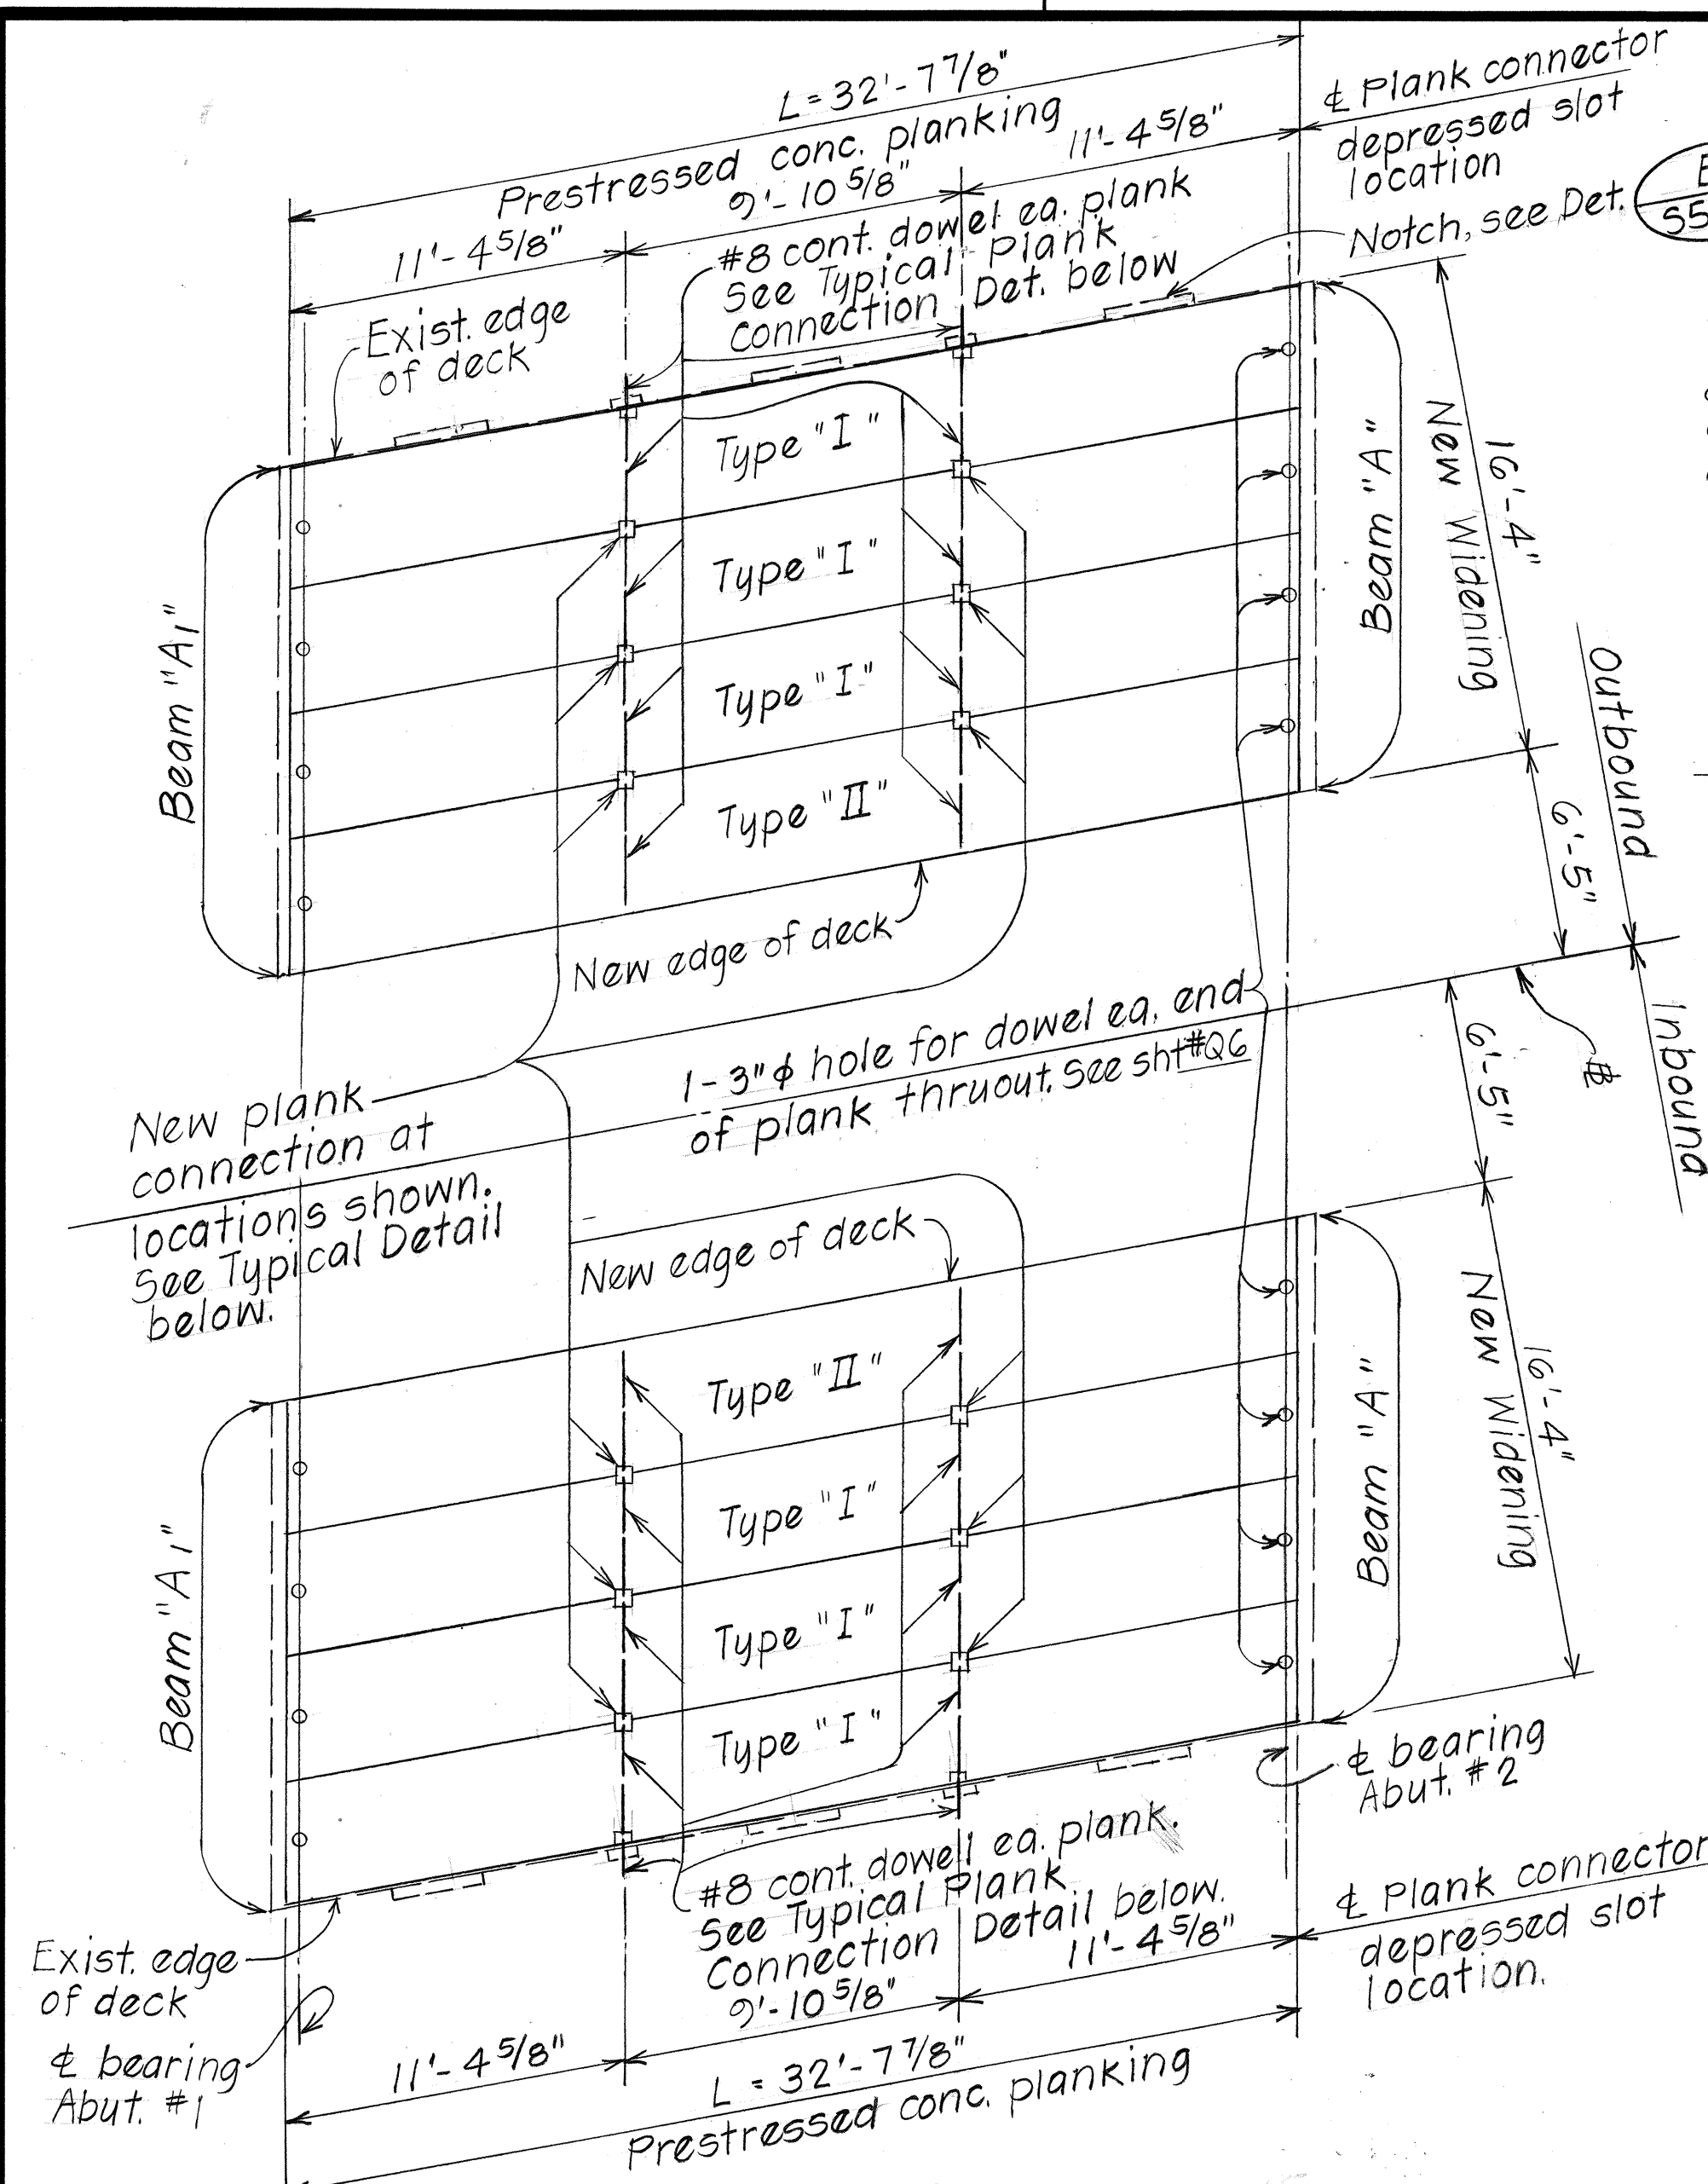




DECK FRAMING PLAN
Scale: 3/16" = 1'-0"

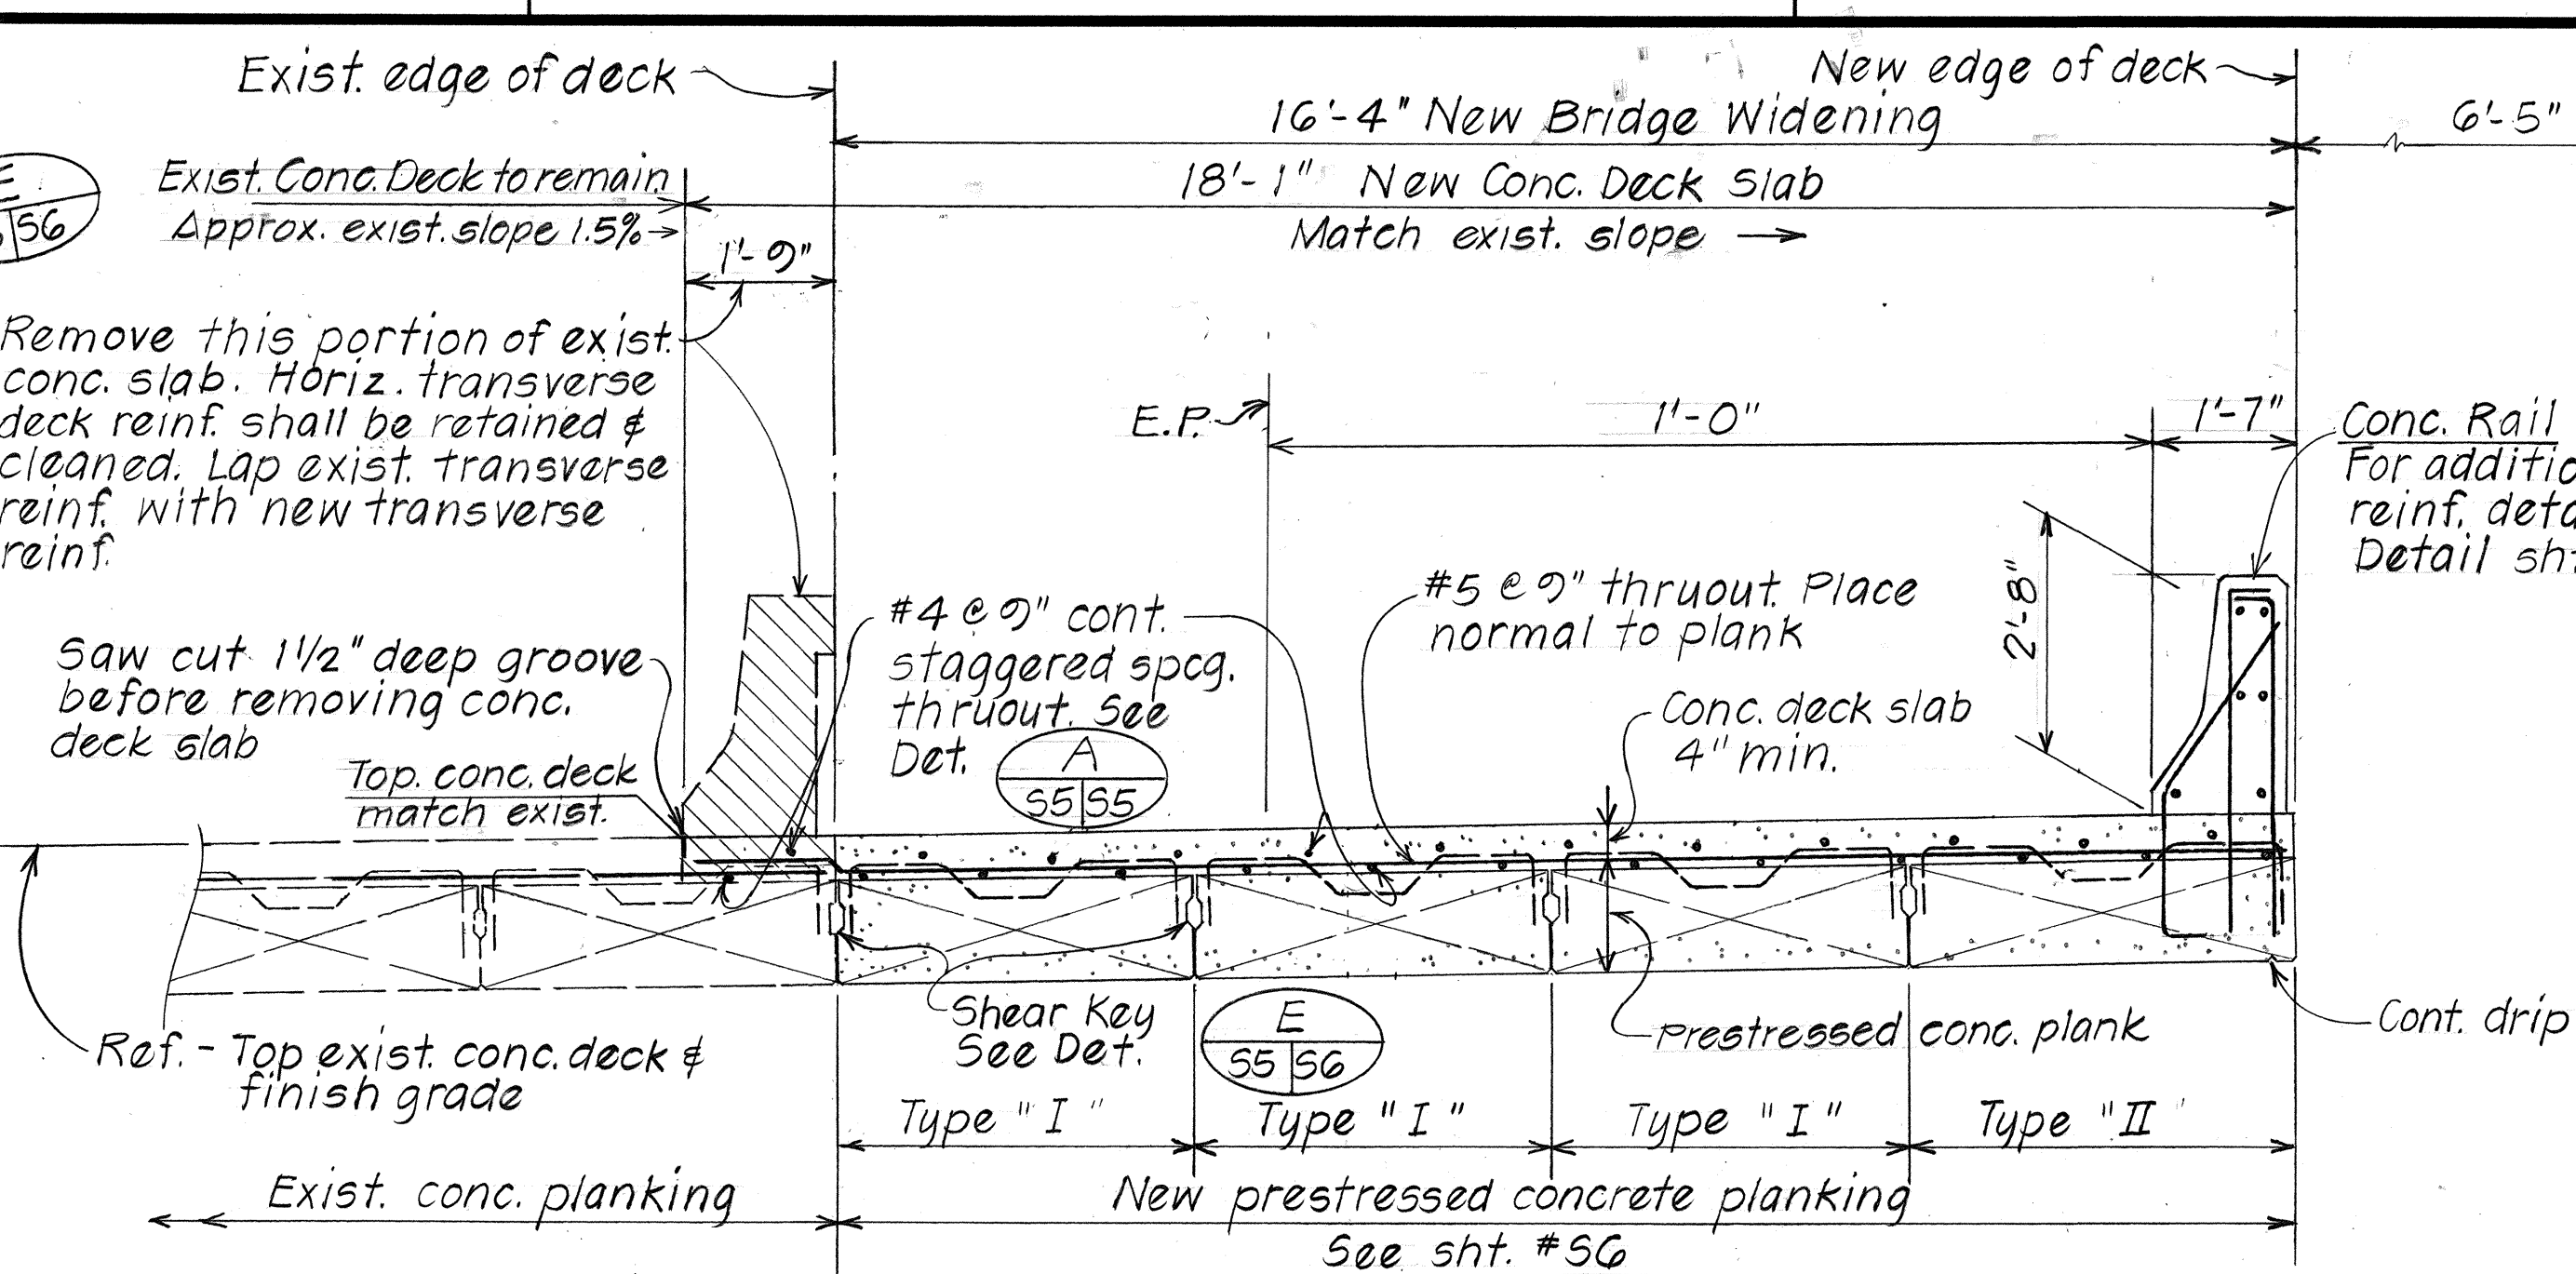


NORMAL SECTION OUTBOUND BRIDGE-AS SHOWN
(INBOUND BRIDGE SIMILAR EXCEPT OPPOSITE HAND)
Scale: 1/2" = 1'-0"

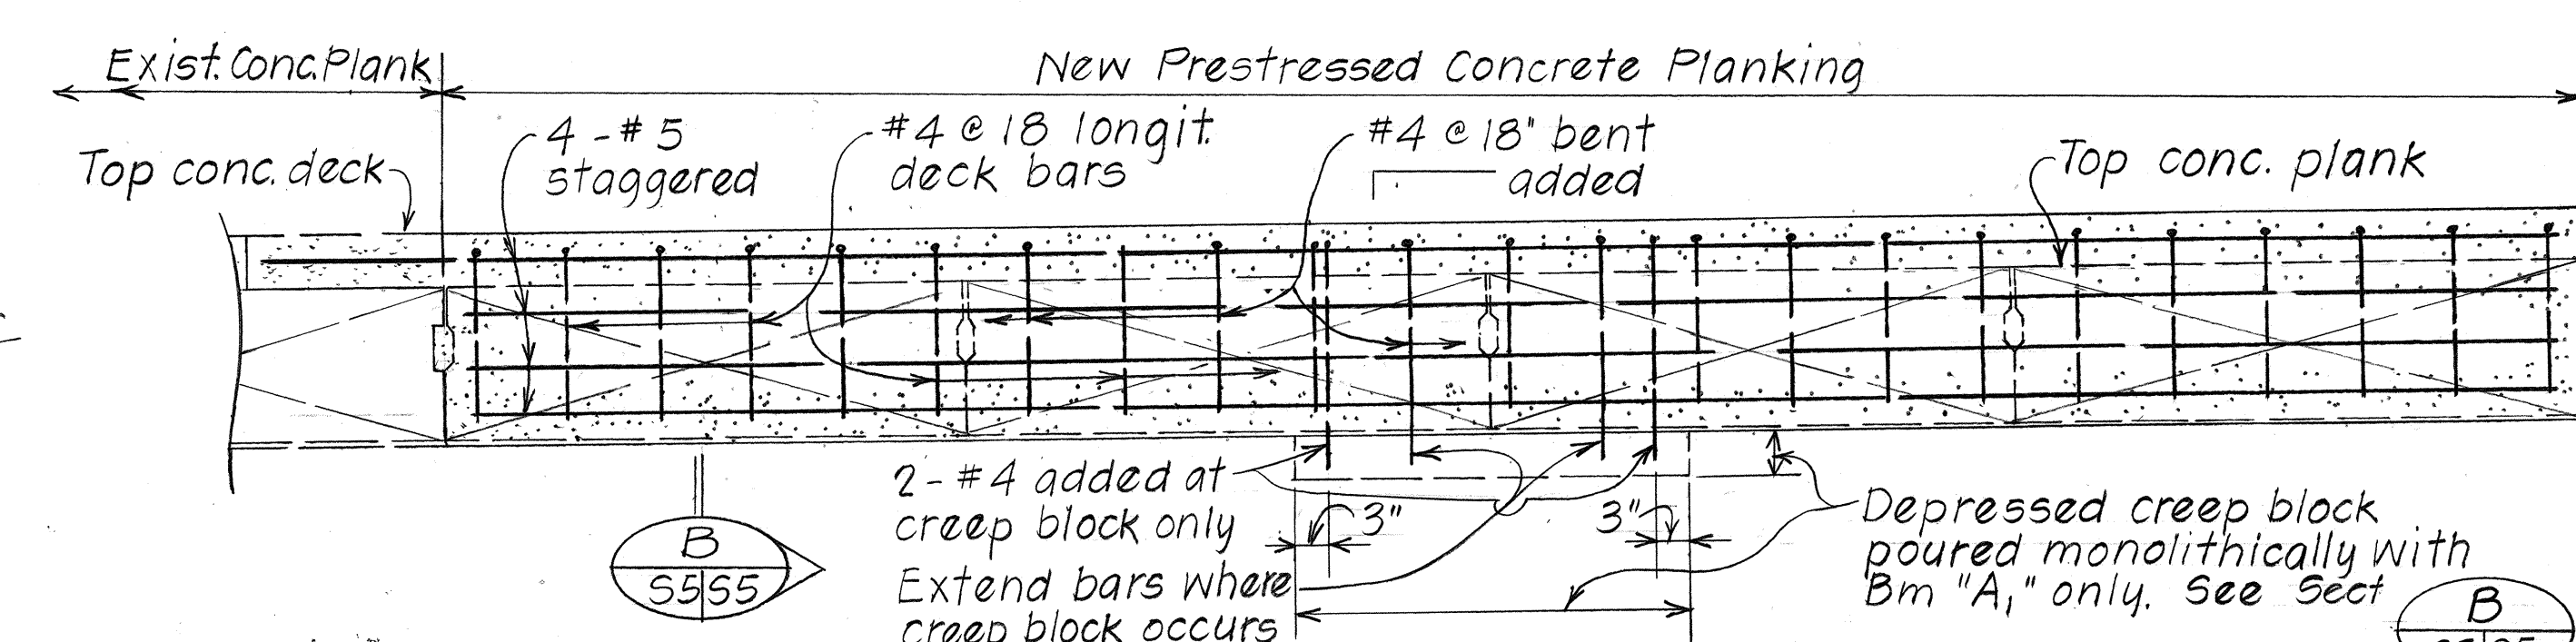


ELEVATION BEAM "A"-AS SHOWN
(BEAM "A1" SIMILAR EXCEPT AS OTHERWISE NOTED)
Scale: 3/4" = 1'-0"

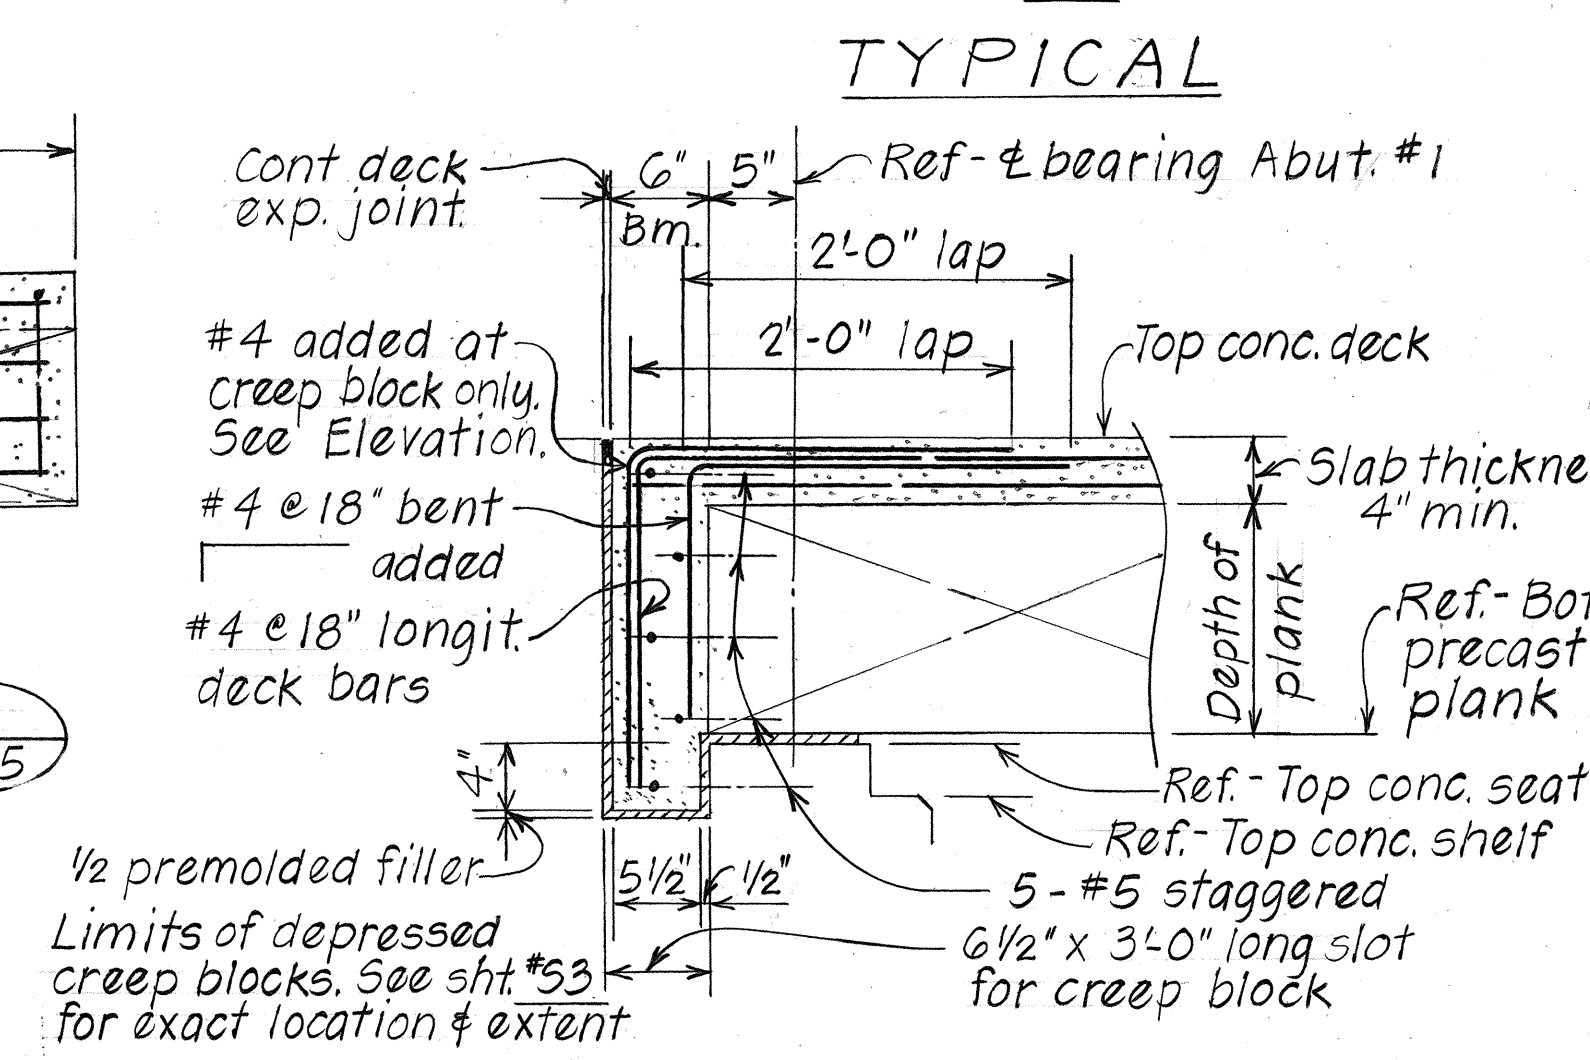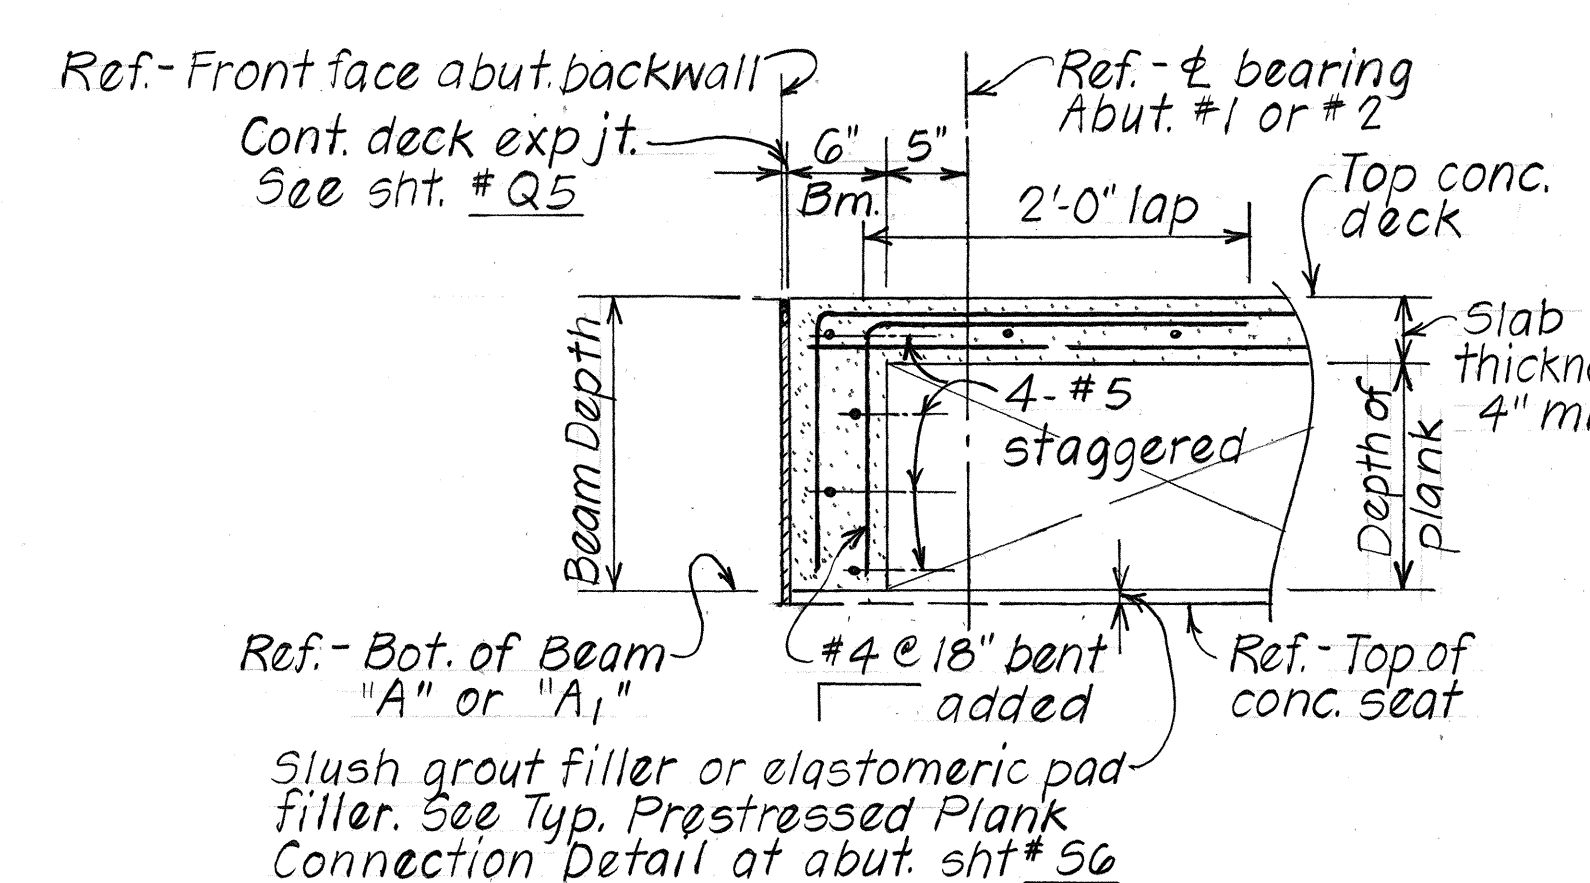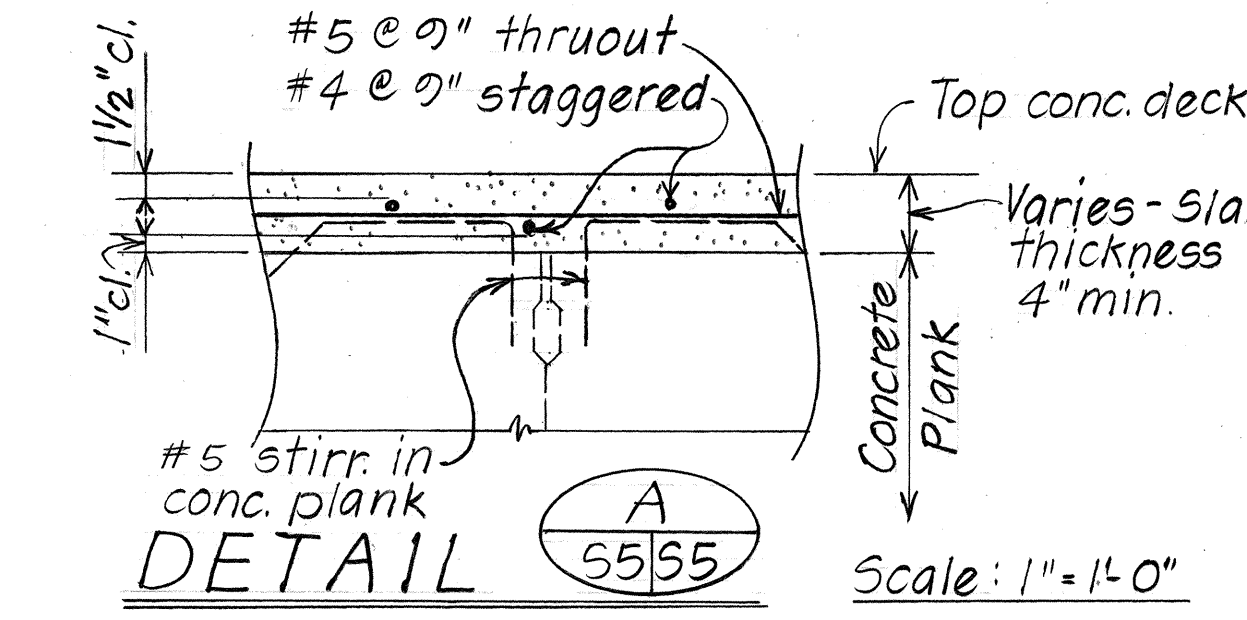

CREEP BLOCK (BEAM "A1" ONLY)
SECTION B 5555 Scale: 1" = 1'-0"

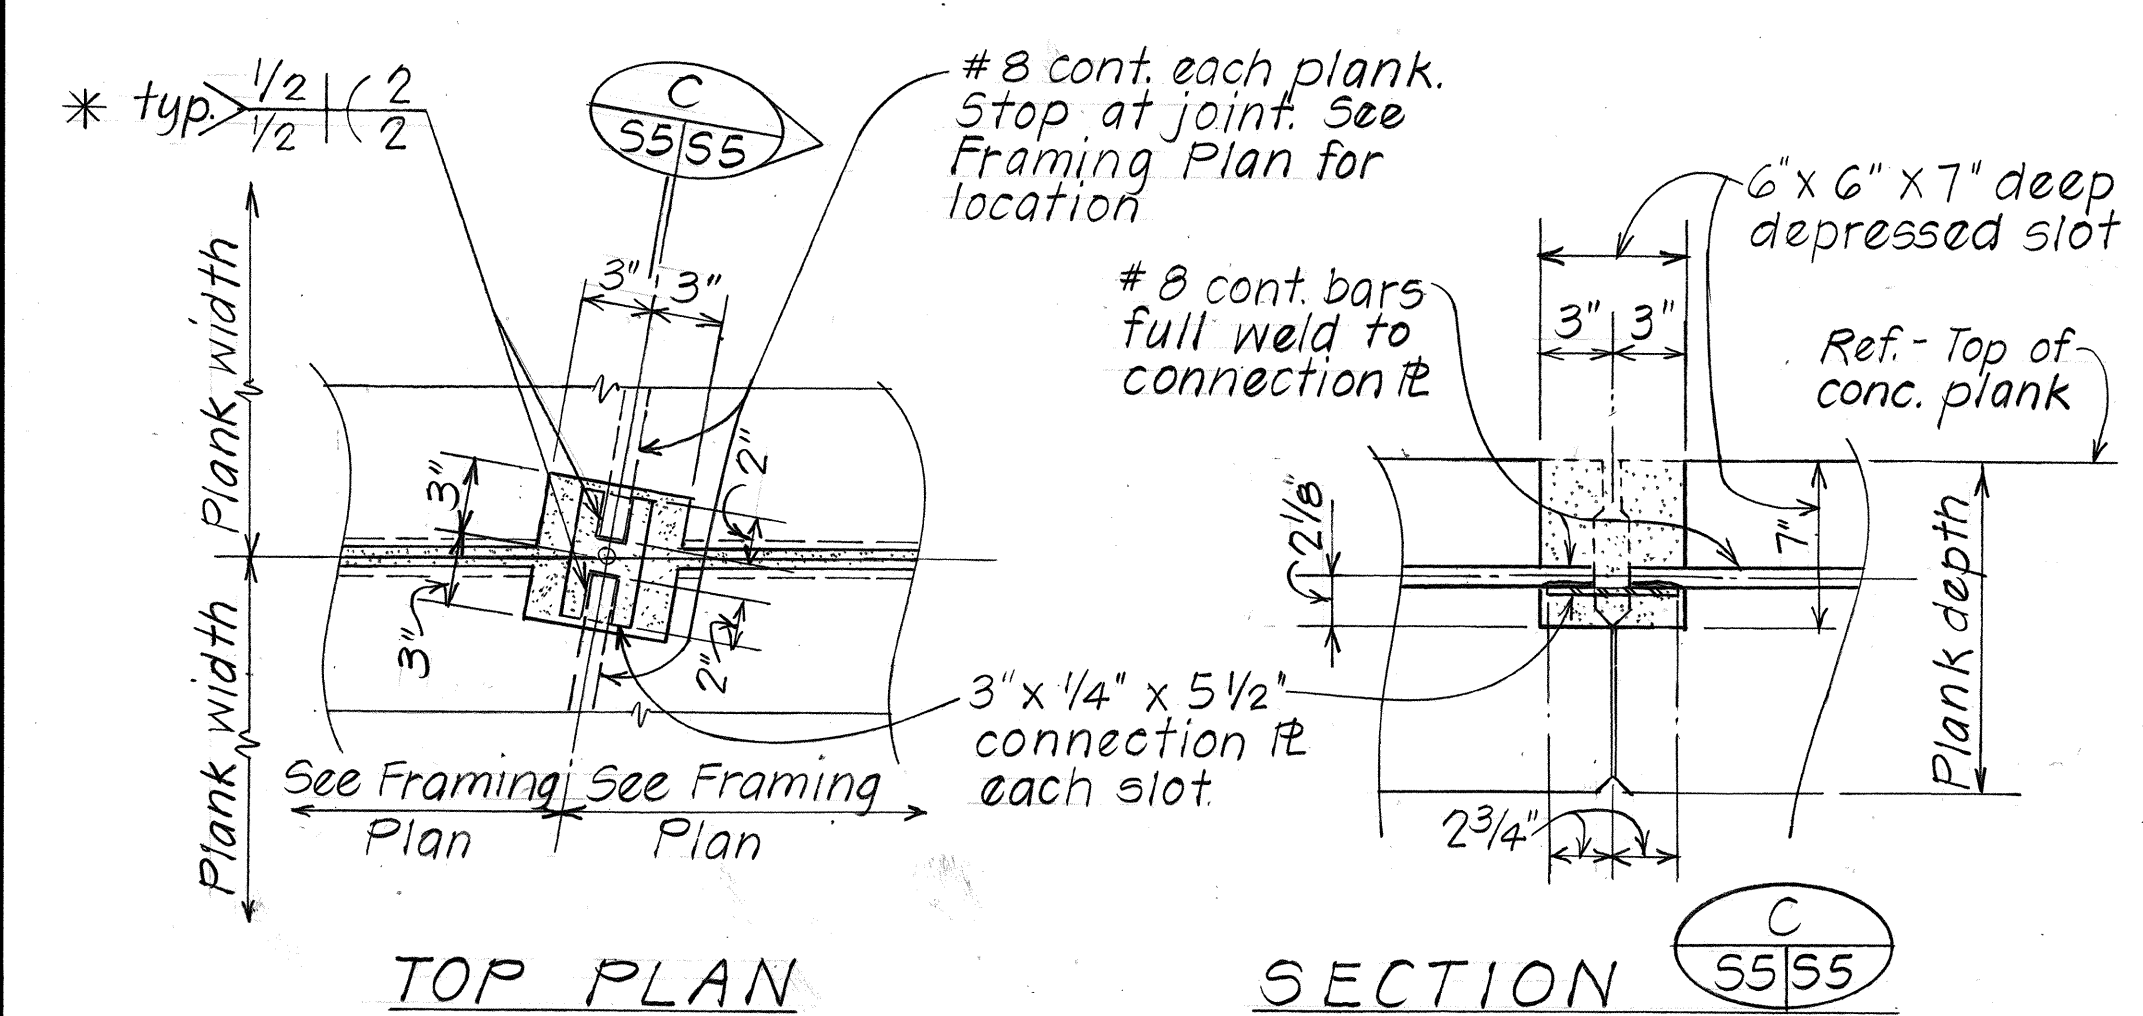

TOP PLAN
SECTION C 5555
AT NEW PLANKS

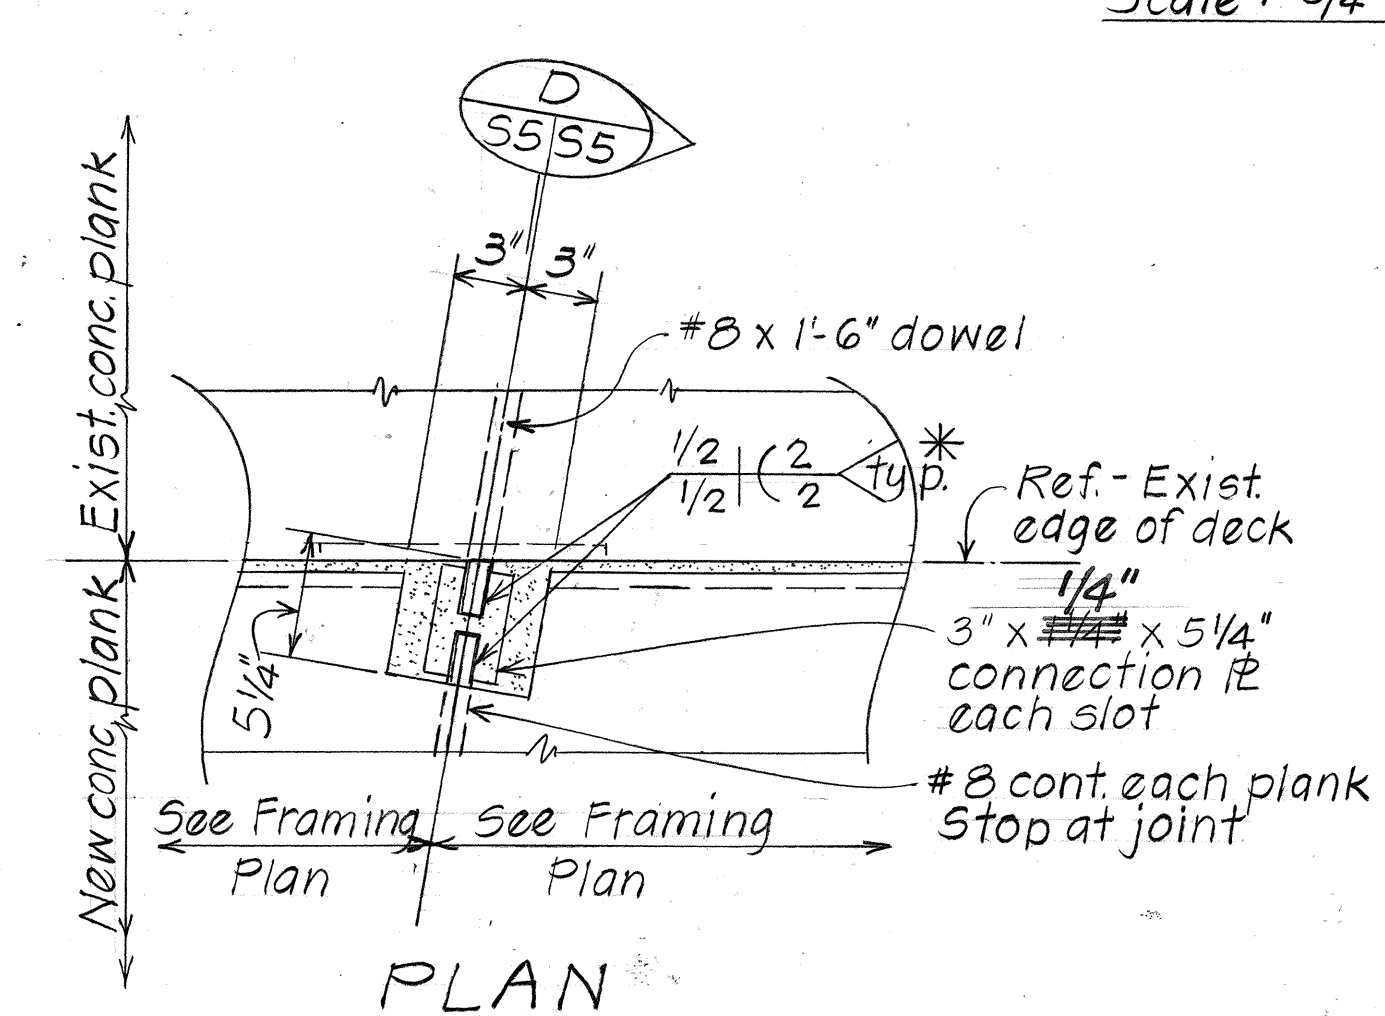



PLAN
SECTION D 5555
AT EXISTING PLANK

TYPICAL PLANK CONNECTION DETAILS
Scale: 1/2" = 1'-0"


STATE OF HAWAII
DEPARTMENT OF TRANSPORTATION
HIGHWAYS DIVISION
PALEHUA SEPARATION WIDENING
NORMAL DECK SECTION
DECK FRAMING PLAN, BEAM "A" & "A1"
INTERSTATE ROUTE H-1, PALAILAI I.C. TO
KUNIA I.C. CONSTRUCTION OF ADDITIONAL LANES
F.A.I. Proj. No. IR-HI-1(187)
Scale: As Shown Date: July 1985
SHEET No. 55 OF 12 SHEETS

FED. ROAD DIST. NO.	STATE	FED. AID PROJ. NO.	FISCAL YEAR	SHEET NO.	TOTAL SHEETS
HAWAII	HAW.	IR-HI-1(189)	1986	57	99

Prestressed Concrete Plank
 f'c = 5,000 psi @ 28 days
 fci = 4,000 psi @ transfer
Prestressed Strands
 A. 1/2" 270 ksi, 7 wire stress relieved strands (ASTM 416)
 Total losses other than friction = 45,000 psi
 B. Allow whole stresses in strands shall be in accordance with design specifications. (See General Structure Notes)

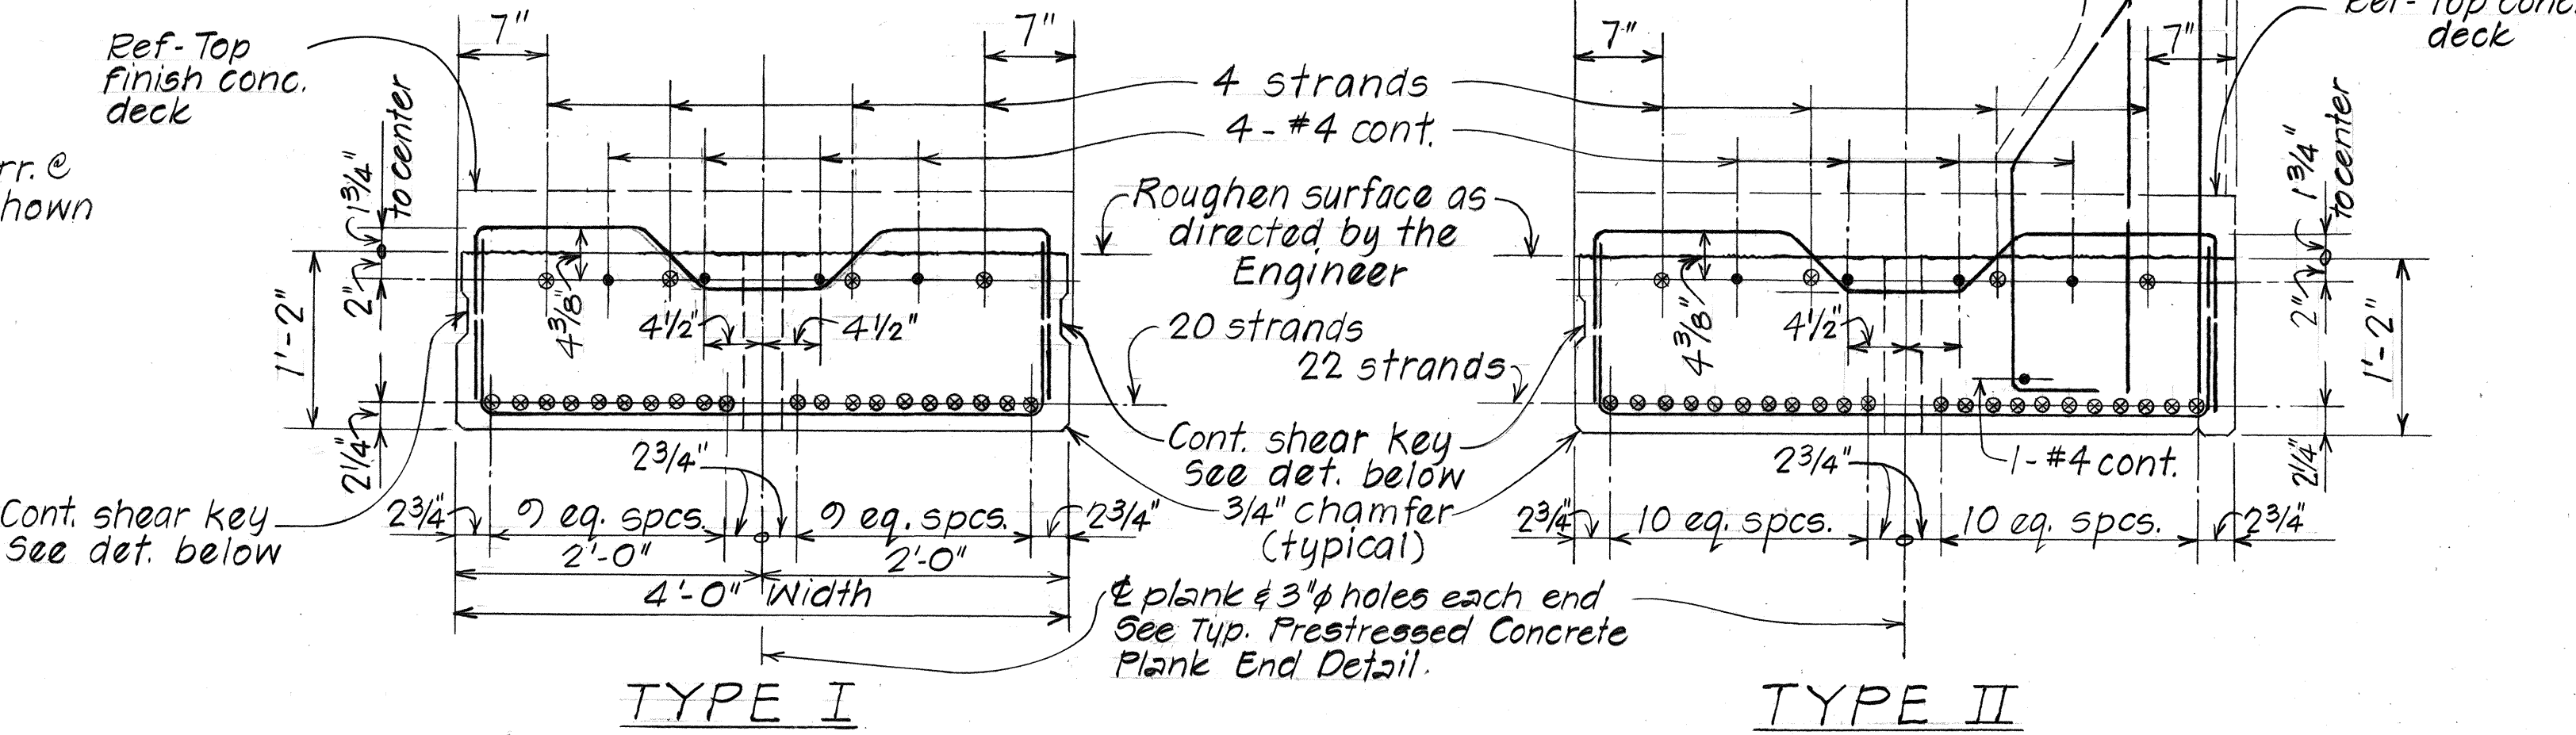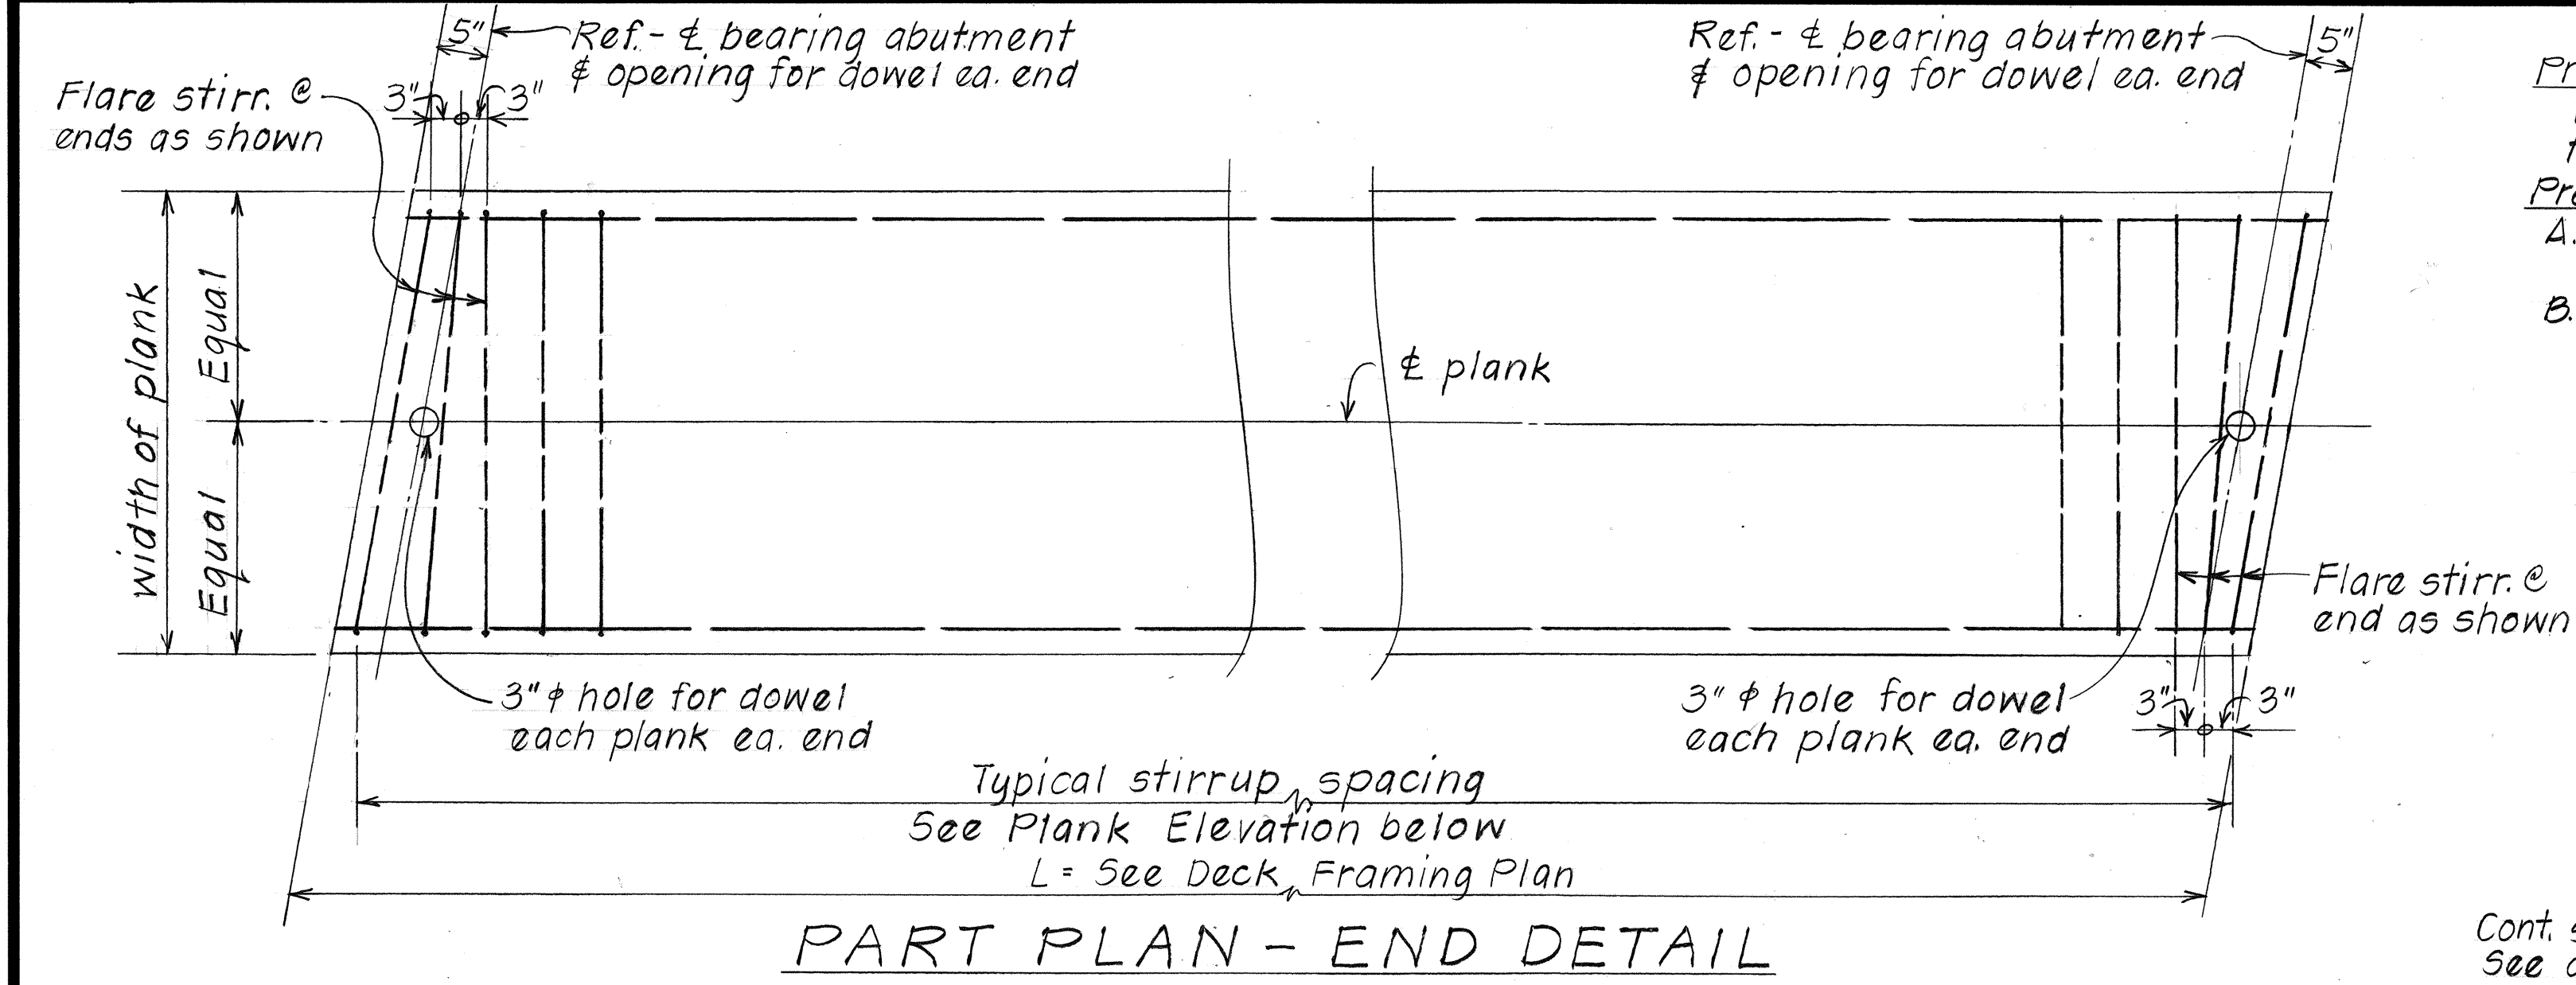


TYPICAL PRESTRESSED CONCRETE PLANK SECTIONS
 Scale: 1" = 1'-0"

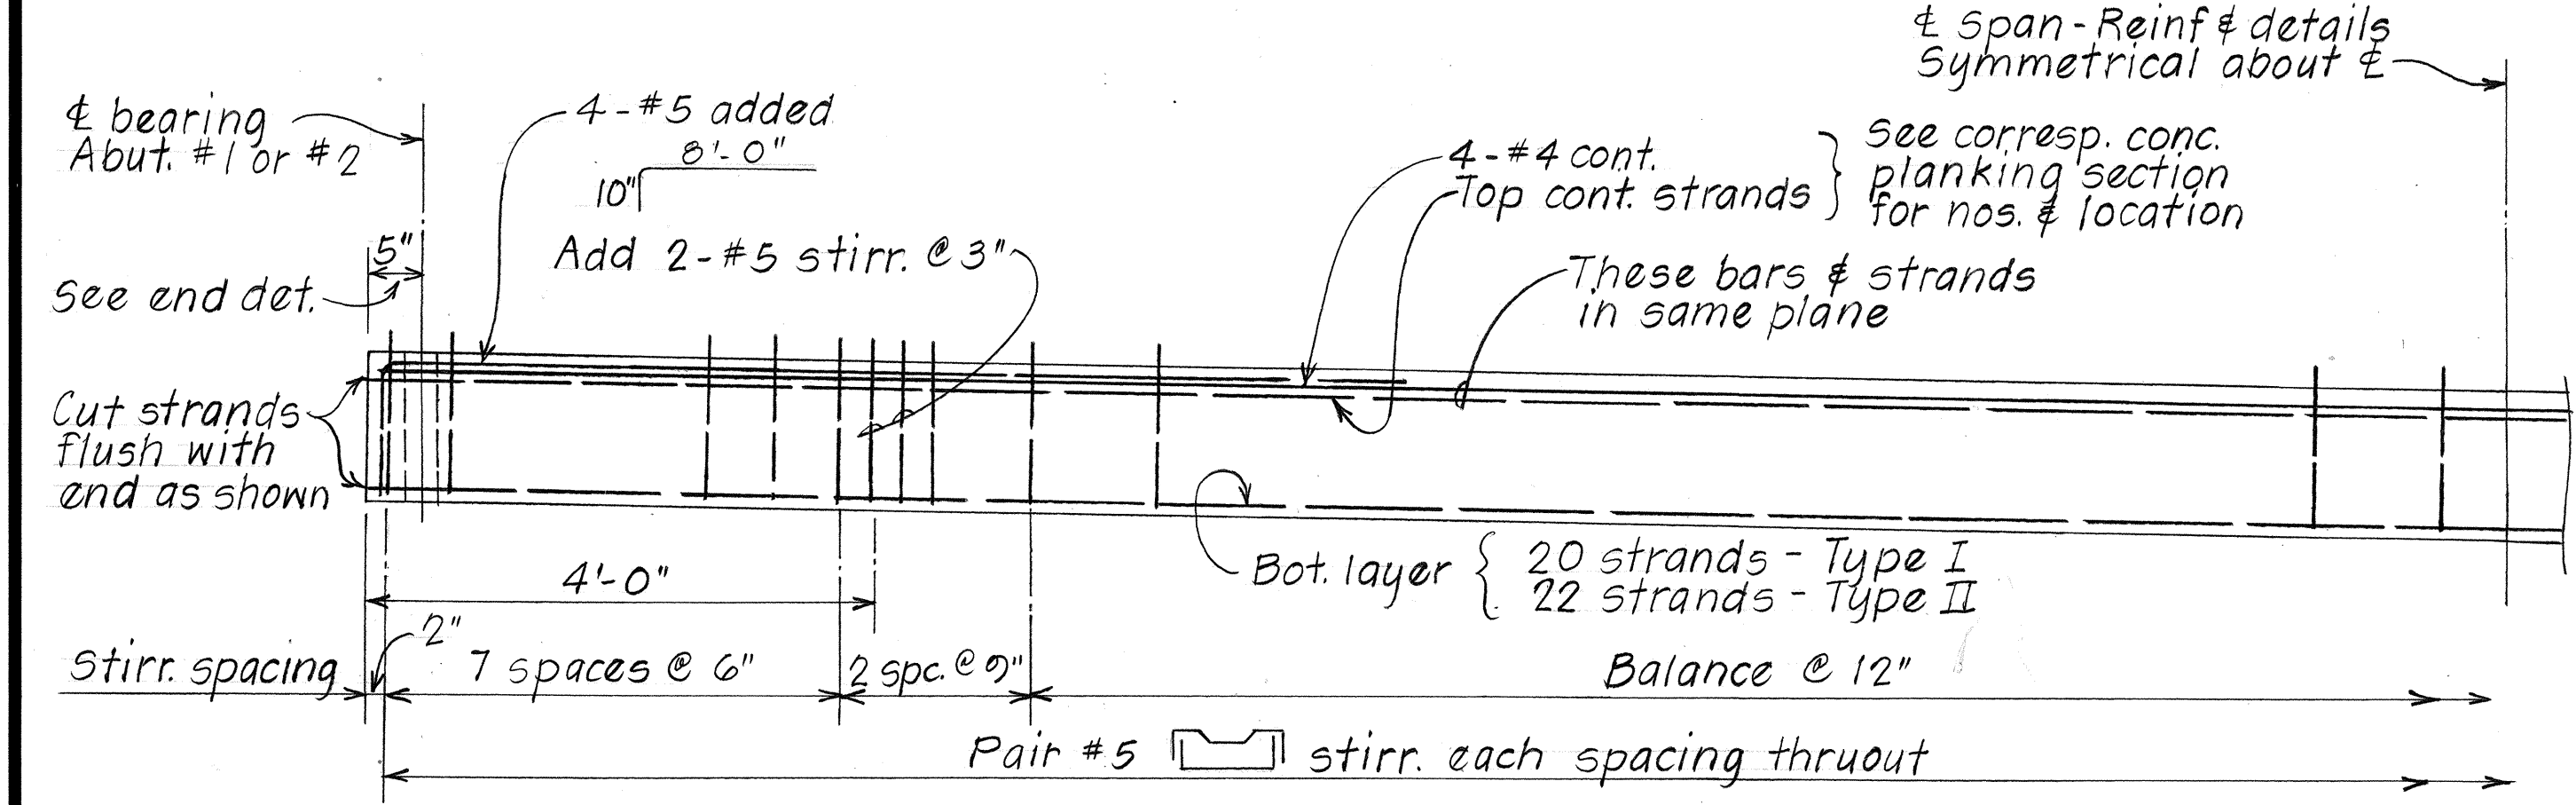

ELEVATION


TYPICAL PRESTRESSED CONCRETE PLANK-TYPES I & II
 Scale: 3/4" = 1'-0"

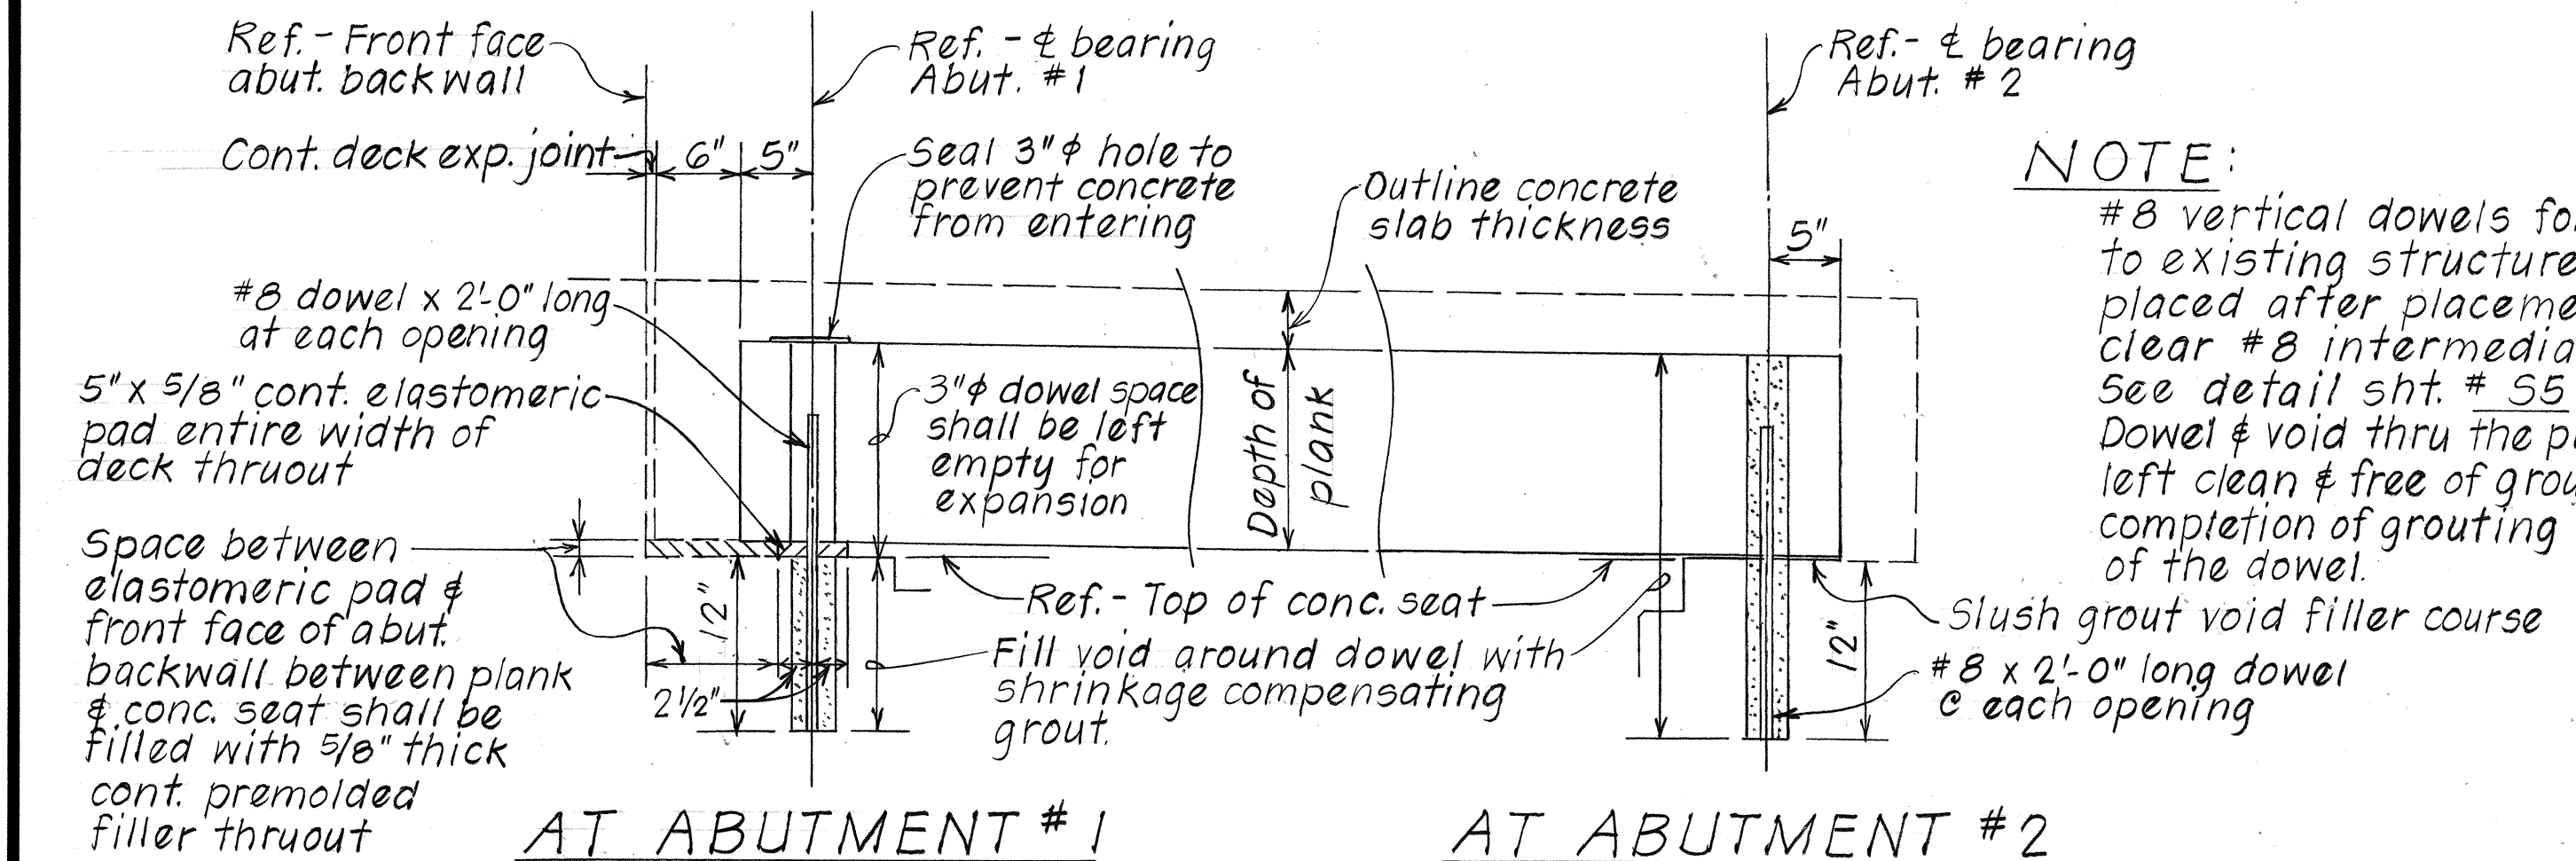

AT ABUTMENT #1 AT ABUTMENT #2


TYPICAL DETAIL - PRESTRESSED PLANK CONNECTION TO ABUTMENTS
 Scale: 1" = 1'-0"

NOTE:
 #8 vertical dowels for plank adjacent to existing structure should be placed after placement of plank so as to clear #8 intermediate plank connector. See detail sht. # 55.
 Dowel & void thru the plank at abut. #1 shall be left clean & free of grout fragments, at the completion of grouting the embedded portion of the dowel.

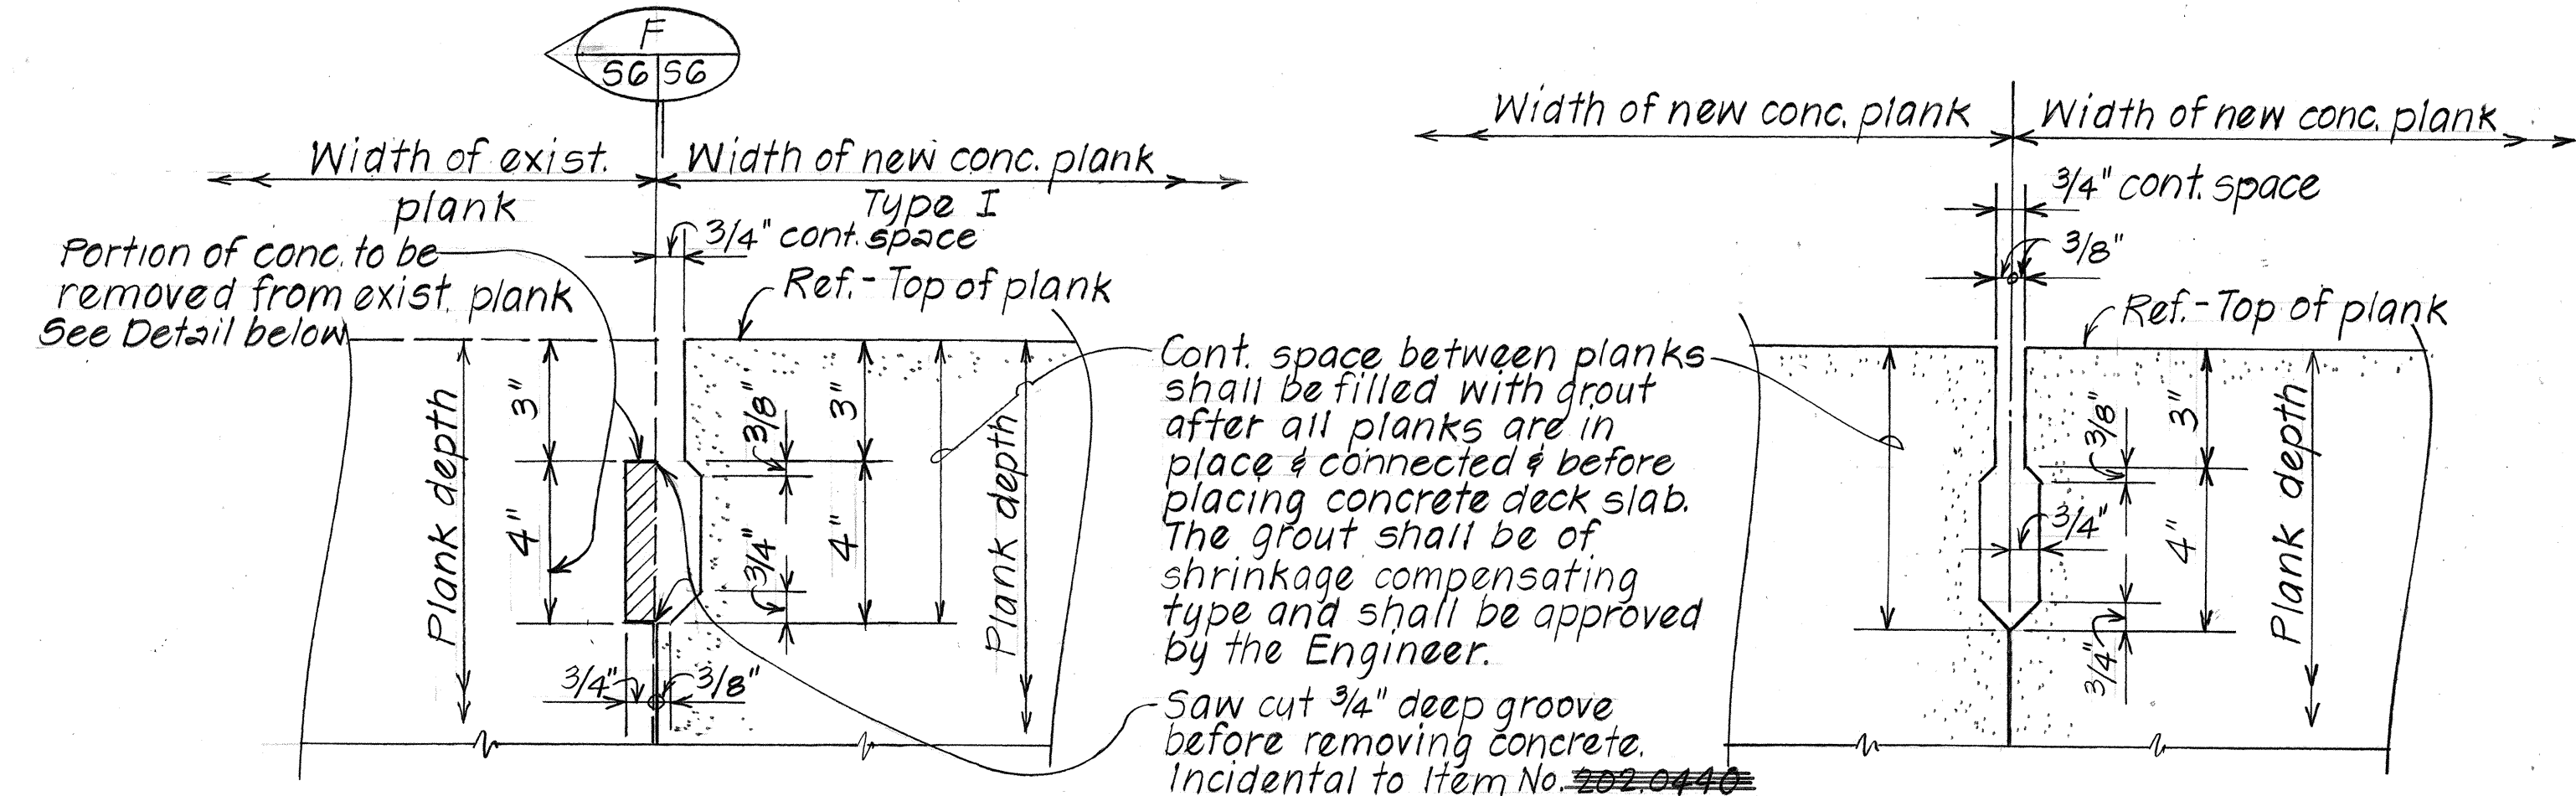

AT EXIST. PLANK ONLY

DETAIL E 5556 Scale: 3" = 1'-0"

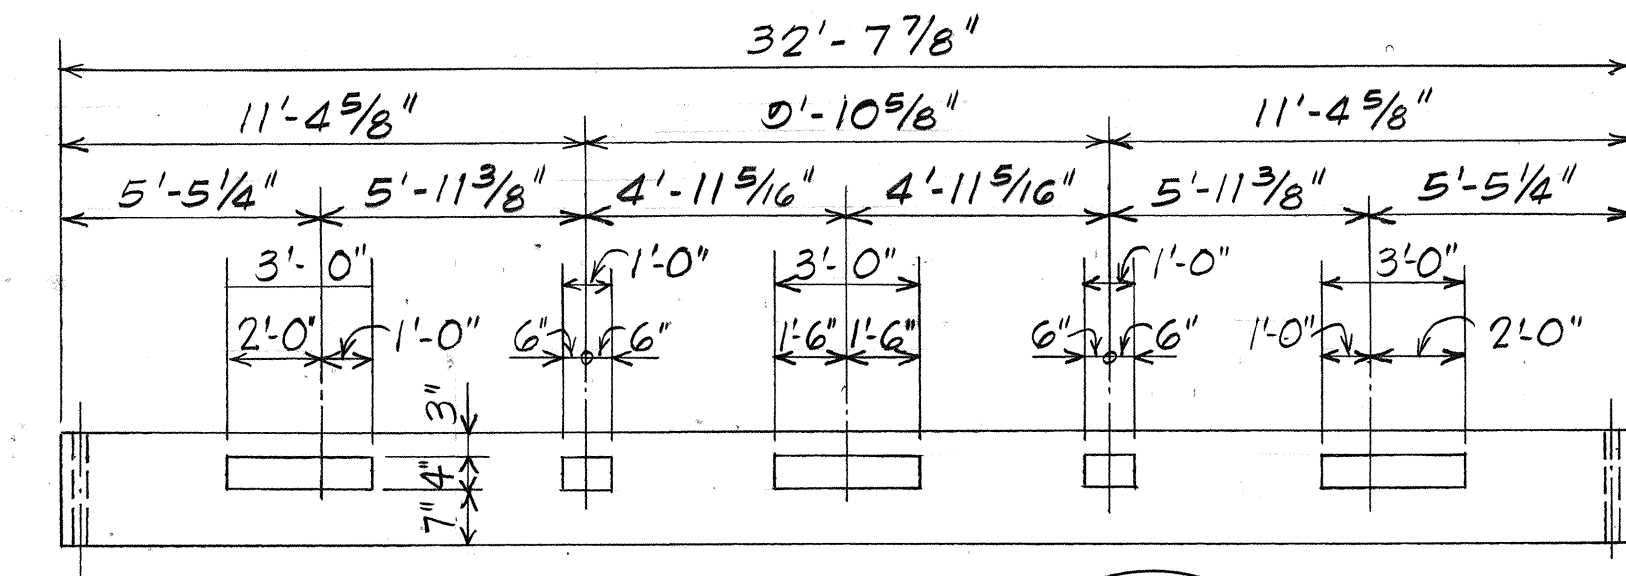


DETAIL F 5656 Not to scale

TYPICAL SHEAR KEY DETAILS

STATE OF HAWAII
 DEPARTMENT OF TRANSPORTATION
 HIGHWAYS DIVISION
PALEHUA SEPARATION WIDENING
TYP. PRESTRESSED CONC. PLANKS
 INTERSTATE ROUTE H-1, PALAILAI I.C. TO KUNIA I.C. CONSTRUCTION OF ADDITIONAL LANES
 F.A.I. Proj. No. IR-HI-1(189)
 Scale: As Shown Date: July 1985
 SHEET No. 56 OF 12 SHEETS

FED. ROAD DIST. NO.	STATE	FED. AID PROJ. NO.	FISCAL YEAR	SHEET NO.	TOTAL SHEETS
HAWAII	HAW.	1R-HI-1(18D)	1986	58	99

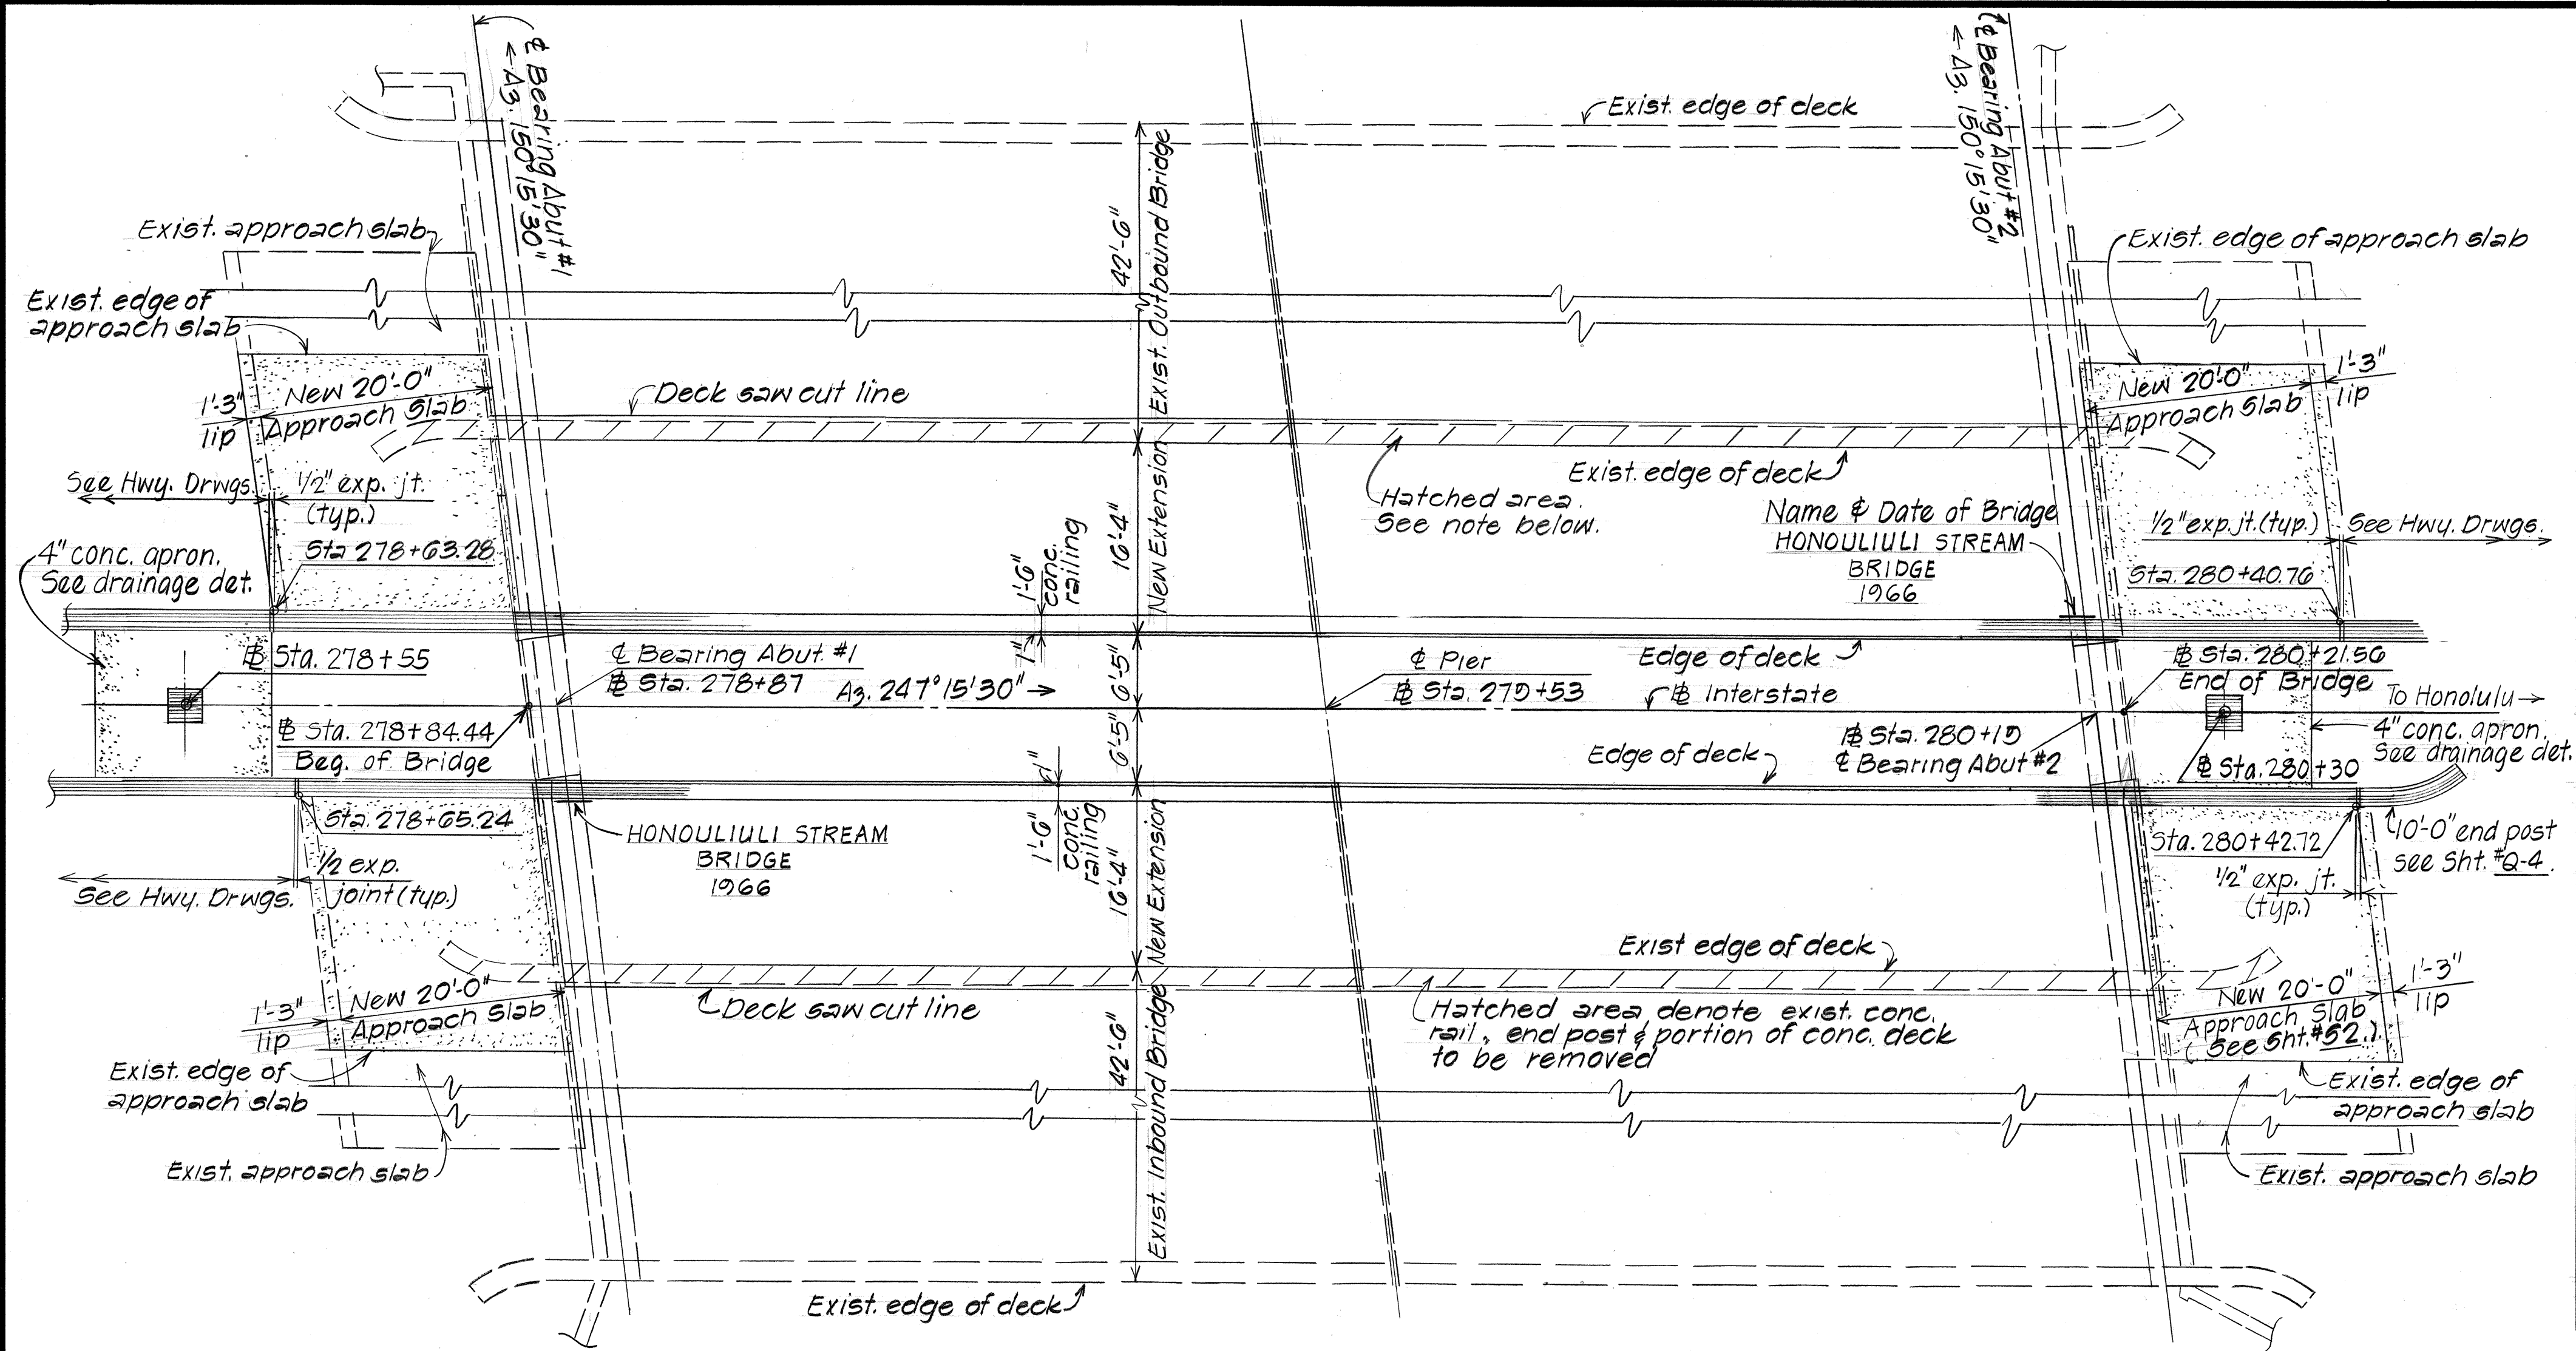


ESTIMATED QUANTITIES

ITEM NO.	ITEM	UNIT	QUANTITIES
202.0442	Removal of portion of Honouliuli Stream Bridge	Lump Sum	(80 C.Y.)
206.6102	Structure excavation for Honouliuli Stream Bridge	Cu.Yd.	361 C.Y.
206.7202	Structure backfill for Honouliuli Stream Bridge	Cu.Yd.	18 C.Y.
206.8200	Filter material for structures	Cu. Yd.	16 C.Y.
503.1085	Deck joint seal (Preformed) - Honouliuli Stream Bridge	Lump Sum	(342 L.F.)
503.1090	Concrete in Honouliuli Stream Bridge	Lump Sum	(240 C.Y.)
503.1091	Concrete in footing for Honouliuli Stream Bridge	Lump Sum	(22 C.Y.)
503.1095	Drilled holes for 1/8" expansion bolts	Each	32 ea.
503.1205	Concrete in footing for bridge rail	Lump Sum	(22 C.Y.)
504.3100	Type III prestressed concrete girder	Lump Sum	(801 L.F.)
507.7600	Concrete bridge railing (2'-8" Barrier Type)	Lin. Ft.	364 L.F.
602.0090	Reinforcing steel in Honouliuli Stream Bridge	Lump Sum	(62,600 Lbs.)
602.0205	Reinforcing steel in footing for bridge rail	Lump Sum	(1,300 Lbs.)

Item no. 202.0442 includes, but is not limited to, concrete railings, abutments, piers & footings



LAYOUT PLAN Scale: 1"=10'-0"




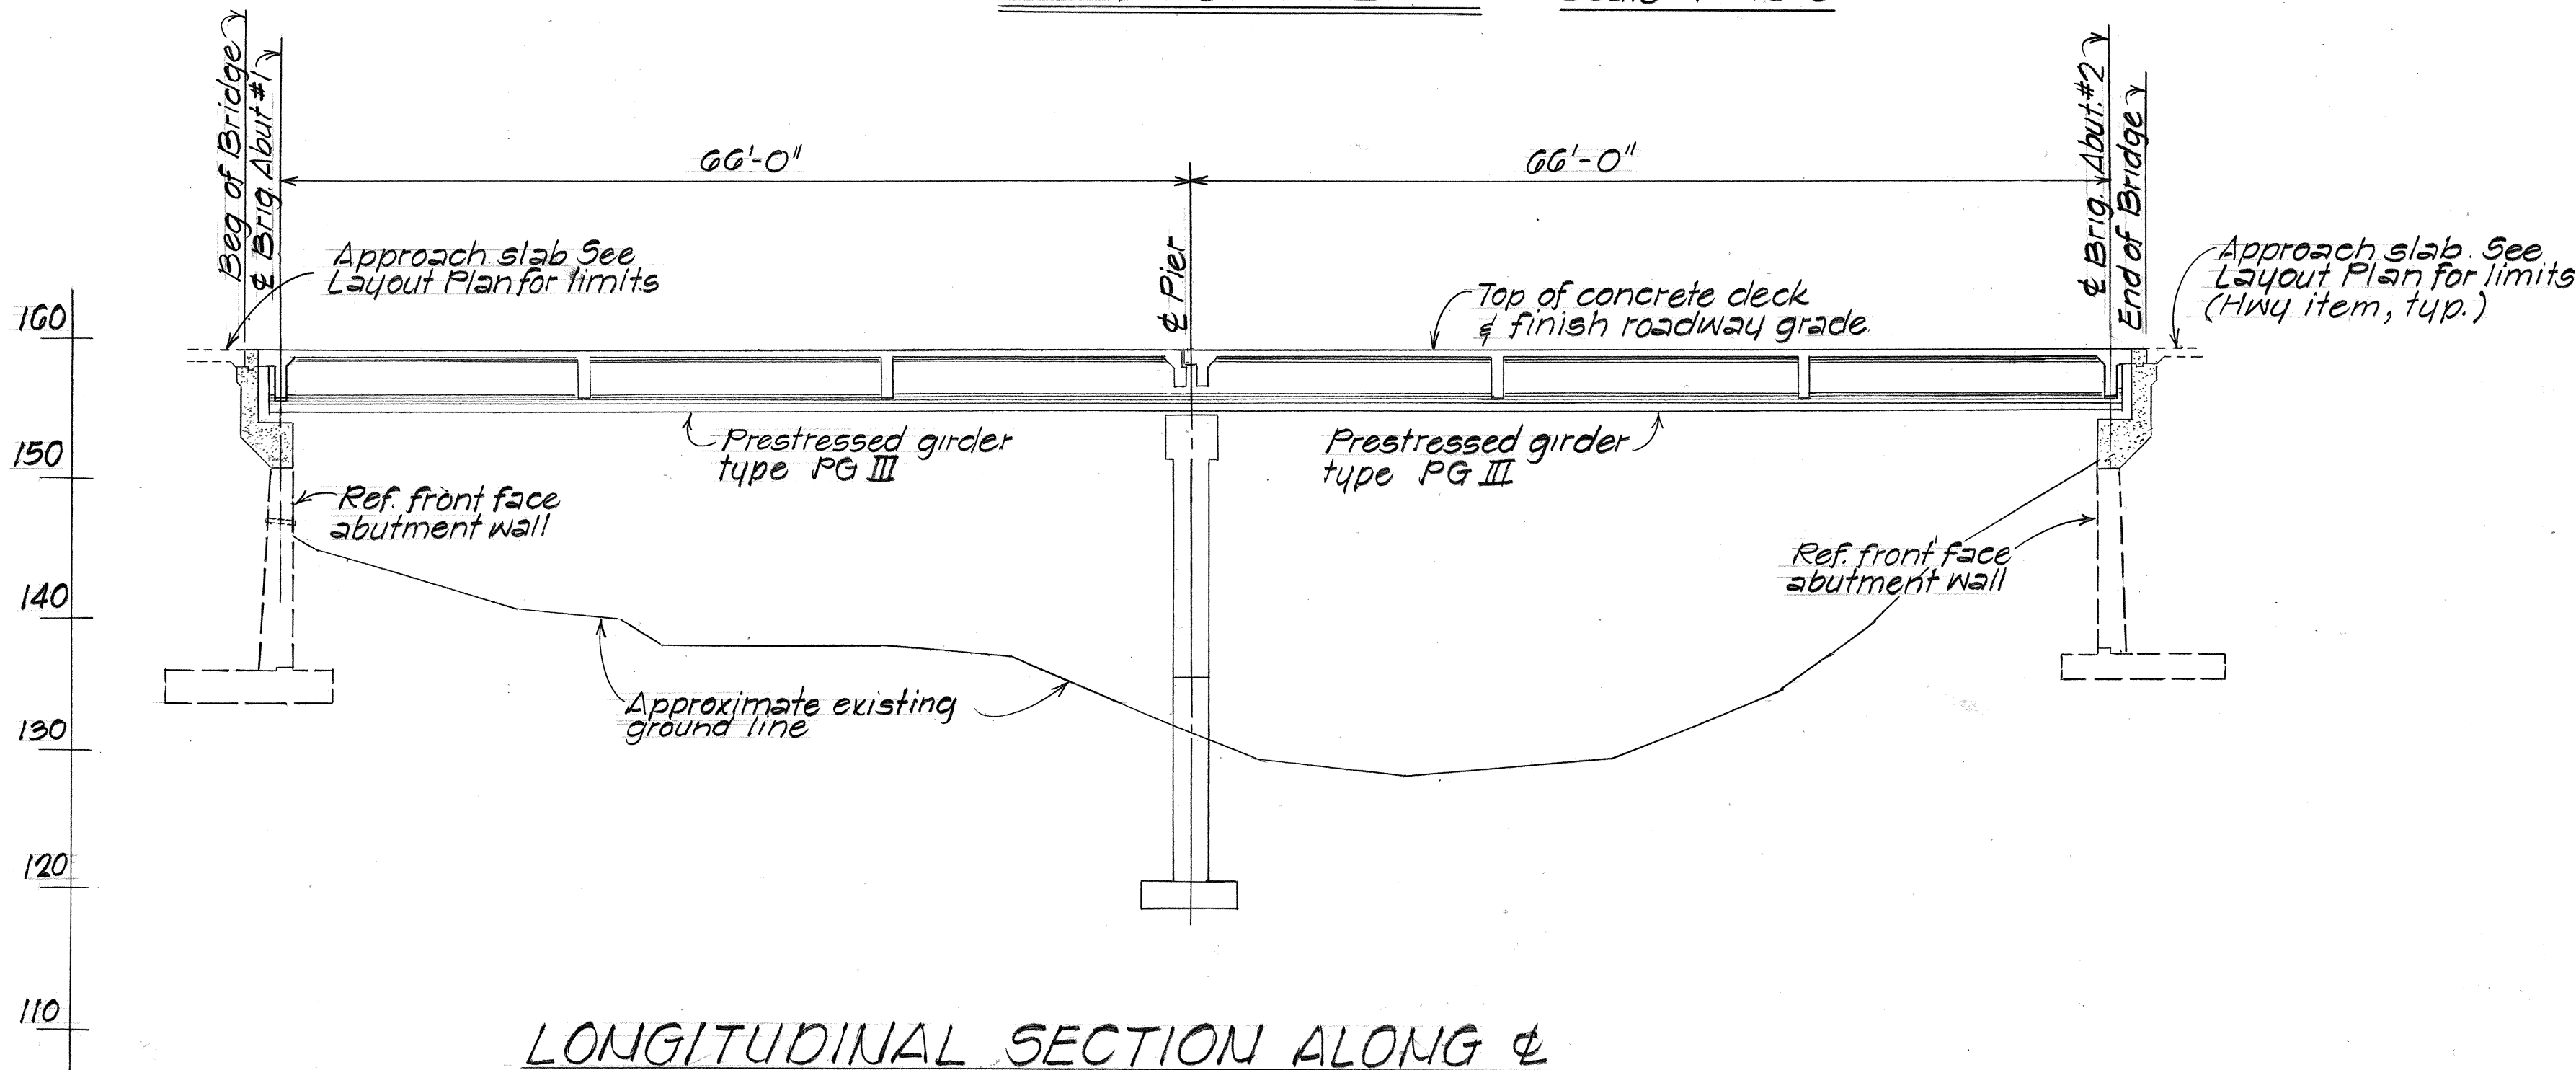


LONGITUDINAL SECTION ALONG & INBOUND OR OUTBOUND BRIDGES Scale: 1"=10'-0"

STATE OF HAWAII DEPARTMENT OF TRANSPORTATION HIGHWAYS DIVISION
HONOUULIULI STREAM BRIDGE WIDENING LAYOUT PLAN, LONGITUDINAL SECTION & ESTIMATED QUANTITIES INTERSTATE ROUTE H-1, PALAILAI I.C. TO KUNIA I.C. CONSTRUCTION OF ADDITIONAL LANES FAI PROJ. NO. 1R-HI-1(18D) Scale: As Shown Date: July 1985
SHEET No. 57 OF 12 SHEETS

FED. ROAD DIST. NO.	STATE	FED. AID PROJ. NO.	FISCAL YEAR	SHEET NO.	TOTAL SHEETS
HAWAII	HAW.	12-HI-1(180)	1986	50	99




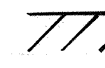
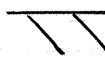
- NOTE:
- Hatched area shown thus  denotes limits of structure excavation payline. All other excavation shall be roadway excavation.
 - Hatched area shown thus  denotes limits of structure backfill.

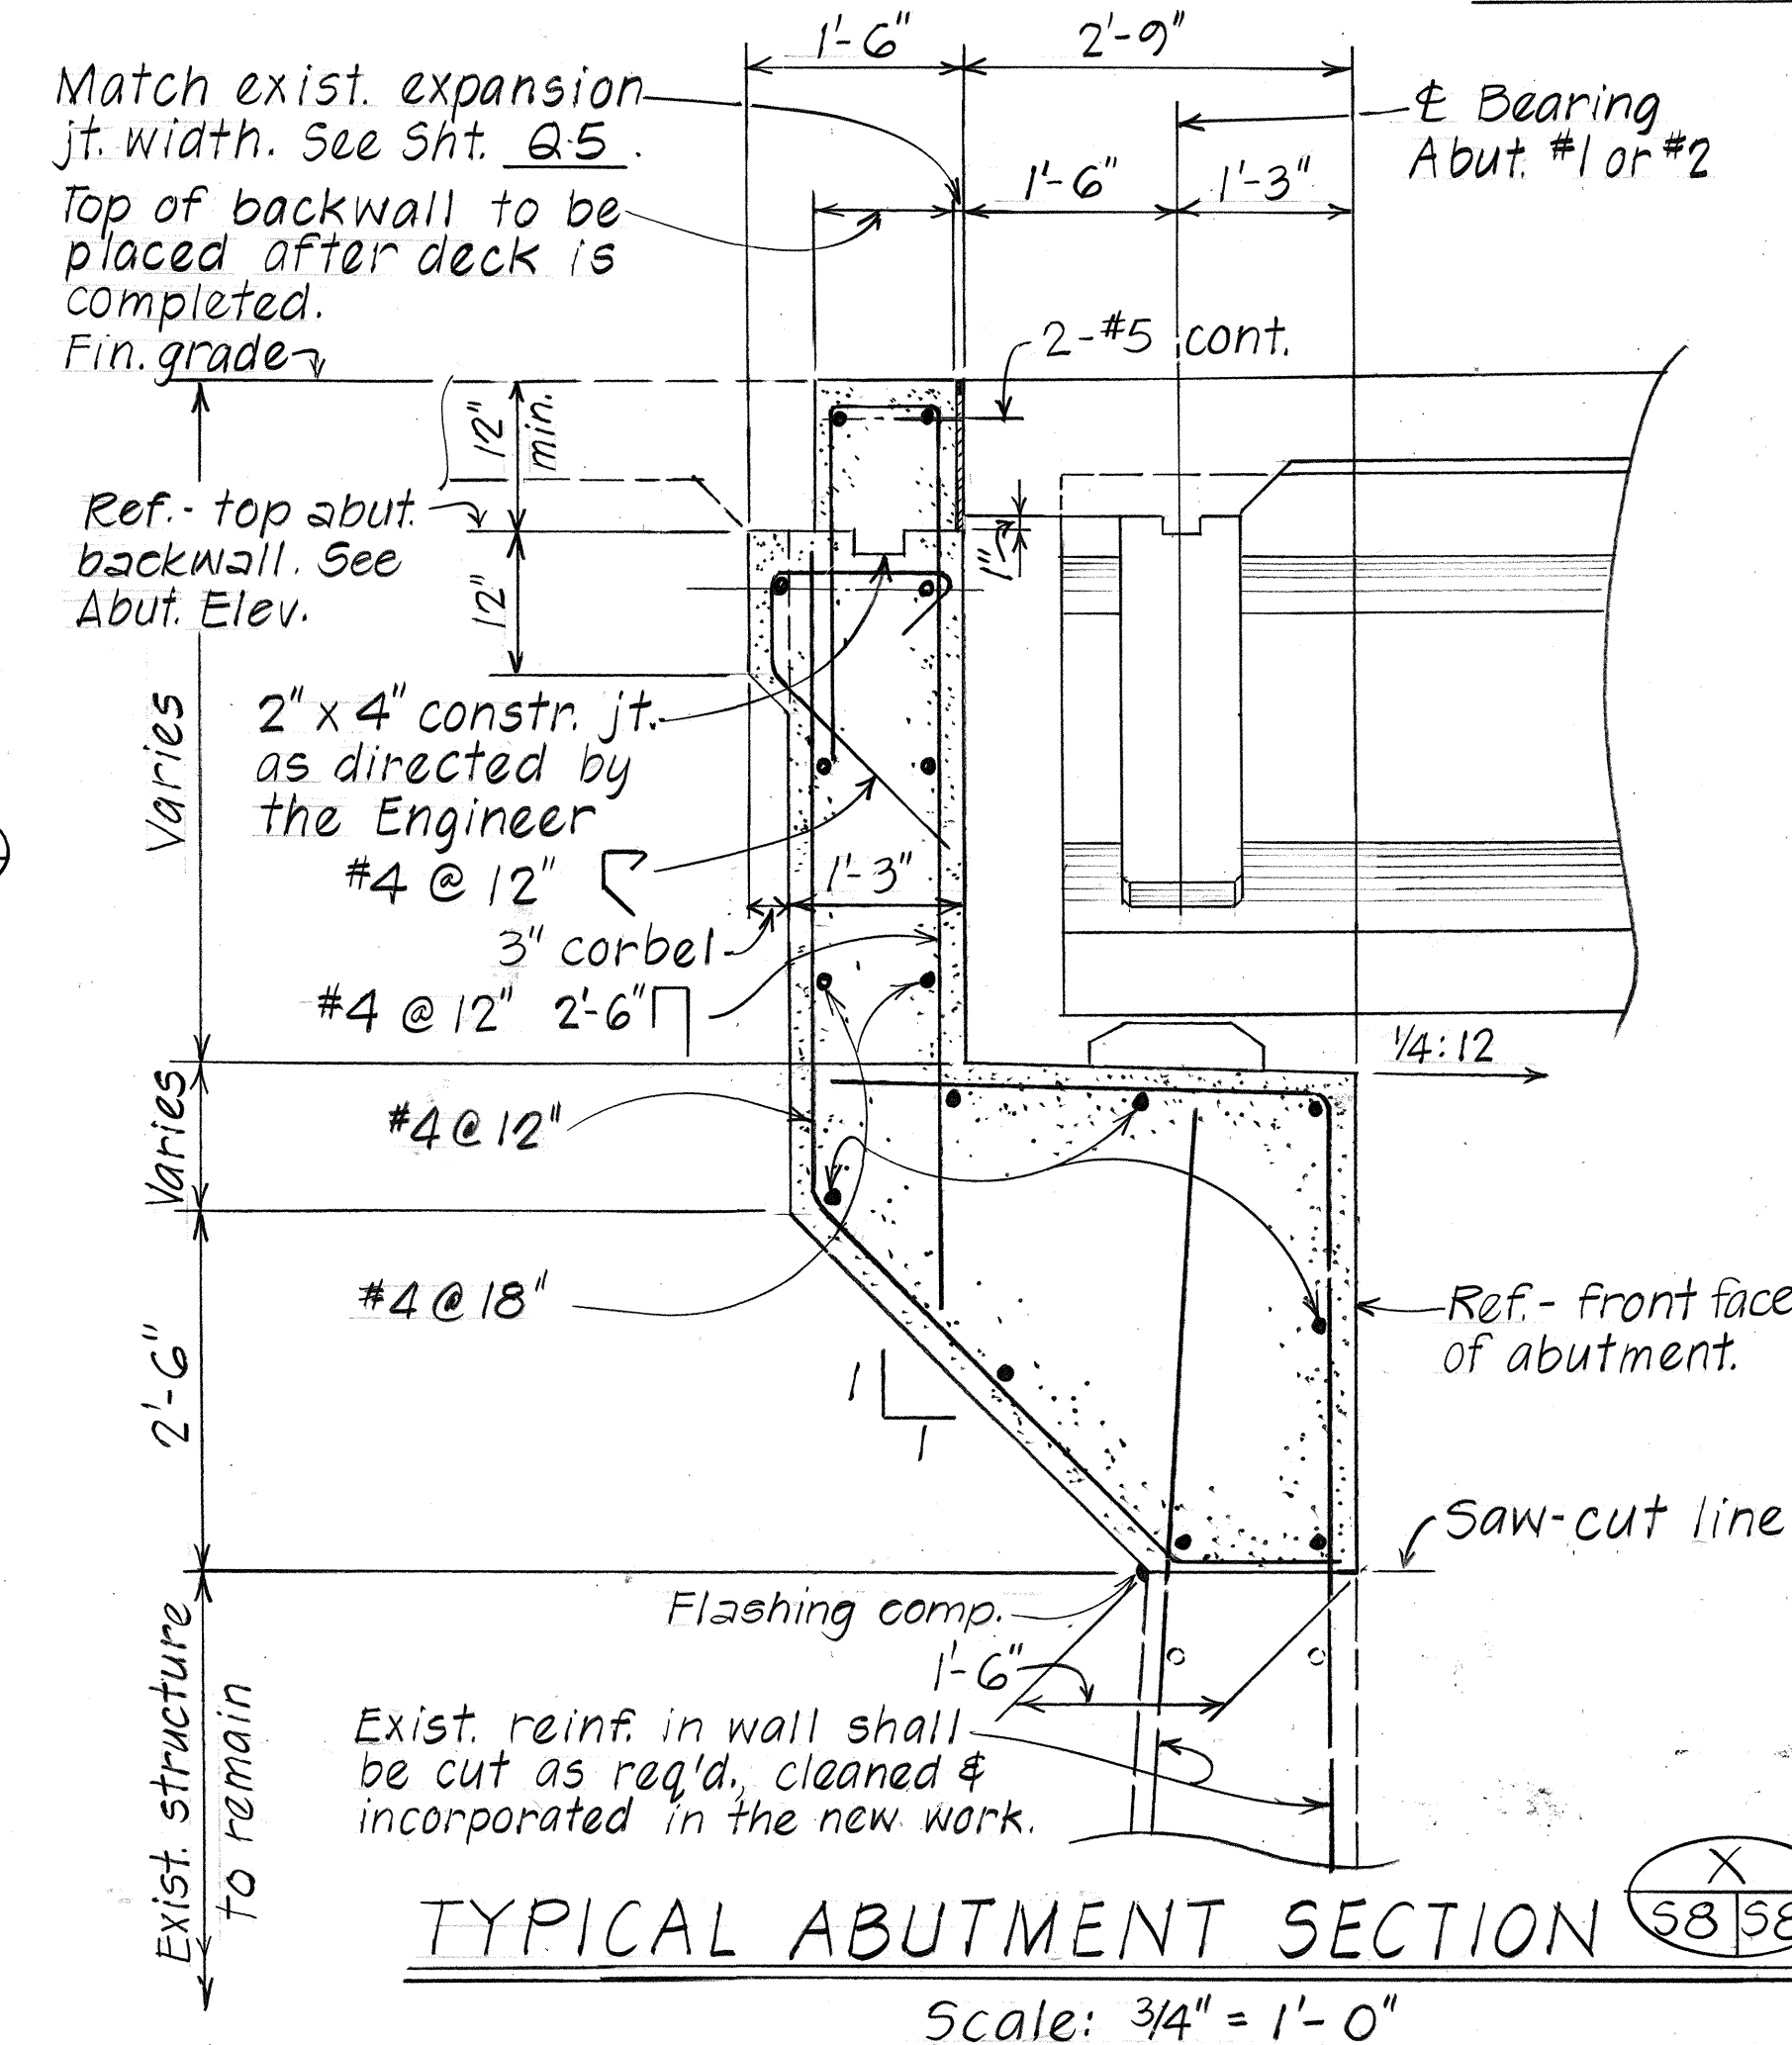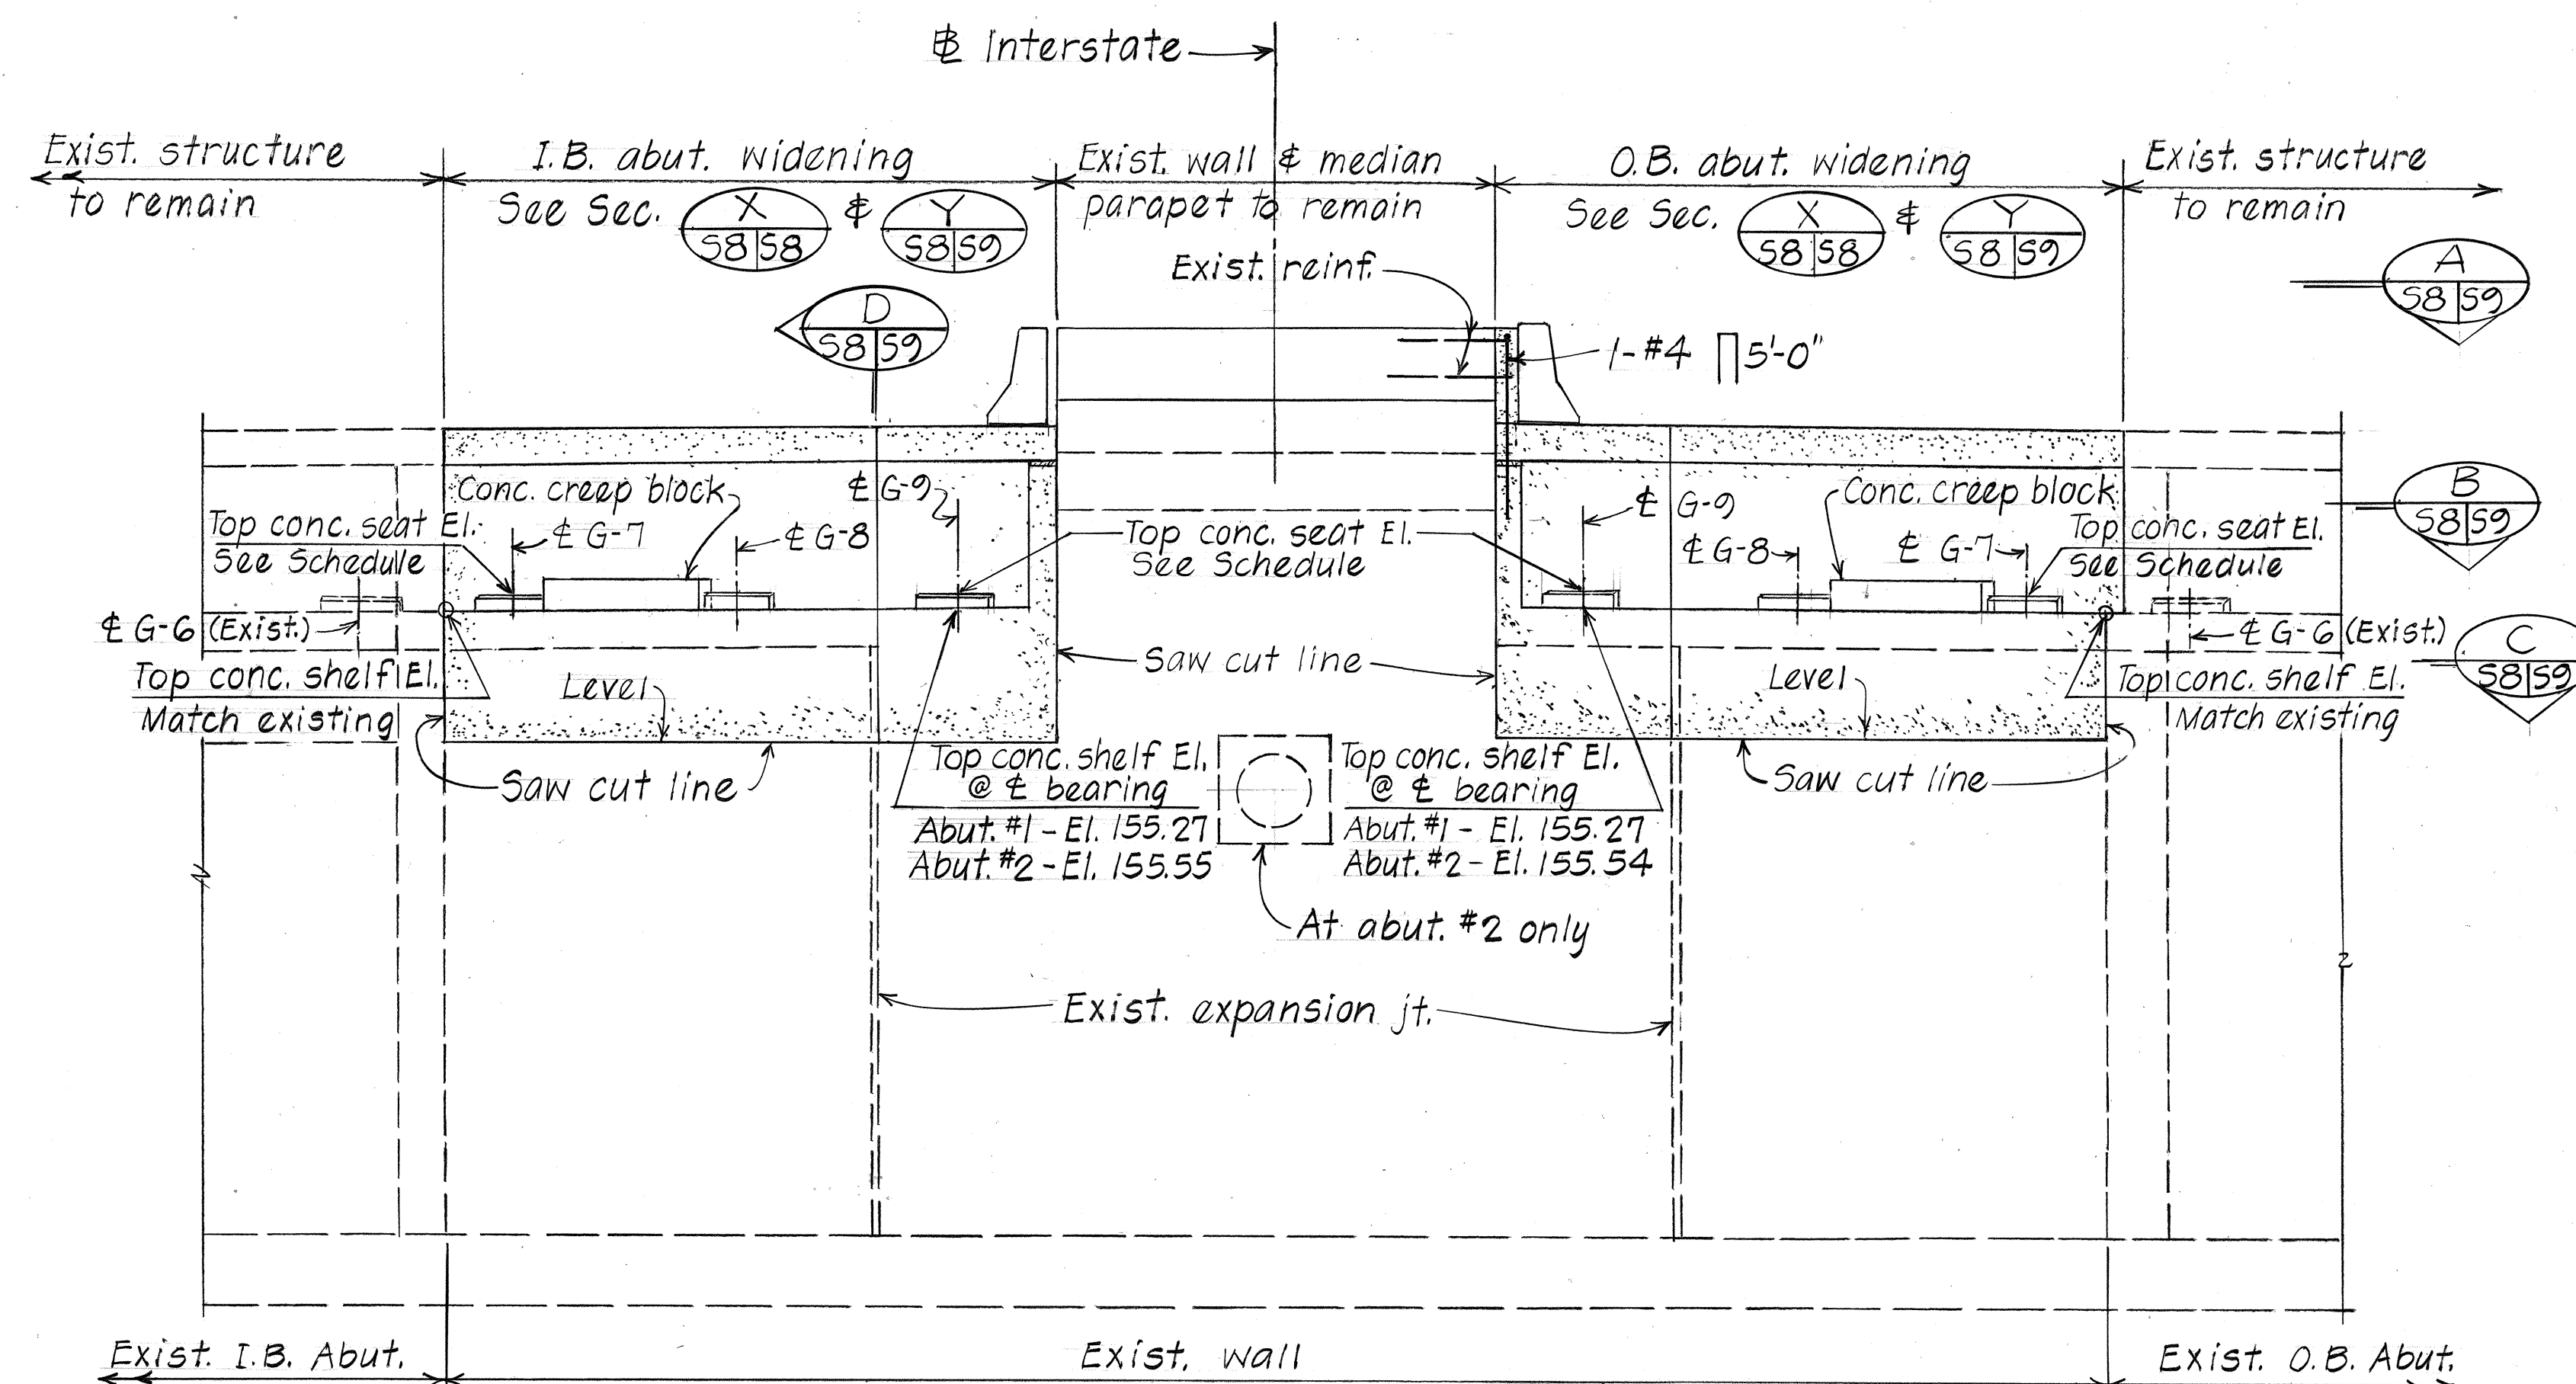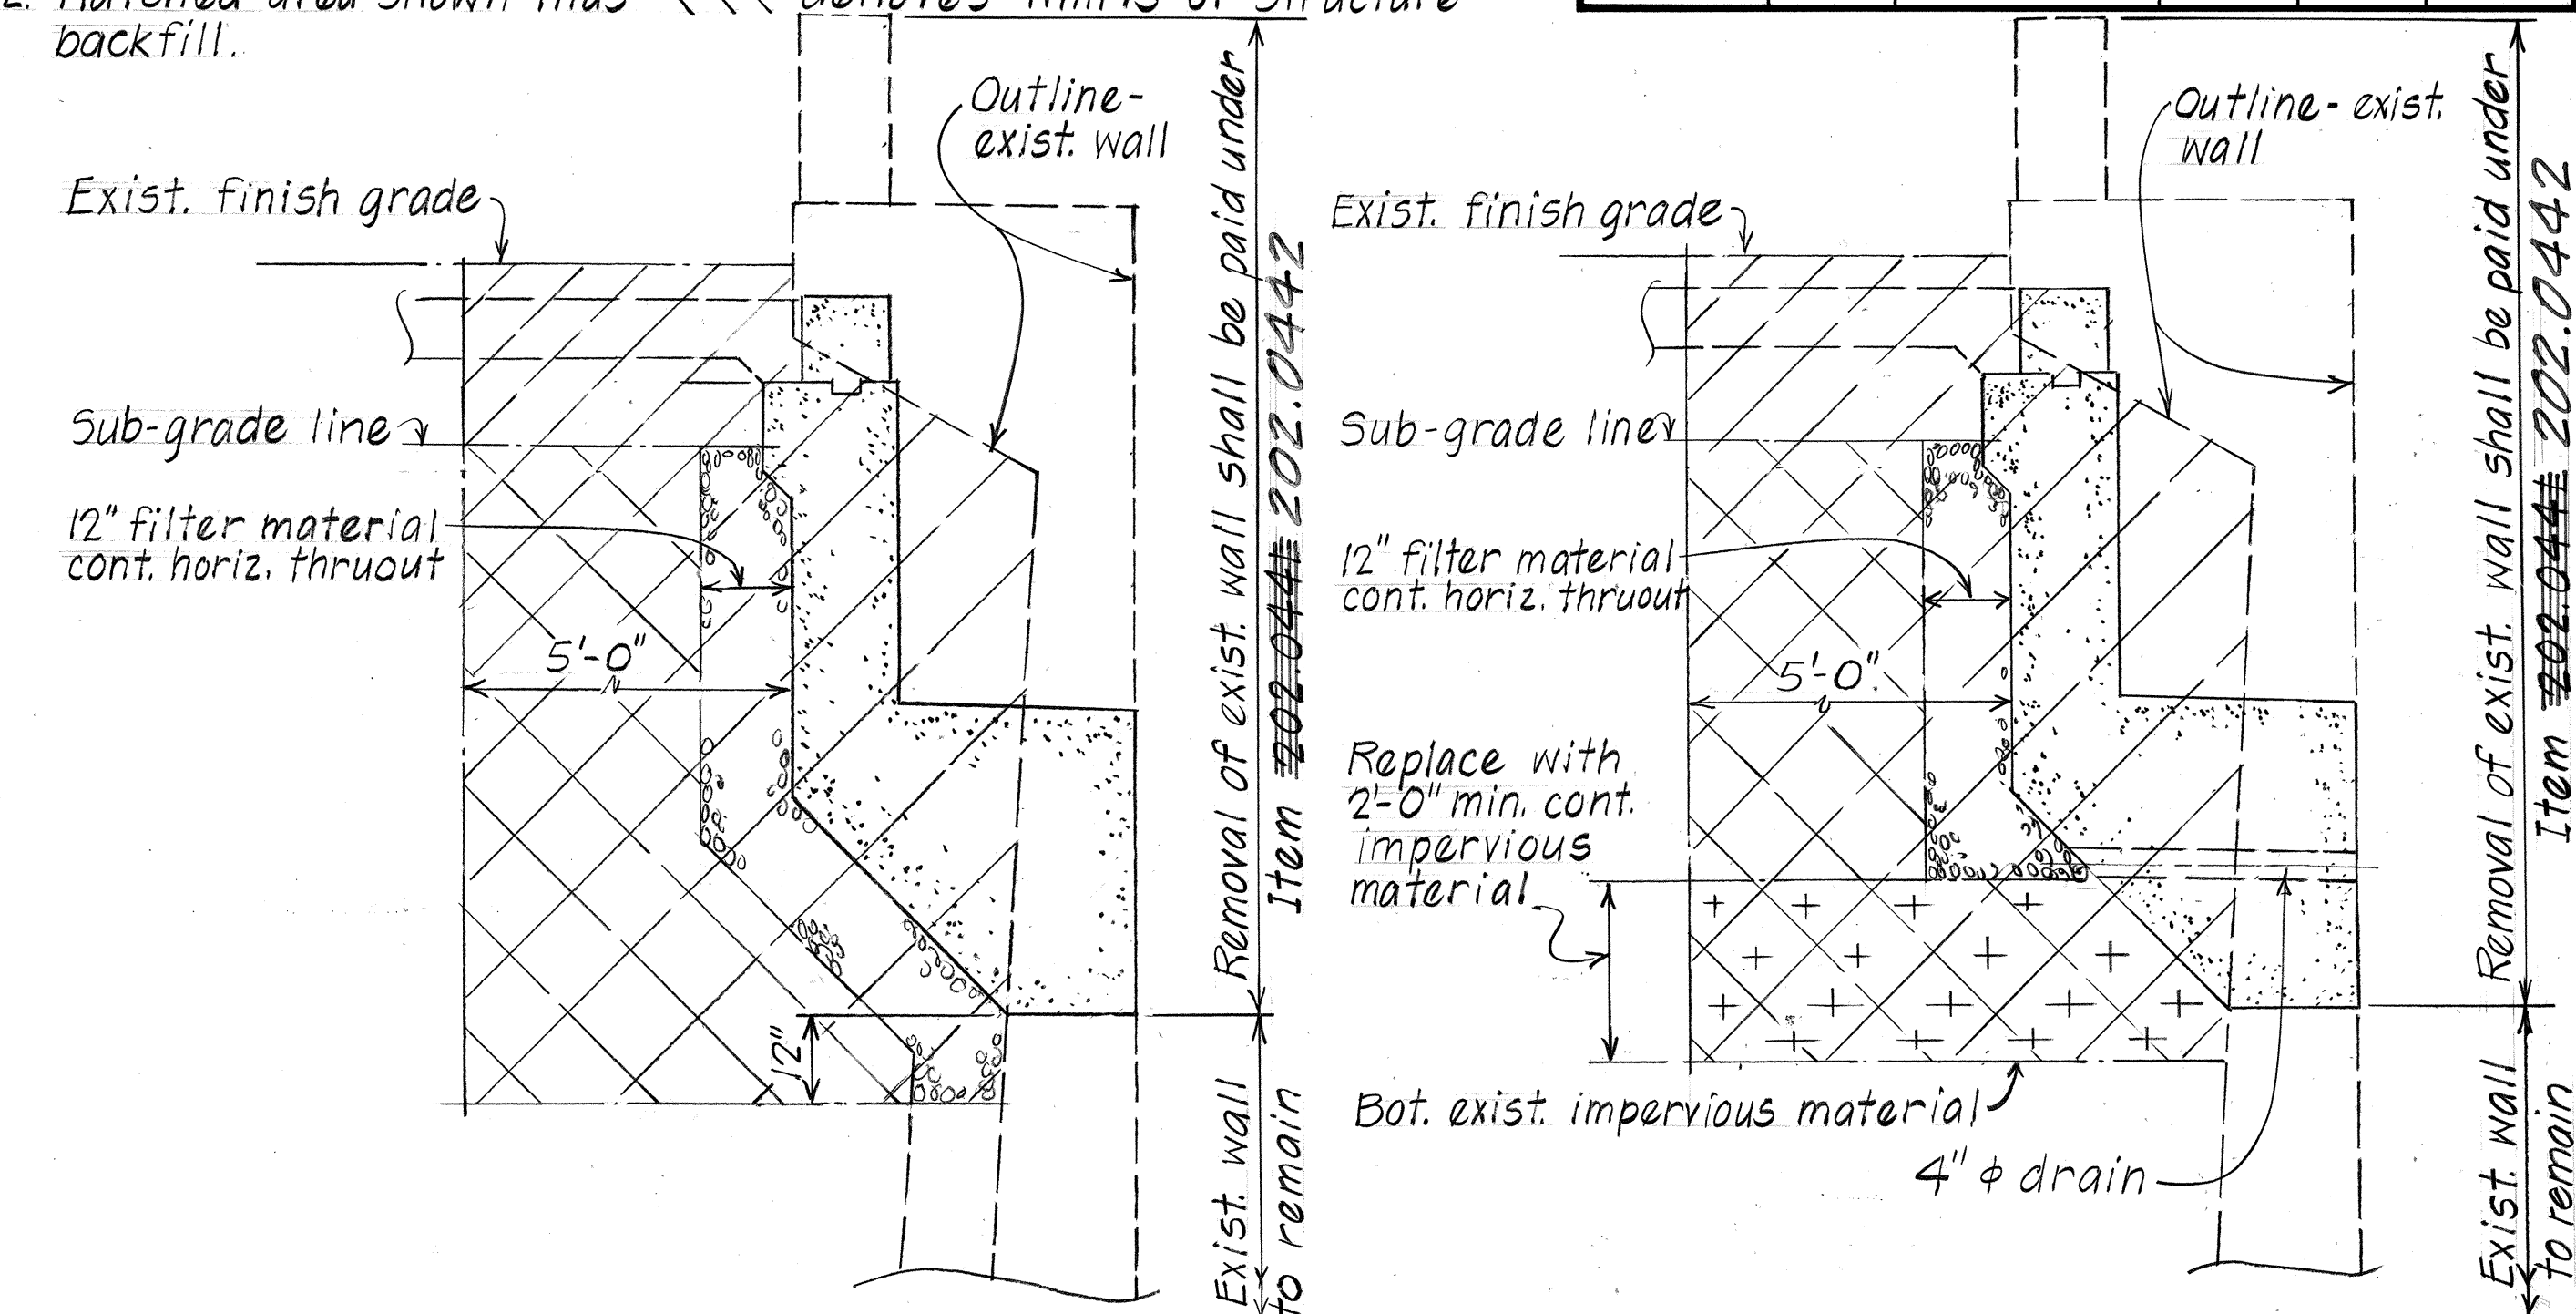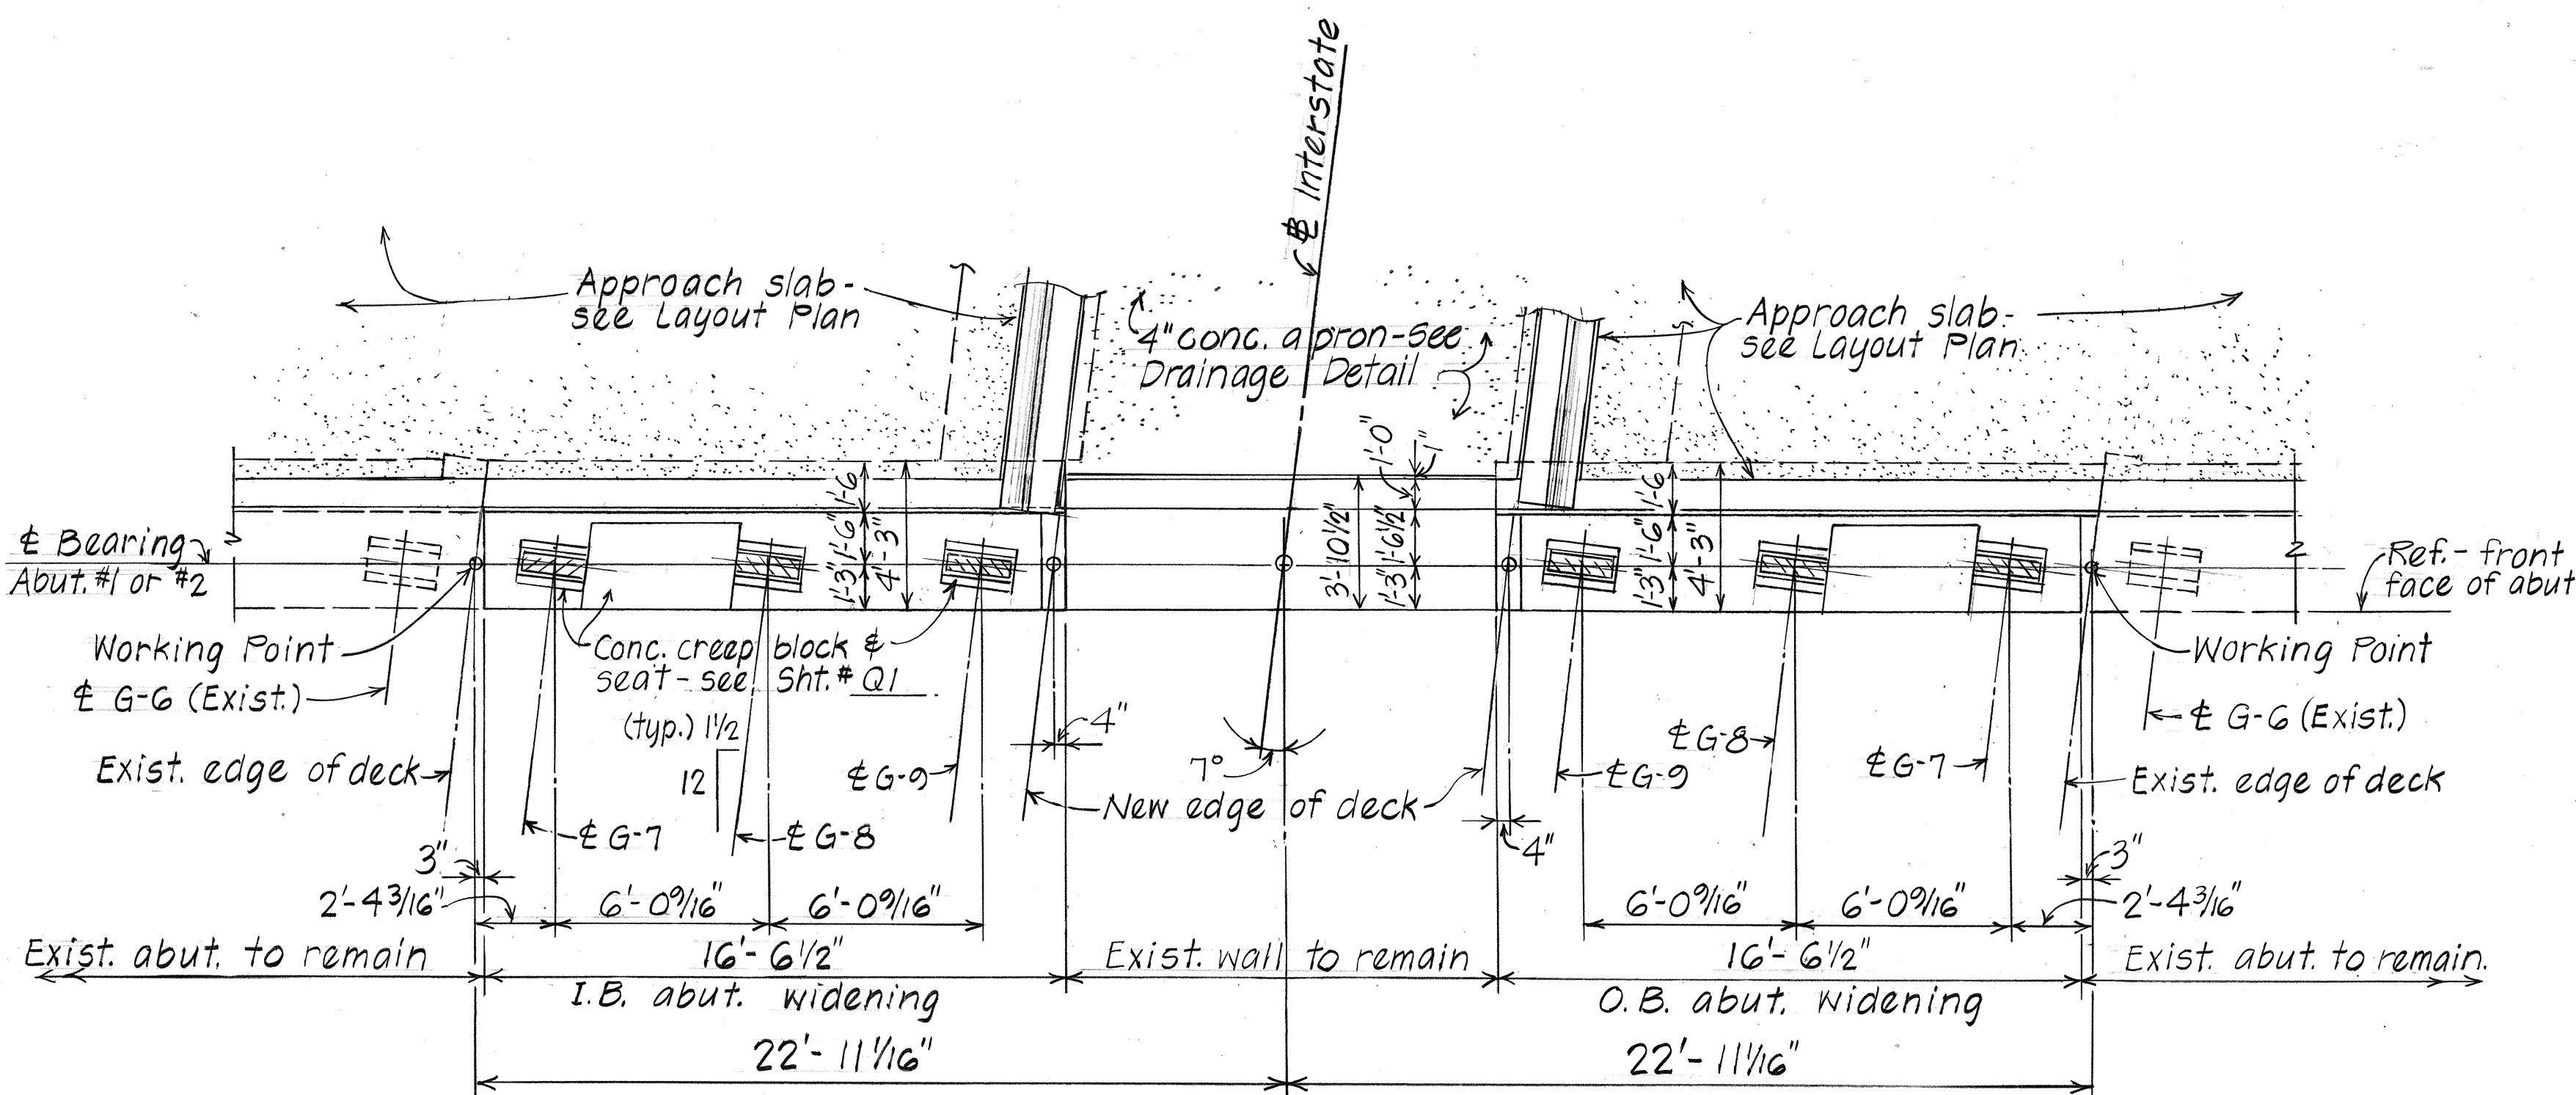

STATE OF HAWAII DEPARTMENT OF TRANSPORTATION HIGHWAYS DIVISION	
HONOLULU STREAM BRIDGE WIDENING	
ABUTMENT ① & ② - PLAN & ELEVATION	
TYPICAL ABUT. SECT. TYP. STRUCT. EXC. DETS.	
INTERSTATE ROUTE H-1, PALAILAI I.C. TO KUNIA I.C. CONSTRUCTION OF ADDITIONAL LANES	
F.A.I. PROJ. NO. 12-HI-1(180)	
Scale: As Shown	Date: July 1985
SHEET NO. 50 OF 12 SHEETS	

ORIGINAL PLAN	DATE
NO. 1	7/85
NO. 2	7/85
NO. 3	7/85
NO. 50	7/85


FED. ROAD DIST. NO.	STATE	FED. AID PROJ. NO.	FISCAL YEAR	SHEET NO.	TOTAL SHEETS
HAWAII	HAW.	1R-HI-1(185)	1986	60	99

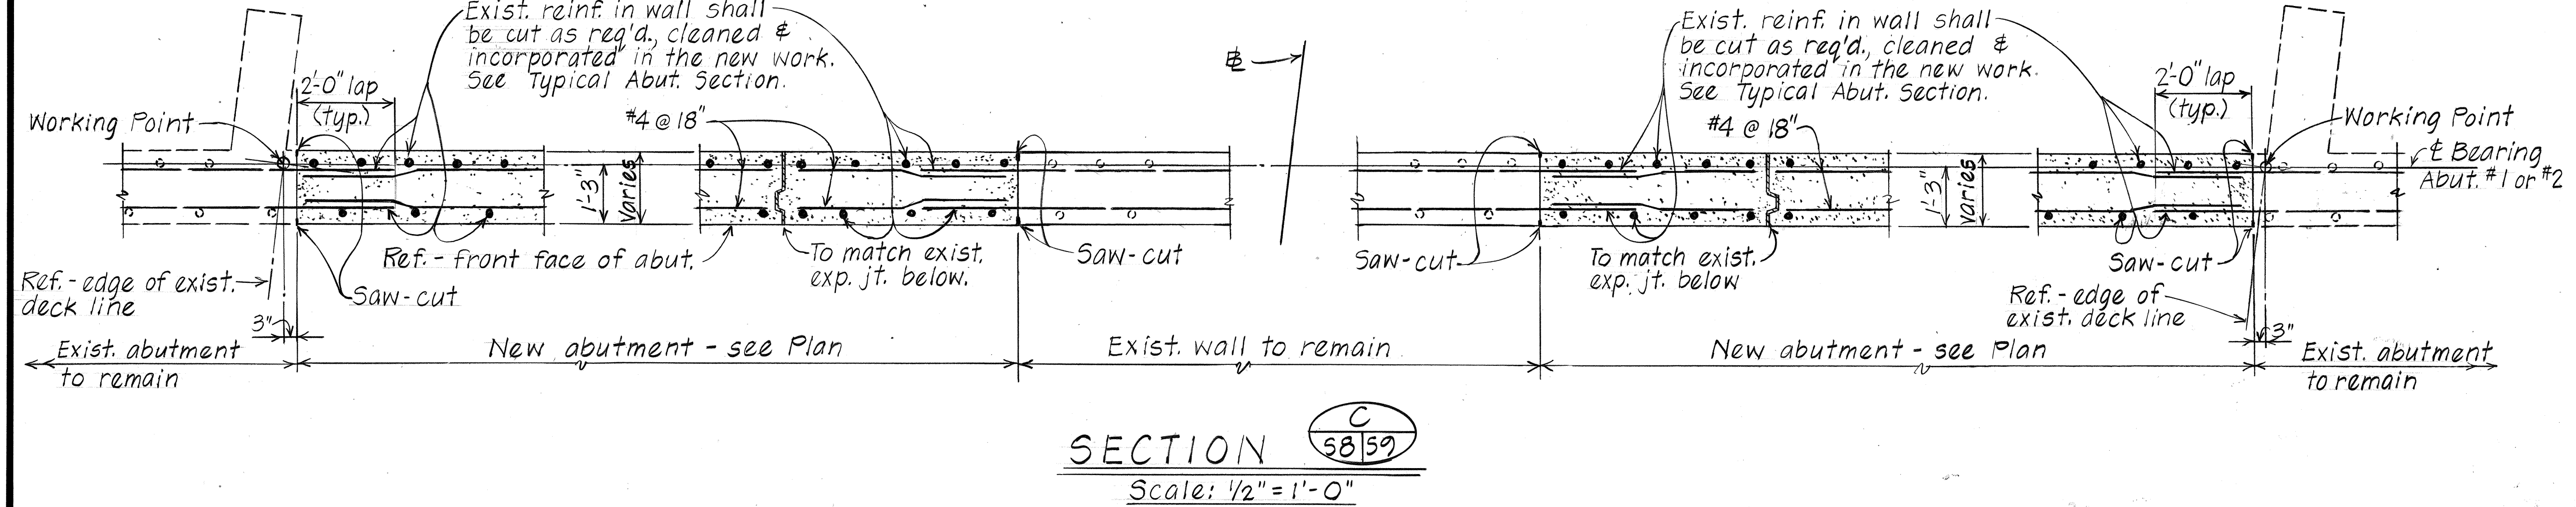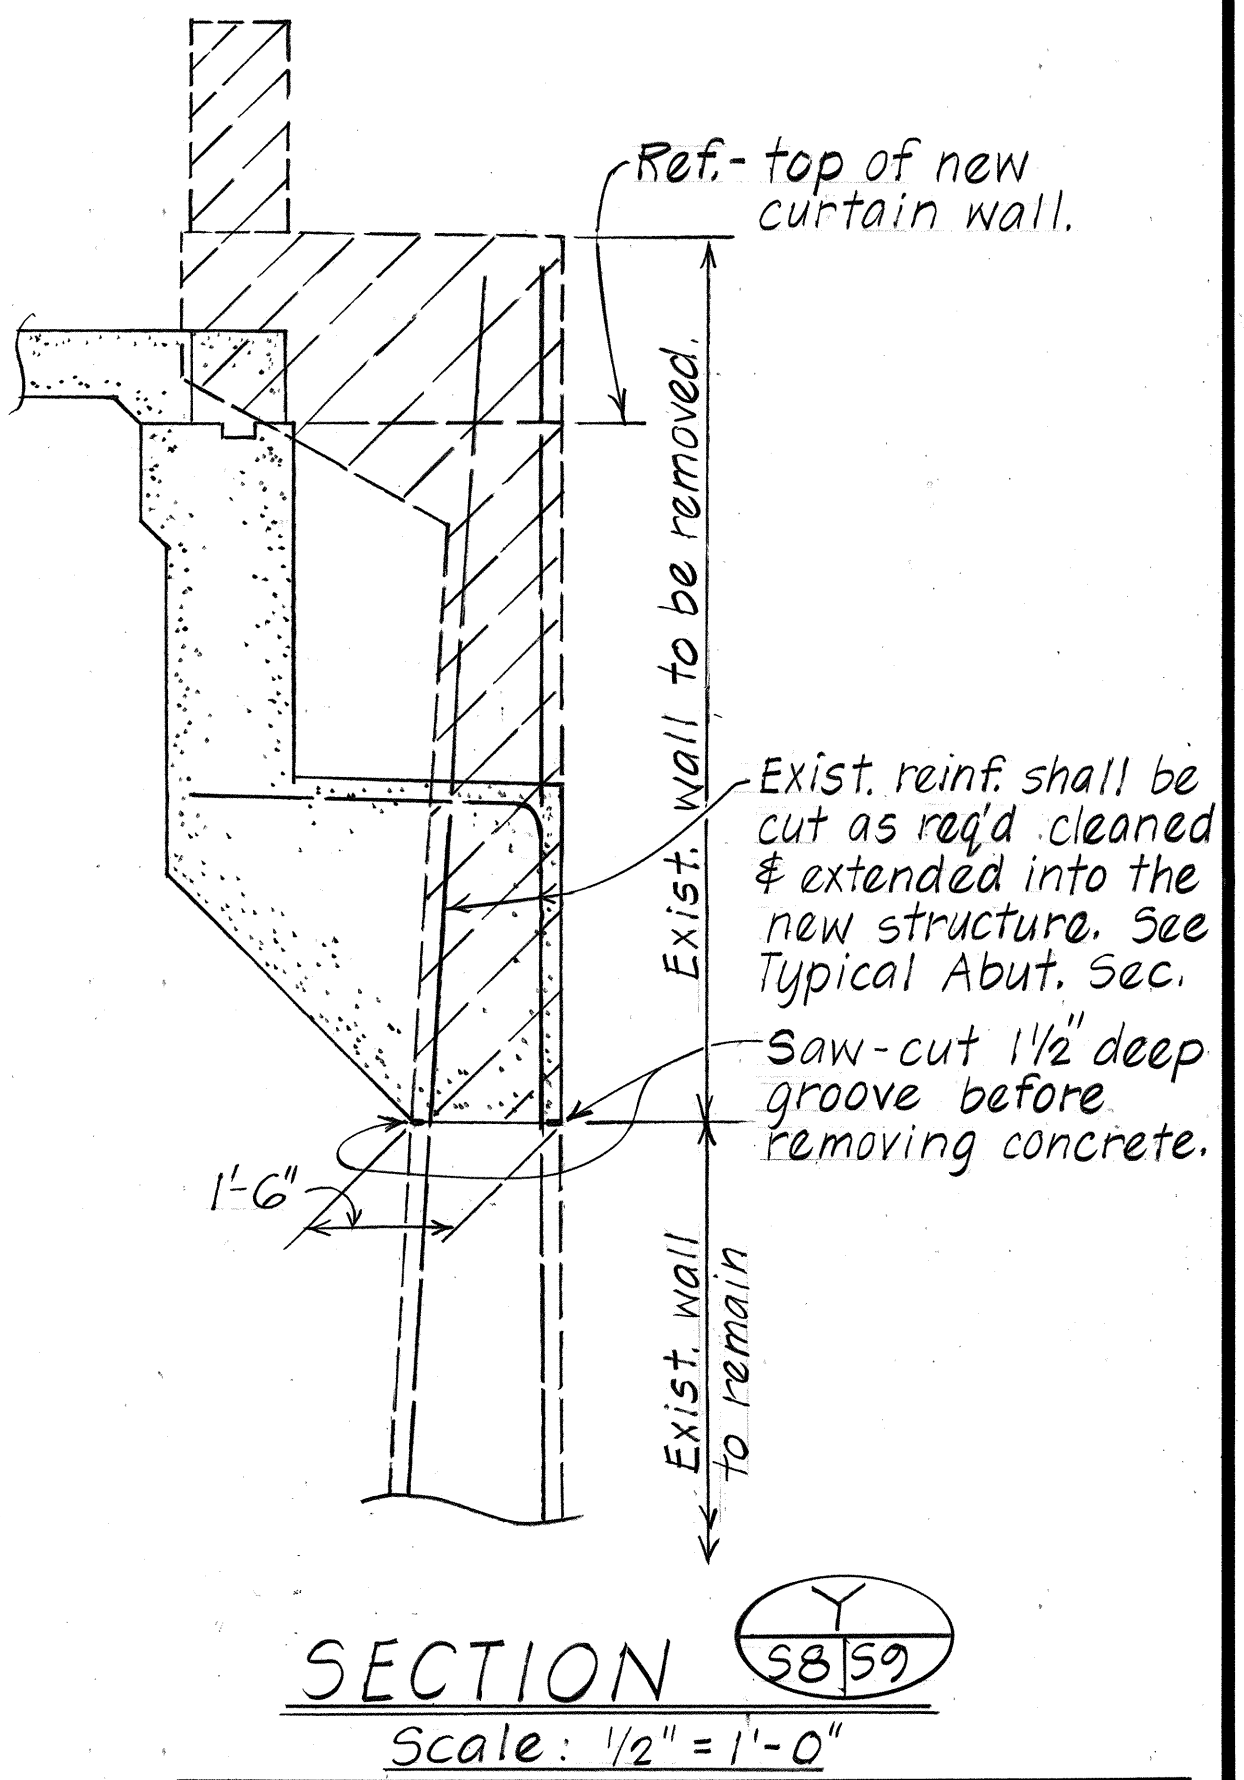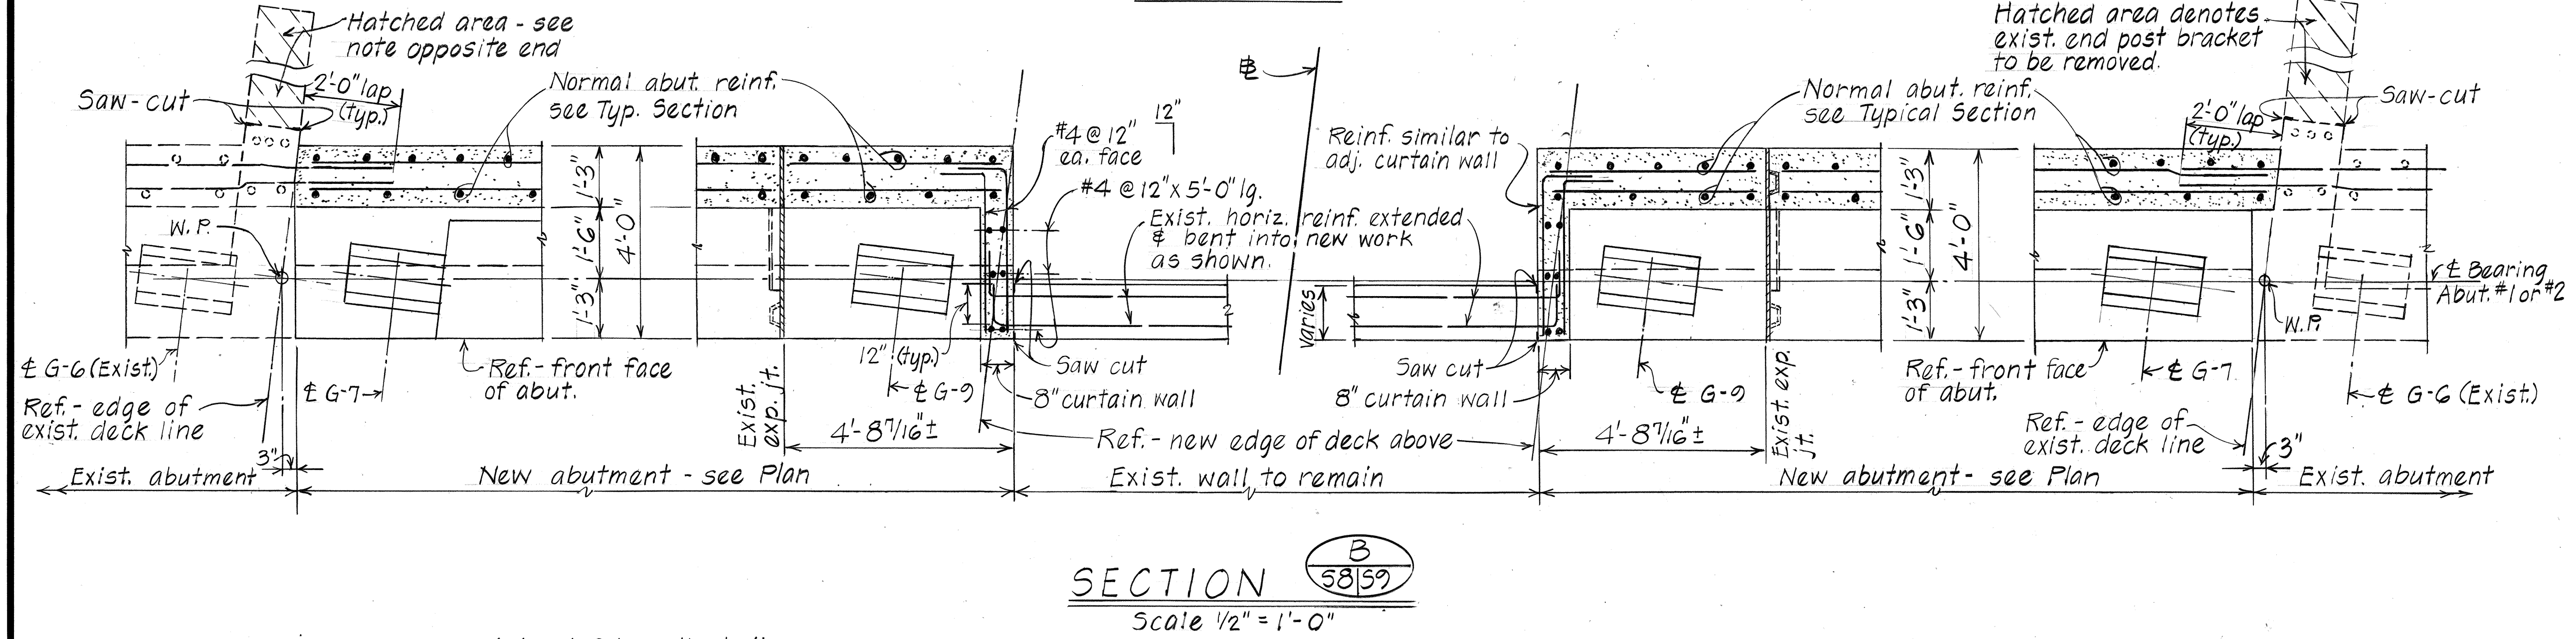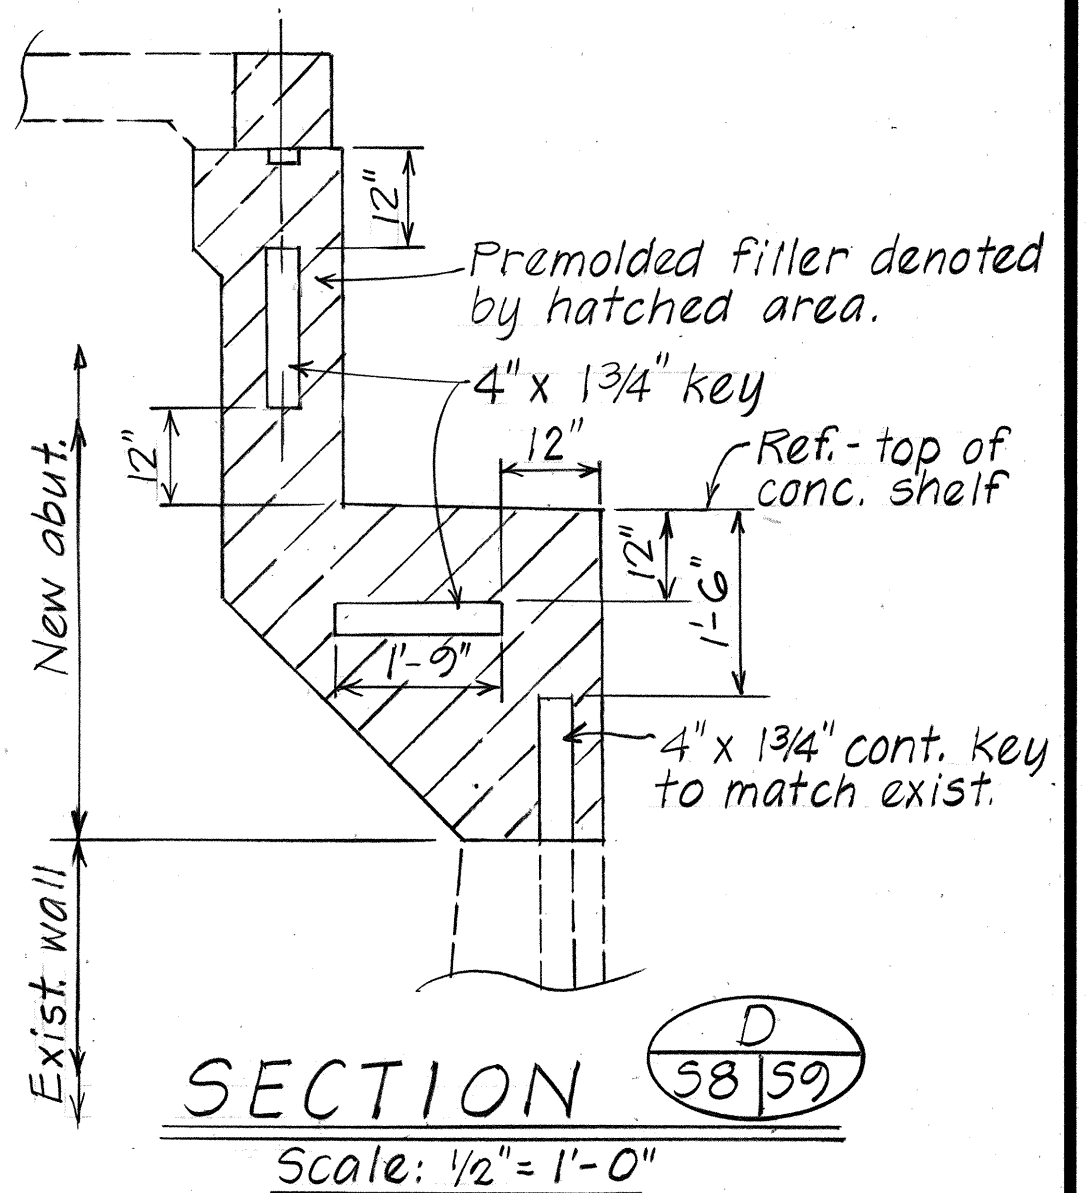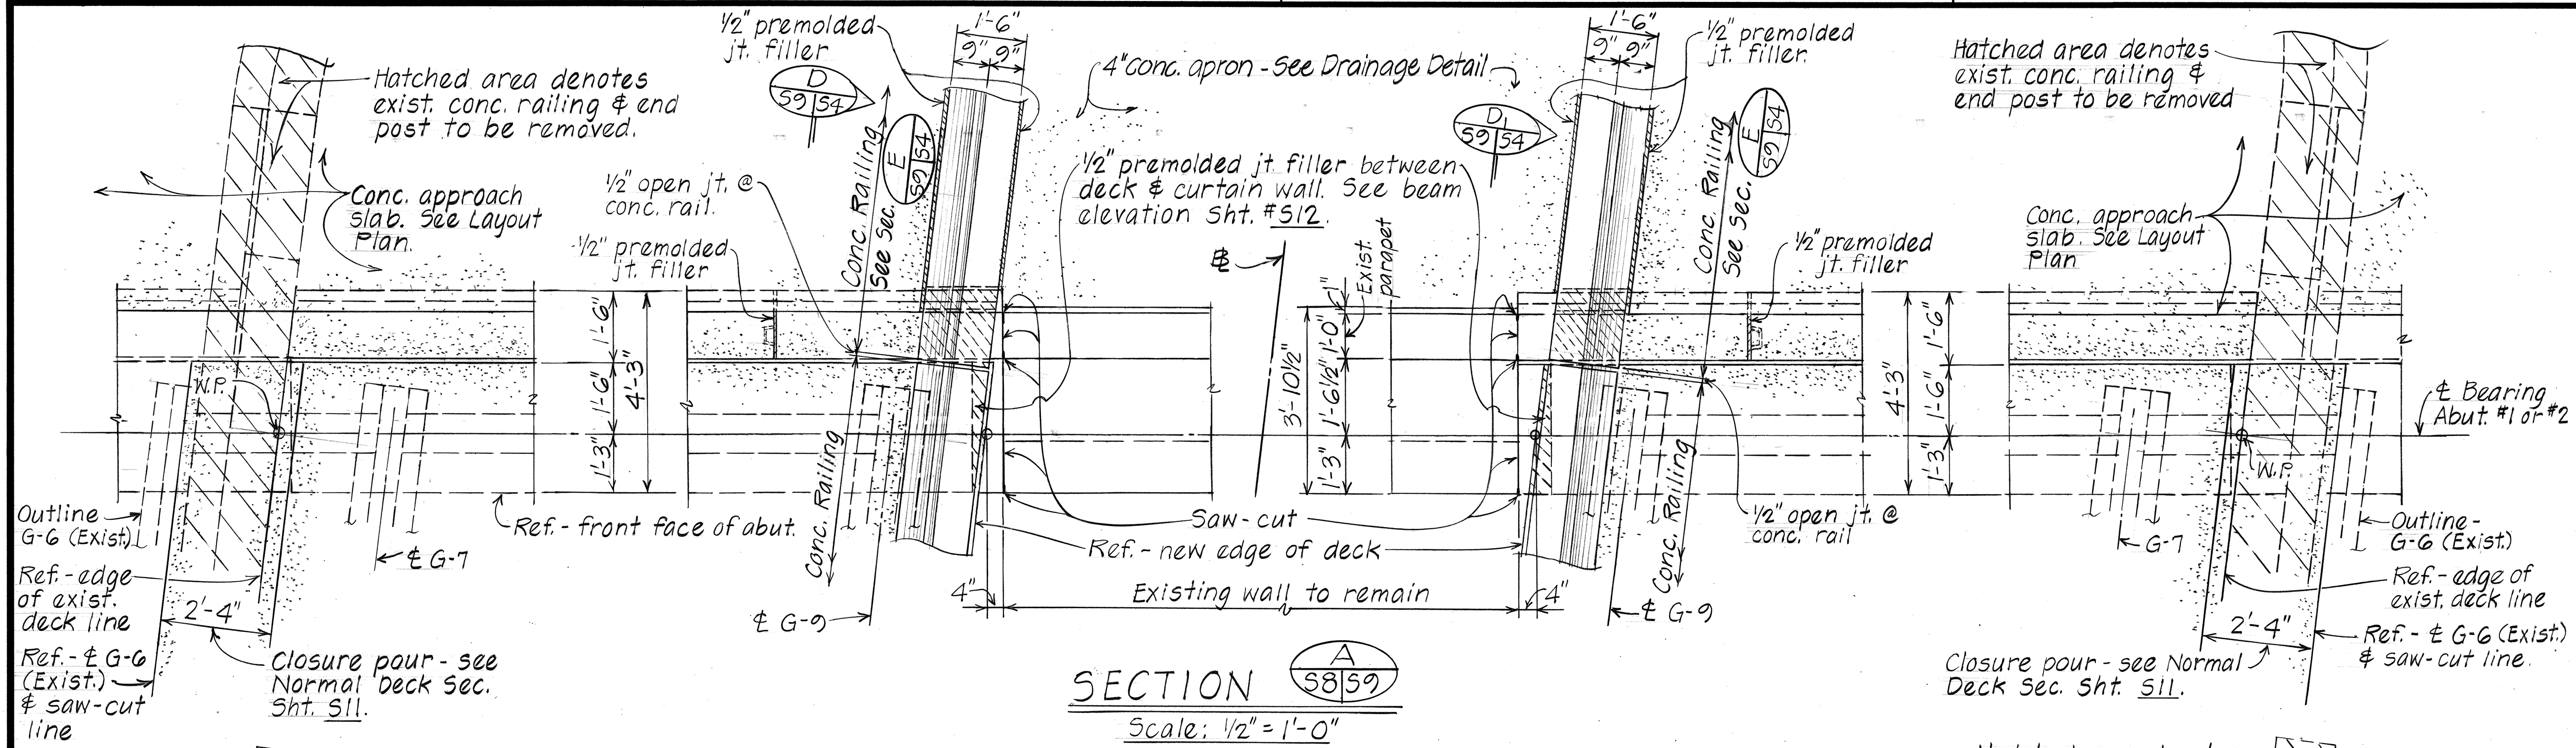


STATE OF HAWAII
DEPARTMENT OF TRANSPORTATION
HIGHWAYS DIVISION
HONOLULU
HONOLULU STREAM BRIDGE WIDENING
ABUTMENT ① & ② SECTIONS
INTERSTATE ROUTE H-1, PALAIALA I.C. TO
KUNIA I.C. CONSTRUCTION OF ADDITIONAL LANES
F.A.I. PROJ. NO. 1R-HI-1(185)
Scale: As Shown Date: July 1985
SHEET No. 59 OF 12 SHEETS

ORIGINAL PLAN	DATE	7/85
DRAWN BY	DATE	7/85
DESIGNED BY	DATE	7/85
NOTED BY	DATE	7/85
CHECKED BY	DATE	7/85


FED. ROAD DIST. NO.	STATE	FED. AID PROJ. NO.	FISCAL YEAR	SHEET NO.	TOTAL SHEETS
HAWAII	HAW.	12-H1-1(180)	1986	61	99

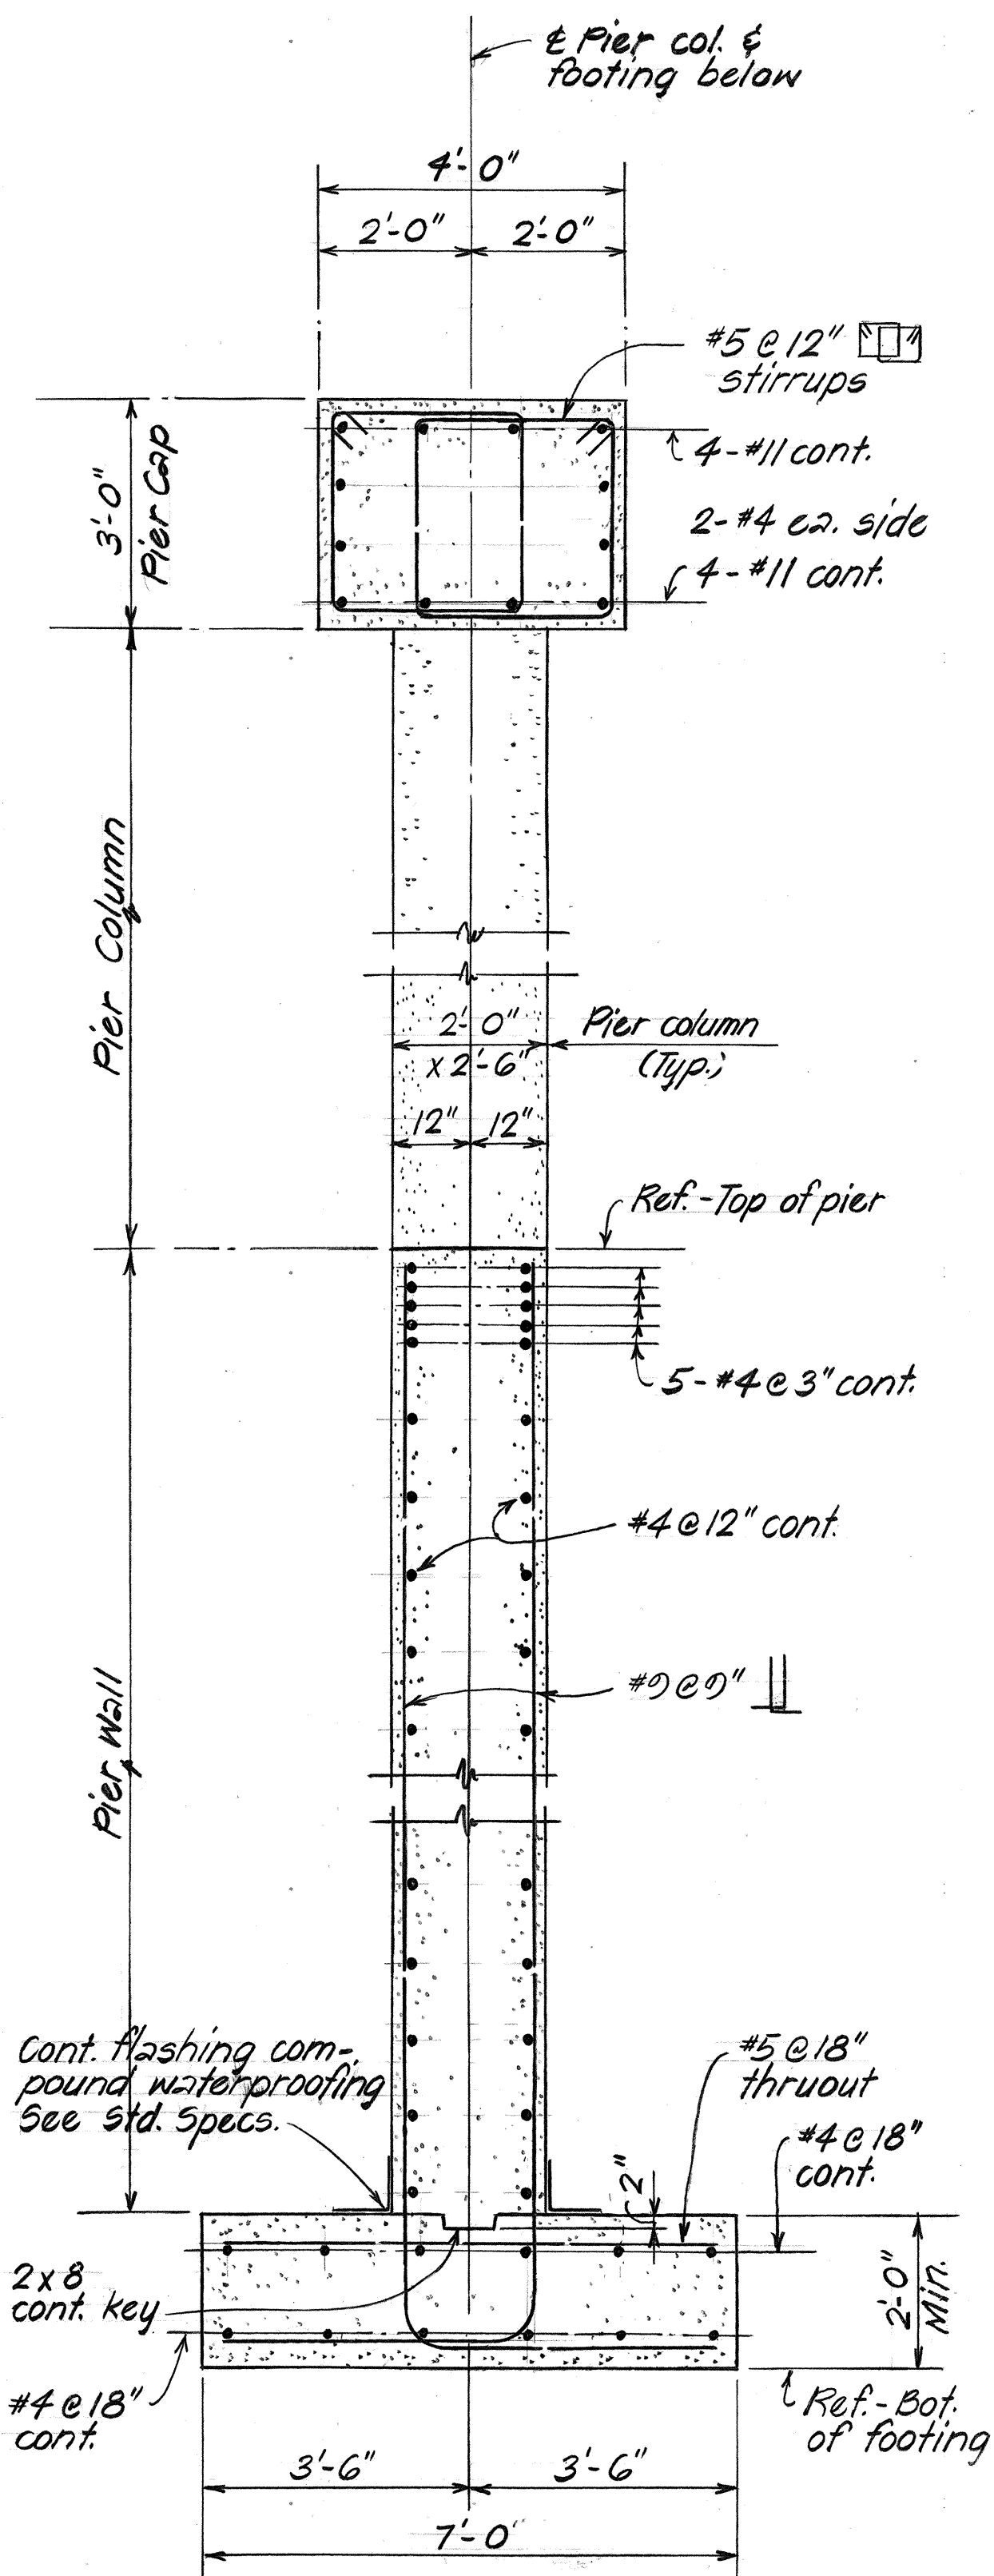


TYPICAL PIER SECTION
Scale: 1/2" = 1'-0"

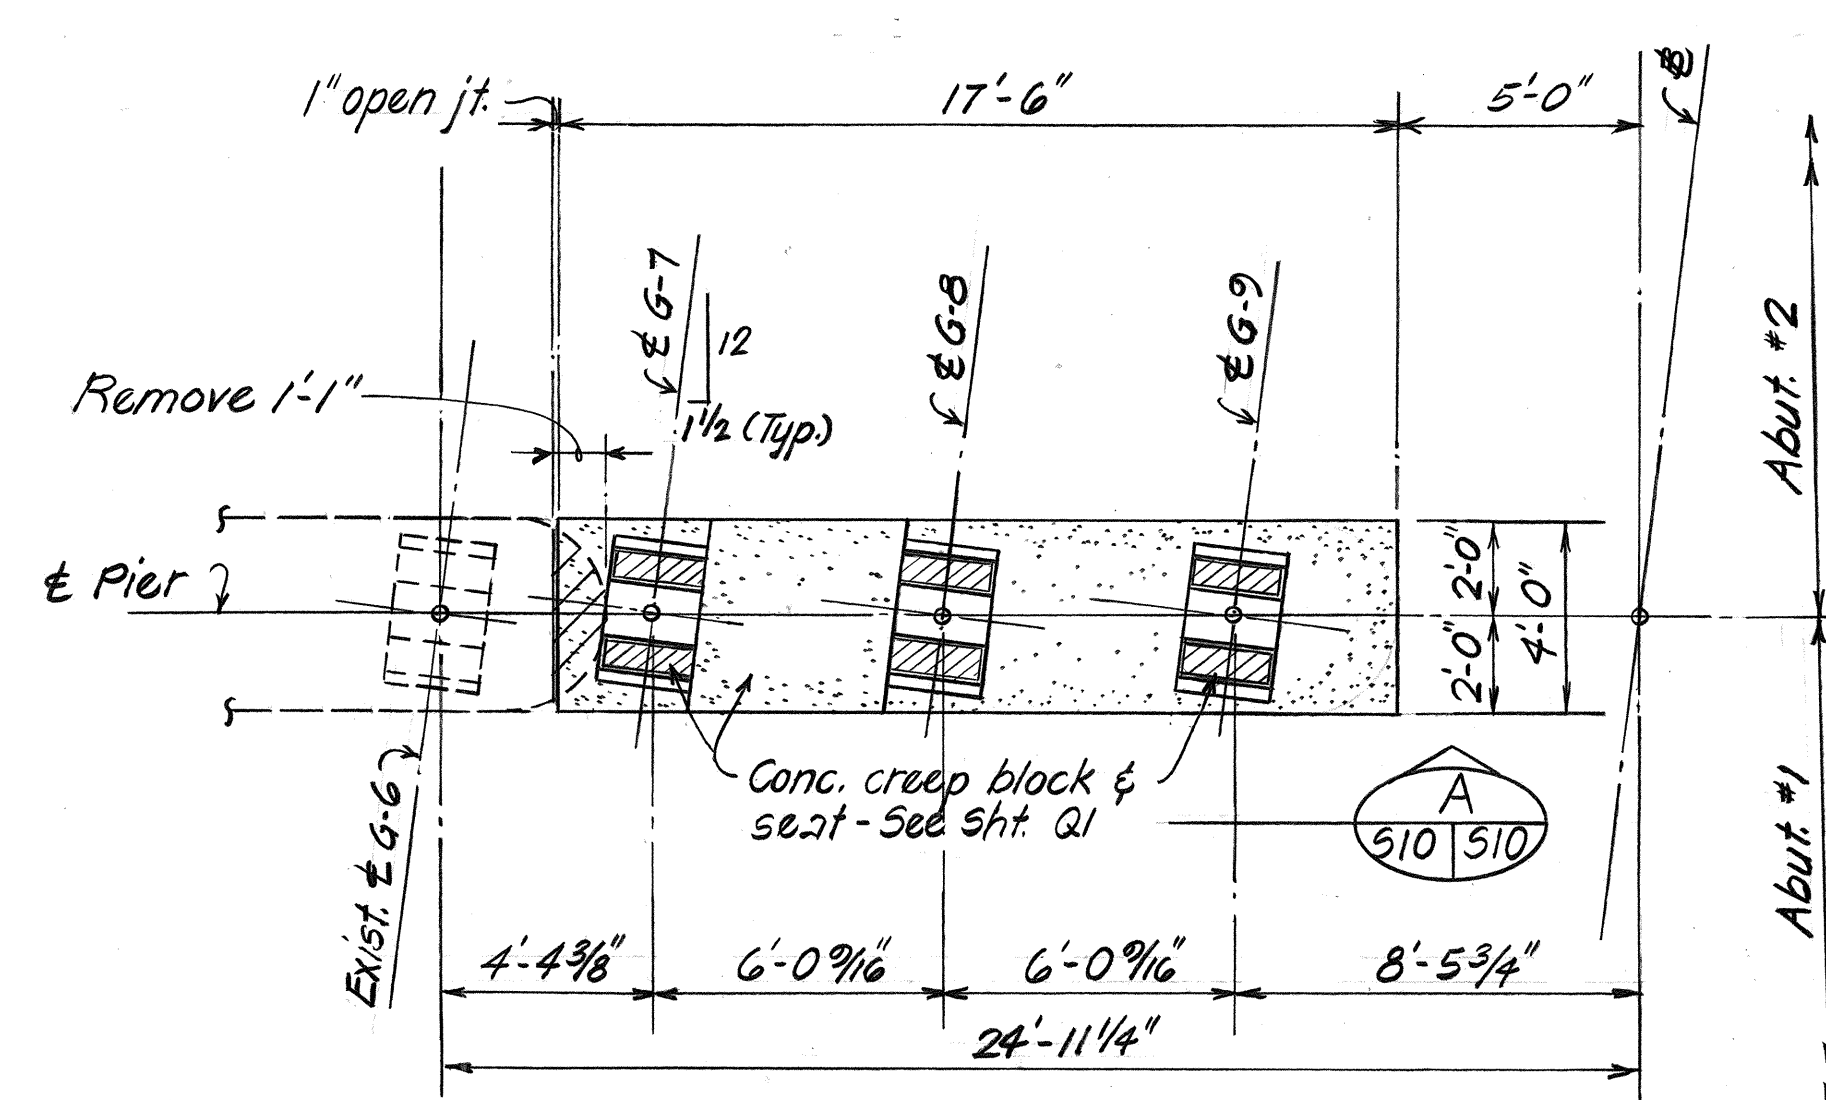


PLAN-PIER
Scale: 1/4" = 1'-0"

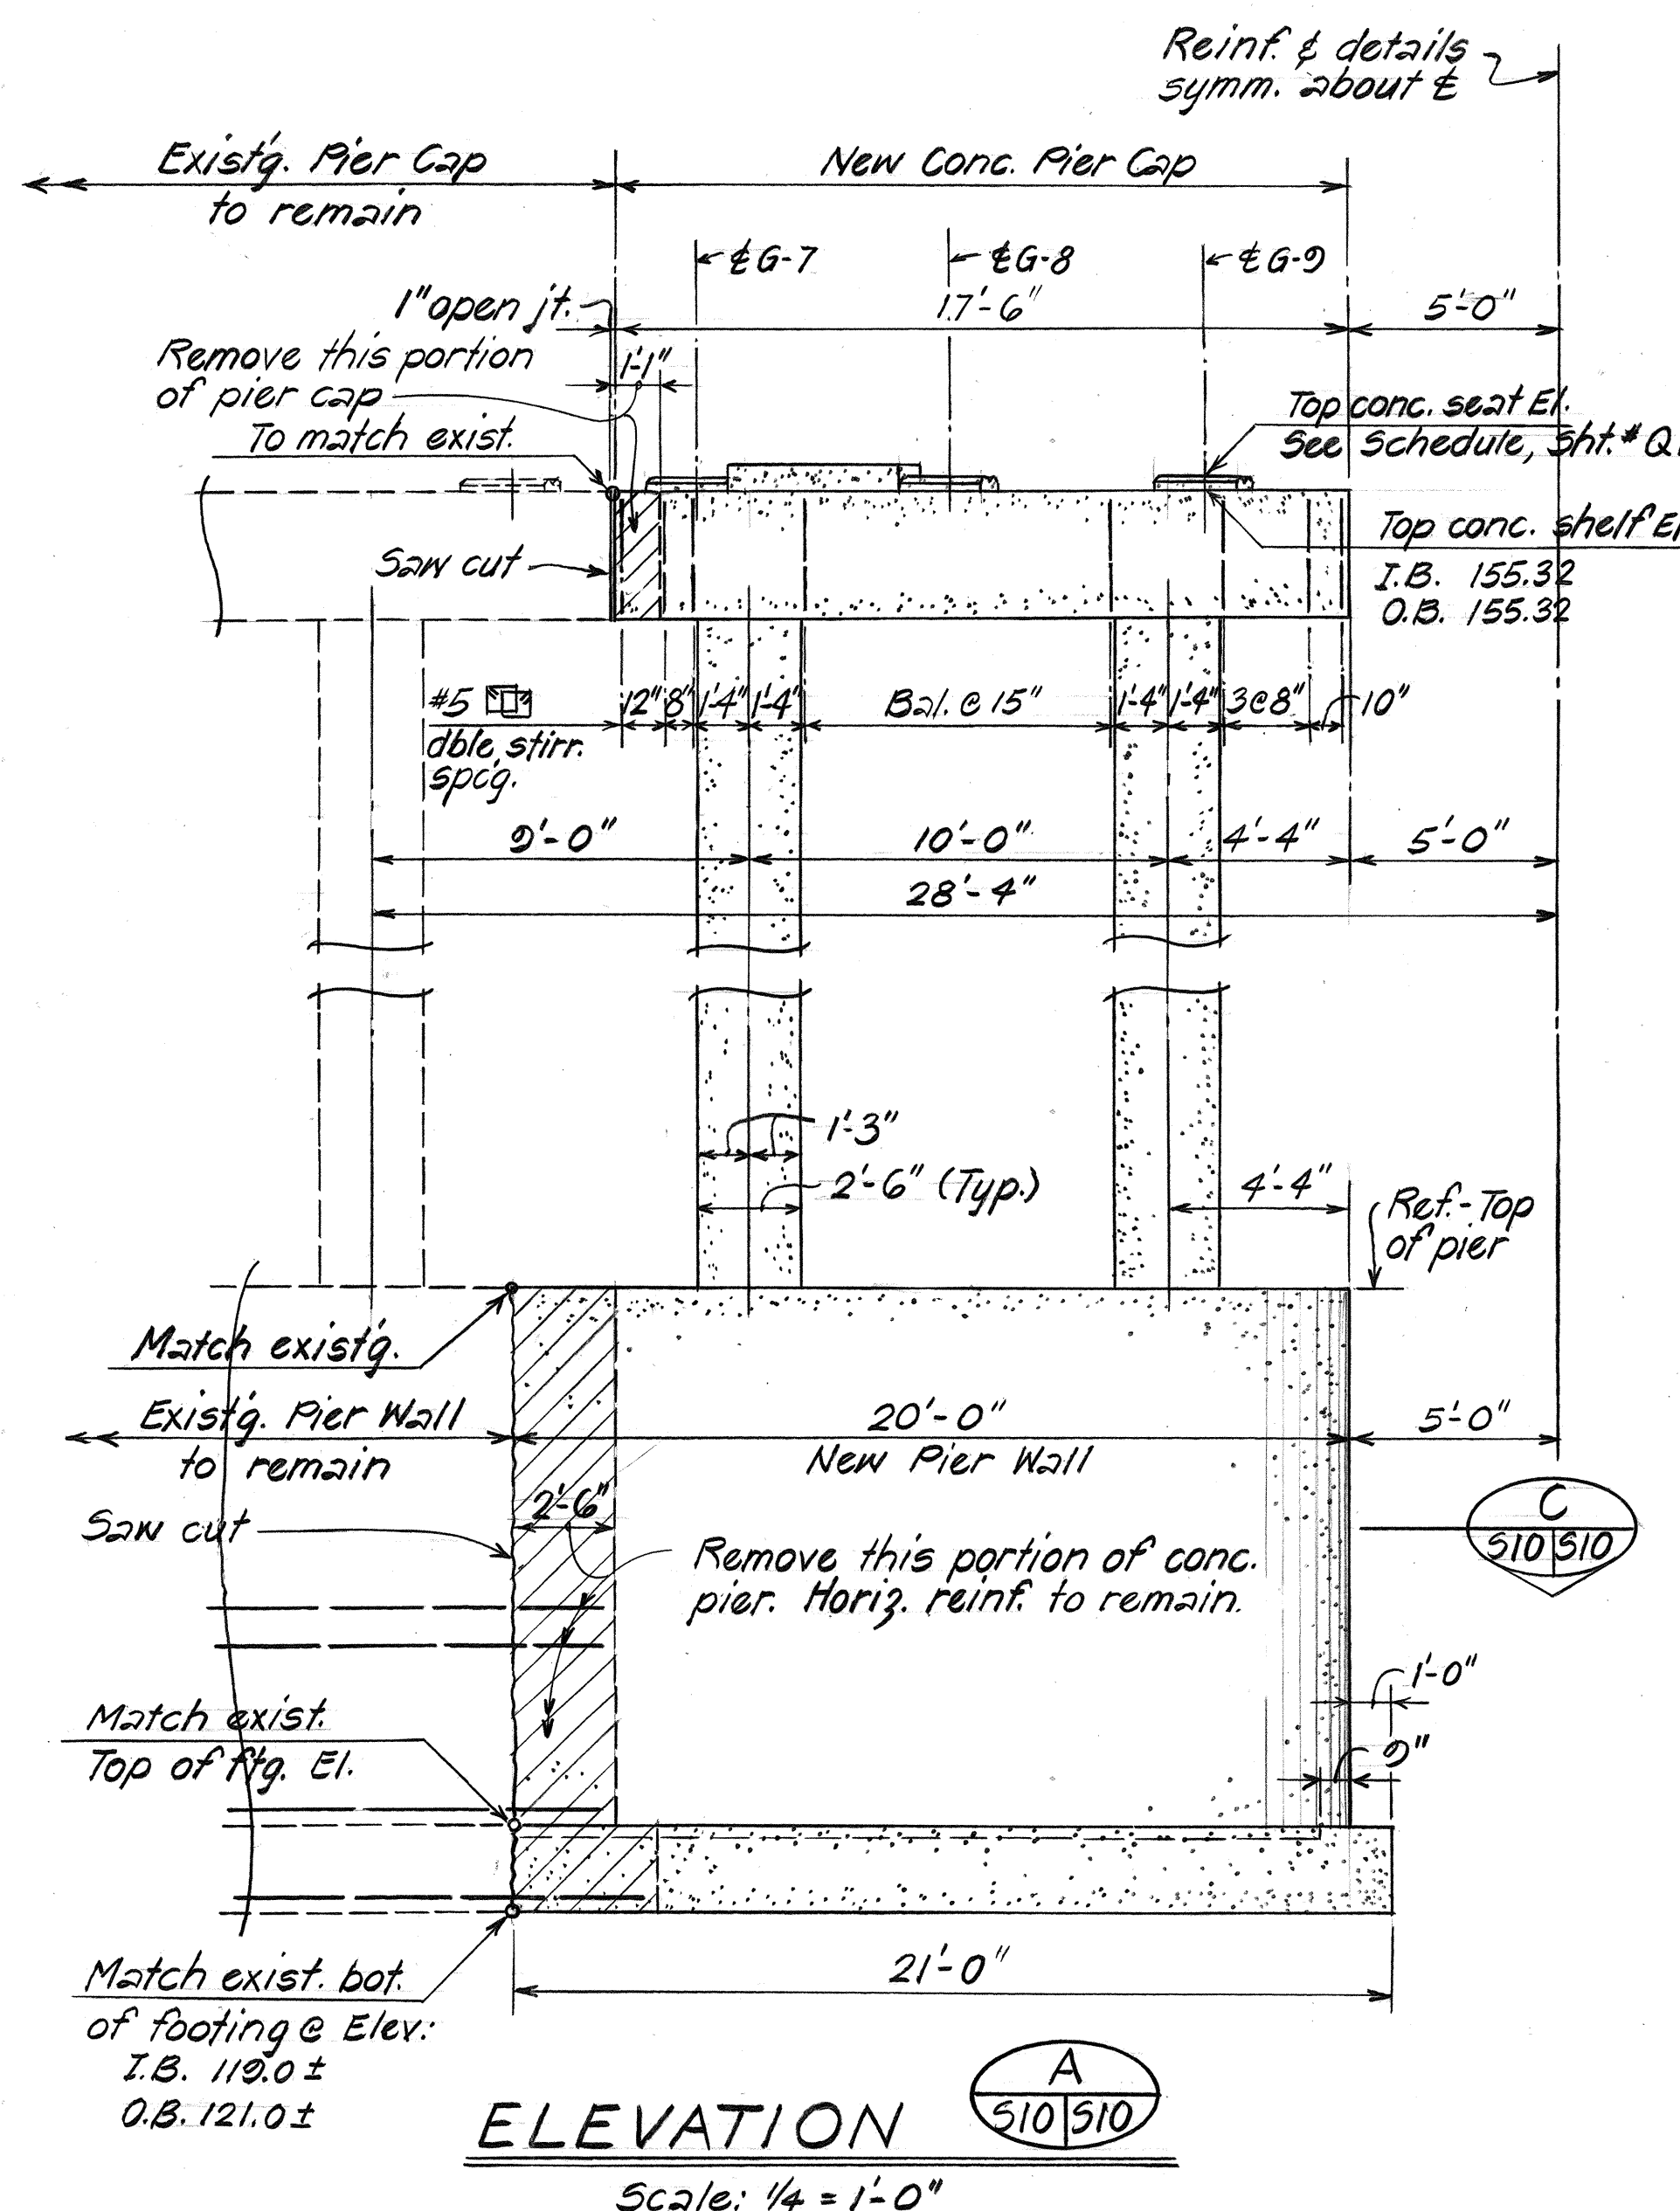


ELEVATION
Scale: 1/4" = 1'-0"

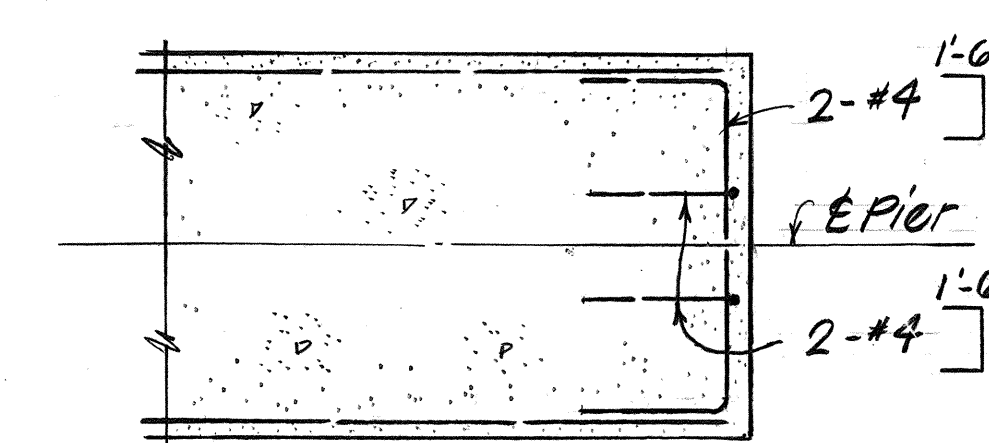

PLAN-TYPICAL PIER CAP NOSING
Scale: 1/2" = 1'-0"

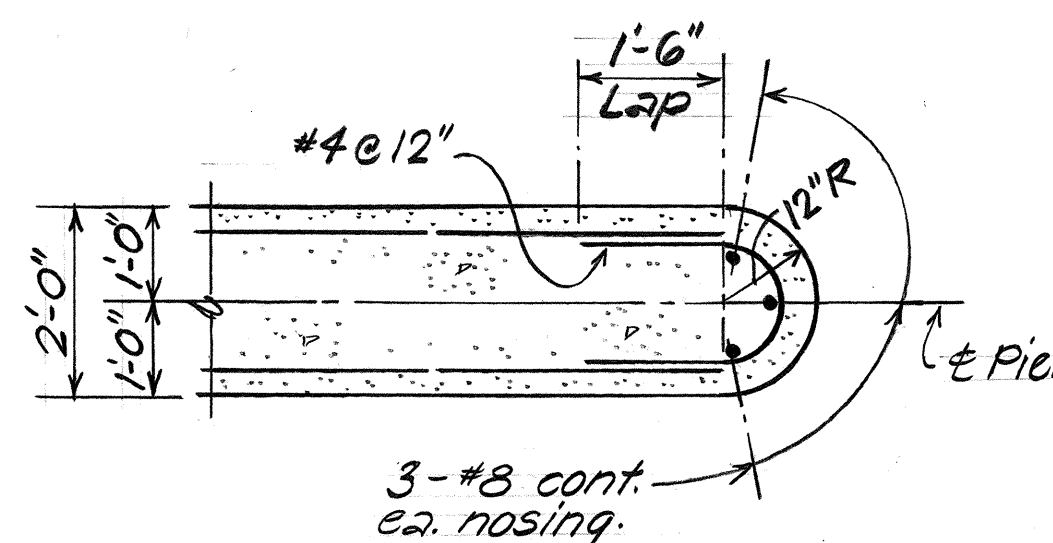


SECTION
Scale: 1/2" = 1'-0"

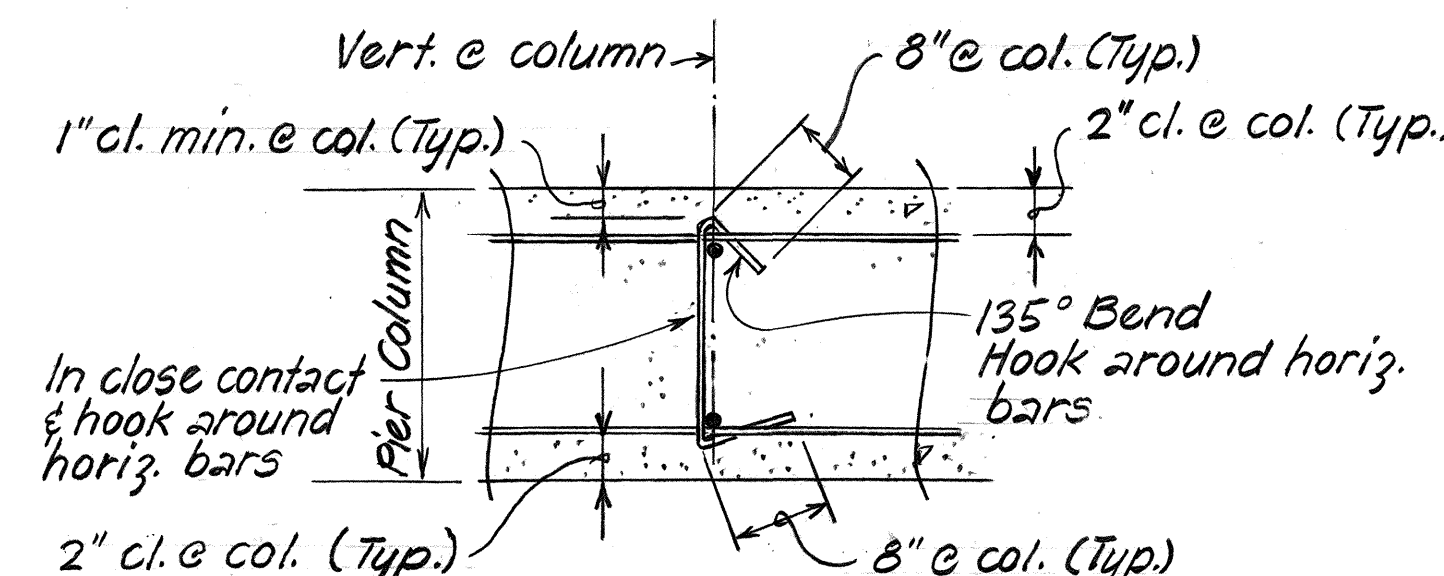


TIE BAR DETAIL
Not to Scale


NOTE:
1. Hatched area shown thus TTT denotes limit of structure excavation payline.

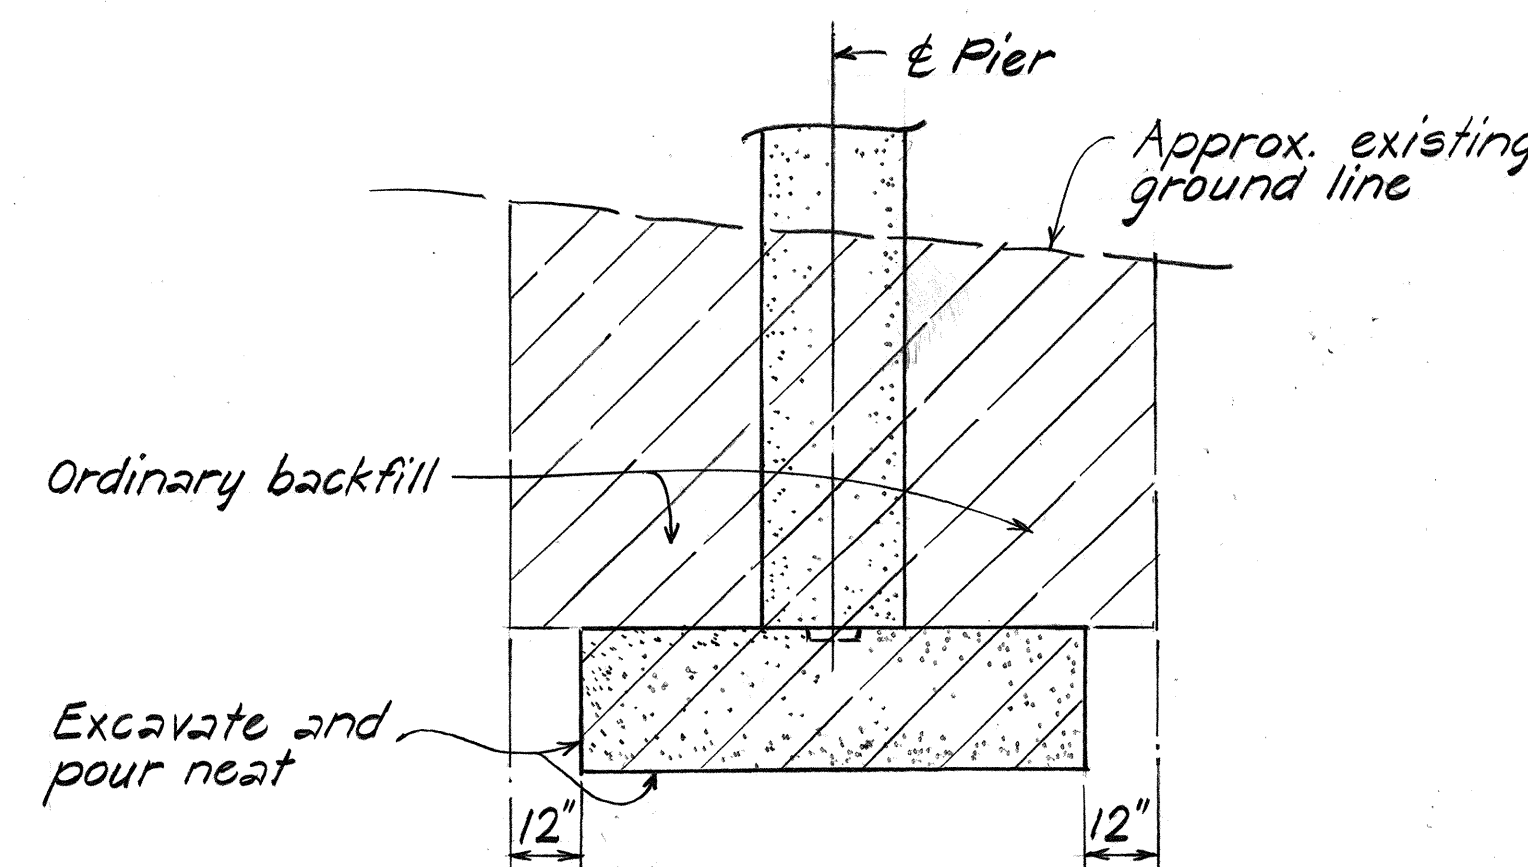

STRUCTURE EXCAVATION PAYLINE AT PIER
Not to Scale

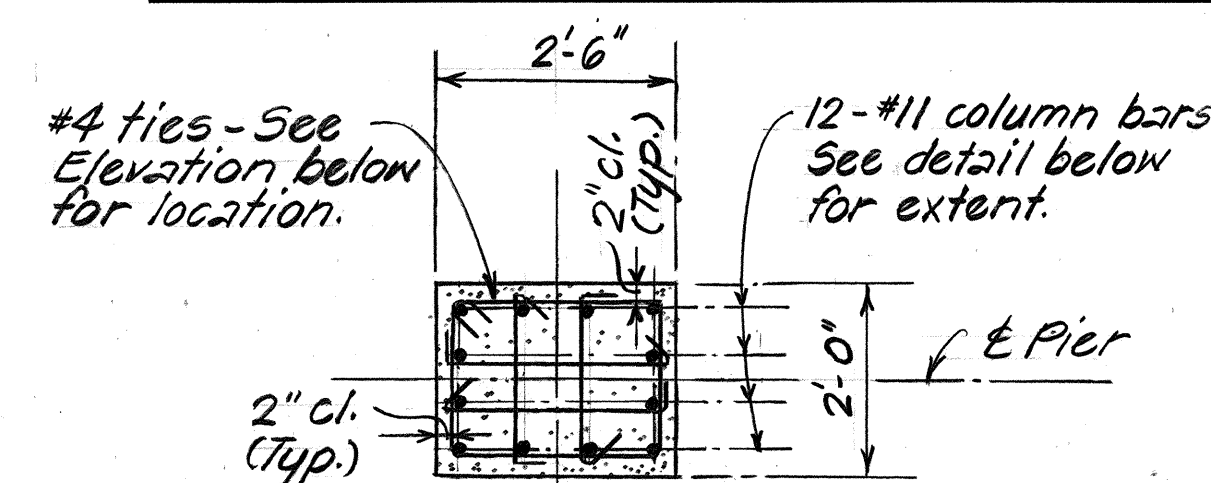

SECTION
Scale: 1/2" = 1'-0"








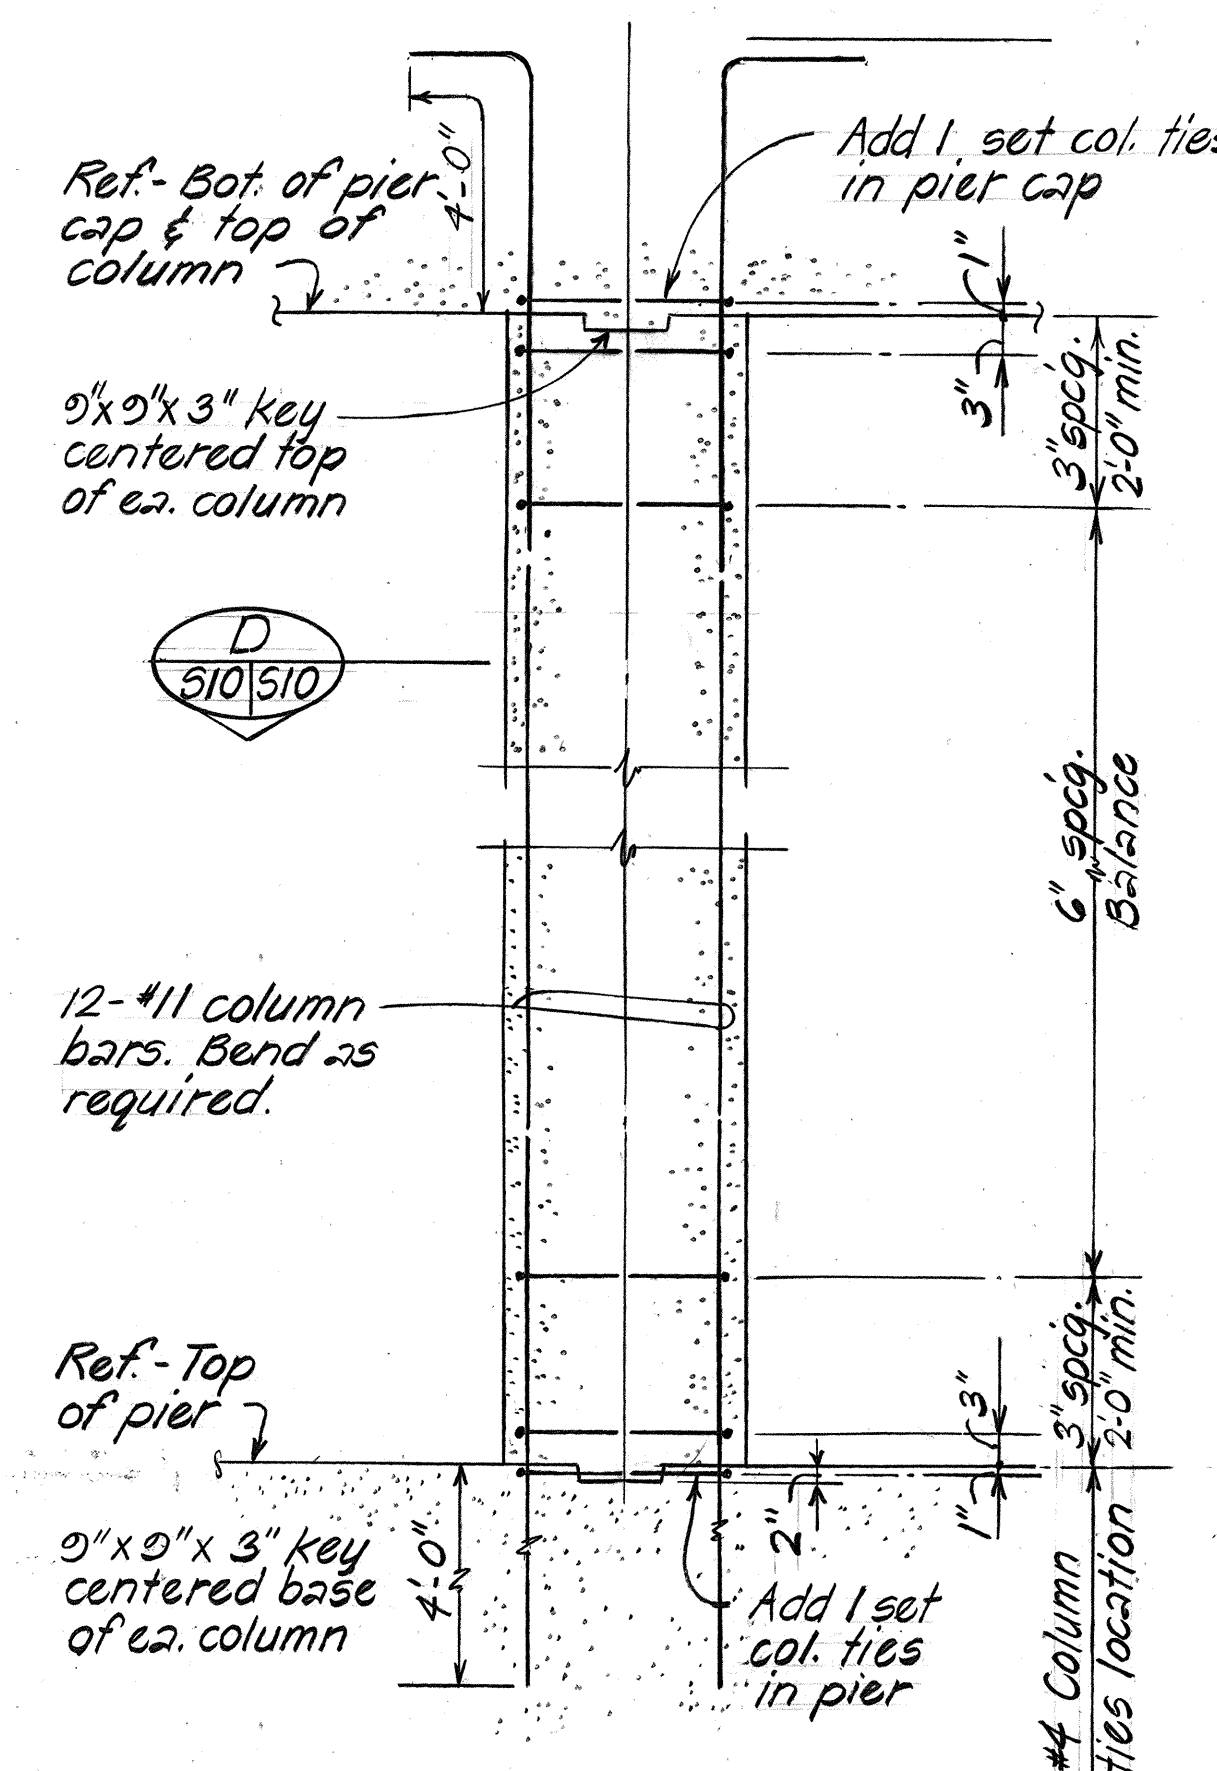


TYPICAL PIER COLUMN DETAIL
Scale: 1/2" = 1'-0"

STATE OF HAWAII DEPARTMENT OF TRANSPORTATION HIGHWAYS DIVISION
HONOLULU STREAM BRIDGE WIDENING PIER DETAILS
INTERSTATE ROUTE H-1, PALAILAI I.C. TO KUNIA I.C. CONSTRUCTION OF ADDITIONAL LANES F.A.I. PROJ. NO. 12-H1-1(180)
Scale: As Shown Date: July 1985
SHEET No. 510 OF 12 SHEETS


DATE: 7/85
DRAWN BY: J.K.M.
DESIGNED BY: M.Y.
QUANTITIES BY: L.A.G.T.
CHECKED BY: L.A.G.T.
NO.

FED. ROAD DIST. NO.	STATE	FED. AID PROJ. NO.	FISCAL YEAR	SHEET NO.	TOTAL SHEETS
HAWAII	HAW.	12-HI-1(180)	1986	62	99

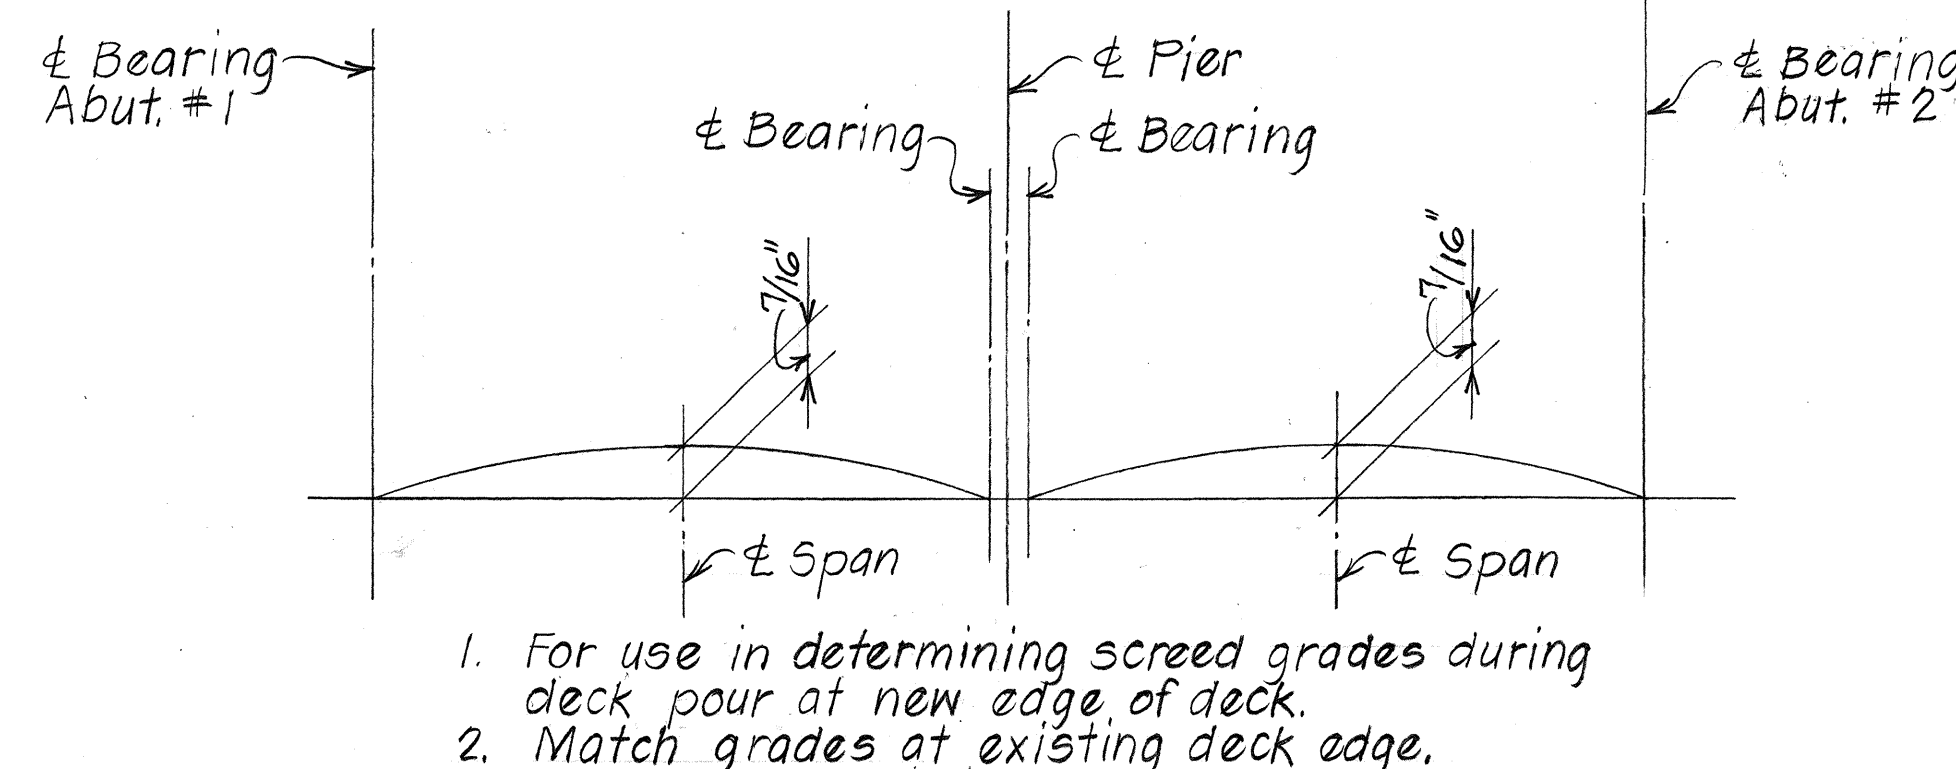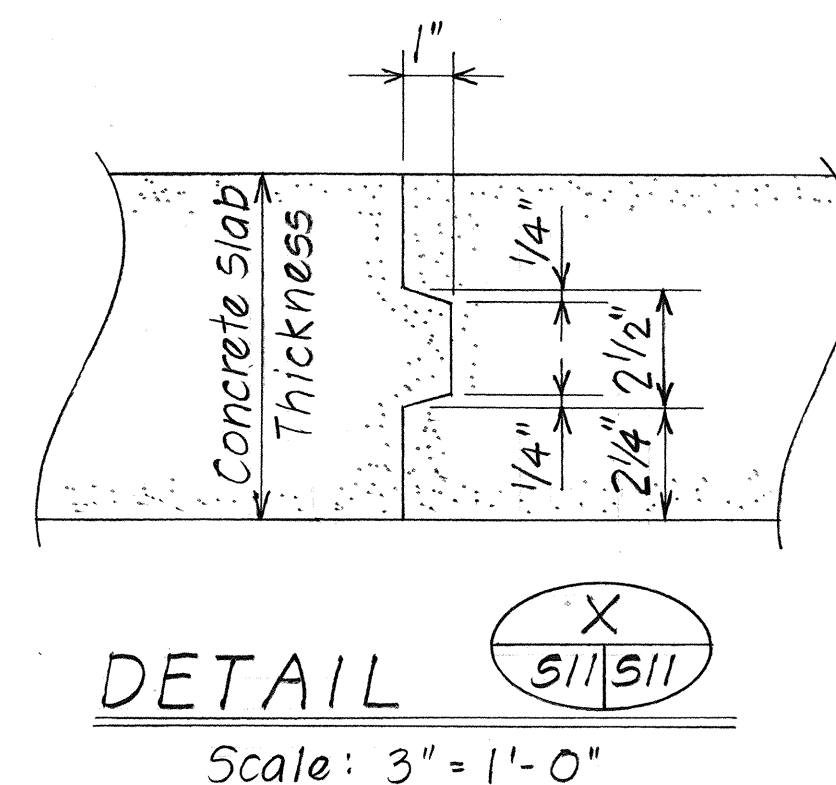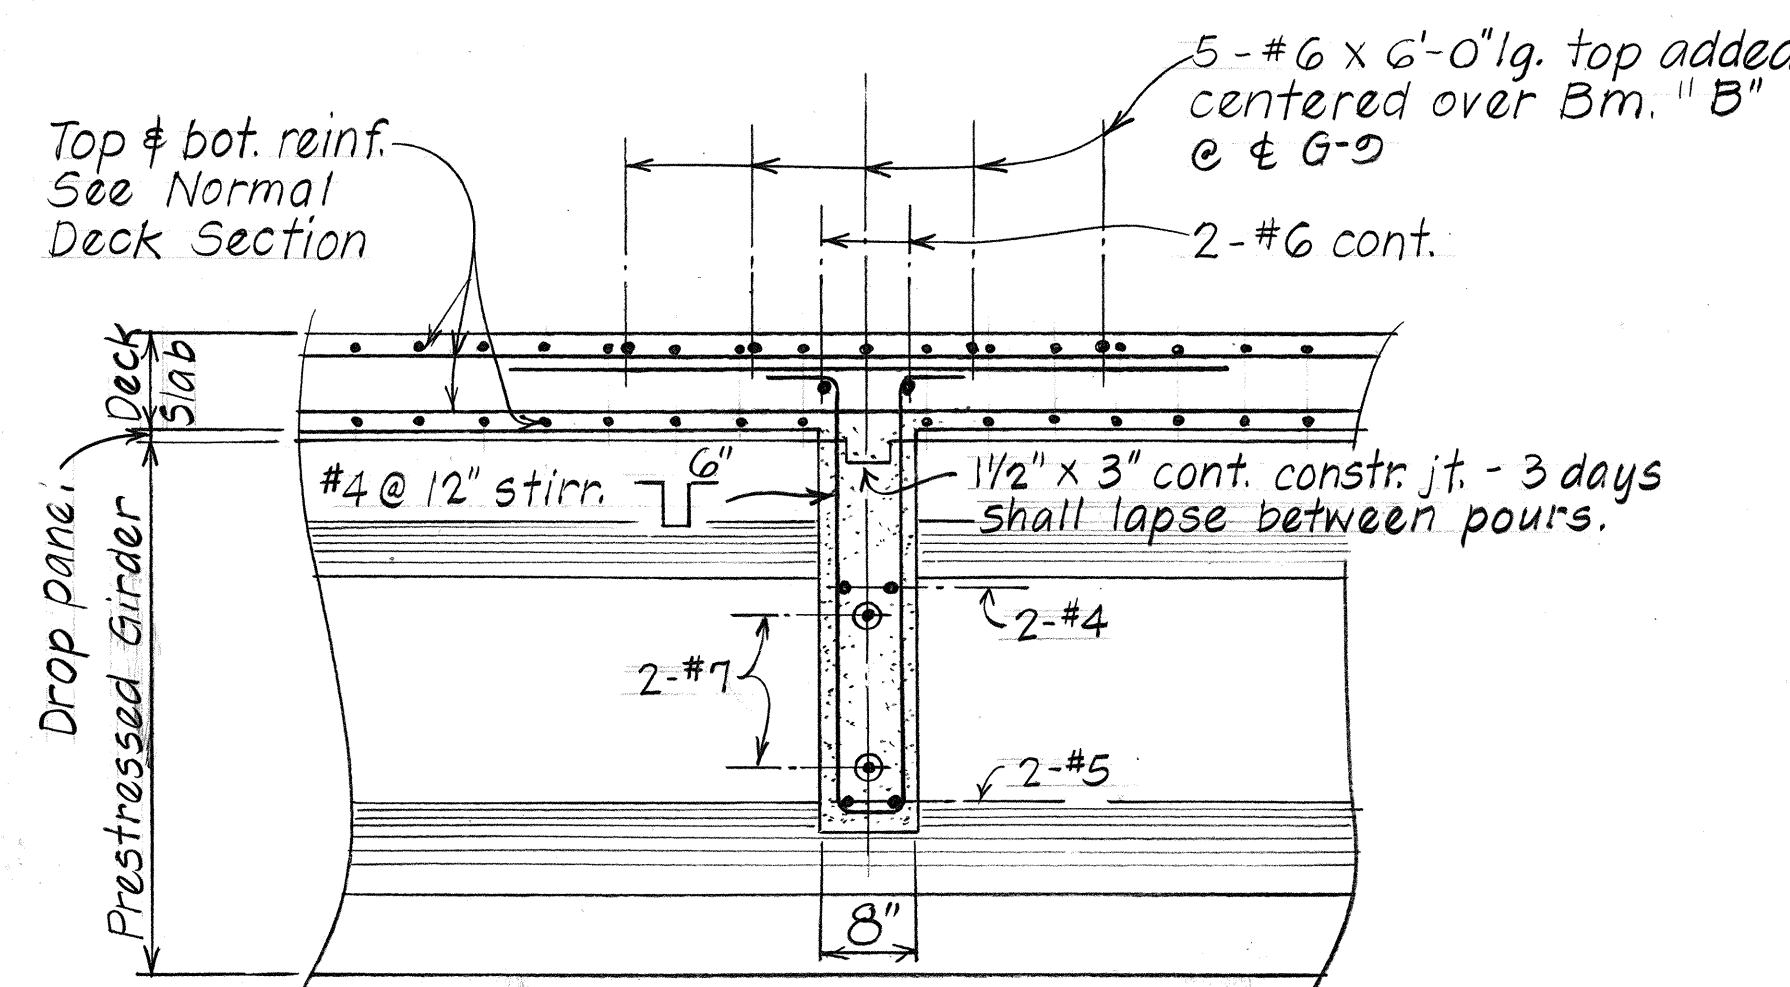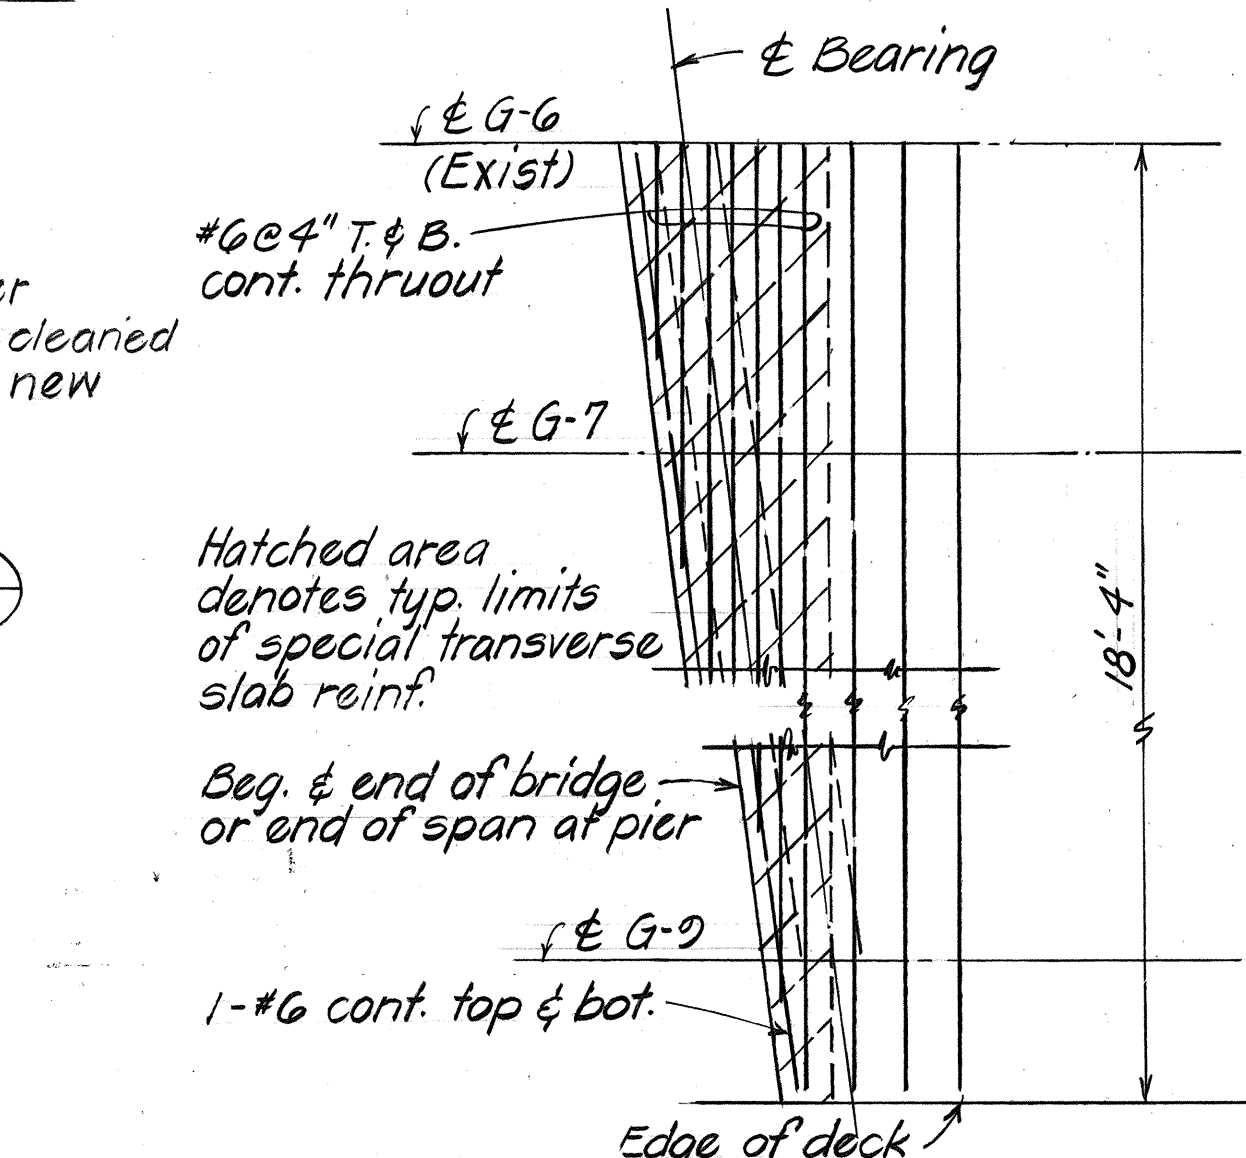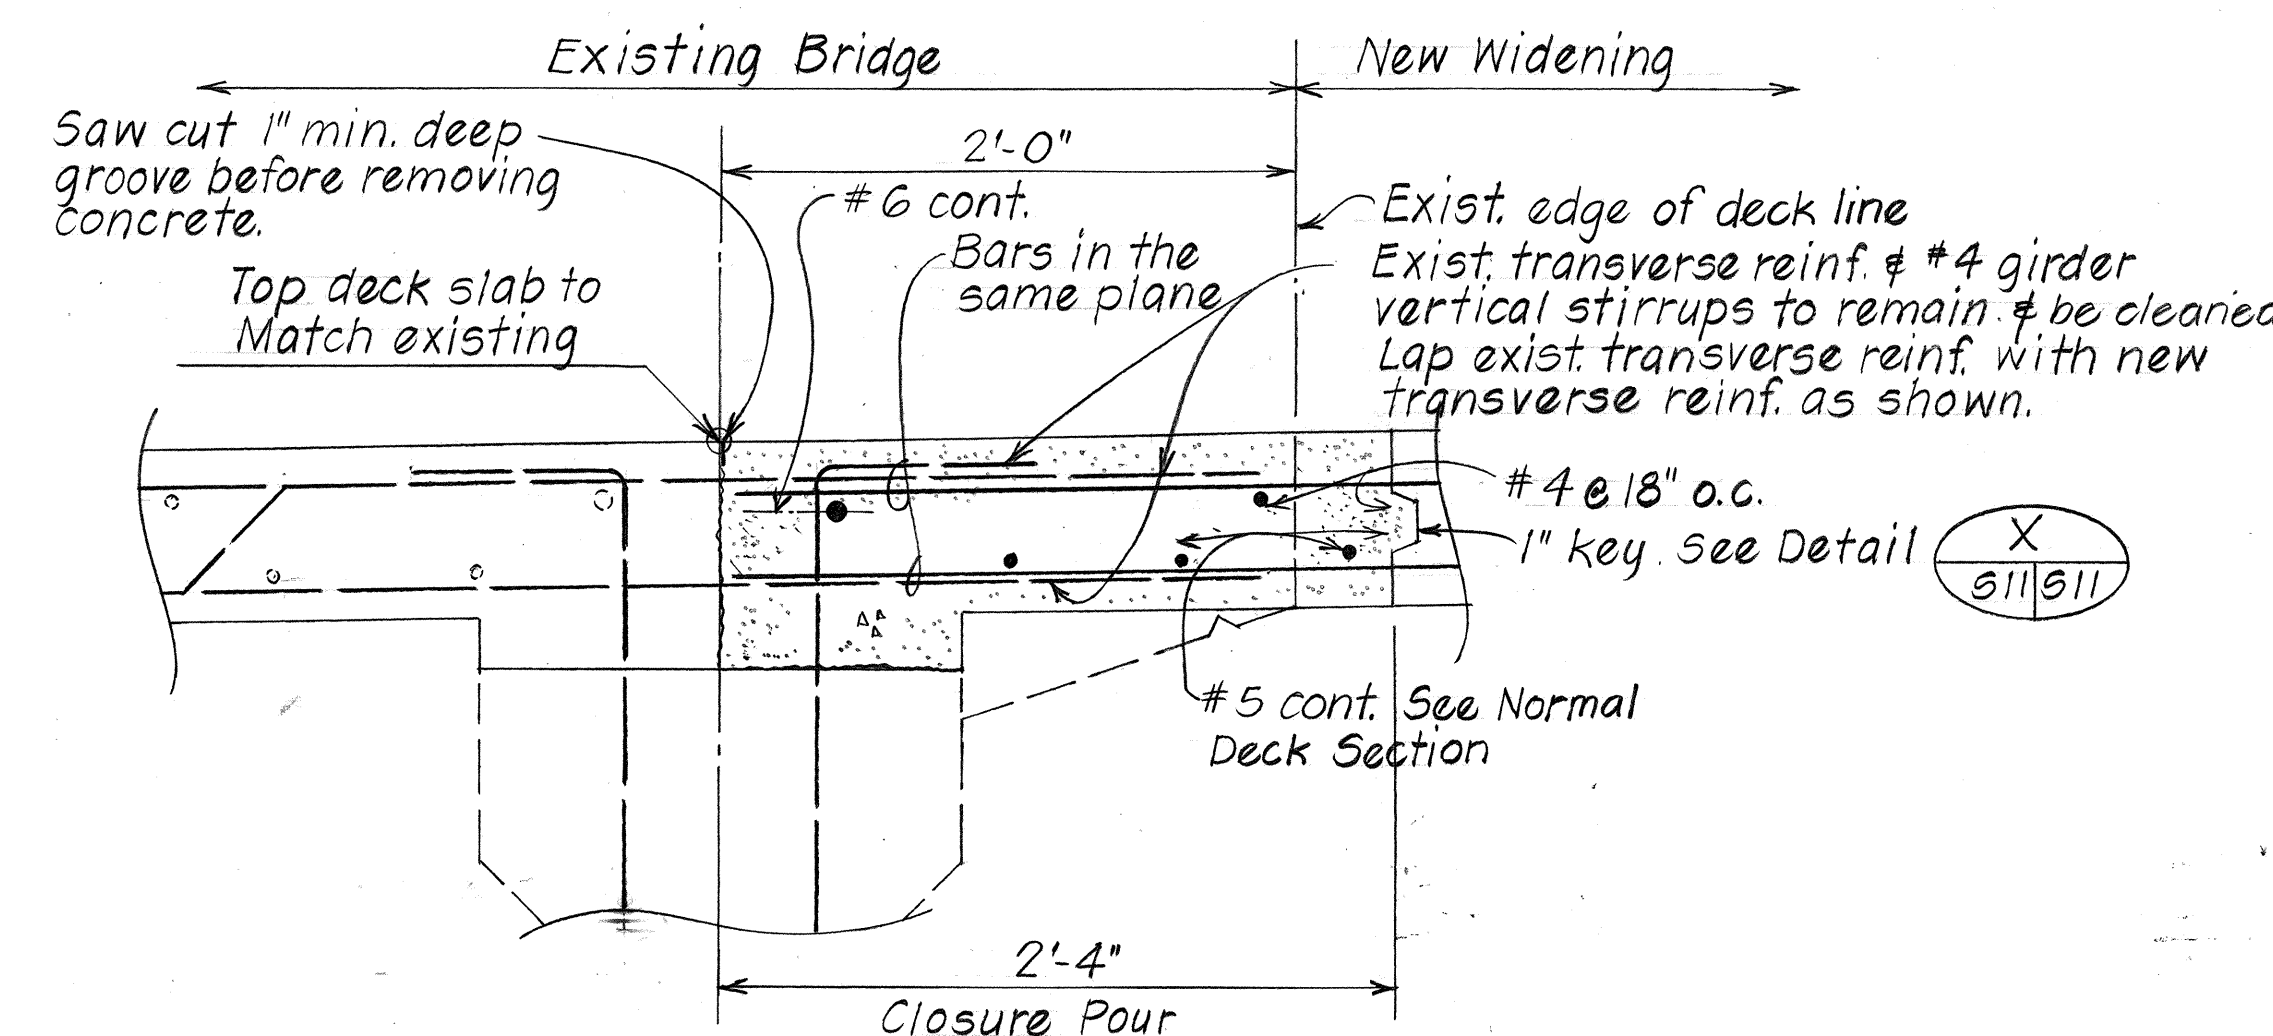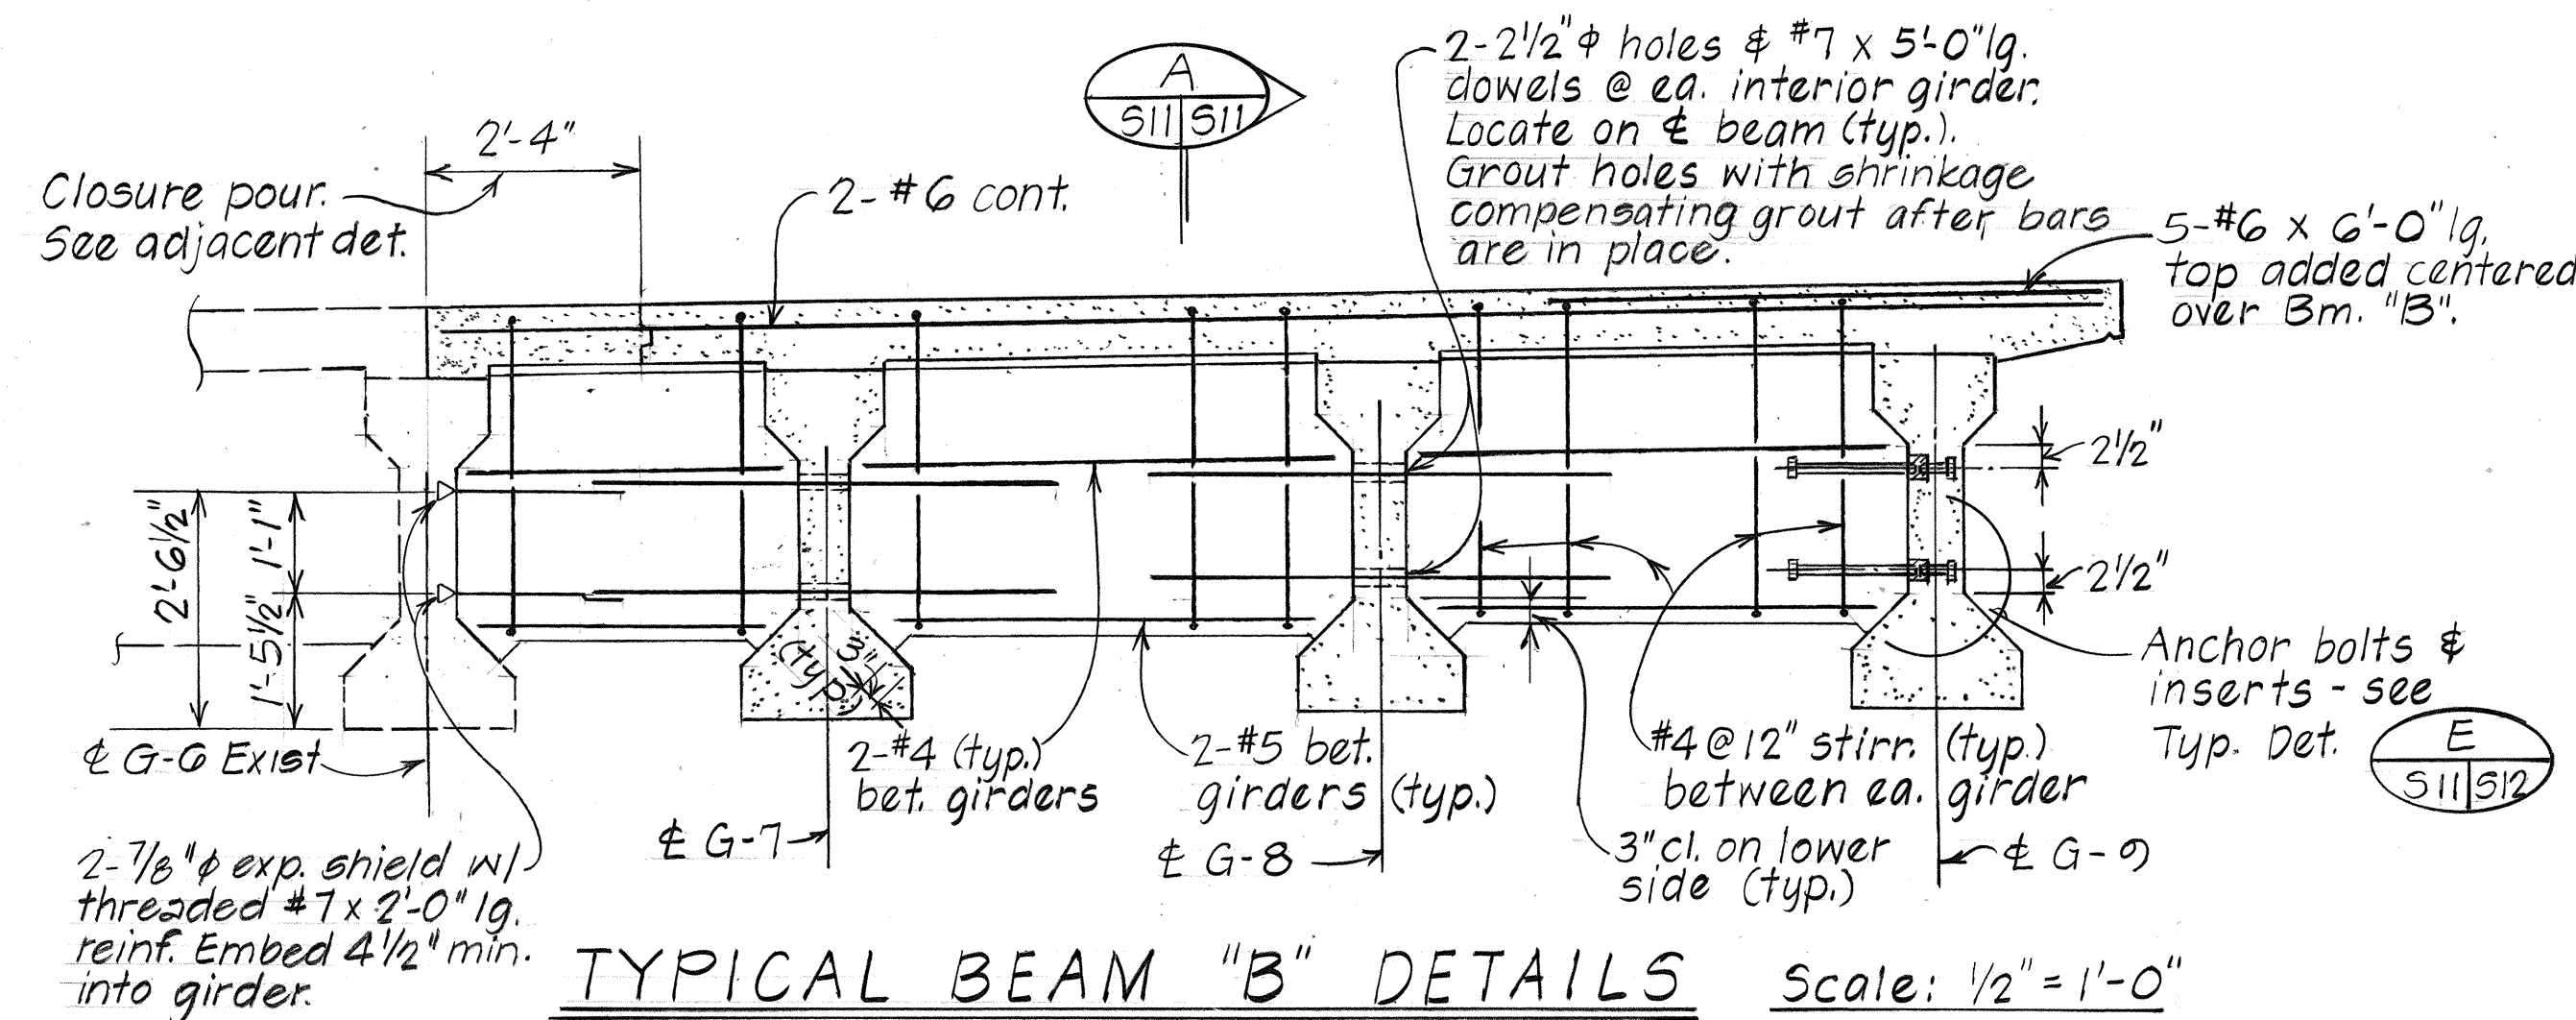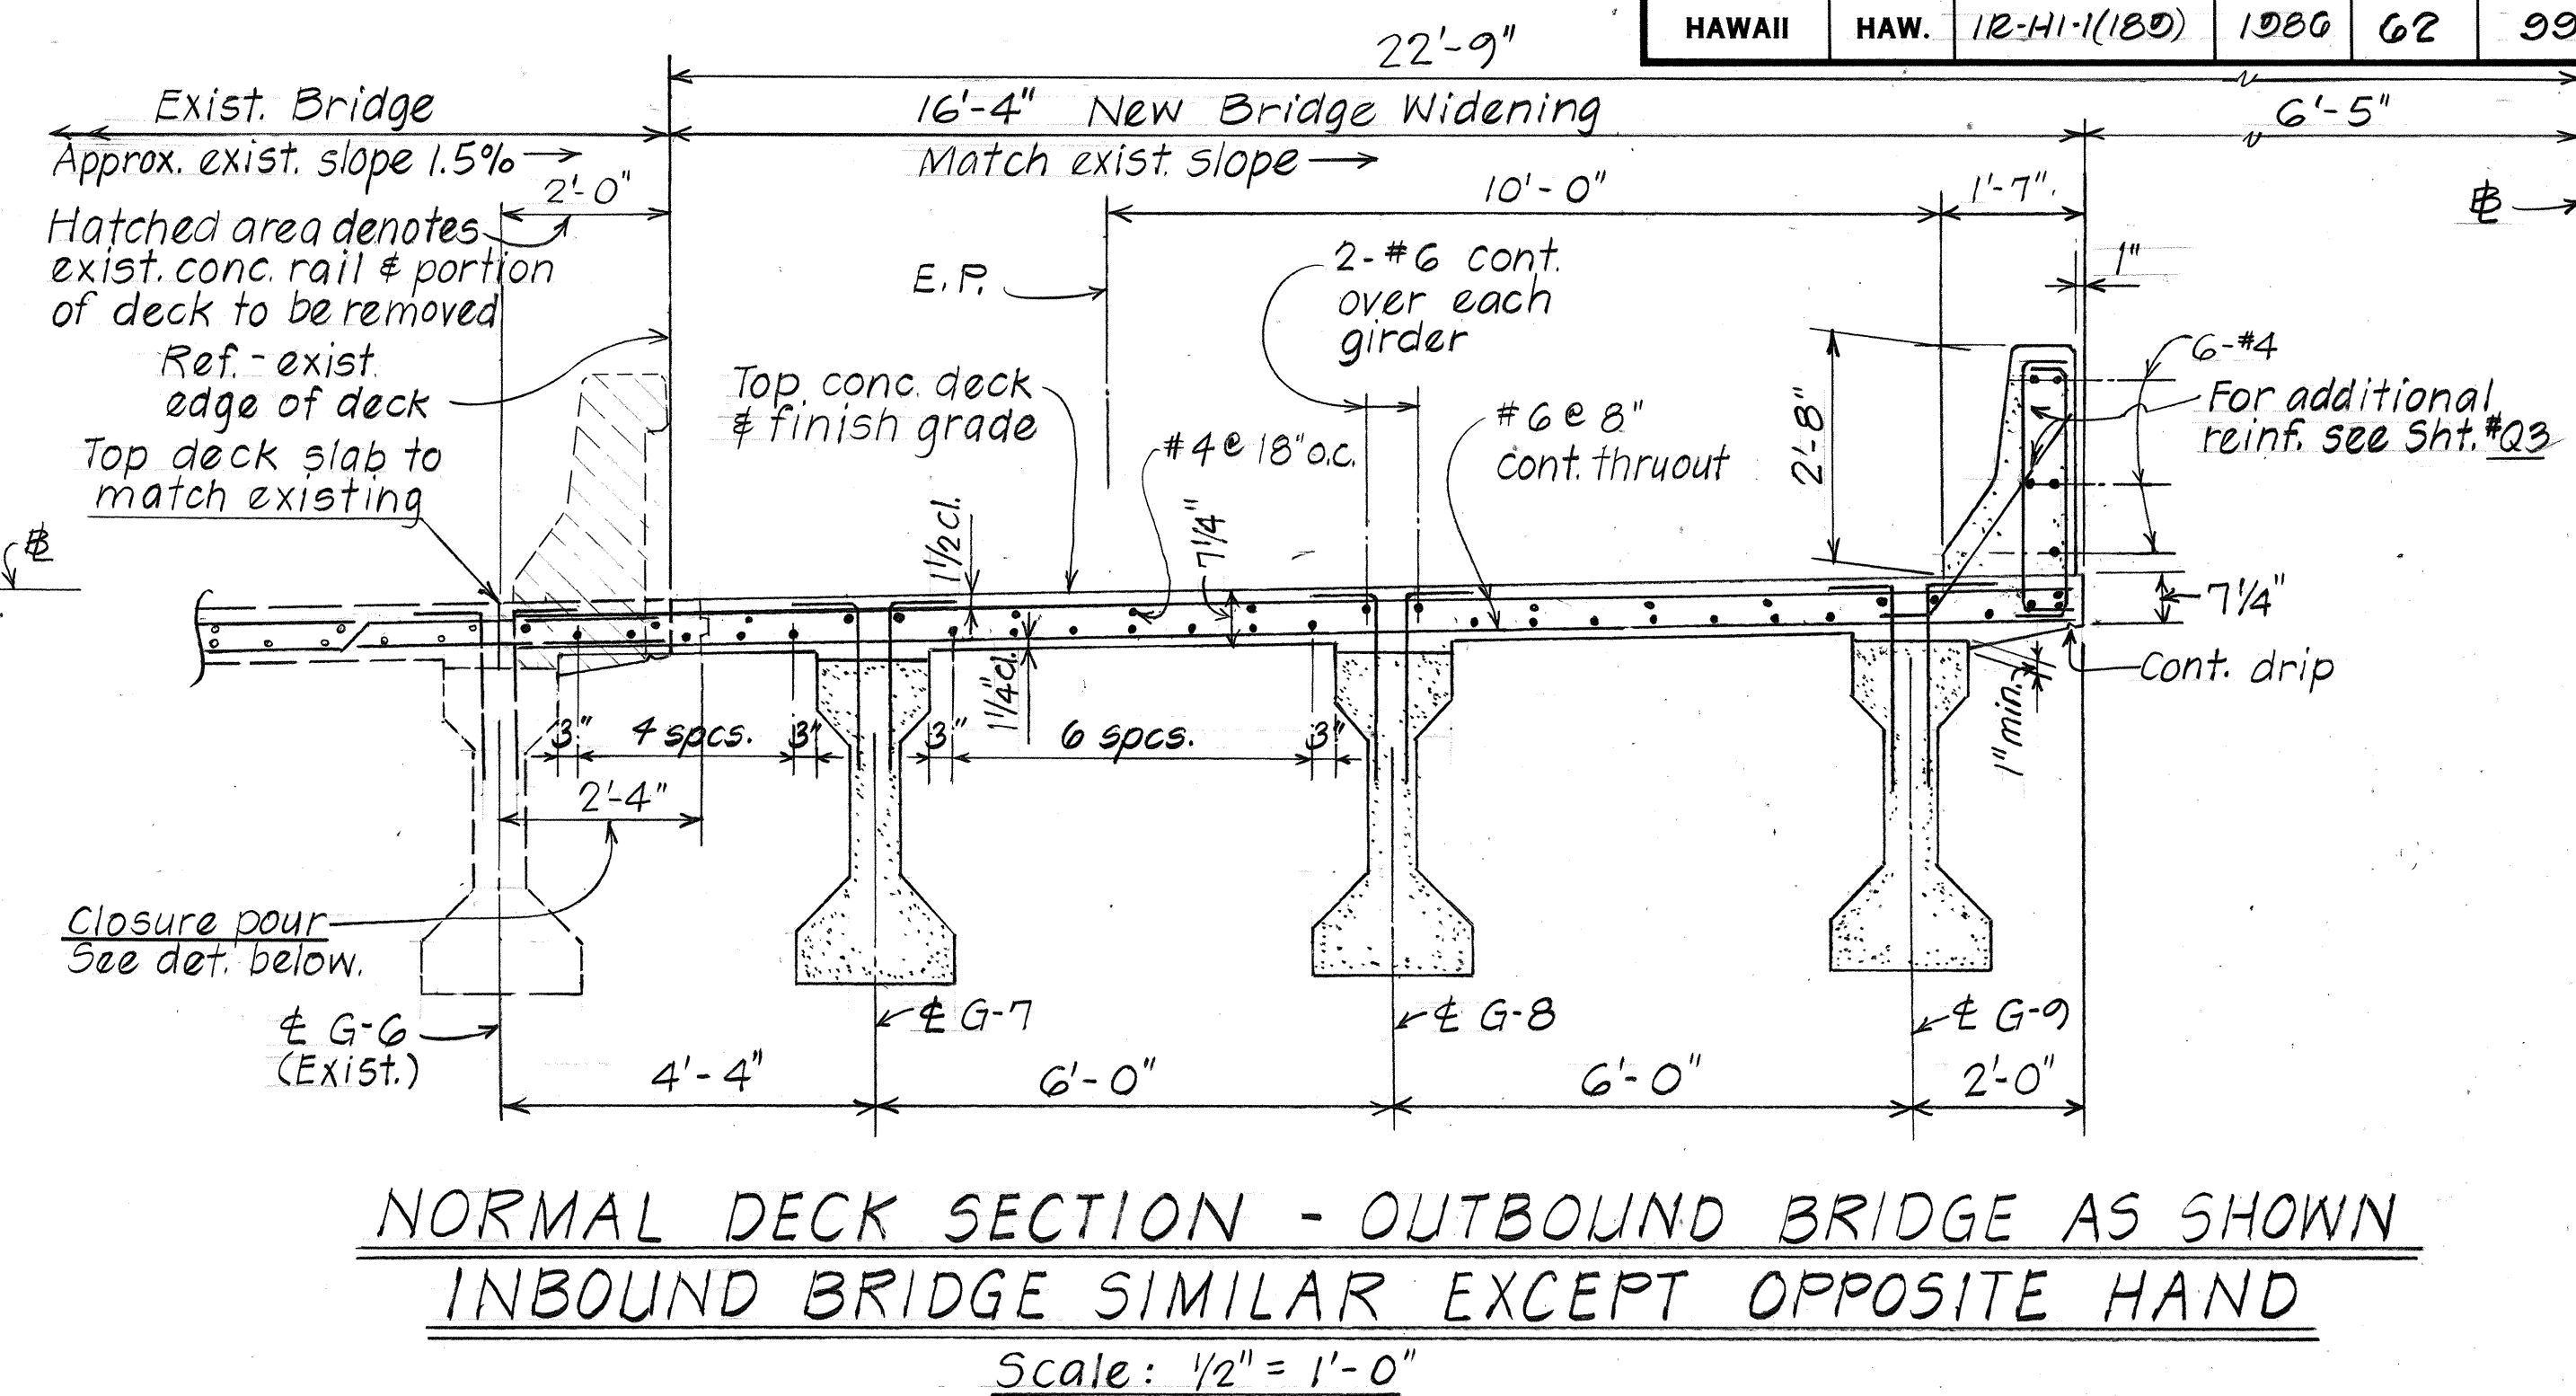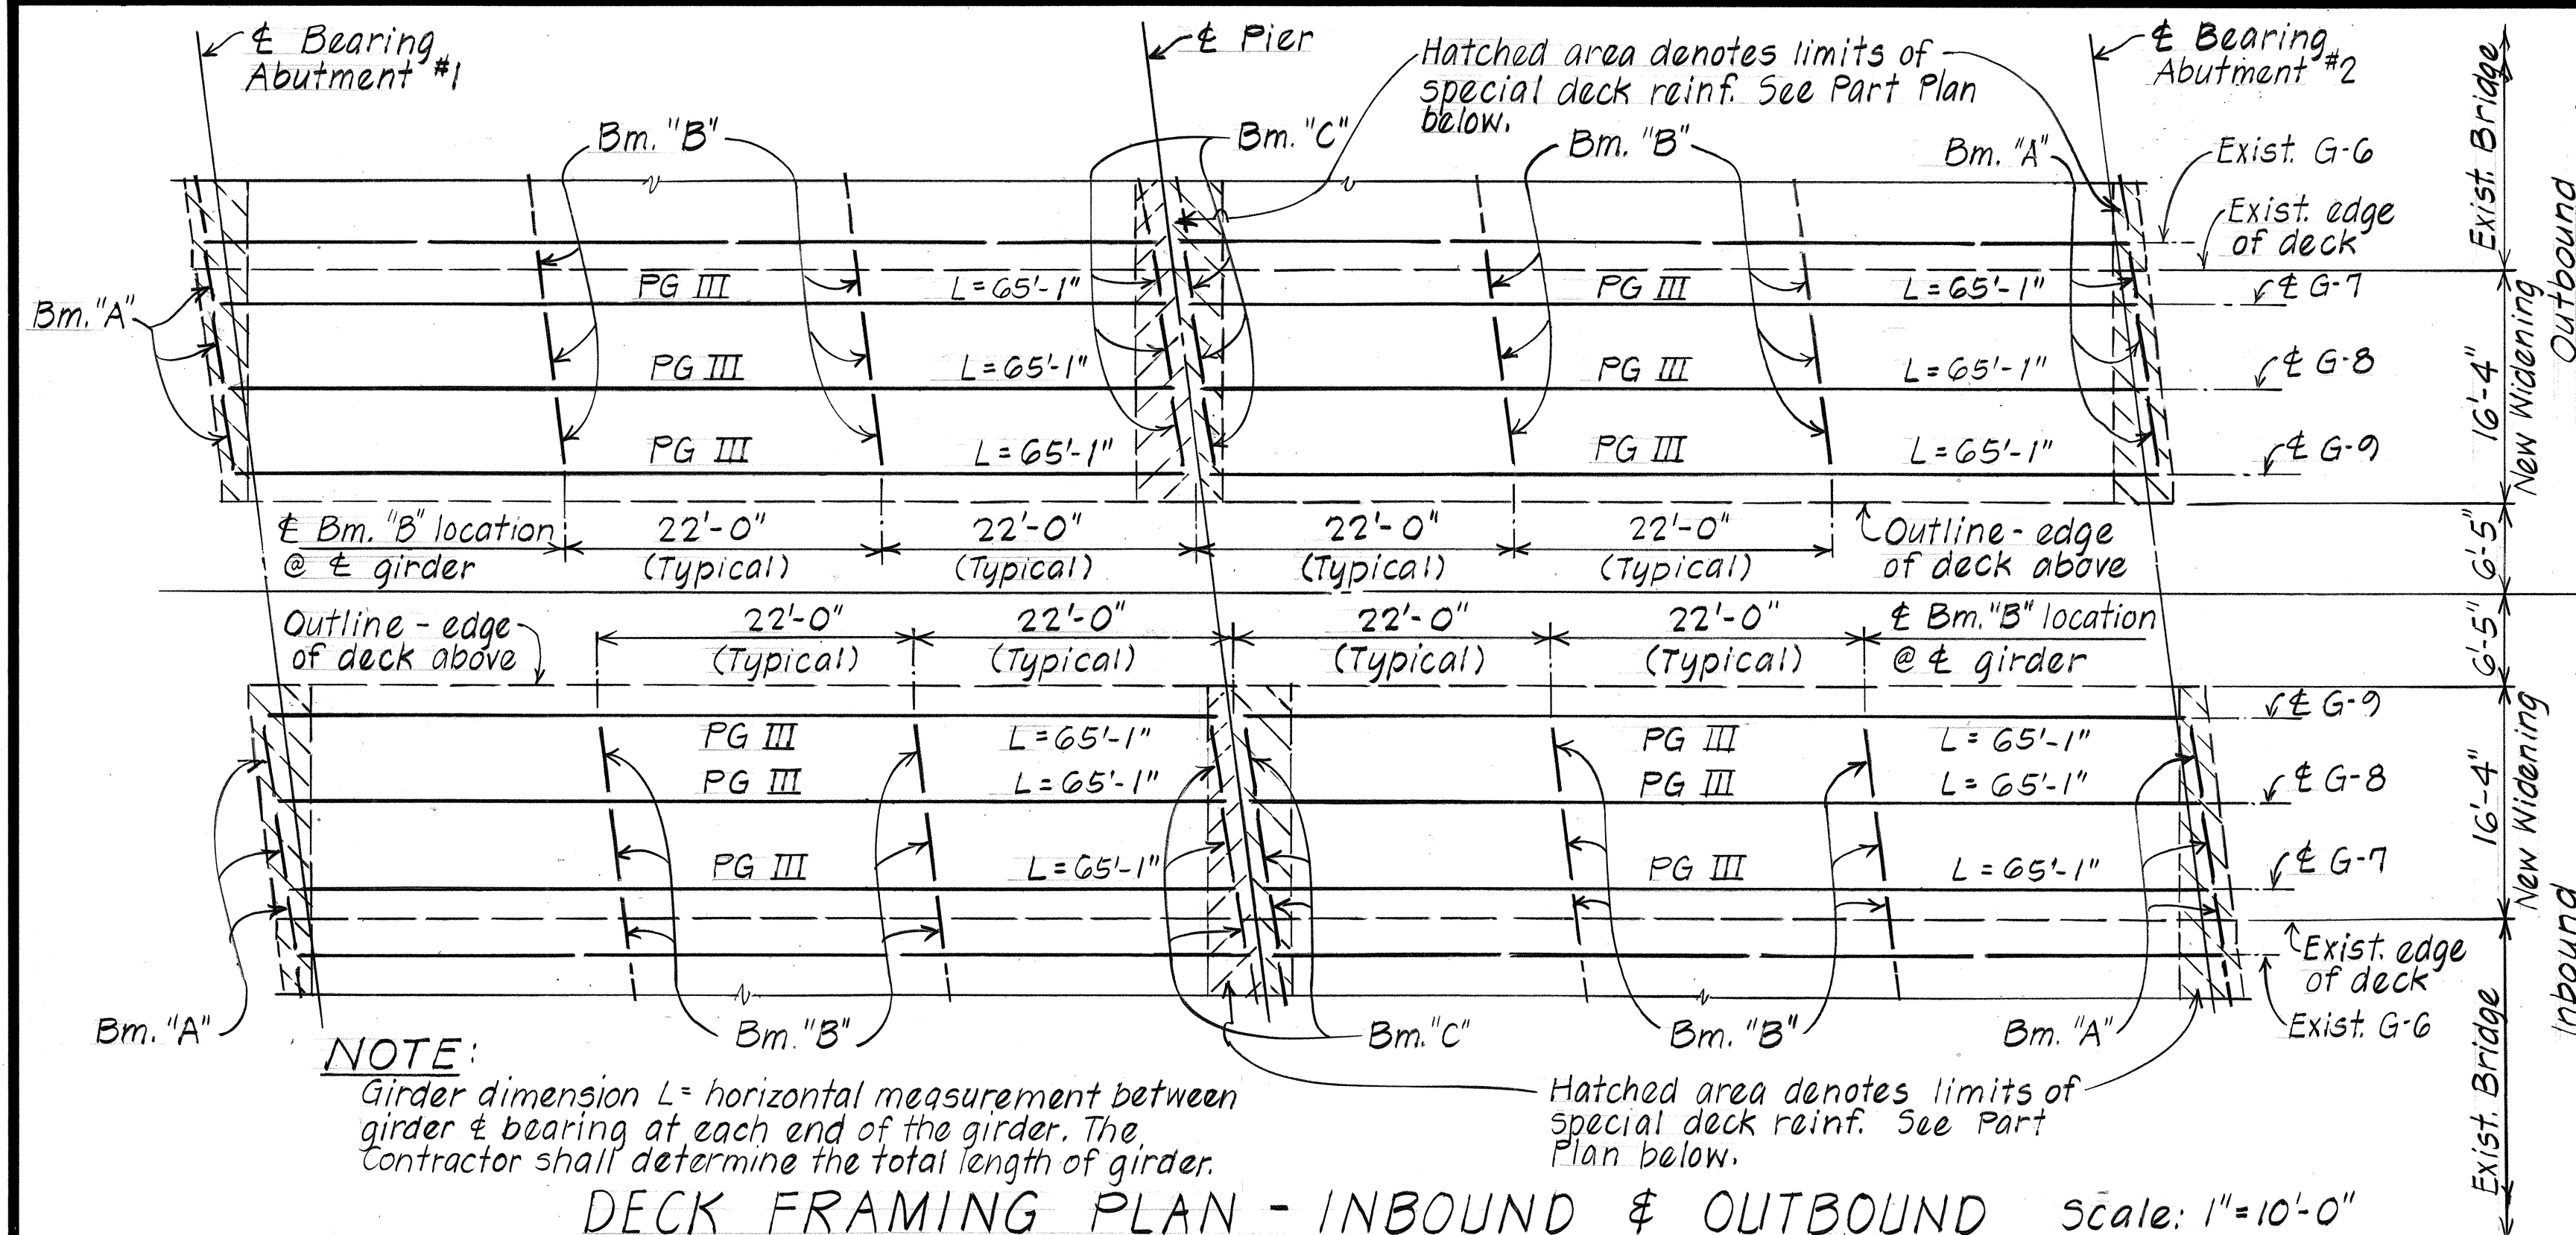


STATE OF HAWAII DEPARTMENT OF TRANSPORTATION HIGHWAYS DIVISION
HONOLULU STREAM BRIDGE WIDENING
NORMAL DECK SECTION, DECK FRAMING PLAN, BEAM "B"
INTERSTATE ROUTE H-1, PALAILAI I.C. TO KUNIA I.C. CONSTRUCTION OF ADDITIONAL LANES
FAI PROJ. NO. 12-HI-1(180)
Scale: As Shown Date: JULY 1985
SHEET NO. 511 OF 12 SHEETS

FED. ROAD DIST. NO.	STATE	FED. AID PROJ. NO.	FISCAL YEAR	SHEET NO.	TOTAL SHEETS
HAWAII	HAW.	IR-HI-1(189)	1986	63	99

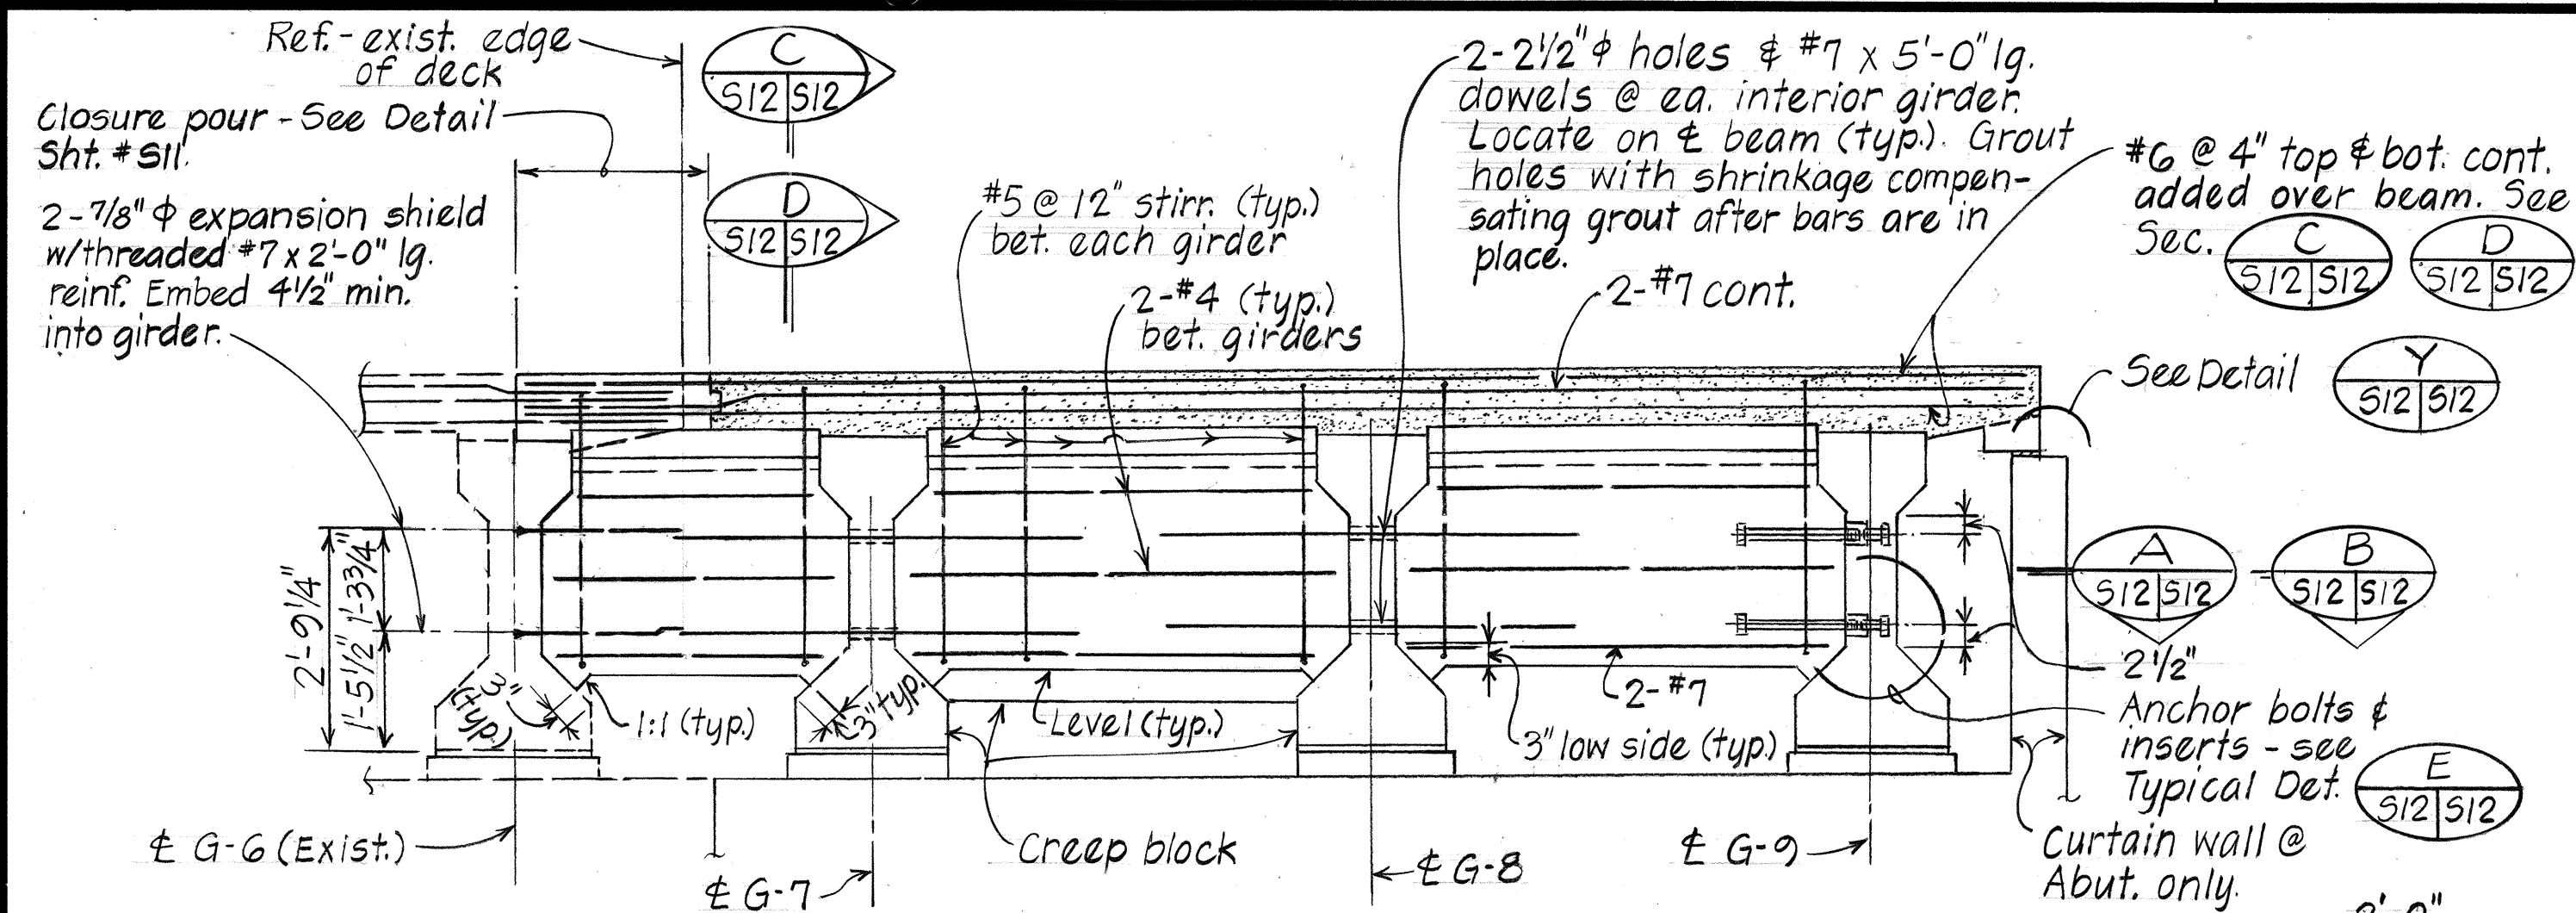


TYPICAL ELEVATION - BEAM "A" AS SHOWN
BEAM "C" SIMILAR EXCEPT AS NOTED OTHERWISE

Scale: 1/2" = 1'-0"

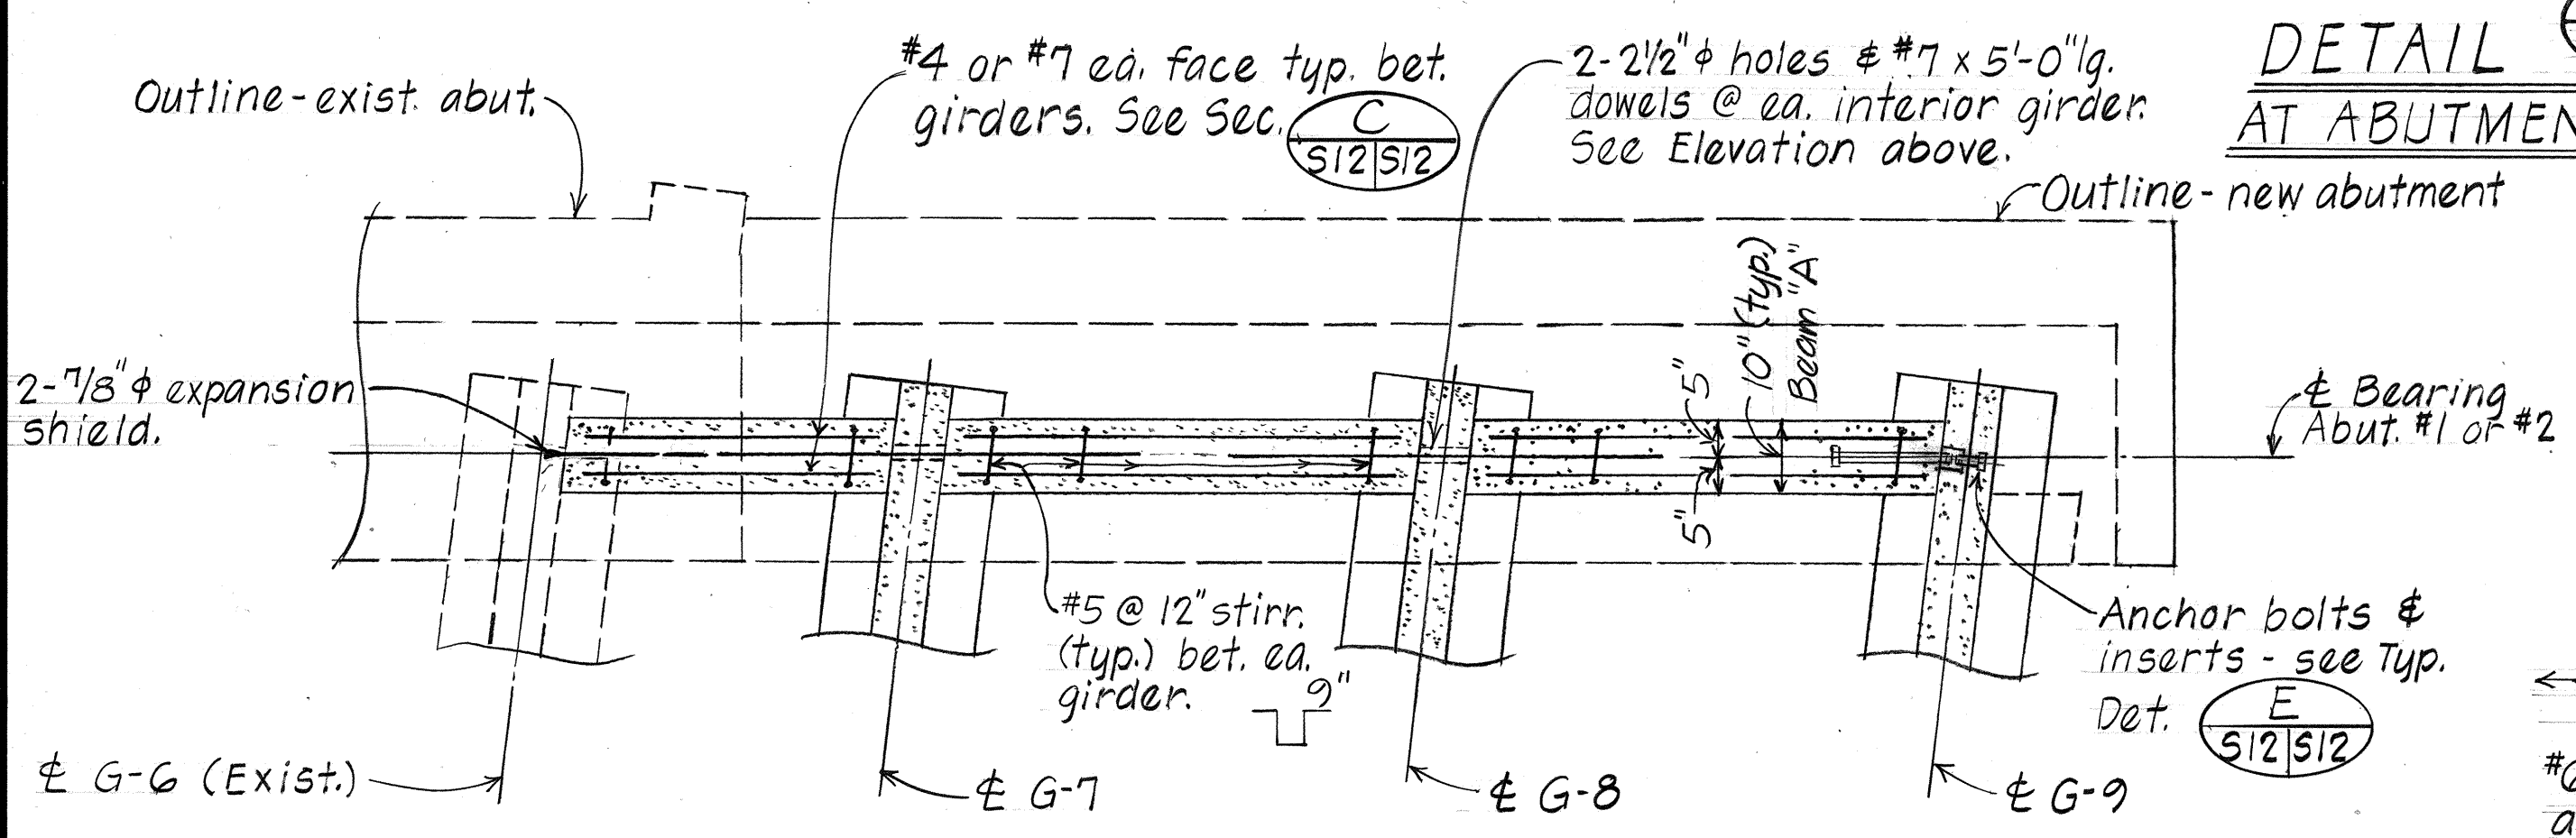


BEAM "A" - SECTION

Scale: 1/2" = 1'-0"

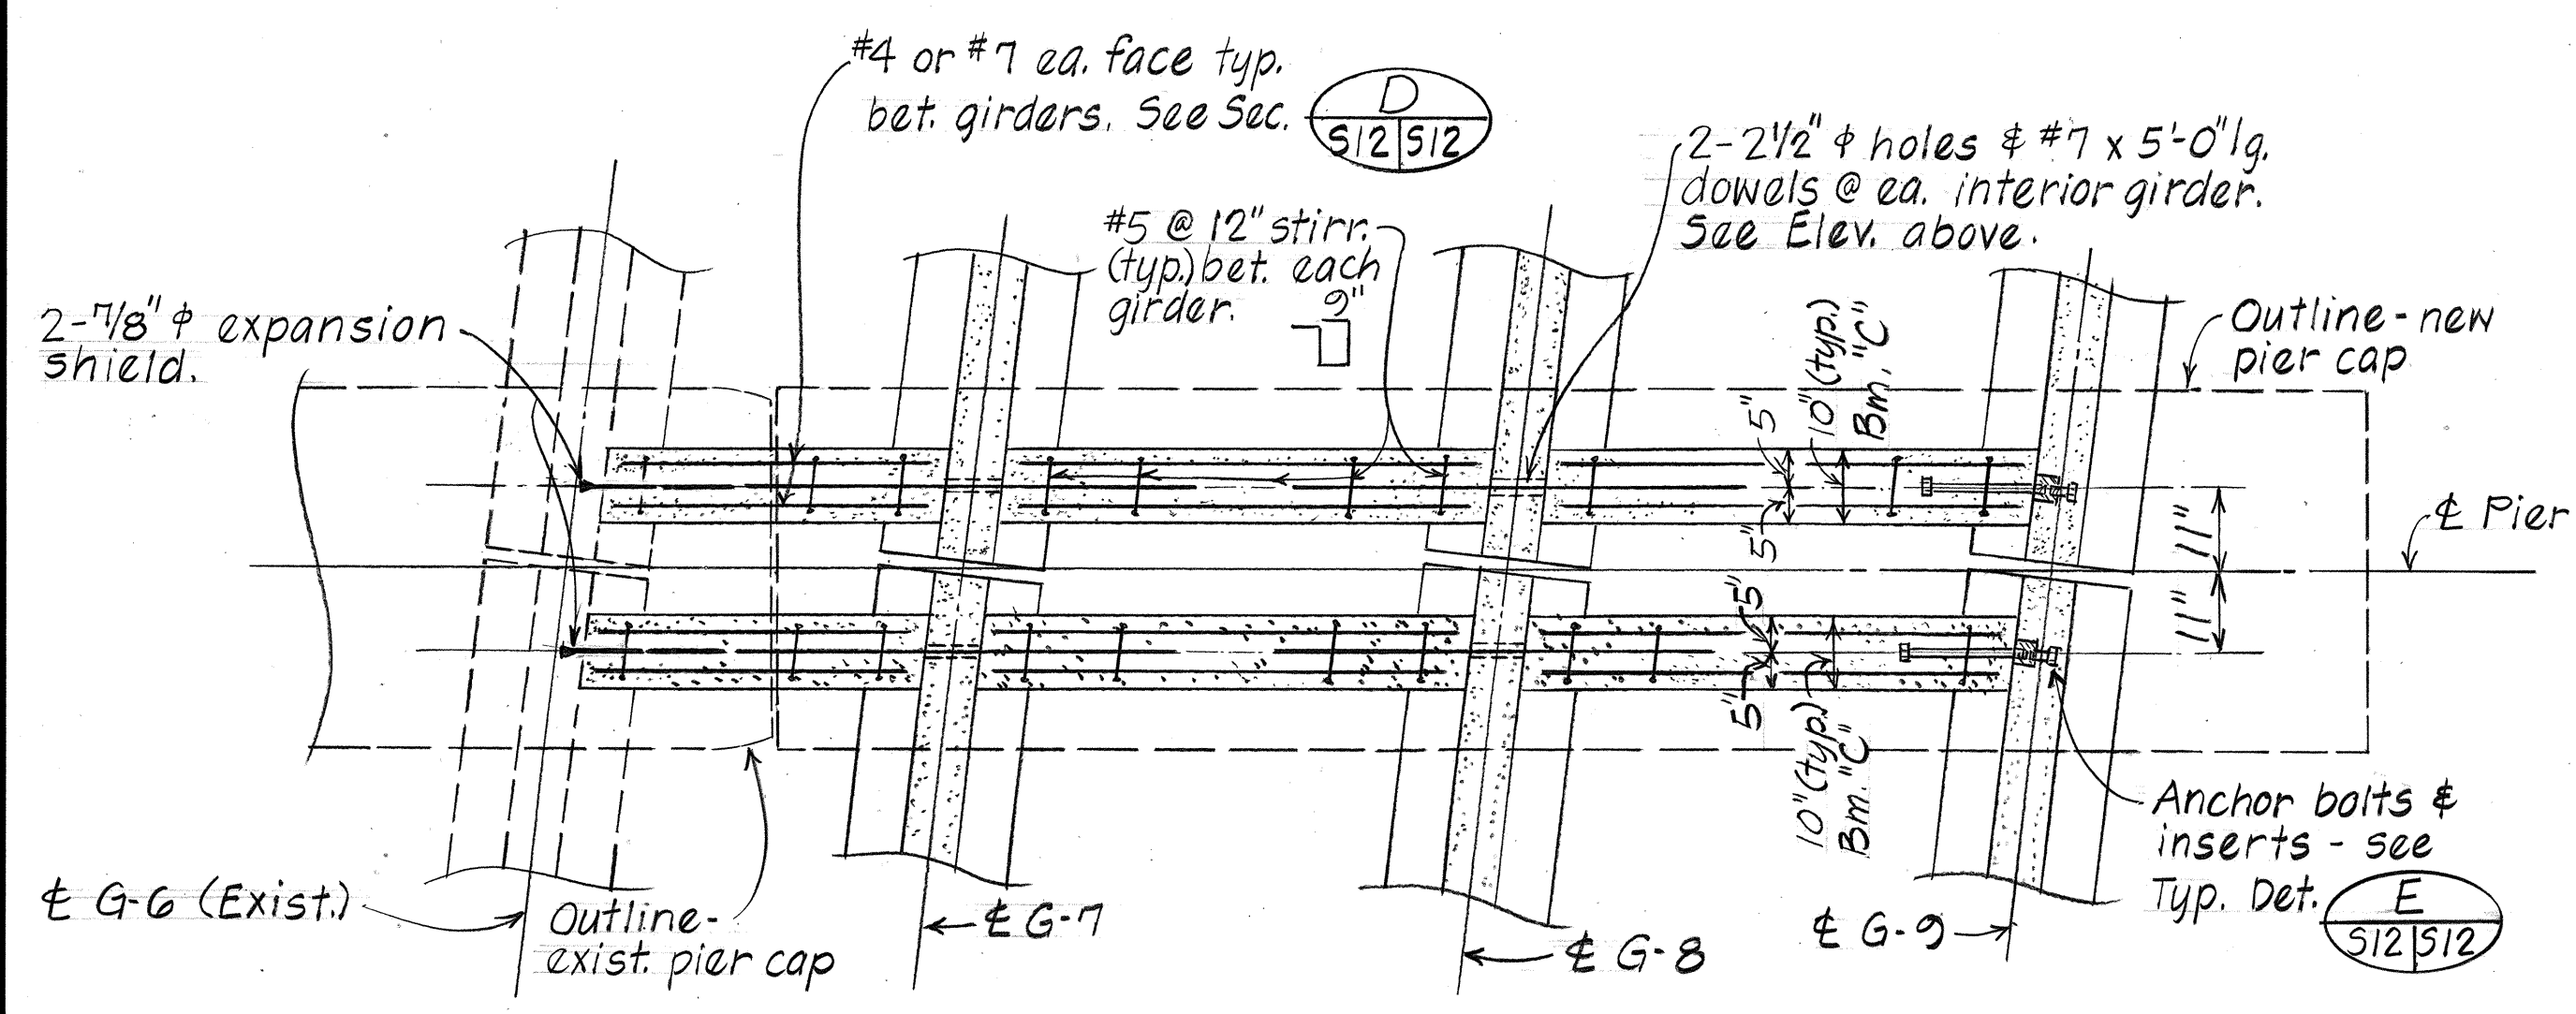


BEAM "C" - SECTION

Scale: 1/2" = 1'-0"

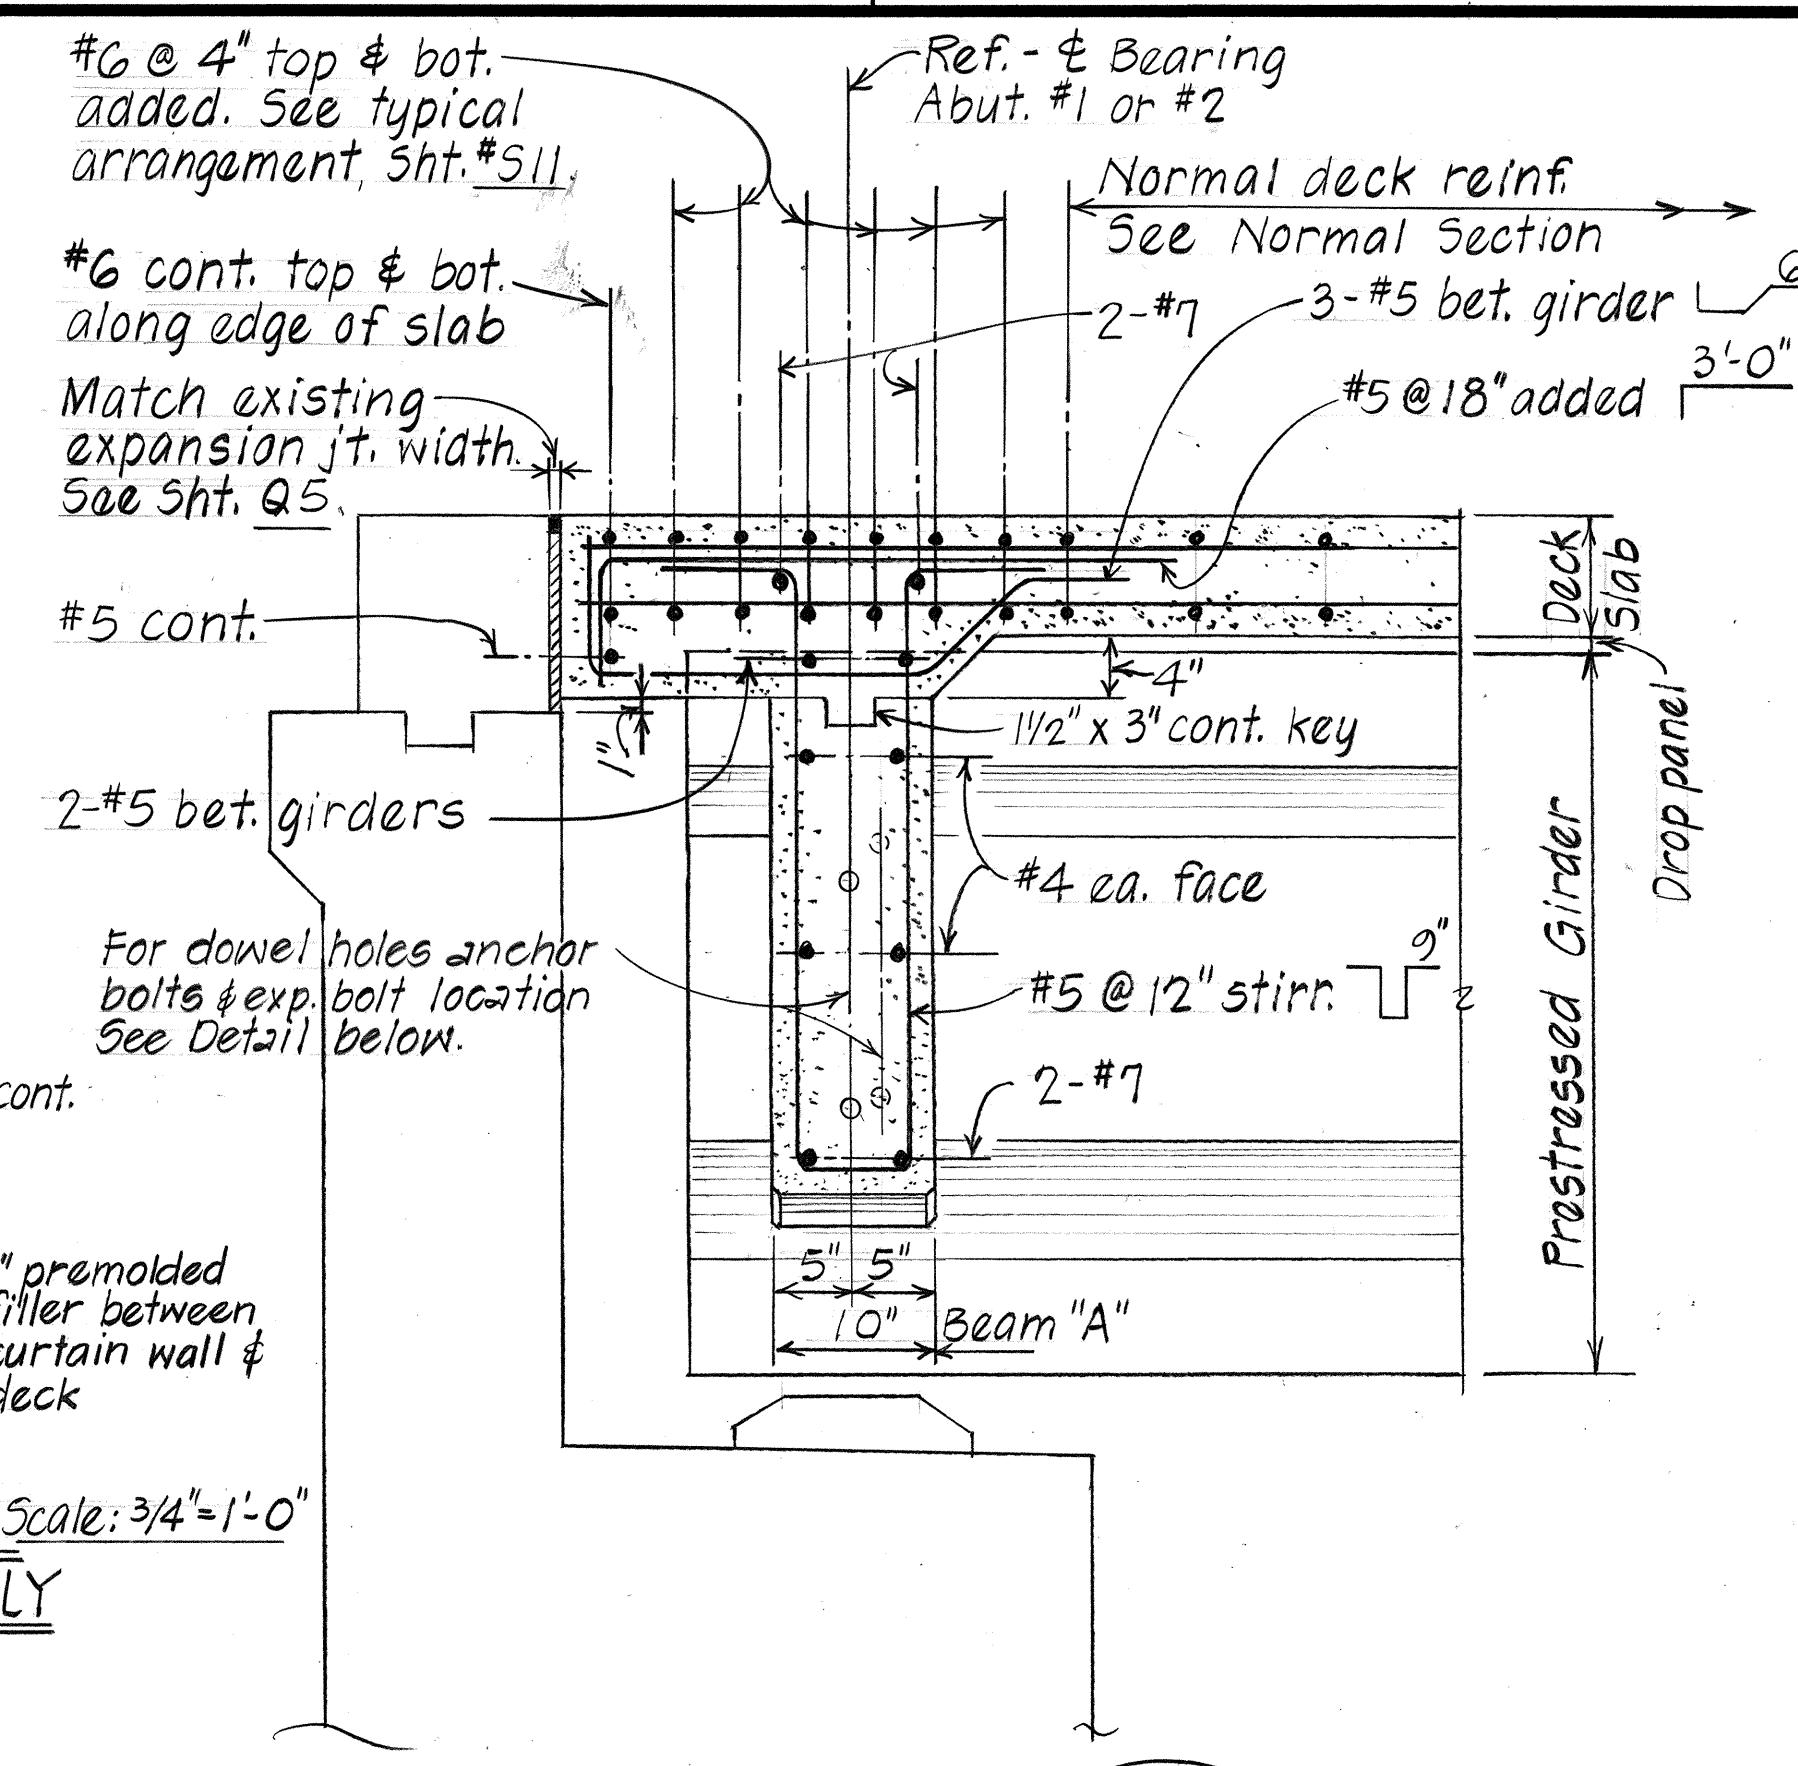

SECTION

Scale: 1" = 1'-0"

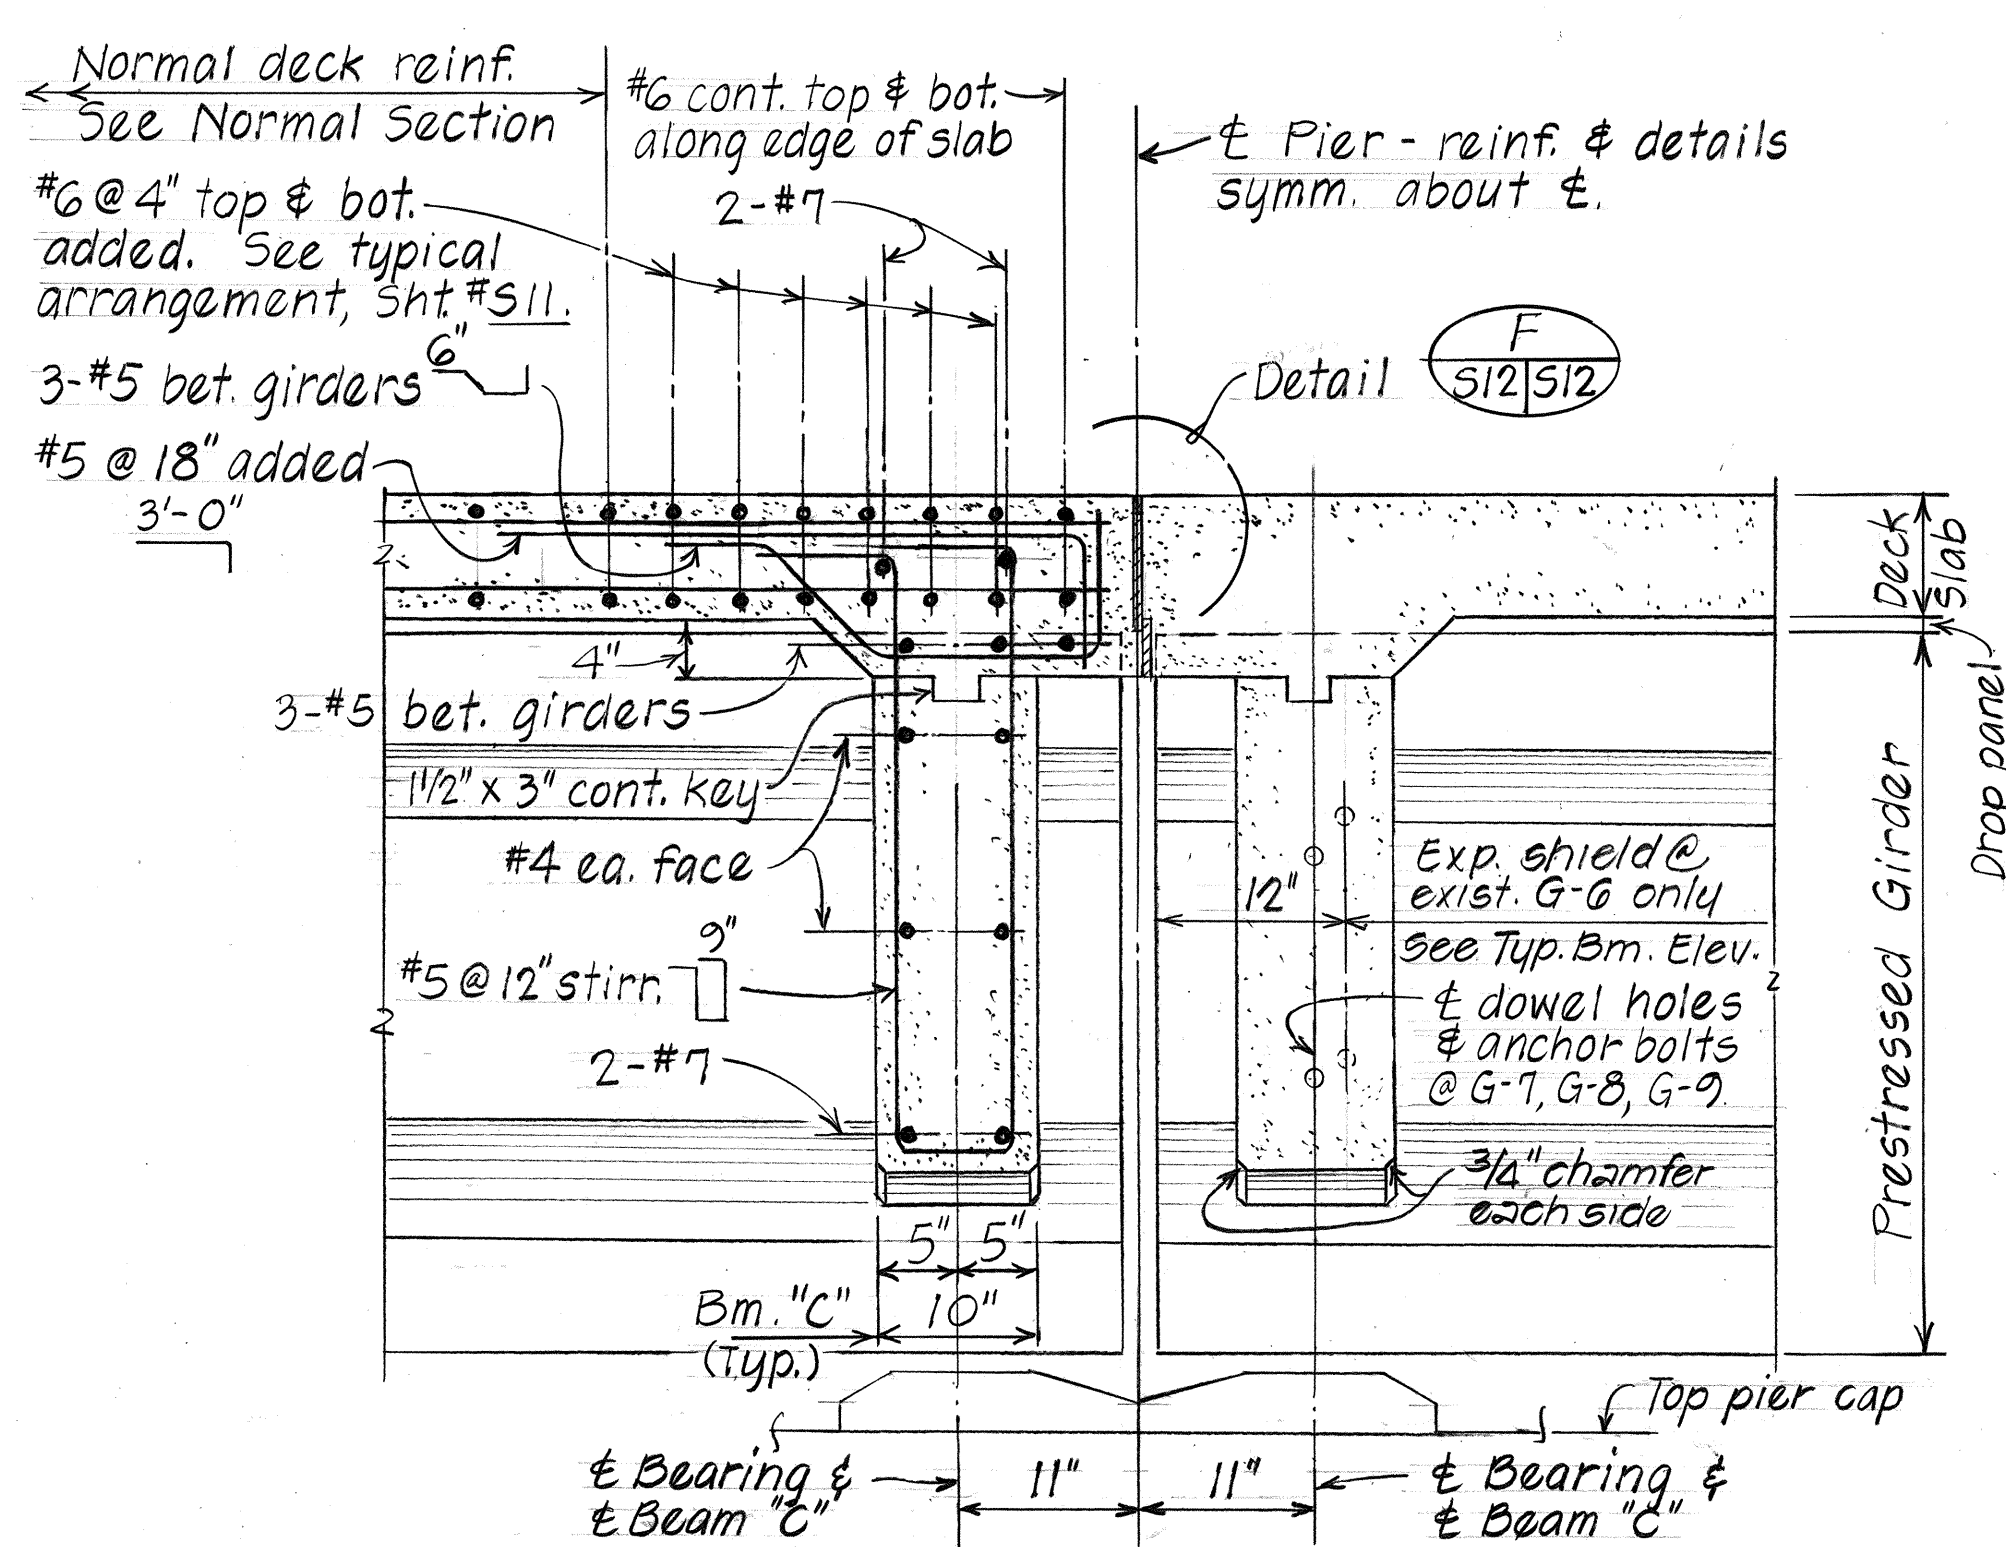


SECTION

Scale: 1" = 1'-0"

TYPICAL INSERT DETAIL

Scale: 3" = 1'-0"

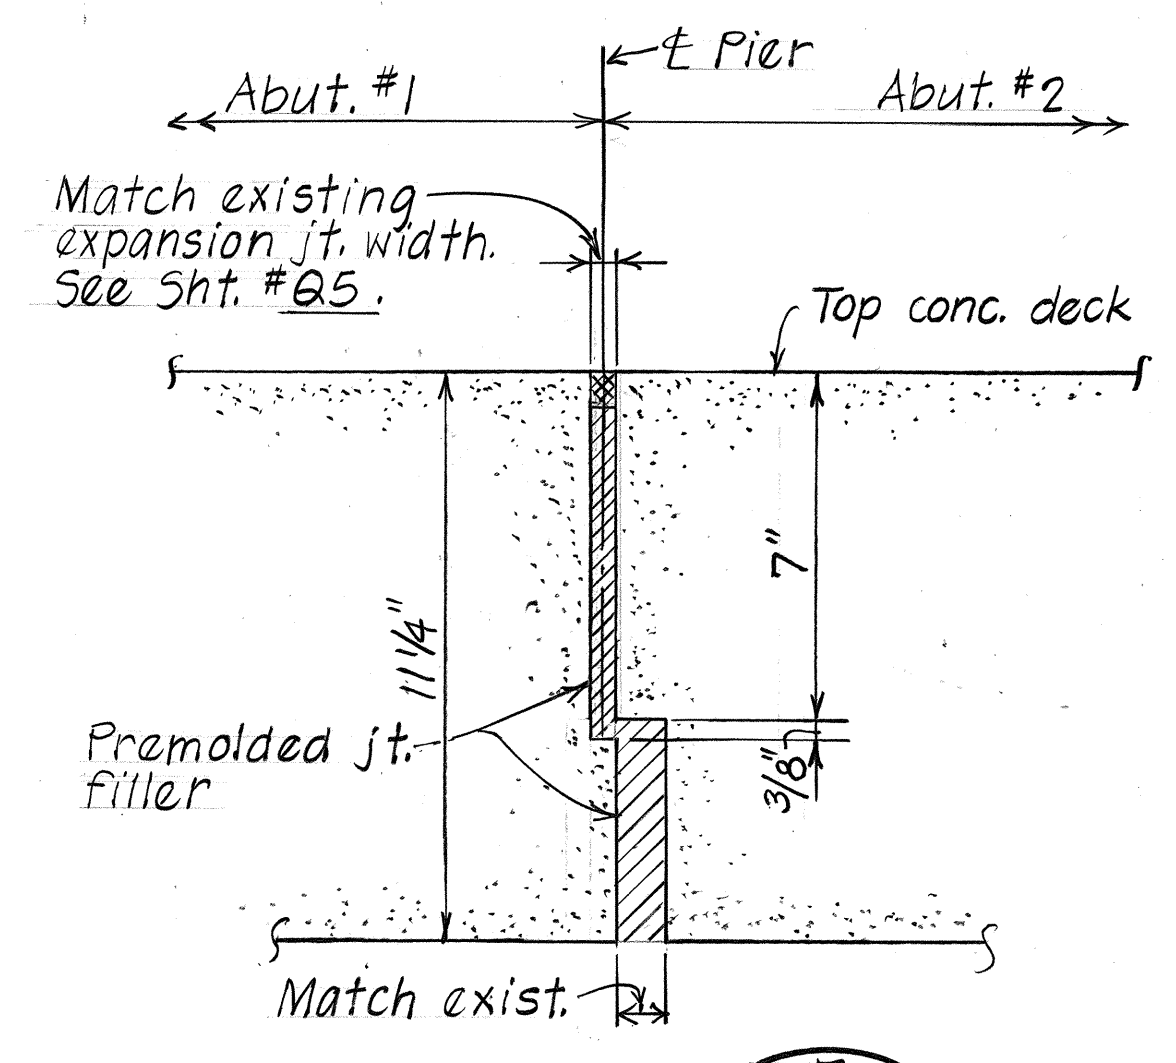


DETAIL

Scale: 3" = 1'-0"

STATE OF HAWAII
DEPARTMENT OF TRANSPORTATION
HIGHWAYS DIVISION
HONOLULU STREAM BRIDGE WIDENING
BEAM "A" & "C" DETAILS
INTERSTATE ROUTE H-1, PALAILAI I.C. TO
KUNIA I.C. CONSTRUCTION OF ADDITIONAL LANES
F.A.I. PROJ. NO. 12-HI-1(189)
Scale: As shown Date: July 1985
SHEET NO. 512 OF 12 SHEETS

TOP CONCRETE SEAT ELEVATION					
LOCATION GIRDER NO.		ABUT. ①	PIER		ABUT. ②
		Ⓢ BEARING	Ⓢ BEARING	Ⓢ BEARING	Ⓢ BEARING
OUTBOUND	G-7	155.30	155.34	155.35	155.57
	G-6	155.30	155.43	155.44	155.66
	G-5	155.48	155.53	155.53	155.75
INBOUND	G-5	155.48	155.53	155.53	155.76
	G-6	155.30	155.44	155.45	155.68
	G-7	155.30	155.35	155.36	155.50

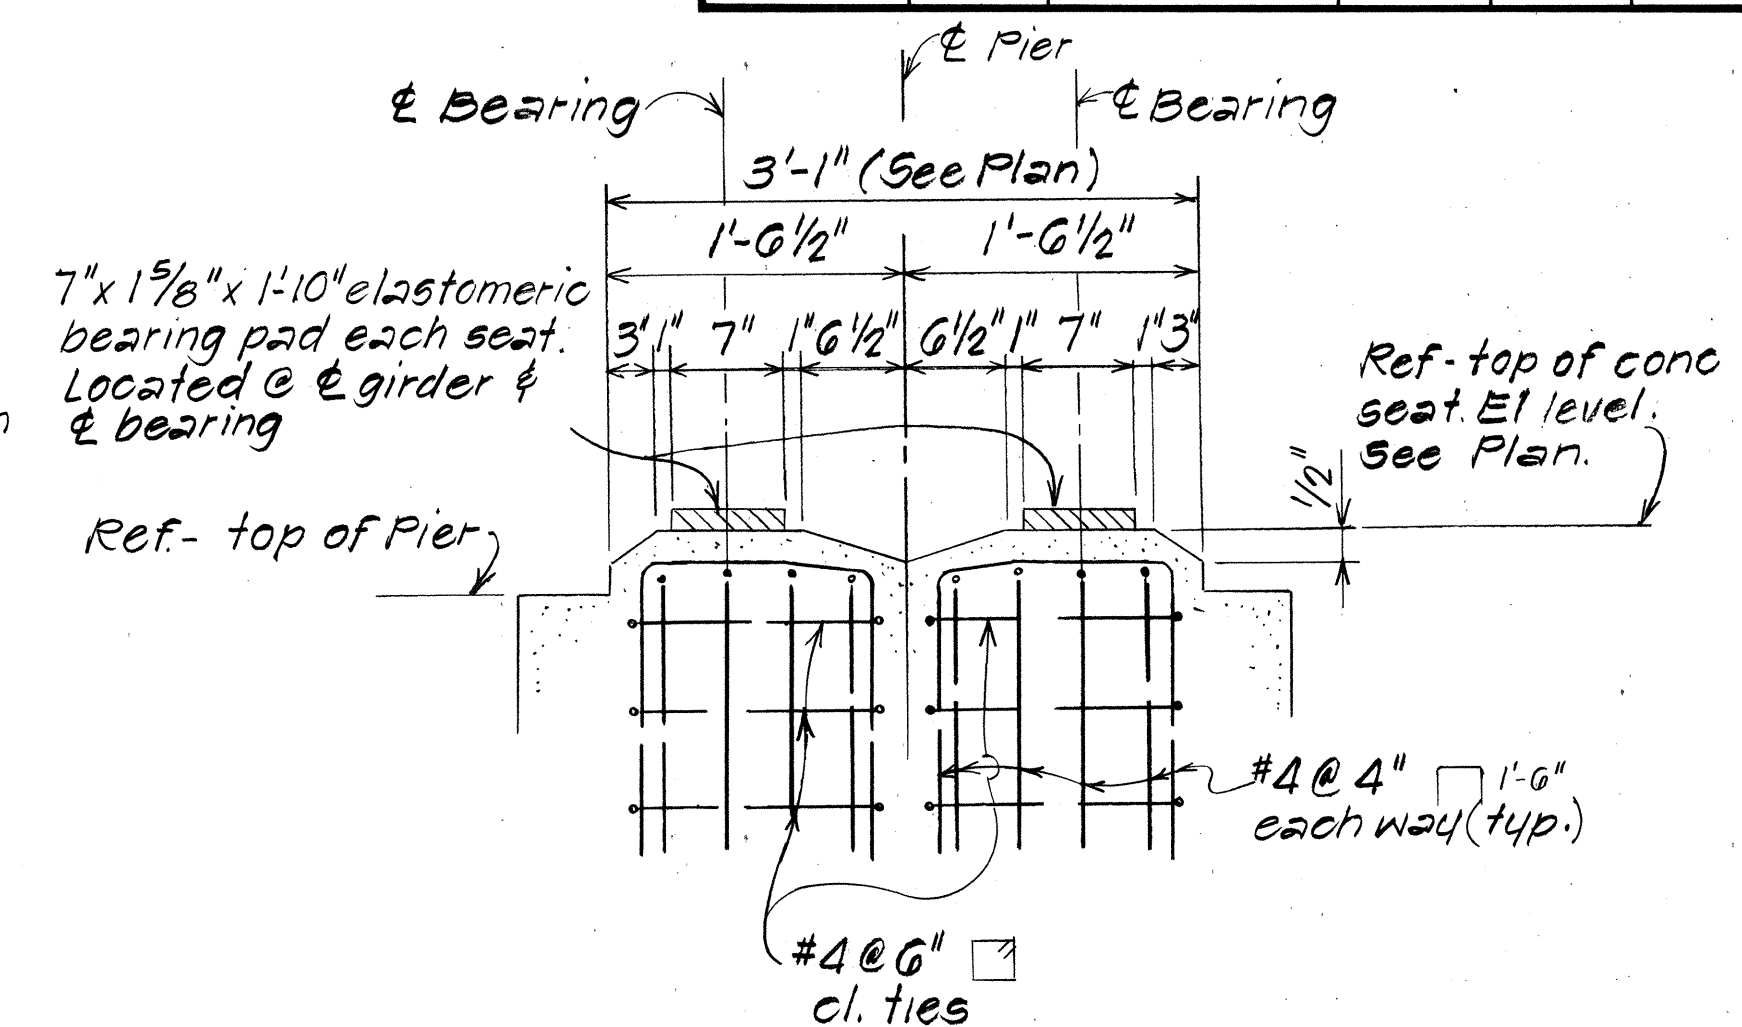


SECTION 
Scale: 1" = 1'-0"

AT PIER CAP


PART PLAN
Scale: 1" = 1'-0"

[illegible]

CONCRETE SEAT CREEP BLOCK CONCRETE SEAT

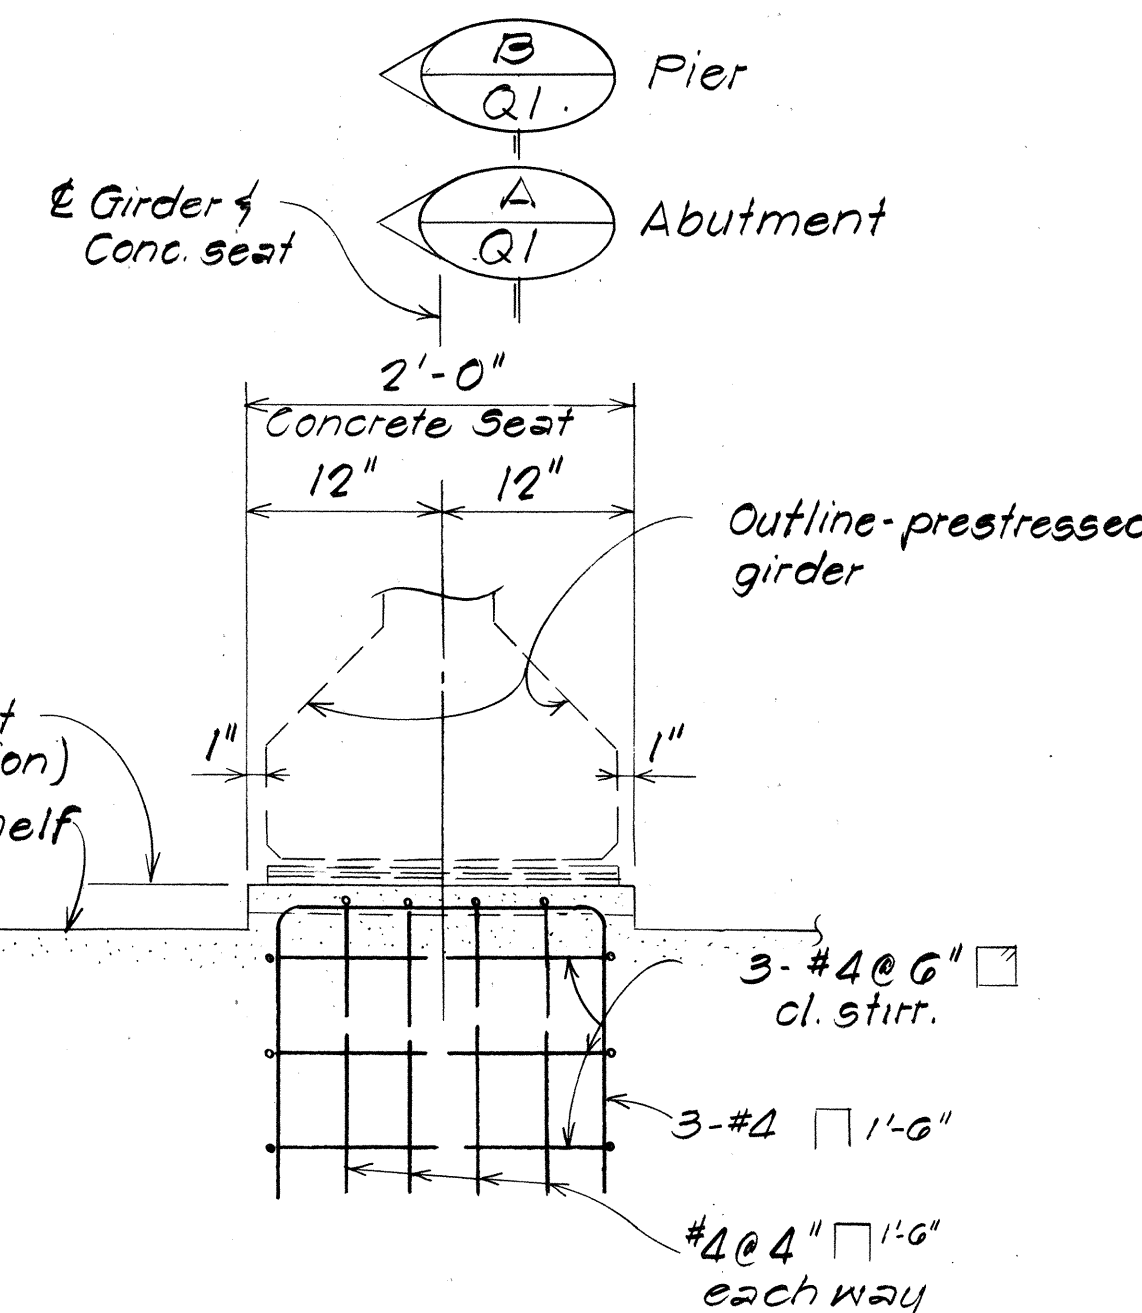

CONCRETE SEAT

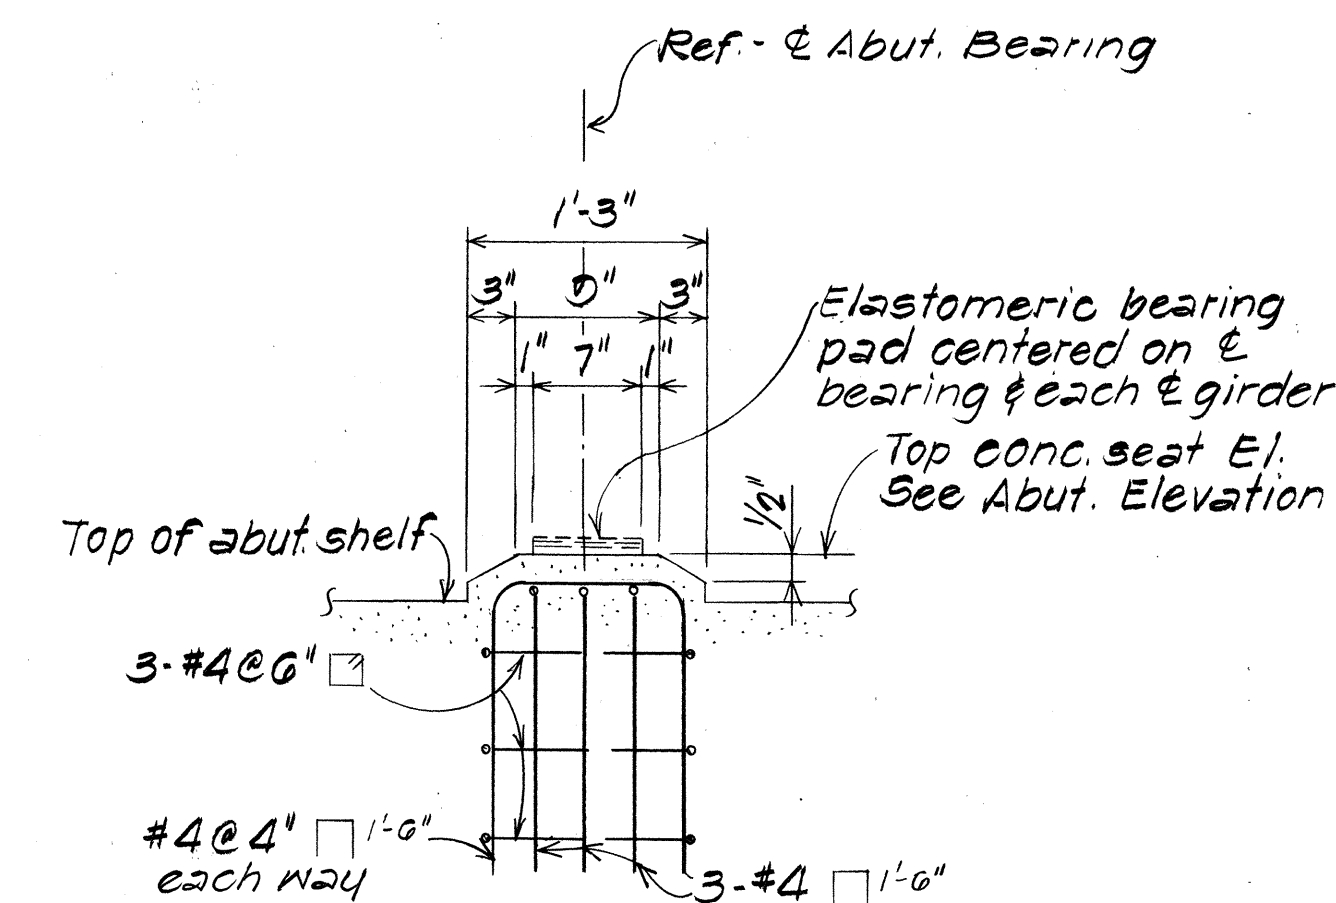


SECTION 

TYPICAL DETAILS
GIRDER CONCRETE SEAT &
CREEP BLOCK DETAILS

Scale: As Shown Date: July 1985
SHEET No. 01 OF 5 SHEETS

FED. ROAD DIST. NO.	STATE	FED. AID PROJ. NO.	FISCAL YEAR	SHEET NO.	TOTAL SHEETS
HAWAII	HAW.	12-HI-1(189)	1986	65	99

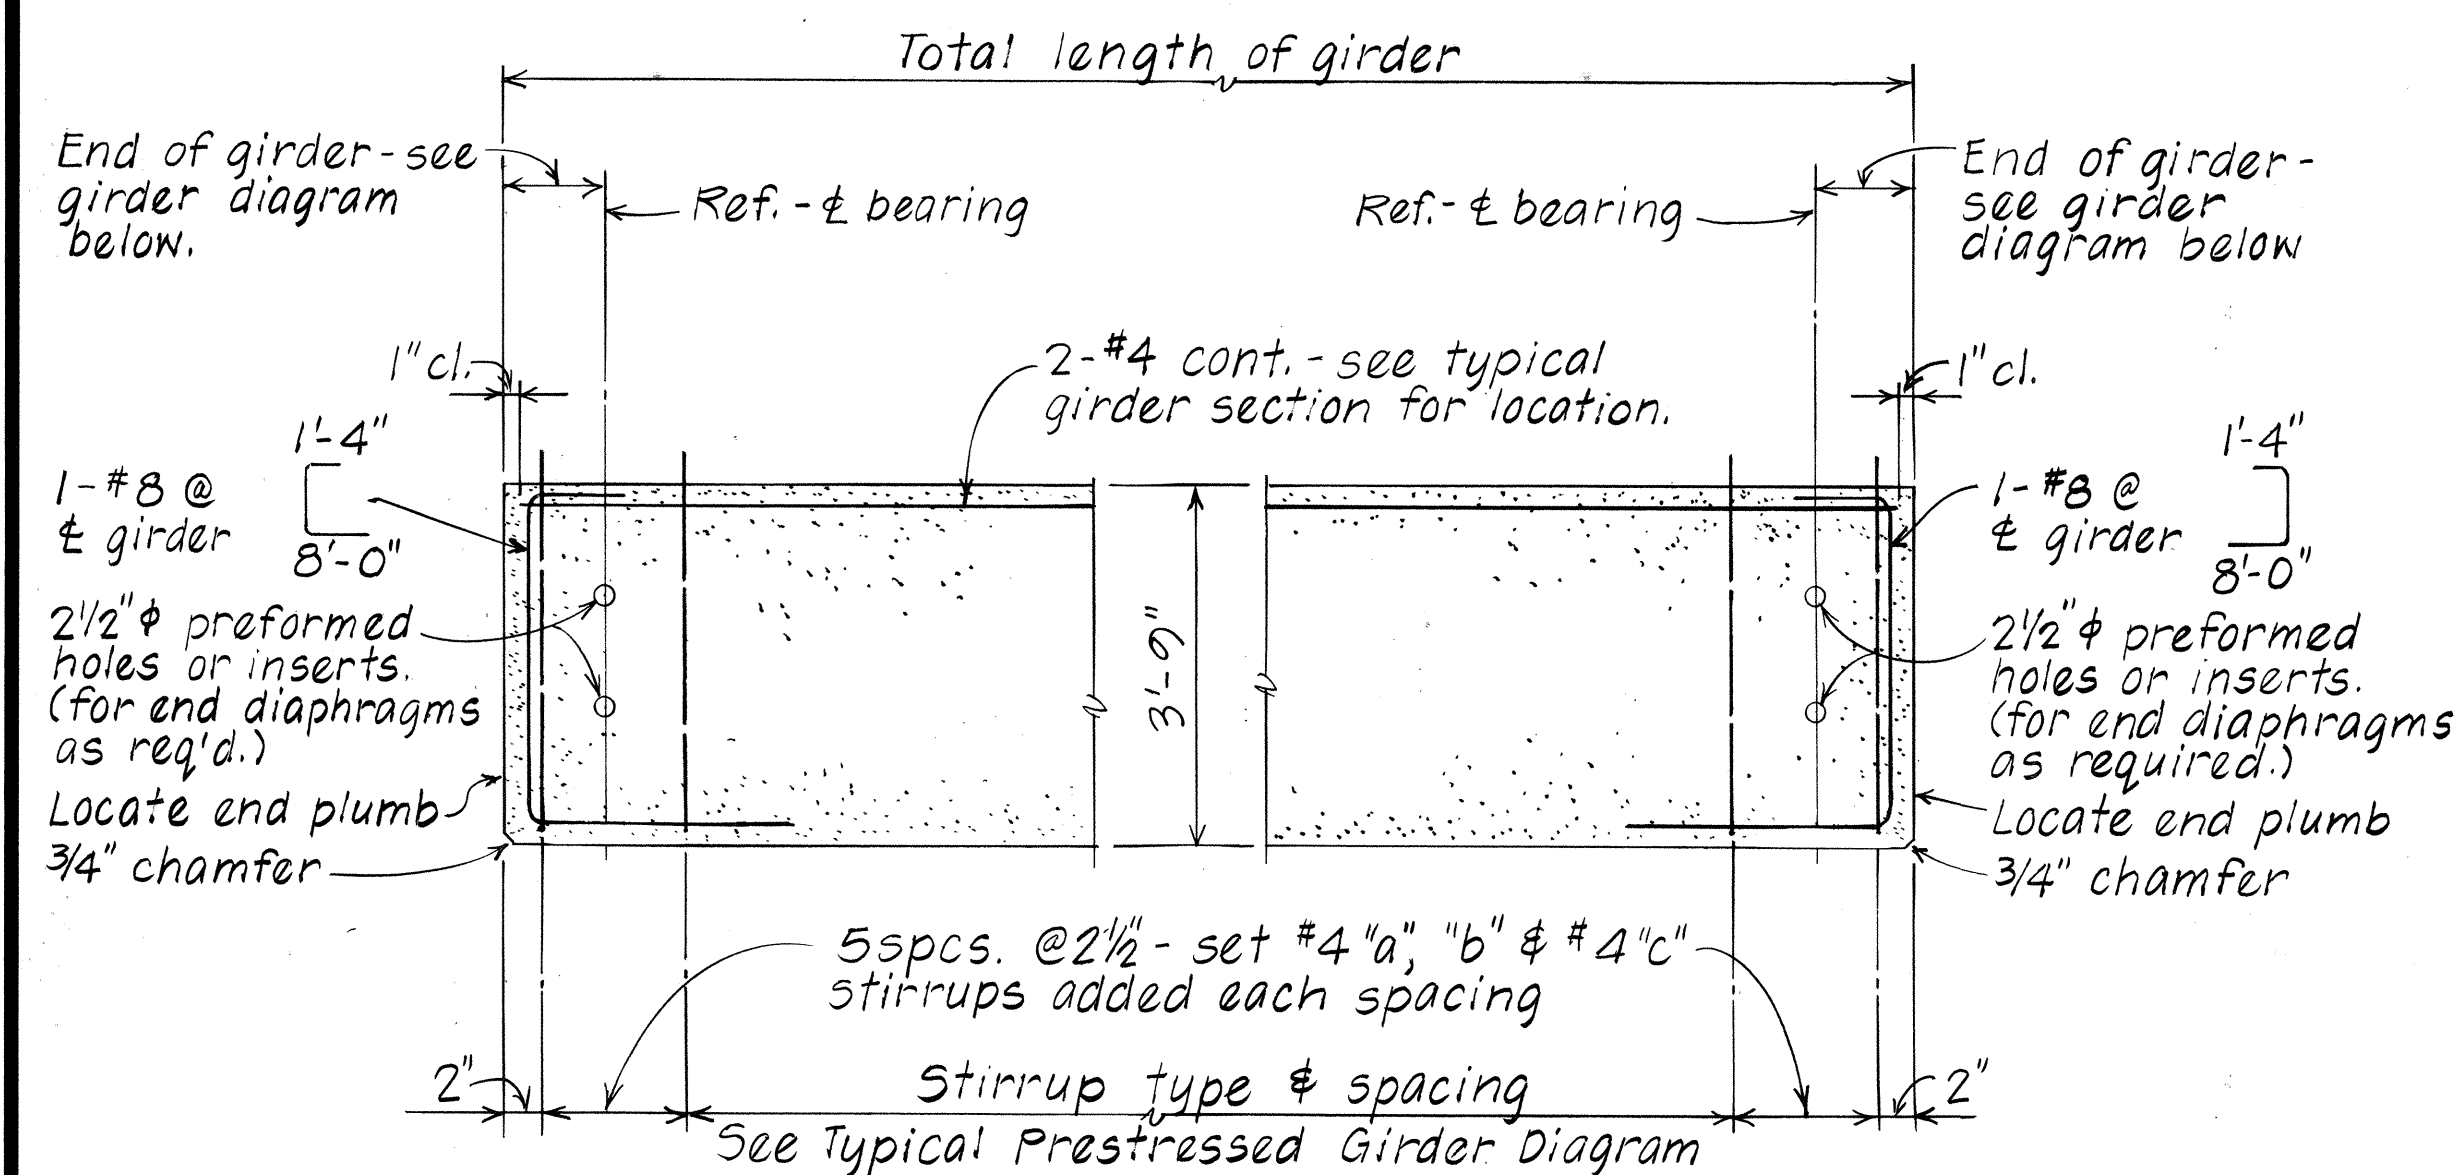

ELEVATION - TYPE PG-III GIRDER END DETAILS

Not to Scale

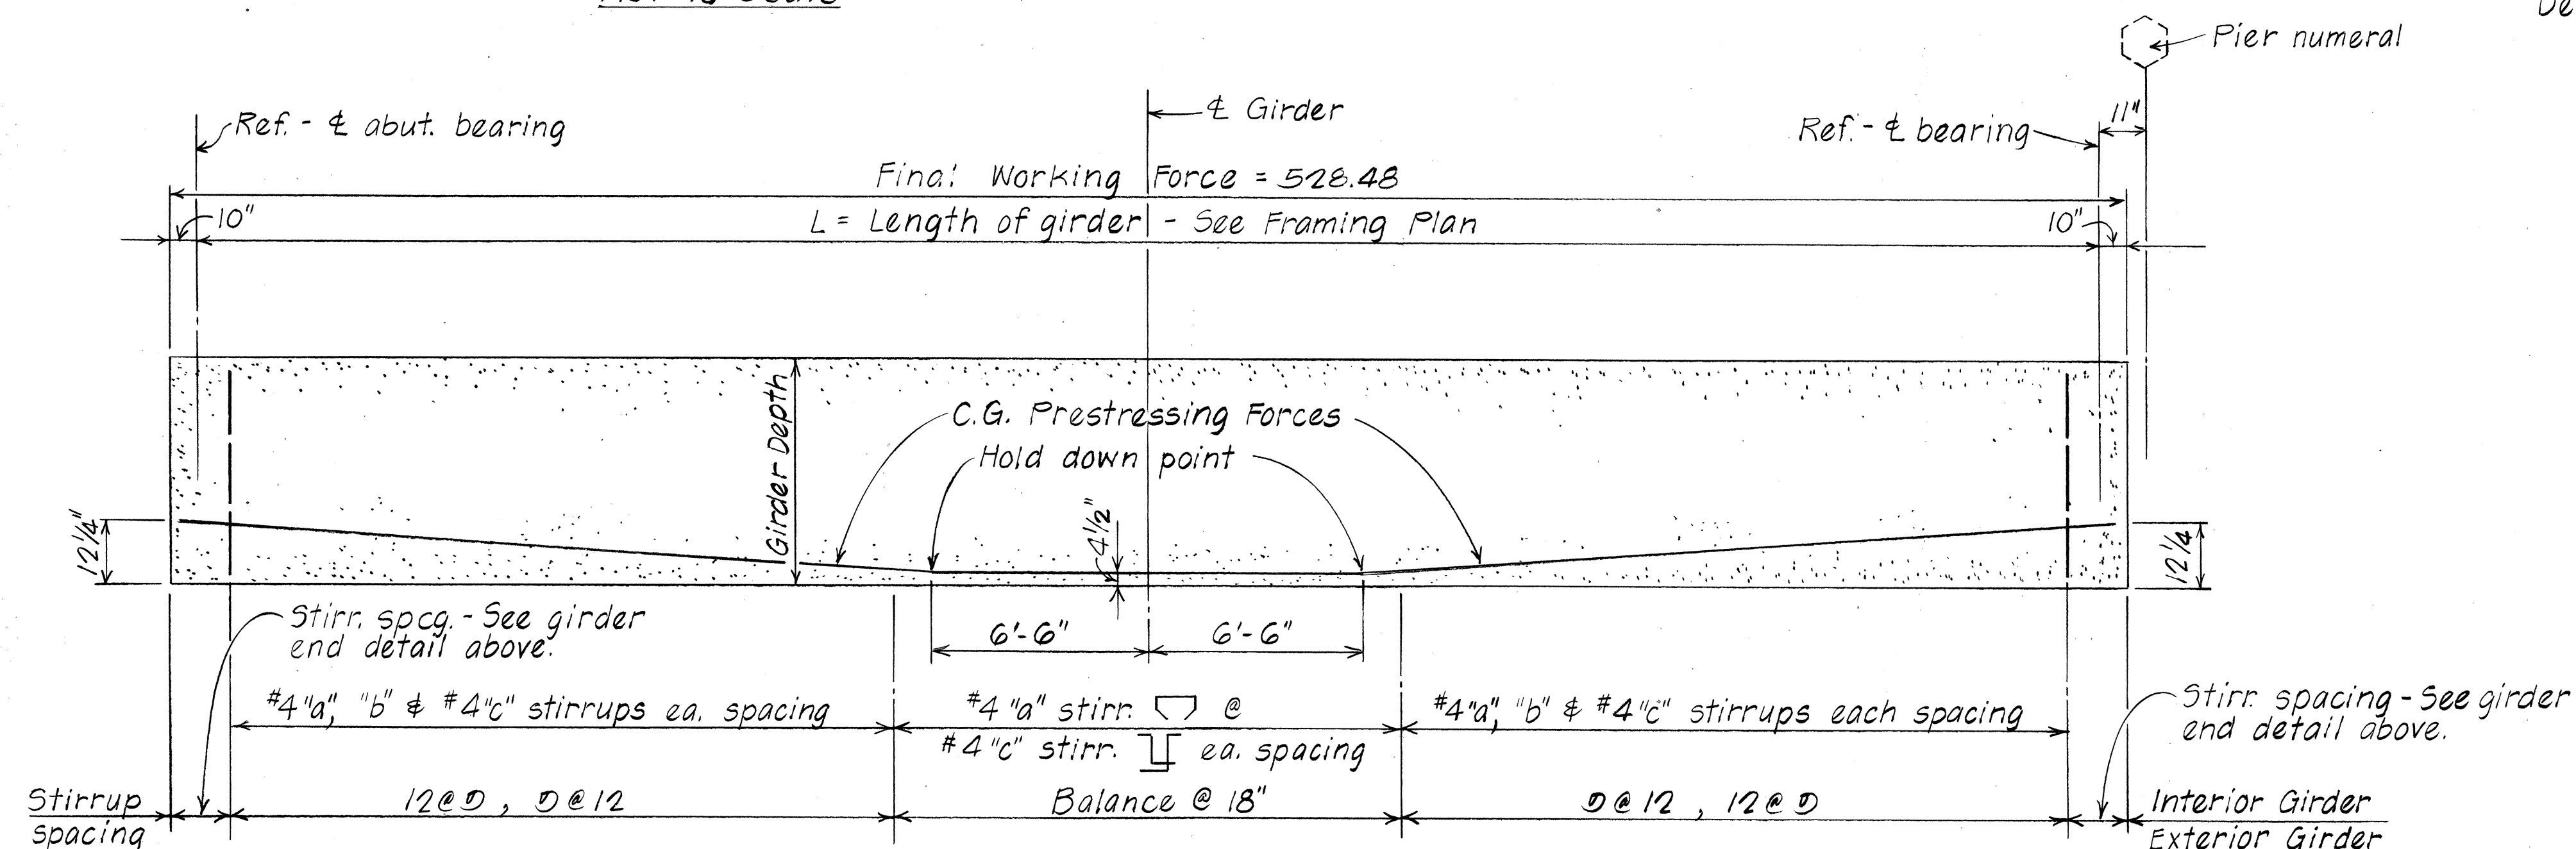


DIAGRAM - TYPICAL PRESTRESSED GIRDER DETAIL TYPE PG-III

Not to Scale

PRESTRESSED CONCRETE GIRDERS:

$f'_c = 5,500$ psi @ 28 days
 $f_{ci} = 4,000$ psi @ transfer


PRESTRESSED STRANDS

- 1/2" ϕ 270 ksi, 7 wire stressed-relieved strands (ASTM A416)
Total losses other than friction = 45,000 psi.
- Allowable stresses in strands shall be in accordance with Design Specifications. (See General Structure Notes)


BUNDLING OF PRESTRESSING REINFORCEMENT

ARRANGEMENT AND CLEARANCE FOR PRETENSIONED STRANDS

- Strands may be bundled in groups as shown.
- The minimum distance "s" between groups or individual strands 2" for 1/2" strands.
- "s" is measured between centers of adjacent strands.

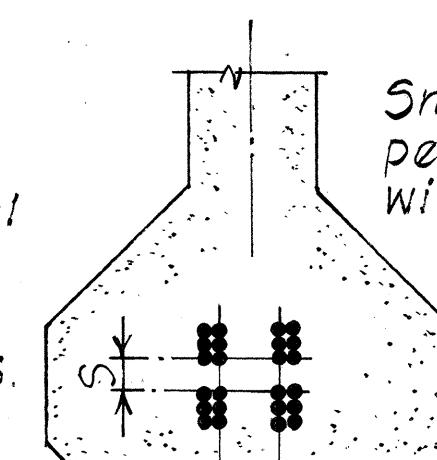

CASE I

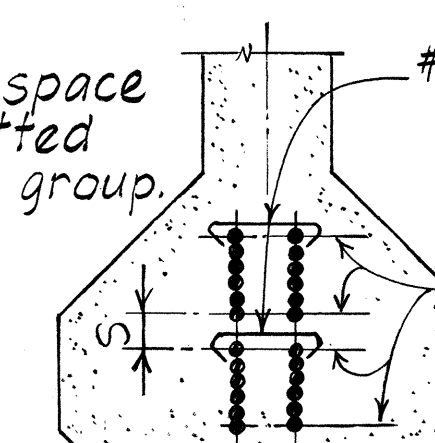

CASE II


Small space permitted within group.

#4 @ 18" between & 6'-0" ea. side of harp pts. at top of each bundle.

Max. of 6 vertically stacked strands in any one group.

Reference Note:

For girder type & location, see Deck Framing Plan Sht. 511.

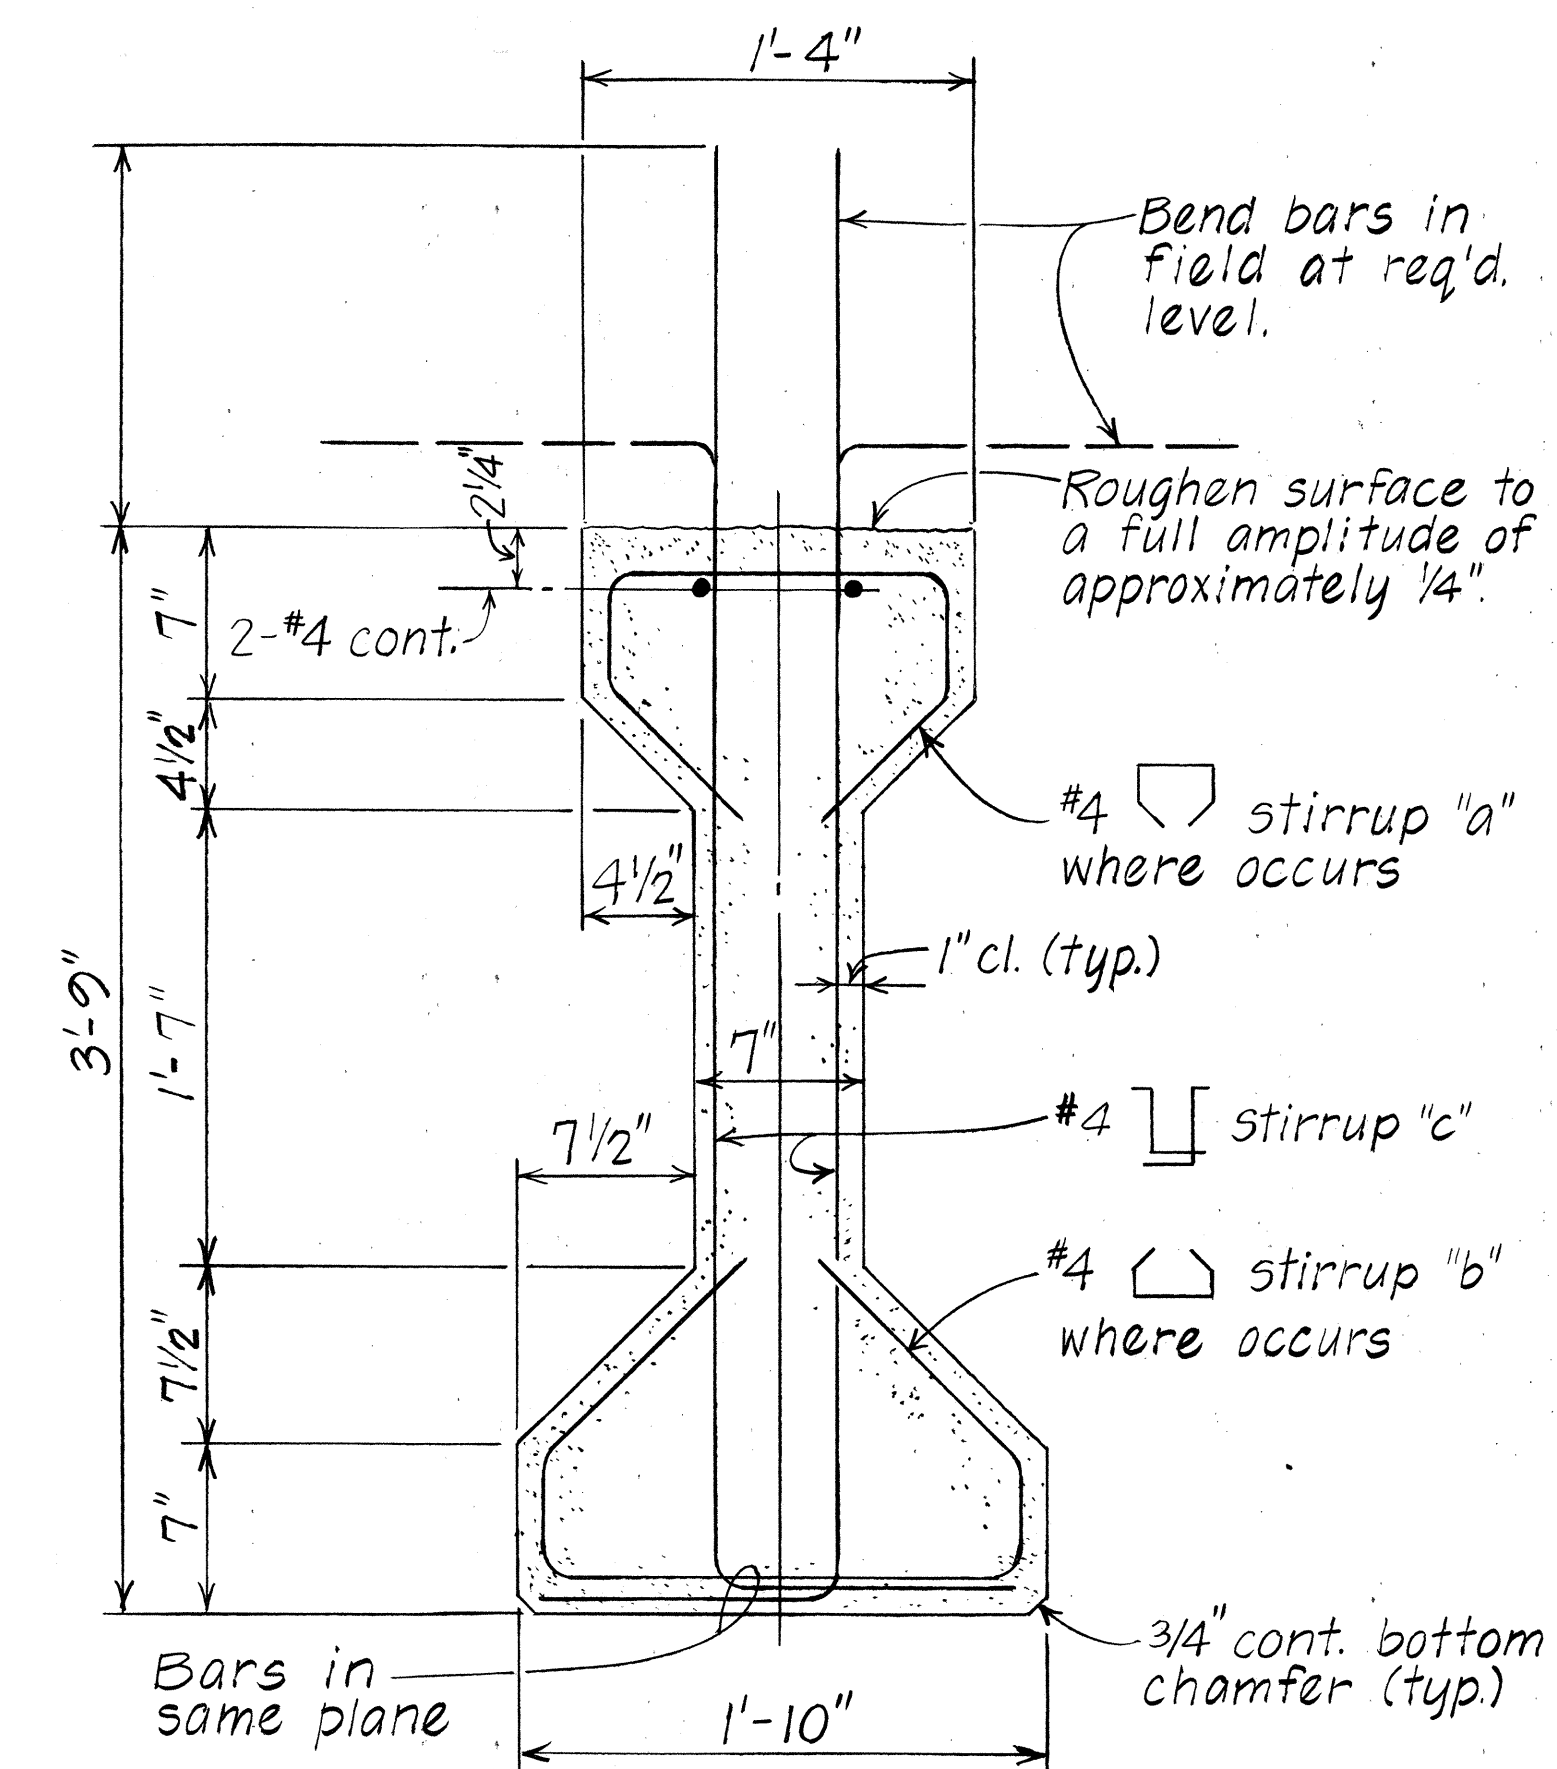

TYPICAL PRESTRESSED CONCRETE GIRDER

Scale: 1 1/2" = 1'-0"

NOTES

- All strand patterns shall be approved by the Engineer.
- Forms must be removed and the beams inspected before strands are out.
- For additional holes and inserts in prestressed girders for beam connections refer to corresponding beam details. See Sht. #511 & 512.
- For additional prestressed girder details not covered by these drawings, refer to corresponding detail plans.
- The calculated camber includes the effect of the initial prestress force and the weight of the girder upon removal from the prestressing bed. Calculated camber values shown do not account for any camber growth of the girder. The actual camber at time of deck pour shall not exceed the calculated camber by more than 100%. Calculated midspan camber = 7/8 inch. Contractor shall submit record of cambers to the Engineer. This record shall include cambers at time of detensioning, delivery, and deck pour.

STATE OF HAWAII
DEPARTMENT OF TRANSPORTATION
HIGHWAYS DIVISION

TYPICAL DETAILS


**PRESTRESSED GIRDER
(TYPE PG-III)**

F.A.I. PROJ. NO. 12-HI-1(189)

Scale: As Shown Date:

SHEET NO. 02 OF 5 SHEETS

FED. ROAD DIST. NO.	STATE	FED. AID PROJ. NO.	FISCAL YEAR	SHEET NO.	TOTAL SHEETS
HAWAII	HAW.	IR-HI-1(189)	1986	66	99


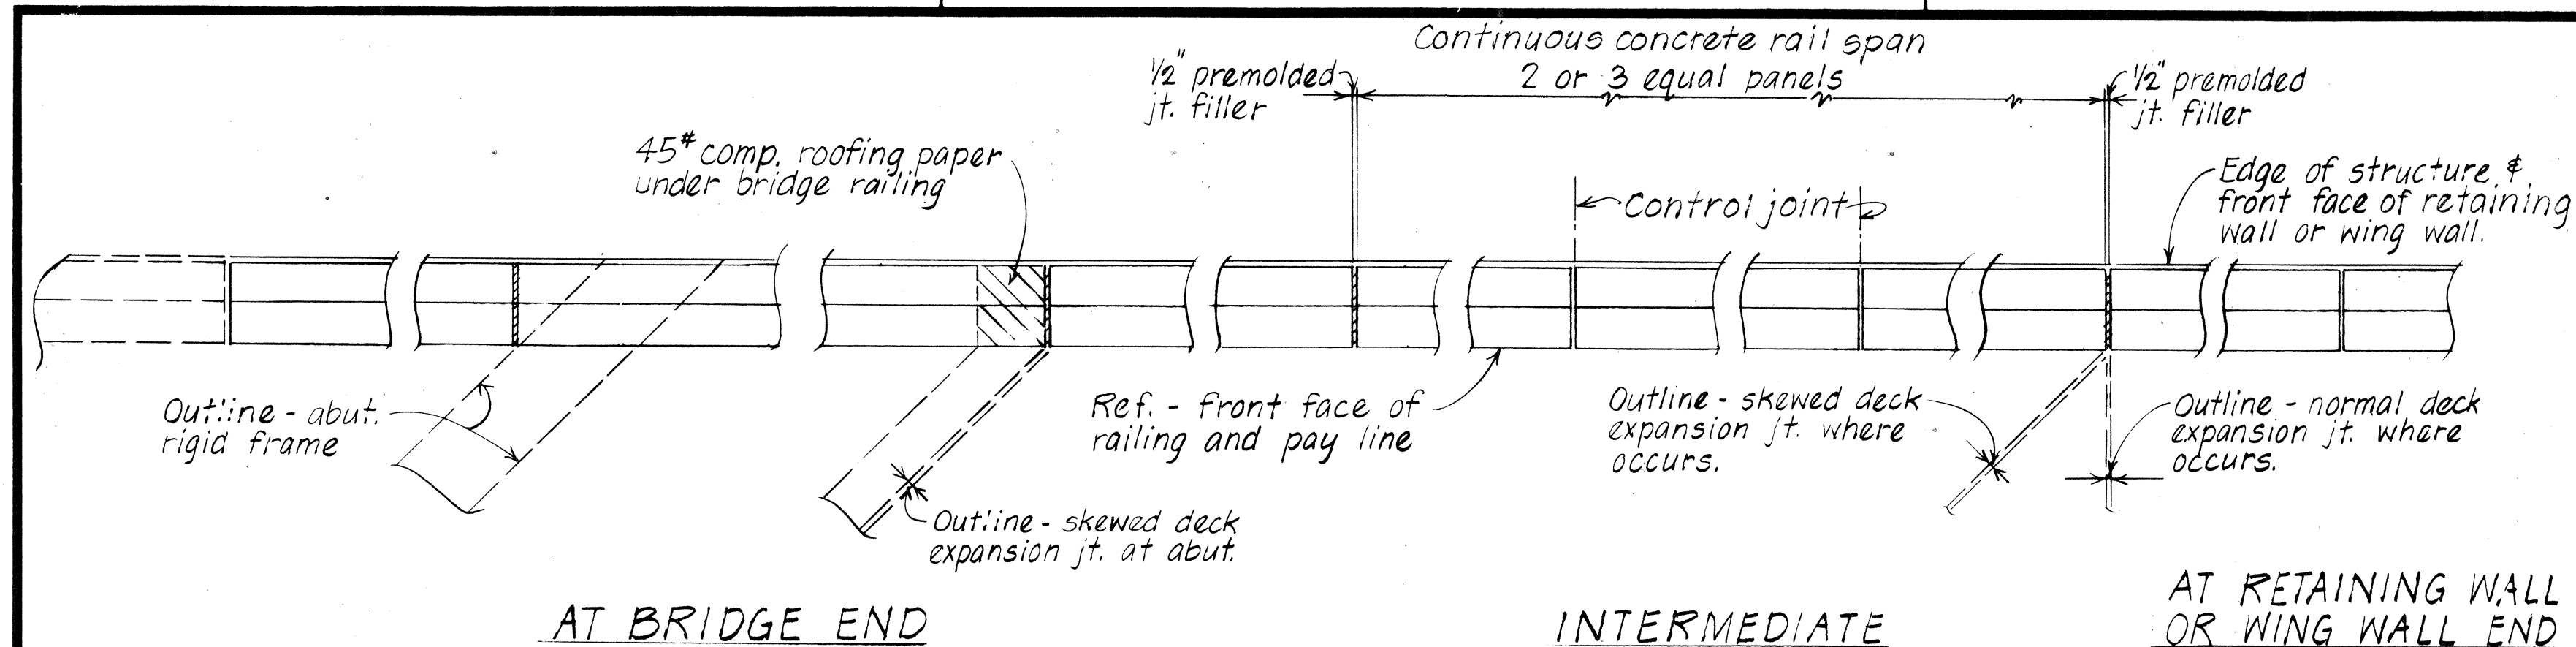


RAILING LAYOUT PLAN





Scale: $3/8" = 1'-0"$

Scale:

* * Railing shall be constructed on deck slope with 2 or 3 equal panels of 30'-0" max. length within each rail span. Locate control joints at interior panel points (typical). Concrete railing to receive Class 2 rubbed finish. See specifications.

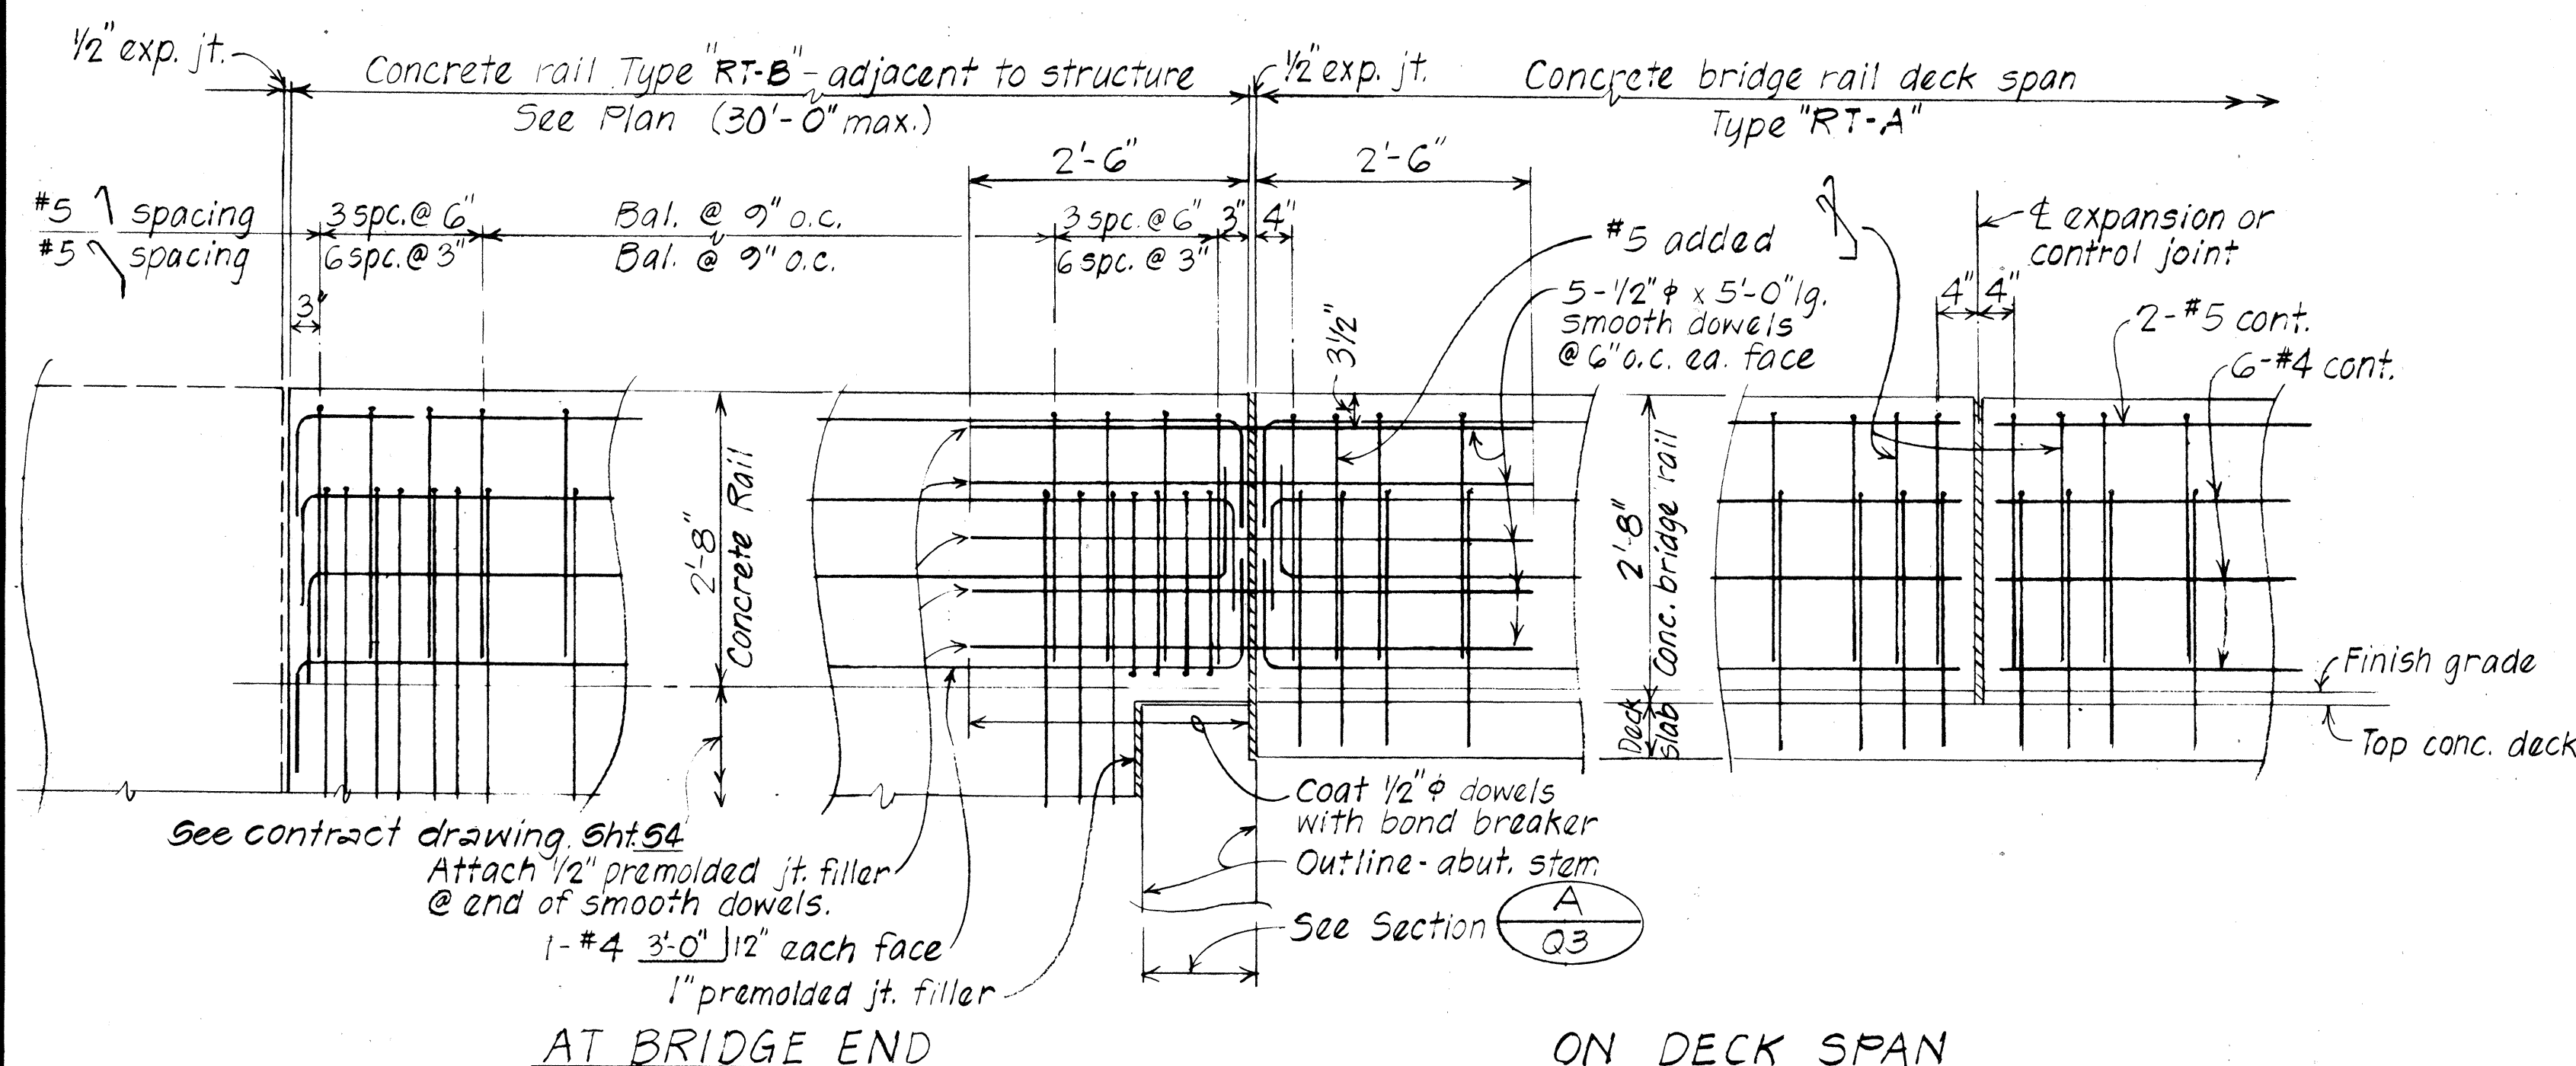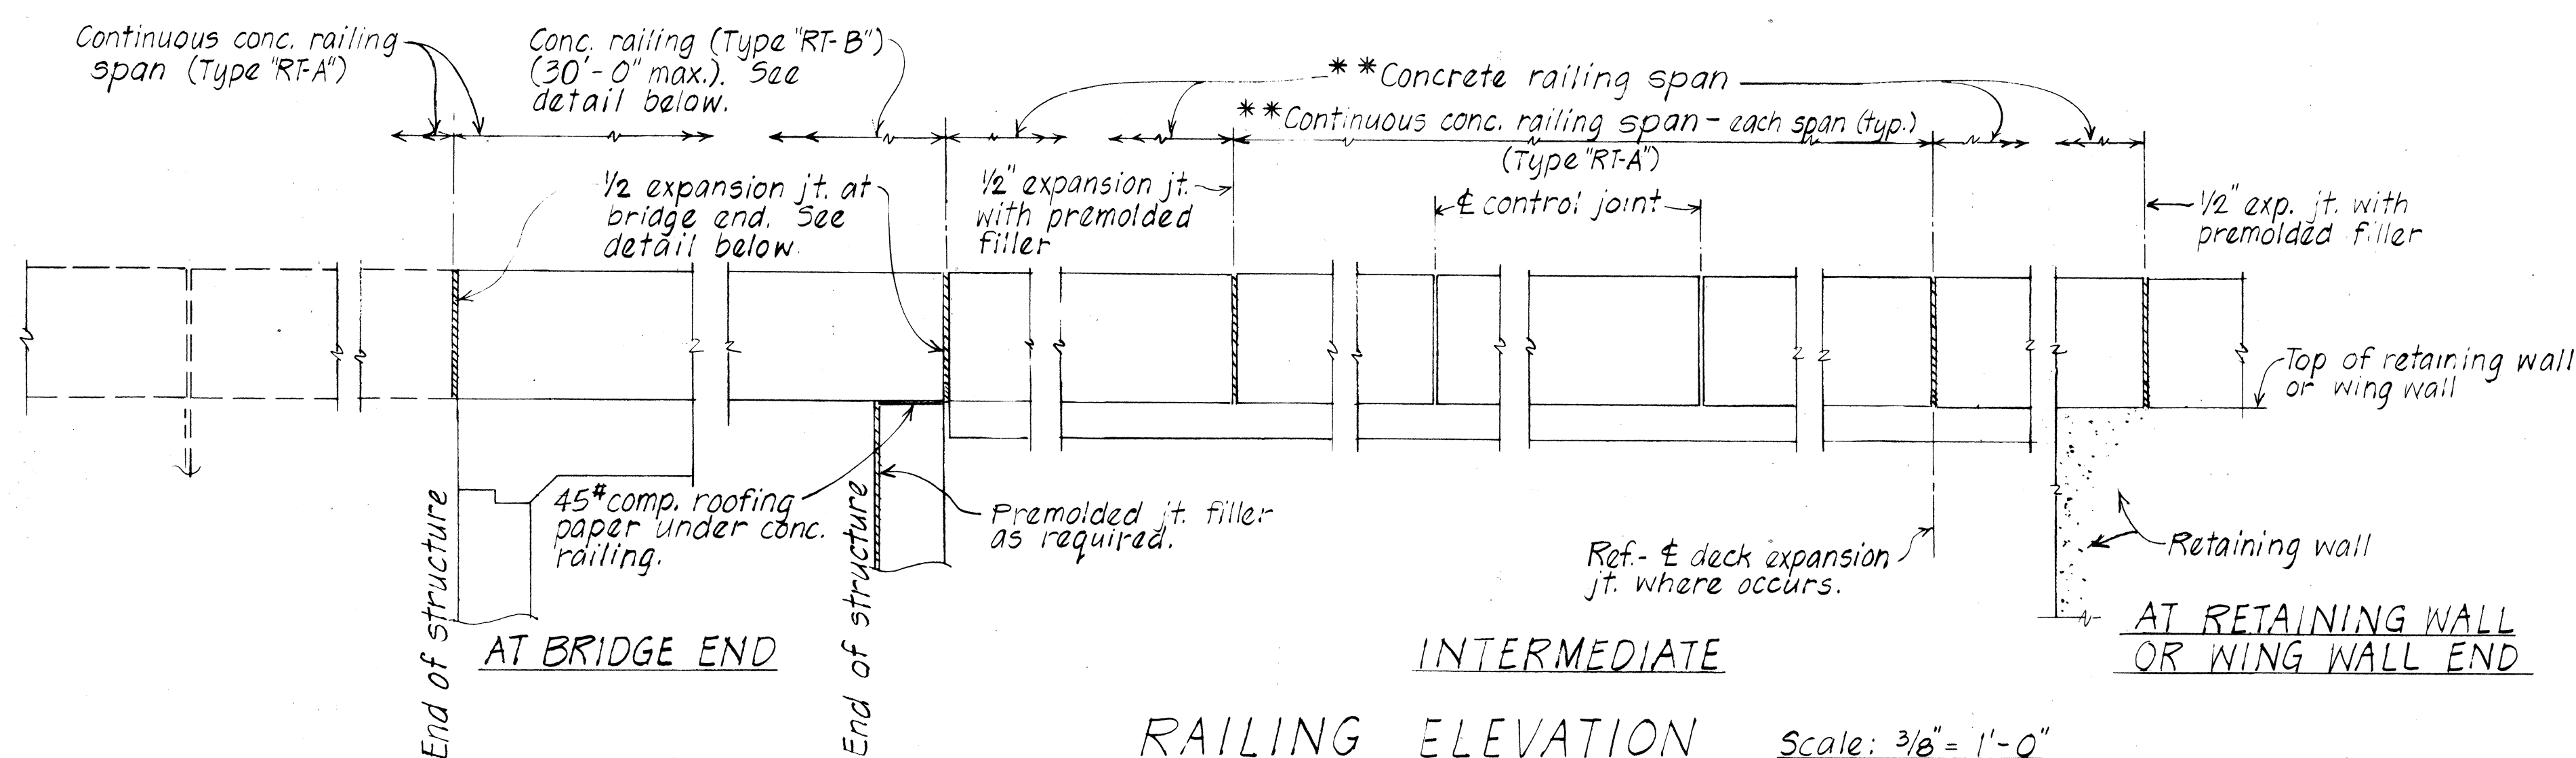

PART ELEVATION - CONCRETE RAILING REINFORCEMENT Scale: $\frac{3}{4}" = 1'-0"$

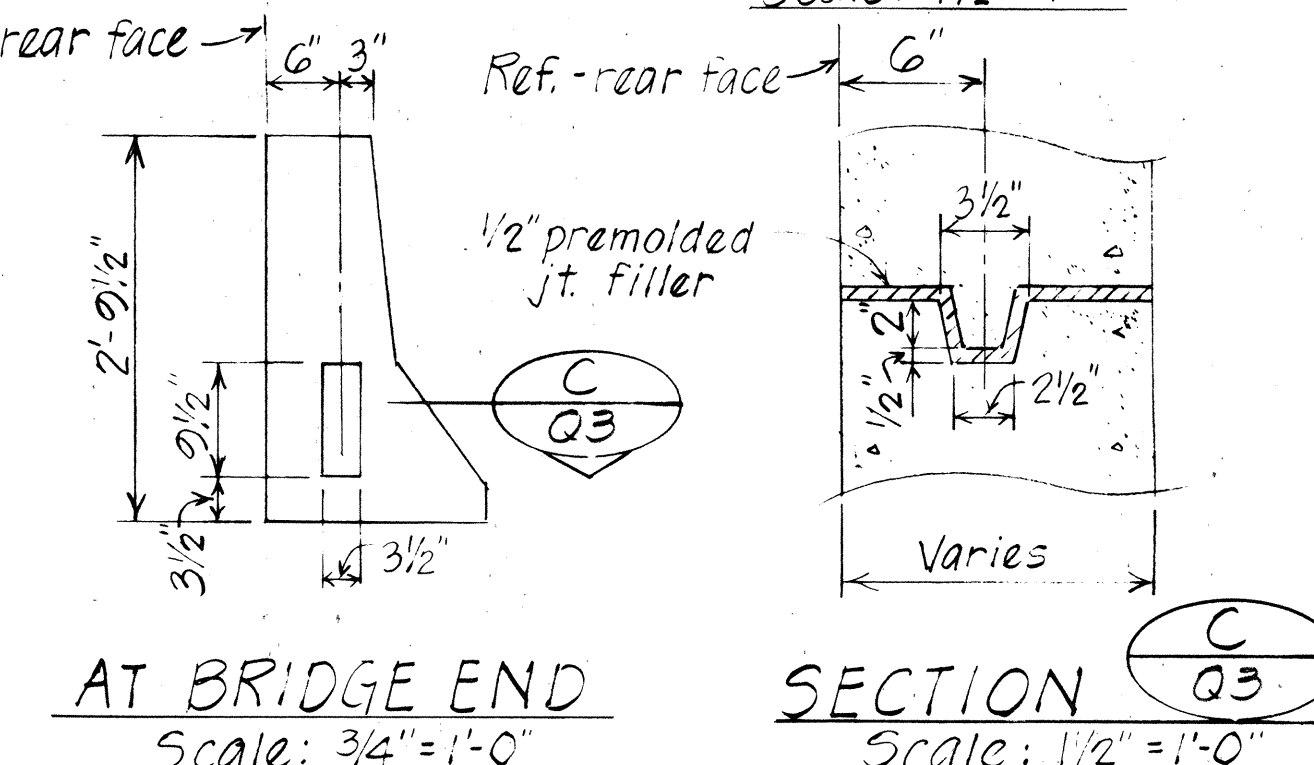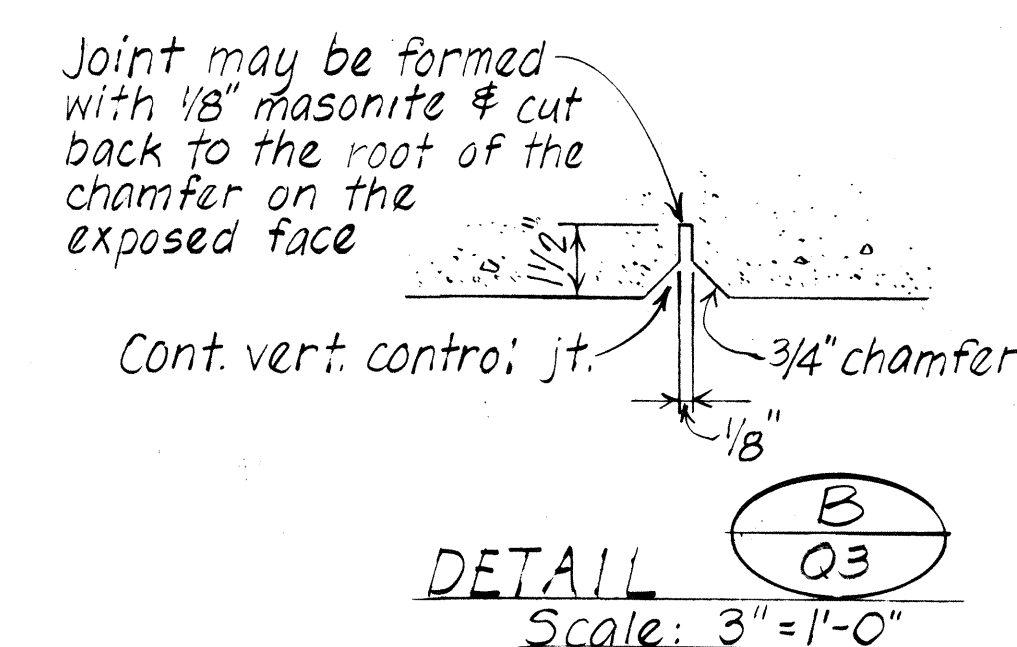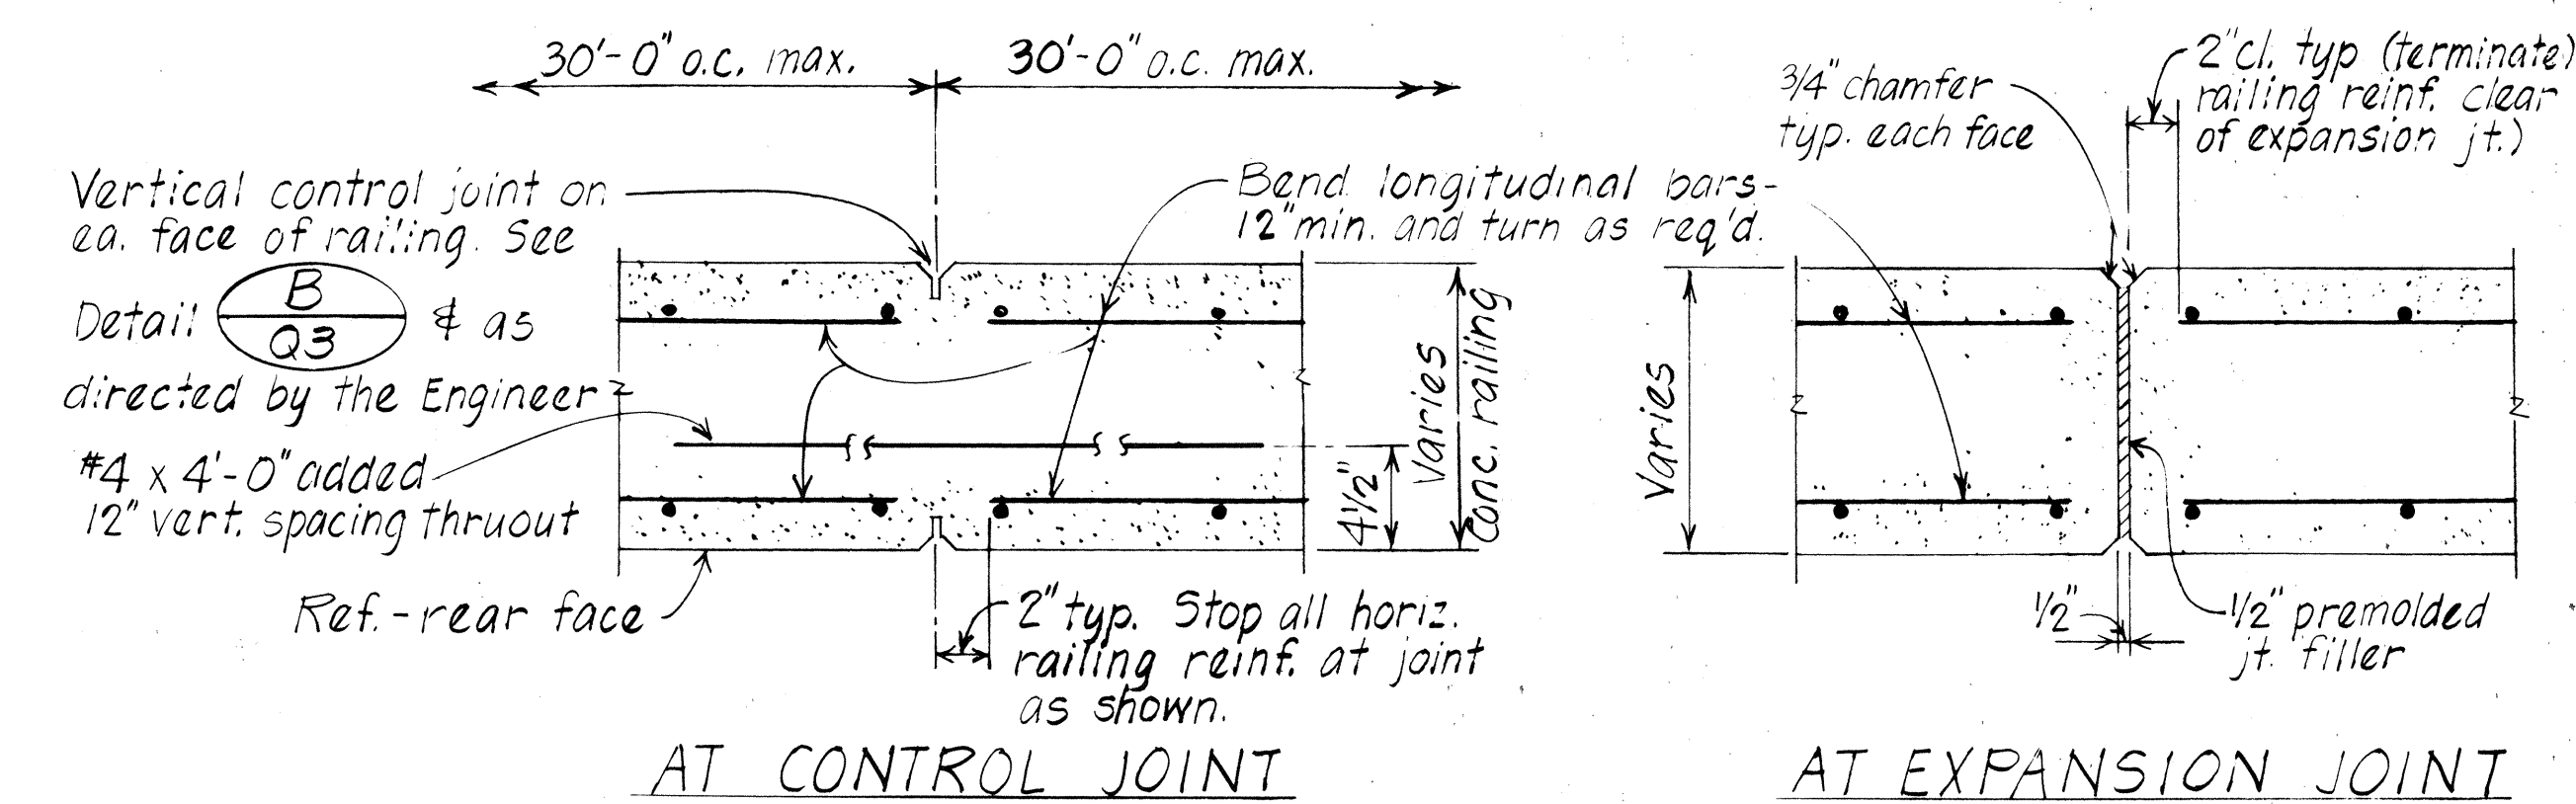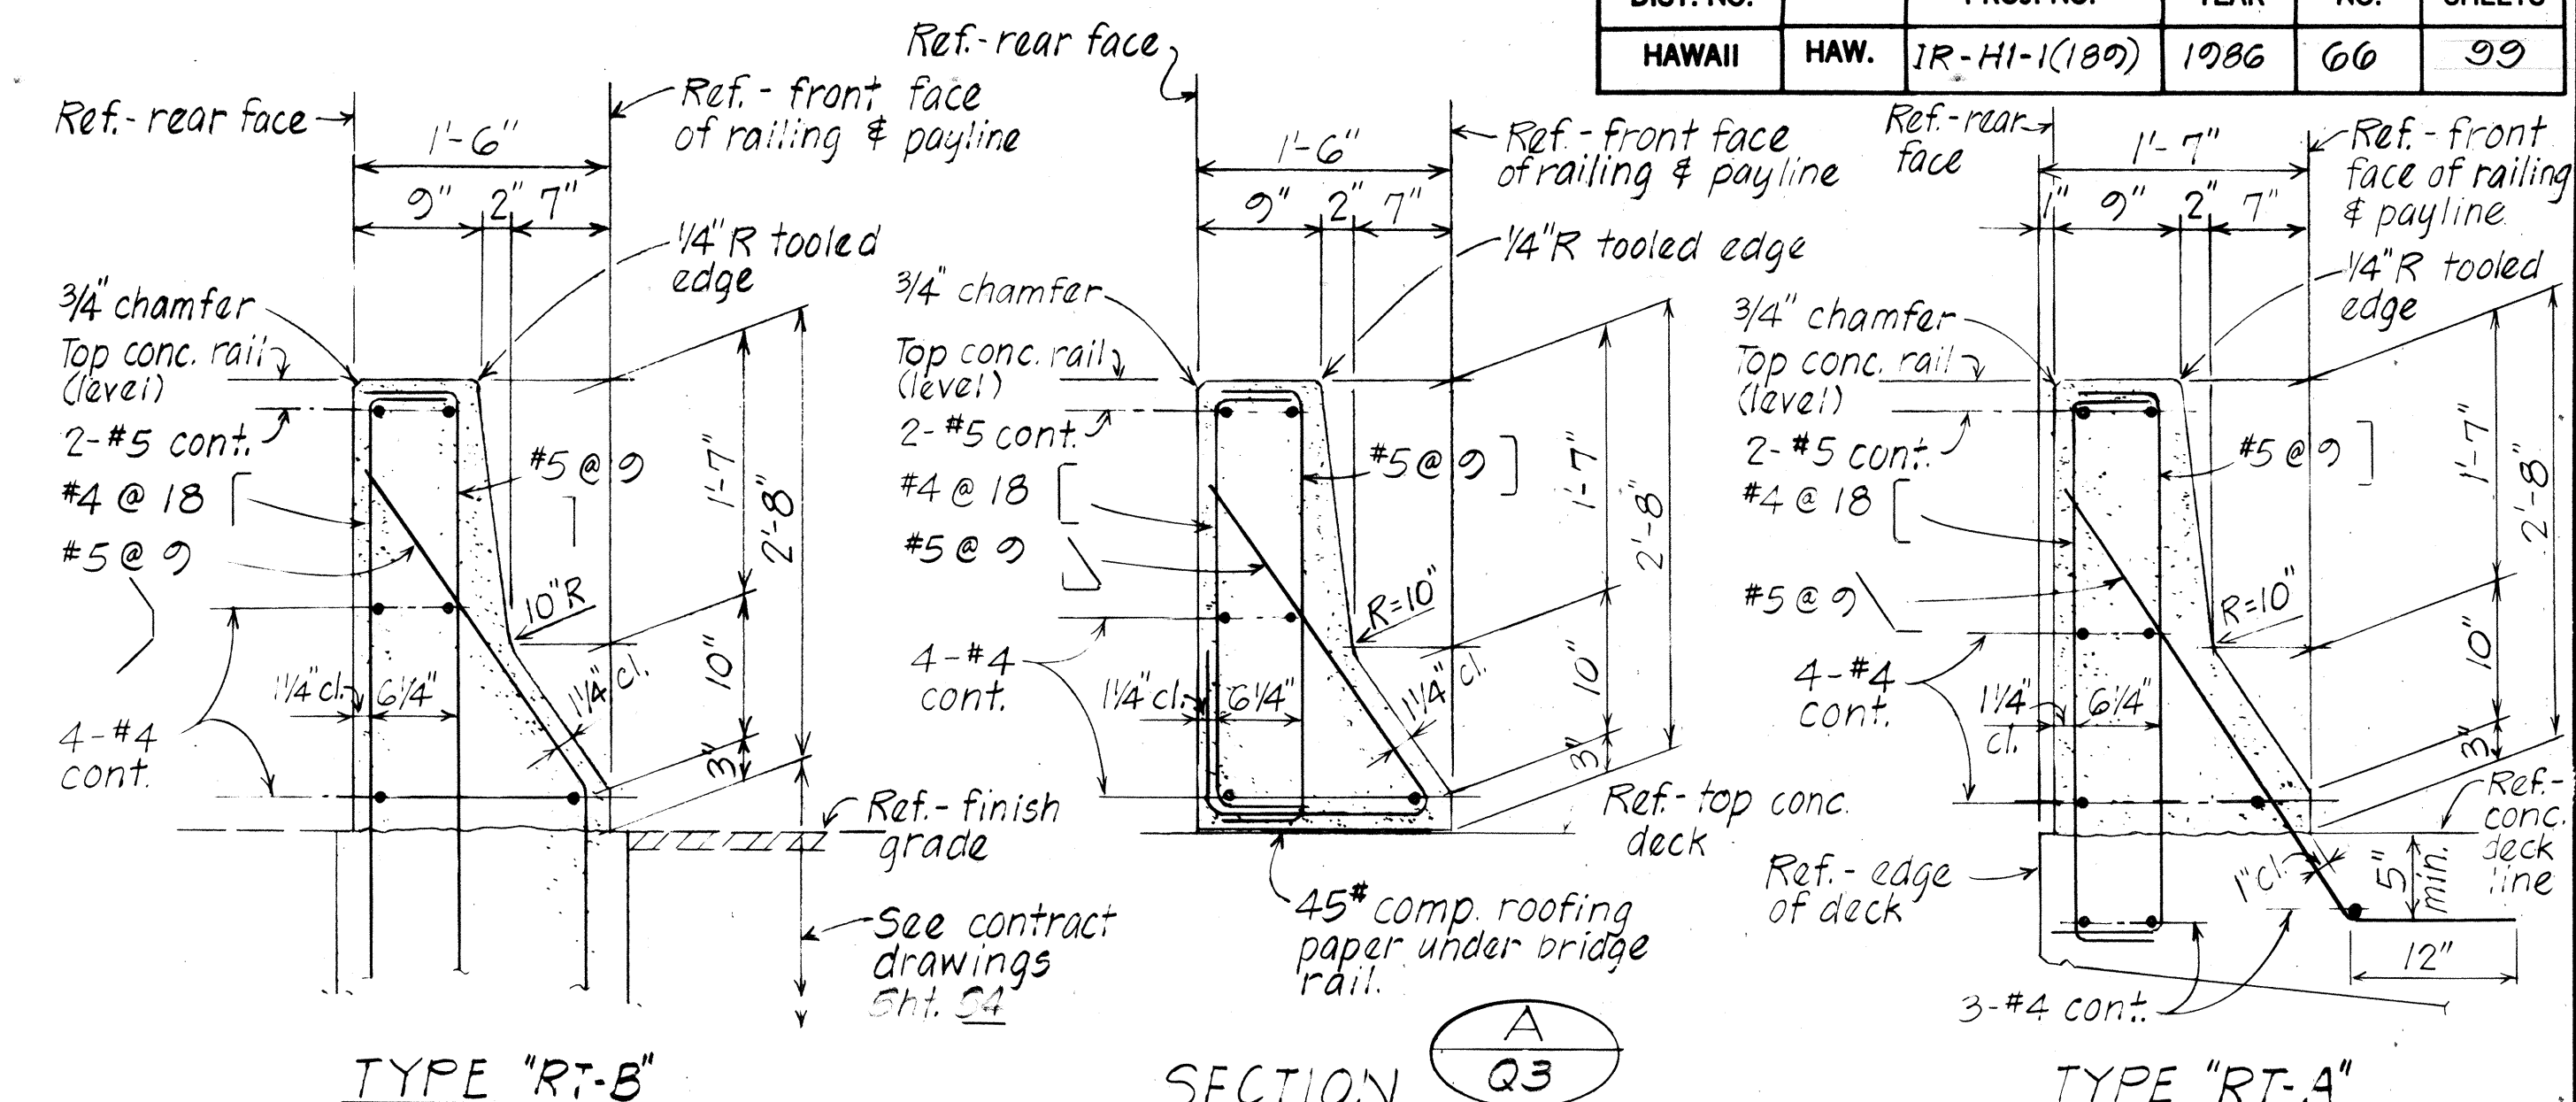


TYPICAL JOINT DETAILS

STATE OF HAWAII
DEPARTMENT OF TRANSPORTATION
LAND TRANSPORTATION FACILITIES DIVISION
TYPICAL DETAILS
CONCRETE BRIDGE RAILING
BARRIER TYPE


F.A.I. PROJ. NO. IR-HI-1(189)
Scale: As Shown Date:
SHEET No. 03 OF 5 SHEETS

**Dimensions as detailed except as otherwise noted on detail drawings.


CURVE DATA
 $\Delta = 40^{\circ} 06' 25''$
 $R = 10'-0''$
 $LC = 7'-0''$

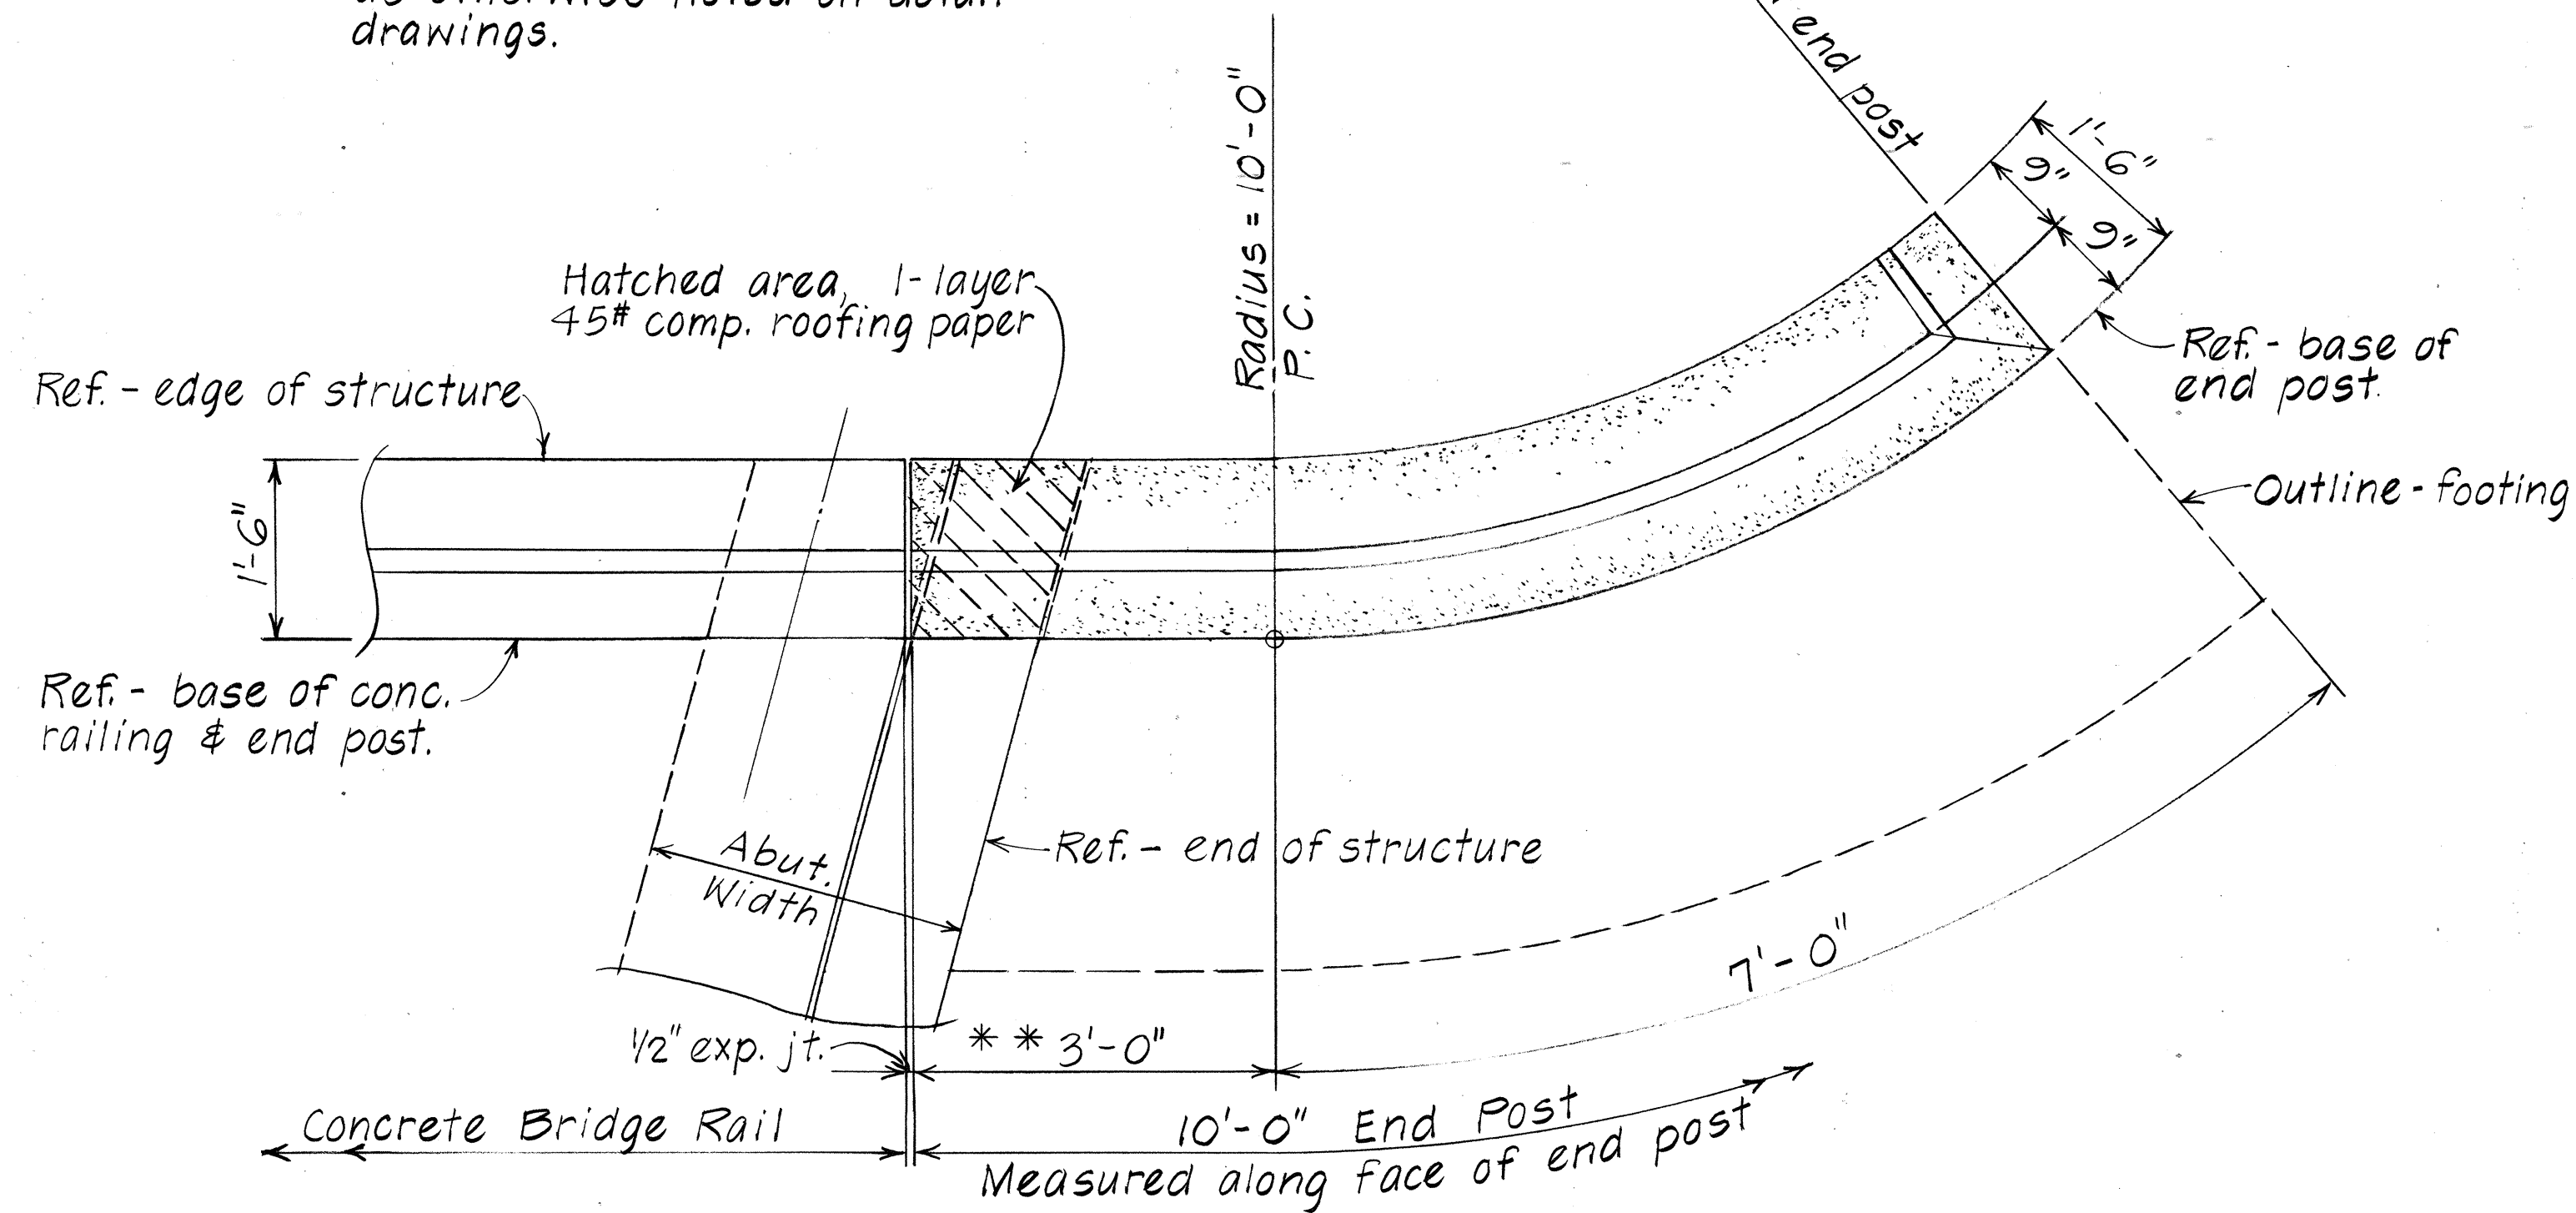

PLAN
 Scale: $\frac{3}{4}" = 1'-0"$

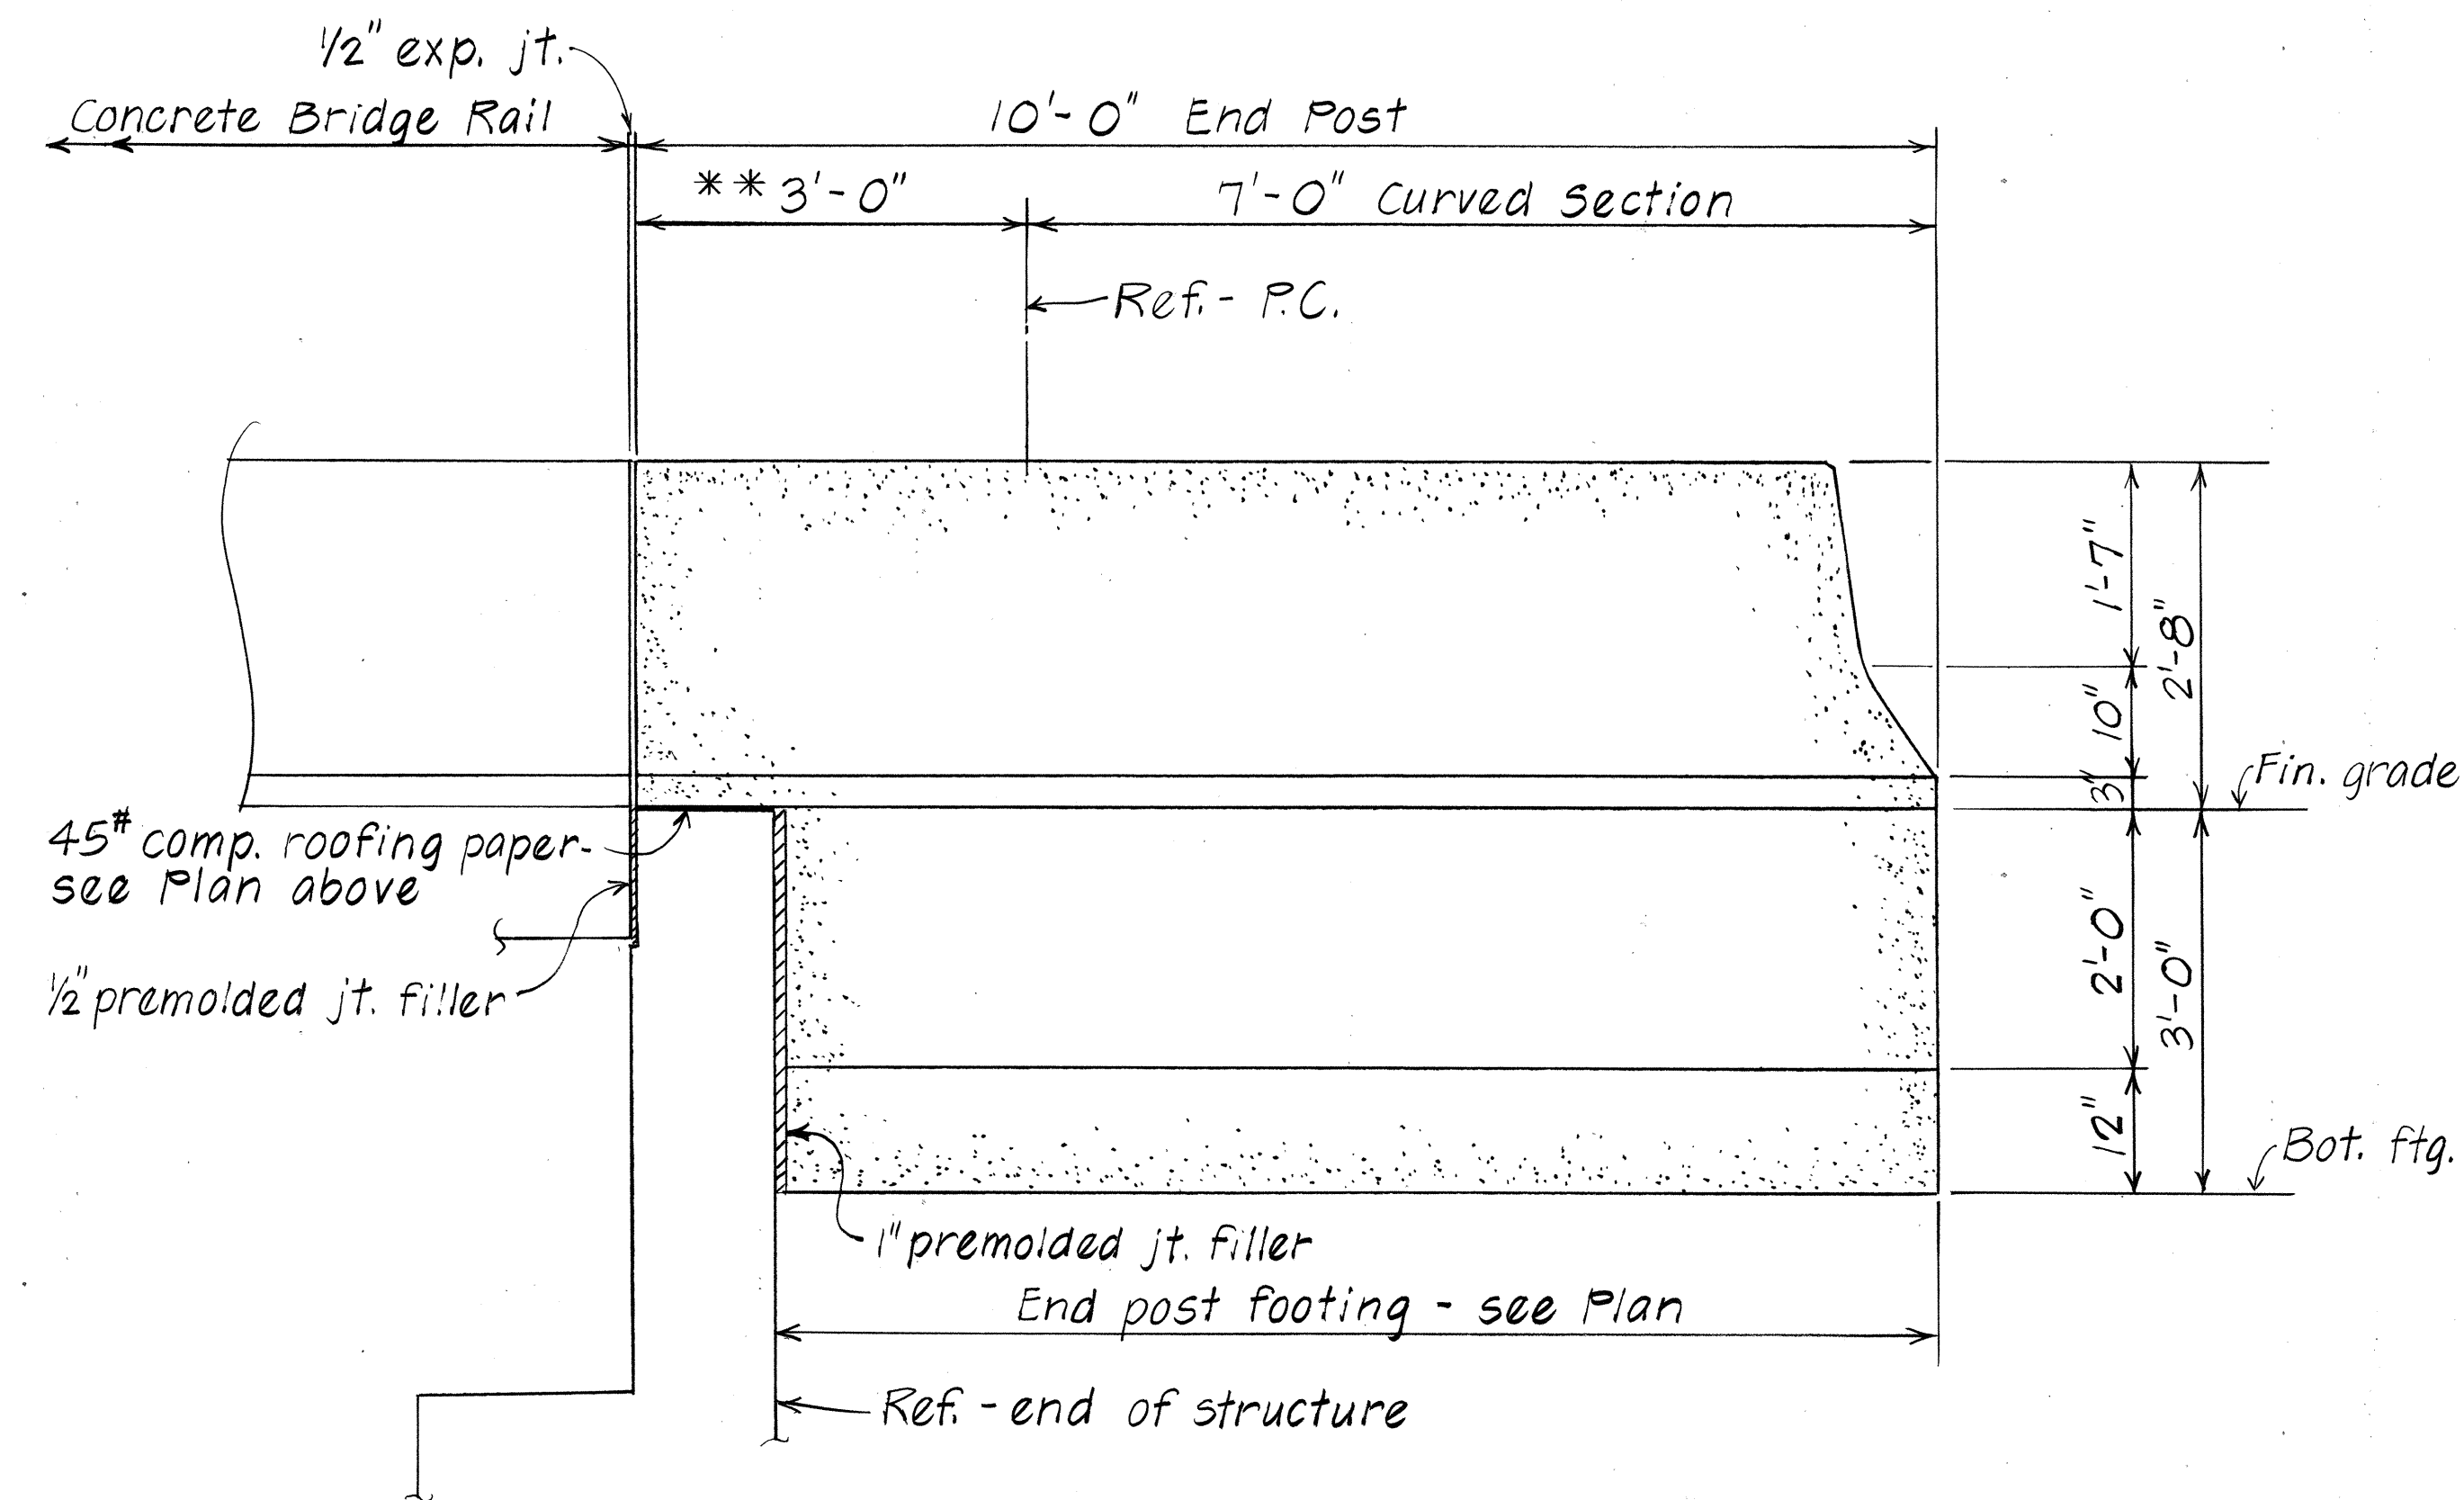

ELEVATION
 Scale: $\frac{3}{4}" = 1'-0"$

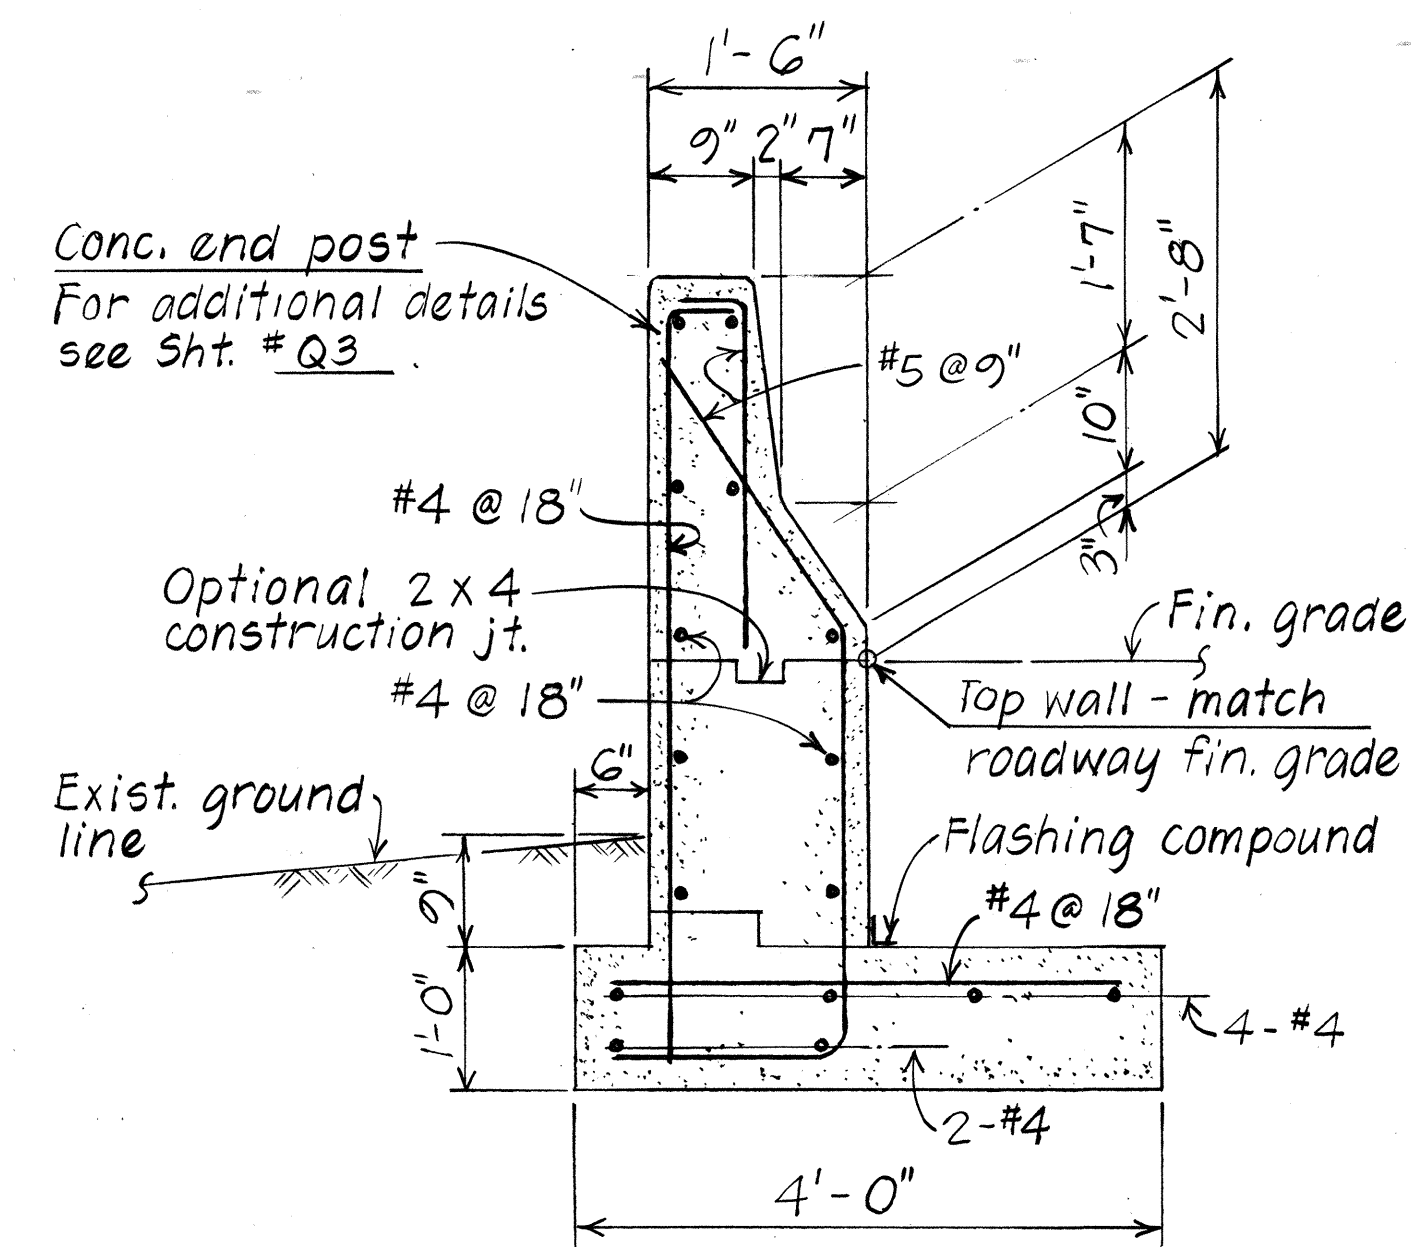


TYPICAL SECTION

TYPICAL END POST DETAILS
 Scale: $\frac{3}{4}" = 1'-0"$

NOTE - Hatched Area:

1. Hatched area shown thus denotes limits of structure excavation pay line. All other excavation shall be roadway excavation.
2. Hatched area shown thus denotes limits of structure backfill (or ordinary backfill).

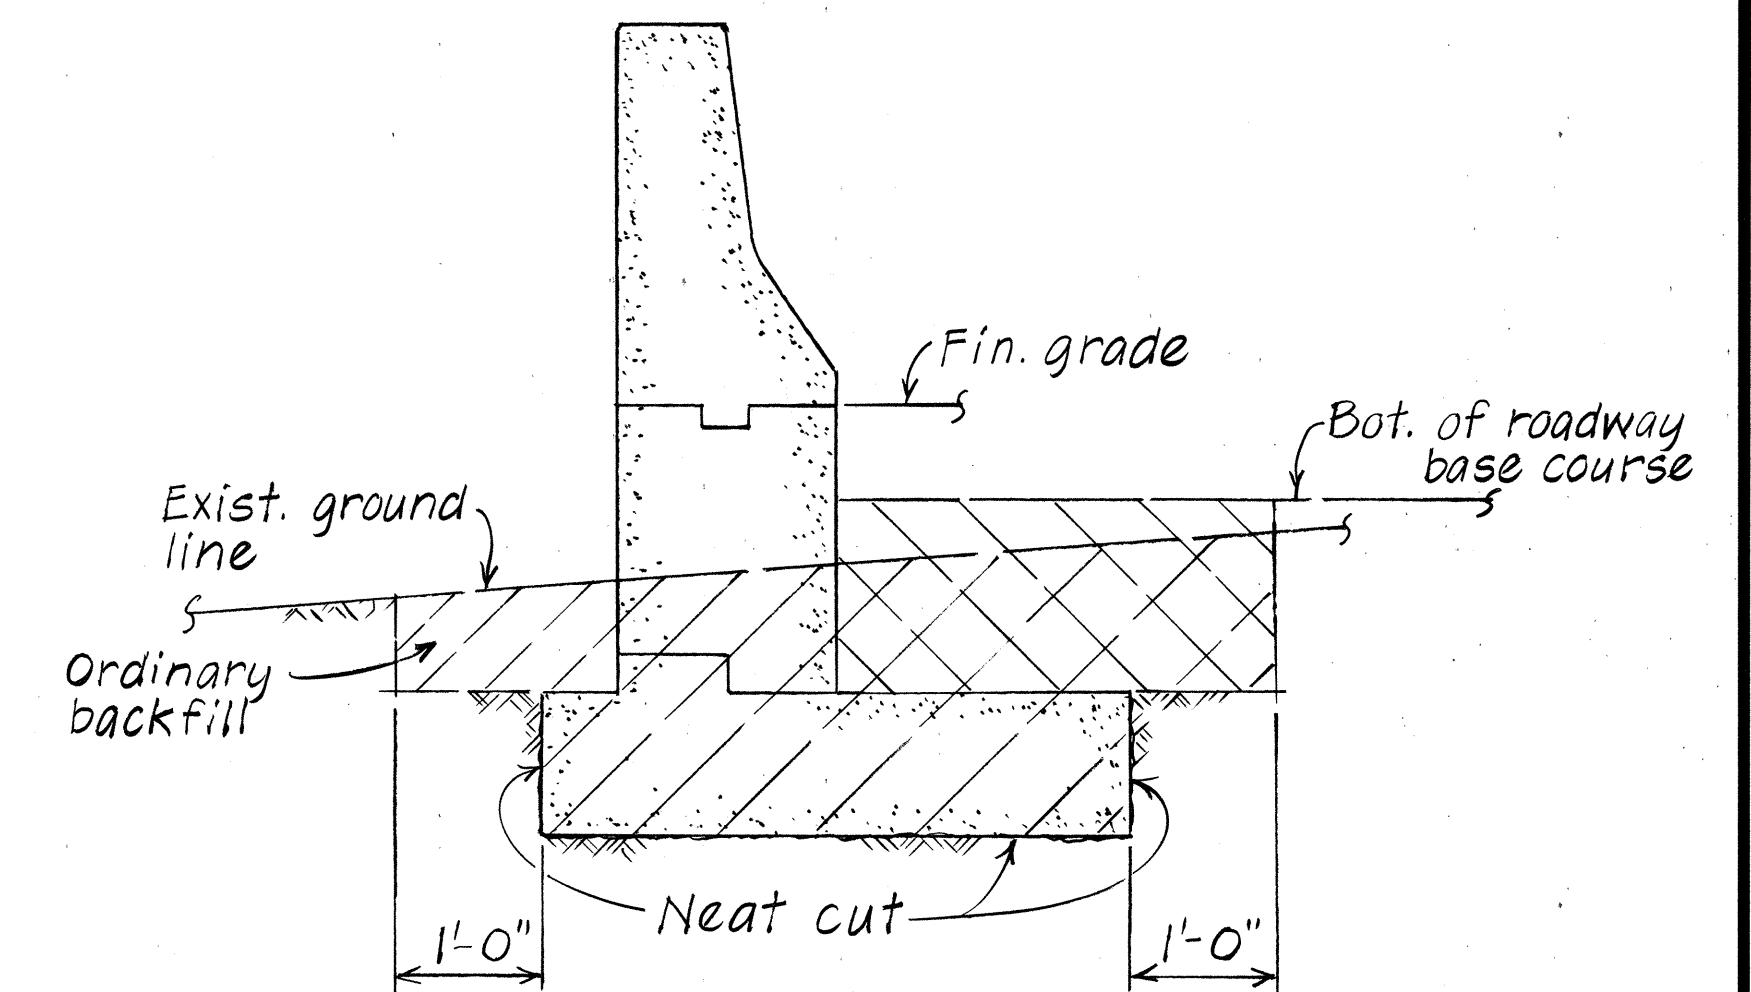

TYPICAL STRUCTURE EXCAVATION & BACKFILL PAY LIMITS DETAIL

FED. ROAD DIST. NO.	STATE	FED. AID PROJ. NO.	FISCAL YEAR	SHEET NO.	TOTAL SHEETS
HAWAII	HAW.	IR-HI-1(189)	1986	67	99


STATE OF HAWAII
 DEPARTMENT OF TRANSPORTATION
 HIGHWAYS DIVISION
TYPICAL DETAILS
CONCRETE END POST

F.A.I. PROJ. NO. IR-HI-1(189)


Scale: As Shown Date: July 1985

SHEET No. 04 OF 5 SHEETS


FED. ROAD DIST. NO.	STATE	FED. AID PROJ. NO.	FISCAL YEAR	SHEET NO.	TOTAL SHEETS
HAWAII	HAW.	12-HI-1(189)	1986	68	99

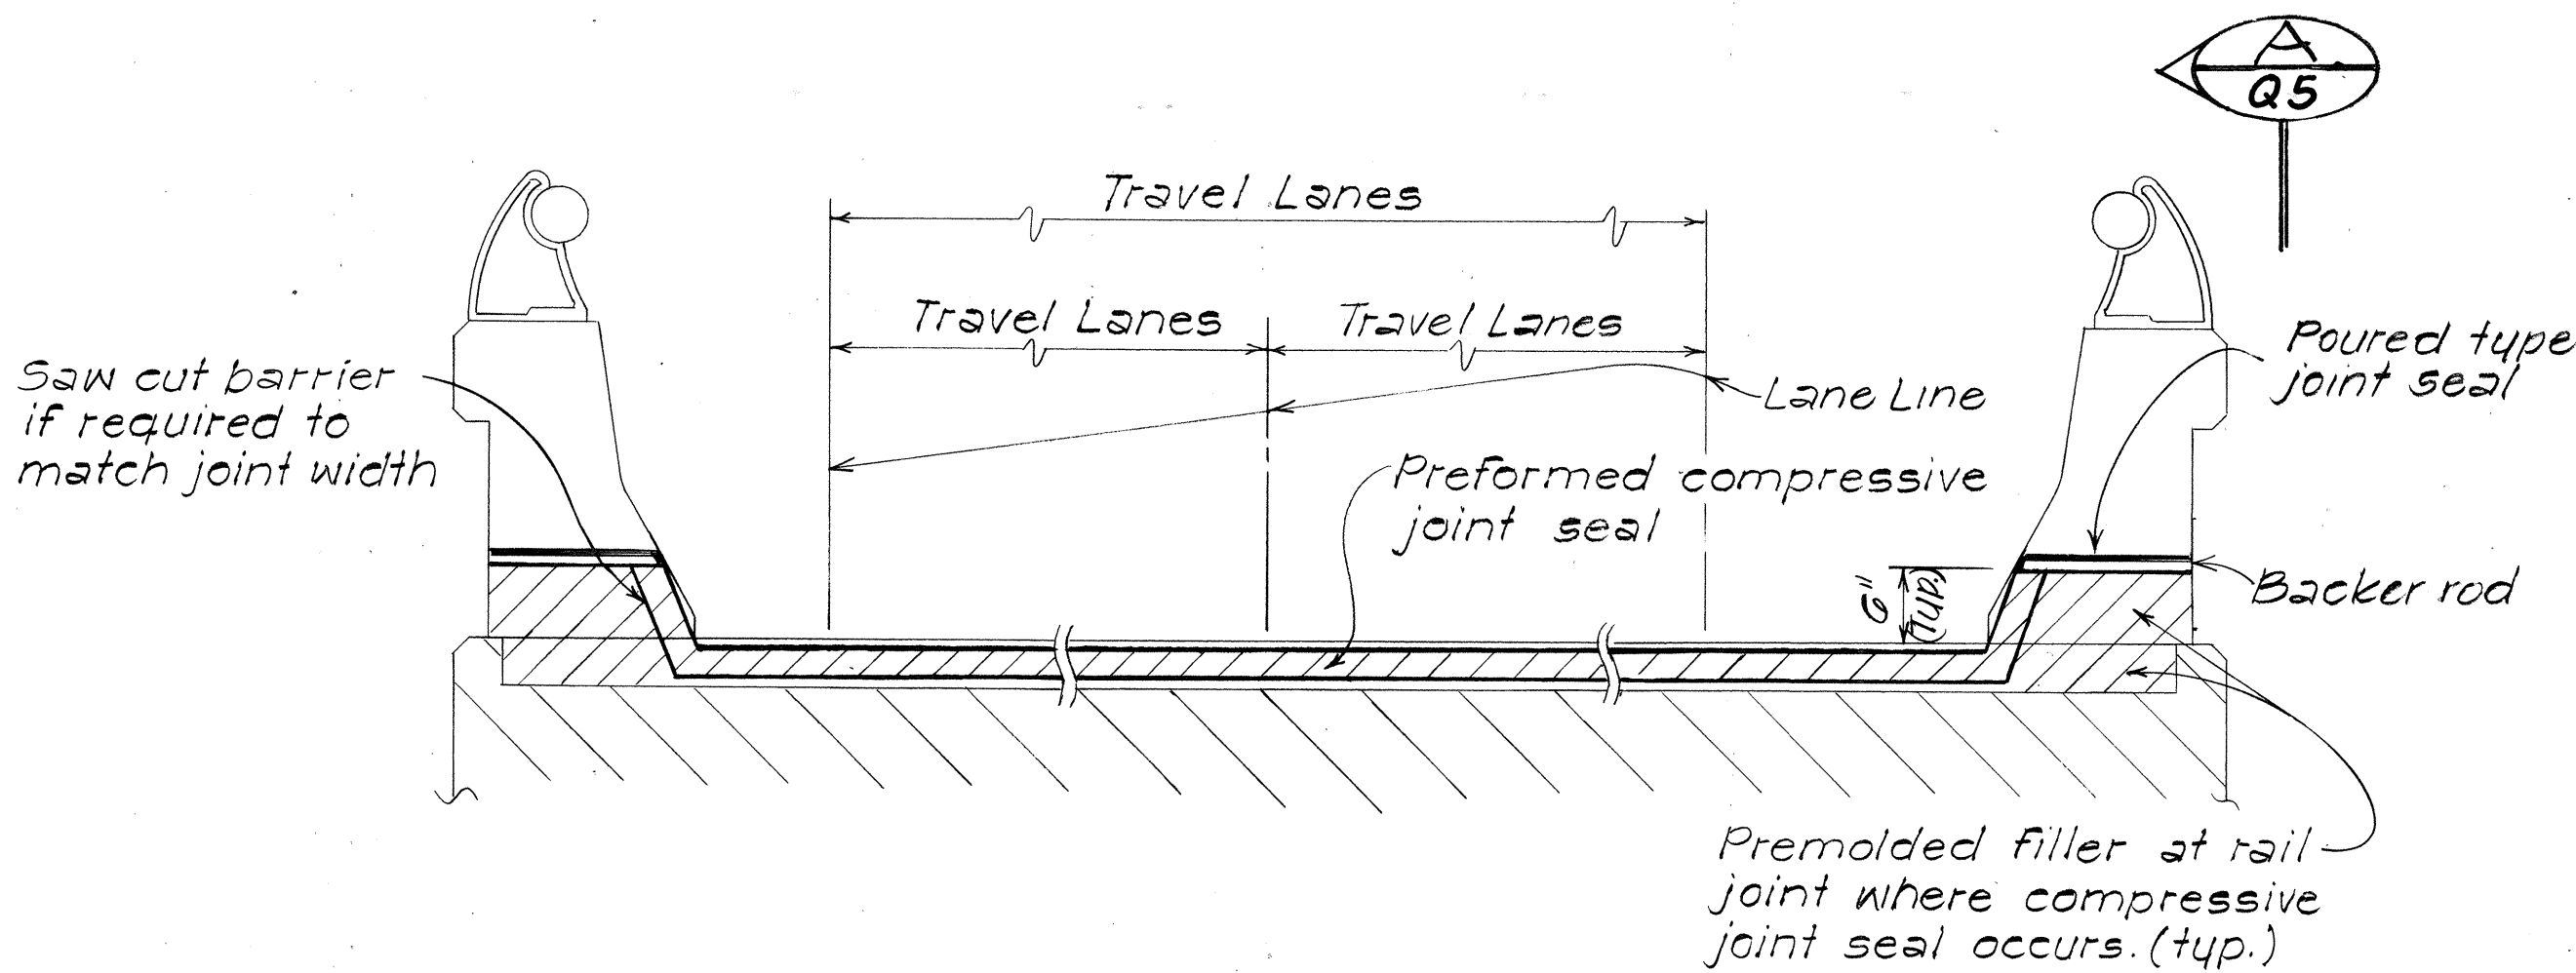


TYPICAL SECTION AT JOINT SEAL
Scale: 3/4" = 1'-0"

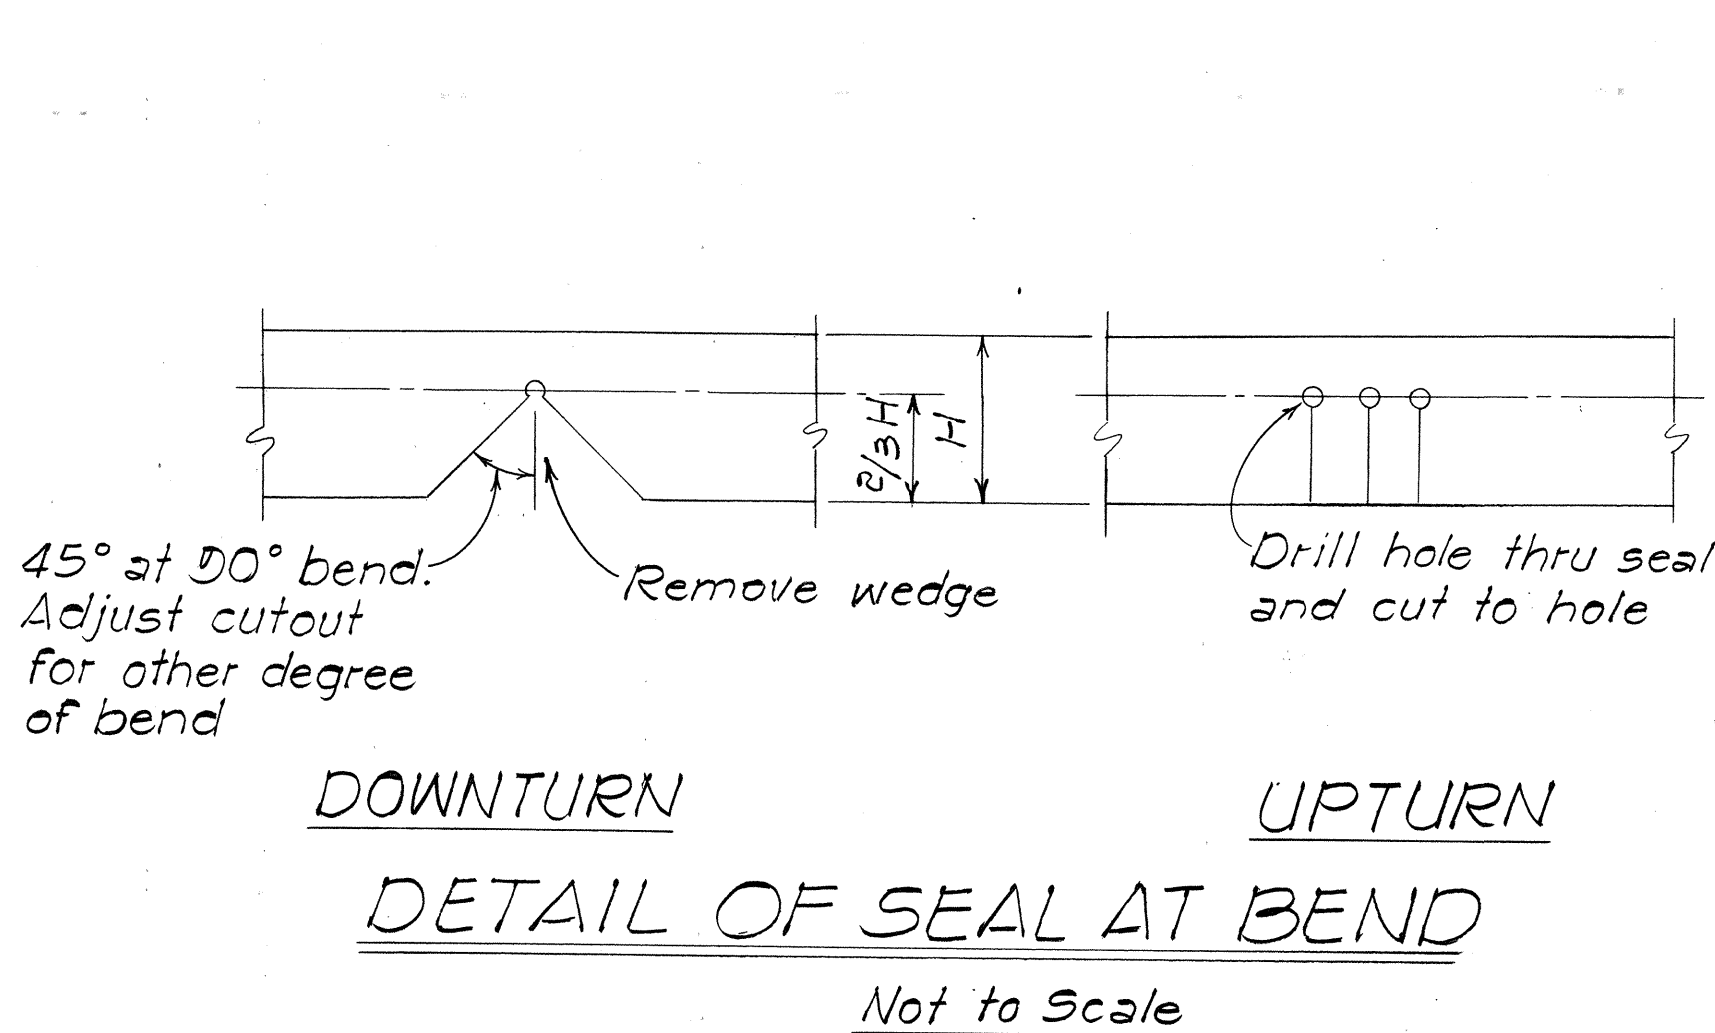


- NOTES:
1. Maintenance of Traffic and Traffic Control - See Subsection 104.04 of the Standard Specifications and Section 645 of the Special Provisions.
 2. Saw cutting of concrete & the poured type joint seal shall be incidental to the preformed joint seal & will not be paid for

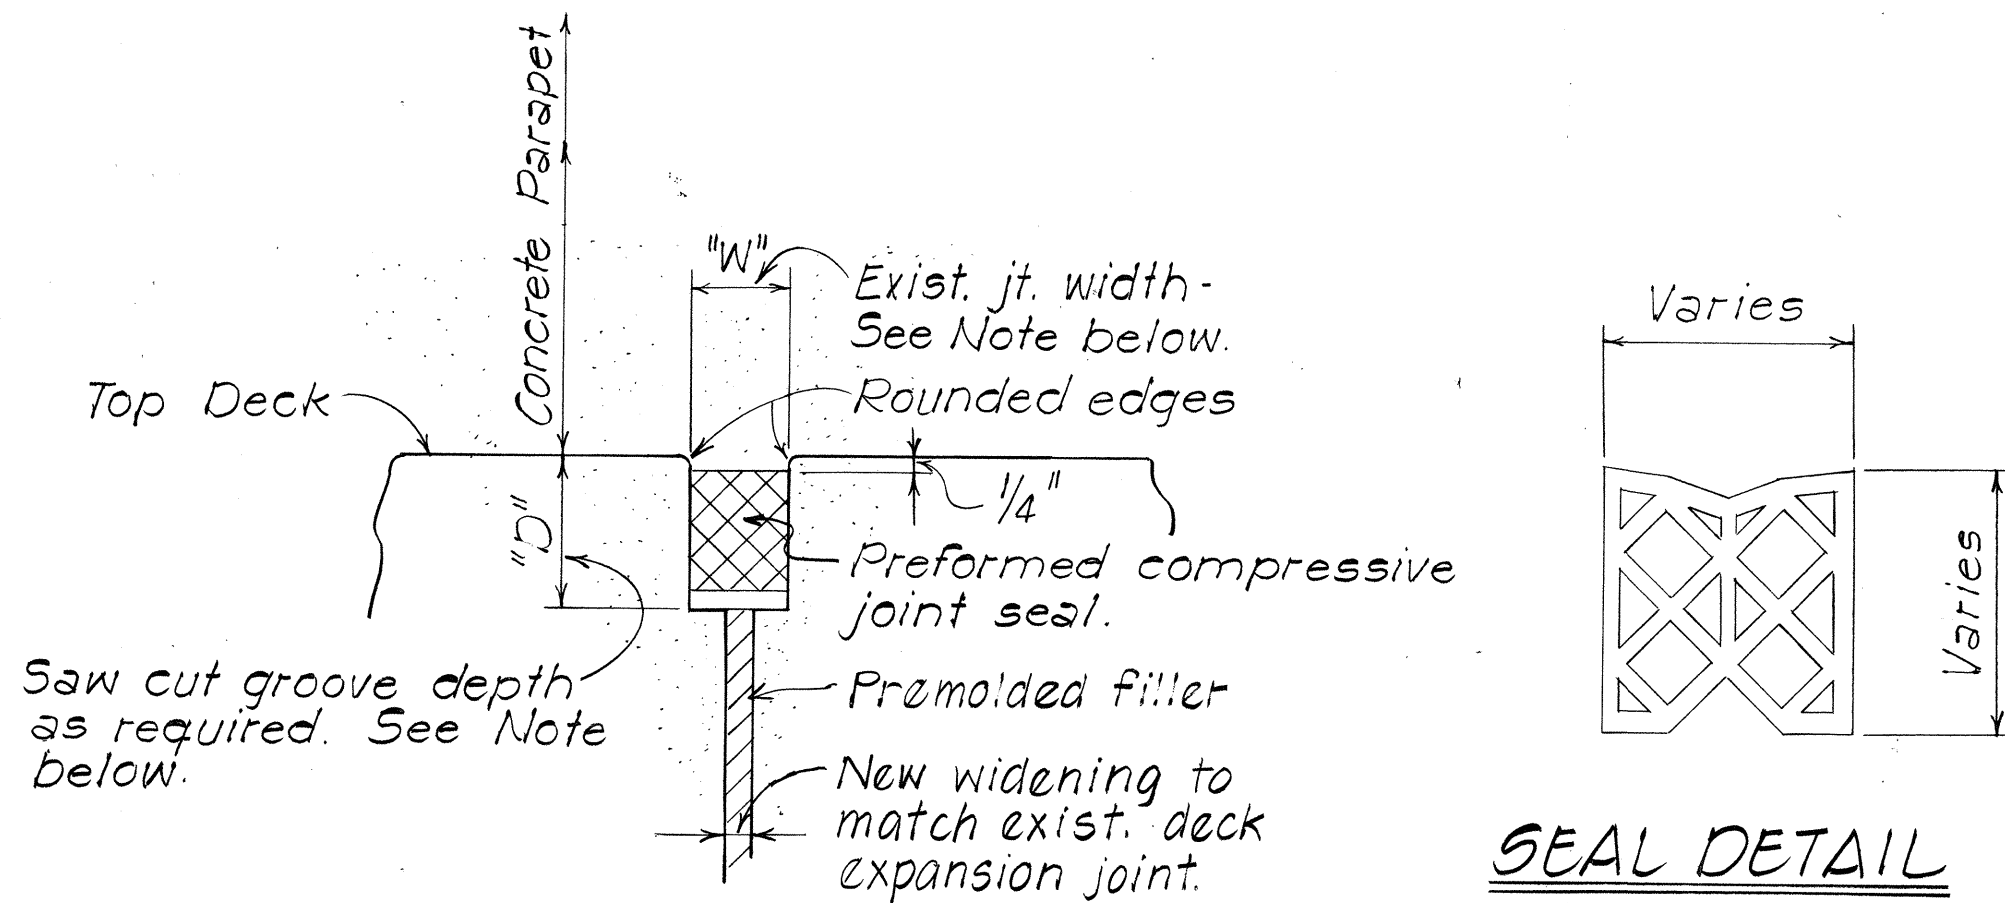


HONOULIULI STREAM BRIDGE

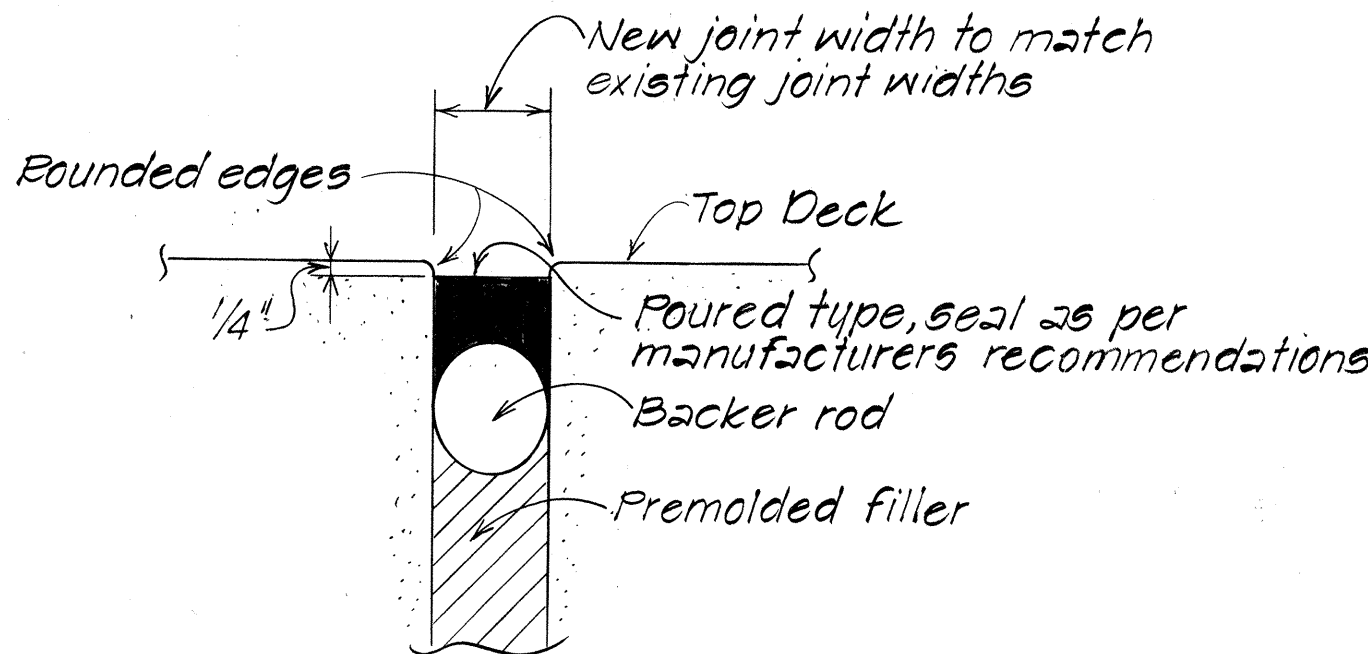

PALEHUA SEPARATION

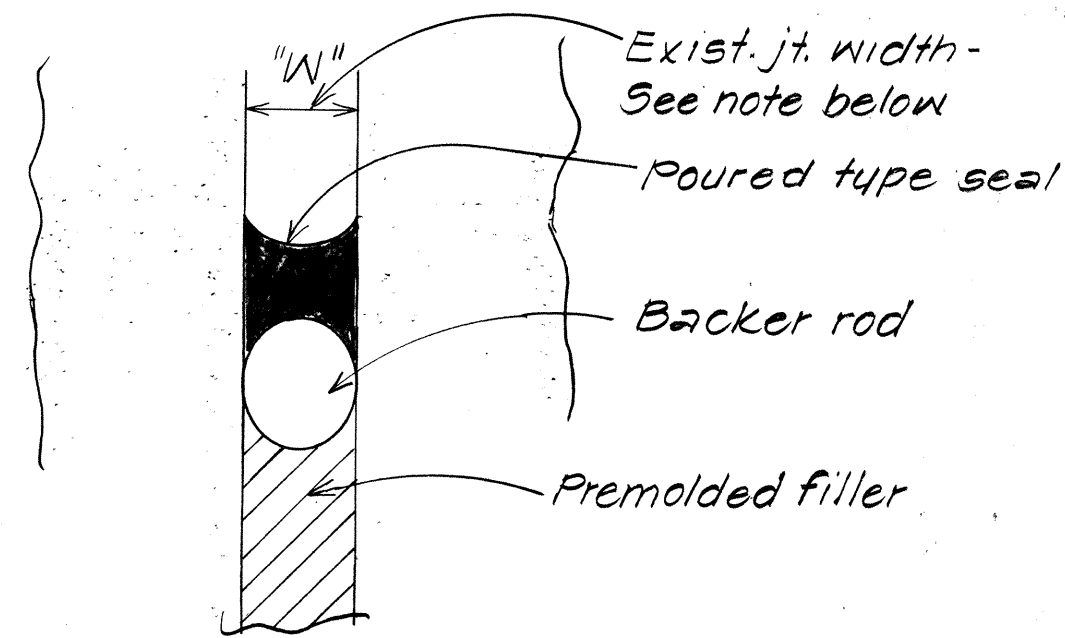

SECTION A Q5
@ CONCRETE RAIL

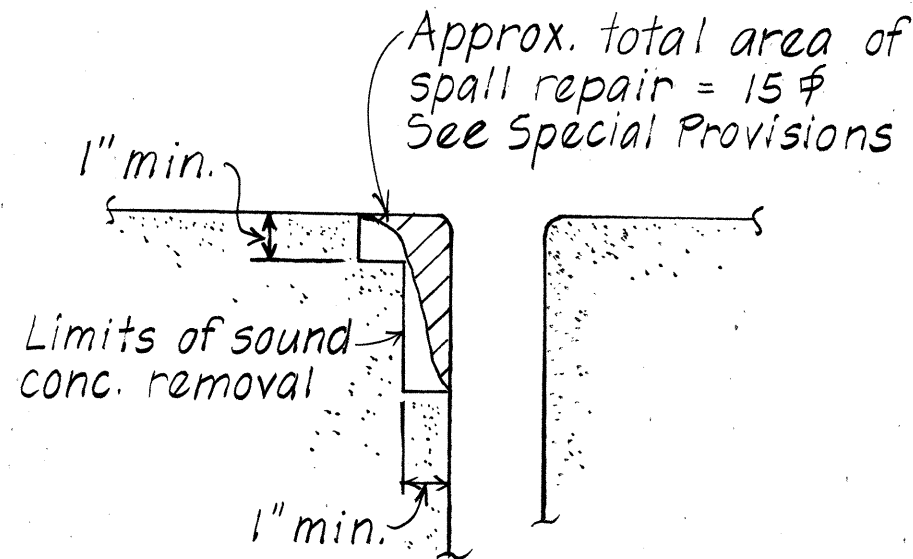

TYPICAL CORNER SPALLS REPAIR AT EXISTING DECK JOINTS
Not to Scale

REPLACEMENT OF EXISTING EXPANSION JOINT SEAL DETAILS

Not to Scale

- NOTE:
- "W" - Existing joint width. This width shall also be the installation width of the new preformed joint seal. The new preformed joint seal size shall be determined by this installation width as recommended by the manufacturer and shall be approved by the Engineer. This width "W" shall be uniform throughout & shall be saw cut, if required, as approved by the Engineer.
- "D" - Groove depth as recommended by the manufacturer. This depth shall be obtained by saw cutting, as required.

SURVEY PLOTTED BY	DATE
DRAWN BY	
DESIGNED BY	
QUANTITIES BY	
CHECKED BY	
ORIGINAL PLAN	
NOTE BOOK	
No.	

STATE OF HAWAII
DEPARTMENT OF TRANSPORTATION
HIGHWAYS DIVISION

TYPICAL DETAILS


REPLACEMENT OF BRIDGE DECK JOINT SEALS, GENERAL NOTES & SEAL DETAILS

F.A.I. PROJ. NO. IR-HI-1(189)


Scale: As Noted Date: July 1985

SHEET No. Q5 OF 5 SHEETS


FED. ROAD DIST. NO.	STATE	FED. AID PROJ. NO.	FISCAL YEAR	SHEET NO.	TOTAL SHEETS
HAWAII	HAW.	1E-H1-1(180)	1986	69	99

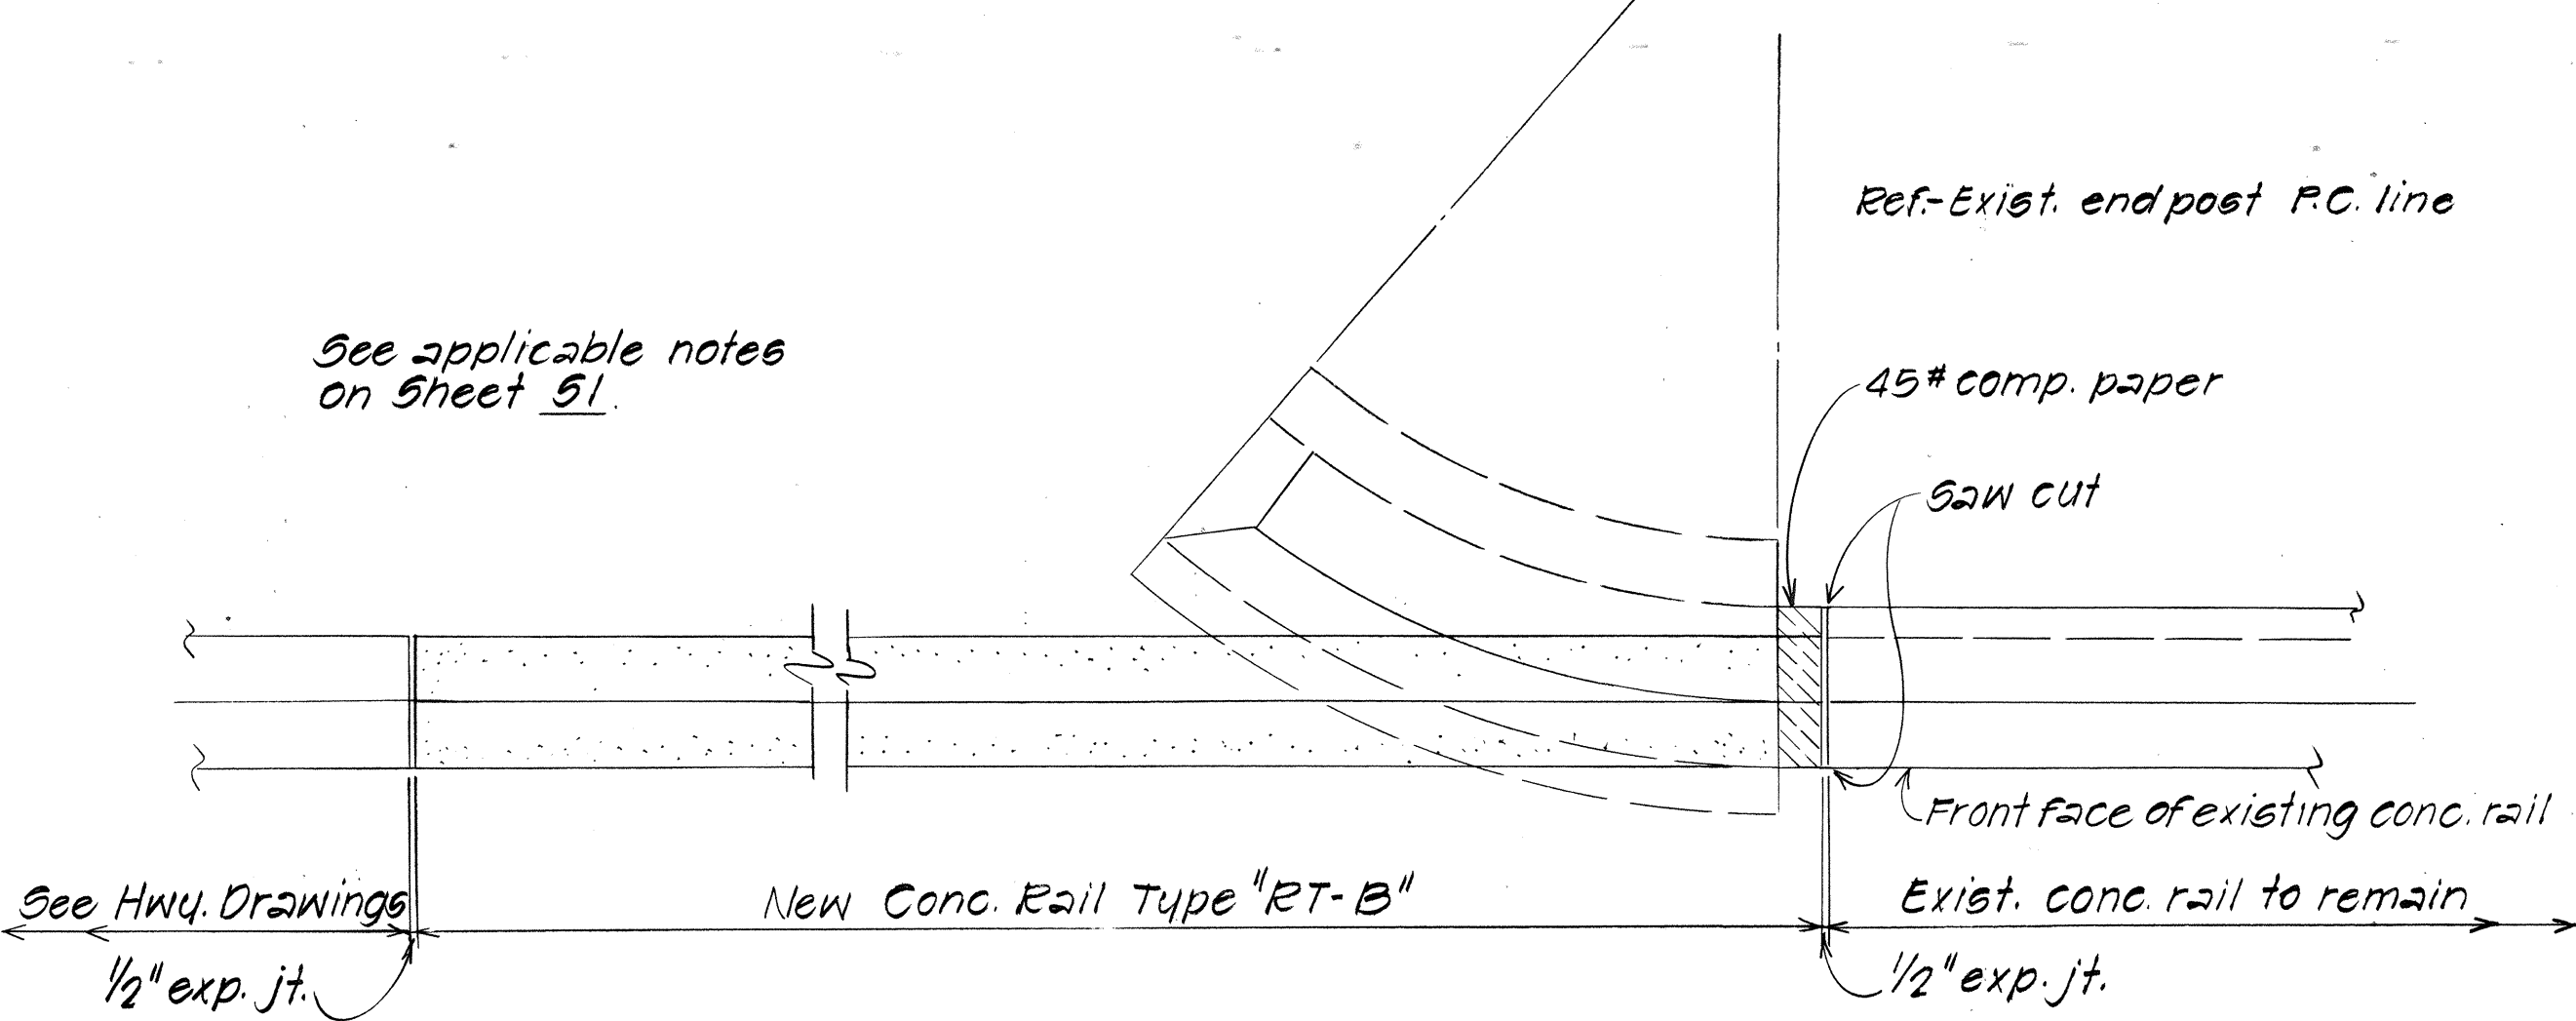


TYPICAL PART PLAN OF EXISTING & NEW CONCRETE RAILING FOR KUNIA SEPARATION Scale: 1/2"=1'-0"

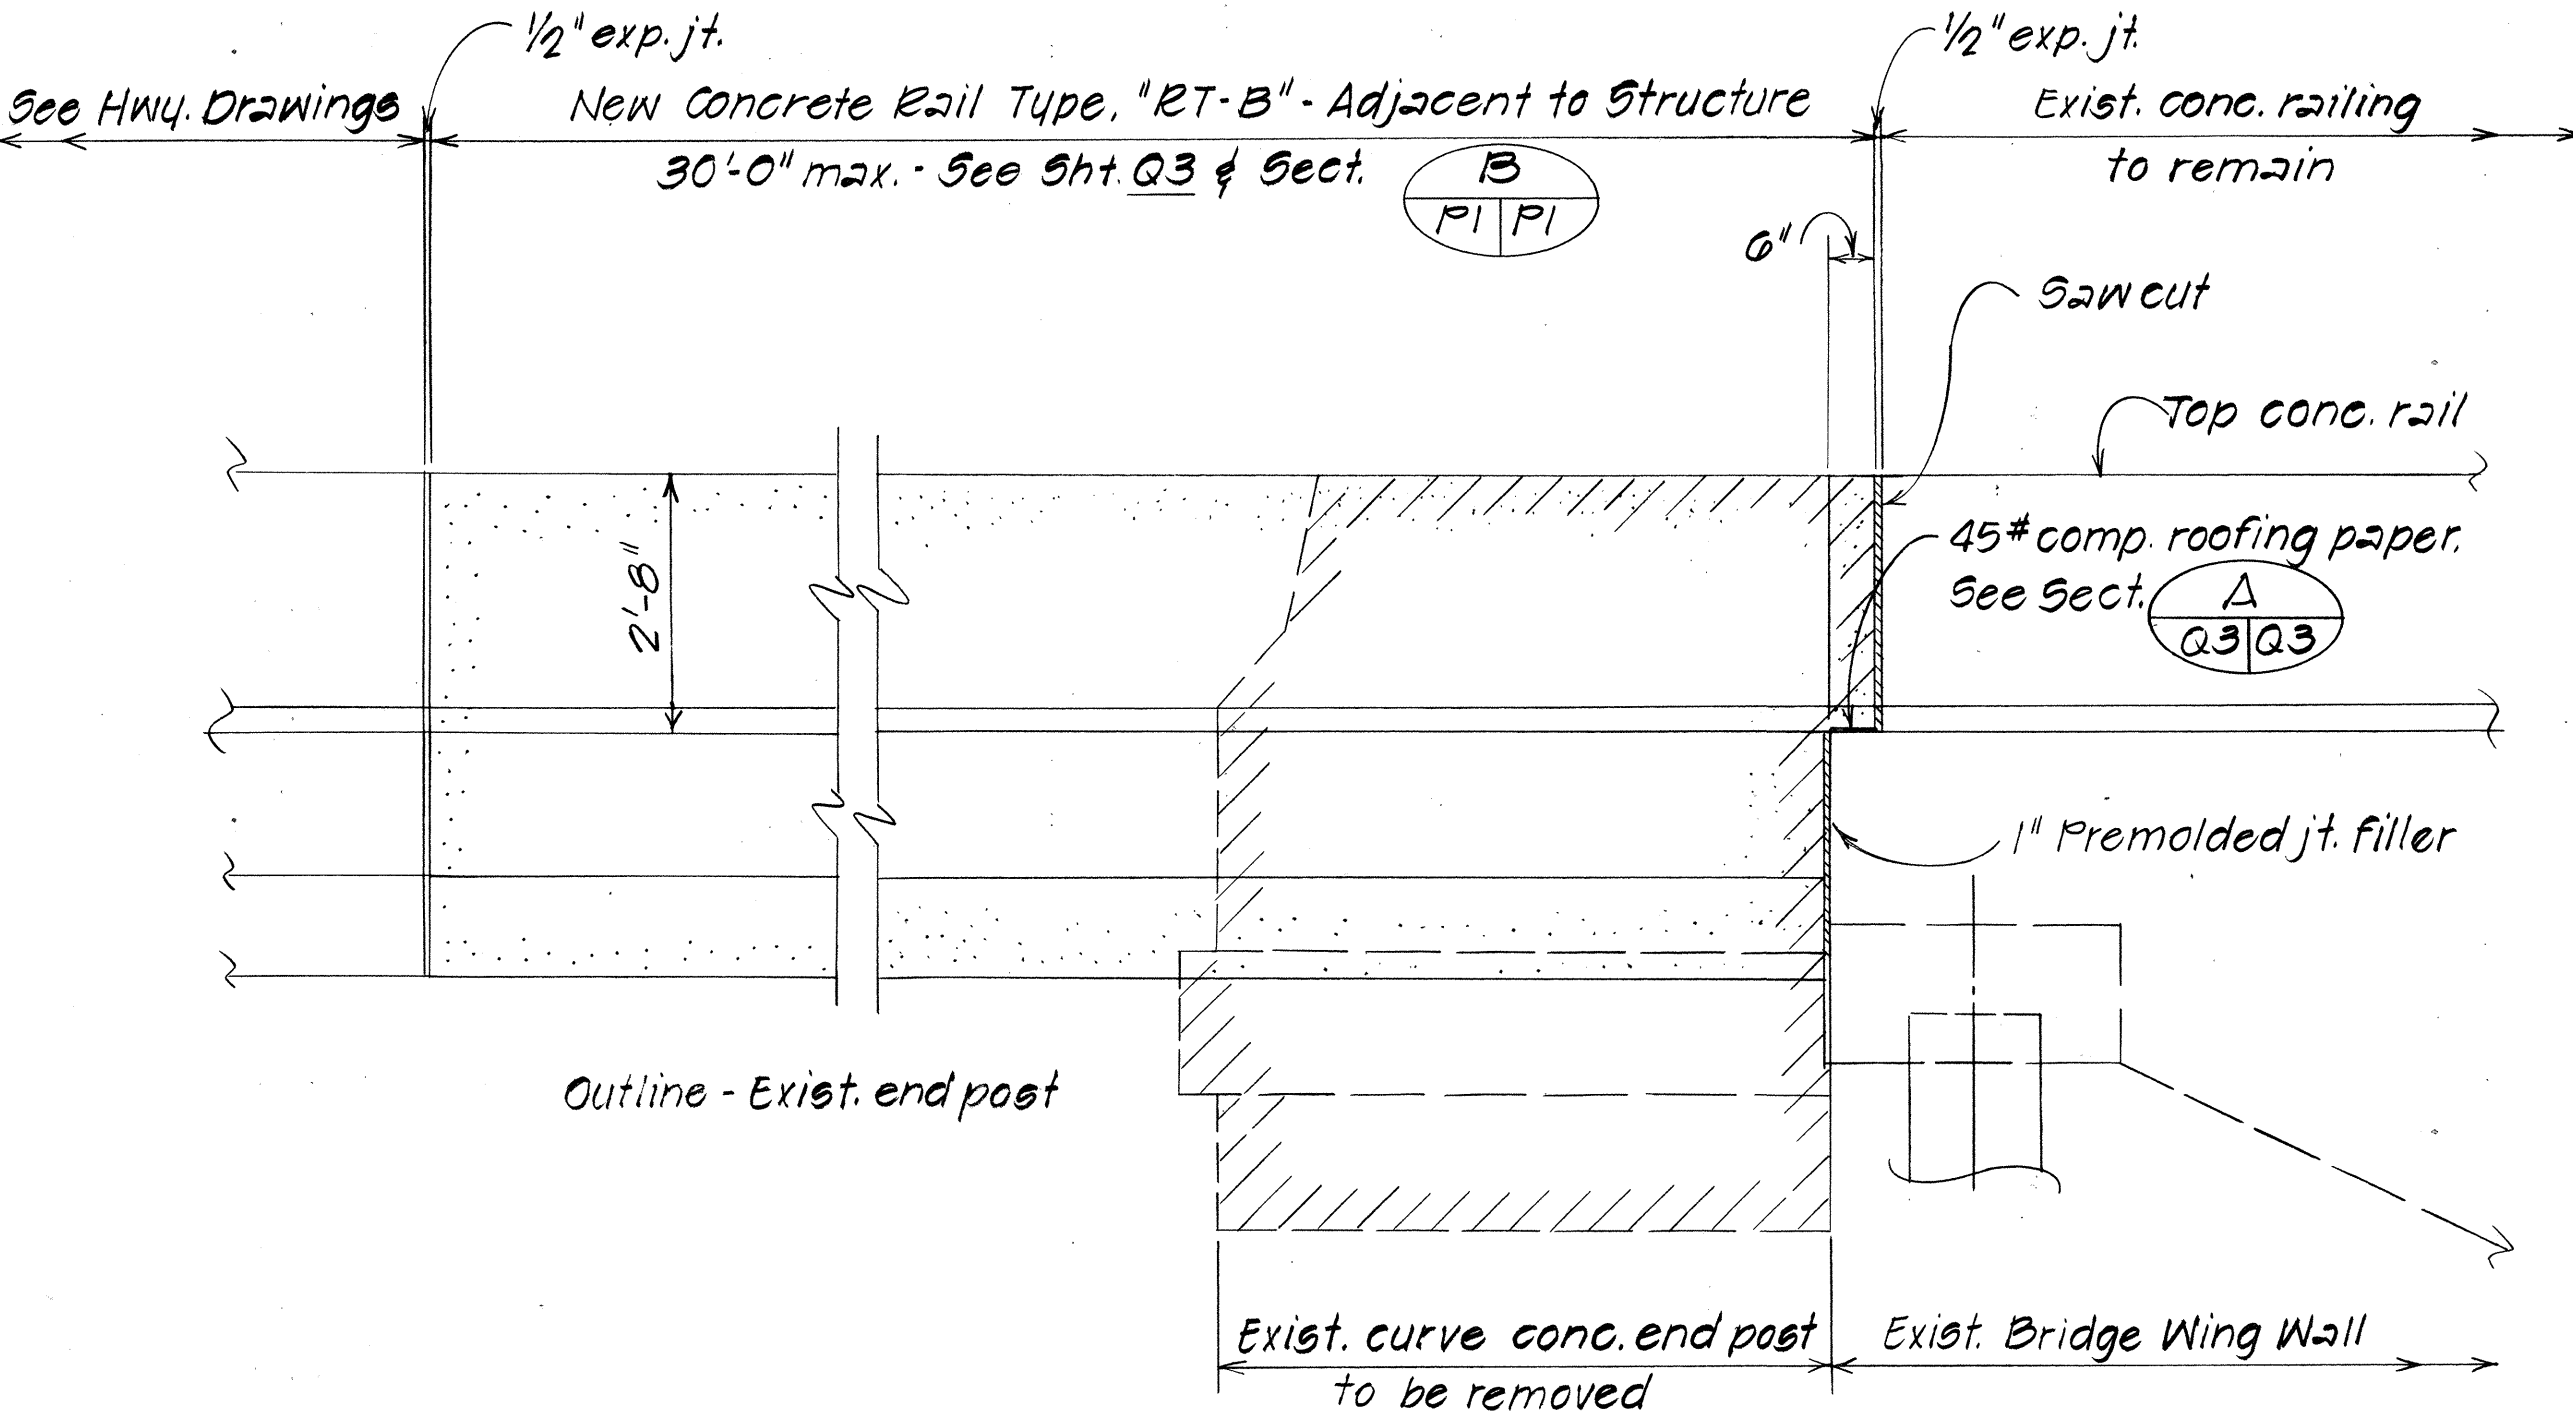

RAILING ELEVATION Scale: 1/2"=1'-0"

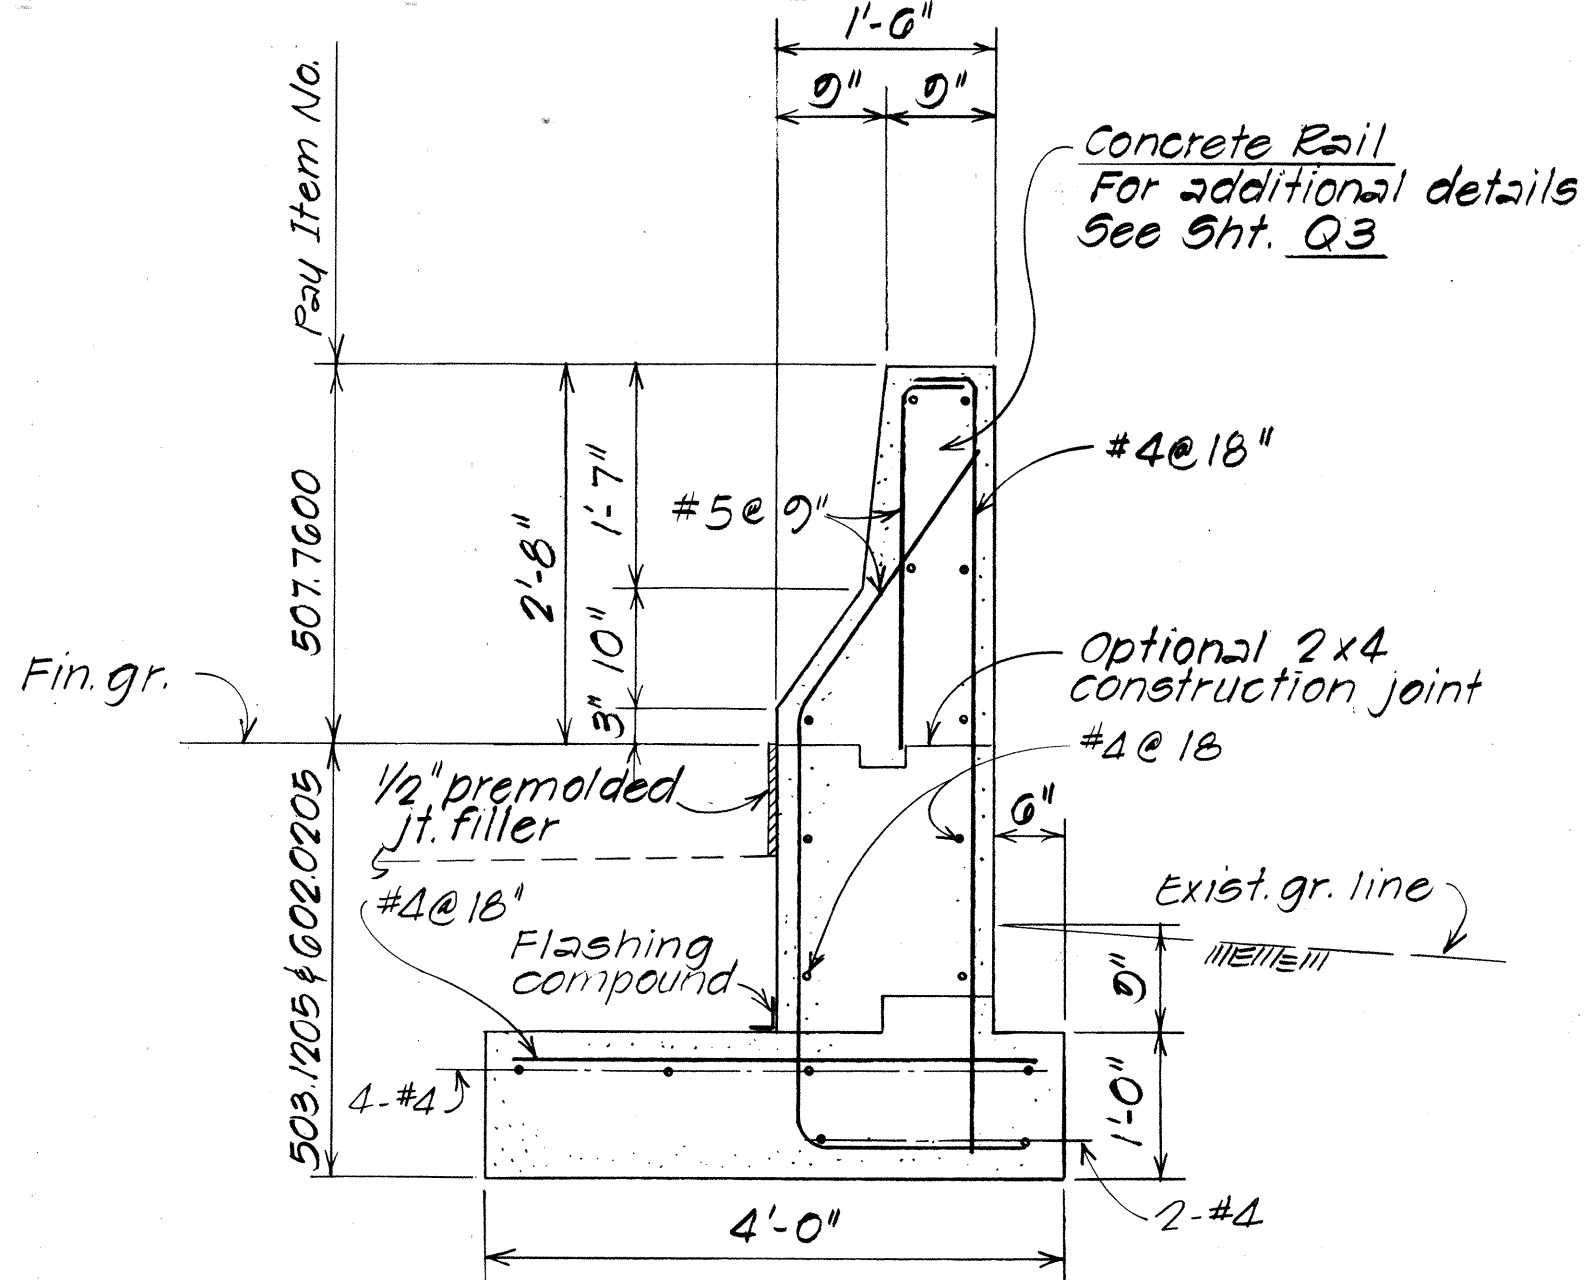


TYPICAL SECTION Scale: 3/4"=1'-0"

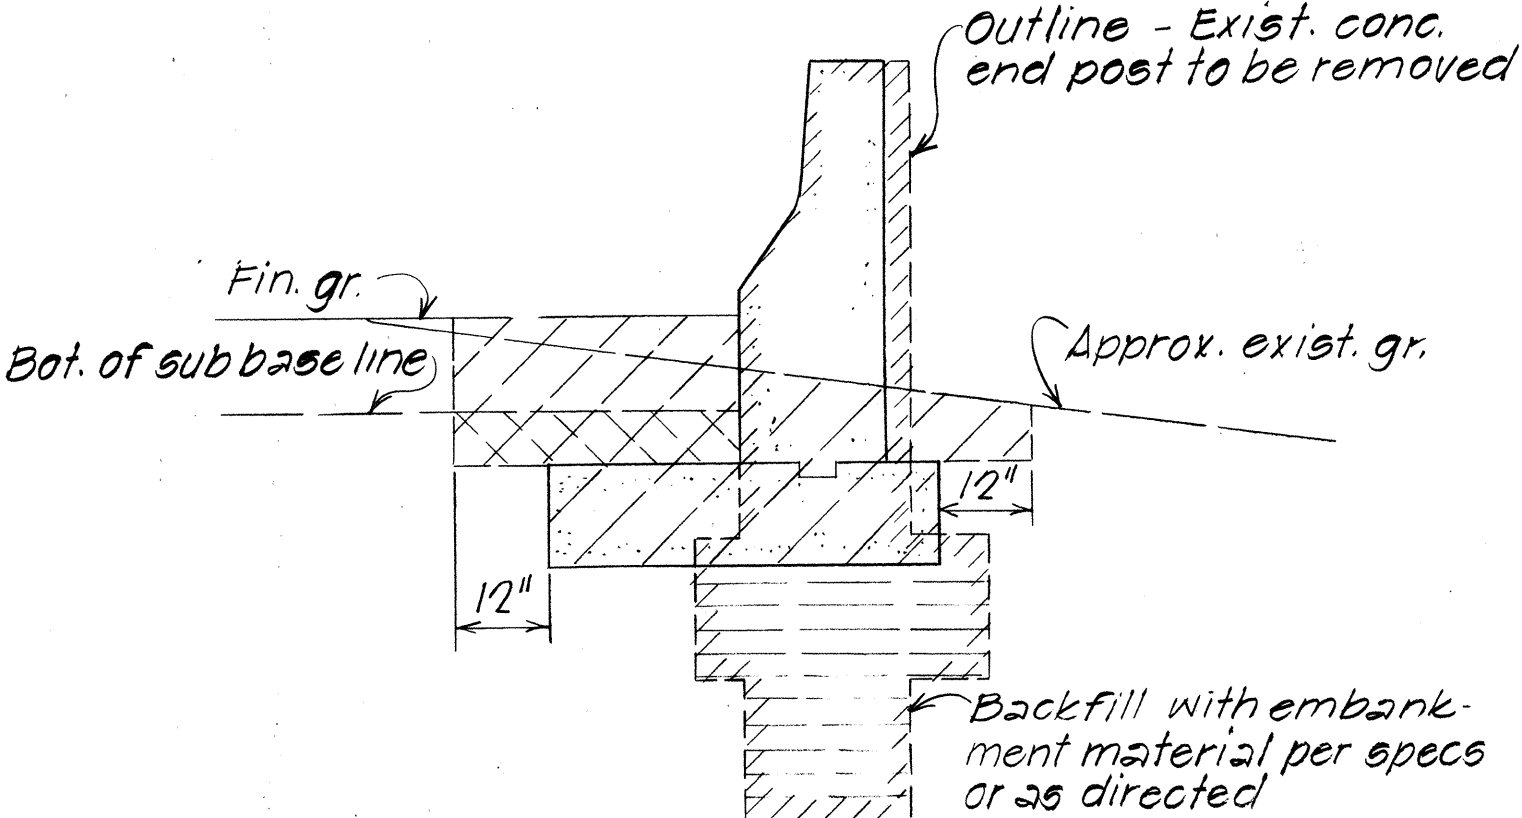

NOTE:
1. Hatched area shown thus // denotes limits of structure excavation payline all other excavation shall be roadway excavation.
2. Hatched area shown thus \\\ denotes limits of structure backfill. Backfill shall be paid under Item 206.6103

TYPICAL END POST EXCAVATION PAYLINE & BACKFILL Scale: 1/2"=1'-0"

ESTIMATED QUANTITIES			
ITEM NO.	ITEM	UNIT	QUANTITIES
202.0443	Removal of end post for Kunia I.C. Structure	Lump Sum	(3 C.Y.)
206.6103	Structure excavation for concrete railing	Cu. Yd.	13 C.Y.
503.1205	Concrete in footing for bridge railing	Lump Sum	(7 C.Y.)
507.7600	Concrete bridge railing (2'-8" traffic type)	Lin Ft.	30 L.F.
602.0205	Reinforcing steel in footing for bridge railing	Lump Sum	(450 Lbs)

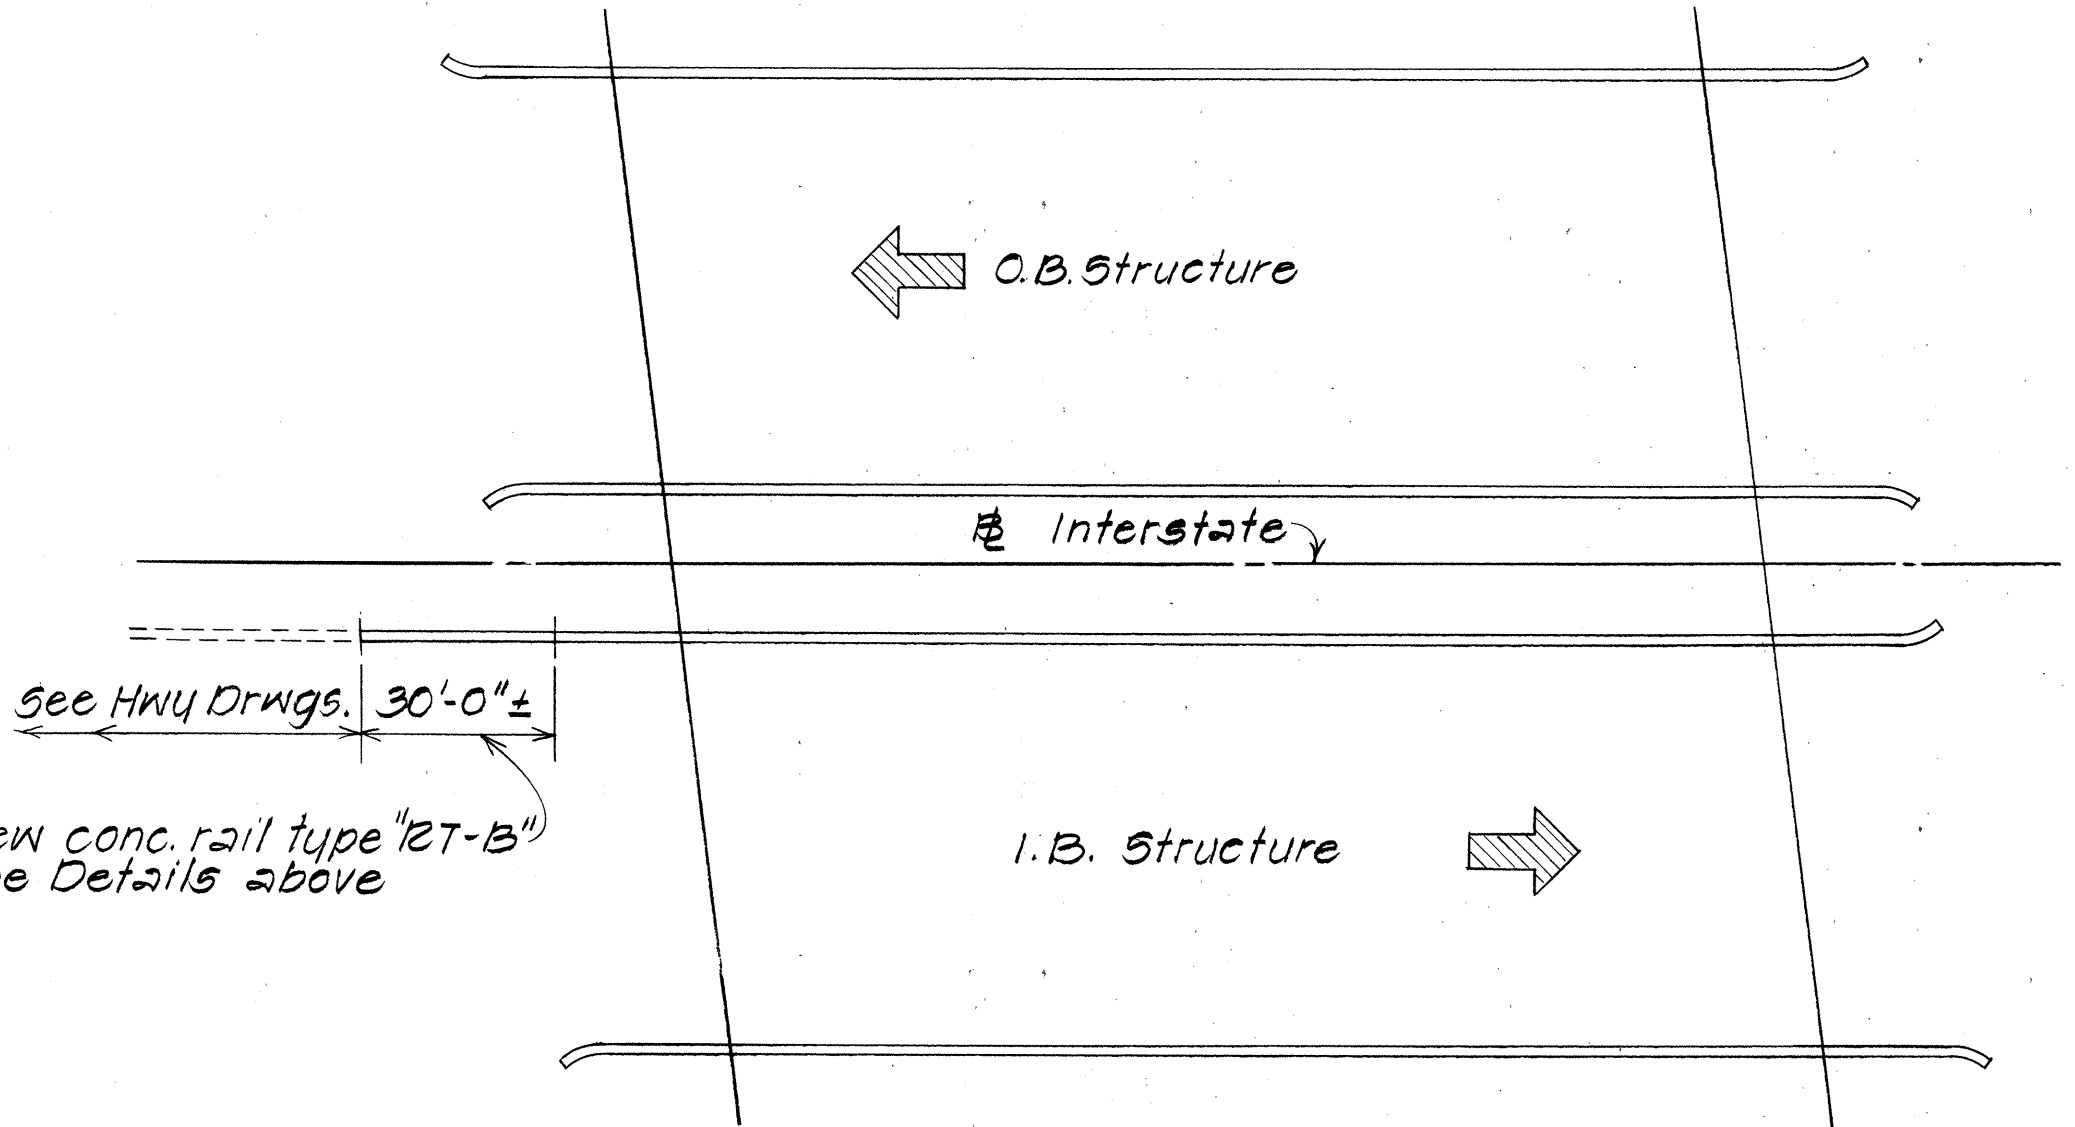

LOCATION PLAN - KUNIA I.C. STRUCTURE Scale: 1"=50'-0"

ORIGINAL PLAN	DATE
DRAWN BY H.N.F.	7/85
DESIGNED BY M.Y.	7/85
QUANTITIES BY L.A.G.T.	7/85
CHECKED BY	
NO.	

STATE OF HAWAII
DEPARTMENT OF TRANSPORTATION
HIGHWAYS DIVISION


KUNIA INTERCHANGE STRUCTURE
REPLACEMENT OF I.B. APPROACH
BRIDGE RAIL

INTERSTATE ROUTE H-1, PALALAI I.C. TO
KUNIA I.C. CONSTRUCTION OF ADDITIONAL LANES
F.A.I. Proj. No. 1E-H1-1(180)


Scale: As Shown Date: July 1985

GENERAL NOTES

- All concrete shall be Class A unless otherwise noted.
- Reinforcing shall be detailed in accordance with A.C.I. Manual of Standard Practice for Detailing Reinforced Concrete Highway Structures unless otherwise noted.
- Clearance for reinforcing bars shall be as follows, unless otherwise noted:
 - 1/2" for stirrups of beams & pier caps.
 - 2" for ties of columns.
 - 2" for formed walls.
 - 3" for footings.
- Minimum spacing between parallel bars shall be 2 1/2 times the diameter of bars, but in no case shall the clear distance between the bars be less than 1 1/2 times the maximum size of the coarse aggregate.
- All dimensions relating to reinforcing are to centers of bars unless otherwise noted.
- Reinforcing bars shall be securely tied at all intersections & lap splices & shall be held in place during pouring to maintain their proper locations as shown on plans.
- Vertical column bars shall be arranged in such a manner as to miss pier cap bars above as directed by the Engineer.
- Except as otherwise noted on drawings, all exterior corners & re-entrant angles in concrete work shall be chamfered 3/4" x 3/4".
- Concrete seats receiving steel plates, lead plates or neoprene pads shall be poured monolithically with supporting structures & top of concrete seats shall be finished with a steel trowel to a smooth level surface at the elevation shown on the plans.
- Elastomeric Pads: Bottom of bridge bearing pads shall be secured against displacement with adhesives approved by the Engineer. Pads shall be incidental to concrete and will not be paid for separately.
- Forms for all exposed surfaces of separation structures and surfaces of retaining walls visible from a traveled way or from a populated area shall be plywood except that metal forms may be permitted provided a surface finish satisfactory to the Engineer can be obtained and the use of such forms is approved in writing by the Engineer. Forms for round columns shall be made of materials that will give a smooth finish and true dimensions as given in the plans. Forms for prestressed concrete members shall be either metal or plywood.
- Gothic letters and figures approximating dimensions shown will be acceptable if approved by the Engineer.
- The contractor shall verify the location of all existing utility lines and notify the respective owners before commencing work of excavation or driving of piles.
- Standard Detail Drawings refer to all structures in general, except for modifications as may be required for special conditions. For such modifications refer to the corresponding detailed drawings.

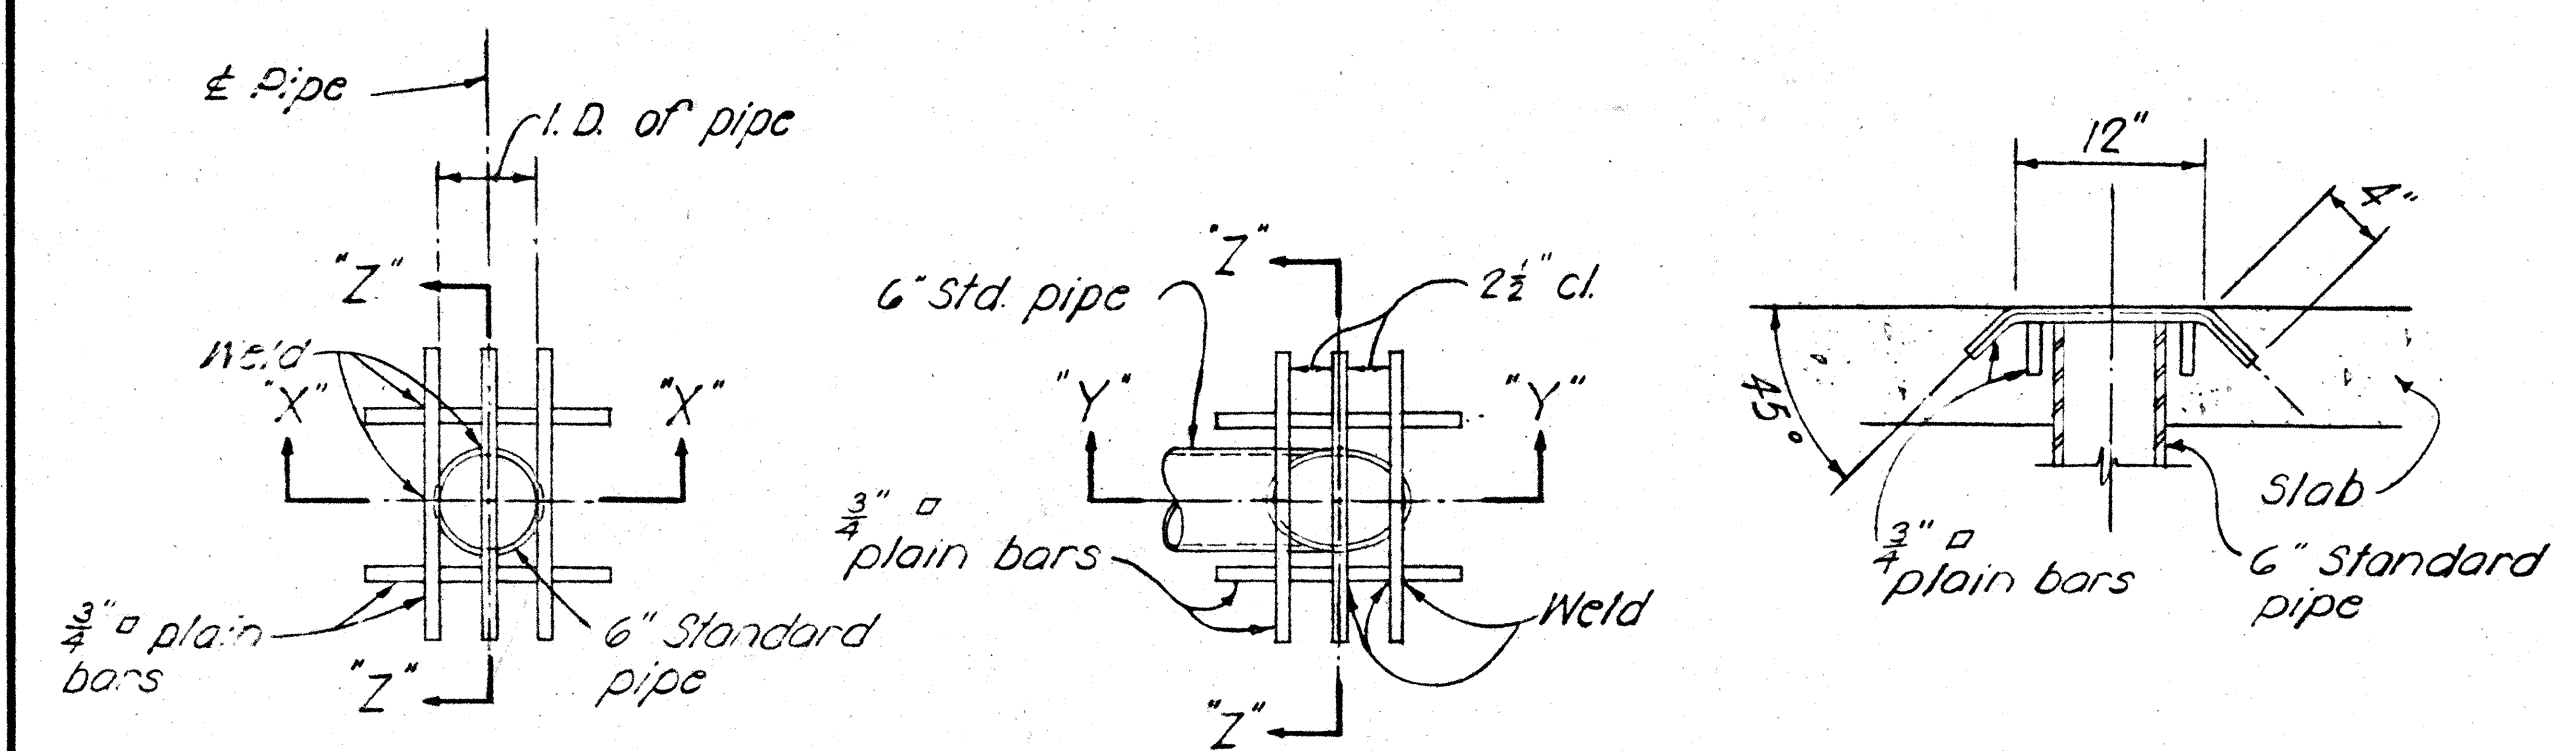


TYPICAL CONCRETE GROOVE DETAIL

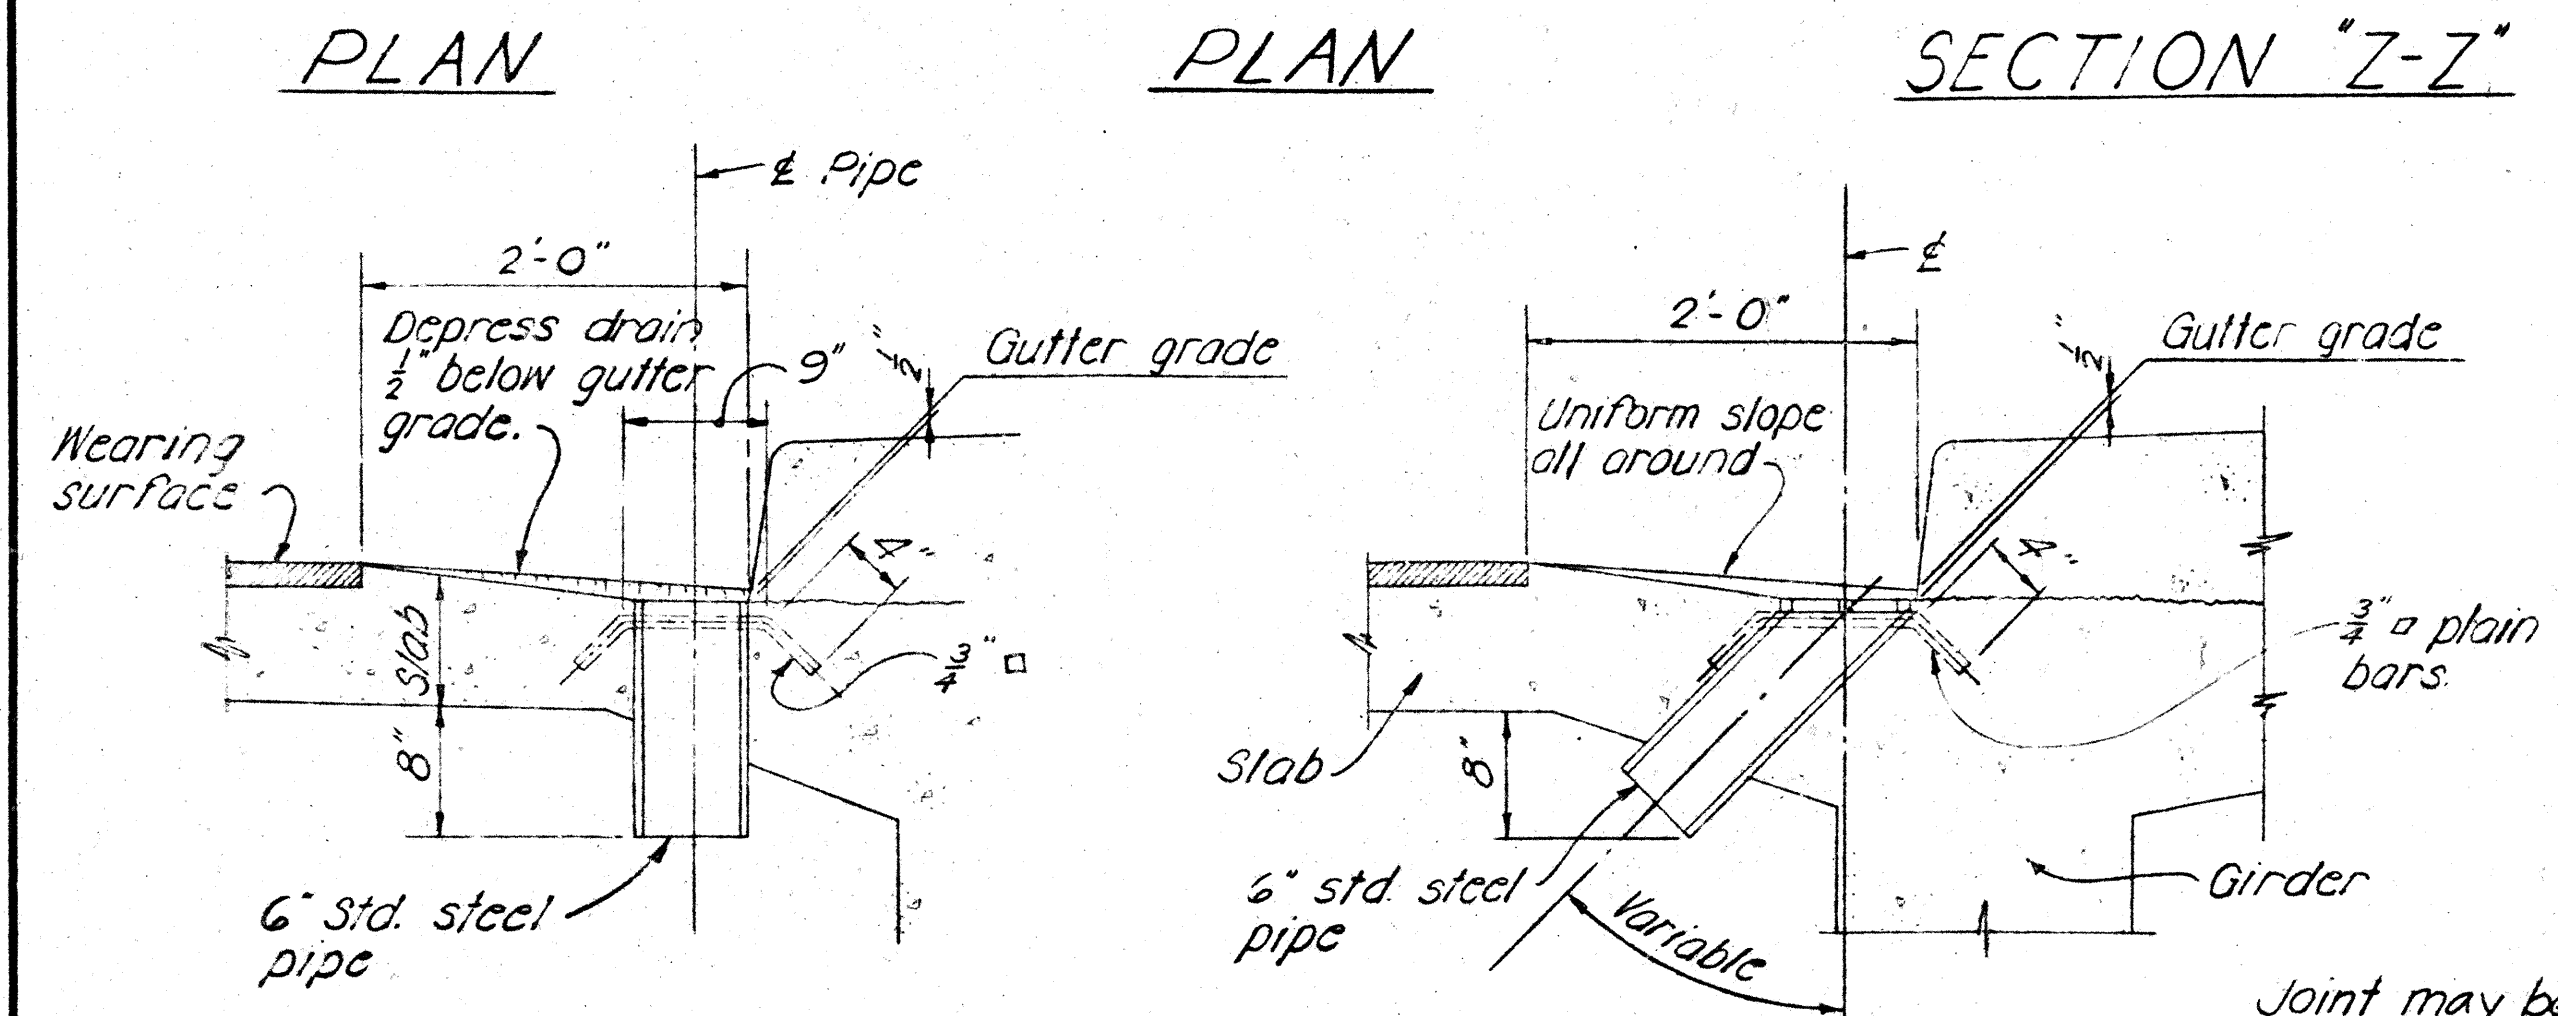


DRIP DETAIL

NOTE: Metal drains shall be considered incidental to Class A Concrete in both concrete and steel bridges and will not be paid for separately. Assembly of grillage and pipe shall be hot-dip galvanized after all welding is completed.


TYPICAL DRAINAGE DETAILS

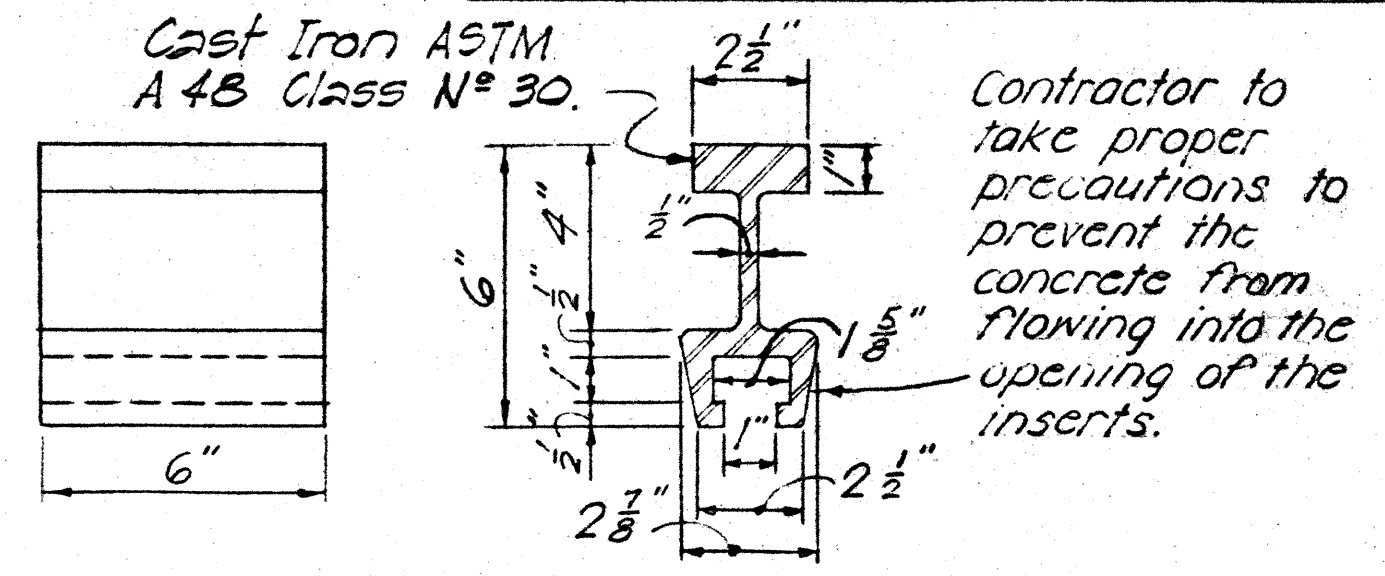


INSERT DETAIL

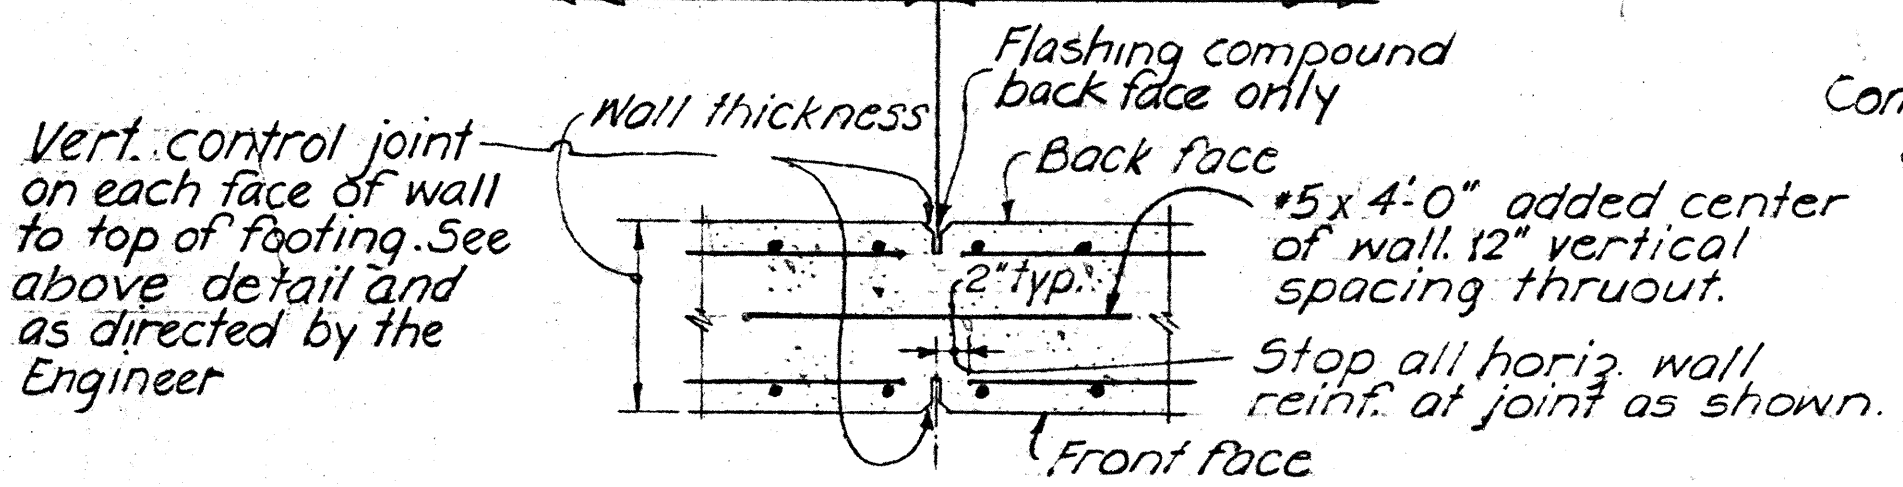

CONTROL JOINT DETAILS

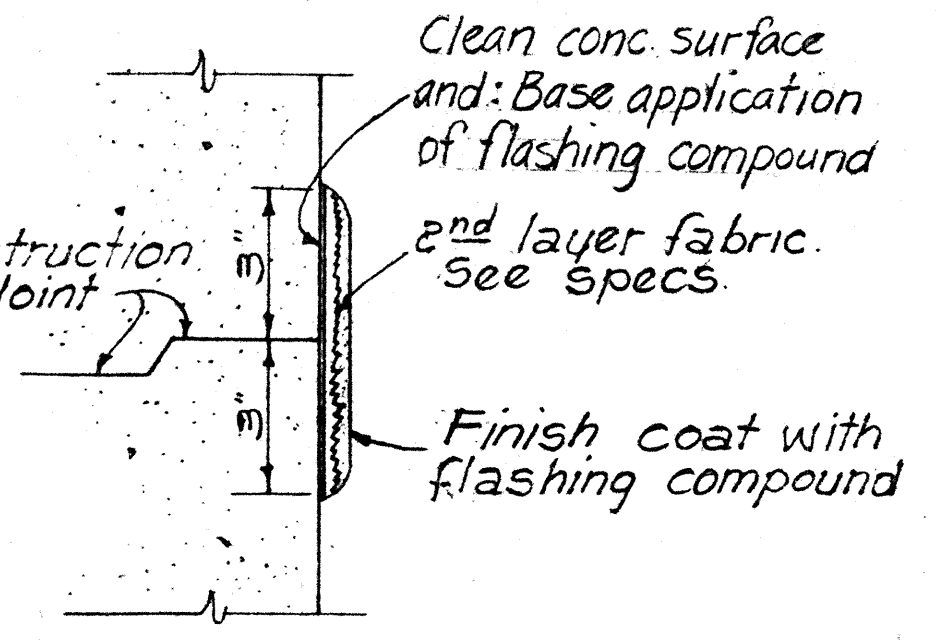

TYP. FLASHING COMPOUND WATERPROOFING DETAIL

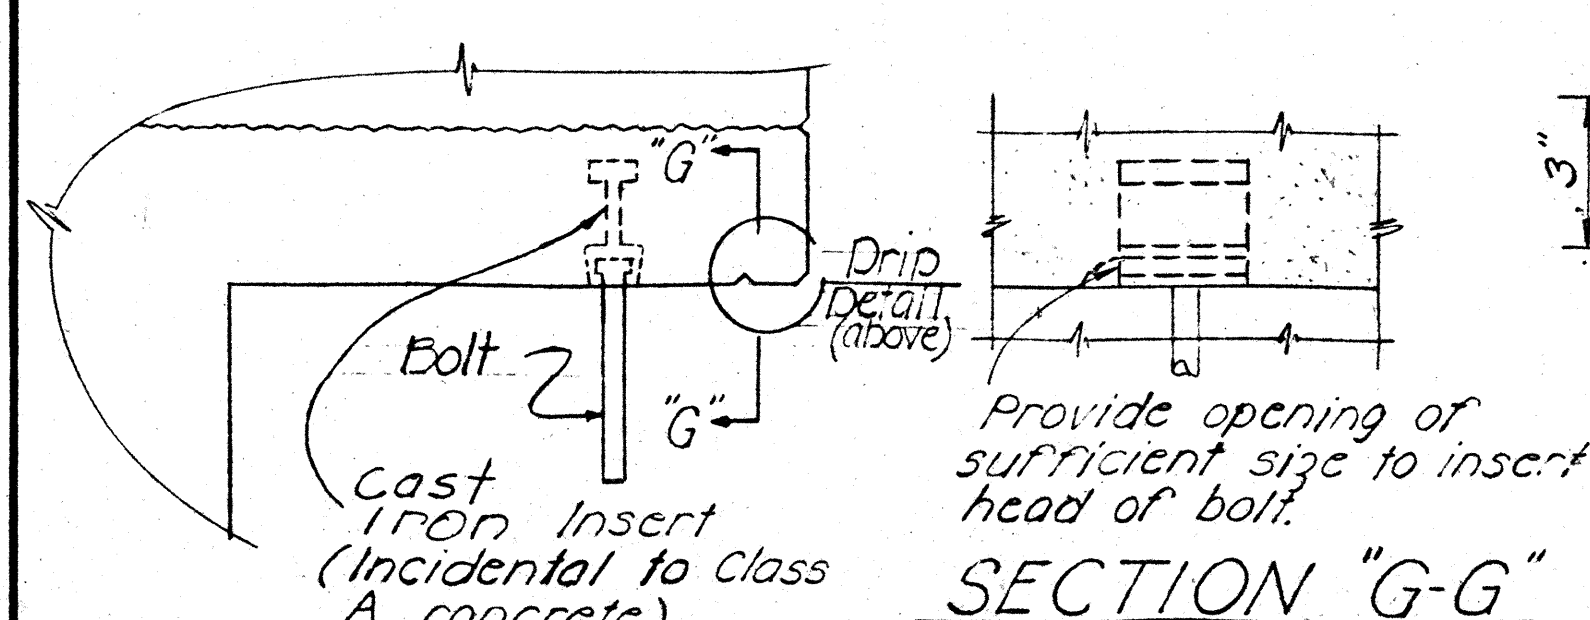


DETAIL OF PIPE HANGERS & INSERTS

NAME DATE

Use correct name of bridge Date of Year built
NOTE: Refer to corresponding detail drawings for placement of such names & dates at end post. Exact details & spacing of letters & figures shall be as directed by the Engineer. See Note #12

TYPICAL DETAIL OF LETTERS & FIGURES AT CONCRETE END POST

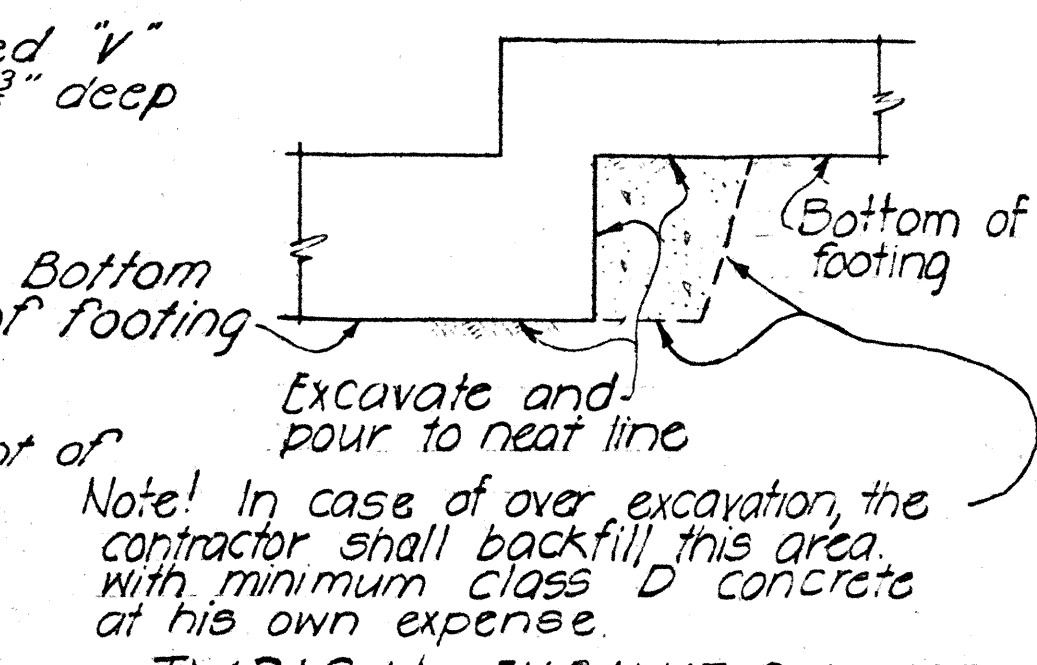

TYPICAL EXCAVATION FOR CONTINUOUS FOOTING STEP-UP

APPROVAL RECOMMENDED:
 Paul T. Yamashita
 BRIDGE DESIGN ENGINEER 1-23-70 DATE

APPROVED
 Paul T. Yamashita
 ASSISTANT CHIEF, ENGINEERING 1-28-70 DATE


NO.	REVISION	APPROVED BY	DATE

STATE OF HAWAII
 DEPARTMENT OF TRANSPORTATION
 HIGHWAYS DIVISION
STANDARD DETAILS
 NOTES AND MISCELLANEOUS
 DETAILS

FED. ROAD DIST. NO.	STATE	FED. AID PROJ. NO.	FISCAL YEAR	SHEET NO.	TOTAL SHEETS
HAWAII	HAW.	I-HI-1 (89)	1975	ADD. 30A	99


NOTES

- ① Exis'tg. bridge structure shown by dash lines. Limits of removal of exis'tg. structure shown by hatched line areas.
- ② For Hanouliuli Stream bridge. Outbound struct., North rail Hanokulu end only. Begin new railing P.C. 2'-0" in from end of exis'tg. end post bracket as shown in Plan to clear exis'tg. conc. sump. All others, begin P.C. at end of exis'tg. end post bracket.
- ③ For curve end section of new concrete railing and connection details of metal guard rail (slat & intermediate support block), see "Standard Details" on sht. # 11B for additional information and details. Also, see note on sht. # 6B.
- ④ For removal of all exis'tg. exposed reinf. (except those shown in "Typ. sect. 8B" and noted on note 5) burn 1" below exis'tg. conc. deck line as shown in detail. Fill resulting 1" depression with mortar and smooth finish to match exis'tg. deck grade.
- ⑤ Clean all exposed vertical reinf. occurring in this section (see "Elev." & "Schedule" for location & limits) before pouring of new railing. Remove horizontal bars and curb reinf. (not shown in detail.)
- ⑥ The Contractor shall erect portable concrete guard rail when reconstructing the bridge exterior railing. See Sheets 13 & 14 for details of temporary guard rail.

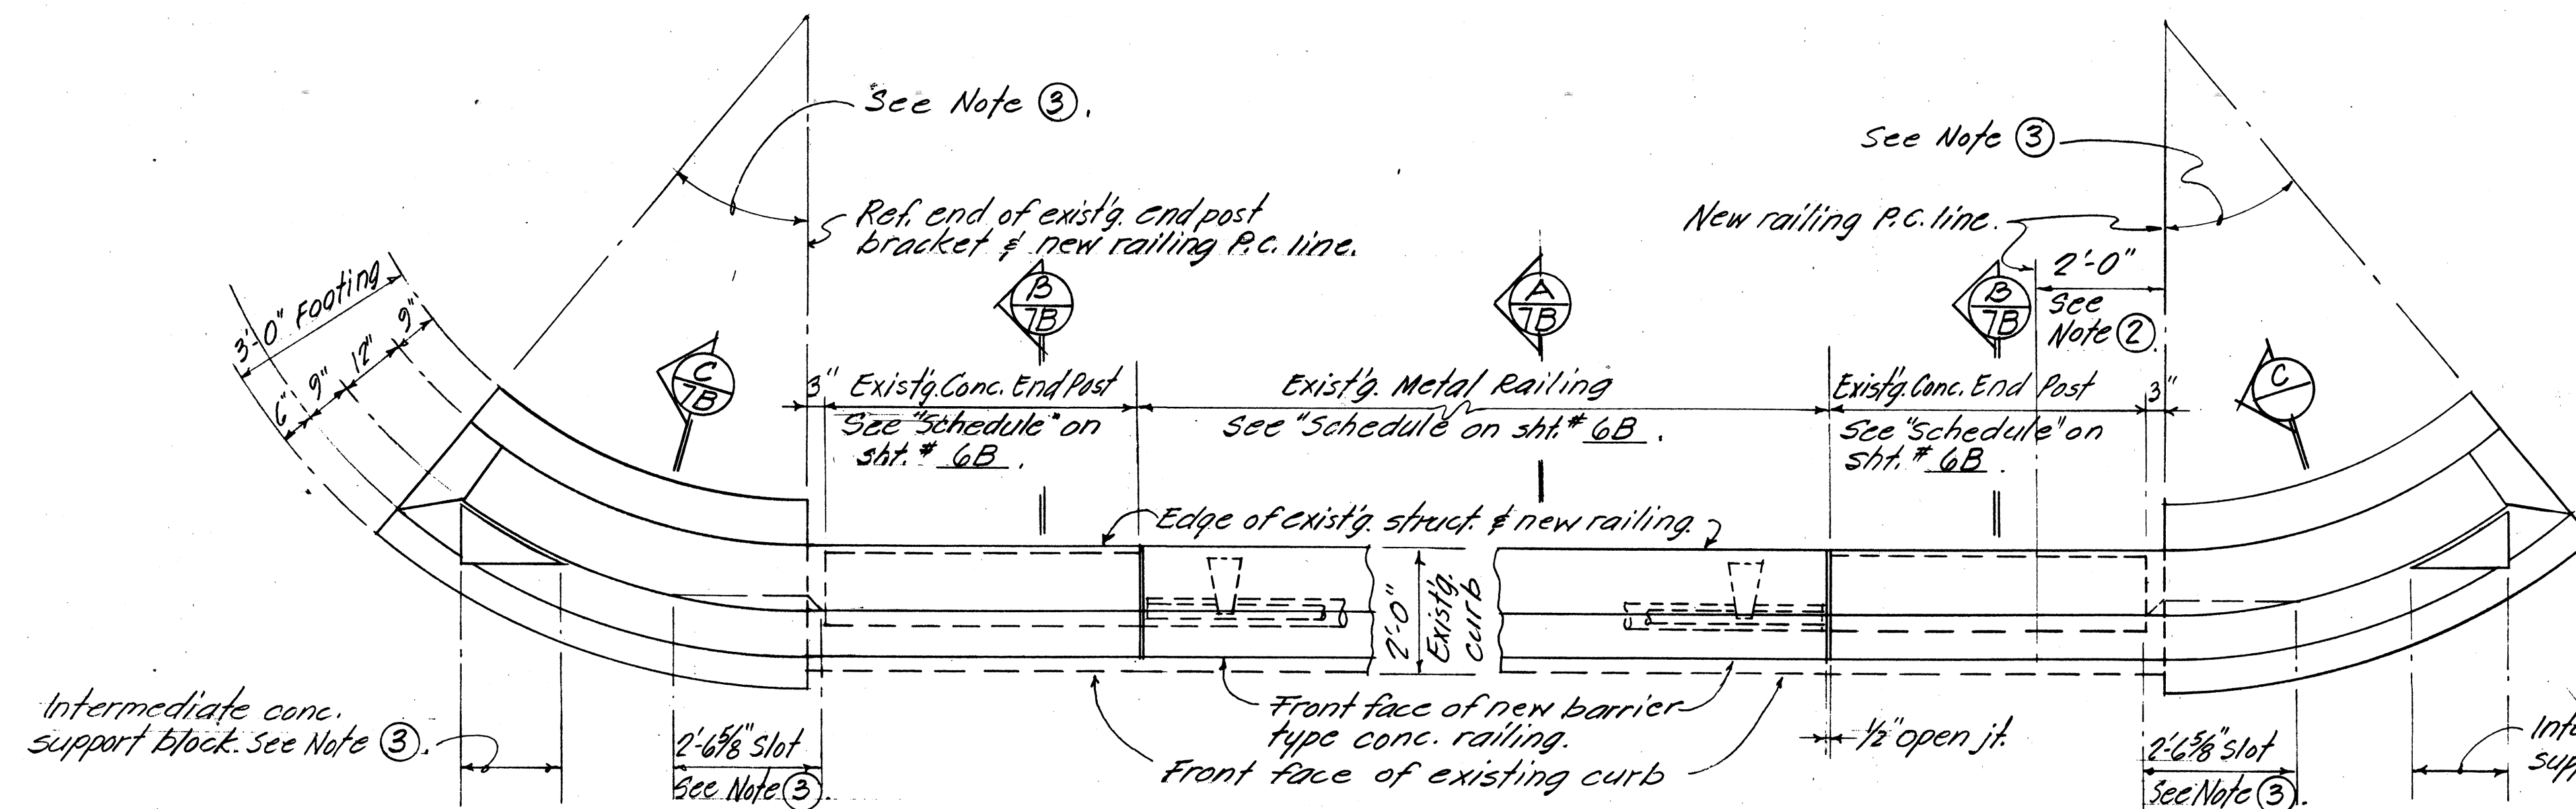


TYP. PART PLAN OF EXISTING & NEW CONC. RAILING
FOR PALEHUA, HONOLULULI & KUNIA SEPARATION

scale: $\frac{1}{2}" = 1'-0"$

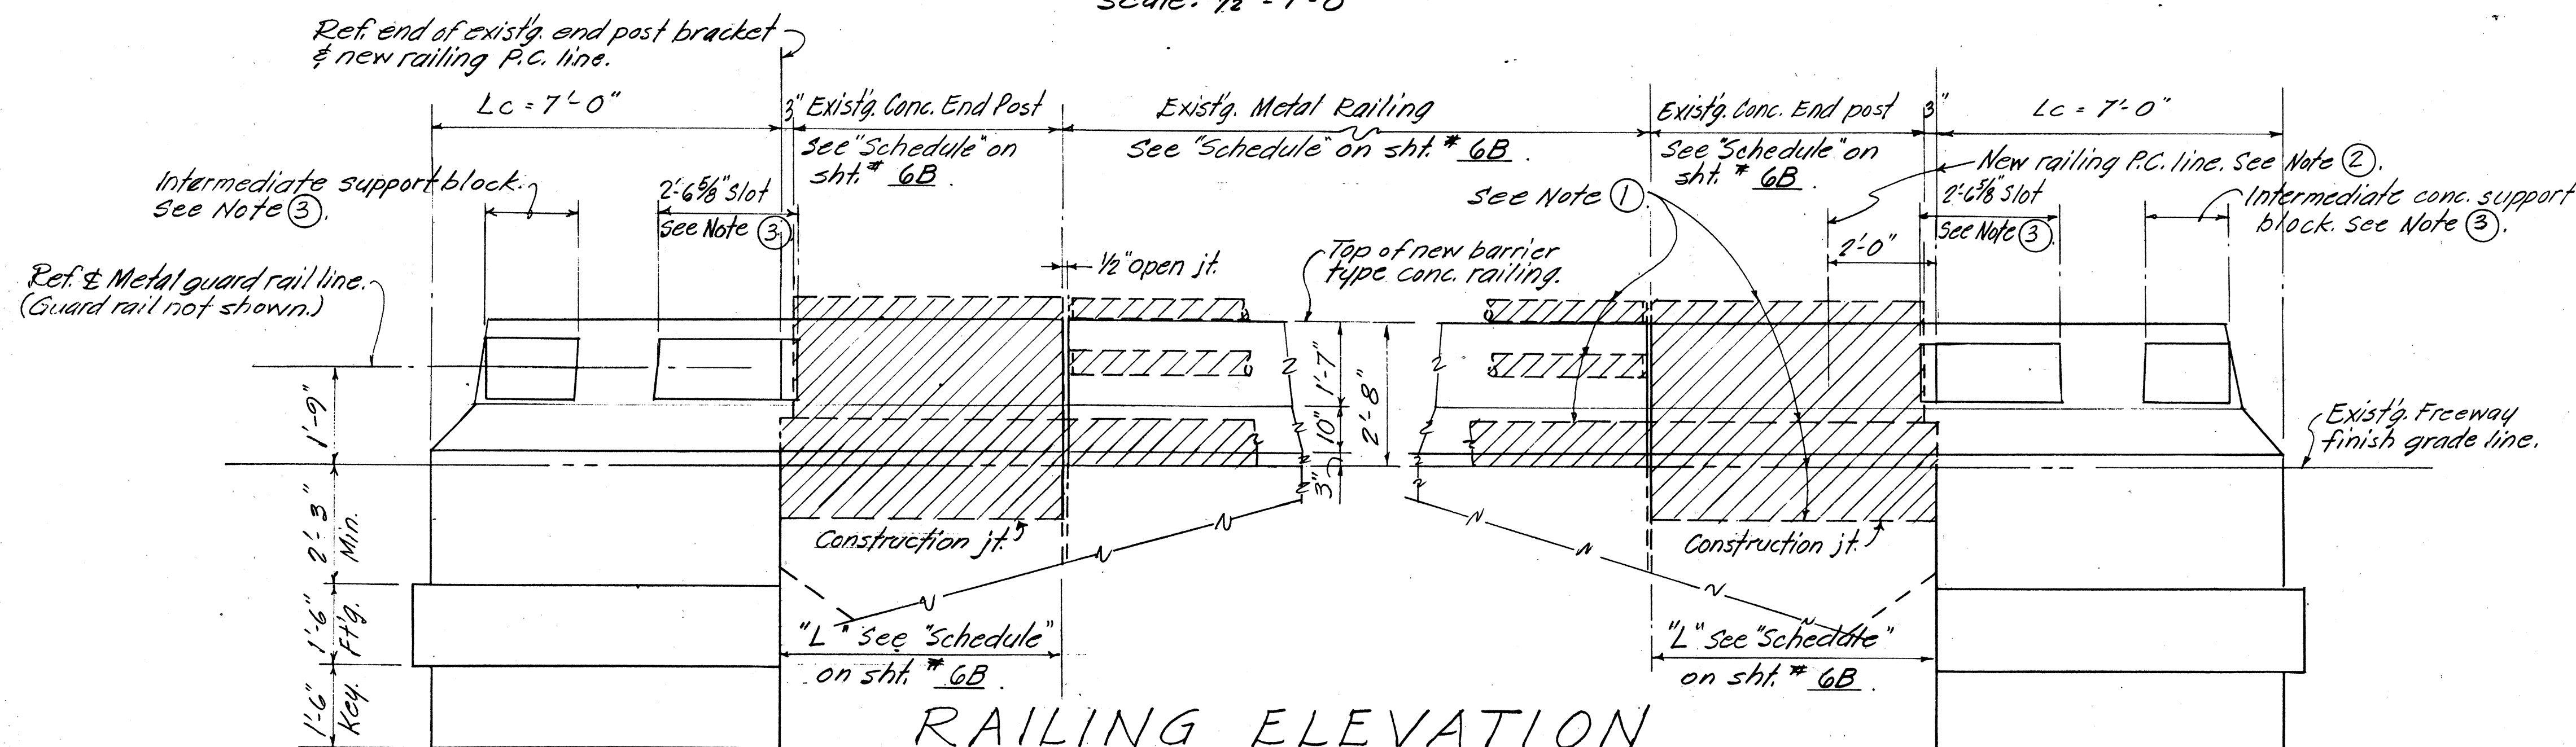

RAILING ELEVATION

Scale: $\frac{1}{2}" = 1' - 0"$

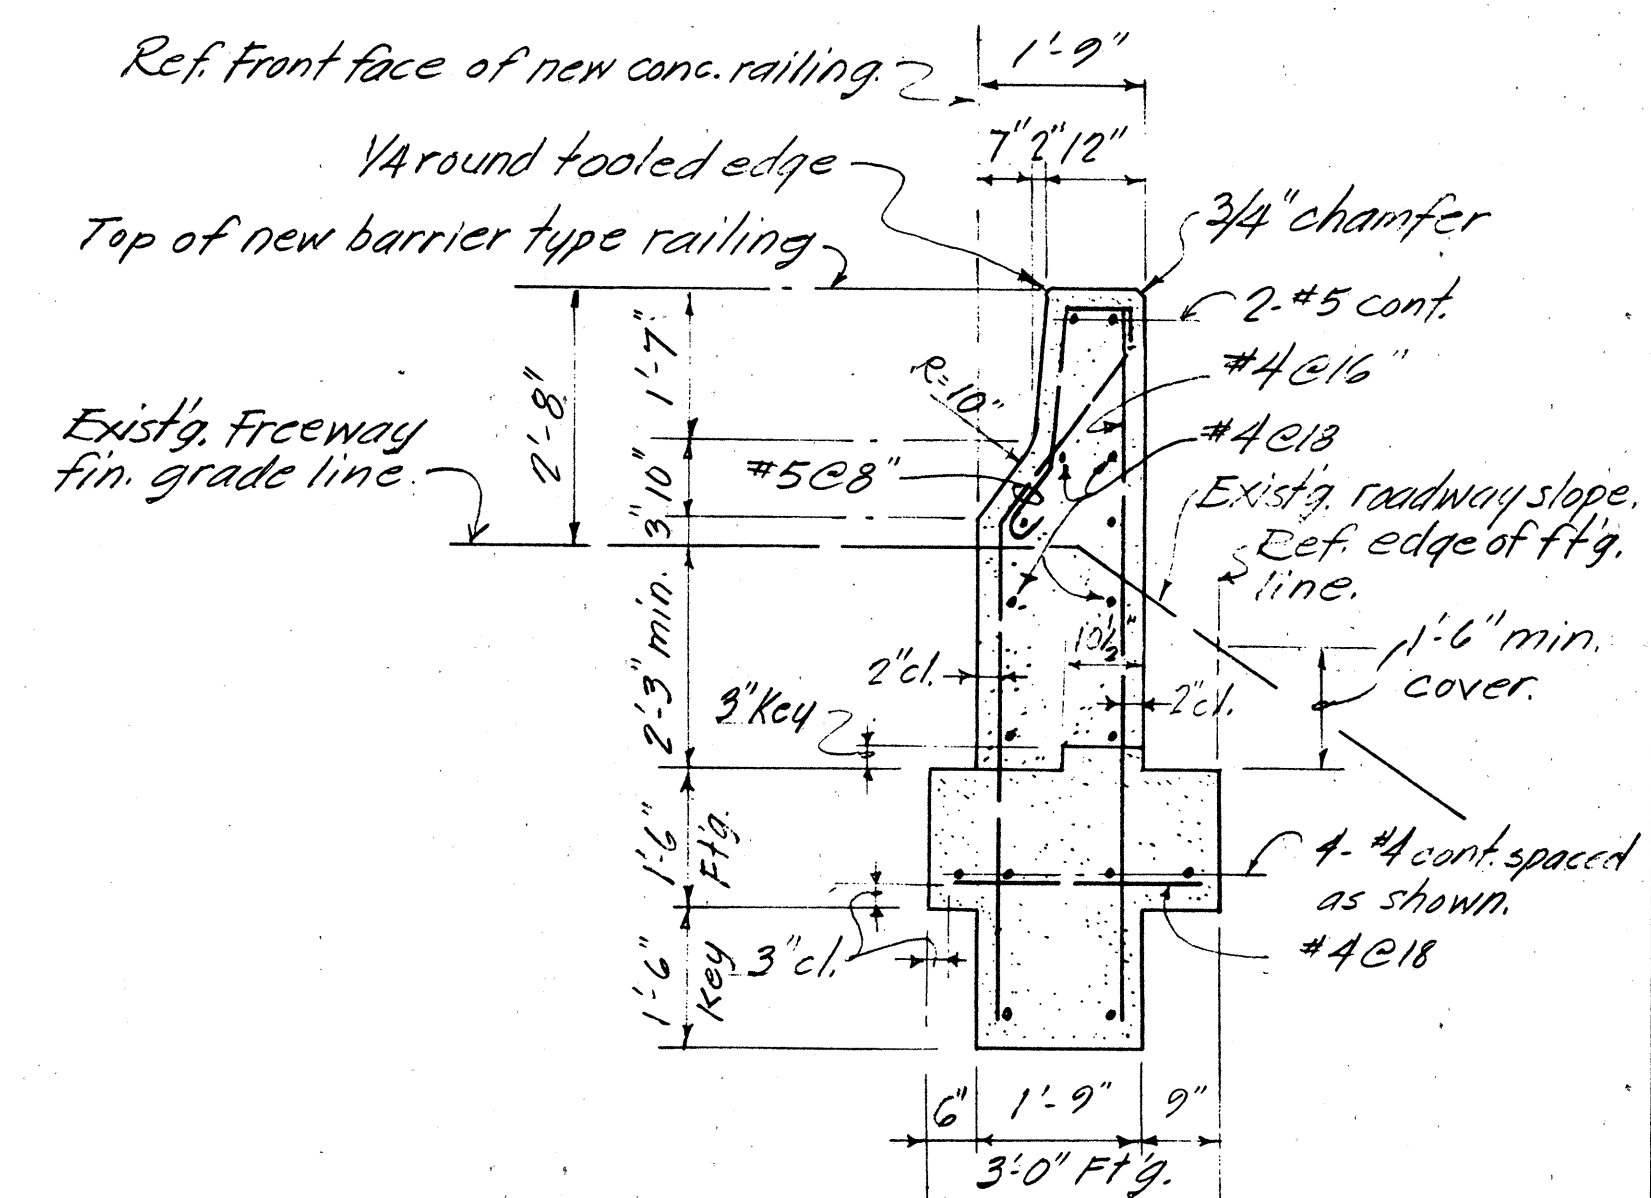

TYP. SECT. $\left(\frac{C}{7B}\right)$ Scale: $\frac{3}{4}'' = 1'-0''$

c) scale: $\frac{3}{4}'' = 1'$ or

ESTIMATED QUANTITIES

ITEM	LOCATION	PALEHUA SEPARATION	HONOLULUI STR. BRIDGE	KUNIA SEPARATION
* REMOVAL OF EXIST'G. CONCRETE CURB		176 Lm.Ft.	582 Lm.Ft.	804 Lm.Ft.
DRILLING OF HOLES FOR DOWELS		404 HOLES	1,312 HOLES	1,812 HOLES
NEW CONC. BARRIER TYPE RAILING		231.5 Lm.Ft.	638 Lm.Ft.	860 Lm.Ft.

* END POST INCLUDED

Note: This tracing prepared during "As-Built" posting.

STATE OF HAWAII
DEPARTMENT OF TRANSPORTATION
HIGHWAYS DIVISION


REMOVAL & RECONSTRUCTION OF RAILROAD
FOR PALEHUA, HONOLULULI & KUNIA
SEPARATION

SAFETY IMPROVEMENTS ALONG INTERSTATE 4-1
PALALAI TO KUNIA

Proj. N^o I-HI-1(108) Date: Dec. '73


SHEET No. 7B OF 11B SHEETS

ADD. 70 A

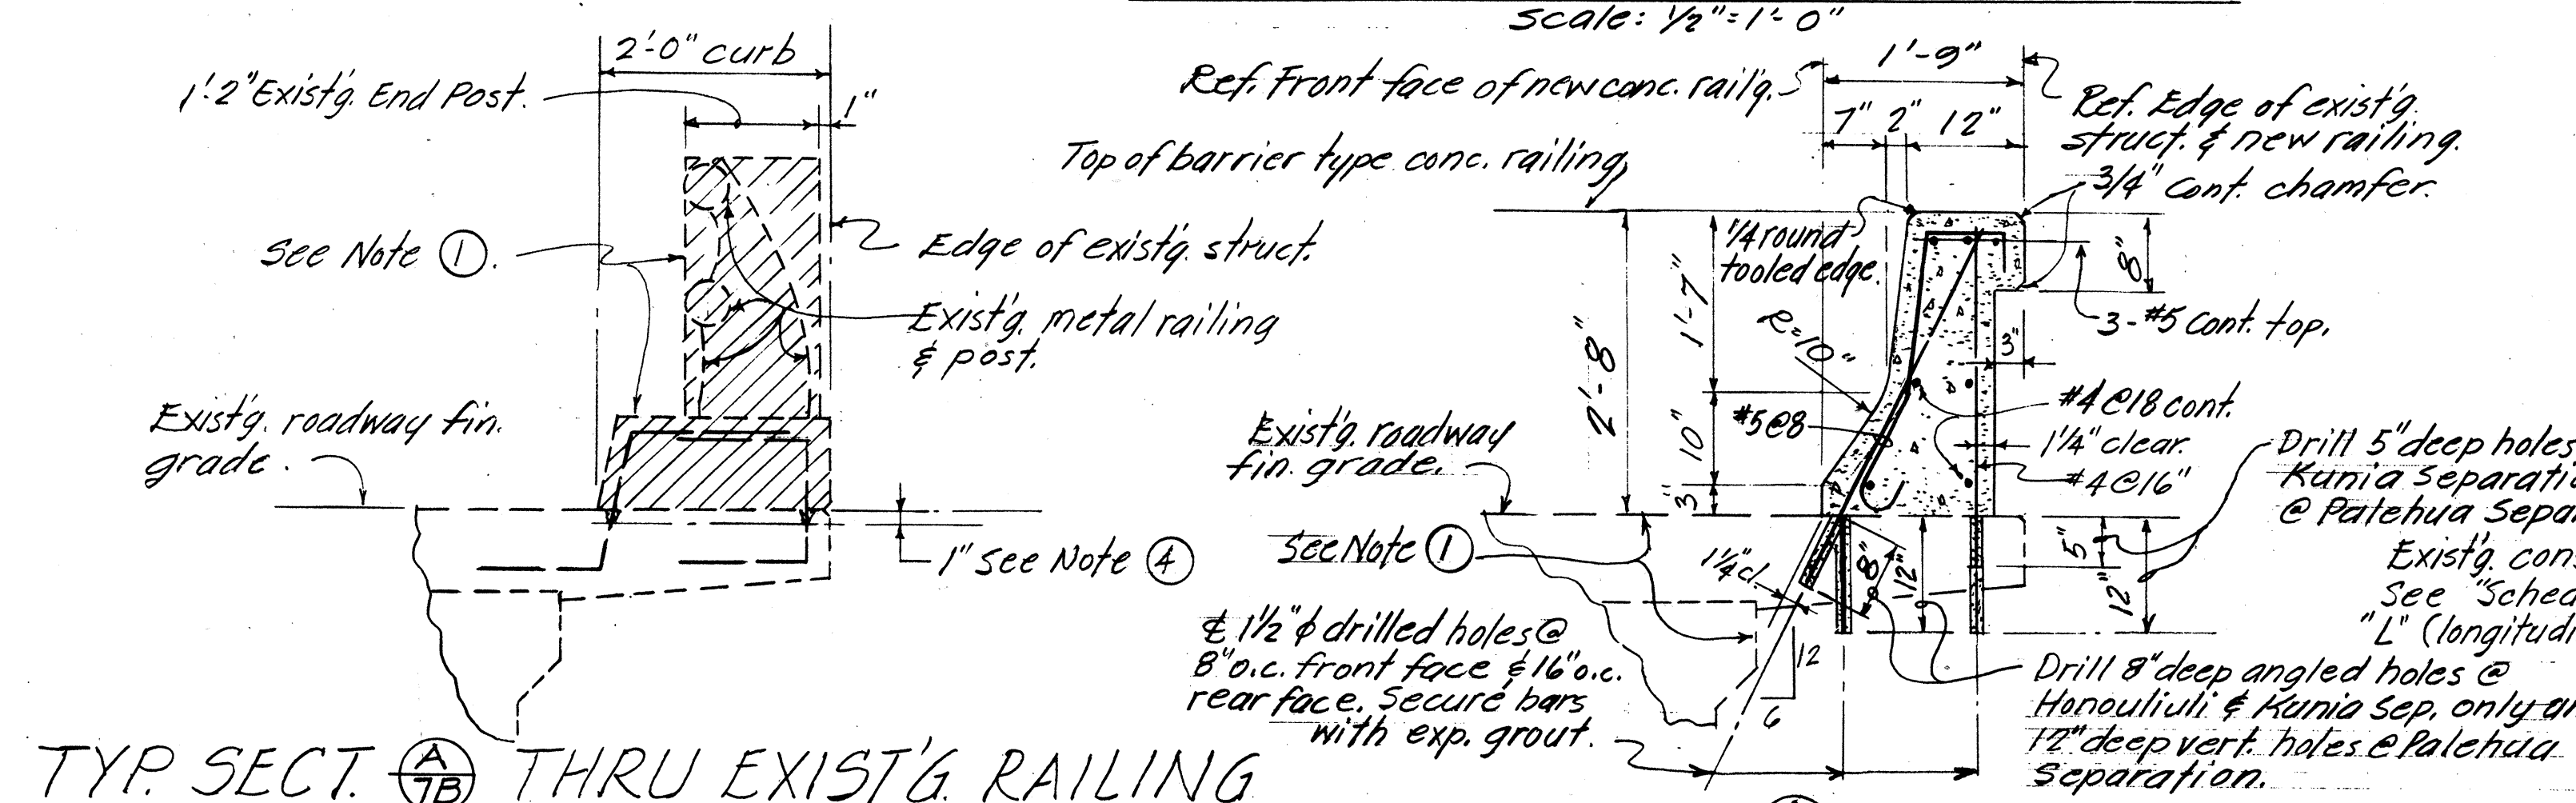


TYP. SECT. $\textcircled{\frac{A}{7B}}$ THRU EXIST'G RAILING

Scale: $\frac{3}{4}" = 1' - 0"$

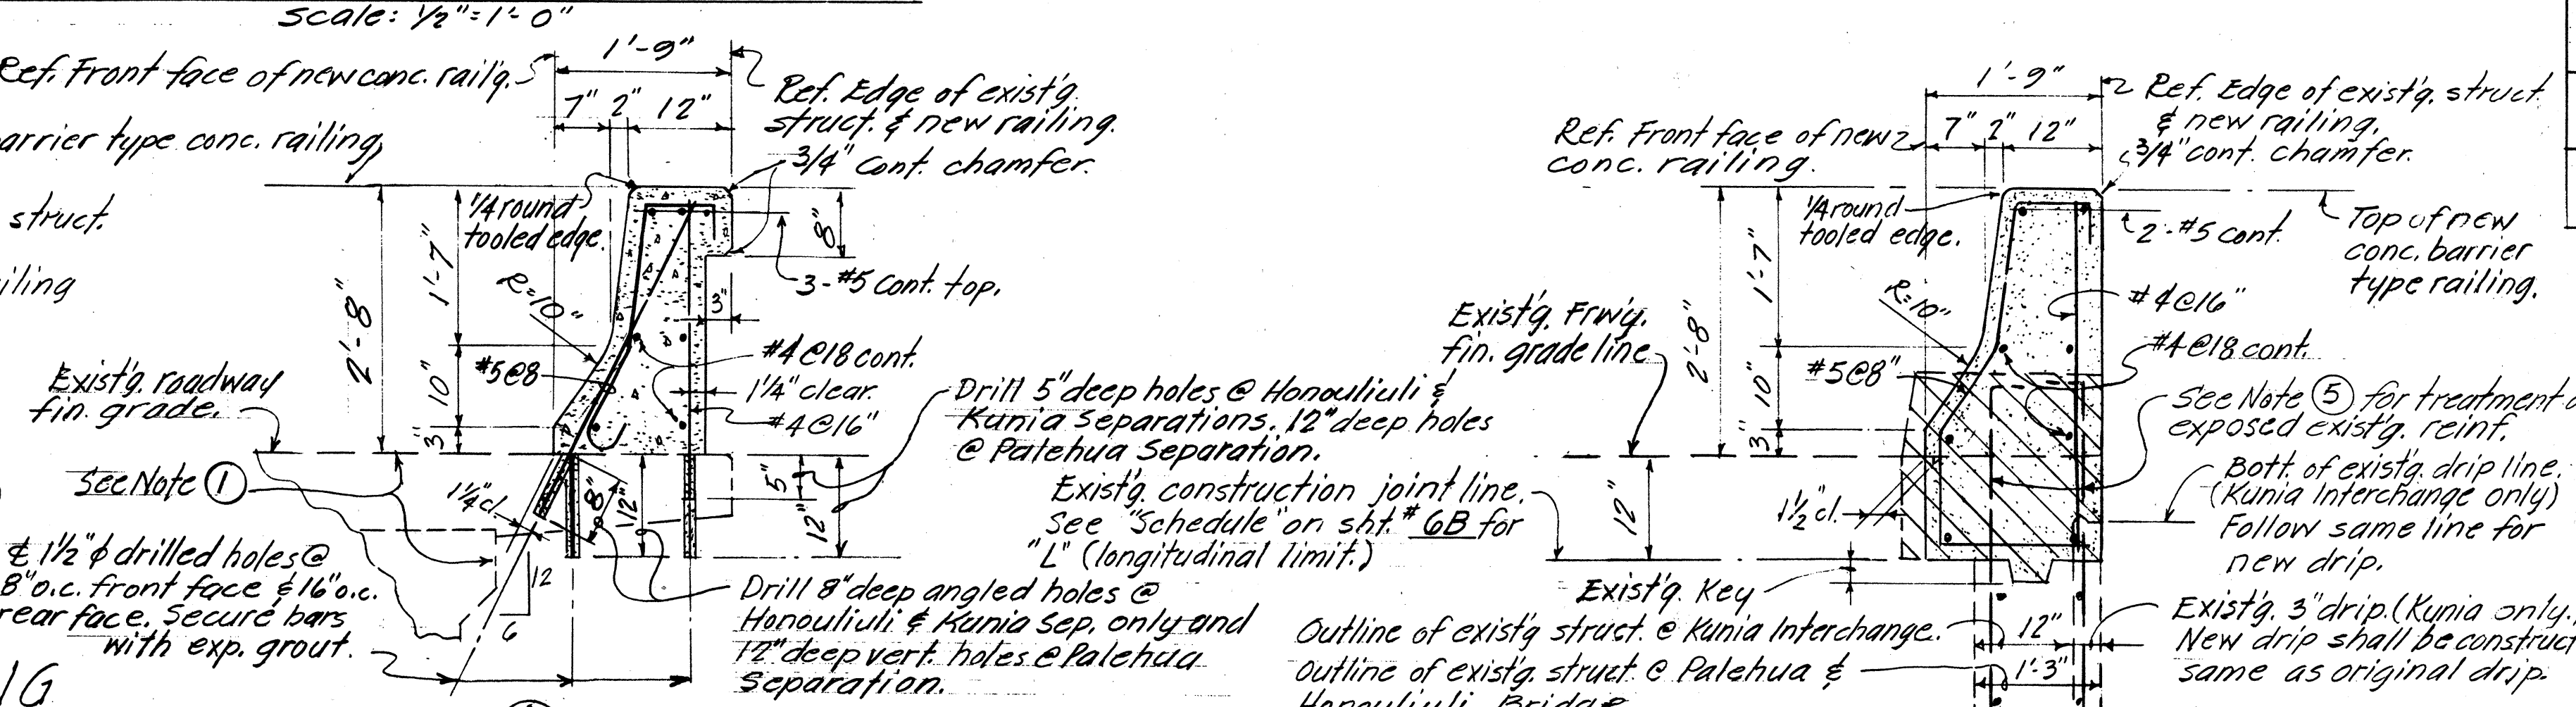

TYP. SECT. $\textcircled{\frac{A}{7B}}$ THRU NEW CONC.


BARRIER TYPE RAILING scale: $\frac{3}{4}" = 1'-0"$

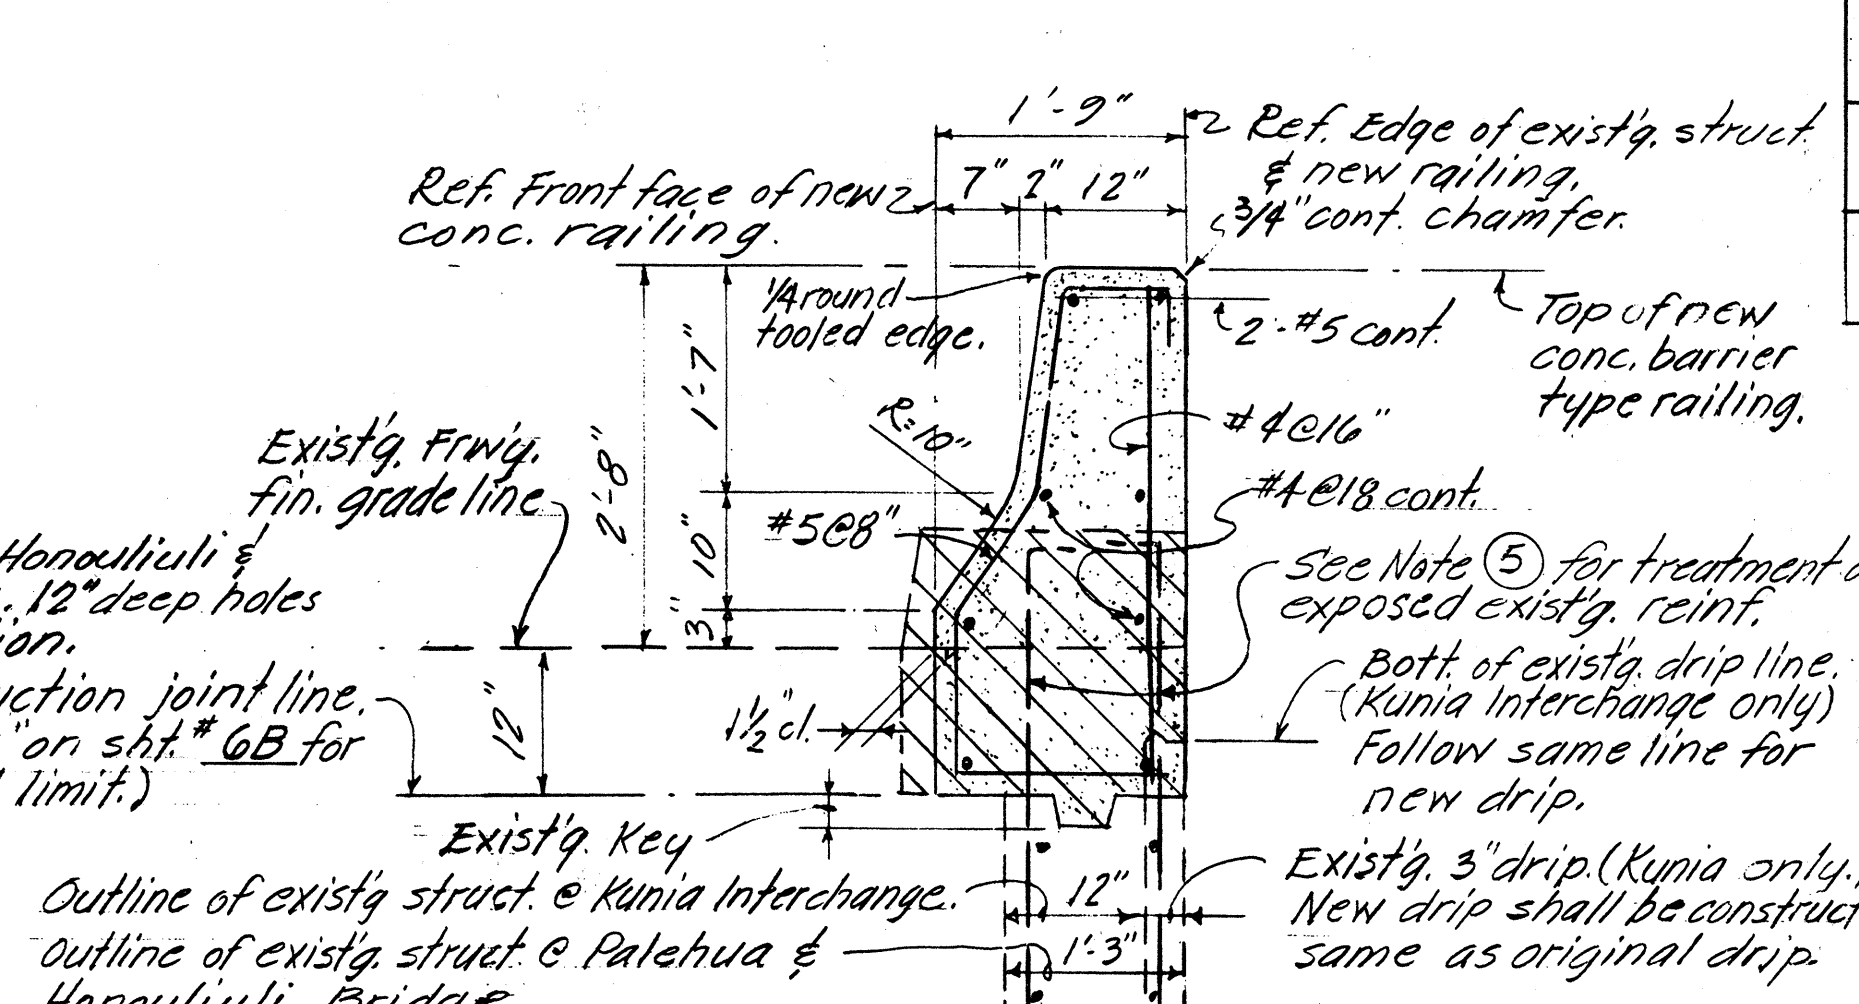

TYP. SECT. (B)
7E


Scale: $\frac{3}{4}" = 1'-0"$

ORIGINAL PLAN	SURVEY PLOTTED BY _____	DATE _____
	DRAWN BY _____	" _____
	TRACED BY _____	" _____
NOTE BOOK	DESIGNED BY _____	" _____
	QUANTITIES BY _____	" _____
No. _____	CHECKED BY _____	" _____

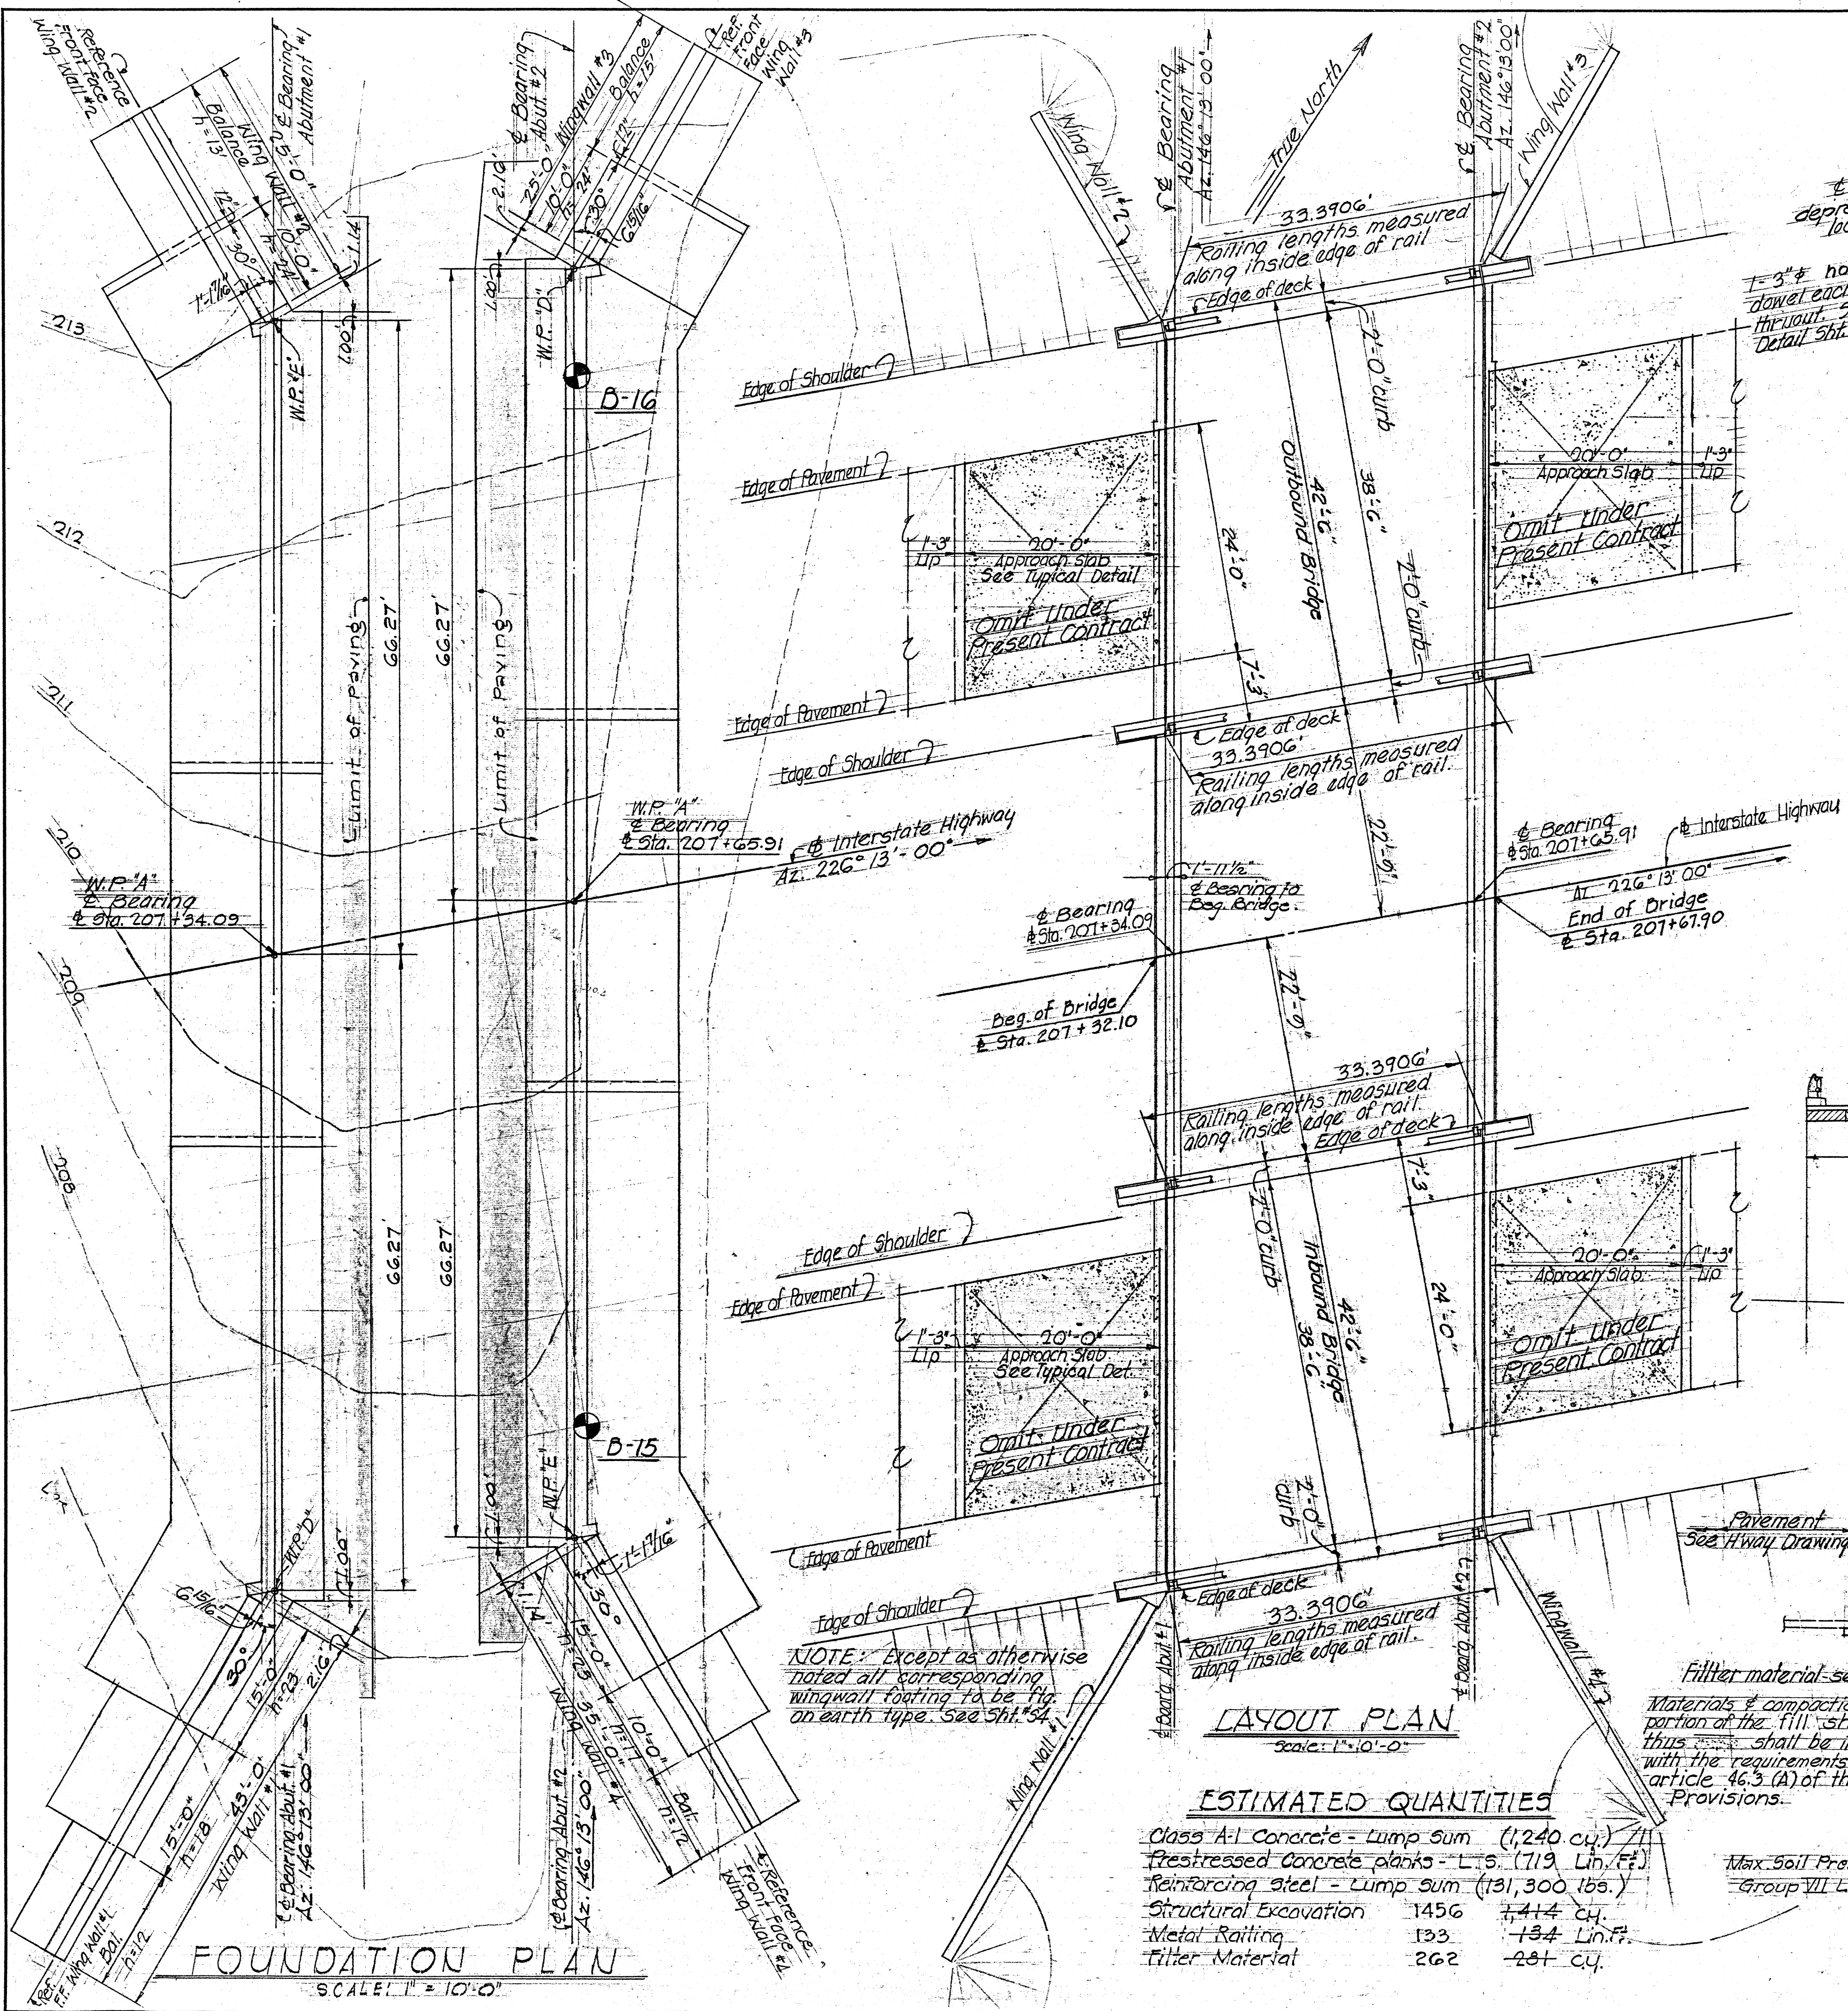


DECK FRAMING PLAN
INBOUND BRIDGE
Scale: 1" = 10'-0"

DECK FRAMING PLAN
OUTBOUND BRIDGE
Scale: 1" = 10'-0"

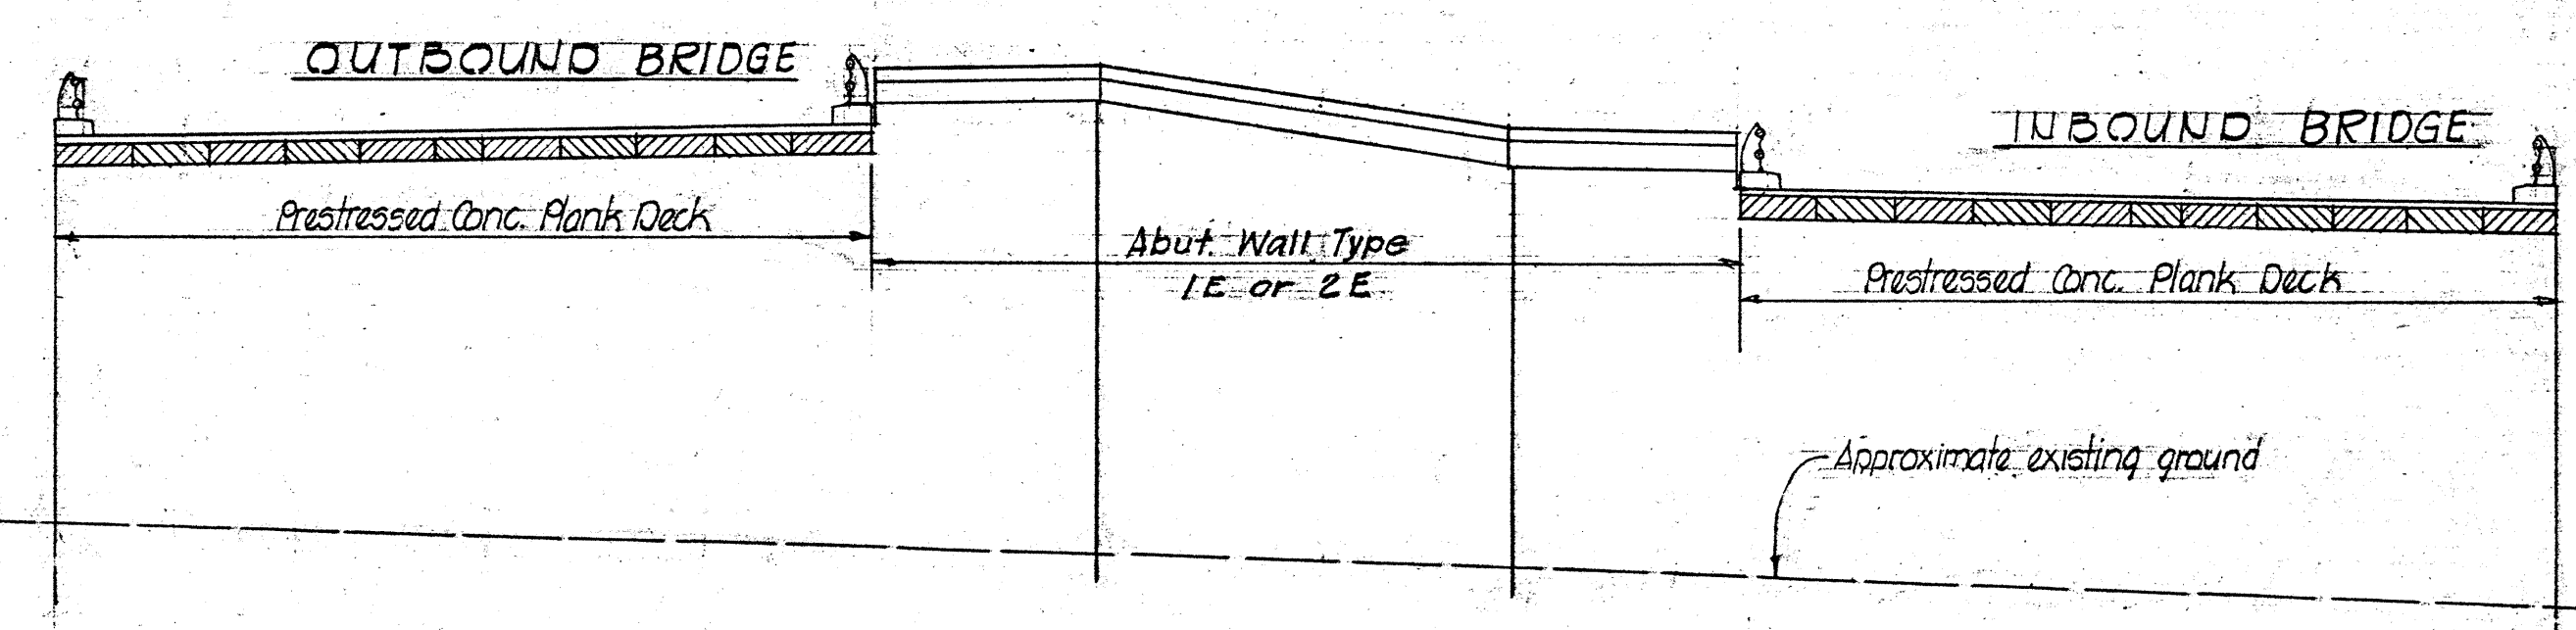

REFERENCE NOTES
1. Top of concrete deck to follow roadway finish grade.


PALEHUA SEPARATION
For information only (Reduction not to scale)

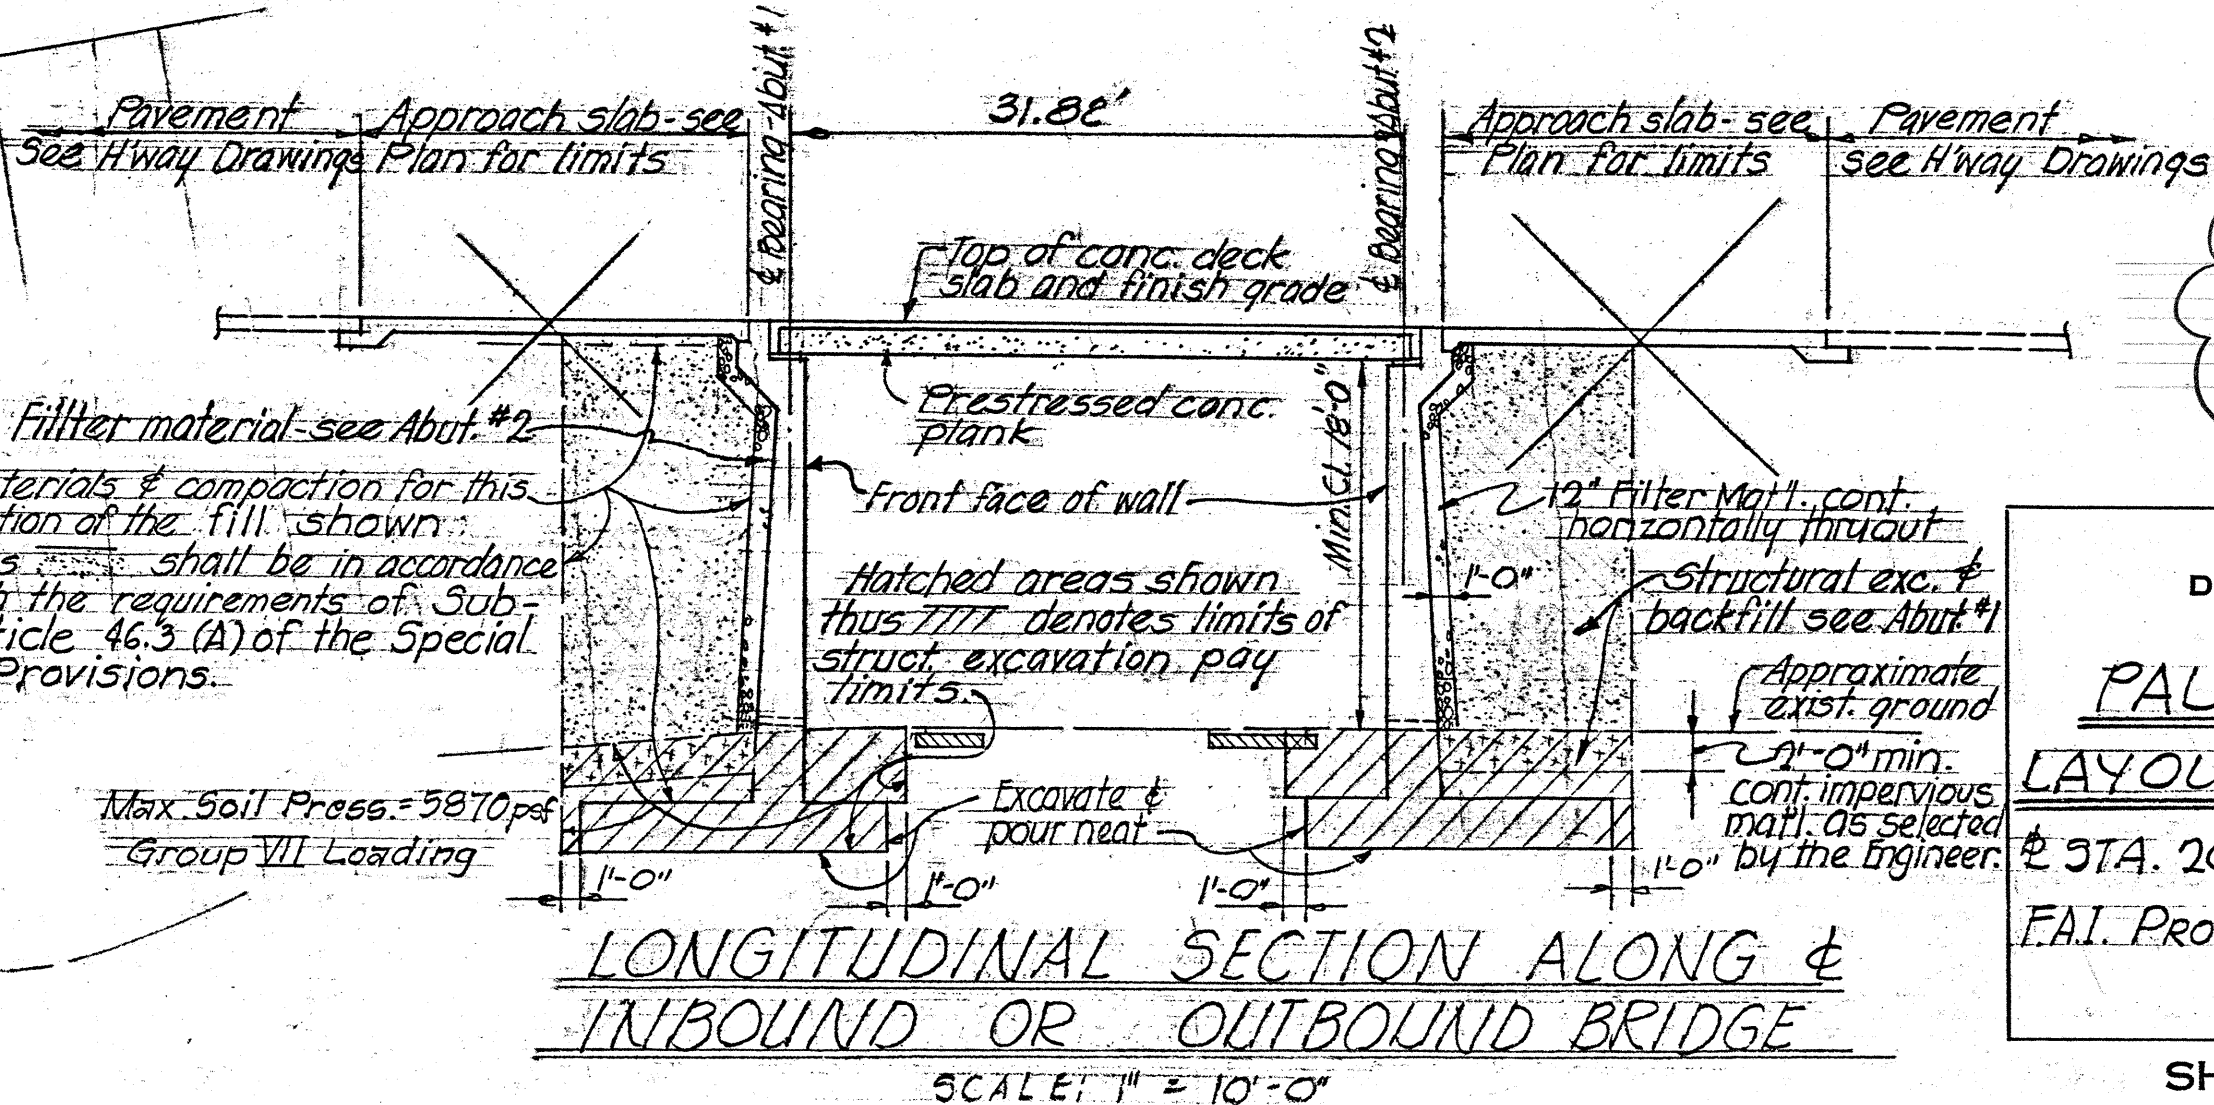


STATE OF HAWAII
DEPARTMENT OF TRANSPORTATION
HIGHWAYS DIVISION

PALEHUA SEPARATION
LAYOUT PLANS AND DETAILS
Sta. 207+32.10 to Sta. 207+67.90
F.A.I. Proj. 1H1-1101 PALEHUA RD. TO KUNIA RD.
NOV. 1964


SHEET No. 01 OF 07 SHEETS

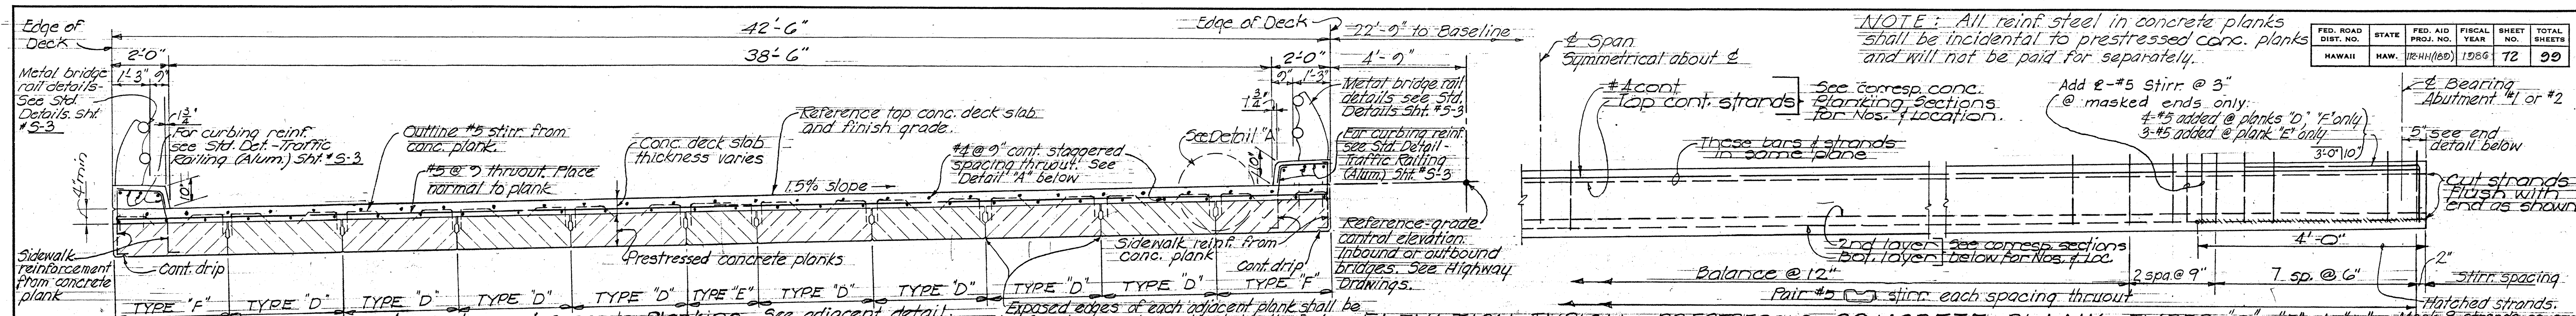


**NORMAL SECTION OUTBOUND BRIDGE AS SHOWN
(INBOUND BRIDGE SIMILAR EXCEPT OPPOSITE HAND)**
Scale: 3/8" = 1'-0"

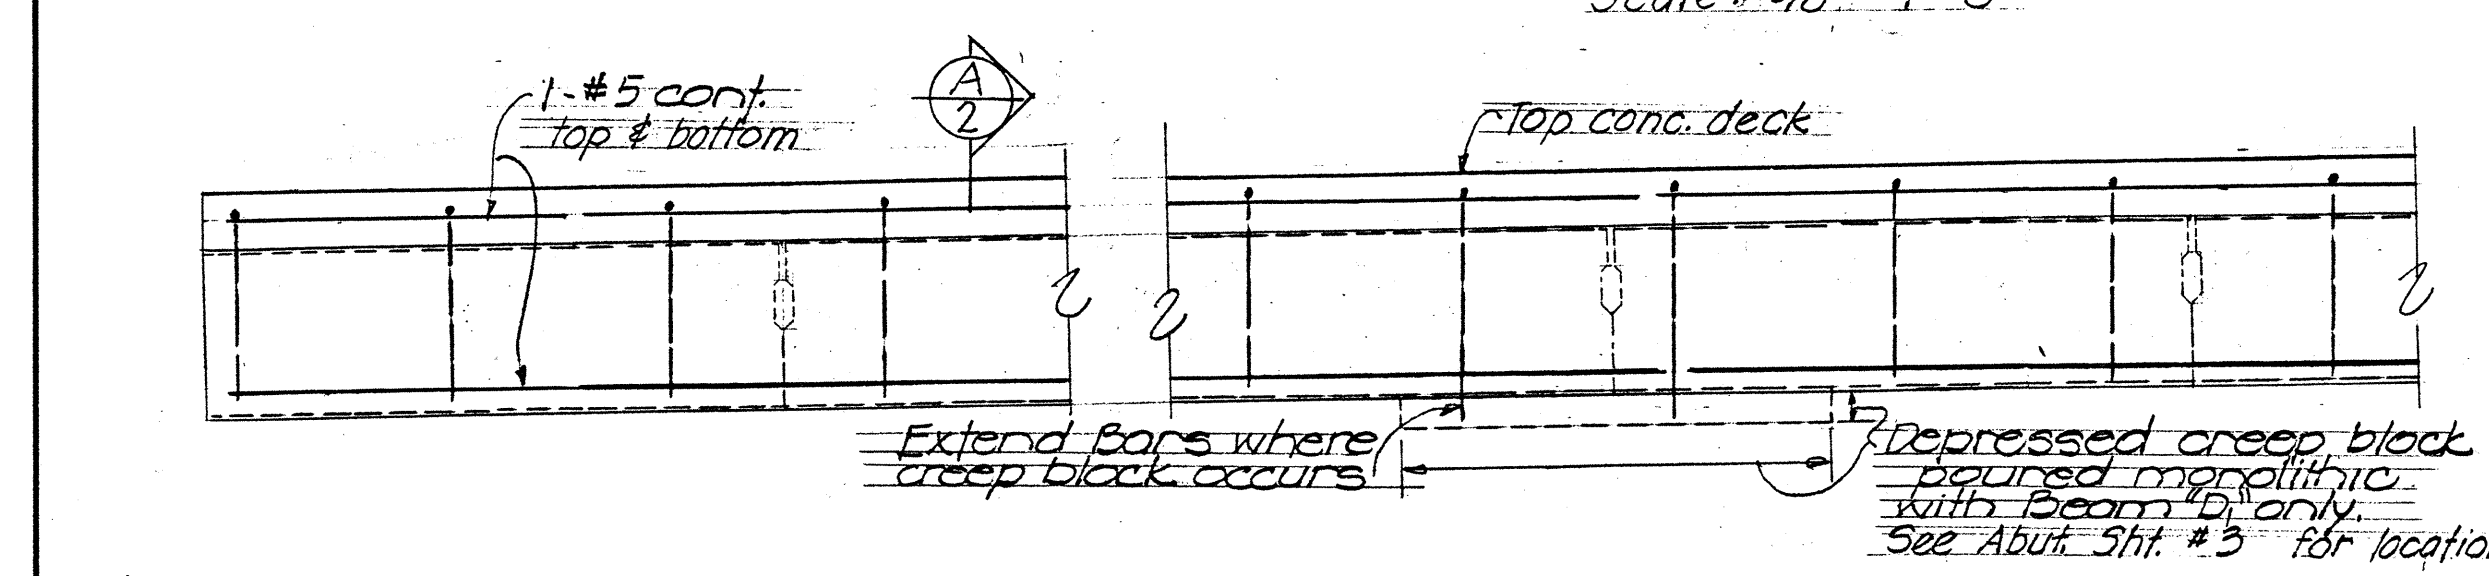


**ELEVATION BEAM "D" AS SHOWN
(BEAM "D" SIMILAR EXCEPT AS OTHERWISE NOTED)**
Scale: 3/4" = 1'-0"

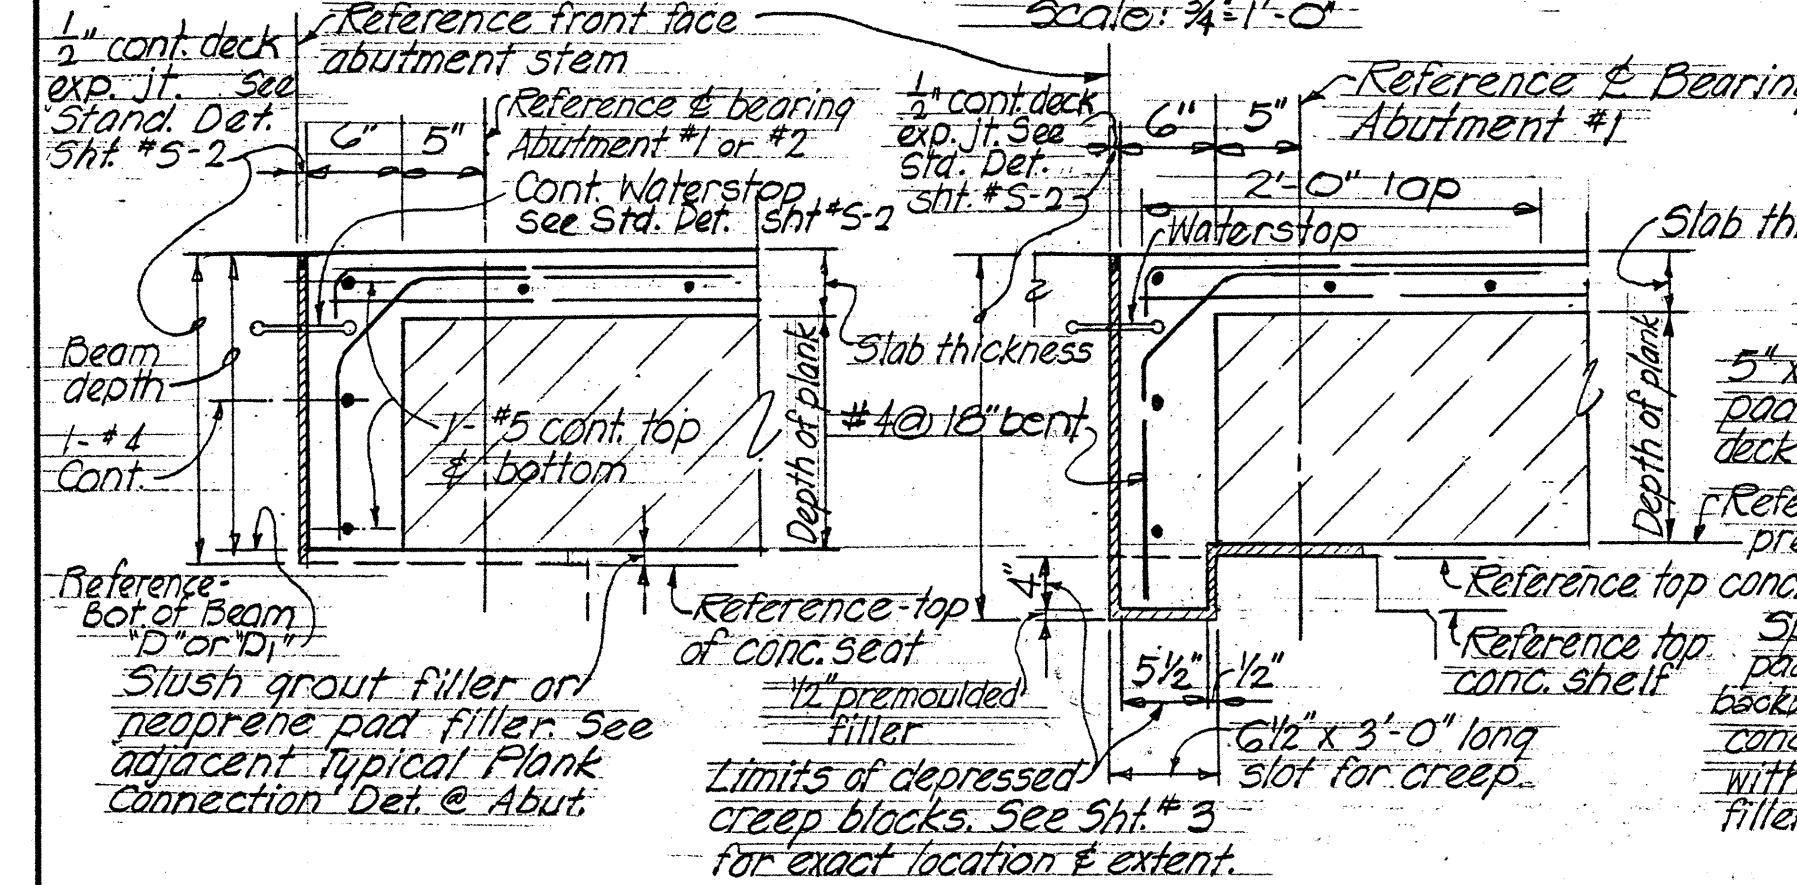


**TYPICAL SECTION (A)
Scale: 1" = 1'-0"**

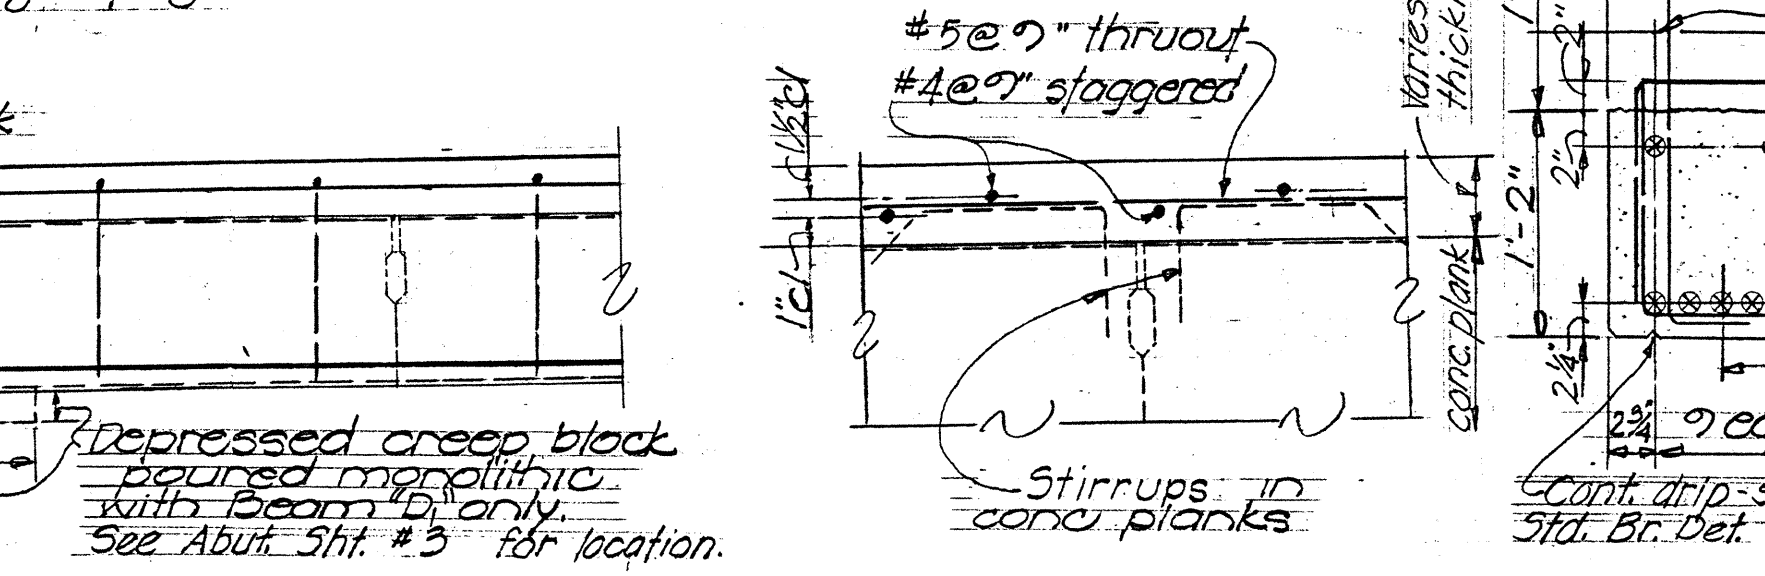


**DETAIL "A"
TYPICAL PLACEMENT TRANSVERSE
DECK SLAB REINFORCEMENT**
Scale: 3/4" = 1'-0"

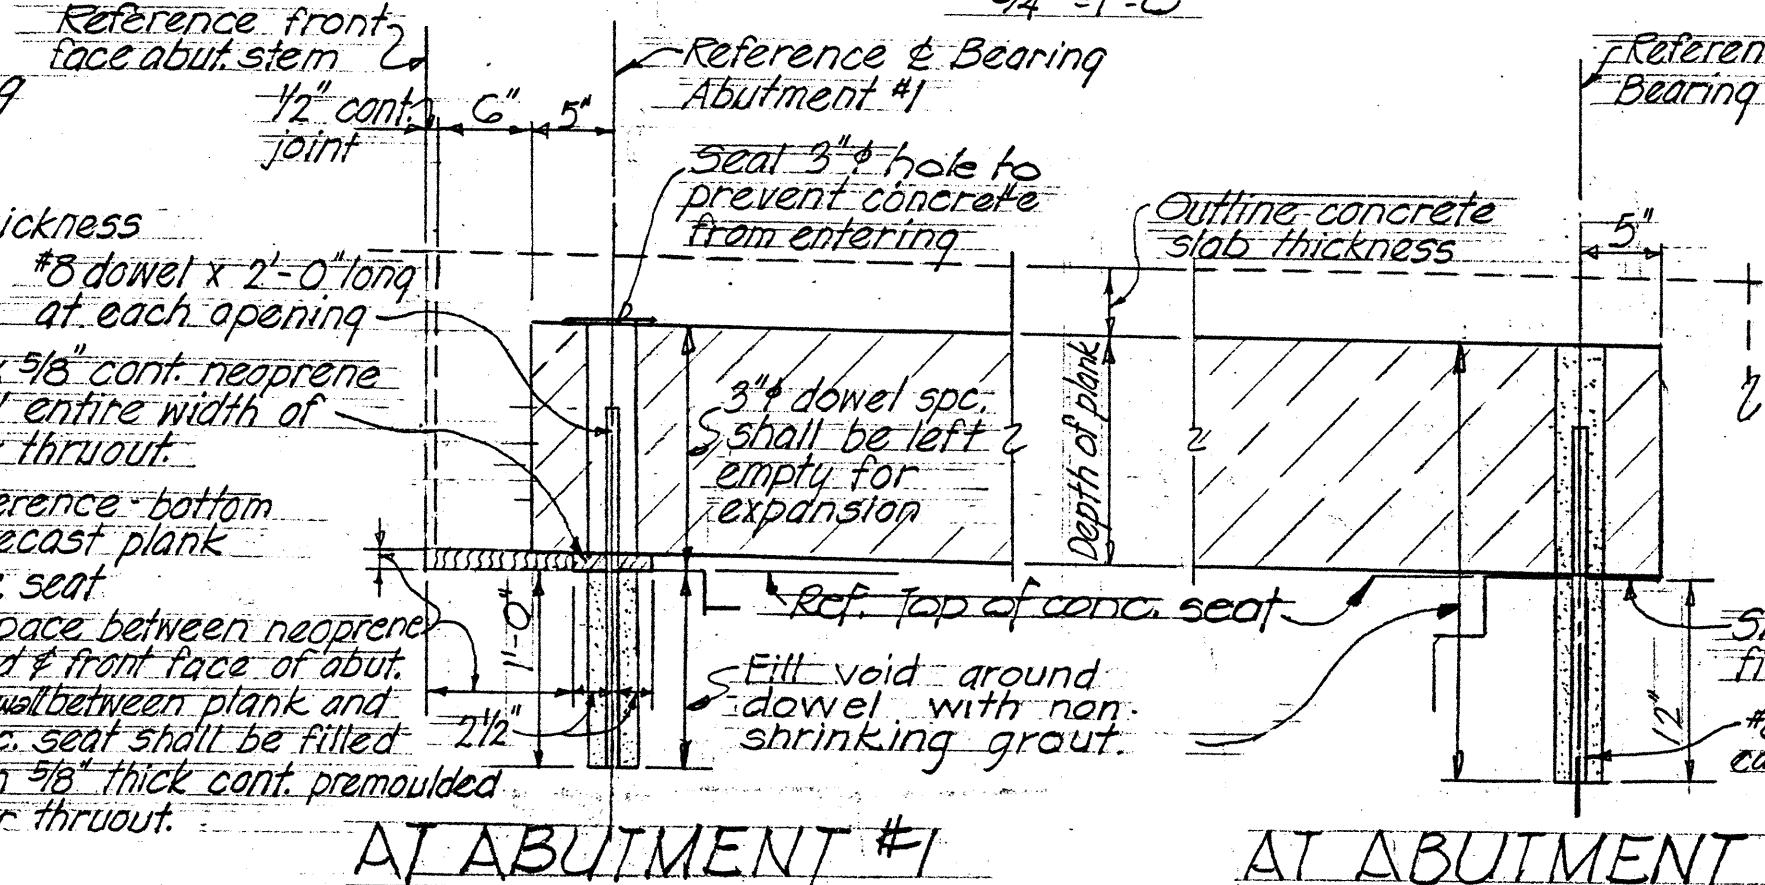


**AT ABUTMENT #1
TYPICAL DETAIL ~ PRESTRESSED PLANK
CONNECTION TO ABUTMENTS**
Scale: 1" = 1'-0"

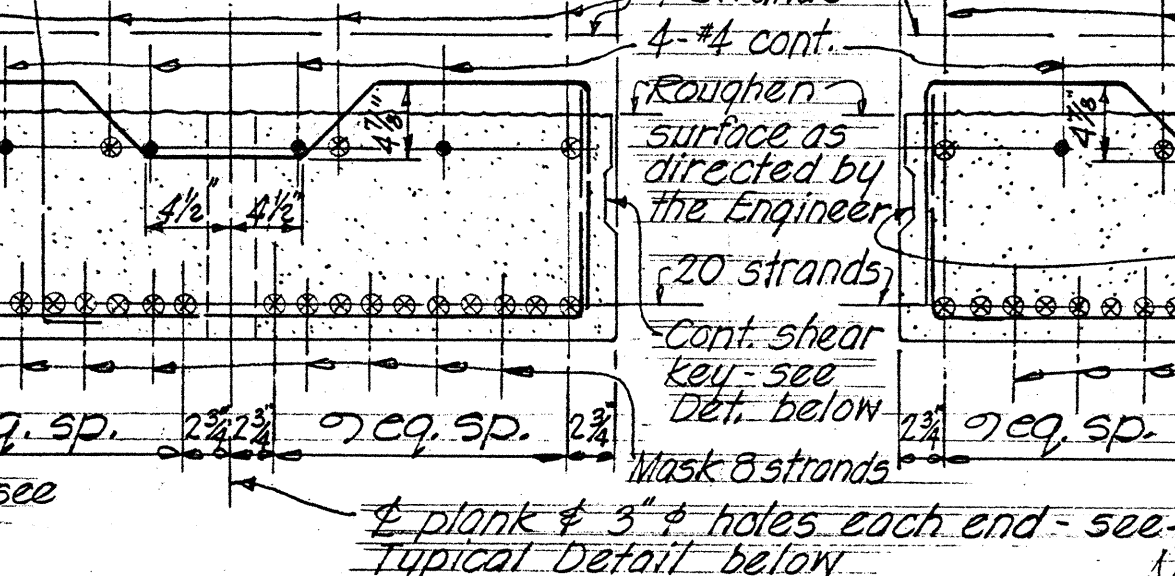


**AT ABUTMENT #2
TYPICAL DETAIL ~ PRESTRESSED PLANK
CONNECTION TO ABUTMENTS**
Scale: 1" = 1'-0"

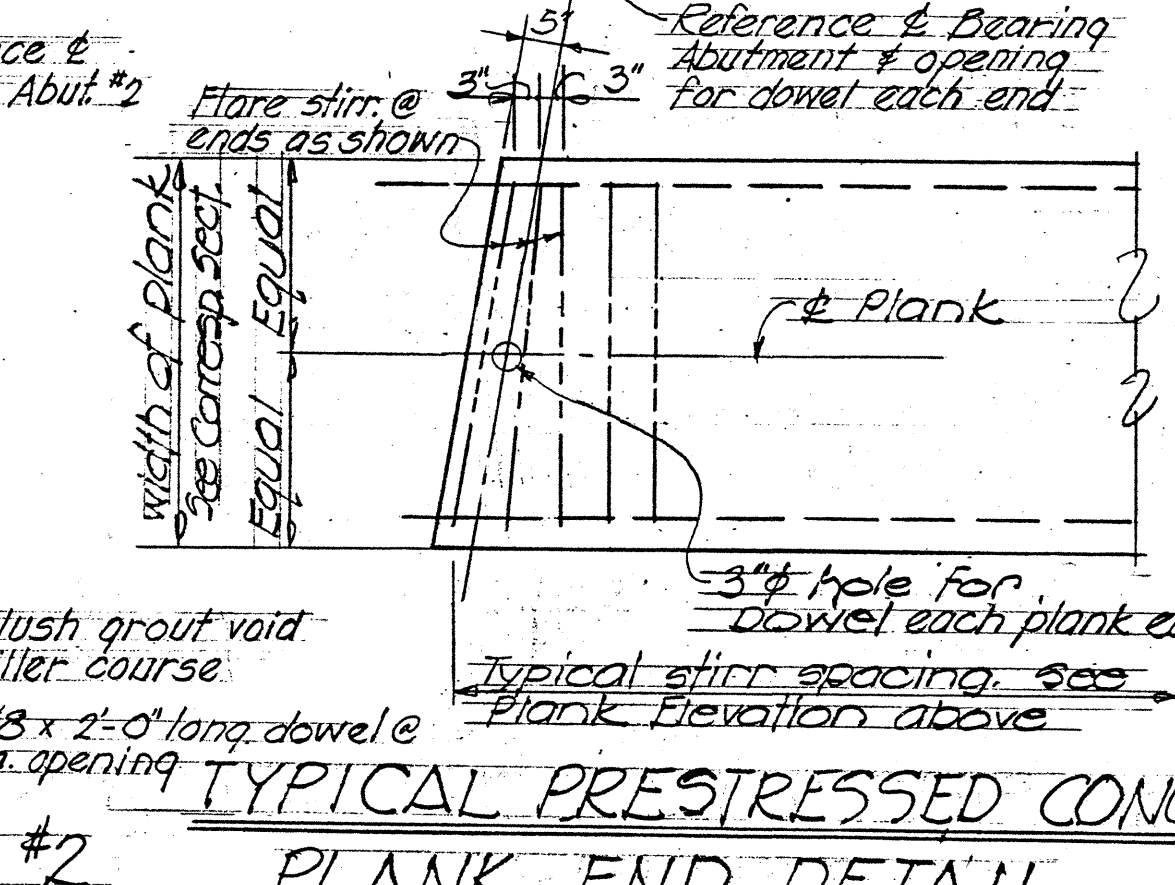


**TYPICAL PRESTRESSED CONCRETE
PLANK END DETAIL**
Scale: 1/2" = 1'-0"

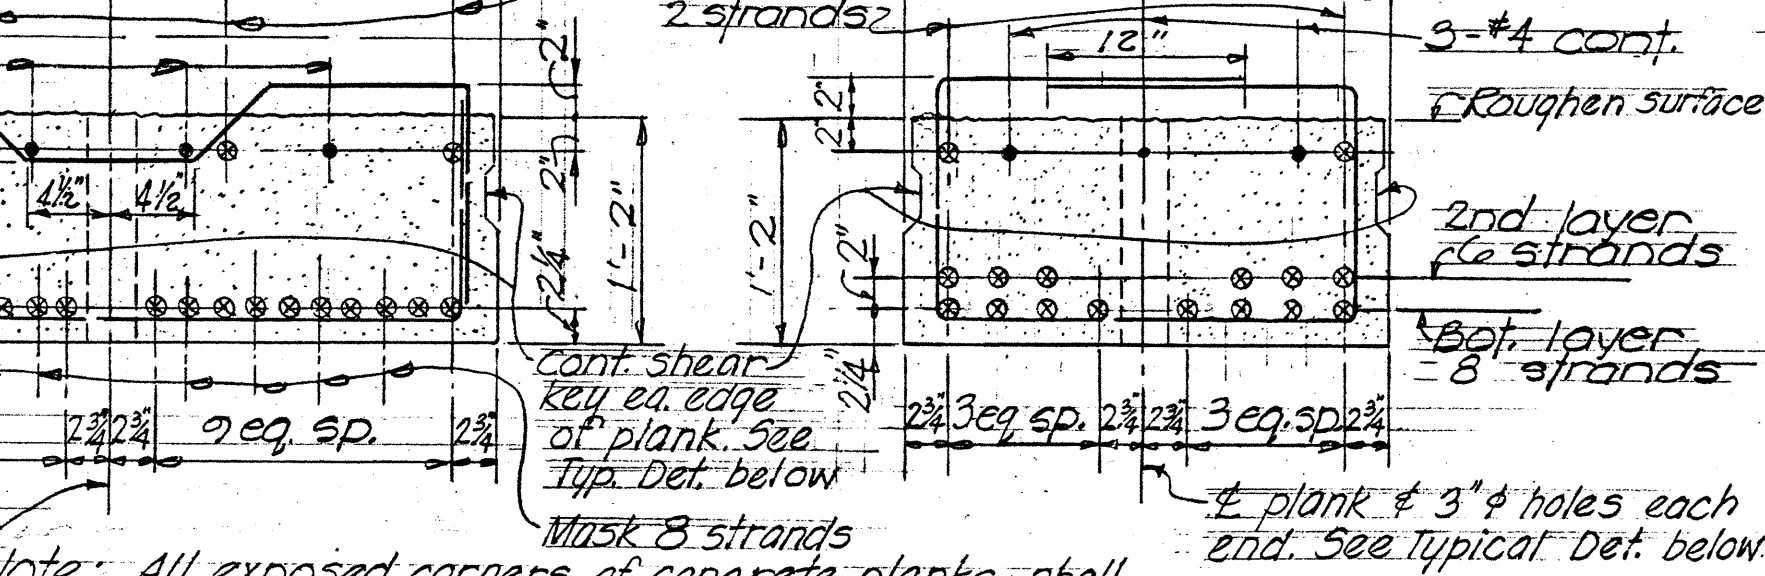

TYPICAL PRESTRESSED CONCRETE PLANK SECTIONS
Scale: 1" = 1'-0"

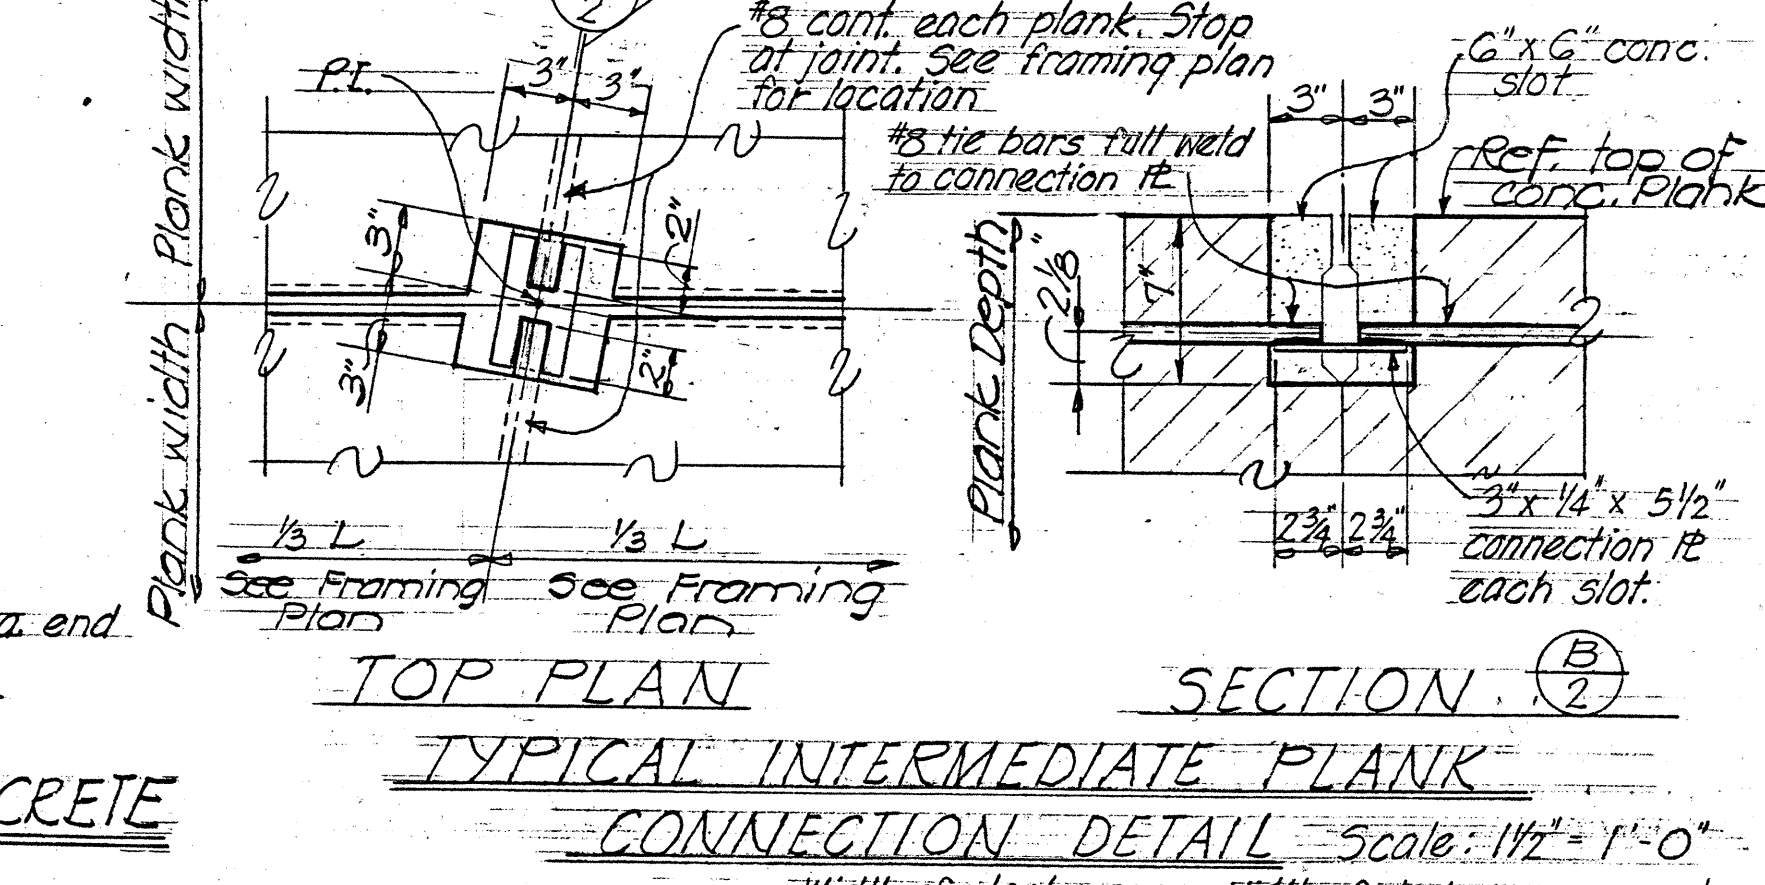

**TYPICAL INTERMEDIATE PLANK
CONNECTION DETAIL**
Scale: 1 1/2" = 1'-0"

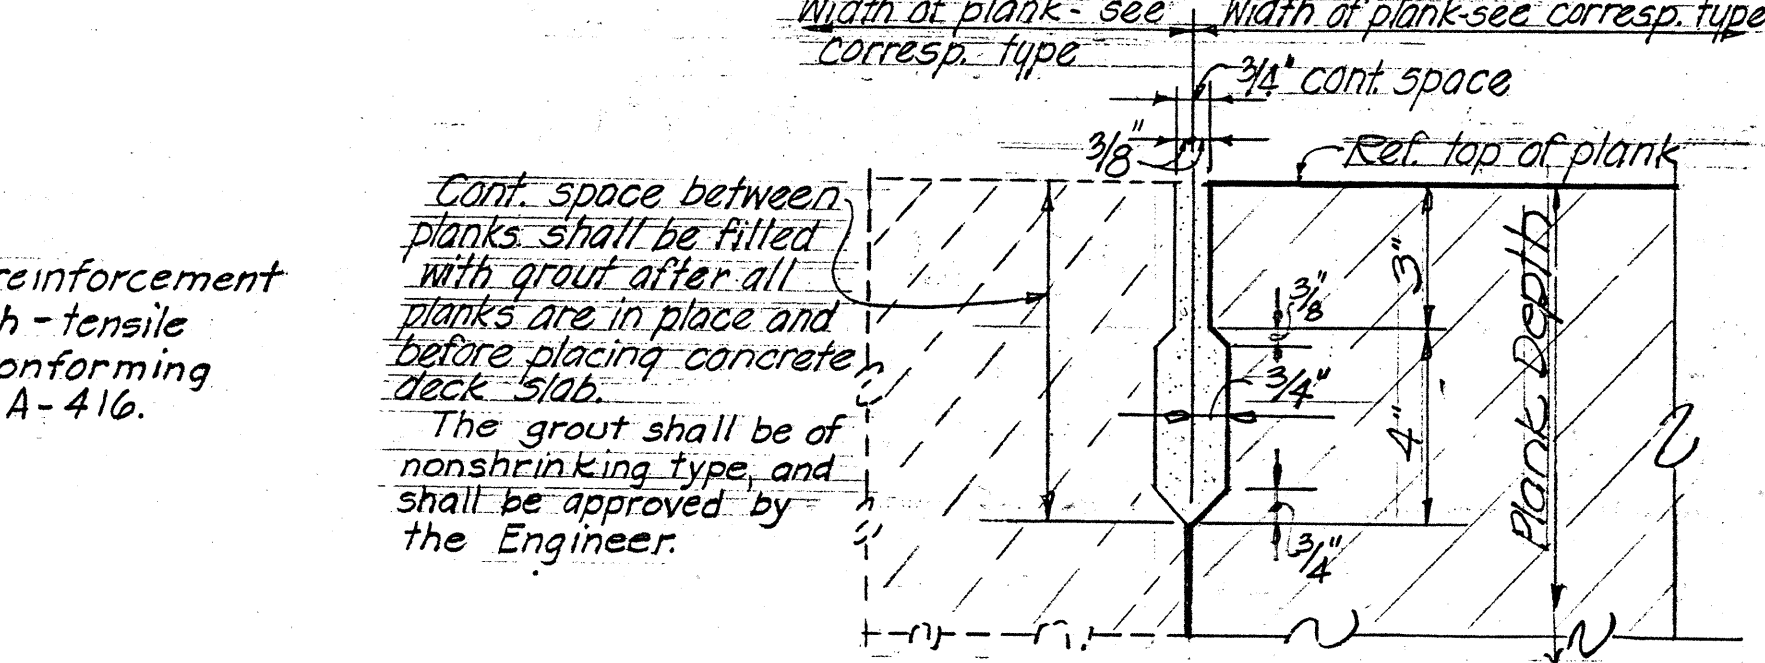


SHEAR KEY DETAIL
Scale: 3/4" = 1'-0"

NOTE: All prestressing reinforcement shall be 1/2" diameter, high-tensile stress-relieved strand, conforming to ASTM Designation: A-416.

PALEHUA SEPARATION
For information only
(Reduction not to scale)


STATE OF HAWAII
DEPARTMENT OF TRANSPORTATION
HIGHWAYS DIVISION
**PALEHUA SEPARATION
SECTIONS & PRESTRESSED CONC. DET.**
E 57A 207+32.10 TO E 57A 207+67.90
F.A.I. Proj. 1H1-11(18) PALEHUA RD. TO KUNIA RD.
Nov. 1964
SHEET No. 02 OF 07 SHEETS

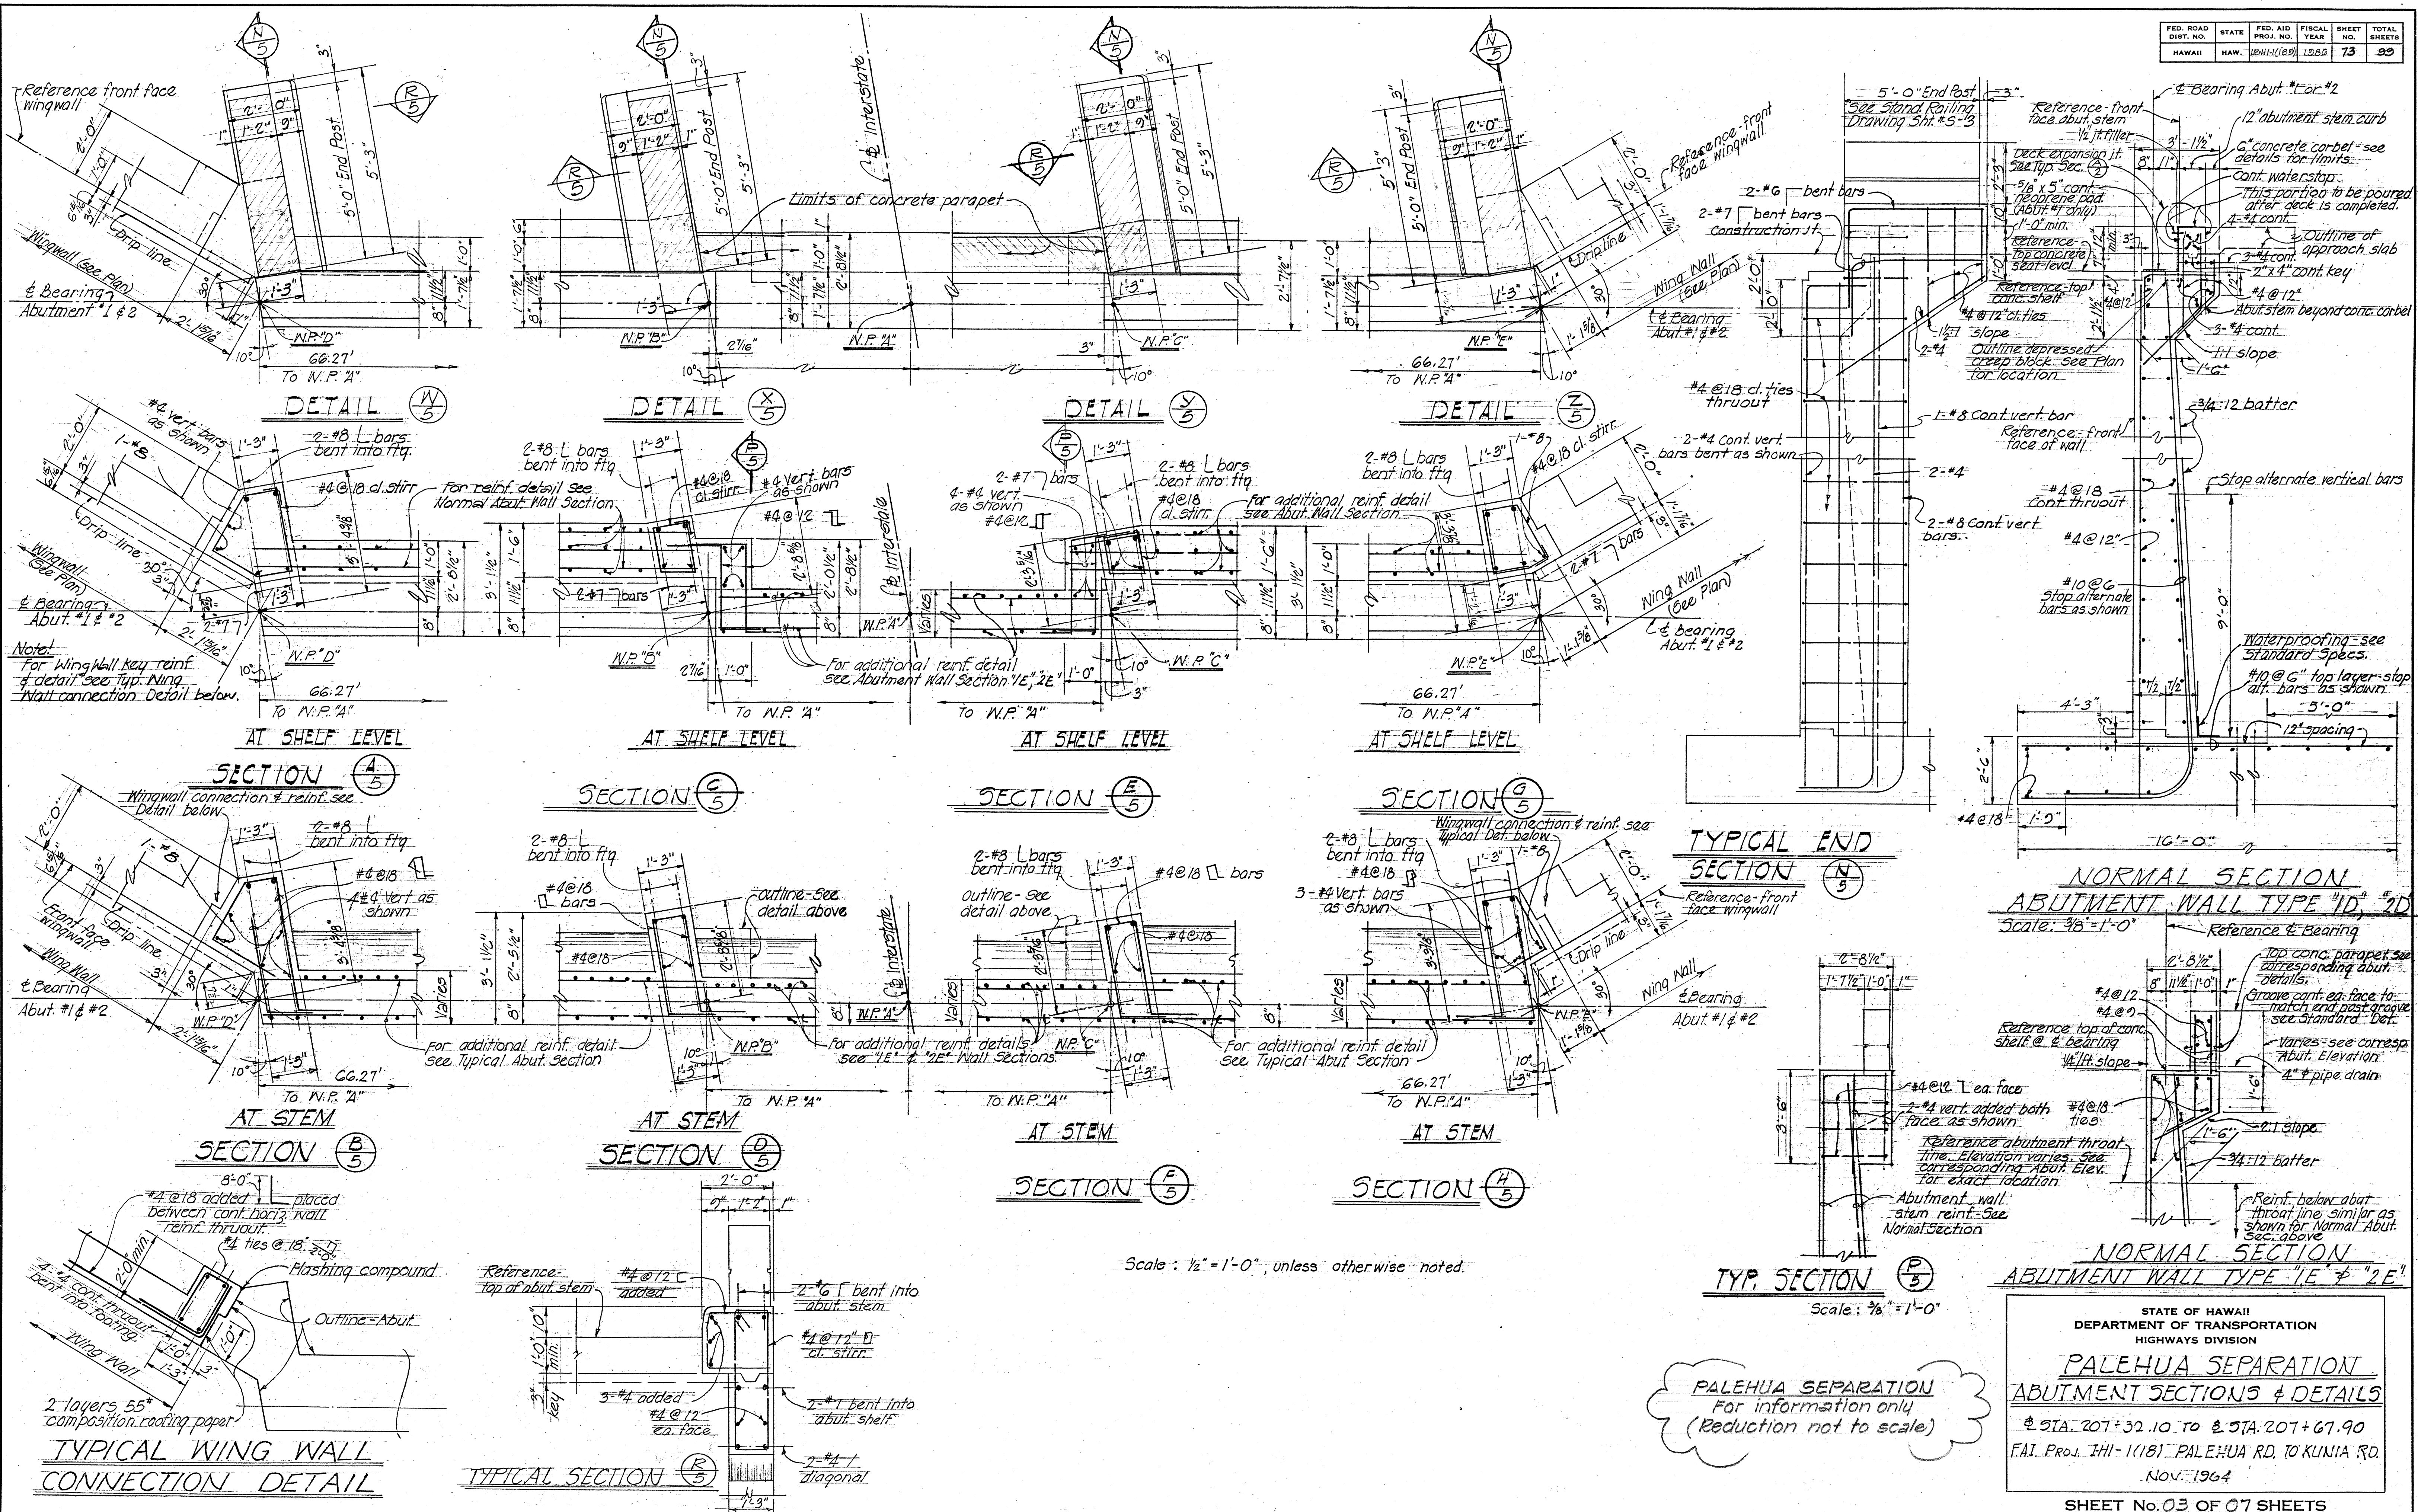

SURVEY PLOTTED BY: *Nov. 1966*
 DRAWN BY: *J.S.K.*
 CHECKED BY: *J.D. L.A.*
 NOTE BOOK
 NO.

PALEHUA SEPARATION
 For information only
 (Reduction not to scale)

STATE OF HAWAII
 DEPARTMENT OF TRANSPORTATION
 HIGHWAYS DIVISION
PALEHUA SEPARATION
ABUTMENT SECTIONS & DETAILS
 STA. 207+32.10 TO STA. 207+67.90
 F.A.I. Proj. IHI-1(18) PALEHUA RD. TO KUNIA RD.
 NOV. 1964
 SHEET No. 03 OF 07 SHEETS



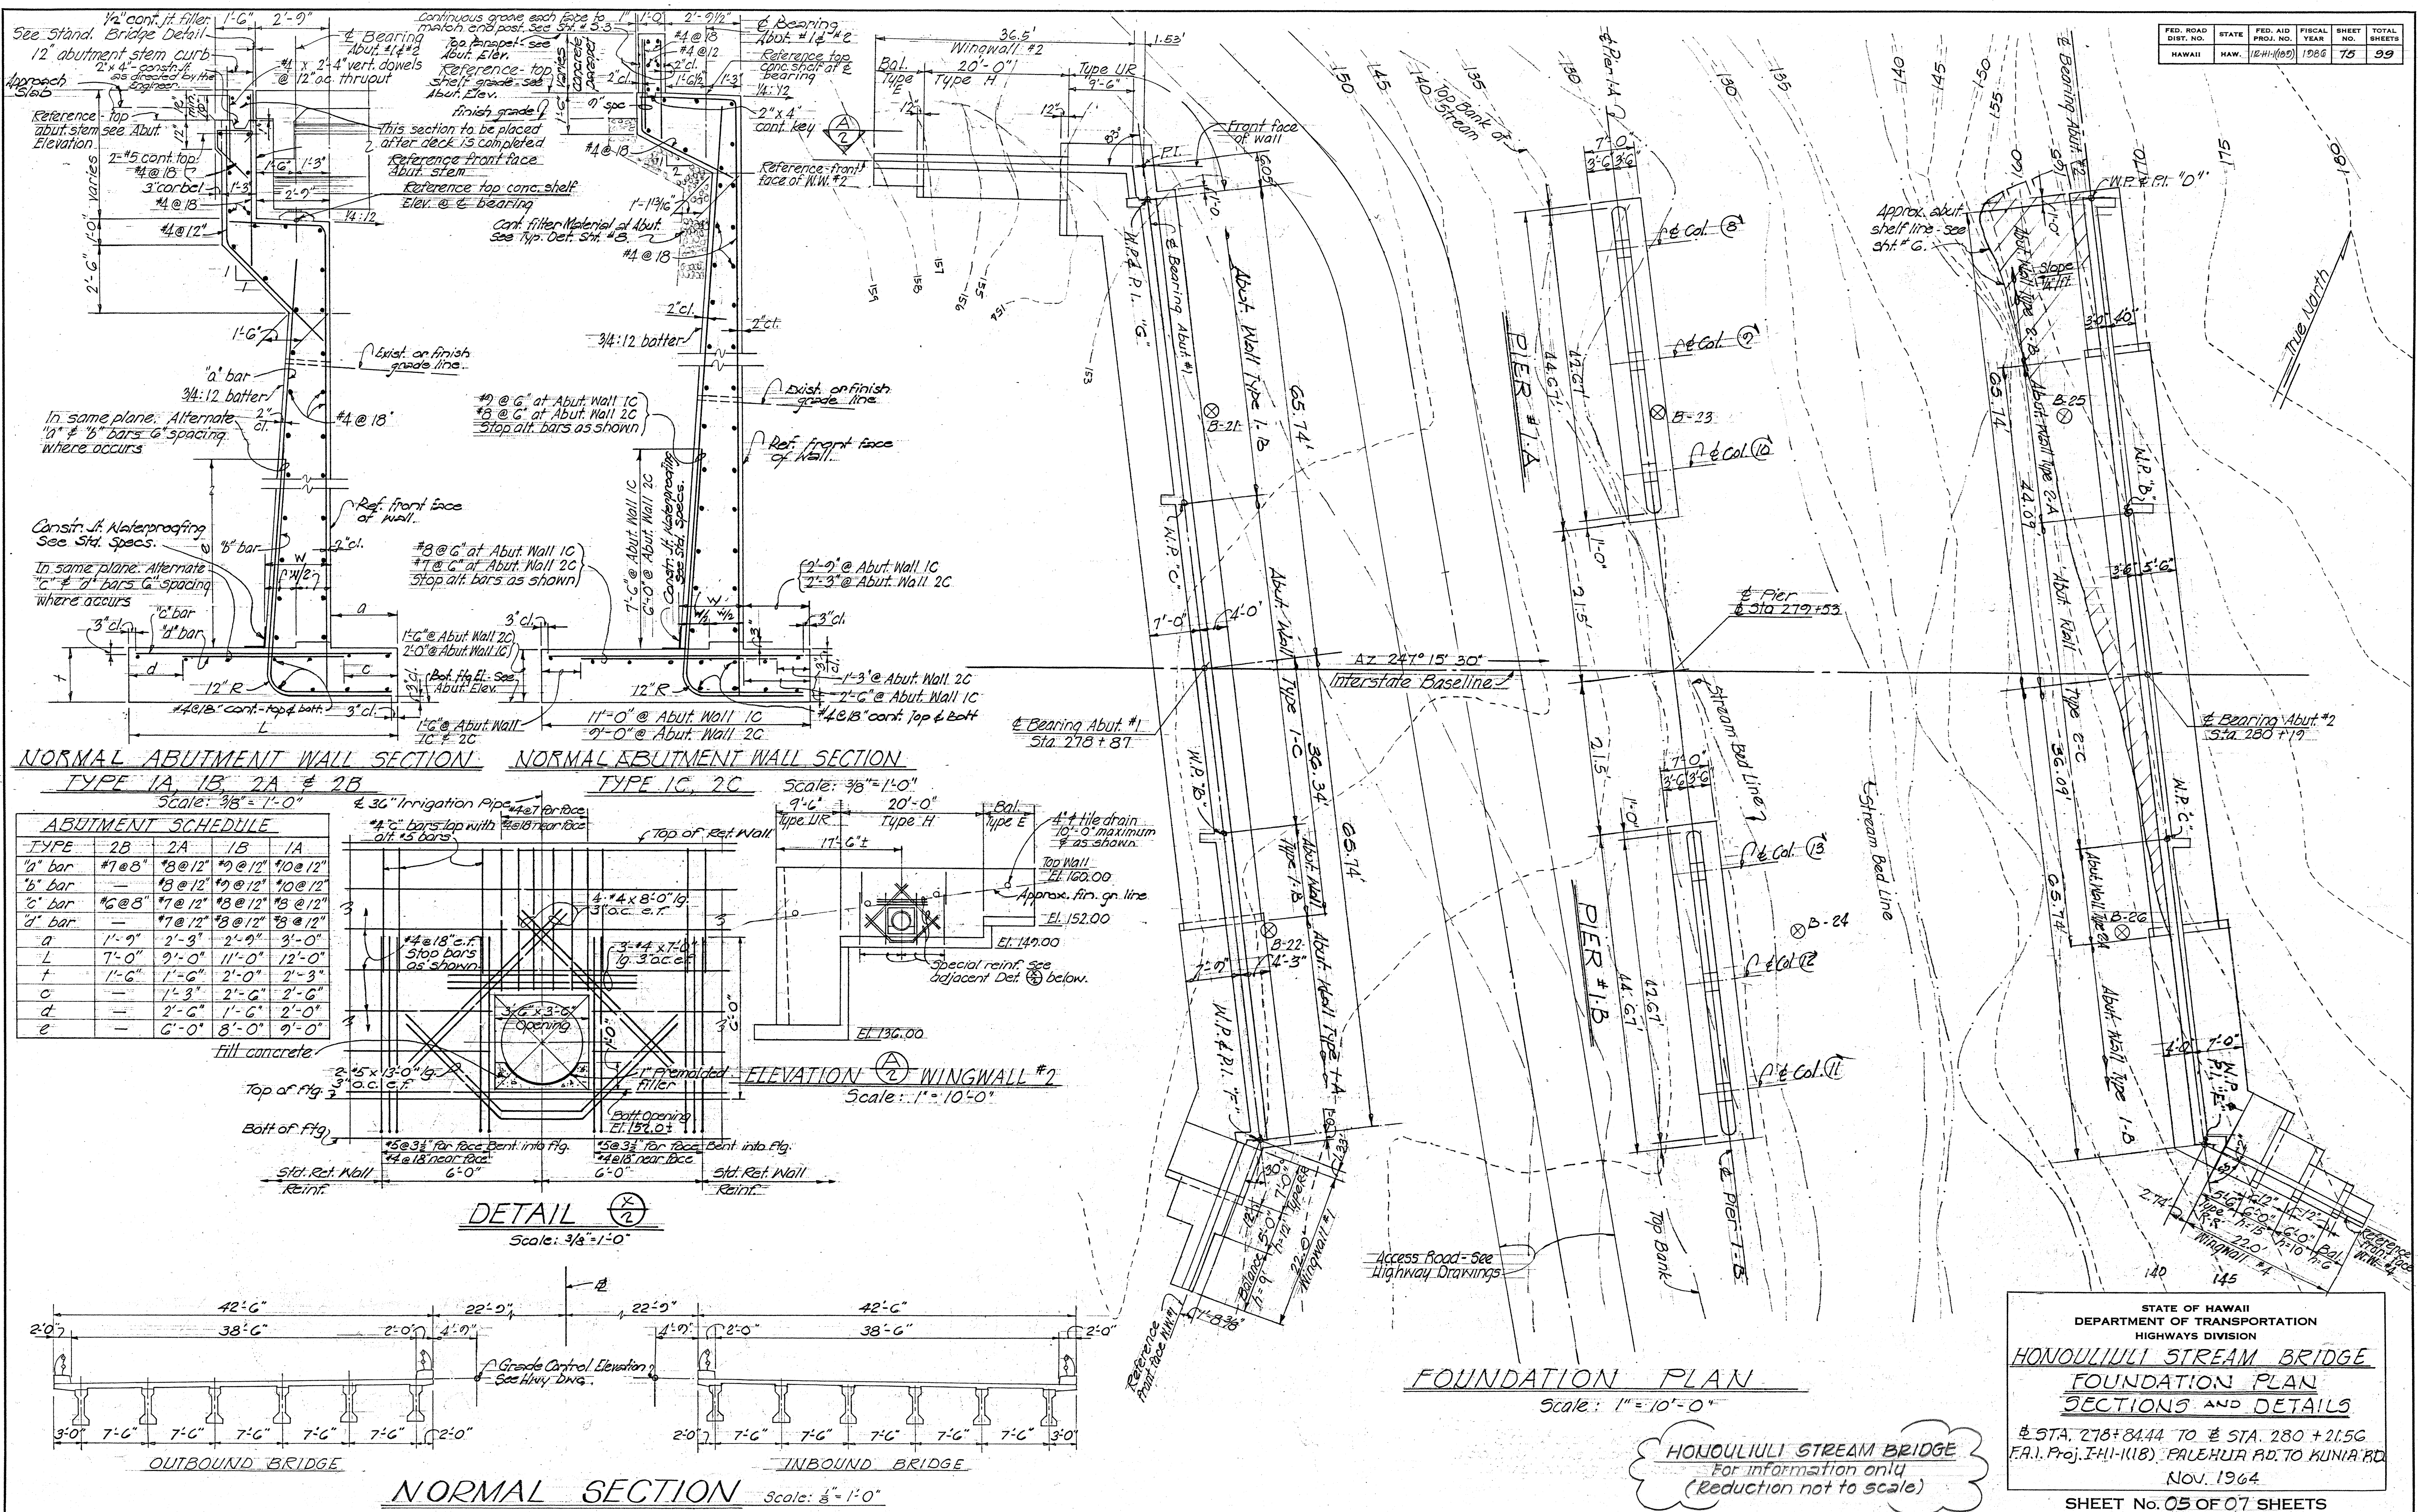


STATE OF HAWAII
DEPARTMENT OF TRANSPORTATION
HIGHWAYS DIVISION

HONOLULI STREAM BRIDGE
FOUNDATION PLAN
SECTIONS AND DETAILS

± STA. 278+84.44 TO ± STA. 280+21.56
F.A.I. Proj. I-41-118) PALEHUA RD. TO KUNIA RD.
NOV. 1964





SHEET No. 05 OF 07 SHEETS

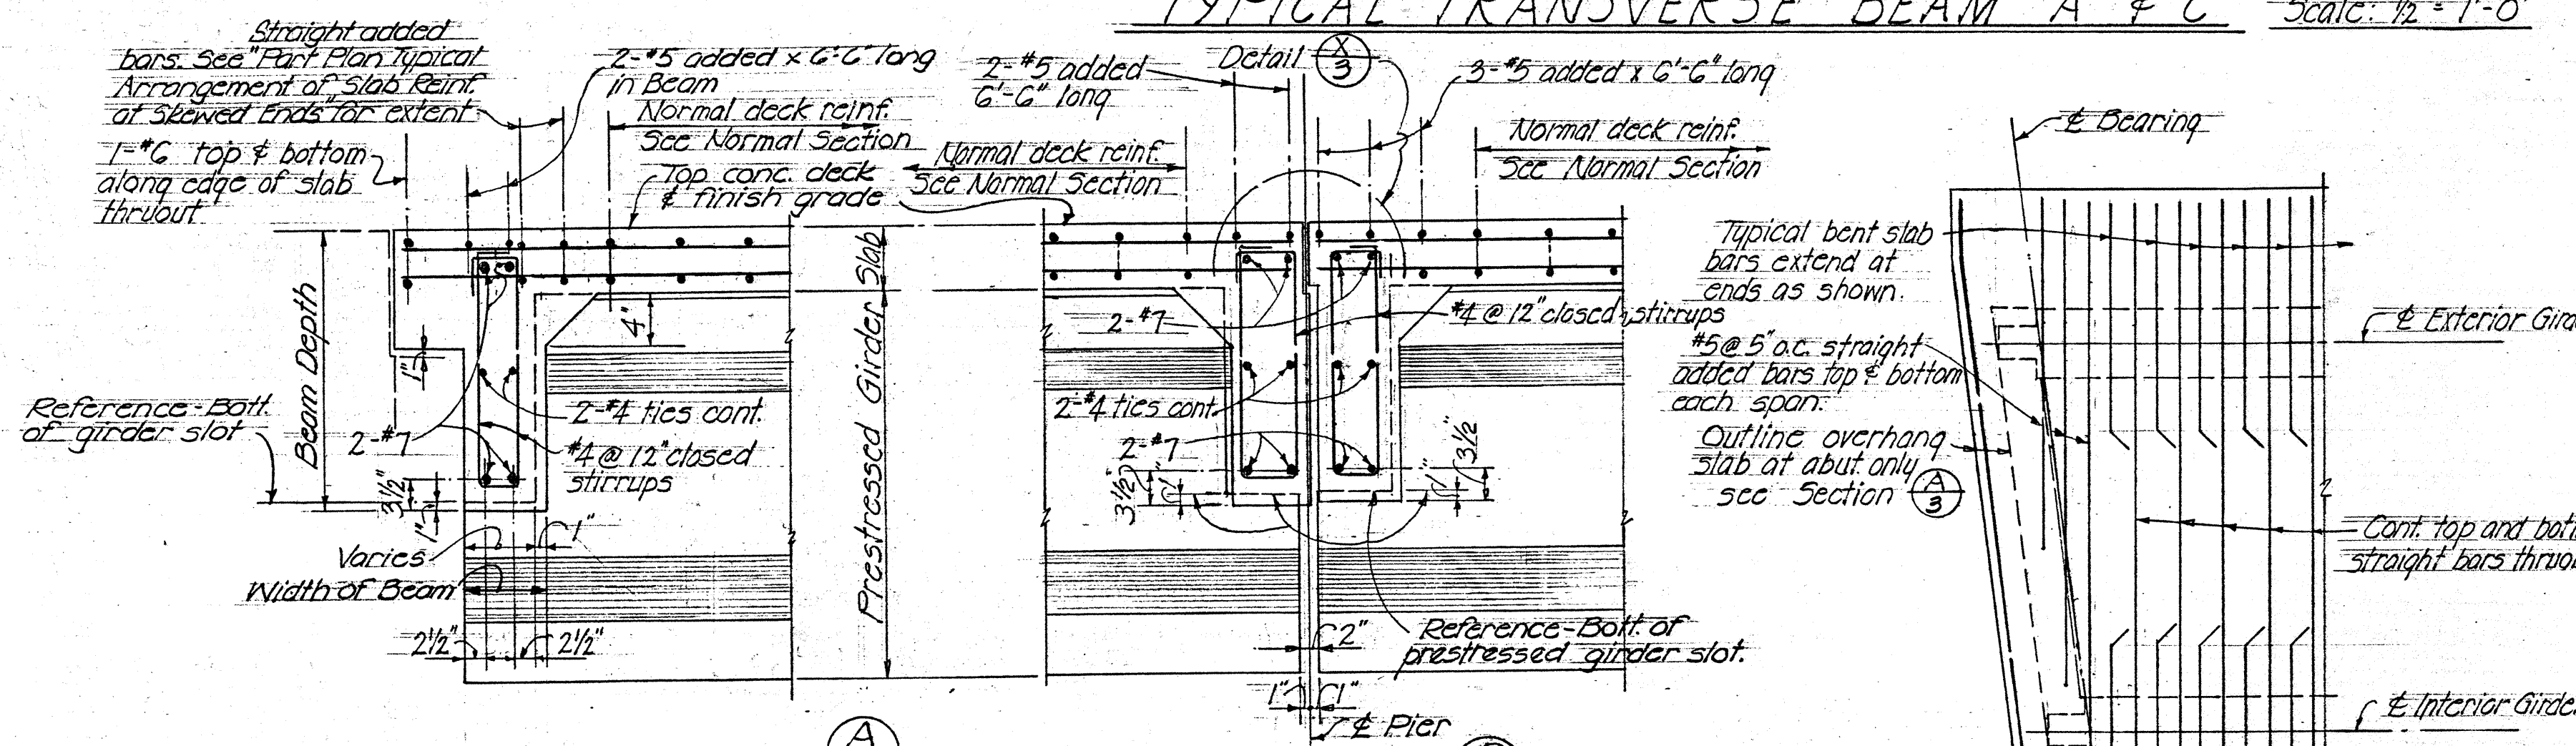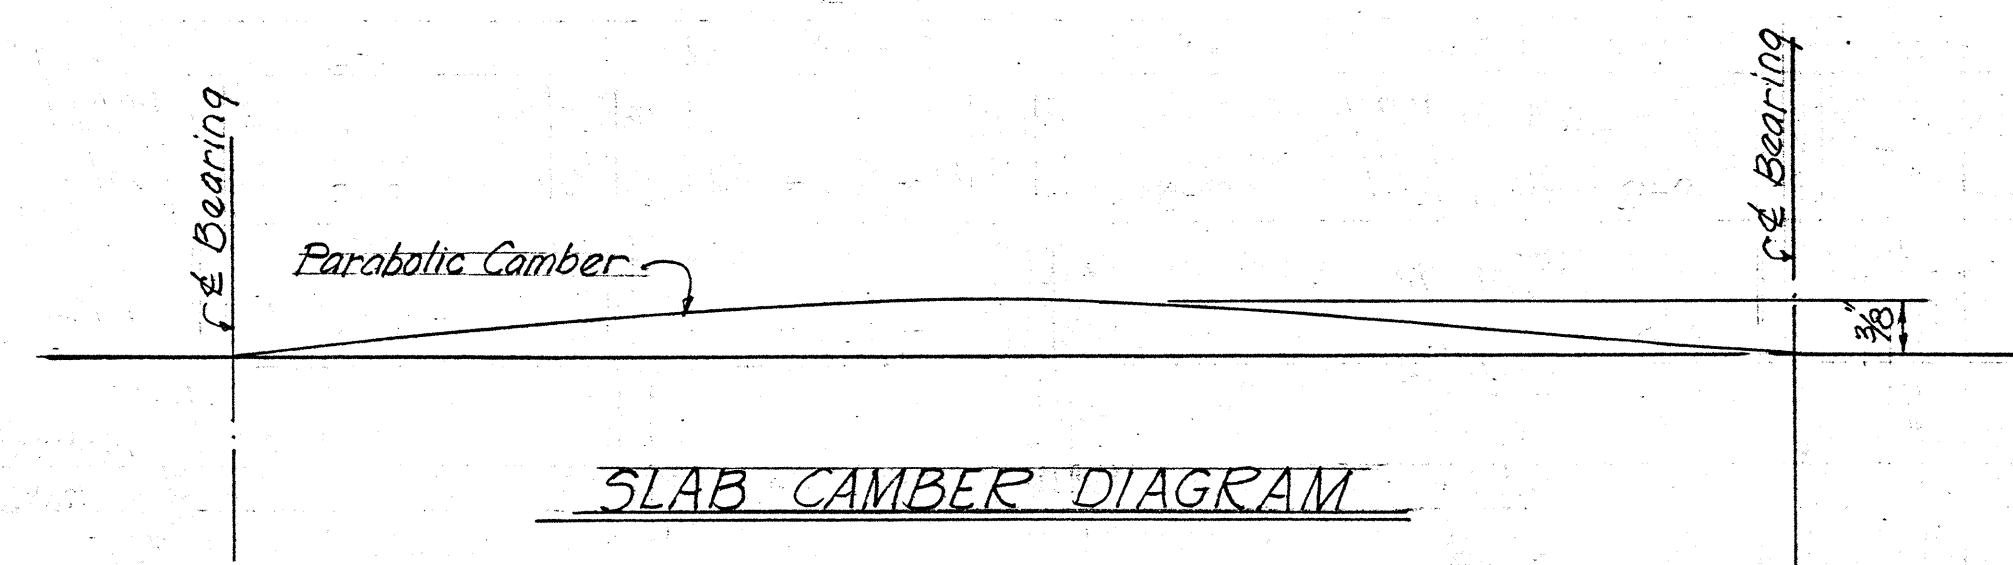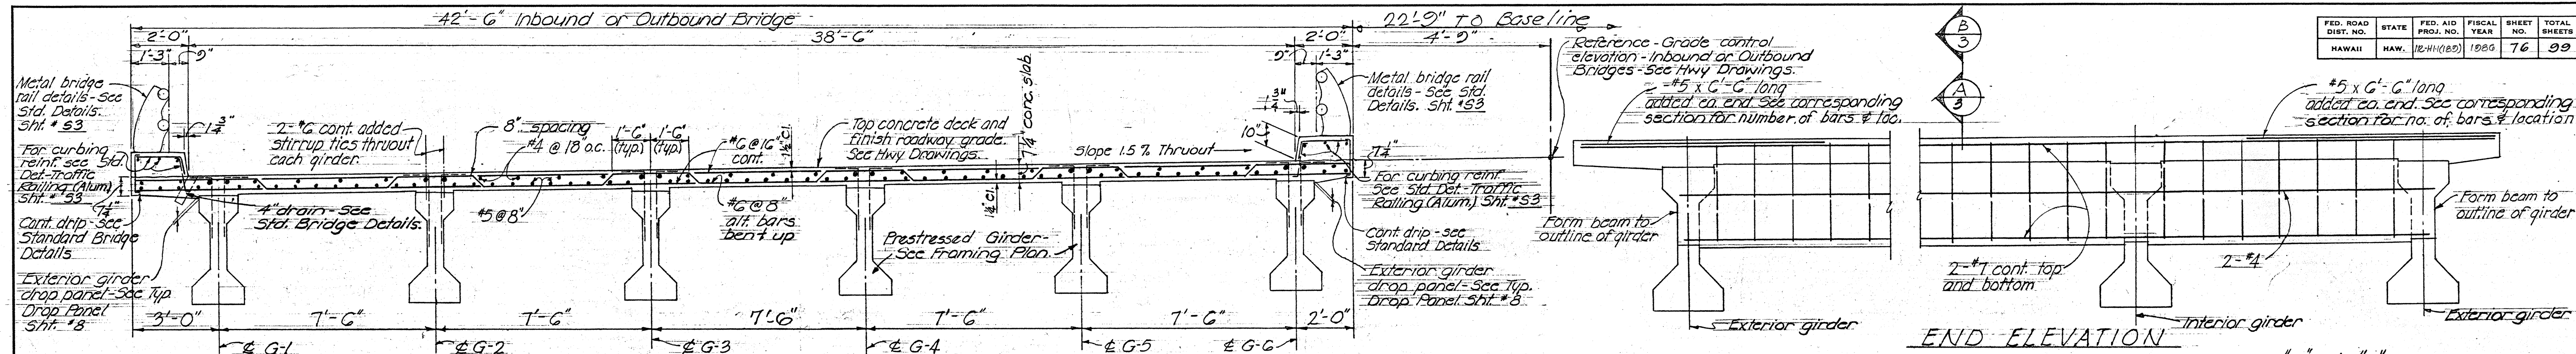

SECTION (A)
(BEAM "A")




SECTION (C)
(BEAM "C")

Note: Weld it incidental to prestressed girder & not paid for separately.

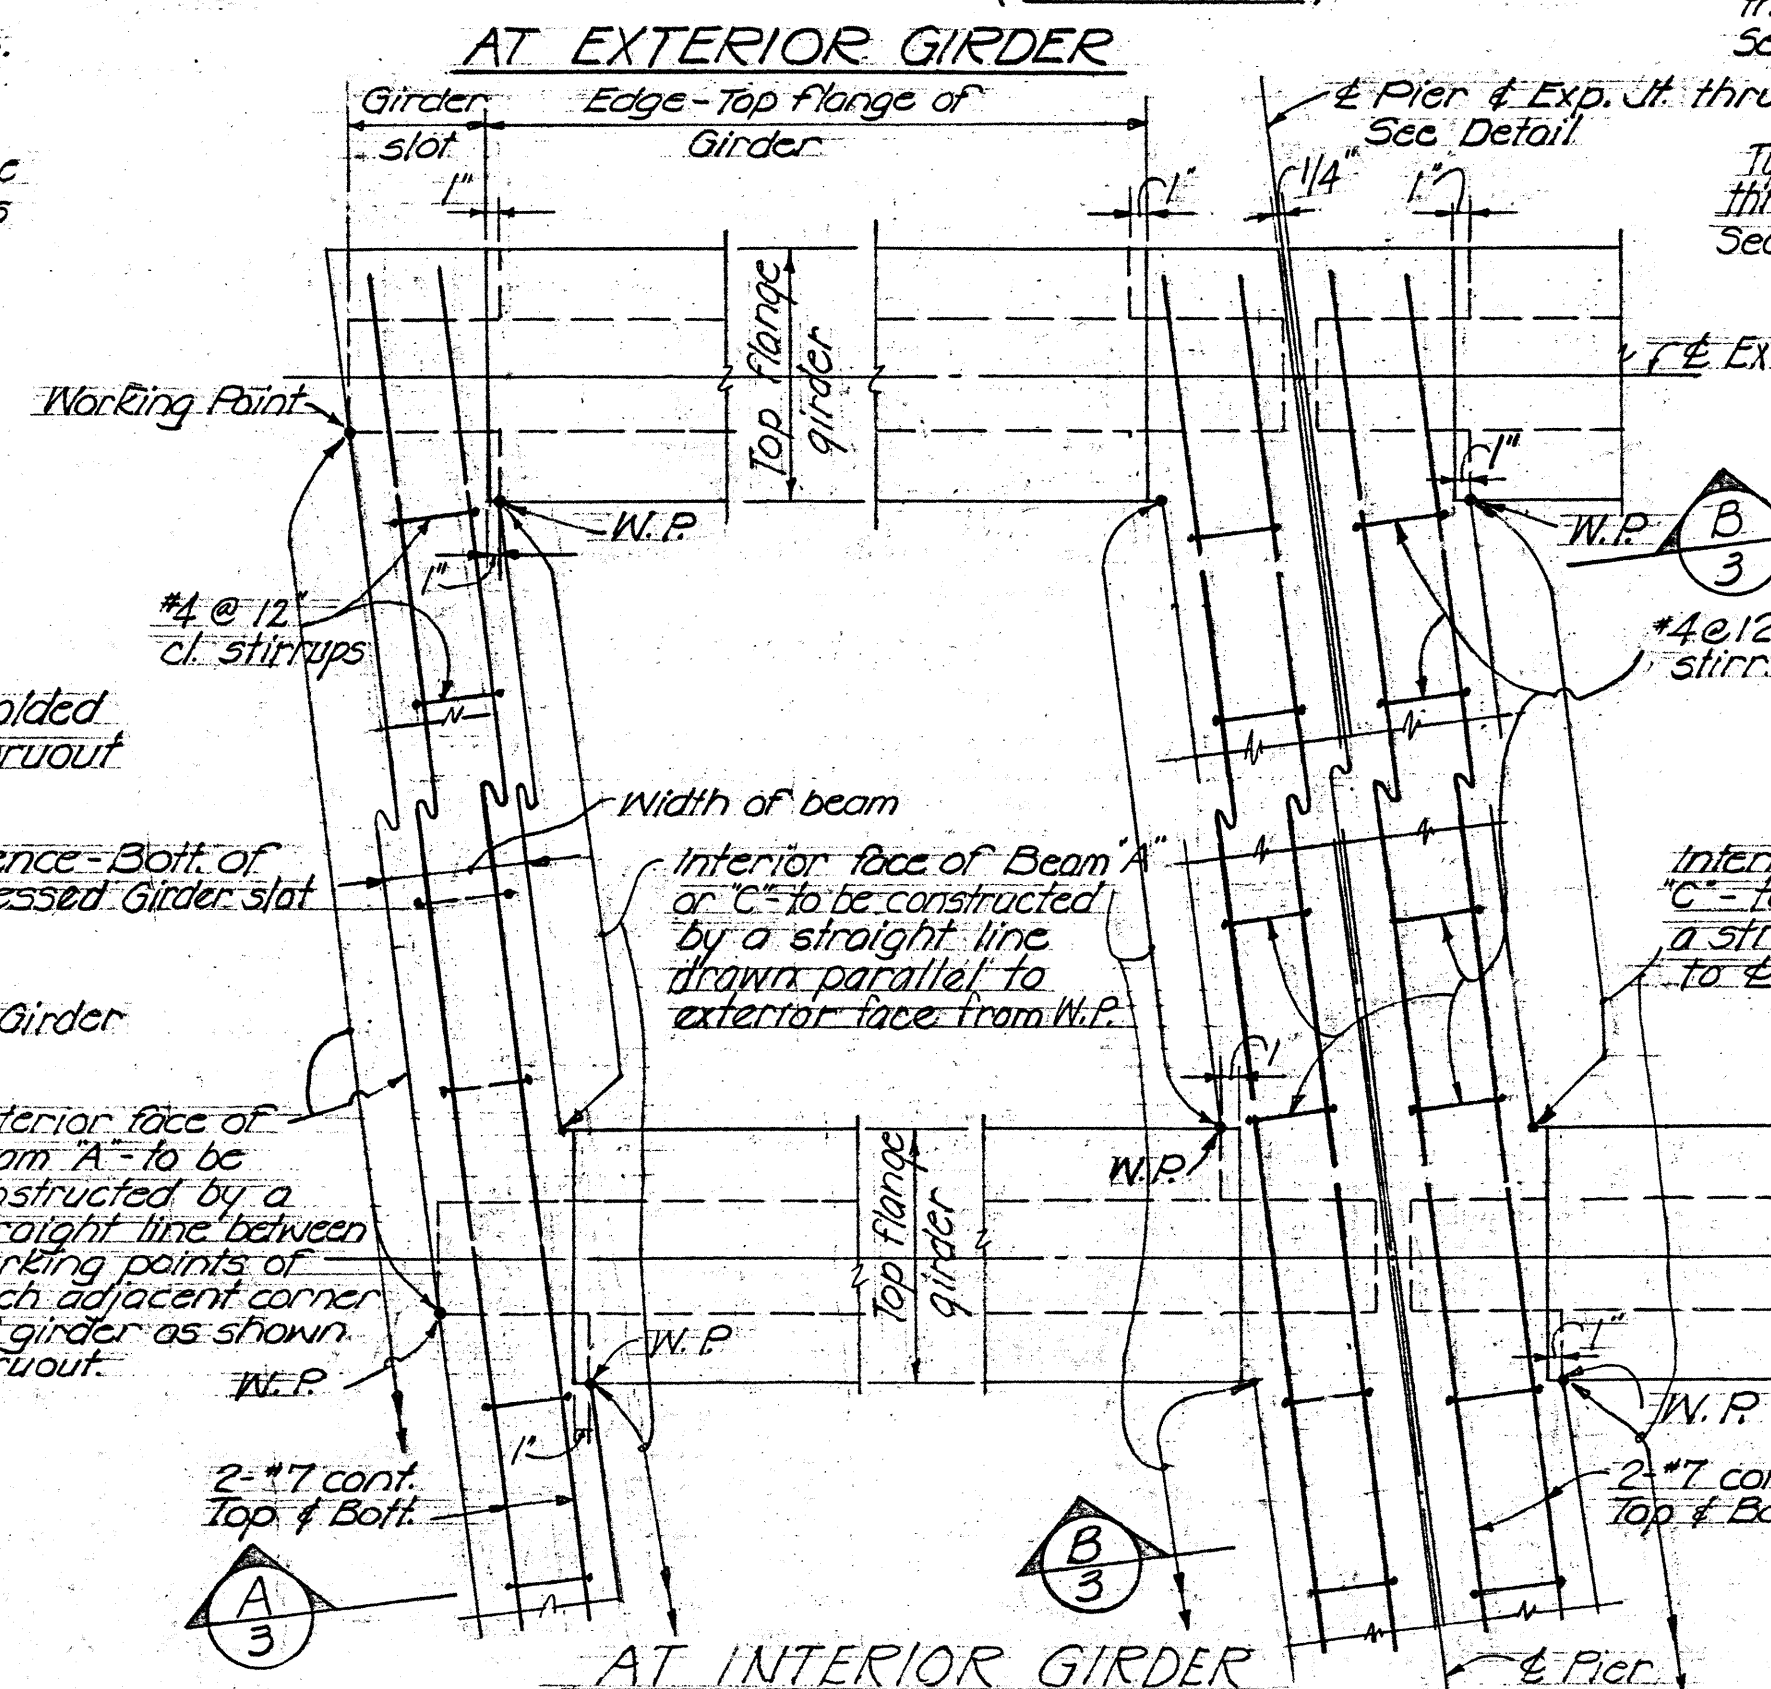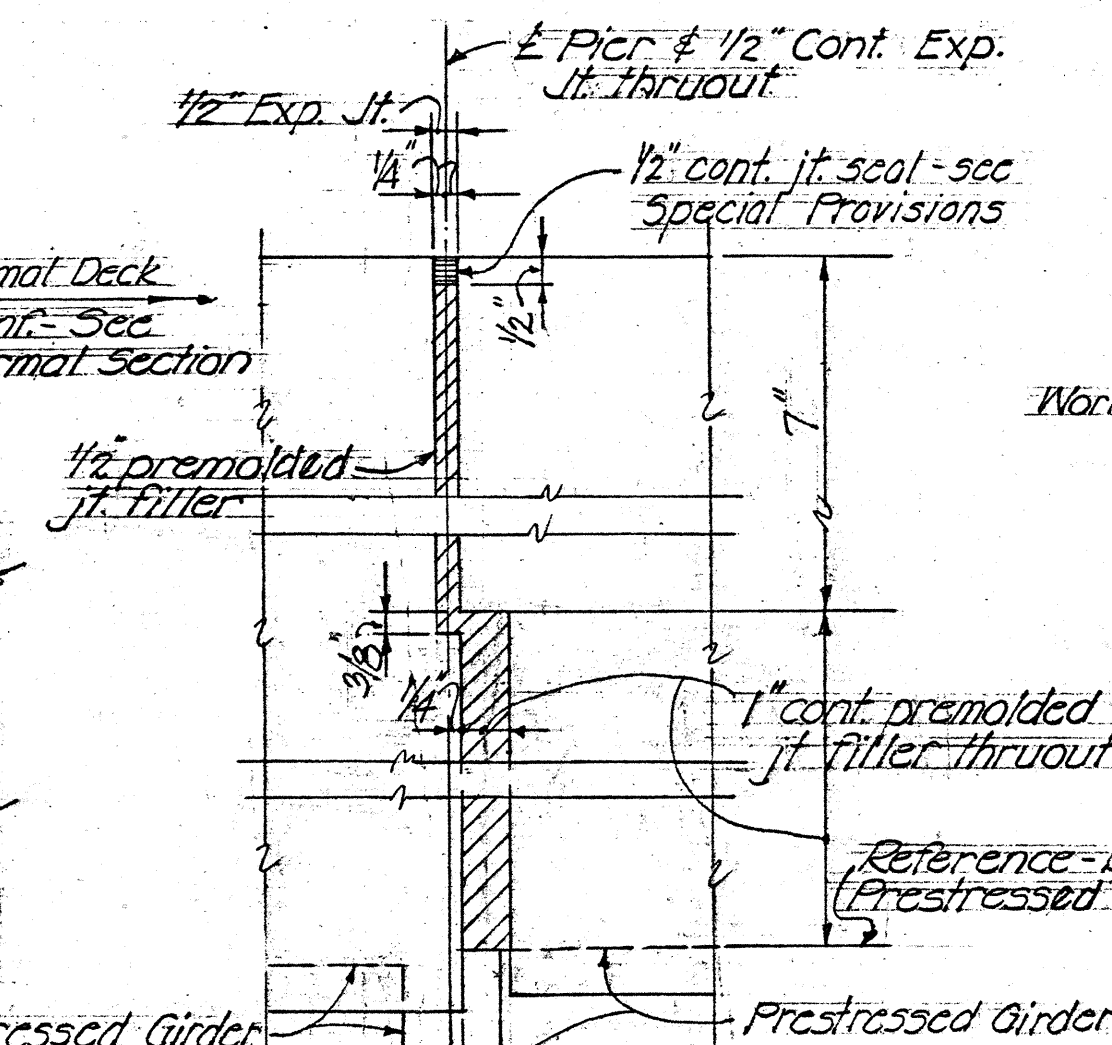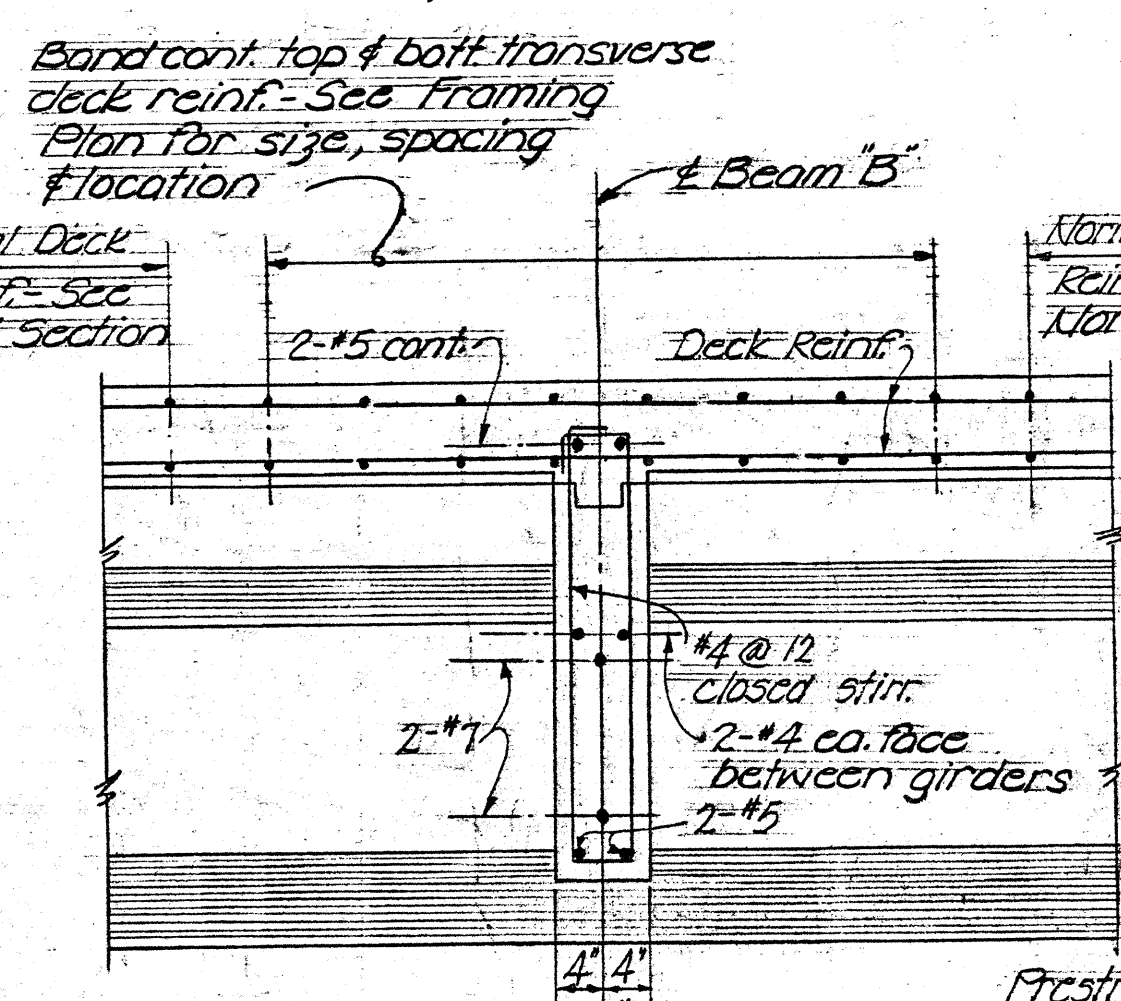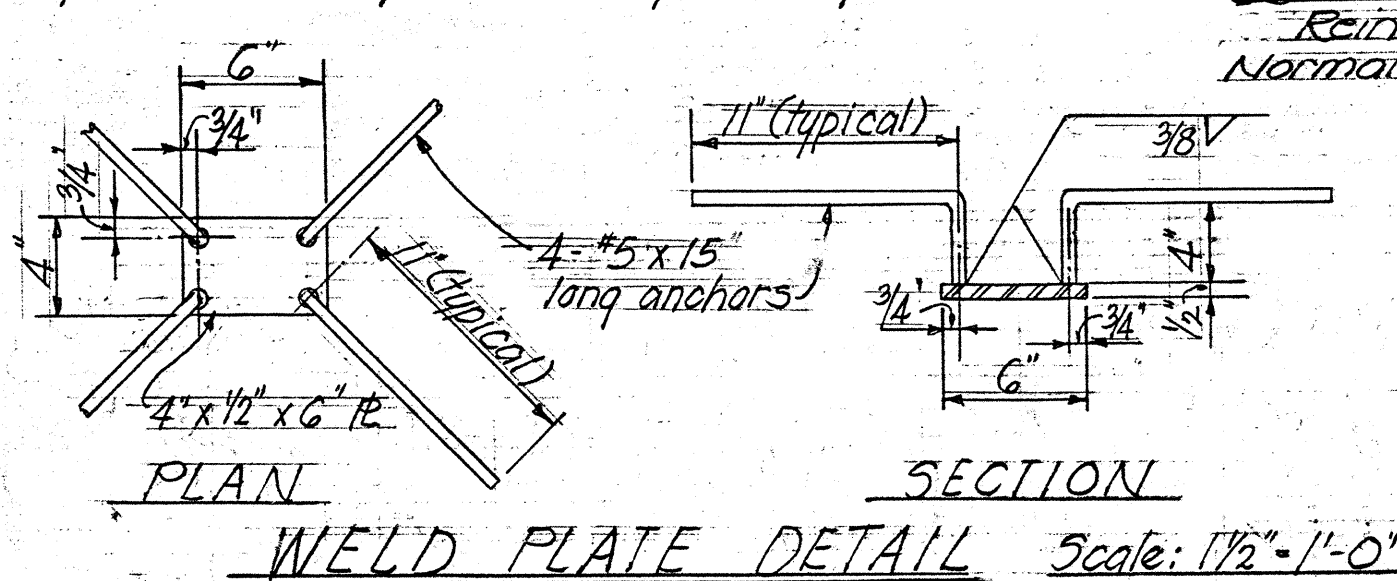

PART PLAN
TYPICAL ARRANGEMENT OF TRANSVERSE SLAB REINFORCEMENT AT SKEWED ENDS

HONOLULU STREAM BRIDGE
For information only
(Reduction not to scale)

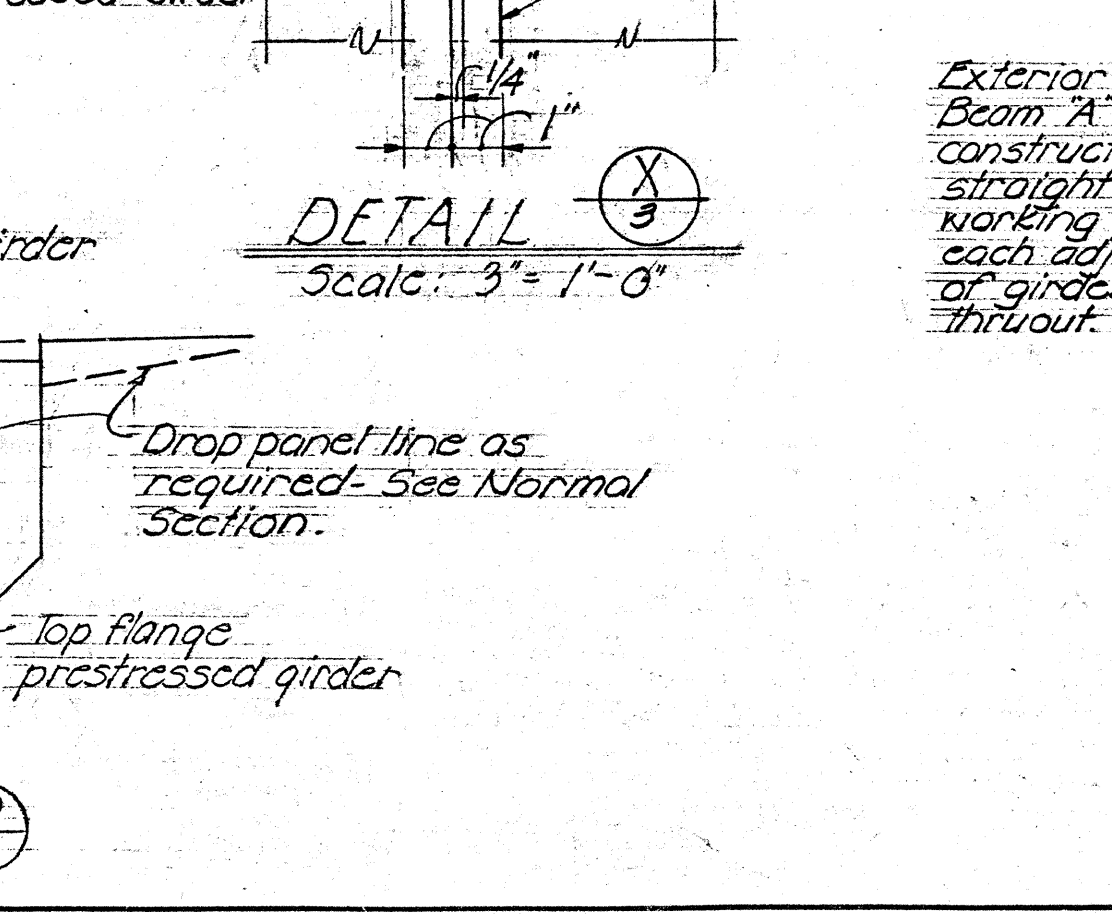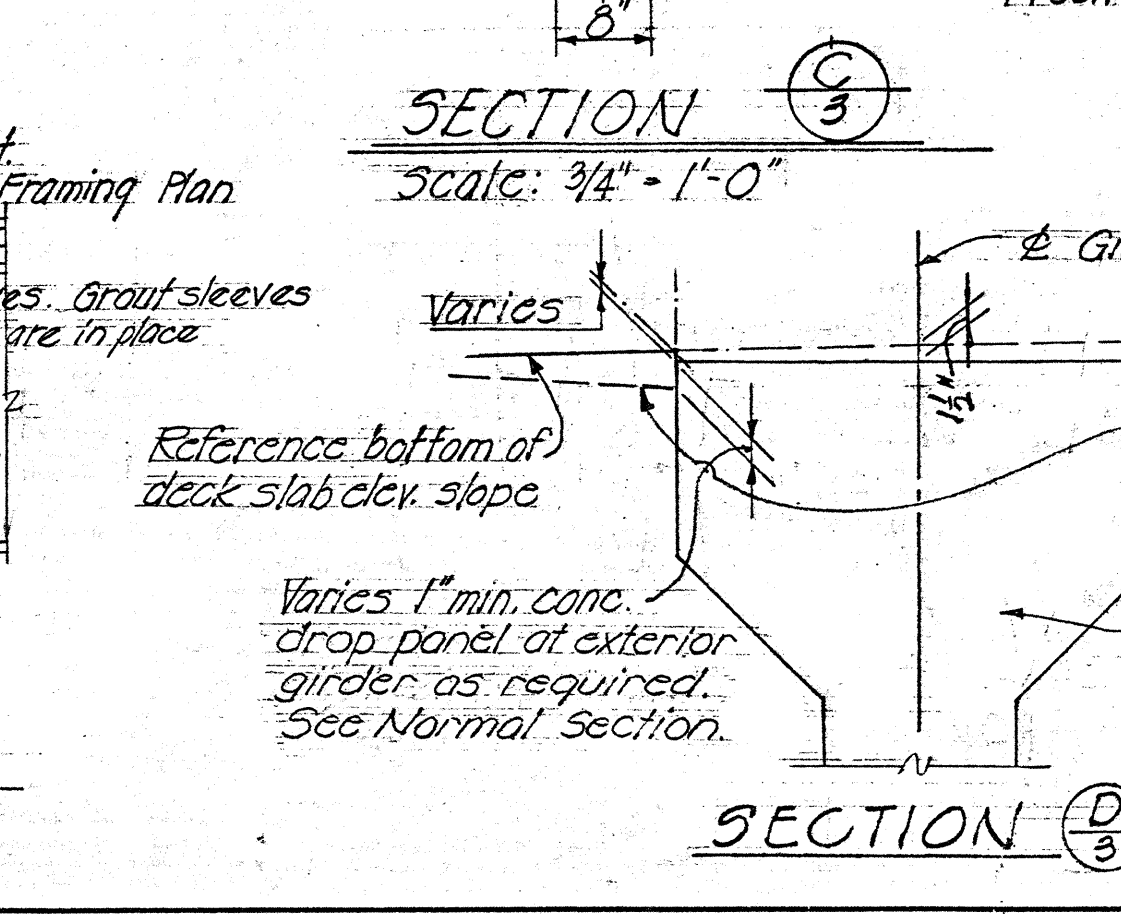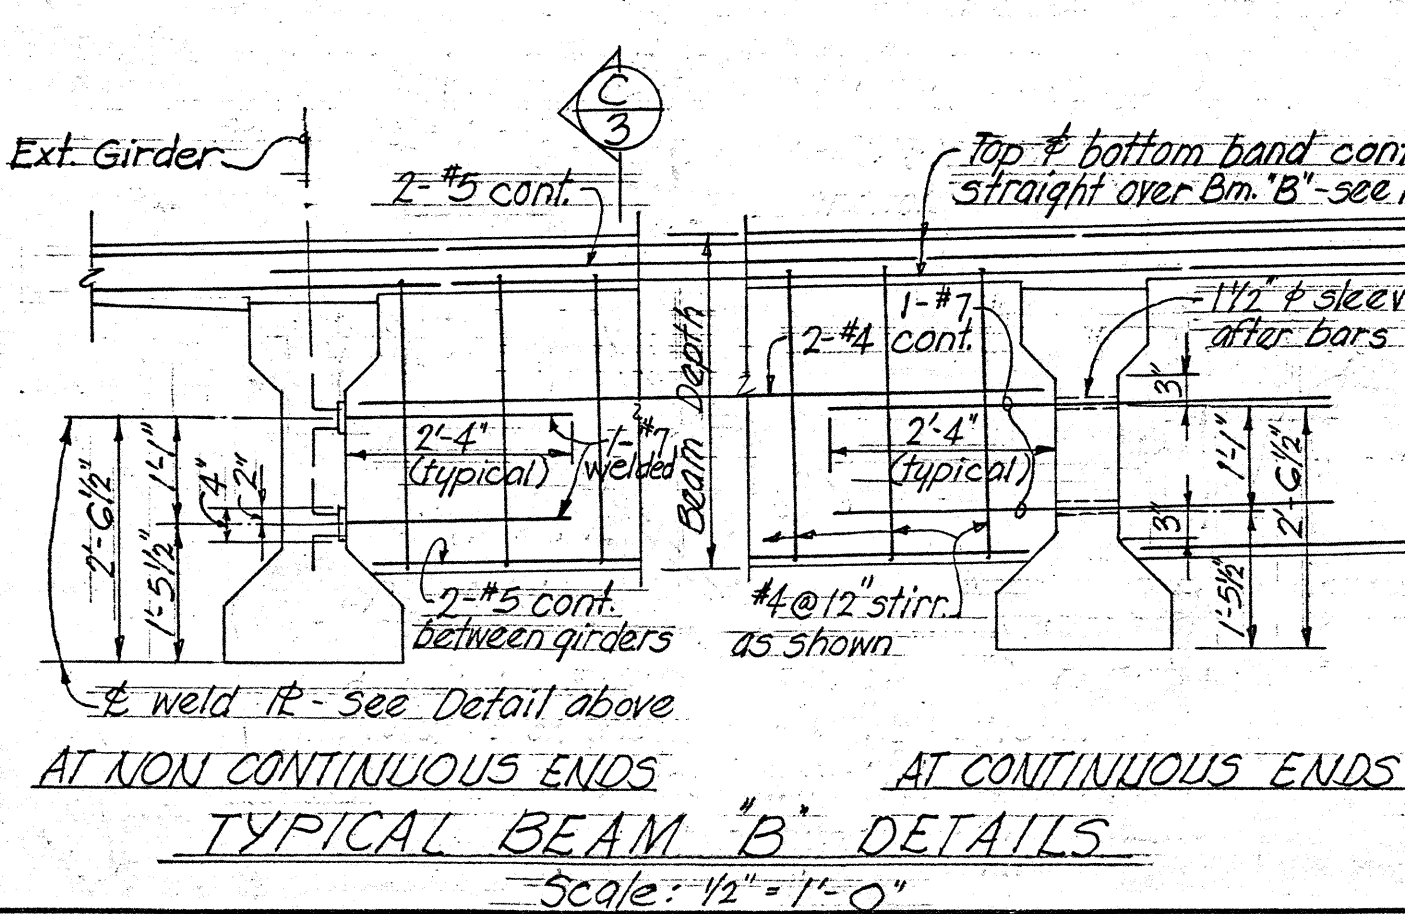

TRANSVERSE BEAM "A" TRANSVERSE BEAM "C"
PLAN - TYPICAL ARRANGEMENT & LOCATION OF TRANSVERSE BEAM REINF. AT GIRDERS

STATE OF HAWAII
DEPARTMENT OF TRANSPORTATION
HIGHWAYS DIVISION
HONOLULU STREAM BRIDGE
DECK SECTIONS AND DETAILS
Sta. 278+84.44 TO Sta. 280+21.56
F.A.I. Proj. I-H-111(18) PALEHUA RD. TO KUNIA RD.
Nov. 1964
SHEET No. 00 OF 07 SHEETS

Hand-drawn technical drawing of a pipe section. The drawing shows a cross-section of a pipe with a diameter of 24 inches, indicated by a circle with '24' inside. The pipe is labeled '3" #2 cont. ea. nosing.' and '4" #2'. The drawing also shows a section of the pipe with a radius of 12 inches, indicated by a curved arrow and 'R=12"'. The length of the section is labeled '1'-6" lap' and '8' 0"'. The drawing also shows a section of the pipe with a diameter of 10 inches, indicated by a circle with '10' inside. The drawing is labeled 'SECTION' and 'B 4'.

[illegible][illegible]

STATE OF HAWAII
DEPARTMENT OF TRANSPORTATION
HIGHWAYS DIVISION

HONOLULU STREAM BRIDGE

PIER DETAILS

STA. 278+84.44 TO STA. 280+21.56
F.R.I. Proj. I-H-1(118) PALEHUA RD. TO KUNIA RD.

Nov. 1964

SHEET No. 07 OF 07 SHEETS

SCALE: $\frac{1}{2}" = 1' - 0"$

NOTE: Top of pier cap shall be constructed along a straight line connecting the two elev. at each end as shown.

Reference E 6-G

Top of Pier Cap at
 E 155.01 Pier #1-A
 E 155.00 Pier #1-B

Top of Pier columns
 (B) or (C)
 Top of creep blk.
 E 155.87
 #1-B 155.89

Top of Pier columns
 (A) or (B)
 Top of creep blk.
 E 155.64
 #1-A 155.67

Top of Pier columns
 (C) or (D)
 Top of creep blk.
 E 155.61
 #1-C 155.63

Top of Pier columns
 (D) or (E)
 Top of creep blk.
 E 155.58
 #1-D 155.61

Top of Pier columns
 (E) or (F)
 Top of creep blk.
 E 155.56
 #1-E 155.59

Top of Pier columns
 (F) or (G)
 Top of creep blk.
 E 155.53
 #1-F 155.56

Top of Pier columns
 (G) or (H)
 Top of creep blk.
 E 155.50
 #1-G 155.53

Top of Pier columns
 (H) or (I)
 Top of creep blk.
 E 155.47
 #1-H 155.50

Top of Pier columns
 (I) or (J)
 Top of creep blk.
 E 155.44
 #1-I 155.47

Top of Pier columns
 (J) or (K)
 Top of creep blk.
 E 155.41
 #1-J 155.44

Top of Pier columns
 (K) or (L)
 Top of creep blk.
 E 155.38
 #1-K 155.41

Top of Pier columns
 (L) or (M)
 Top of creep blk.
 E 155.35
 #1-L 155.38

Top of Pier columns
 (M) or (N)
 Top of creep blk.
 E 155.32
 #1-M 155.35

Top of Pier columns
 (N) or (O)
 Top of creep blk.
 E 155.29
 #1-N 155.32

Top of Pier columns
 (O) or (P)
 Top of creep blk.
 E 155.26
 #1-O 155.29

Top of Pier columns
 (P) or (Q)
 Top of creep blk.
 E 155.23
 #1-P 155.26

Top of Pier columns
 (Q) or (R)
 Top of creep blk.
 E 155.20
 #1-Q 155.23

Top of Pier columns
 (R) or (S)
 Top of creep blk.
 E 155.17
 #1-R 155.20

Top of Pier columns
 (S) or (T)
 Top of creep blk.
 E 155.14
 #1-S 155.17

Top of Pier columns
 (T) or (U)
 Top of creep blk.
 E 155.11
 #1-T 155.14

Top of Pier columns
 (U) or (V)
 Top of creep blk.
 E 155.08
 #1-U 155.11

Top of Pier columns
 (V) or (W)
 Top of creep blk.
 E 155.05
 #1-V 155.08

Top of Pier columns
 (W) or (X)
 Top of creep blk.
 E 155.02
 #1-W 155.05

Top of Pier columns
 (X) or (Y)
 Top of creep blk.
 E 154.99
 #1-X 155.02

Top of Pier columns
 (Y) or (Z)
 Top of creep blk.
 E 154.96
 #1-Y 154.99

Top of Pier columns
 (Z) or (AA)
 Top of creep blk.
 E 154.93
 #1-Z 154.96

Top of Pier columns
 (AA) or (AB)
 Top of creep blk.
 E 154.90
 #1-AA 154.93

Top of Pier columns
 (AB) or (AC)
 Top of creep blk.
 E 154.87
 #1-AB 154.90

Top of Pier columns
 (AC) or (AD)
 Top of creep blk.
 E 154.84
 #1-AC 154.87

Top of Pier columns
 (AD) or (AE)
 Top of creep blk.
 E 154.81
 #1-AD 154.84

Top of Pier columns
 (AE) or (AF)
 Top of creep blk.
 E 154.78
 #1-AE 154.81

Top of Pier columns
 (AF) or (AG)
 Top of creep blk.
 E 154.75
 #1-AF 154.78

Top of Pier columns
 (AG) or (AH)
 Top of creep blk.
 E 154.72
 #1-AG 154.75

Top of Pier columns
 (AH) or (AI)
 Top of creep blk.
 E 154.69
 #1-AH 154.72

Top of Pier columns
 (AI) or (AJ)
 Top of creep blk.
 E 154.66
 #1-AI 154.69

Top of Pier columns
 (AJ) or (AK)
 Top of creep blk.
 E 154.63
 #1-AJ 154.66

Top of Pier columns
 (AK) or (AL)
 Top of creep blk.
 E 154.60
 #1-AK 154.63

Top of Pier columns
 (AL) or (AM)
 Top of creep blk.
 E 154.57
 #1-AL 154.60

Top of Pier columns
 (AM) or (AN)
 Top of creep blk.
 E 154.54
 #1-AM 154.57

Top of Pier columns
 (AN) or (AO)
 Top of creep blk.
 E 154.51
 #1-AN 154.54

Top of Pier columns
 (AO) or (AP)
 Top of creep blk.
 E 154.48
 #1-AO 154.51

Top of Pier columns
 (AP) or (AQ)
 Top of creep blk.
 E 154.45
 #1-AP 154.48

Top of Pier columns
 (AQ) or (AR)
 Top of creep blk.
 E 154.42
 #1-AQ 154.45

Top of Pier columns
 (AR) or (AS)
 Top of creep blk.
 E 154.39
 #1-AR 154.42

Top of Pier columns
 (AS) or (AT)
 Top of creep blk.
 E 154.36
 #1-AS 154.39

Top of Pier columns
 (AT) or (AU)
 Top of creep blk.
 E 154.33
 #1-AT 154.36

Top of Pier columns
 (AU) or (AV)
 Top of creep blk.
 E 154.30
 #1-AU 154.33

Top of Pier columns
 (AV) or (AW)
 Top of creep blk.
 E 154.27
 #1-AV 154.30

Top of Pier columns
 (AW) or (AX)
 Top of creep blk.
 E 154.24
 #1-AW 154.27

Top of Pier columns
 (AX) or (AY)
 Top of creep blk.
 E 154.21
 #1-AX 154.24

Top of Pier columns
 (AY) or (AZ)
 Top of creep blk.
 E 154.18
 #1-AY 154.21

Top of Pier columns
 (AZ) or (BA)
 Top of creep blk.
 E 154.15
 #1-AZ 154.18

Top of Pier columns
 (BA) or (BB)
 Top of creep blk.
 E 154.12
 #1-BA 154.15

Top of Pier columns
 (BB) or (BC)
 Top of creep blk.
 E 154.09
 #1-BB 154.12

Top of Pier columns
 (BC) or (BD)
 Top of creep blk.
 E 154.06
 #1-BC 154.09

Top of Pier columns
 (BD) or (BE)
 Top of creep blk.
 E 154.03
 #1-BD 154.06

Top of Pier columns
 (BE) or (BF)
 Top of creep blk.
 E 154.00
 #1-BE 154.03

Top of Pier columns
 (BF) or (BG)
 Top of creep blk.
 E 153.97
 #1-BF 154.00

Top of Pier columns
 (BG) or (BH)
 Top of creep blk.
 E 153.94
 #1-BG 153.97

Top of Pier columns
 (BH) or (BI)
 Top of creep blk.
 E 153.91
 #1-BH 153.94

Top of Pier columns
 (BI) or (BJ)
 Top of creep blk.
 E 153.88
 #1-BI 153.91

Top of Pier columns
 (BJ) or (BK)
 Top of creep blk.
 E 153.85
 #1-BJ 153.88

Top of Pier columns
 (BK) or (BL)
 Top of creep blk.
 E 153.82
 #1-BK 153.85

Top of Pier columns
 (BL) or (BM)
 Top of creep blk.
 E 153.79
 #1-BL 153.82

Top of Pier columns
 (BM) or (BN)
 Top of creep blk

SCALE: $\frac{1}{4}'' = 1'-0''$

SCALE: $\frac{1}{2}" = 11'-0"$

[illegible]

PICTURAL SECTION $\left(\frac{A}{4}\right)$

Scale: $\frac{3}{8}'' = 1'-0''$