

INDEX TO DRAWINGS	
SHEET NO.	DESCRIPTION
1	TITLE SHEET
2	GENERAL NOTES
3-6	TYPICAL ROADWAY SECTIONS AND DETAILS
7-8	CONSTRUCTION ZONE TRAFFIC CONTROL PLANS
9-14	ROADWAY PLANS
15-27	GUARDRAIL SUMMARY & DETAILS
28	ADJUSTING OAHU SUGAR COMPANY'S FACILITIES
29	CENTERLINE & REFERENCE SURVEY MONUMENT
30-34	FIELD OFFICE & PROJECT SITE LABORATORY DETAILS
35-37	CROSS-SECTIONS
38-51	DRAINAGE PLANS & DETAILS
52-77	STRUCTURE WIDENING PLANS AND DETAILS
78-99	SIGNING & MARKING PLANS AND DETAILS

① 49A, ② ADD.70A, ③ C.O.99S-1, ARE SUPPLEMENT SHEETS TO THE CONTRACT PLANS. TOTAL=102

- ①
- ②
- ③

STATE OF HAWAII

DEPARTMENT OF TRANSPORTATION

HIGHWAYS DIVISION

HONOLULU, HAWAII

" AS BUILT "

PLANS FOR

INTERSTATE ROUTE H-1

PALAILAI INTERCHANGE TO KUNIA INTERCHANGE



CONSTRUCTION OF ADDITIONAL LANES

F.A.I. PROJECT NO. IR-HI-1(189)

DISTRICT OF EWA

ISLAND OF OAHU

FED. ROAD DIST. NO.	STATE	FED. AID PROJ. NO.	FISCAL YEAR	SHEET NO.	TOTAL SHEETS
HAWAII	HAW.	IR-HI-1 (189)	1986	1	99

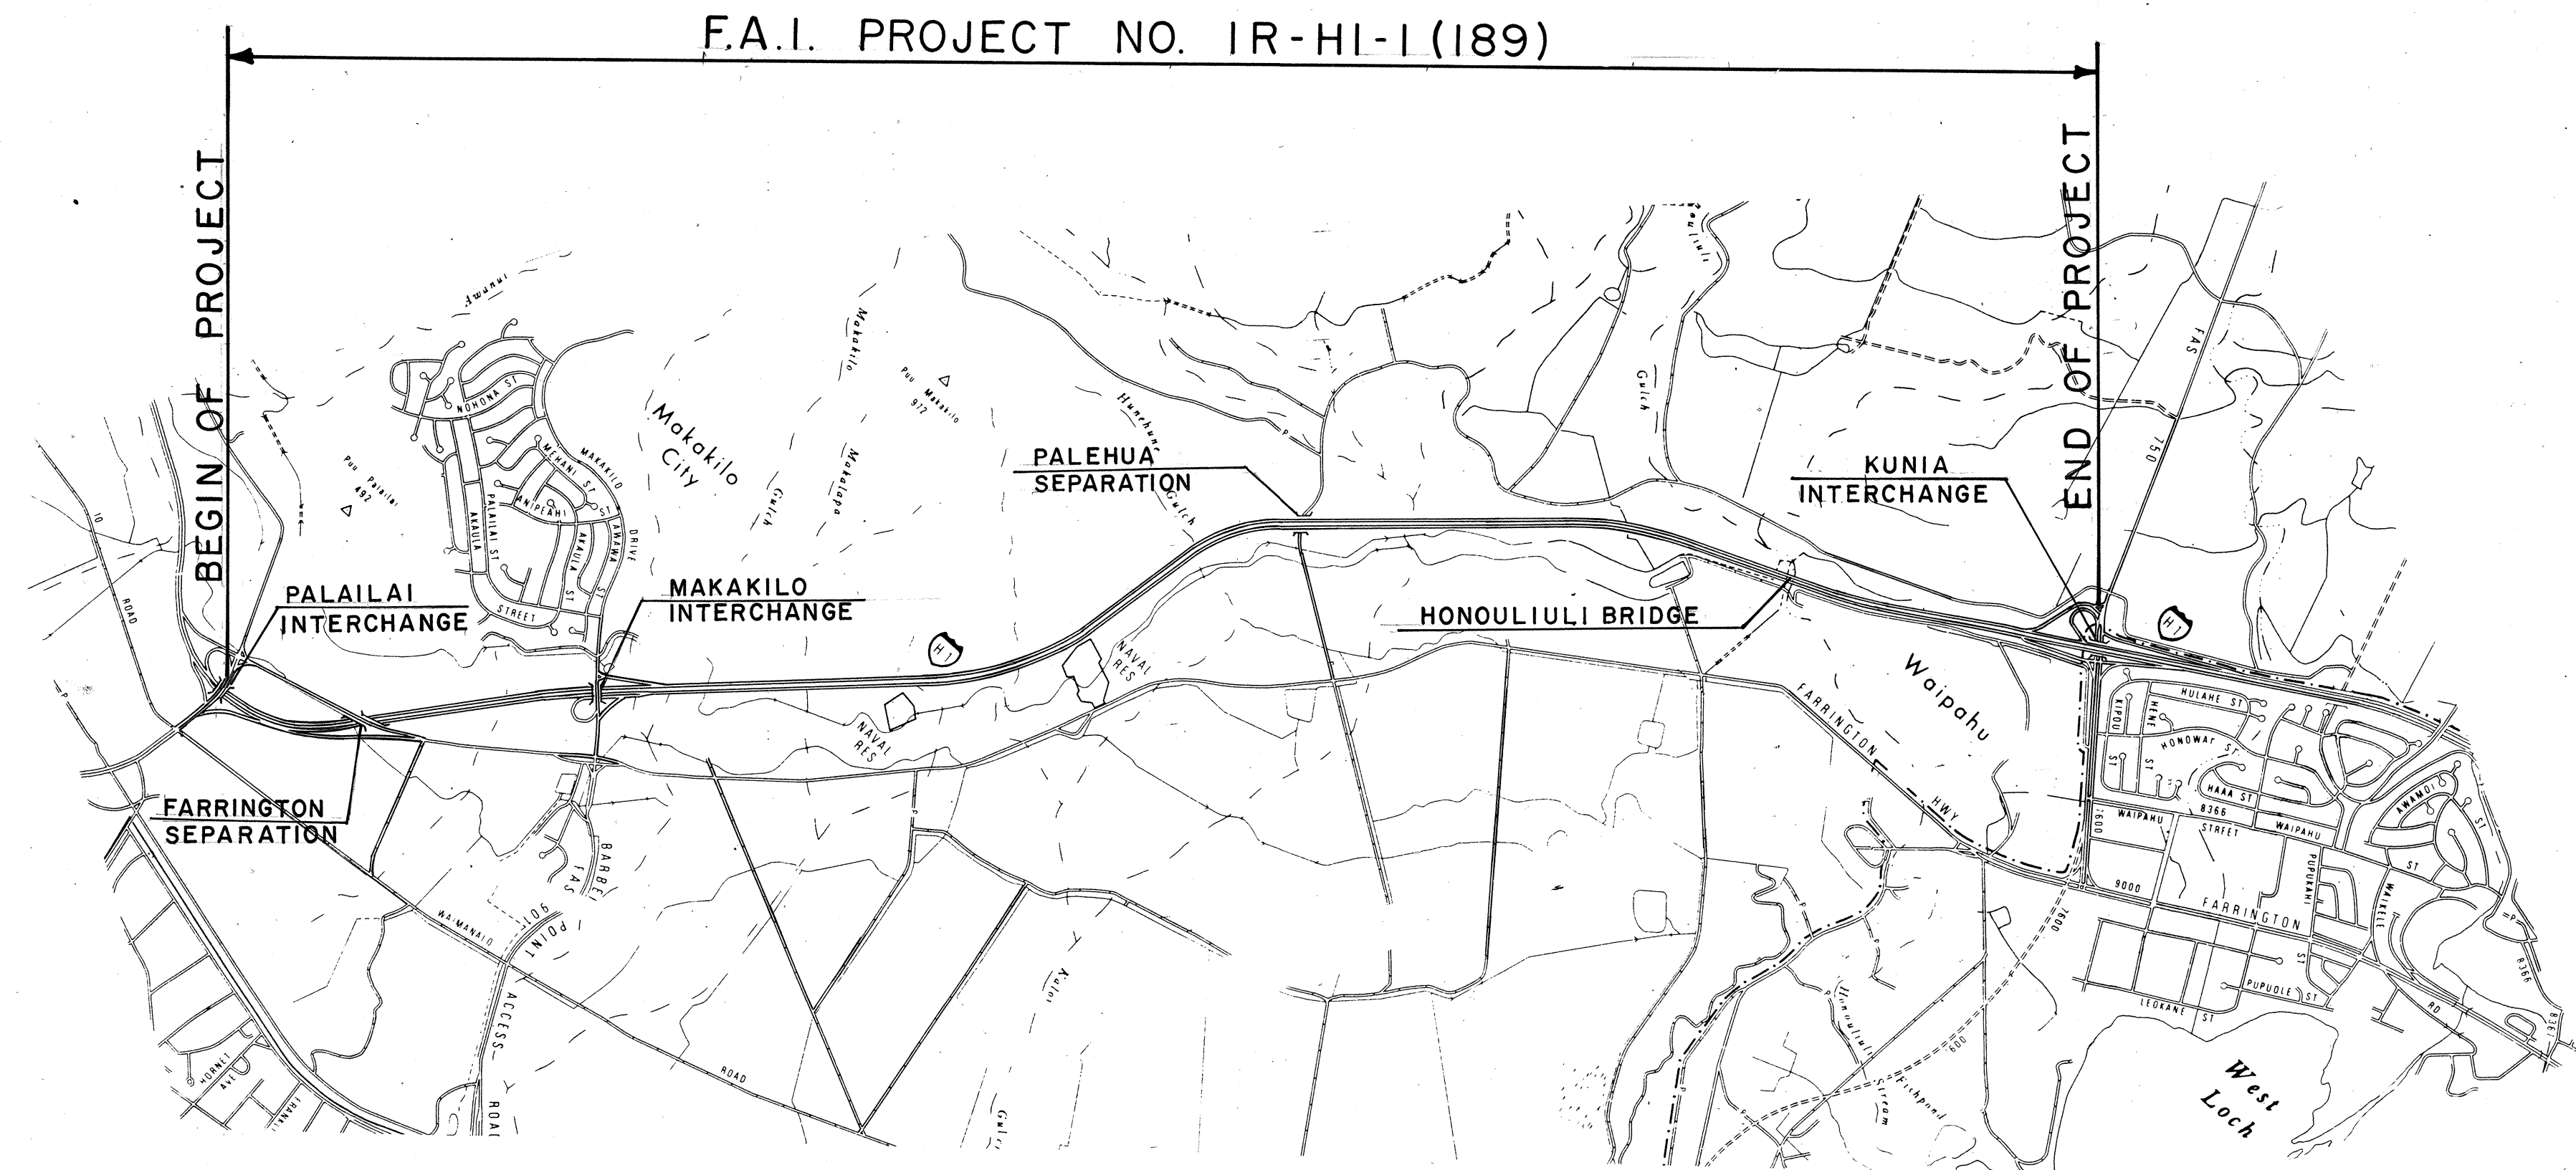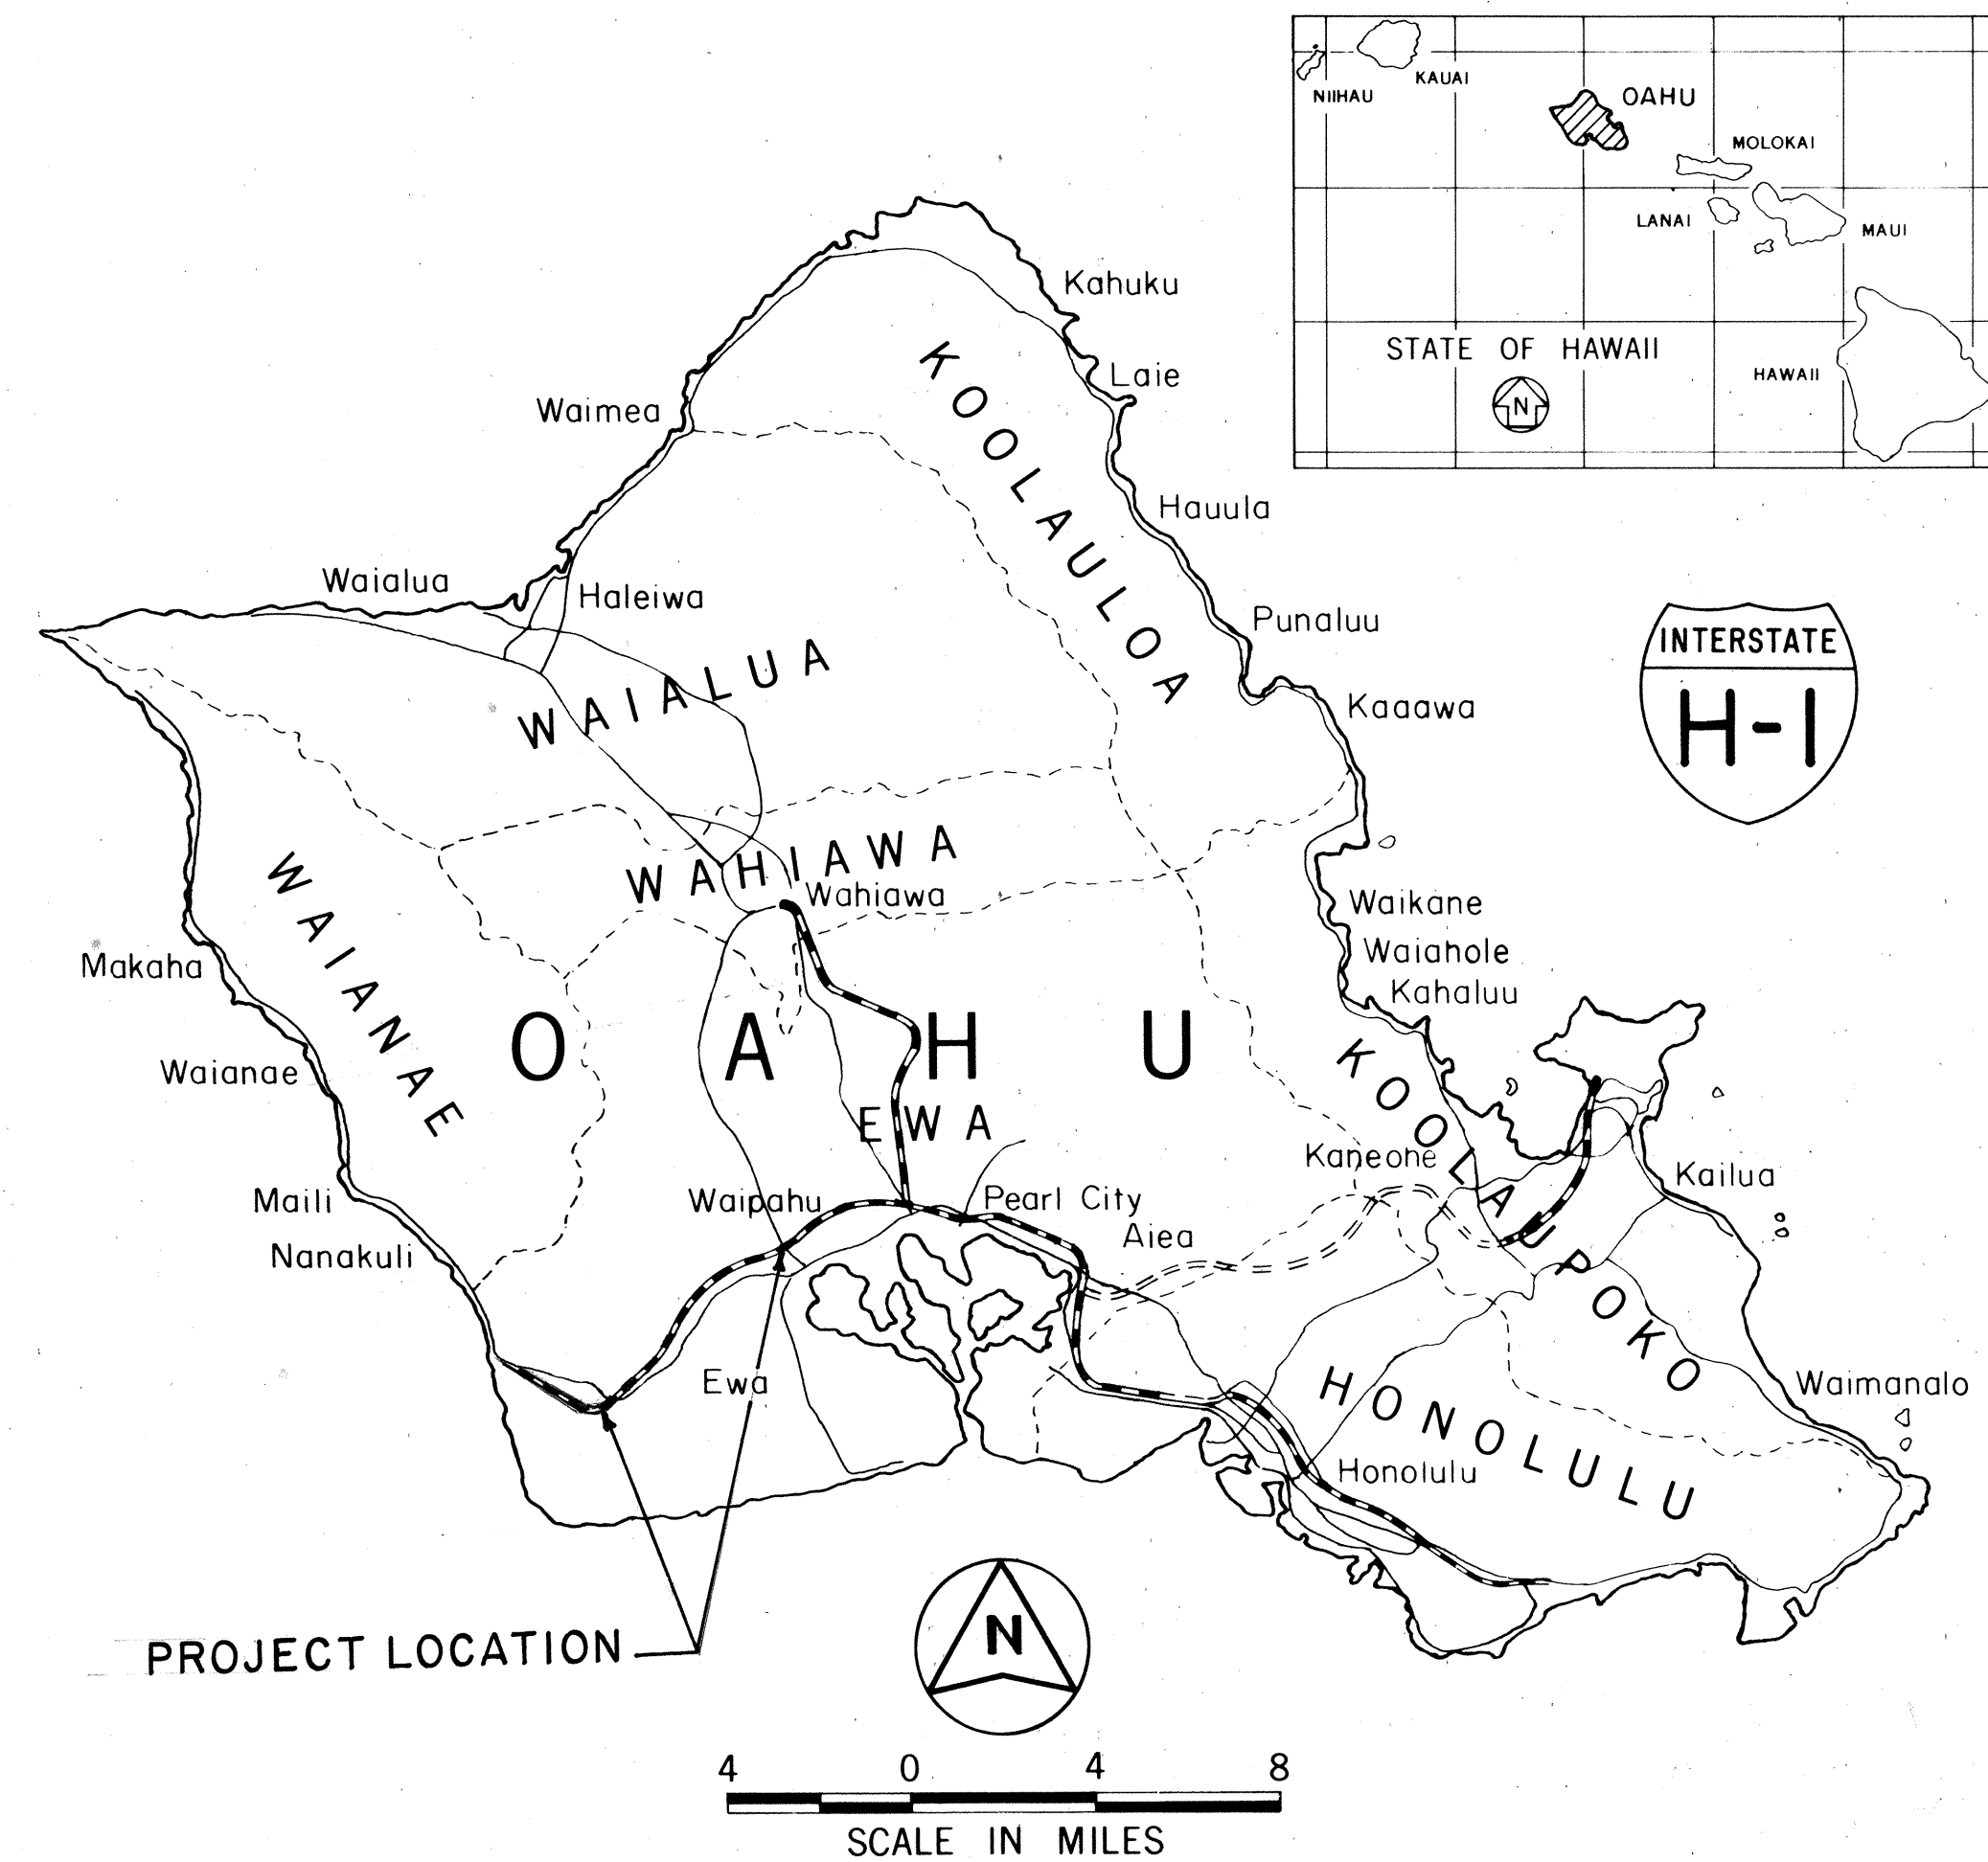

CHANGES MADE DURING CONSTRUCTION HAVE BEEN INCORPORATED ON THESE PLANS EXCEPT CHANGES IN THE ORIGINAL THEORETICAL QUANTITIES. FOR ACTUAL QUANTITIES, REFER TO PROJECT LEDGER AND/OR COMPUTATION BOOK.

Michael Diniya

RESIDENT ENGINEER

4/25/89

DATE

DESIGN DESIGNATION

	PALAILAI INTERCHANGE TO MAKAKILO INTERCHANGE	MAKAKILO INTERCHANGE TO KUNIA INTERCHANGE
CURRENT ADT(1985)	25,560	39,350
DESIGN ADT(2005)	59,800	84,700
DHV	5,680	8,045
D	50/50	55/45
T ₂₄	6.0%	6.0%
V	70 M.P.H.	70 M.P.H.

DEPARTMENT OF TRANSPORTATION

FEDERAL HIGHWAY ADMINISTRATION

APPROVED:

for DIVISION ADMINISTRATOR

10/2/85

DATE

DEPARTMENT OF TRANSPORTATION

STATE OF HAWAII

APPROVED:

DIR. OF TRANSPORTATION

9/20/85

DATE

UNIT "C"

DESIGNED BY

R. SIAROT

P.S. & E. BY

548-7537

PHONE

JUNE, 1985

DATE

LAYOUT PLAN

0 2000 4000 6000

GRAPHIC SCALE IN FEET

GROSS LENGTH OF PROJECT 5.286 MILES