	INDEX TO DRAWINGS
SHEET NO.	DESCRIPTION
1	TITLE SHEET
2-4	INSTALLATION OF VEHICLE DETECTOR
	LOOPS AT VARIOUS TRAFFIC COUNT
	STATIONS
5-7	STANDARD DETAILS
1	

STATE OF HAWAII

DEPARTMENT OF TRANSPORTATION HIGHWAYS DIVISION


PLANS FOR

"AS-BUILT"

INSTALLATION OF VEHICLE DETECTOR LOOPS AT VARIOUS TRAFFIC COUNT STATIONS

FEDERAL AID PROJECT NO. HPR-0010(8), UNIT 2

DISTRICT OF HONOLULU ISLAND OF OAHU

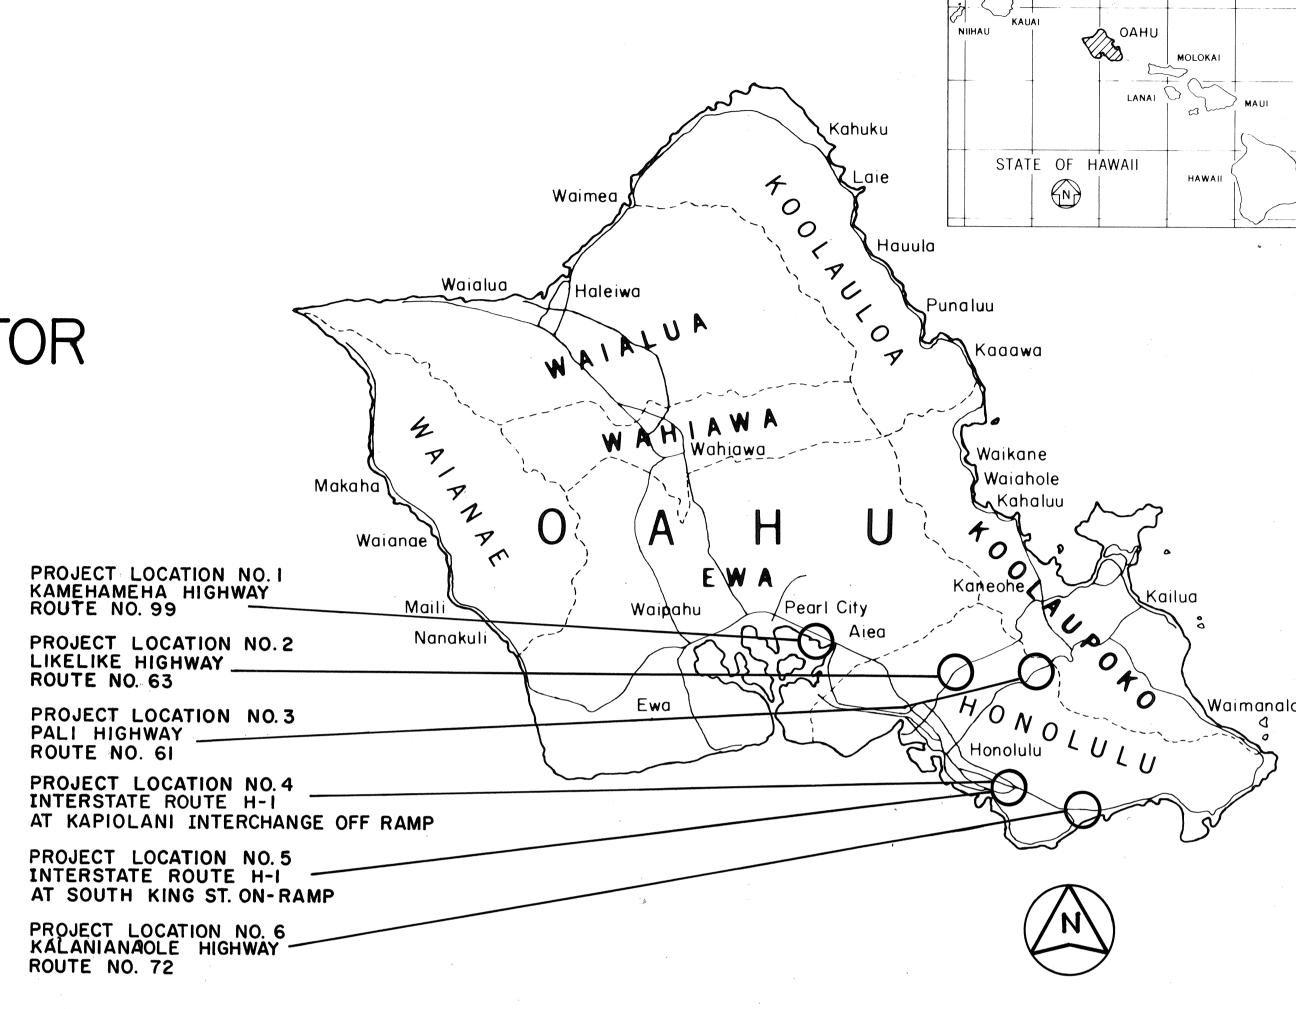

FED. ROAD

DIST. NO.

HAWAII

STATE

CHANGES MADE DURING CONSTRUCTION HAVE
BEEN INCORPORATED ON THESE PLANS EXCEPT
CHANGES IN THE ORIGINAL THEORETICAL
QUANTITIES. FOR ACTUAL QUANTITIES, REFER TO
PROJECT LEDGER AND/OR COMPUTATION BOOK.

[National Astron.]
[10-26-88]

LOCATION MAP

RESIDENT ENGINEER

DEPARTMENT OF TRANSPORTATION
STATE OF HAWAII

APPROVED:

DATE

John OF TRANSPORTATION DA

48-7534 MAY2,198 PHONE DATE

A. YAMAGUCHI 5.

HWY-T

FISCAL | SHEET

YEAR

1986

SHEETS

FED. AID

PROJ. NO.

HPR-0010 (8)

UNIT 2