



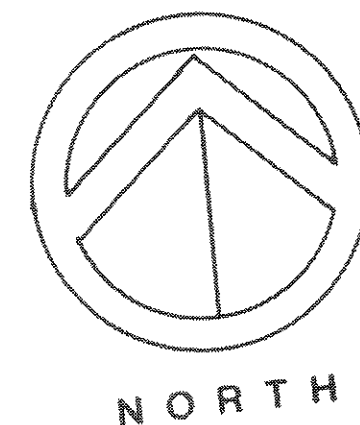

FED. ROAD DIST. NO.	STATE	FED. AID PROJ. NO.	FISCAL YEAR	SHEET NO.	TOTAL SHEETS
HAWAII	HAW.	IR-HI-1(200):17	1986	2	22

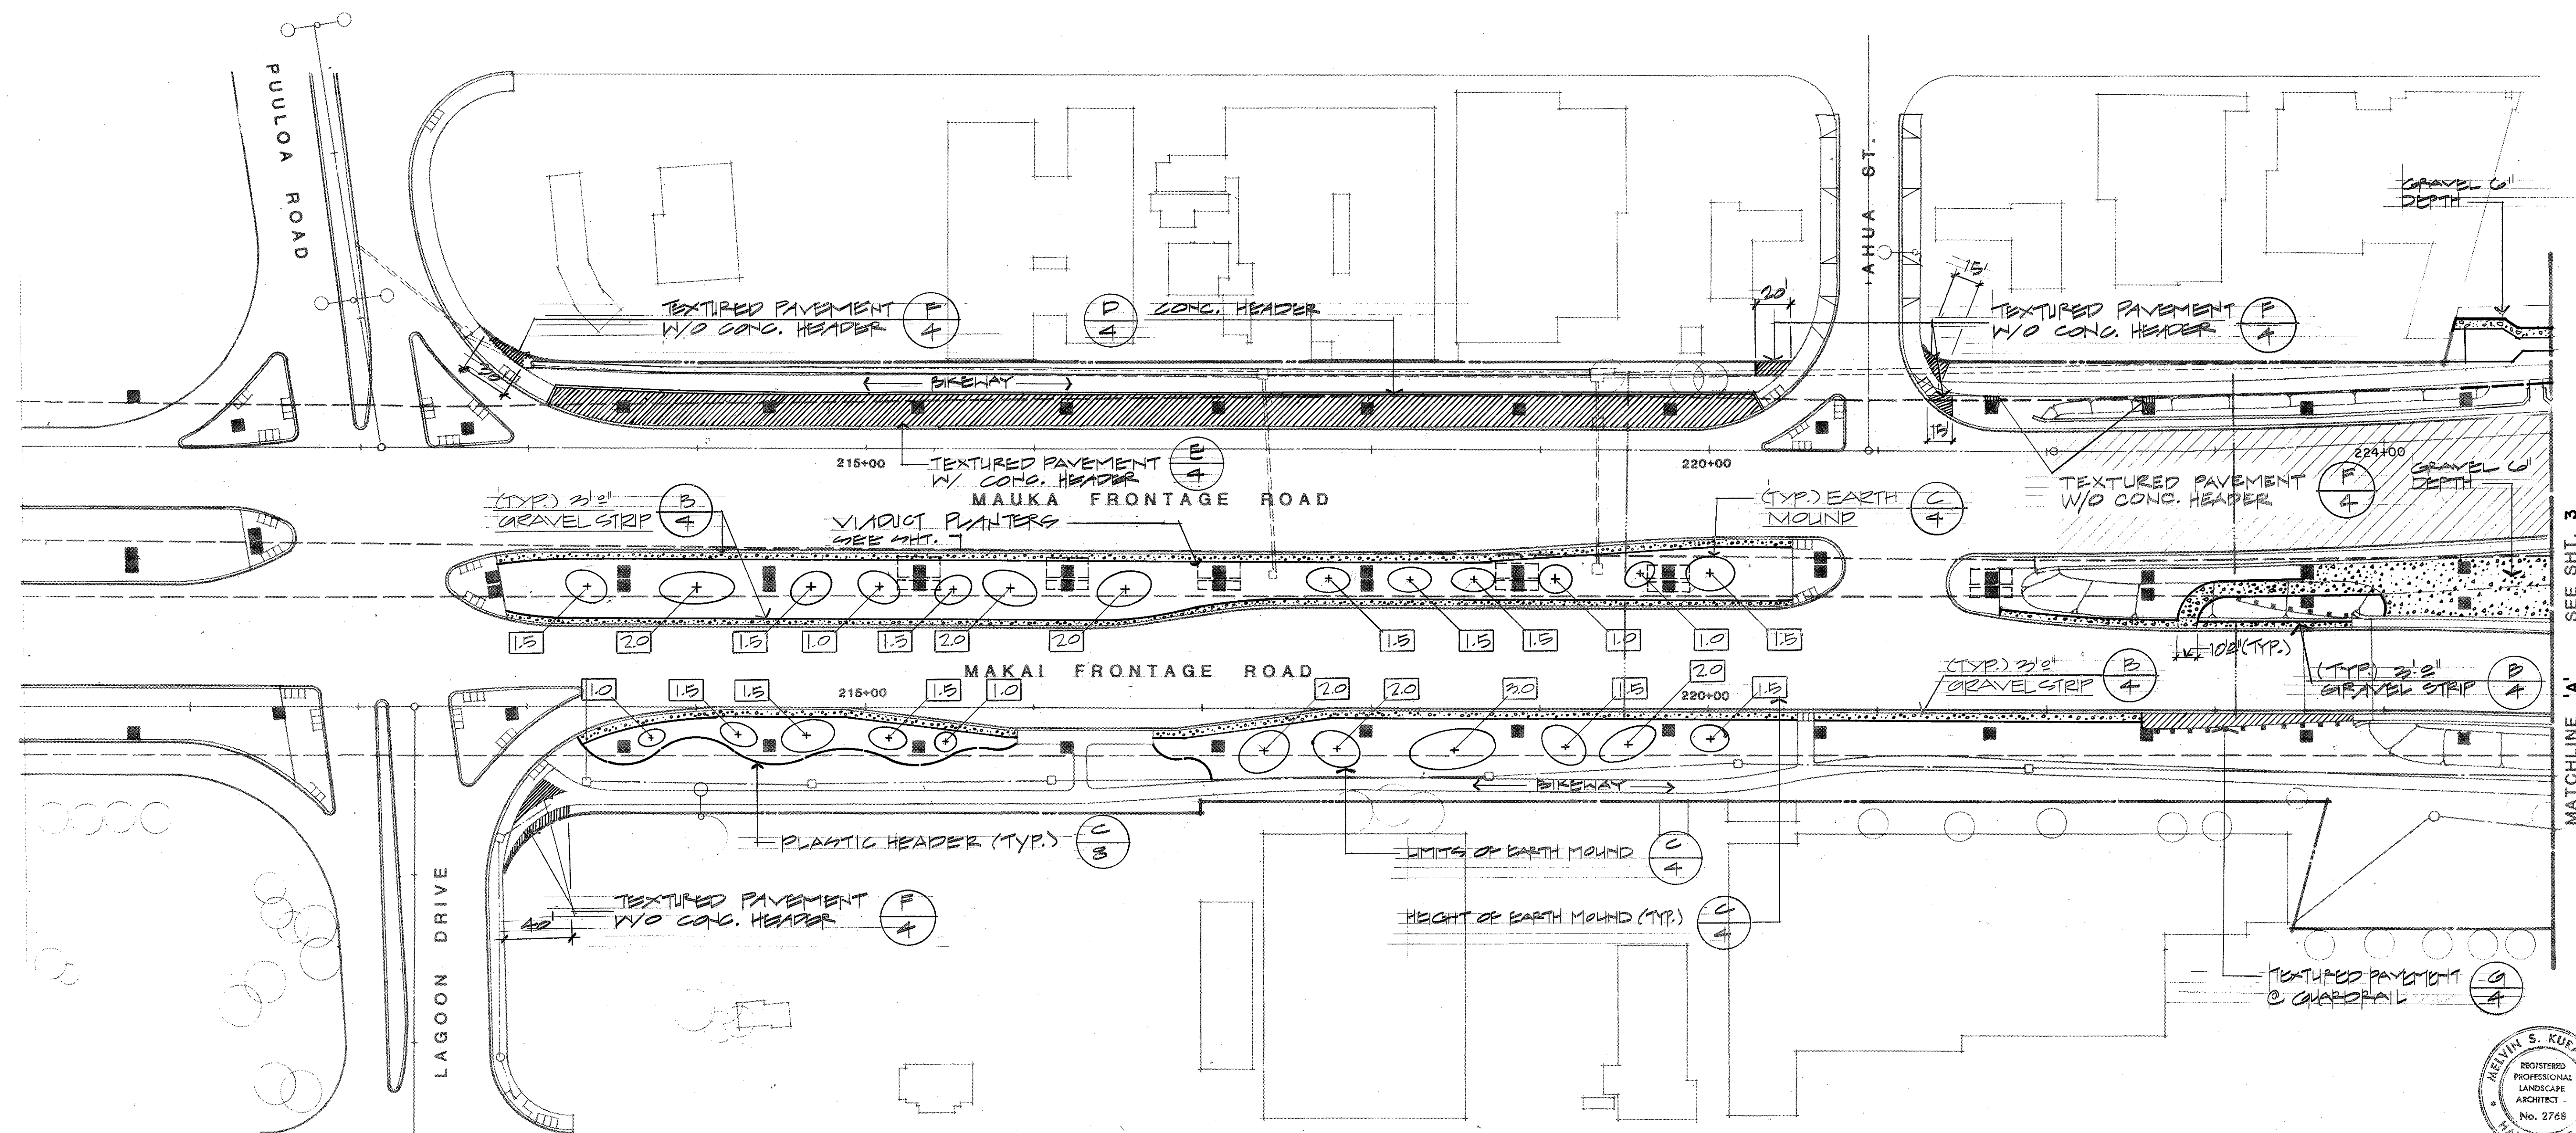

DATE	
ORIGINAL PLAN	
DRAWN BY	
CHECKED BY	
NOTED BY	
QUANTITIES BY	
CHECKED BY	
NO.	

3/1/87	CHANGED LIMIT OF GRAVEL AT RIGHT-OF-WAY LINE ON MAUKA SIDE FROM STA. 224+40 TO STA. 225+00
DATE	REVISION

STATE OF HAWAII
DEPARTMENT OF TRANSPORTATION
HIGHWAYS DIVISION

CONSTRUCTION PLAN

KEEHI INTERCHANGE LANDSCAPING
(WEST OF MOANALUA STREAM)
FAIP NO. IR-HI-1(200):17

SCALE: 1"=50'-0" DATE: MAY 1986


SHEET No. 2 OF 20 SHEETS




THIS WORK WAS PREPARED BY ME OR UNDER MY SUPERVISION

Melvin S. Kumaka

ADD. 2

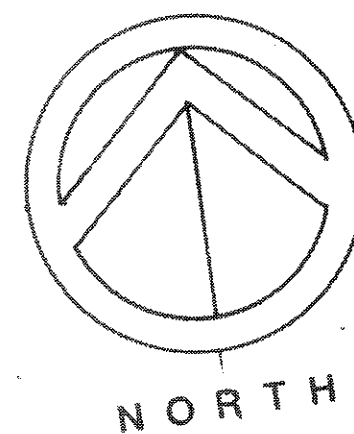

FED. ROAD DIST. NO.	STATE	FED. AID PROJ. NO.	FISCAL YEAR	SHEET NO.	TOTAL SHEETS
HAWAII	HAW.	IR-HI-1(200):17	1986	3	22

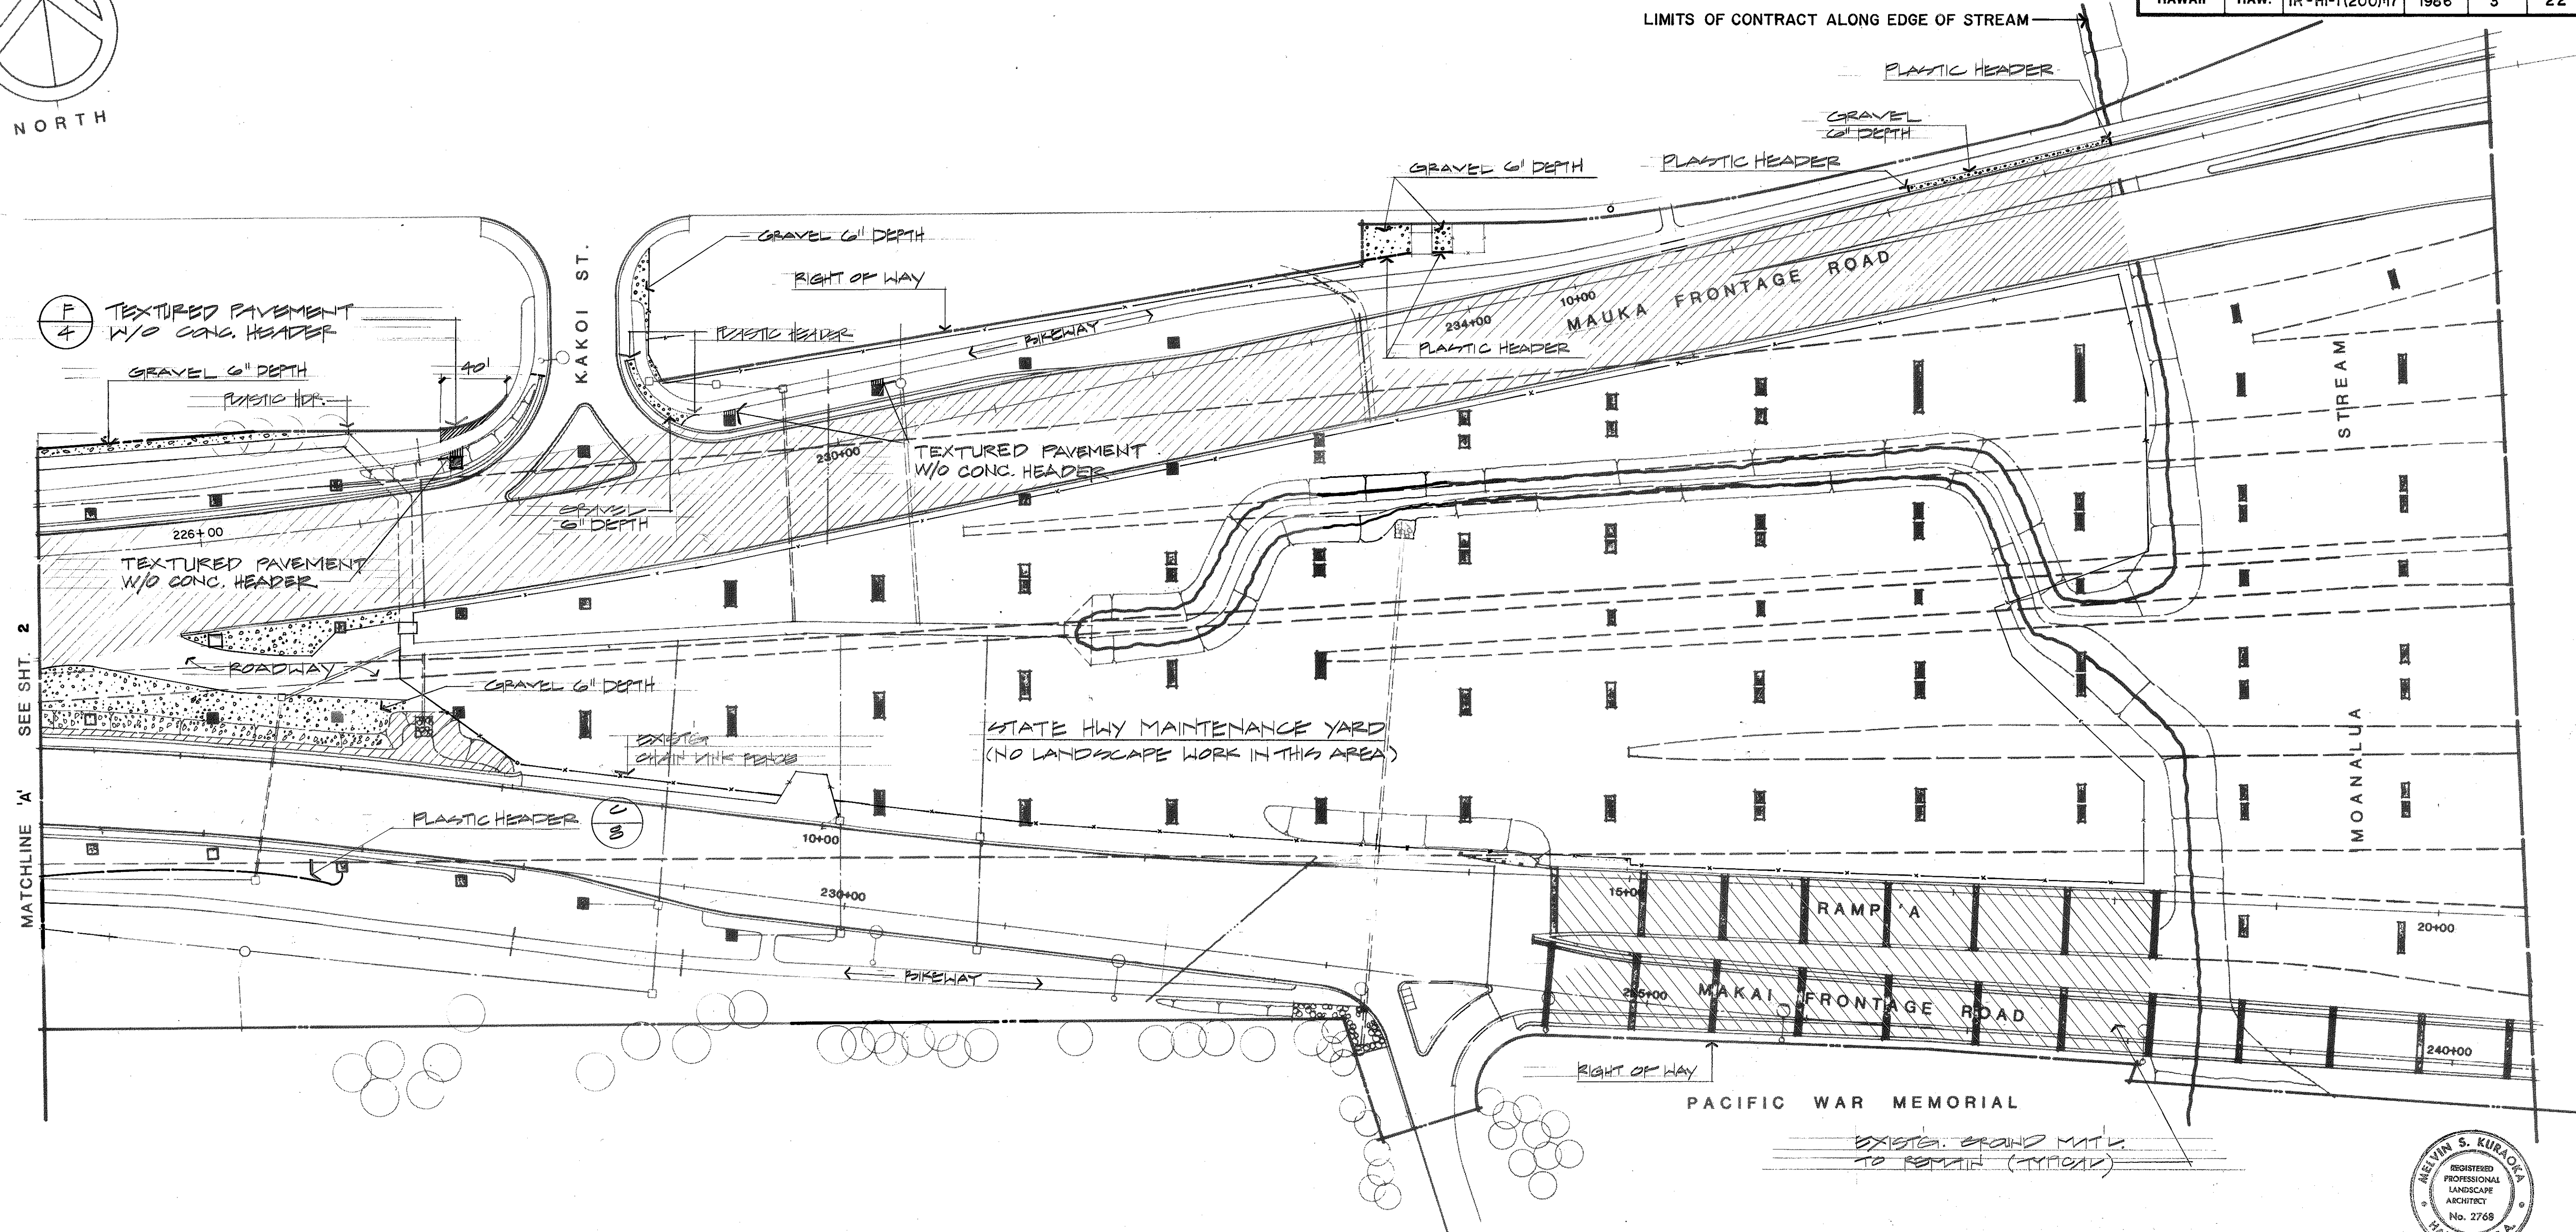

DATE	
DESIGNED BY	
DRAWN BY	
CHECKED BY	
ORIGINAL PLAN	
NOTED BY	
NO.	

7-16-87	DELETED PLASTIC HEADER FROM STA. 226+90 TO 227+95 & TEXTURED PAVEMENT FROM STA. 232+12 TO 232+32 ON MAKAU SIDE OF MAKAU FRONTAGE ROAD.
3/1/87	CHANGED LIMIT OF GRAVEL AT RIGHT-OF-WAY LINE ON MAUKA SIDE FROM STA. 225+00 TO STA. 226+90
DATE	REVISION

STATE OF HAWAII
DEPARTMENT OF TRANSPORTATION
HIGHWAYS DIVISION

CONSTRUCTION PLAN
KEEHI INTERCHANGE LANDSCAPING
(WEST OF MOANALUA STREAM)
FAIP NO. IR-HI-1(200):17
SCALE: 1"=50'-0" DATE: MAY 1986
SHEET No. 3 OF 20 SHEETS

C.O. ADD. 3