


FED. ROAD DIST. NO.	STATE	FED. AID PROJ. NO.	FISCAL YEAR	SHEET NO.	TOTAL SHEETS
HAWAII	HAW.	IR-HI(200)17	1986	16	22

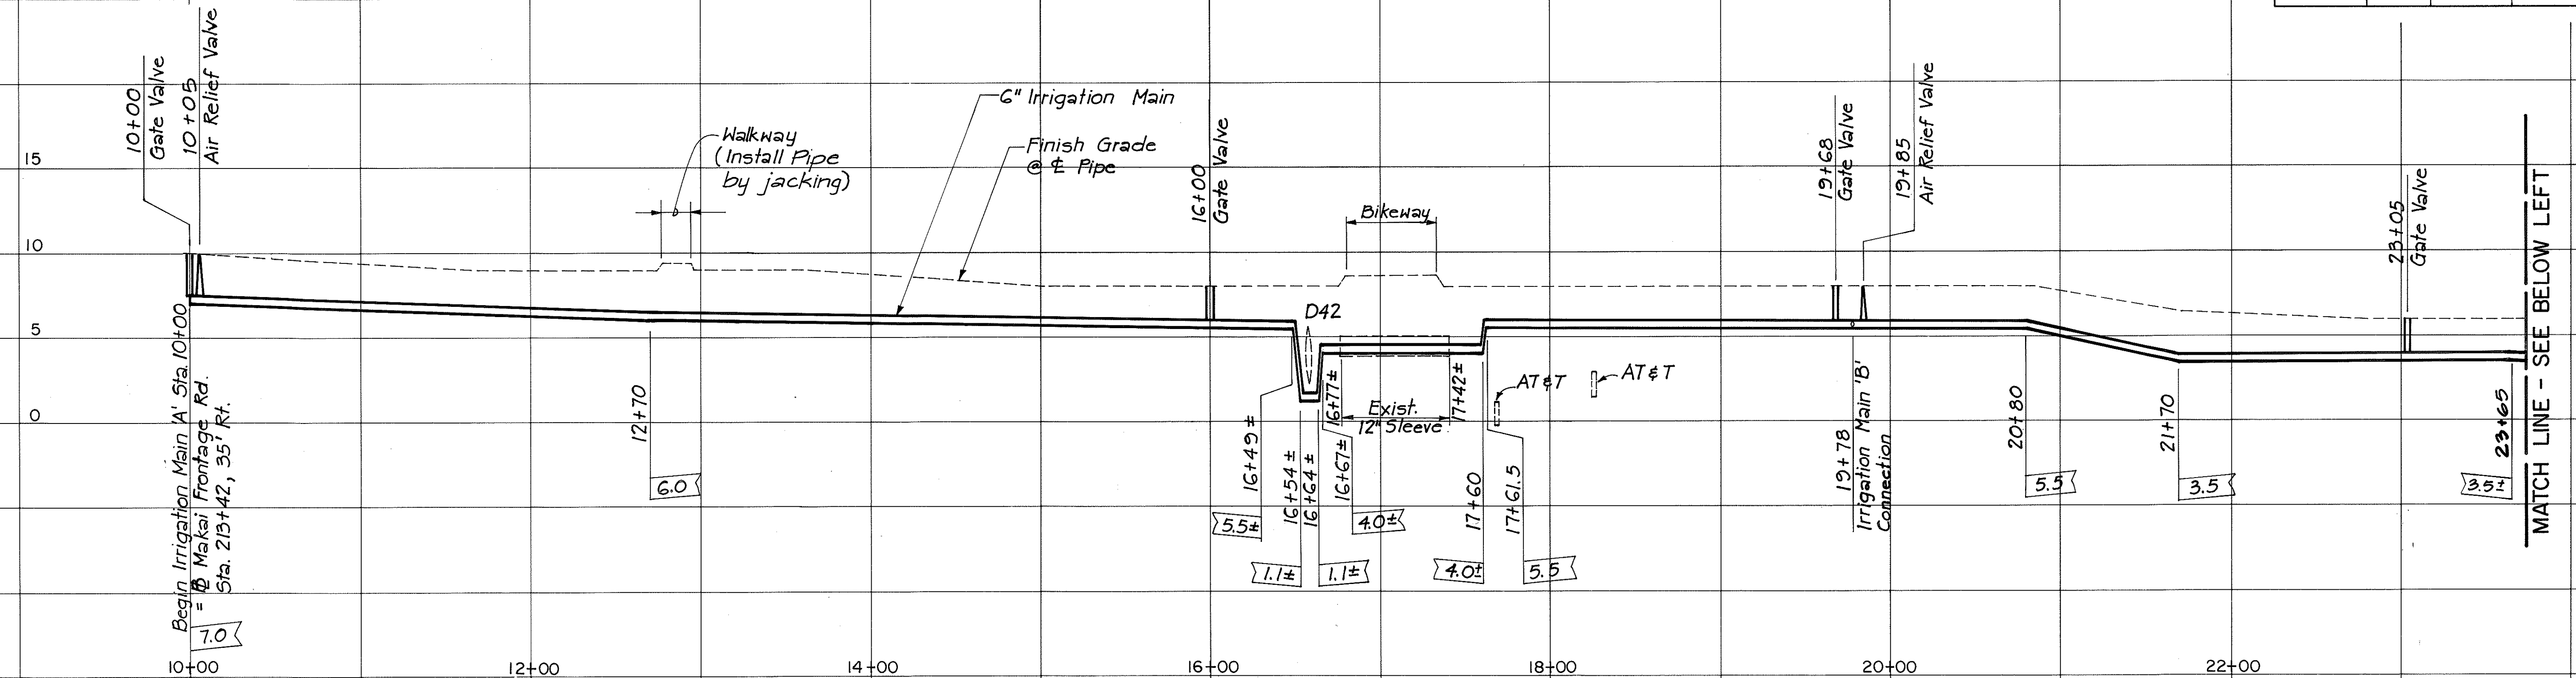

IRRIGATION MAIN 'A'


SCALE: HORIZ. 1" = 50'
VERT. 1" = 5'

NOTE:

Profile shall be adjusted as necessary to maintain minimum 2 feet pipe cover.

ESTIMATED QUANTITY:

6" Irrigation Main - 2600 Lin. Ft.

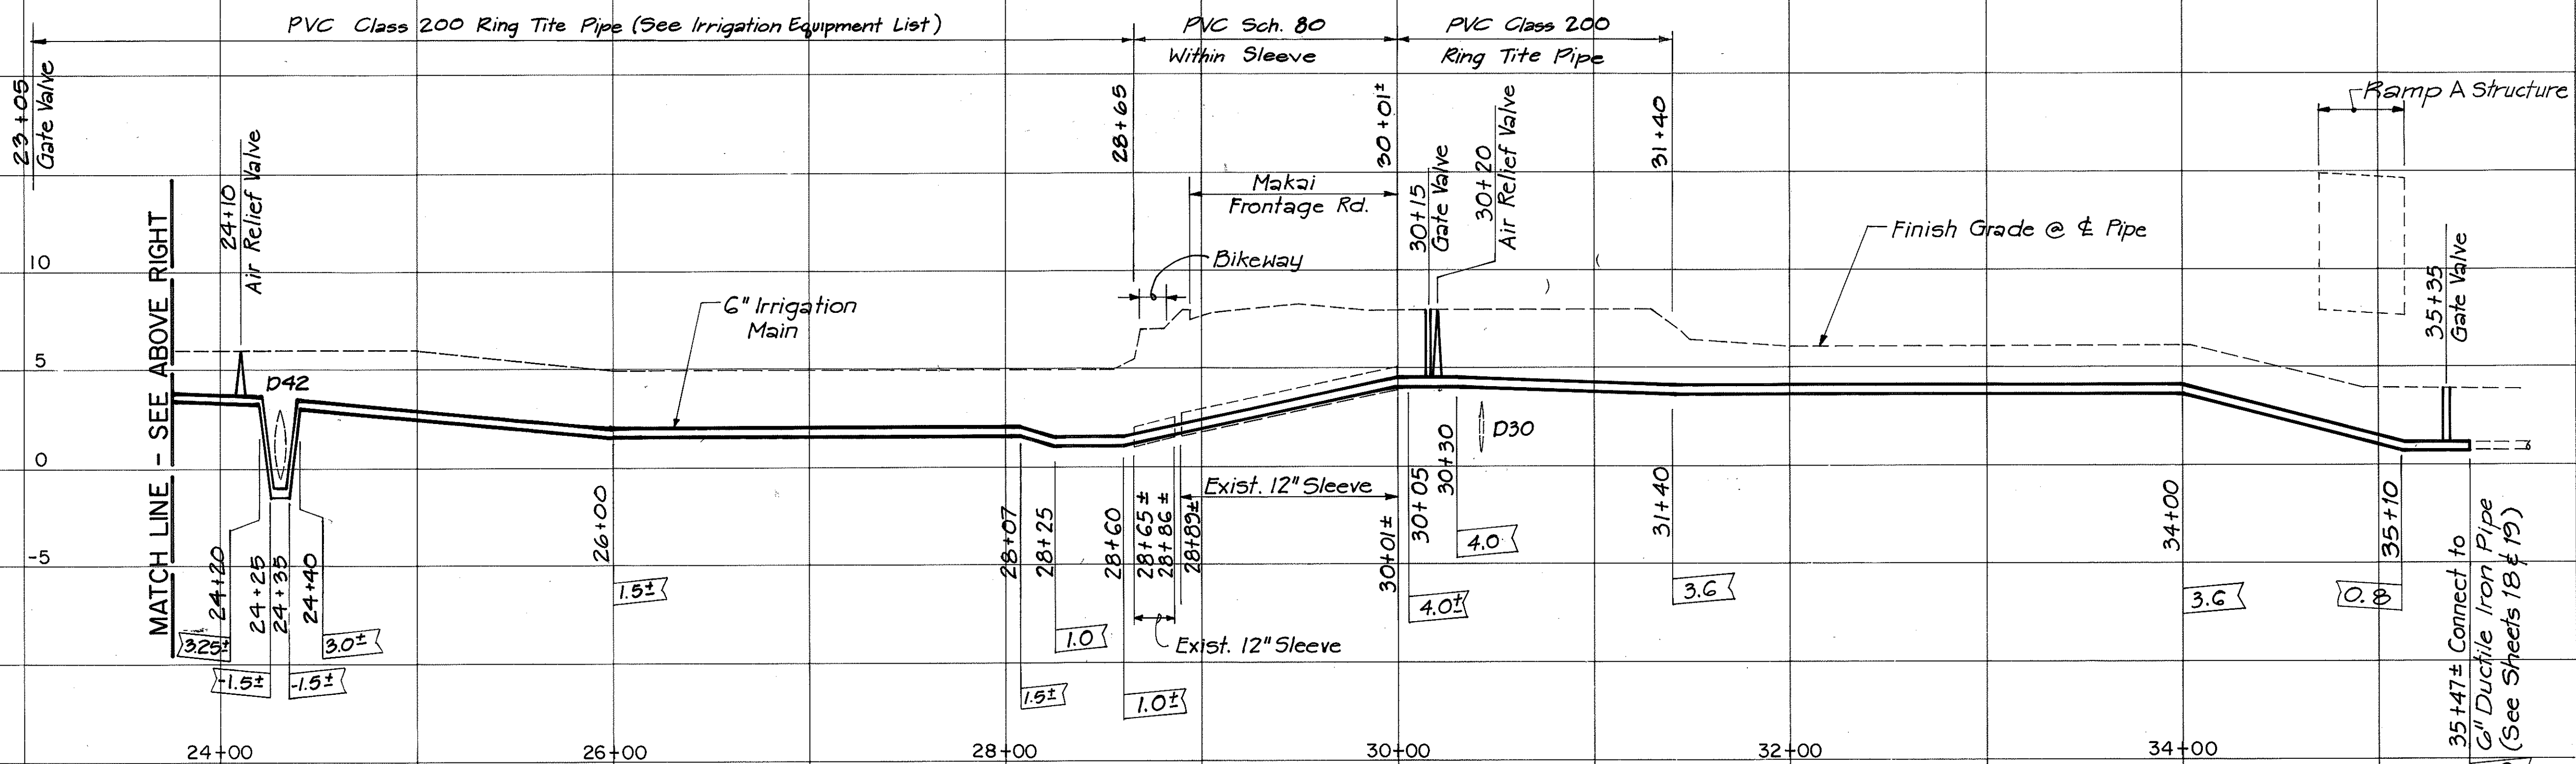

IRRIGATION MAIN 'A'

SCALE: HORIZ. 1" = 50'
VERT. 1" = 5'

STATE OF HAWAII
DEPARTMENT OF TRANSPORTATION
HIGHWAYS DIVISION

IRRIGATION MAIN PROFILES



KEEHI INTERCHANGE LANDSCAPING
(WEST OF MOANALUA STREAM)
FAIP NO. IR - HI - I(200)17

SCALE: AS SHOWN DATE: 12/15/1986
SHEET NO. 16 OF 20 SHEETS

7-16-87
REVISE IRRIGATION MAIN
PROFILE FROM STATION 23+05 TO
28+07 AND TYPE OF MAIN

SURVEY PLOTTED BY	DATE
DRAWN BY	
TRACED BY	
QUANTITIES BY	
CHECKED BY	
NO.	

FED. ROAD DIST. NO.	STATE	FED. AID PROJ. NO.	FISCAL YEAR	SHEET NO.	TOTAL SHEETS
HAWAII	HAW.	IR-HI-1(200)17	1986	17	22

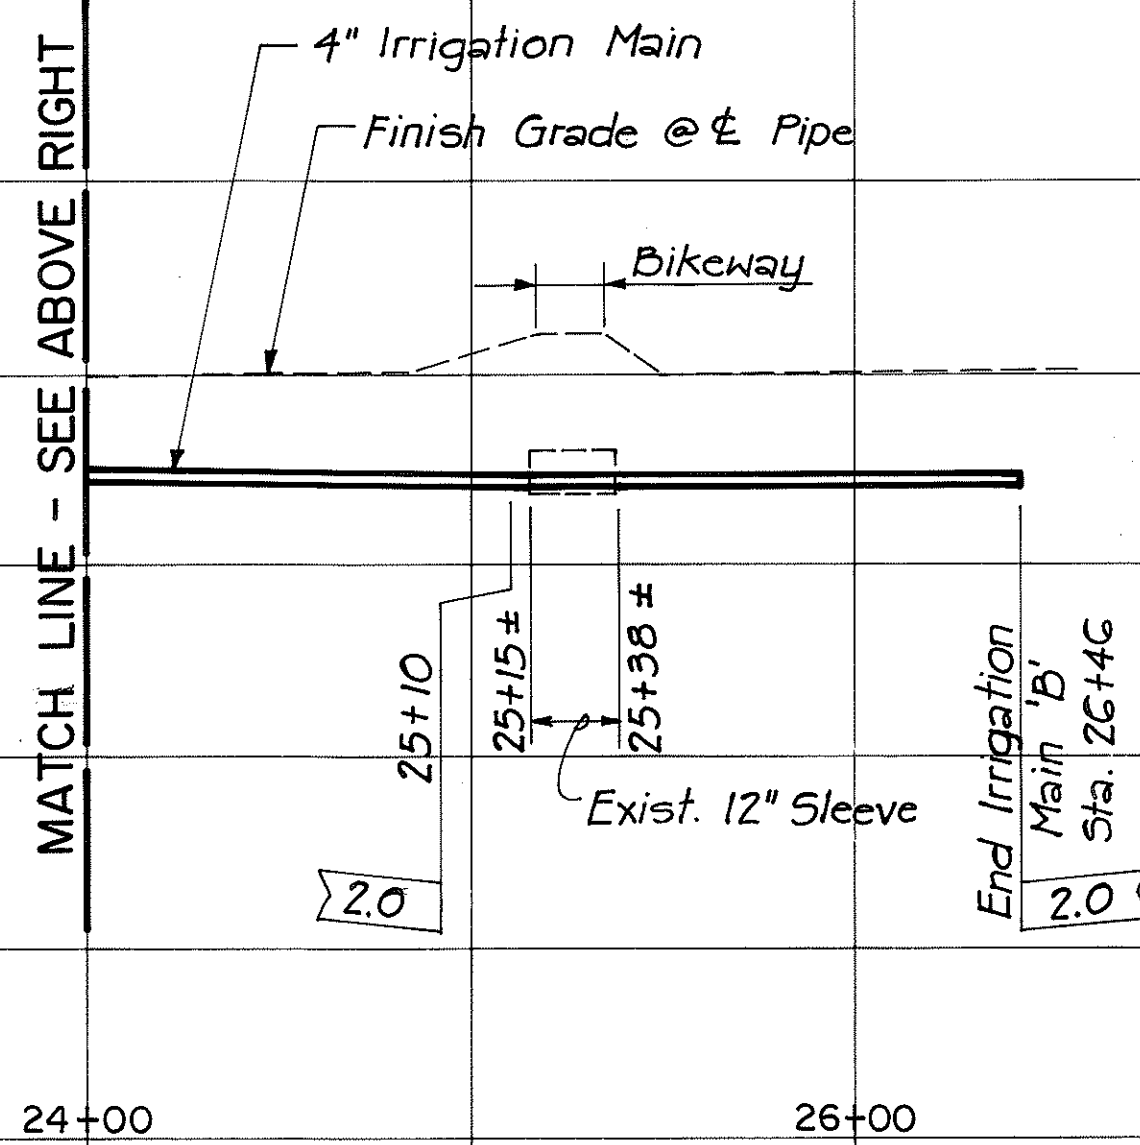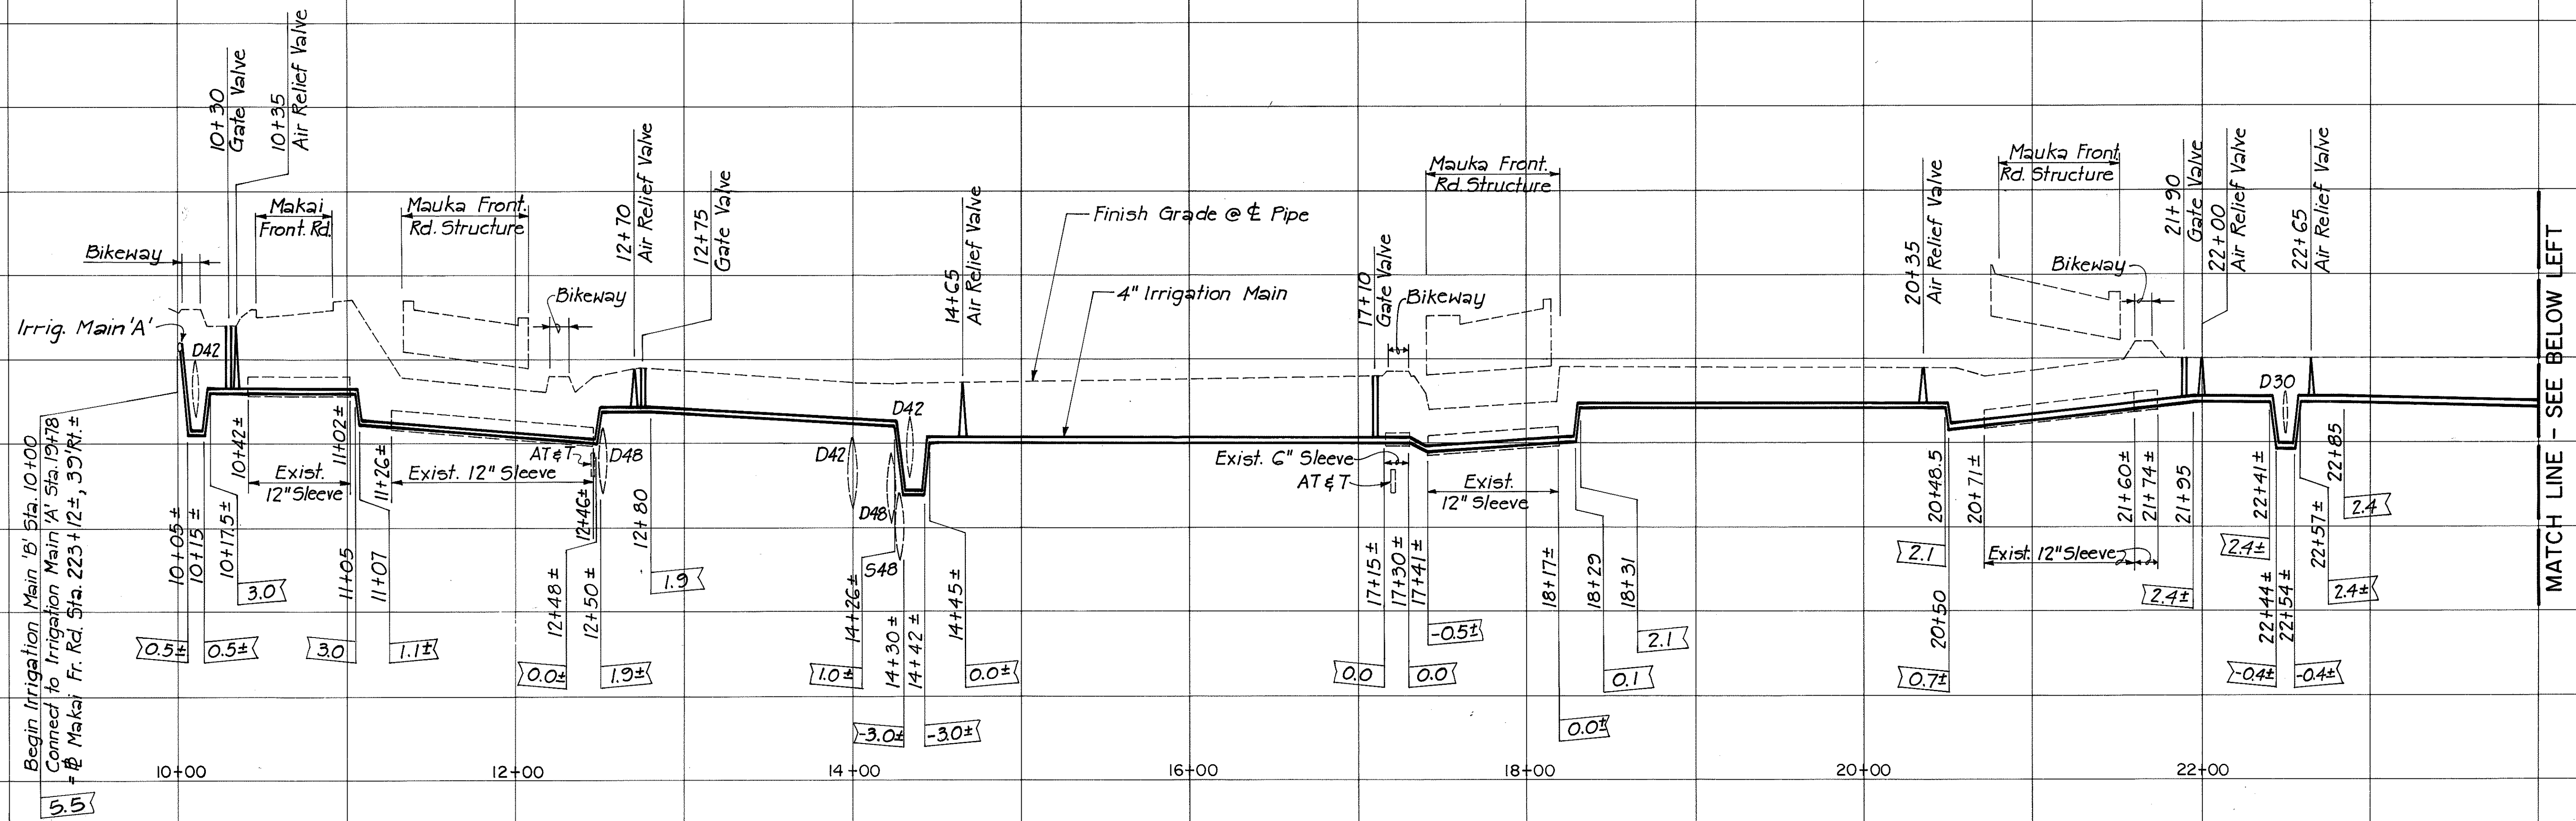

IRRIGATION MAIN 'B'

SCALE: HORIZ. 1" = 50'
VERT. 1" = 5'

NOTE:
Profile shall be adjusted as necessary to maintain minimum 2 feet pipe cover.

ESTIMATED QUANTITY:
4" Irrigation Main - 1770 Lin. Ft.

STATE OF HAWAII
DEPARTMENT OF TRANSPORTATION
HIGHWAYS DIVISION

IRRIGATION MAIN PROFILES

KEEHI INTERCHANGE LANDSCAPING
(WEST OF MOANALUA STREAM)
FAIP NO. IR-HI-1(200)17

SCALE: AS SHOWN DATE: 12/15/1986
SHEET NO. 17 OF 20 SHEETS

SURVEY PLOTTED BY	DATE
DRAWN BY	
DESIGNED BY	
QUANTITIES BY	
CHECKED BY	
ORIGINAL PLAN	
NOTE BOOK	
No.	