



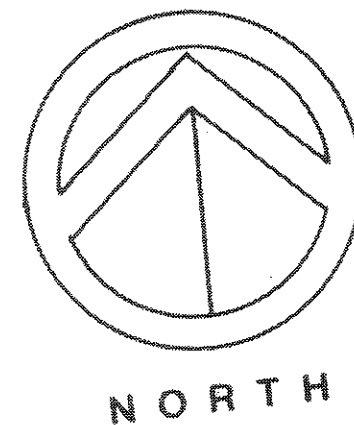

FED. ROAD DIST. NO.	STATE	FED. AID PROJ. NO.	FISCAL YEAR	SHEET NO.	TOTAL SHEETS
HAWAII	HAW.	IR-HI-1(200)47	1986	9	22

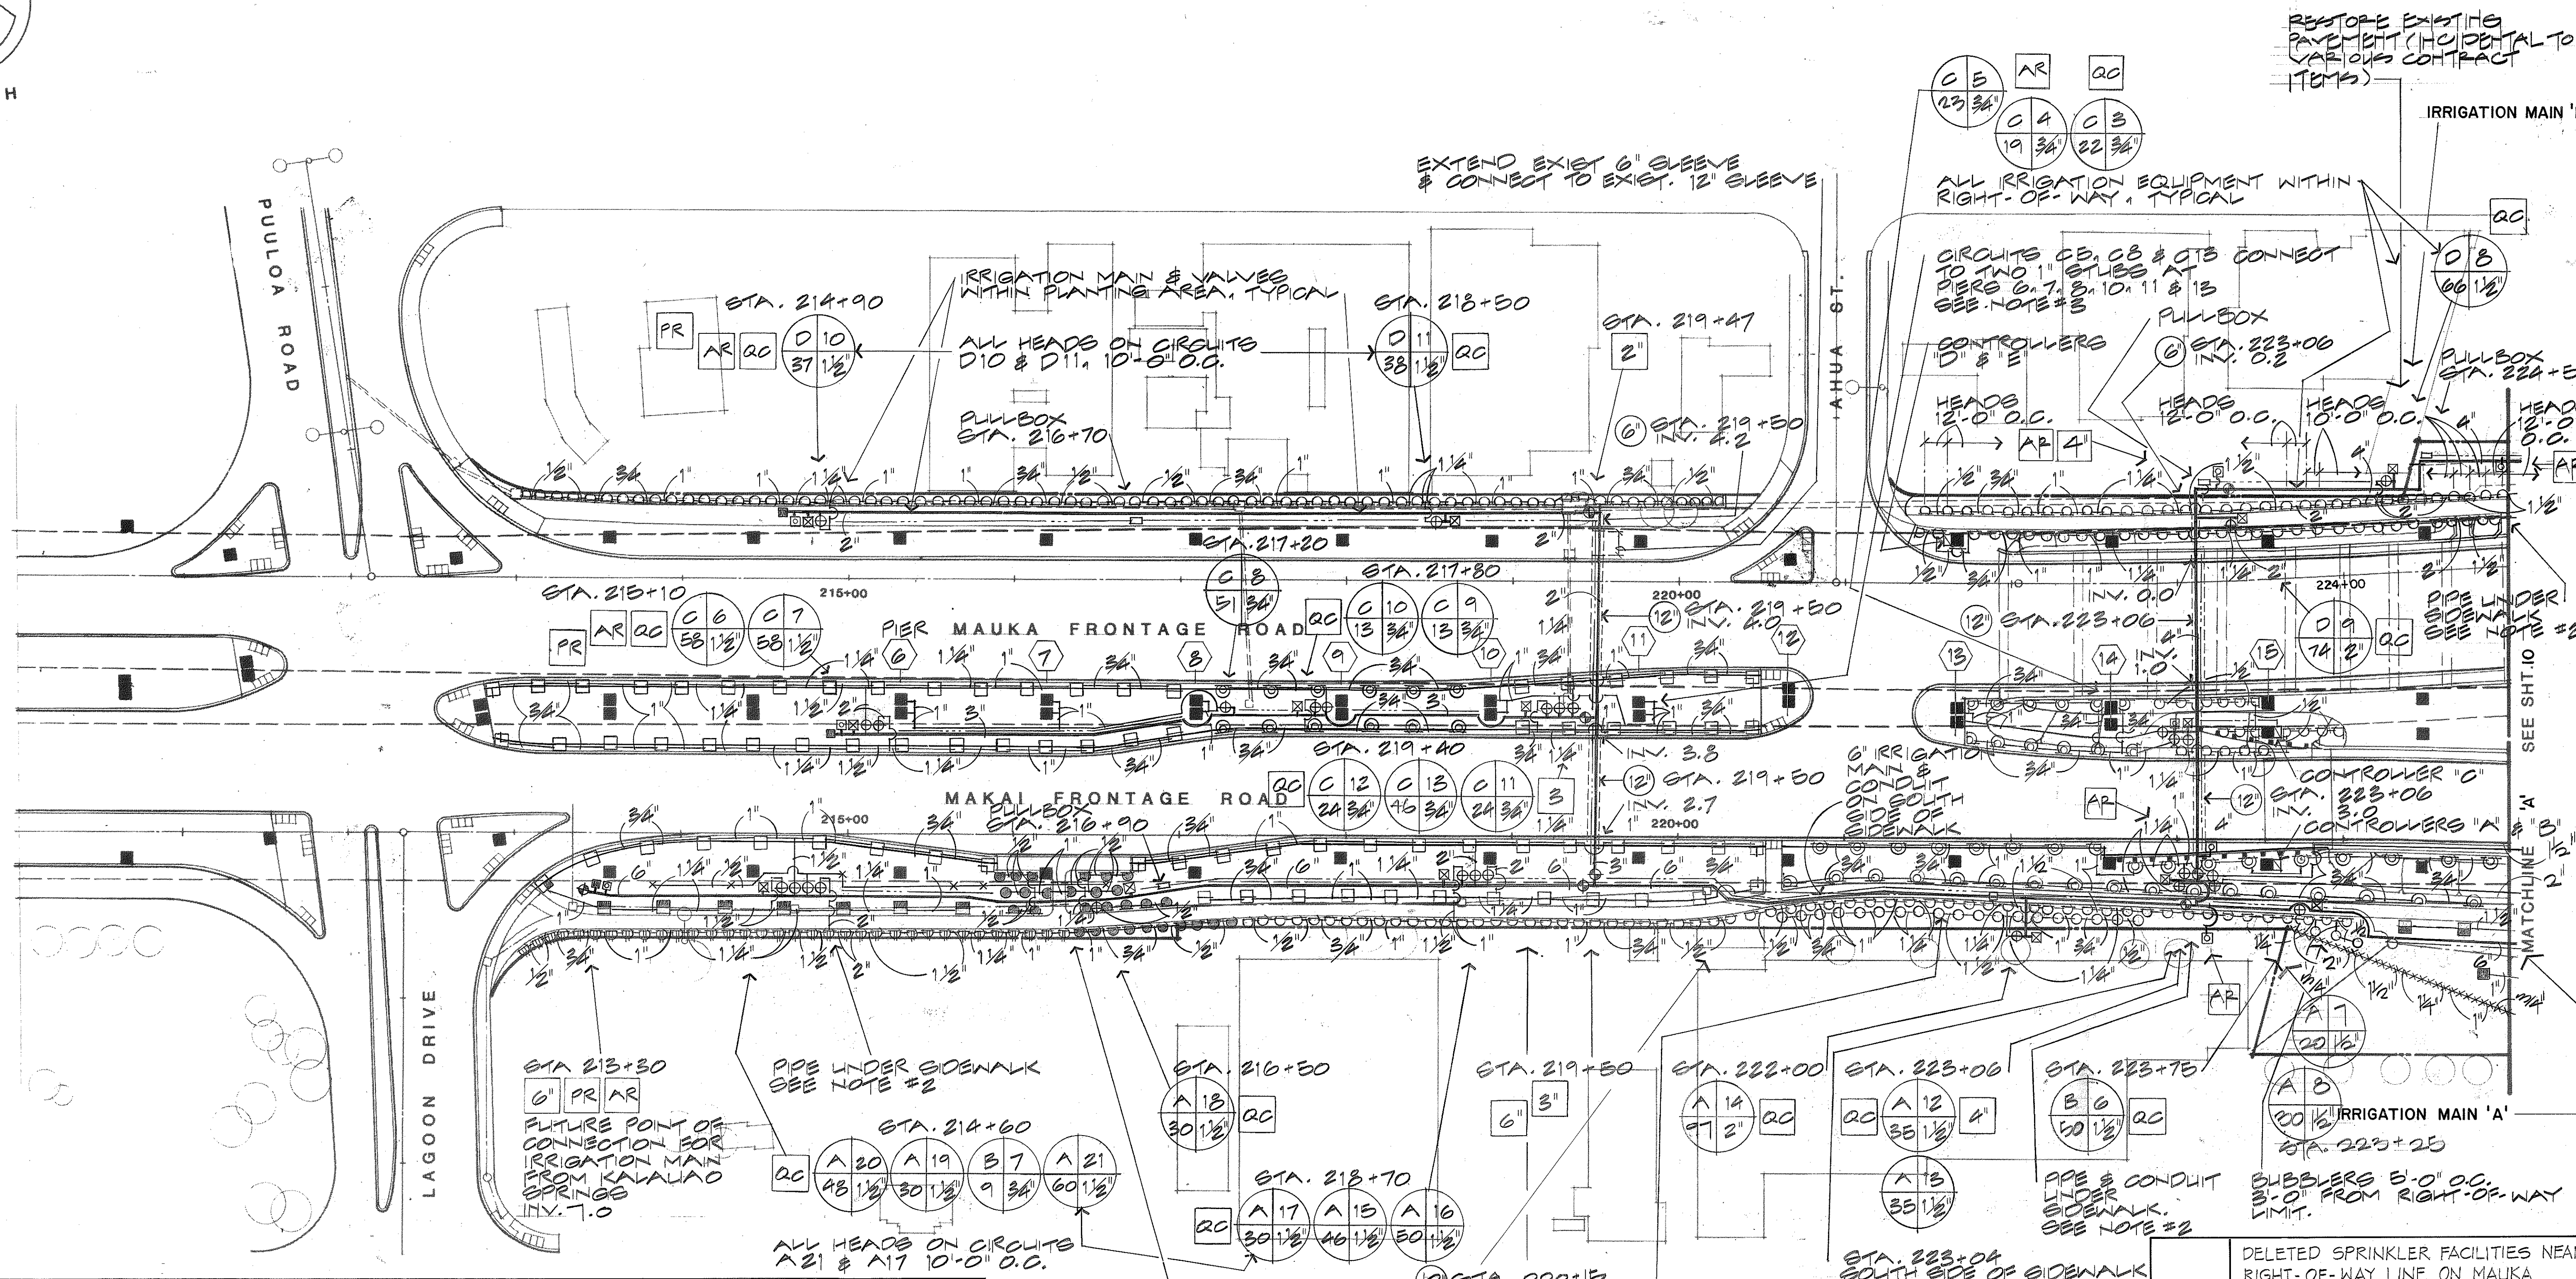

NOTE

- IRRIGATION MAIN INSTALLED BY OTHERS AT CONNECTION POINT AT MAKAI FRONTAGE ROAD STA. 242+04 (SEE SHT. 10 & 11) WILL BE IN SERVICE ON OR BEFORE 30 WORKING DAYS FROM THE DATE OF NOTICE-TO-PROCEED.
- ALL PIPES & CONDUITS CROSSING SIDEWALKS WHERE SLEEVES DO NOT EXIST SHALL BE INSTALLED BY JACKING. DO NOT CUT OR DAMAGE EXISTING PAVEMENT.
- INVERT ELEVATIONS OF EXISTING 1" STUBS TO VIADUCT PLANTERS:
PER INVERT ELEV. 1'-0" O.C.
PER INVERT ELEV. 1'-0" O.C.
PER INVERT ELEV. 1'-0" O.C.
- CONTROLLER "A" SHALL HAVE 23 STATIONS. CONTROLLER "C" SHALL HAVE 13 STATIONS, & CONTROLLERS "B", "D", & "E" SHALL HAVE 12 STATIONS.

NOTE:

CAUTION HIGH PRESSURE GAS LINE ON MAKAI SIDE OF MAKAI FRONTAGE ROAD. SEE UTILITY SHEET U-1.
FOR NOTES ON GAS LINE SEE SHT. C.O. II.


ALL FULL CIRCLE HEADS EQUALLY SPACED BETWEEN SIDEWALK & RIGHT-OF-WAY LIMIT



THIS WORK WAS PREPARED BY ME OR UNDER MY SUPERVISION


DATE	3/1/87	REVISION	DELETED SPRINKLER FACILITIES NEAR RIGHT-OF-WAY LINE ON MAKAI SIDE FROM STA. 224+40 TO STA. 225+00
STATE OF HAWAII DEPARTMENT OF TRANSPORTATION HIGHWAYS DIVISION			
IRRIGATION PLAN			
KEEHI INTERCHANGE LANDSCAPING (WEST OF MOANALUA STREAM) FAIP NO. IR-HI-1(200):17			
SCALE: 1" = 50'-0" DATE: MAY 1986			
SHEET No. 9 OF 20 SHEETS			

C.O. ADD. 9

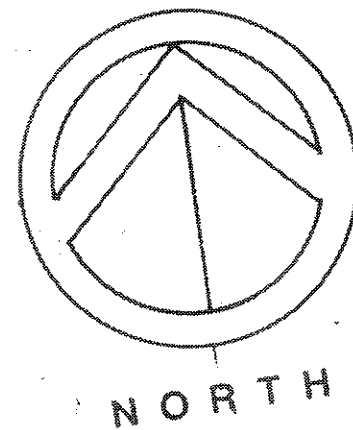


LIMITS OF CONTRACT ALONG EDGE OF STREAM

FED. ROAD DIST. NO.	STATE	FED. AID PROJ. NO.	FISCAL YEAR	SHEET NO.	TOTAL SHEETS
HAWAII	HAW.	IR-HI-1(200)17	1986	10	22

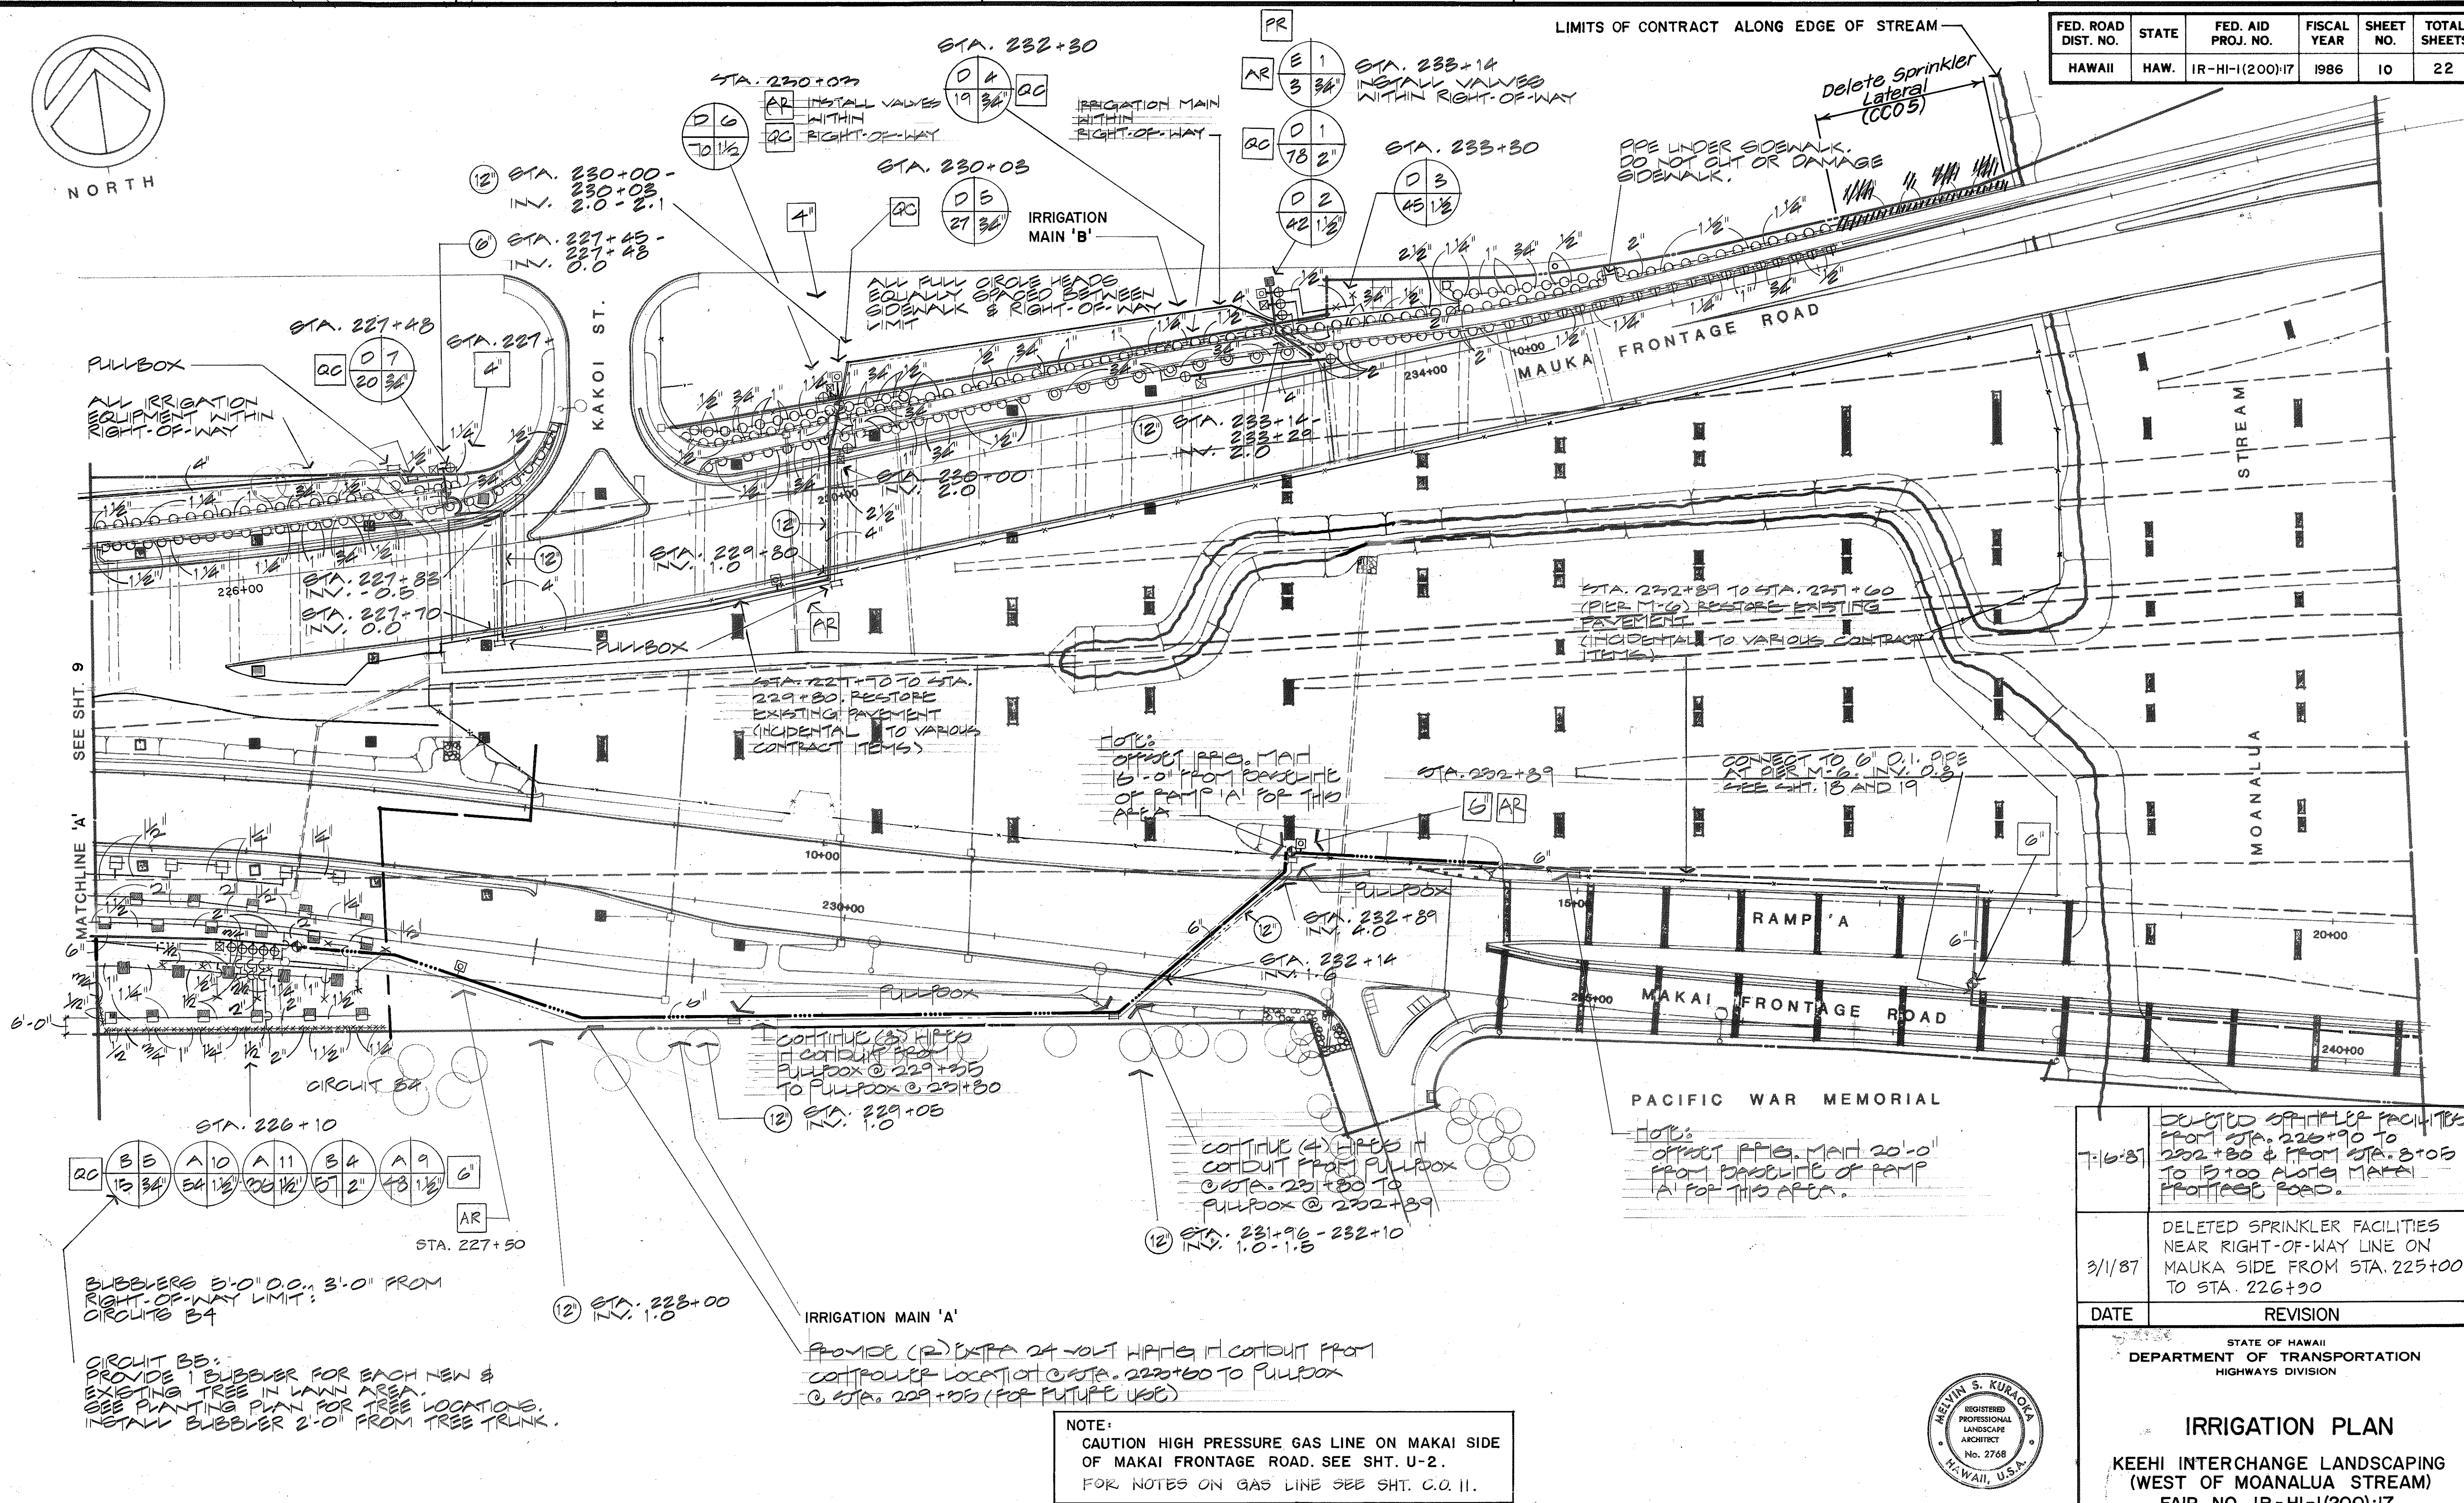

DATE	
DESIGNED BY	
DRAWN BY	
CHECKED BY	
NOTED BY	
NO.	

7/16/87	DELETED SPRINKLER FACILITIES FROM STA. 226+90 TO 227+80 & FROM STA. 8+05 TO 15+00 ALONG MAUKA FRONTAGE ROAD.
3/1/87	DELETED SPRINKLER FACILITIES NEAR RIGHT-OF-WAY LINE ON MAUKA SIDE FROM STA. 225+00 TO STA. 226+90
DATE	REVISION
STATE OF HAWAII DEPARTMENT OF TRANSPORTATION HIGHWAYS DIVISION	
IRRIGATION PLAN	
KEEHI INTERCHANGE LANDSCAPING (WEST OF MOANALUA STREAM) FAIP NO. IR-HI-1(200)17	
SCALE: 1"=50'-0"	DATE: MAY 1986
SHEET No. 10 OF 20 SHEETS	

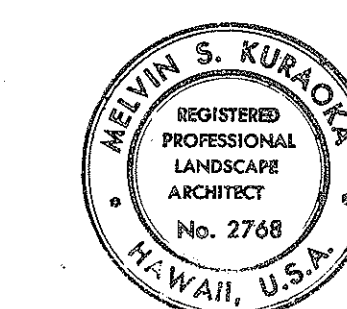

THIS WORK WAS PREPARED BY ME OR UNDER MY SUPERVISION

NOTE:
CAUTION HIGH PRESSURE GAS LINE ON MAKAI SIDE OF MAKAI FRONTAGE ROAD. SEE SHT. U-2.
FOR NOTES ON GAS LINE SEE SHT. C.O. 11.

C.O. ADD. 10