


INDEX TO DRAWINGS	
SHEET NO.	DESCRIPTION
1	TITLE SHEET
2 - 3	CONSTRUCTION PLAN
4	PAVING & EARTHWORK DETAILS
5 - 6	PLANTING PLAN
7	VIADUCT PLANTING DETAILS
8	PLANT LIST, NOTES & DETAILS
9 - 10	IRRIGATION PLAN
11	VIADUCT IRRIGATION PLAN
12	IRRIGATION LEGEND, NOTES & DETAILS
13 - 15	IRRIGATION DETAILS
16 - 17	IRRIGATION MAIN PROFILES
18 - 19	6" IRRIGATION MAIN ON MAKAI FRONT. RD.
20	STRUCTURE CONVERSION OF FREE FALL SCUPPERS ON VIADUCTS
21	UTILITIES PLAN SHT. 'A'
22	UTILITIES PLAN SHT. 'B'



STATE OF HAWAII
DEPARTMENT OF TRANSPORTATION
HIGHWAYS DIVISION
HONOLULU, HAWAII
"AS BUILT"
PLANS FOR
LANDSCAPING OF A PORTION OF
INTERSTATE ROUTE H-1
KEEHI INTERCHANGE
WEST OF MOANALUA STREAM
FEDERAL AID INTERSTATE PROJECT NO. IR-HI-1(200):17
DISTRICT OF HONOLULU
ISLAND OF OAHU

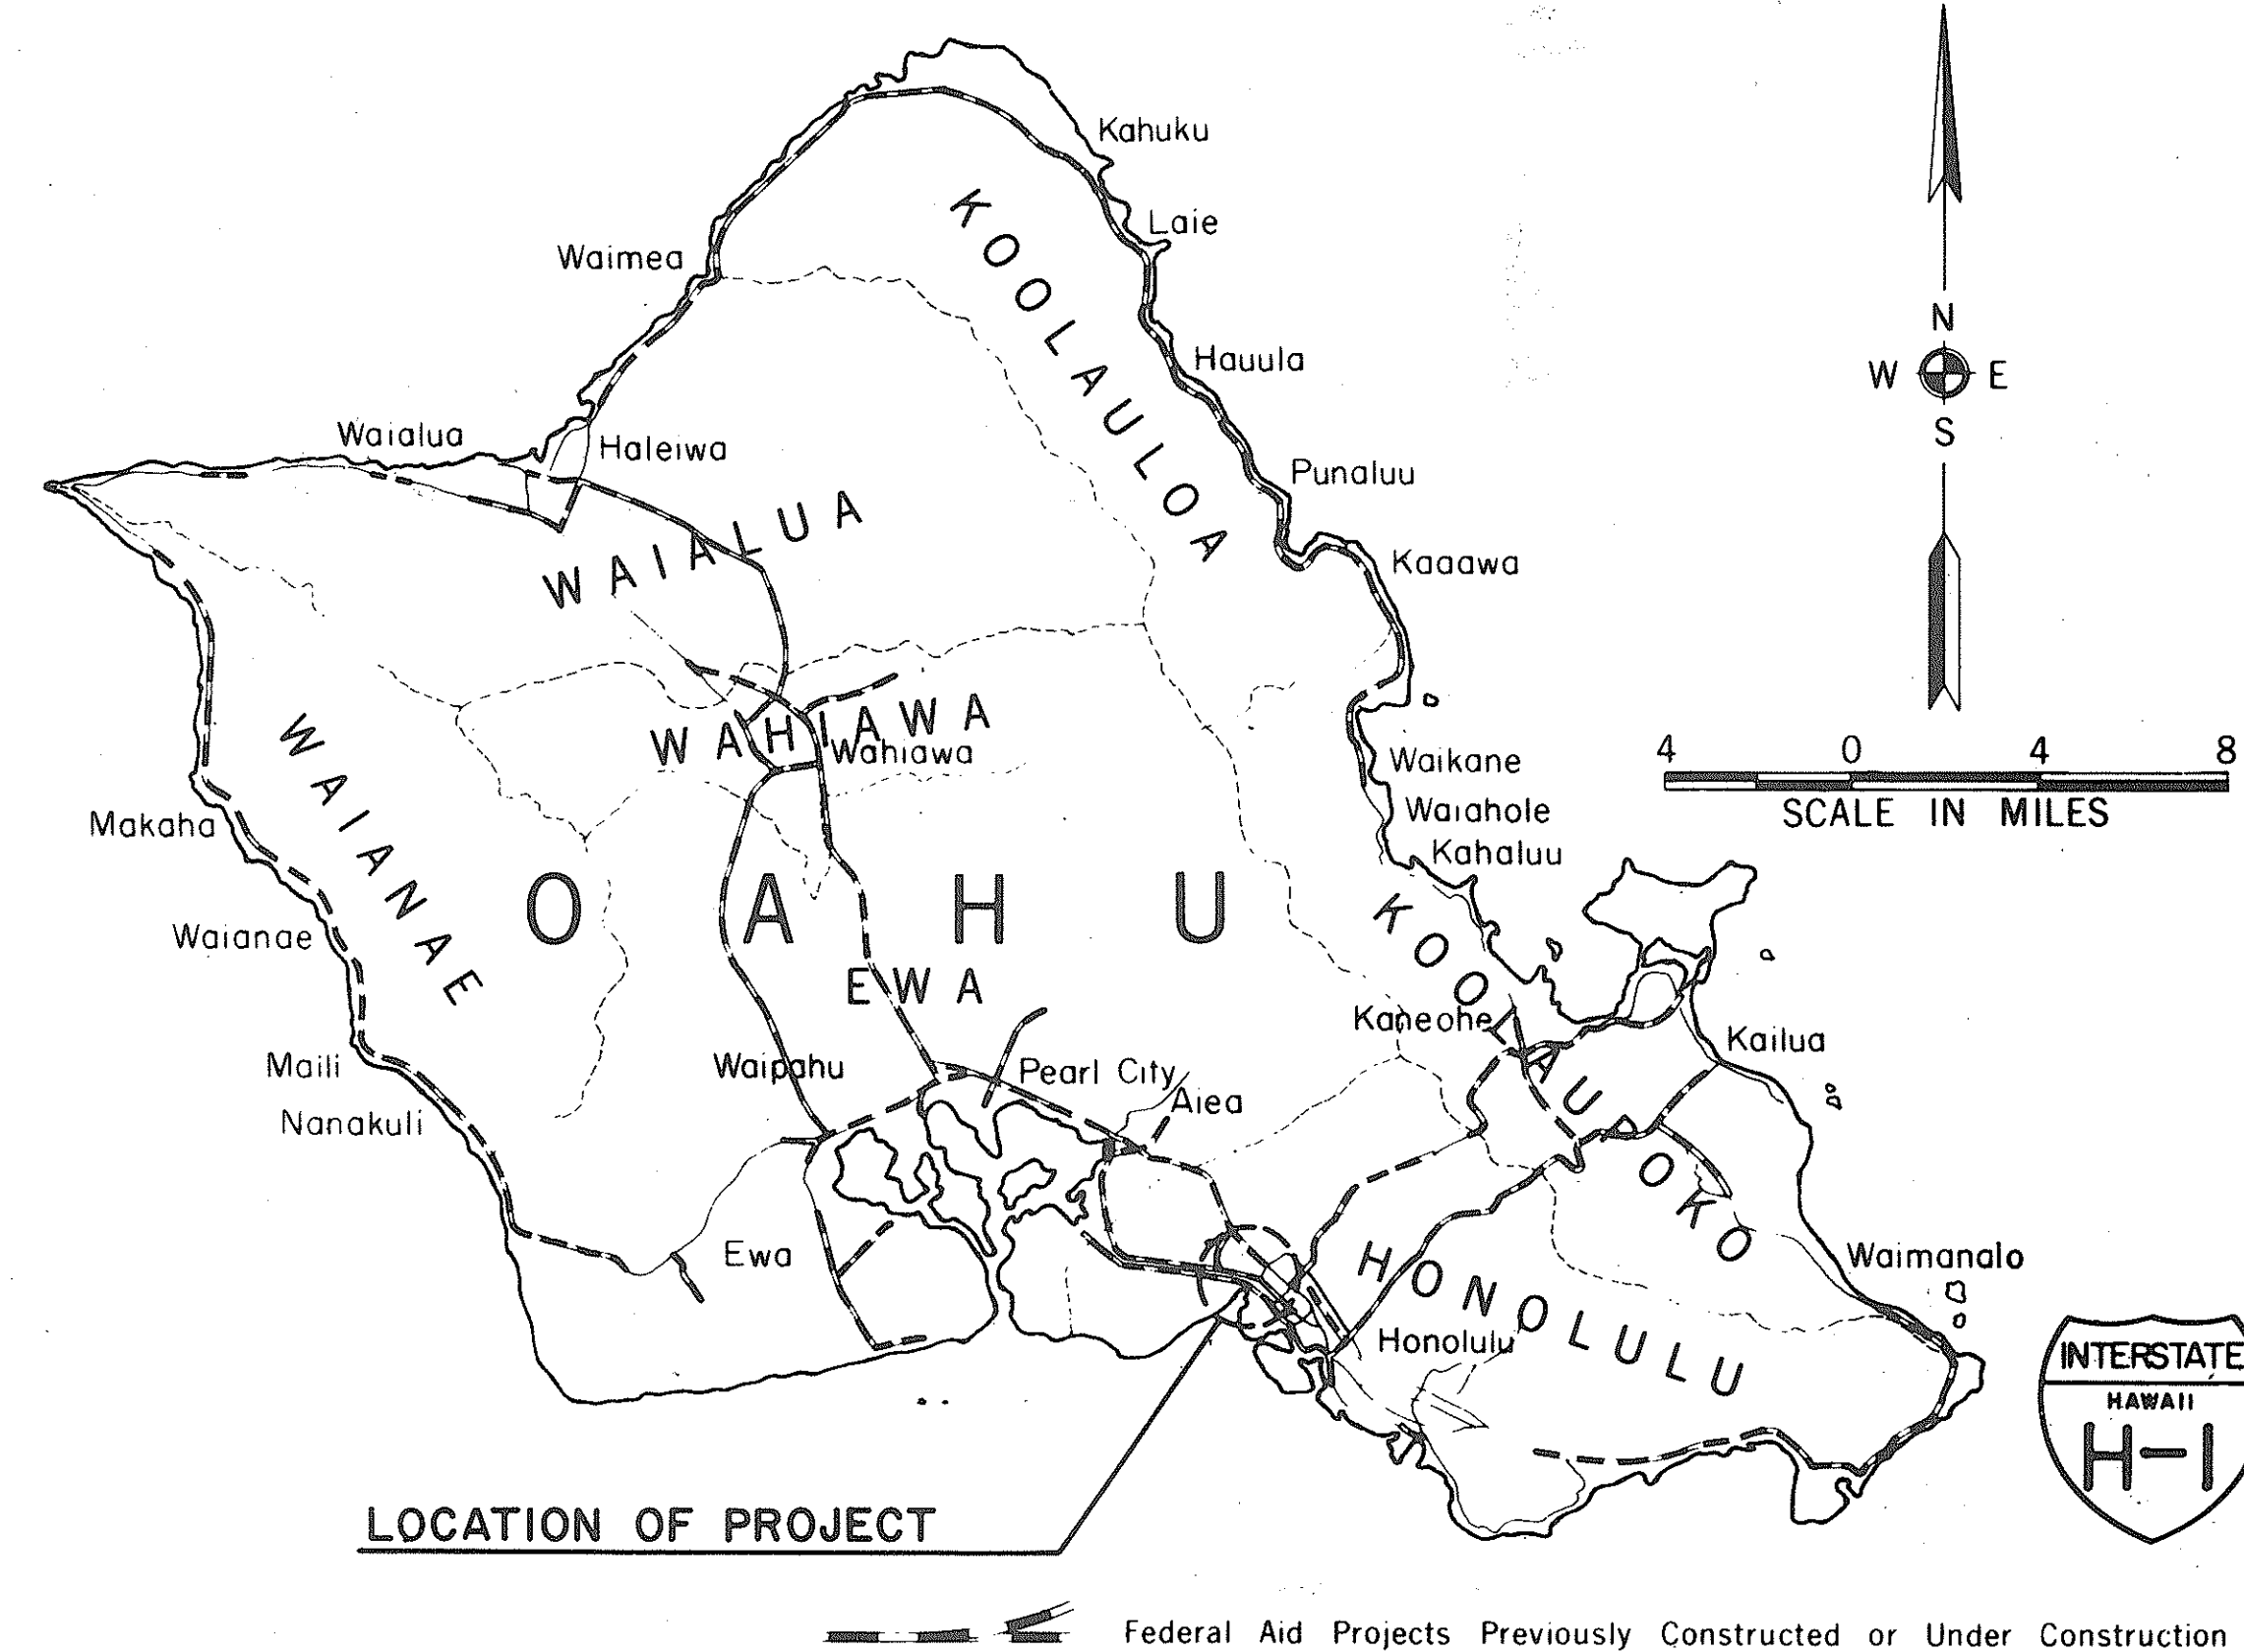

DESIGN CLASSIFICATION


DESIGN ADT (1994)..... 98,000
DHV..... 10,800
D..... 60/40
T..... 5%
V..... 60 MPH

CHANGES MADE DURING CONSTRUCTION HAVE BEEN INCORPORATED ON THESE PLANS EXCEPT CHANGES IN THE ORIGINAL THEORETICAL QUANTITIES. FOR ACTUAL QUANTITIES, REFER TO PROJECT LEDGER AND/OR COMPUTATION BOOK.

[Signature]
RESIDENT ENGINEER
July 27, 1989
DATE

DEPARTMENT OF TRANSPORTATION
FEDERAL HIGHWAY ADMINISTRATION
APPROVED BY:
[Signature]
DIVISION ADMINISTRATOR
9.24.86
DATE

DEPARTMENT OF TRANSPORTATION
STATE OF HAWAII
APPROVED BY:
[Signature]
DIR. OF TRANSPORTATION
DATE

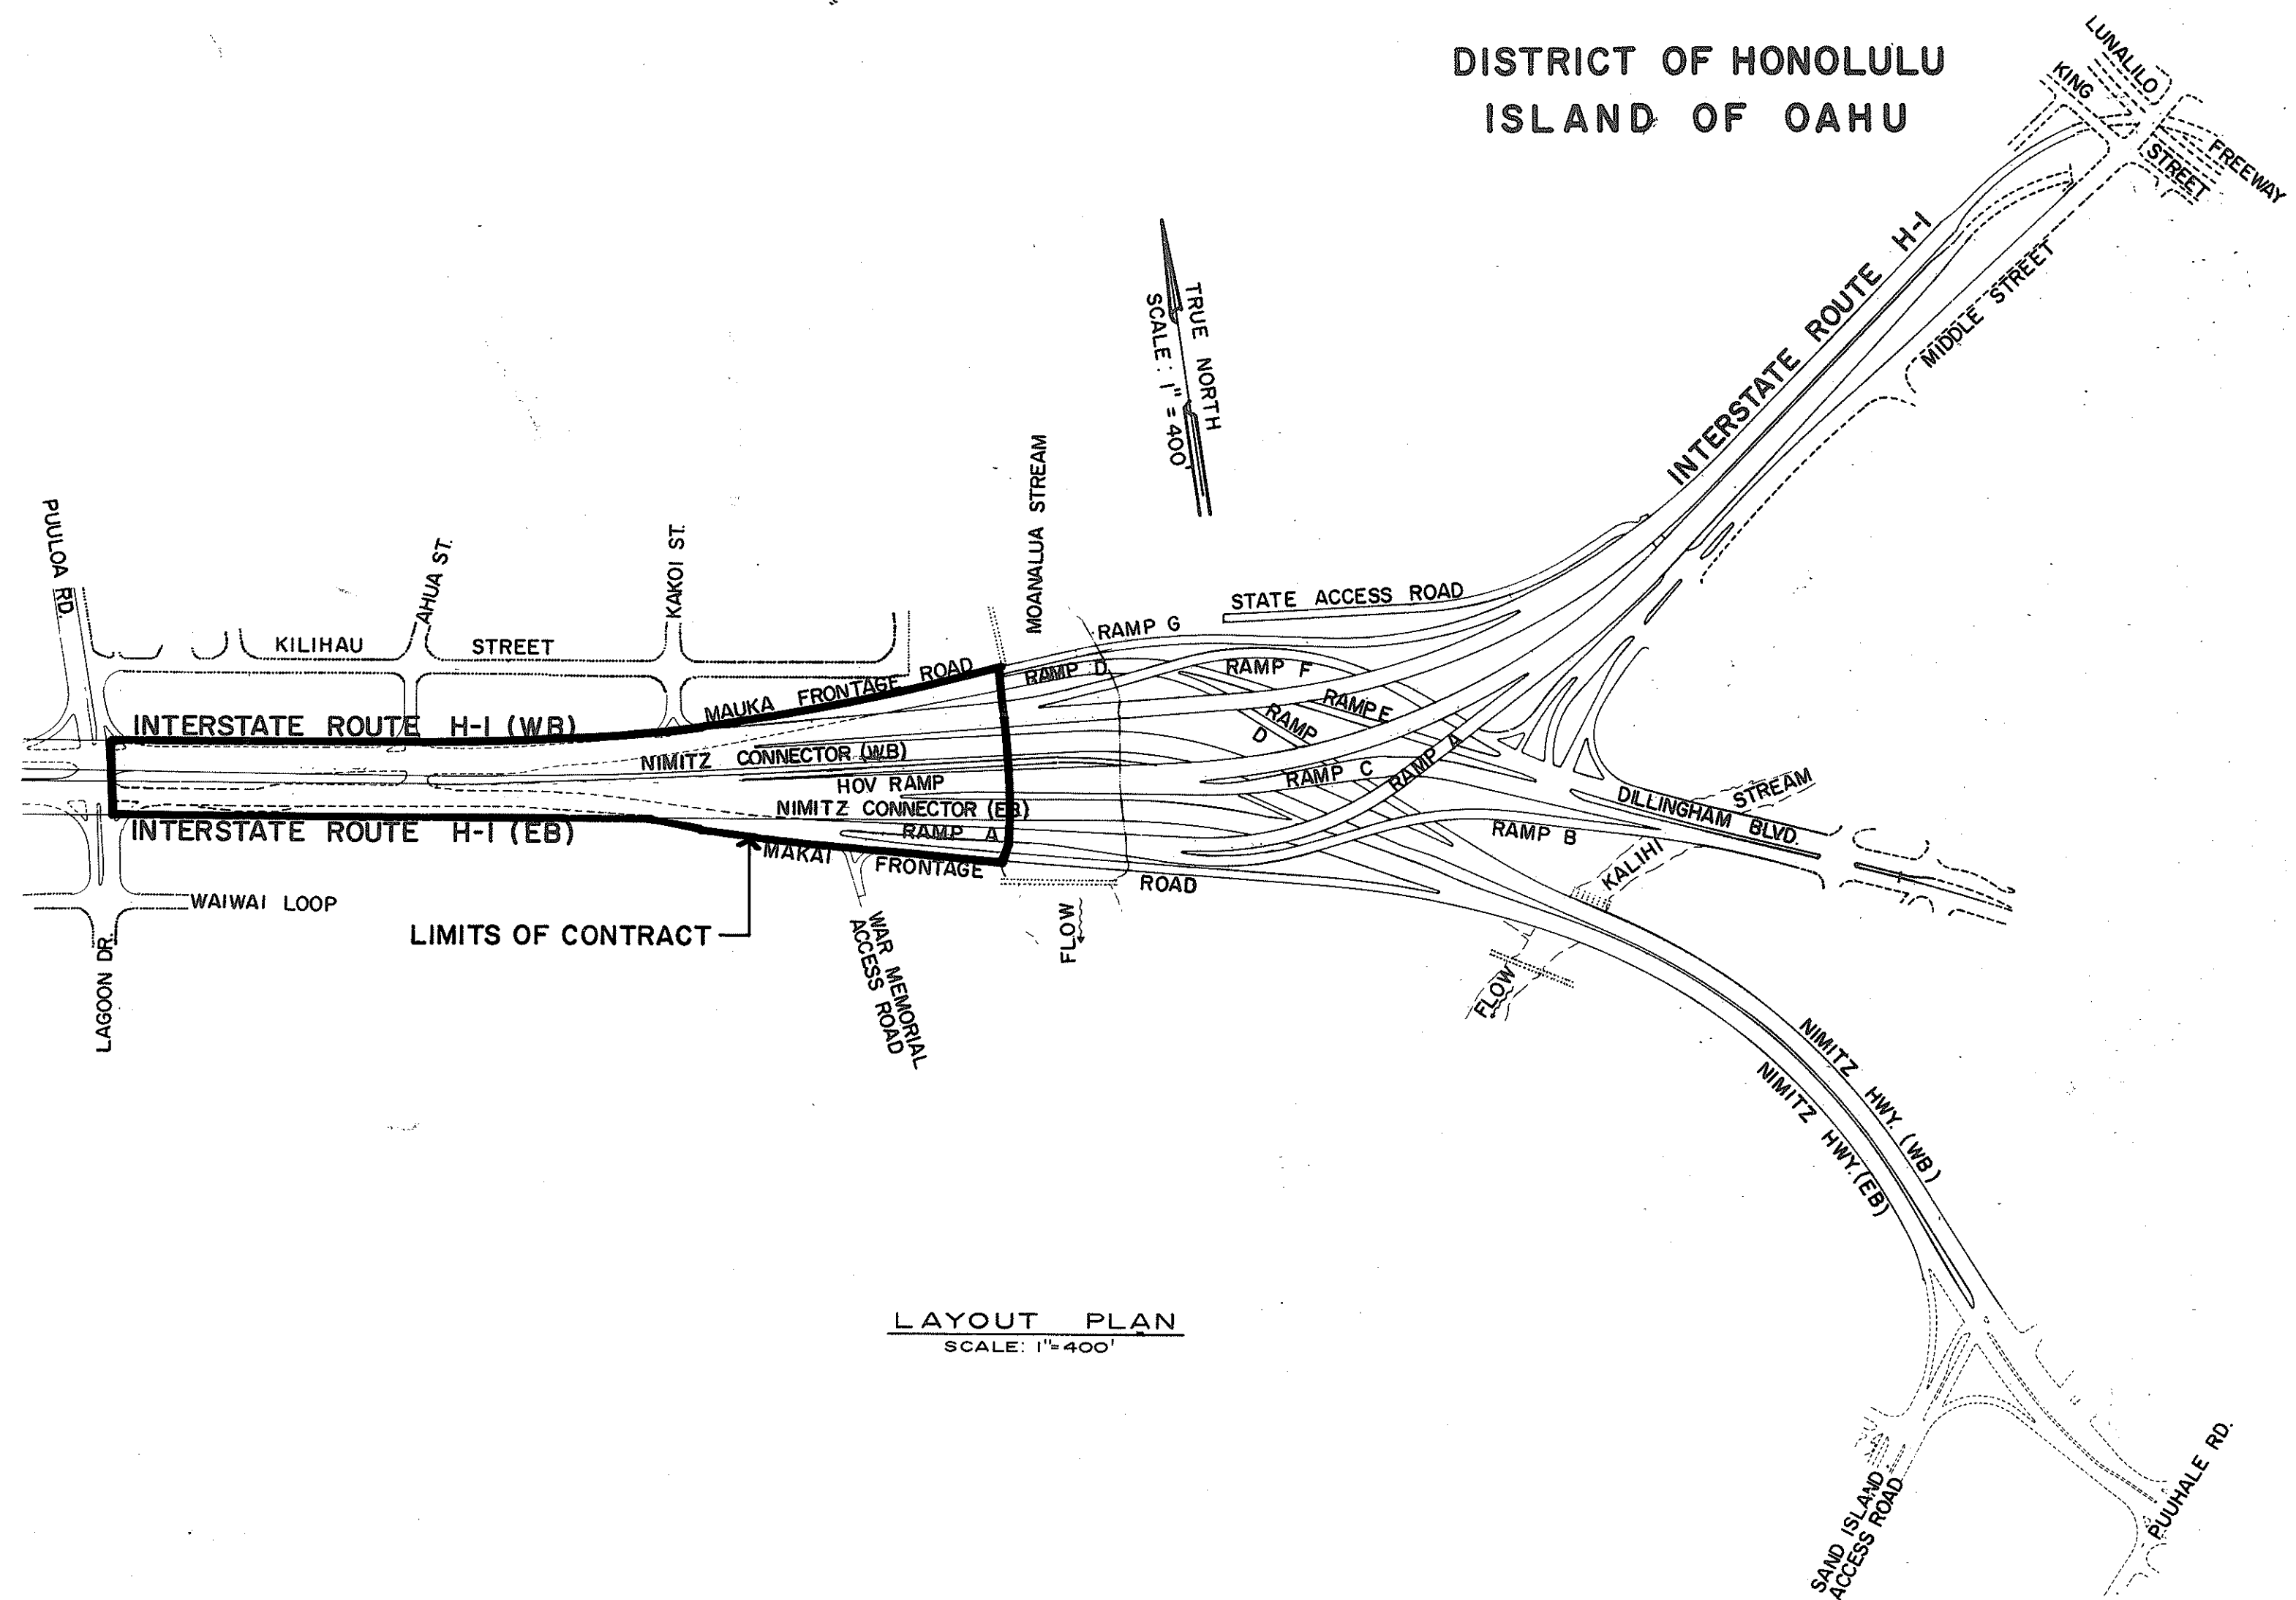

HAWAII DESIGN ASSOC.
DESIGNED BY
PAUL WOLF
P S & E BY
521-3051
PHONE
MAY 1986
DATE

ORIGINAL PLAN	DATE
DRAWN BY	
DESIGNED BY	
QUANTITIES BY	
CHECKED BY	