

INDEX TO DRAWINGS	
SHEET NO.	DESCRIPTION
1	TITLE SHEET
2 - 3	PLANTING & CONSTRUCTION PLAN
4	PLANT LIST, NOTES & DETAILS
5	PLANTING DETAILS
6 - 7	IRRIGATION PLAN
8	IRRIGATION LEGEND, NOTES & DETAILS
9 - 11	IRRIGATION DETAILS
12	IRRIGATION MAIN PROFILES
13	UTILITIES PLAN EXISTING

STATE OF HAWAII

DEPARTMENT OF TRANSPORTATION

HIGHWAYS DIVISION

HONOLULU, HAWAII

"AS-BUILT"

PLANS FOR

LANDSCAPING OF A PORTION OF

INTERSTATE ROUTE H-1

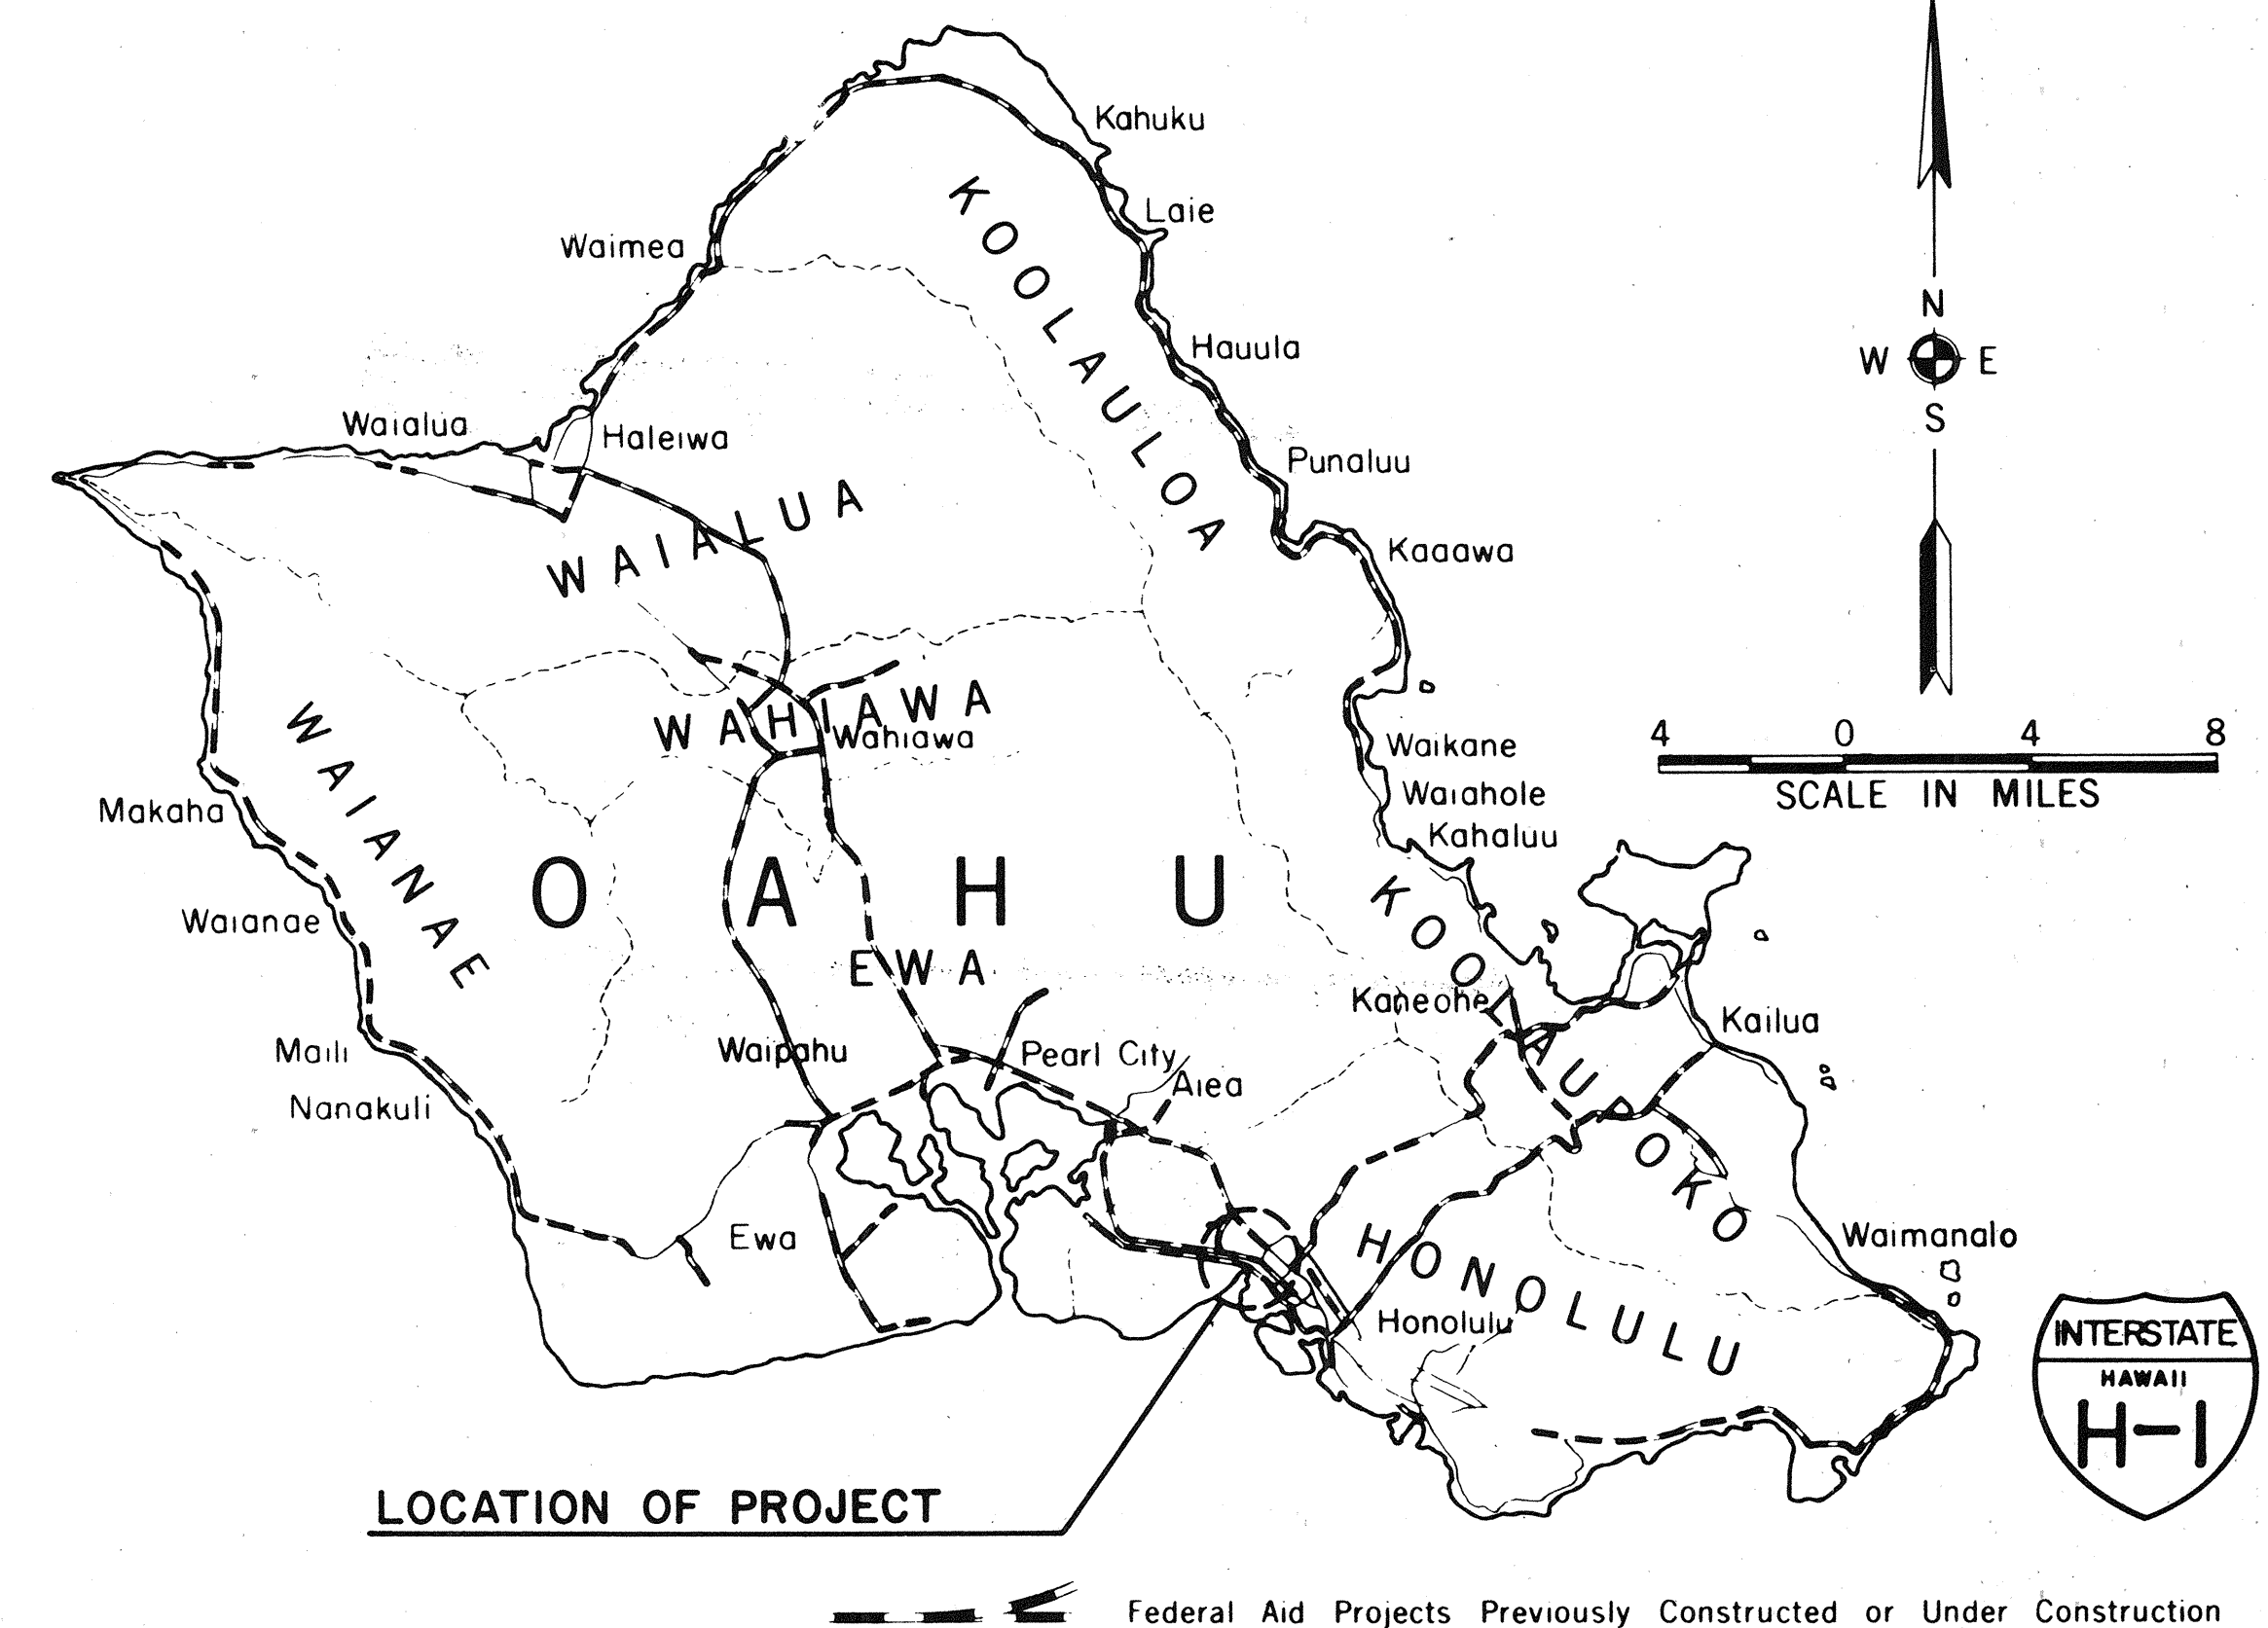
KEEHI INTERCHANGE

EAST OF MOANALUA STREAM

FEDERAL AID INTERSTATE PROJECT NO. IR-HI-1(201):17

DISTRICT OF HONOLULU

ISLAND OF OAHU



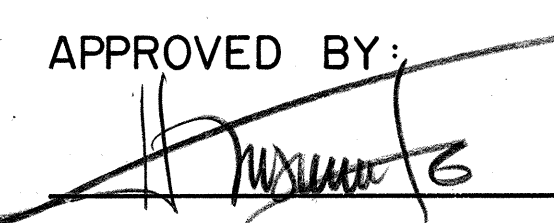
DESIGN CLASSIFICATION

DESIGN ADT (1994).....98,000
 DHV.....10,800
 D.....60/40
 T.....5%
 V.....60 MPH

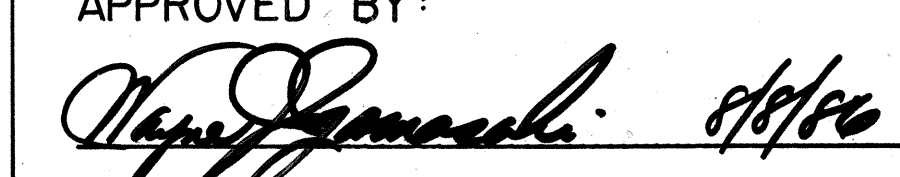
CHANGES MADE DURING CONSTRUCTION HAVE BEEN INCORPORATED ON THESE PLANS EXCEPT CHANGES IN THE ORIGINAL THEORETICAL QUANTITIES. FOR ACTUAL QUANTITIES, REFER TO PROJECT LEDGER AND/OR COMPUTATION BOOK.

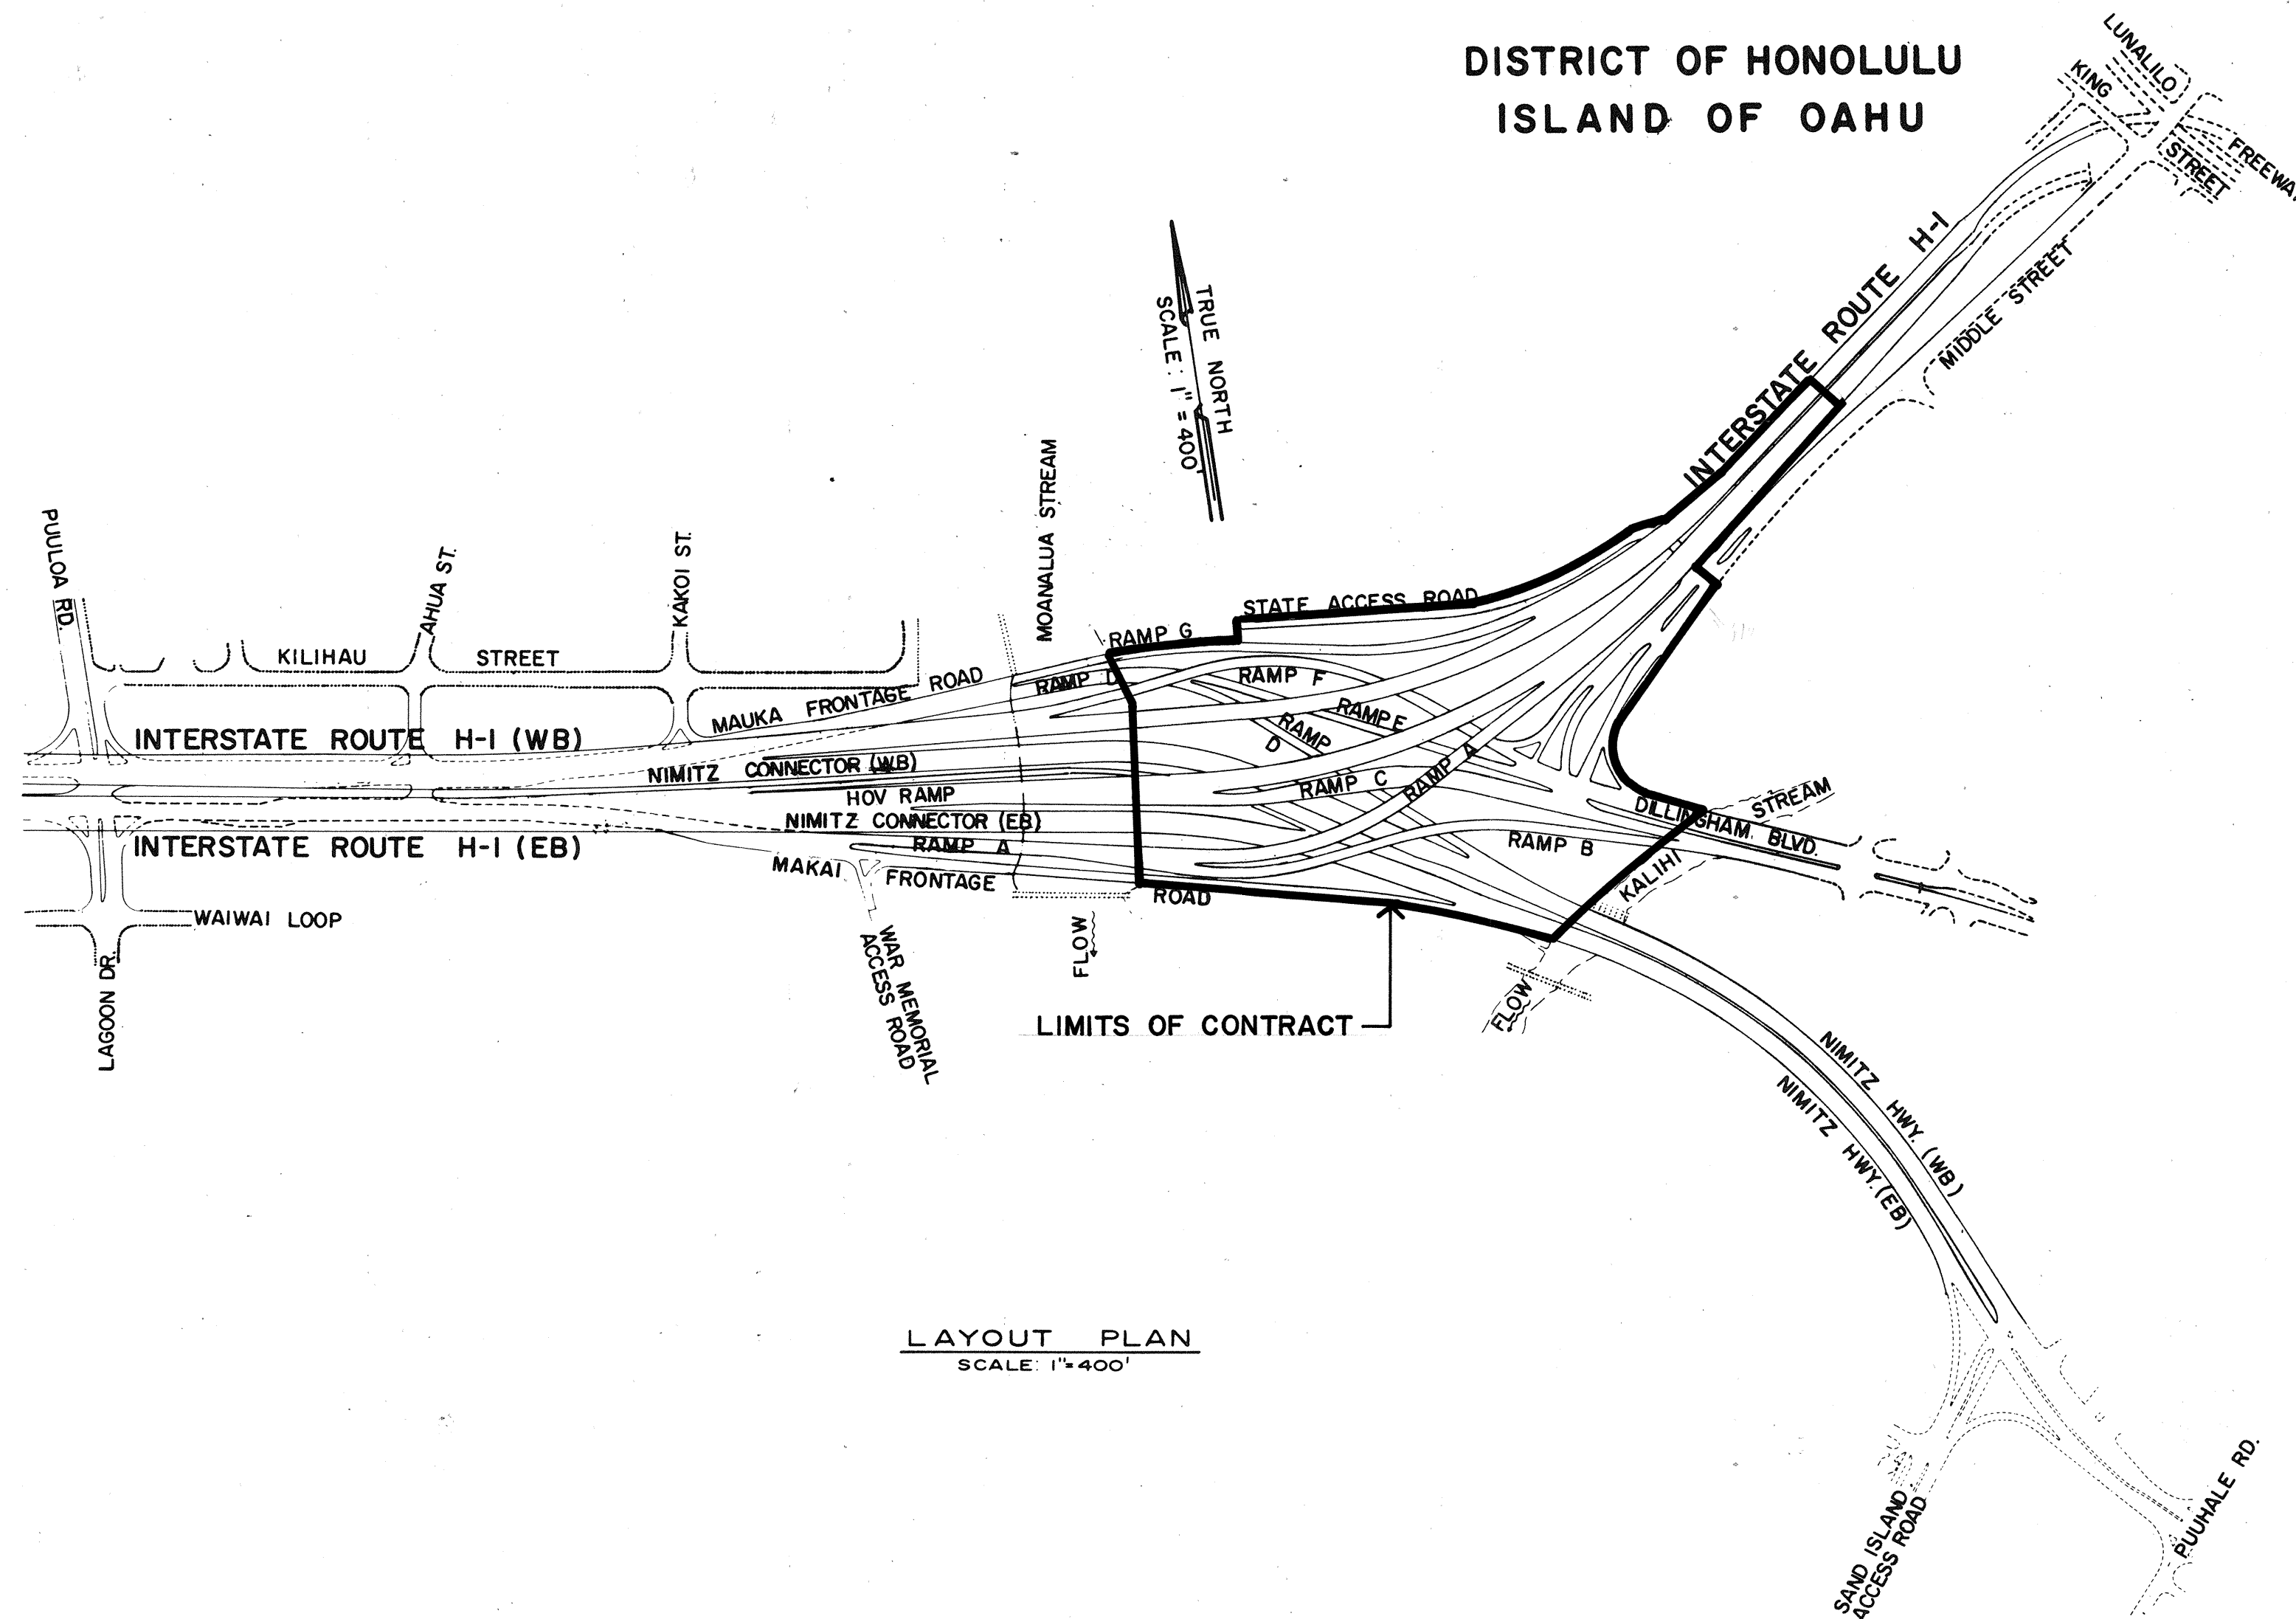
Ward B. Louie
 RESIDENT ENGINEER 7-3-90
 DATE

DEPARTMENT OF TRANSPORTATION
 FEDERAL HIGHWAY ADMINISTRATION

APPROVED BY:

 DIVISION ADMINISTRATOR 9.24.86
 DATE

DEPARTMENT OF TRANSPORTATION
 STATE OF HAWAII

APPROVED BY:

 DIR. OF TRANSPORTATION 8/6/86
 DATE



SURVEY PLOTTED BY
 DRAWN BY
 DESIGNED BY
 CHECKED BY

DATE
 DATE
 DATE
 DATE

HAWAII DESIGN ASSOC. DESIGNED BY PAUL WOLF P S & E BY MAY 1986 DATE
 521-3051 PHONE