



FED. ROAD DIST. NO.	STATE	FED. AID PROJ. NO.	FISCAL YEAR	SHEET NO.	TOTAL SHEETS
HAWAII	HAW.	HPR-0010(10) U-1, U-2	1987	2	8

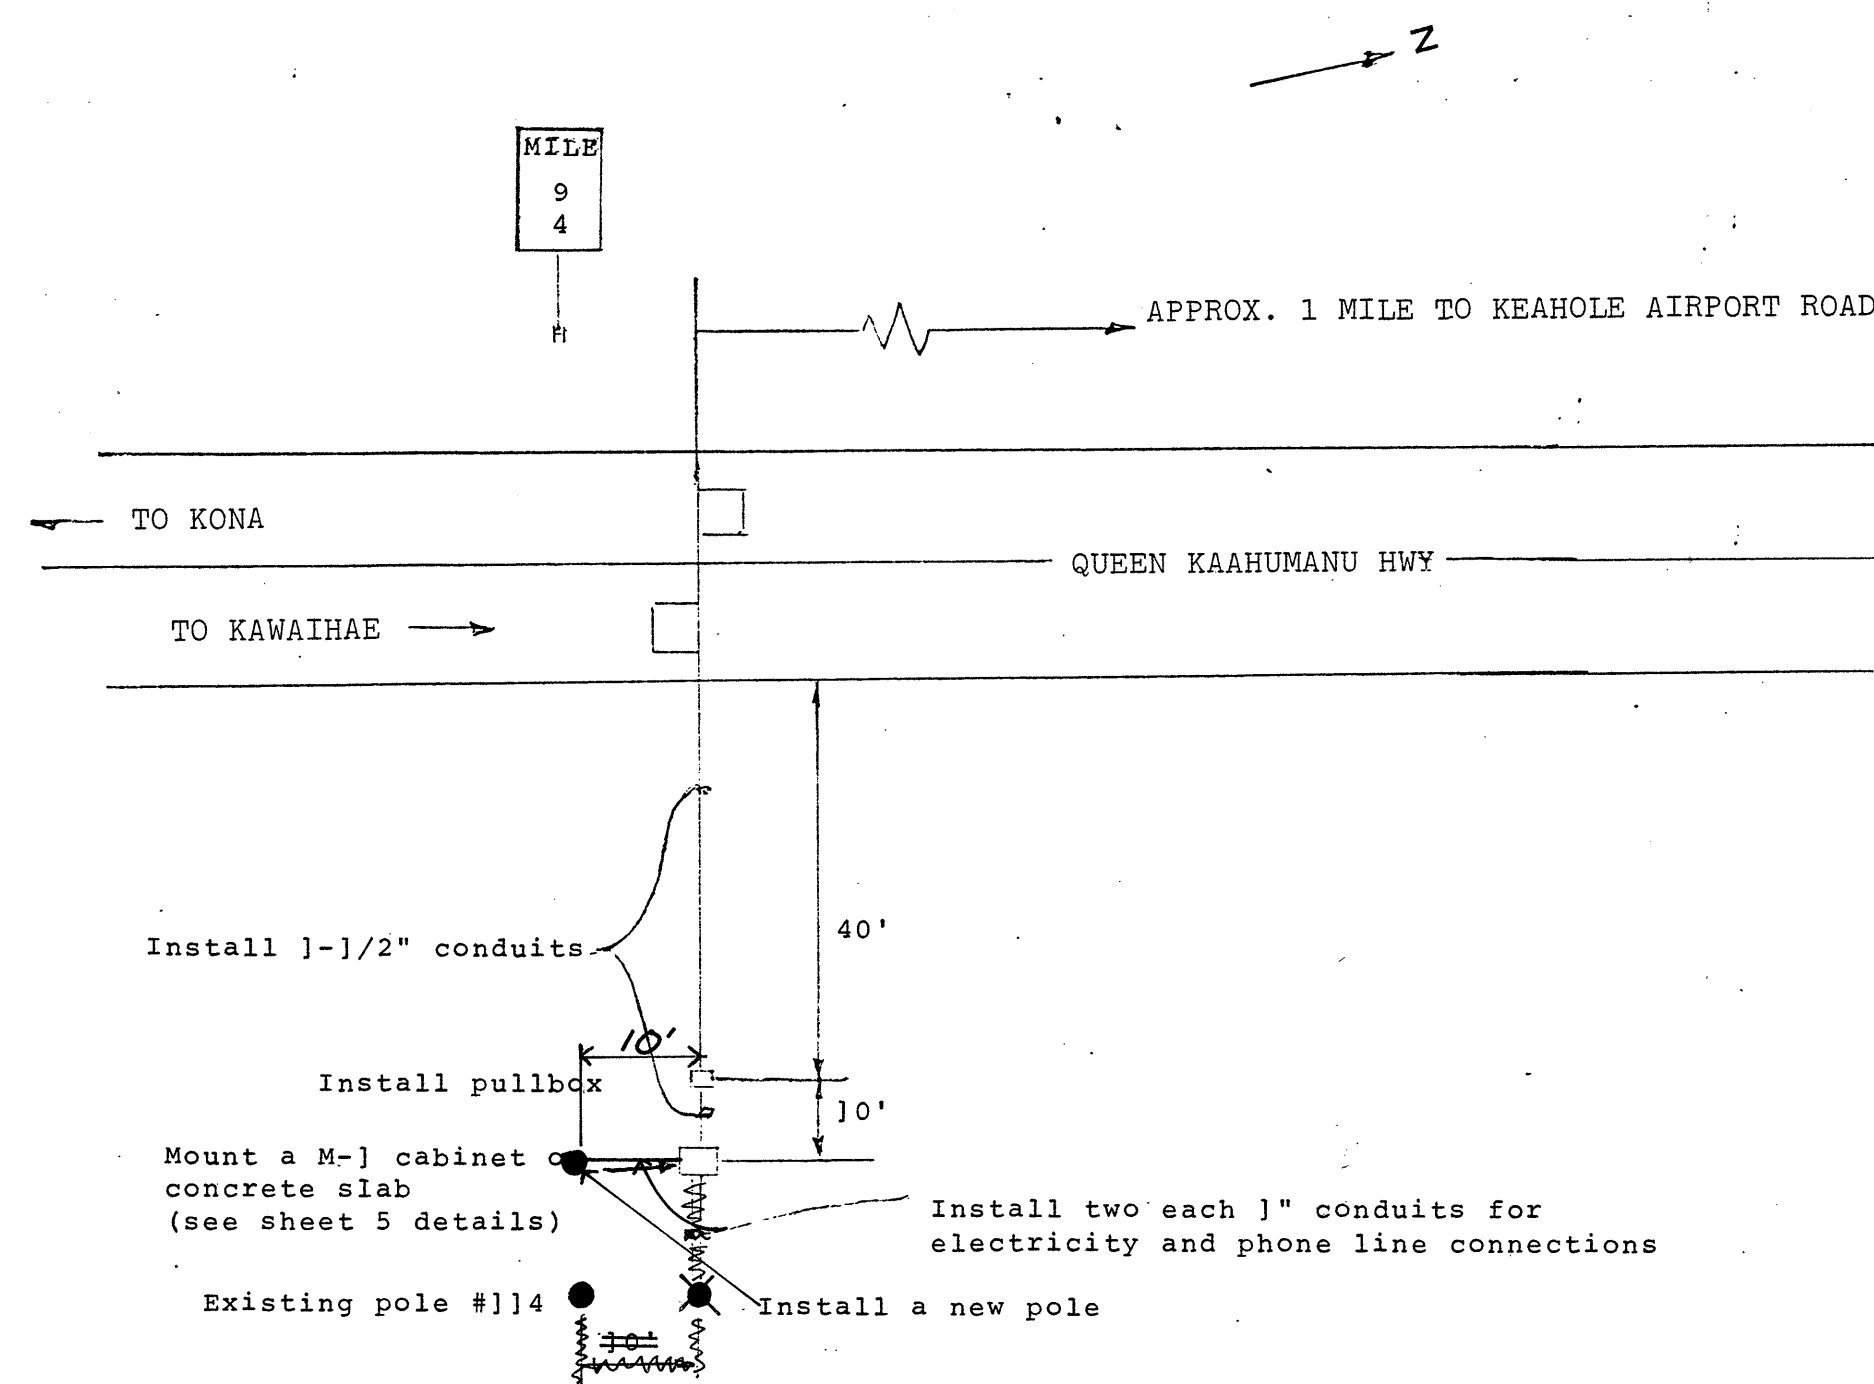


LOCATION 4

QUEEN KAAHUMANU HIGHWAY AT MILEPOST 94

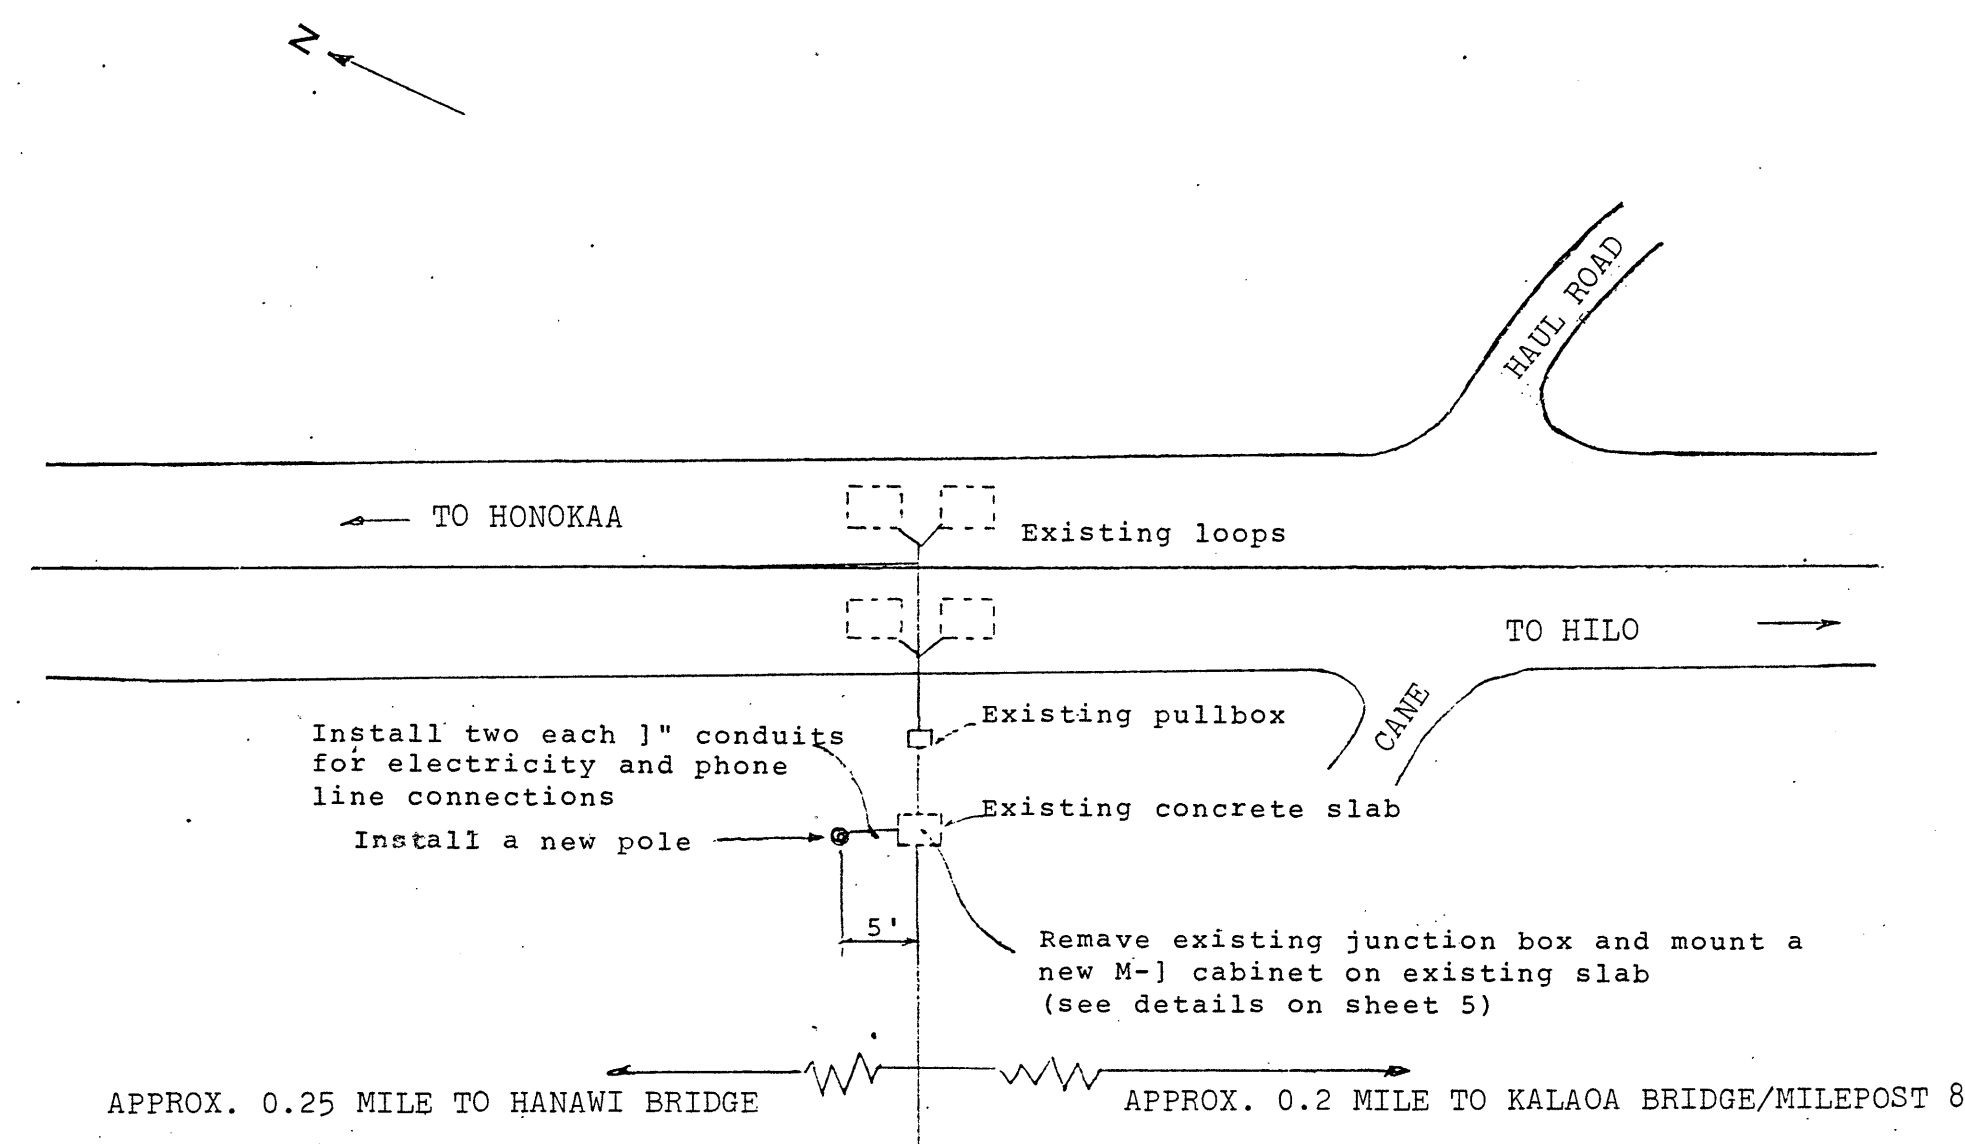


LOCATION 1

HAWAII BELT ROAD IN THE VICINITY OF KALAOA BRIDGE

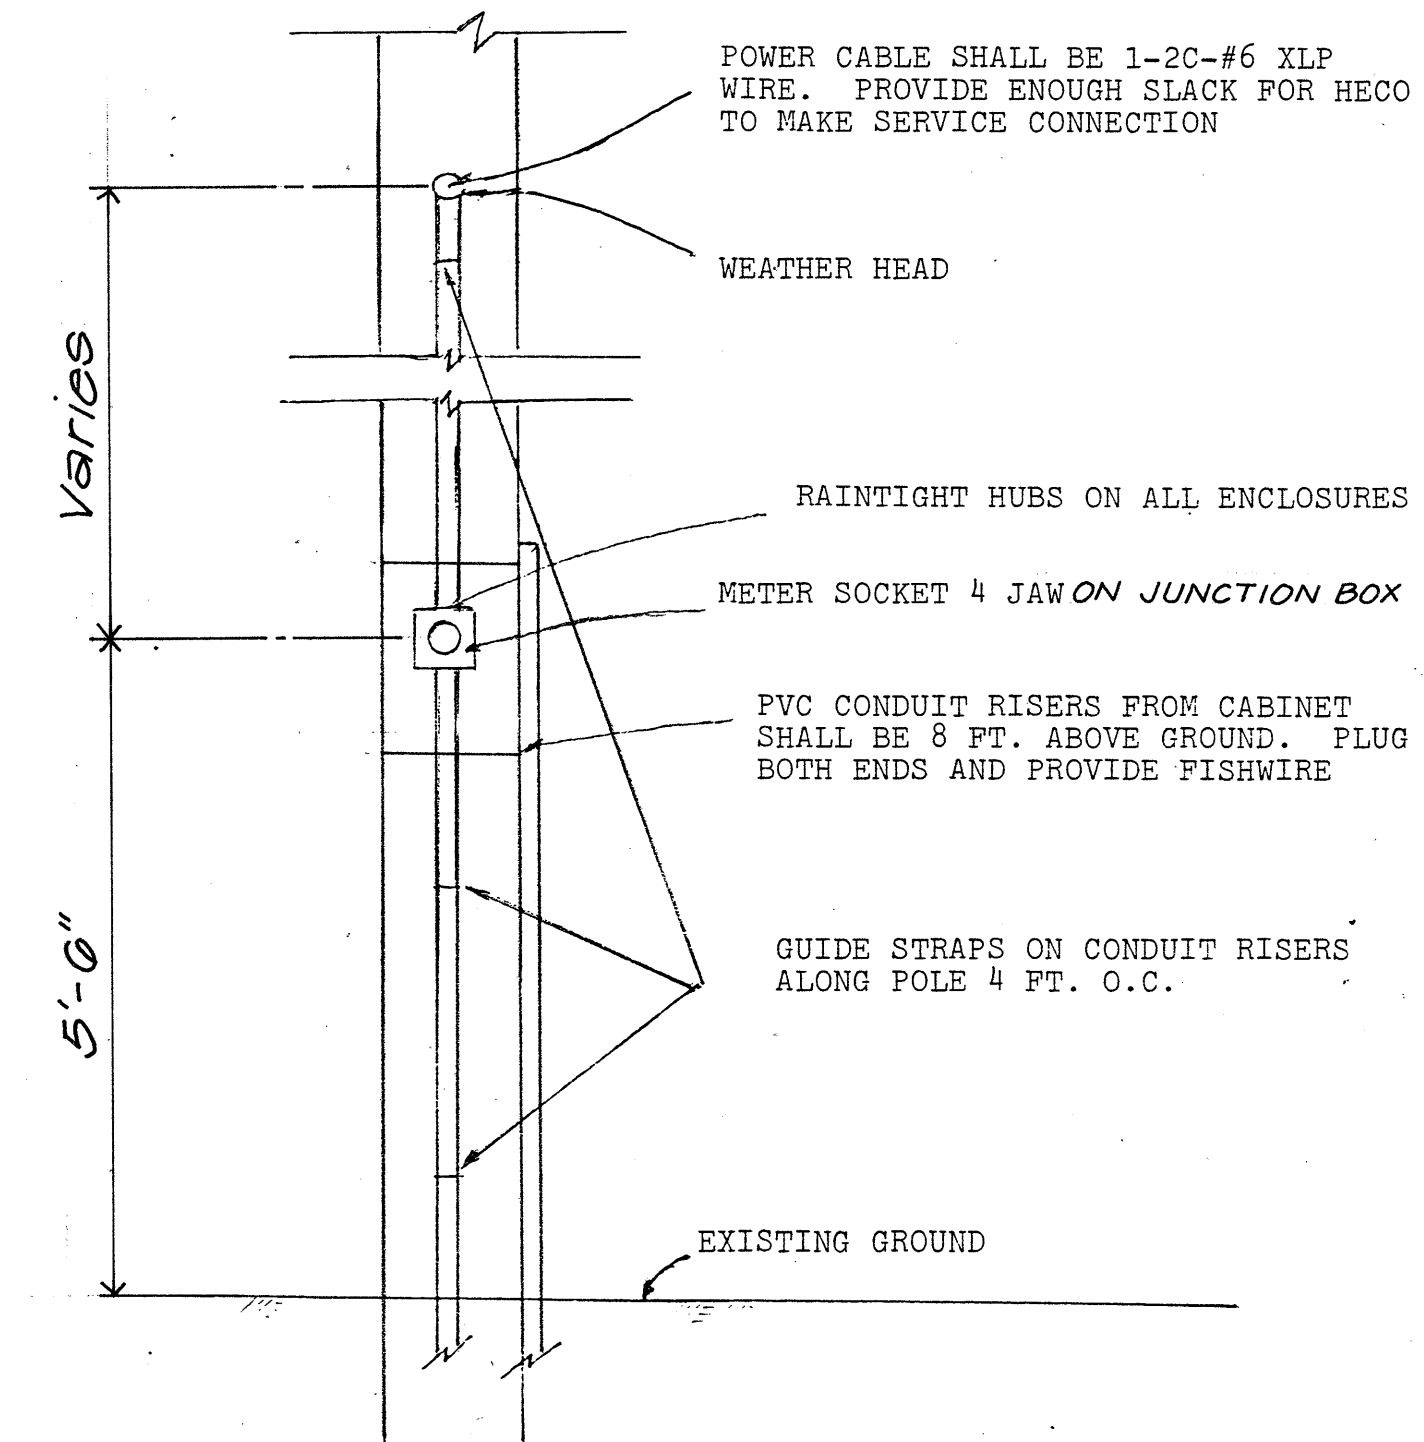


A C POWER CONNECTION ON POLE

SEE SHEET 2S-1
LOCATION 3 AT 104.37 M.P.

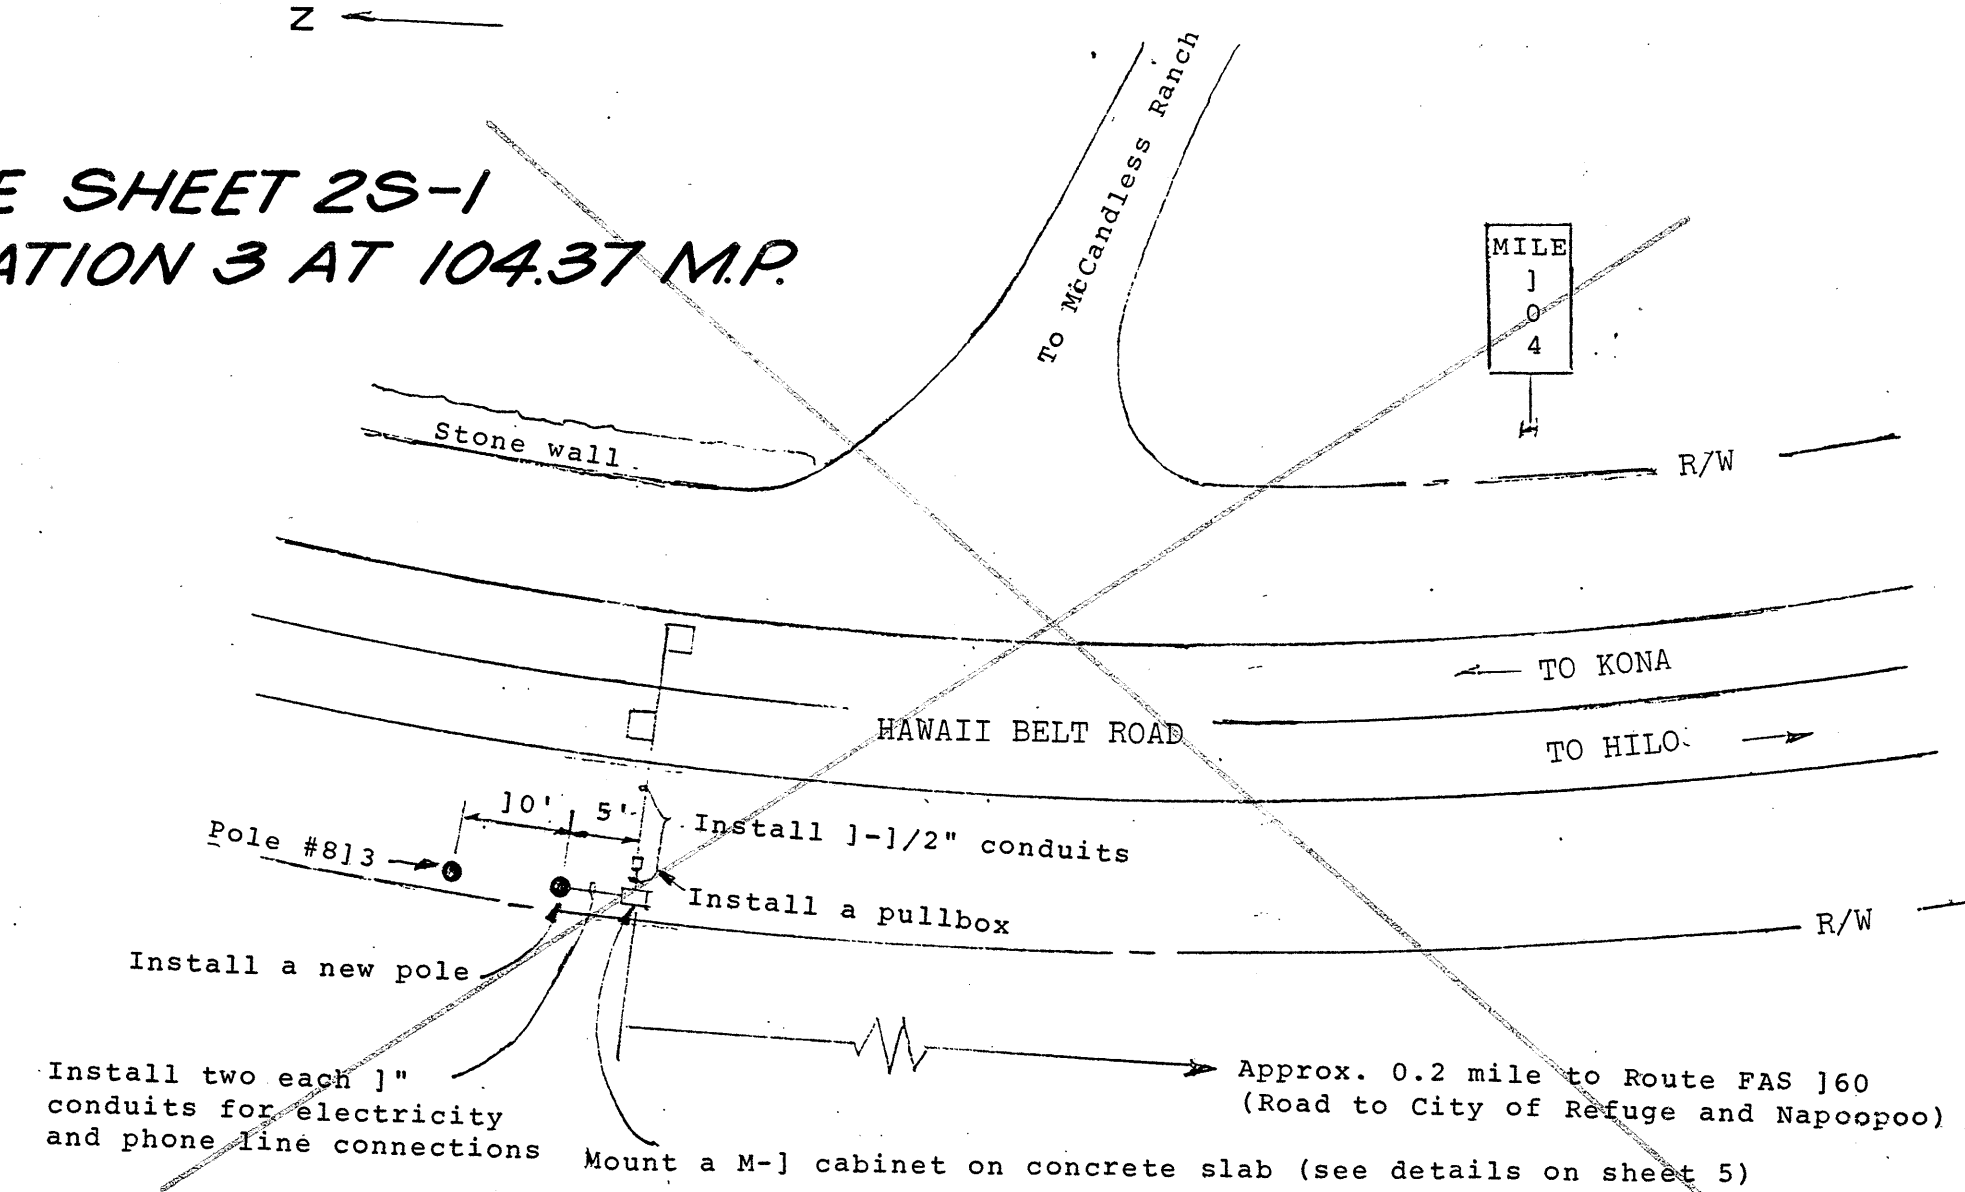

LOCATION 3

HAWAII BELT ROAD AT MILEPOST 104.37

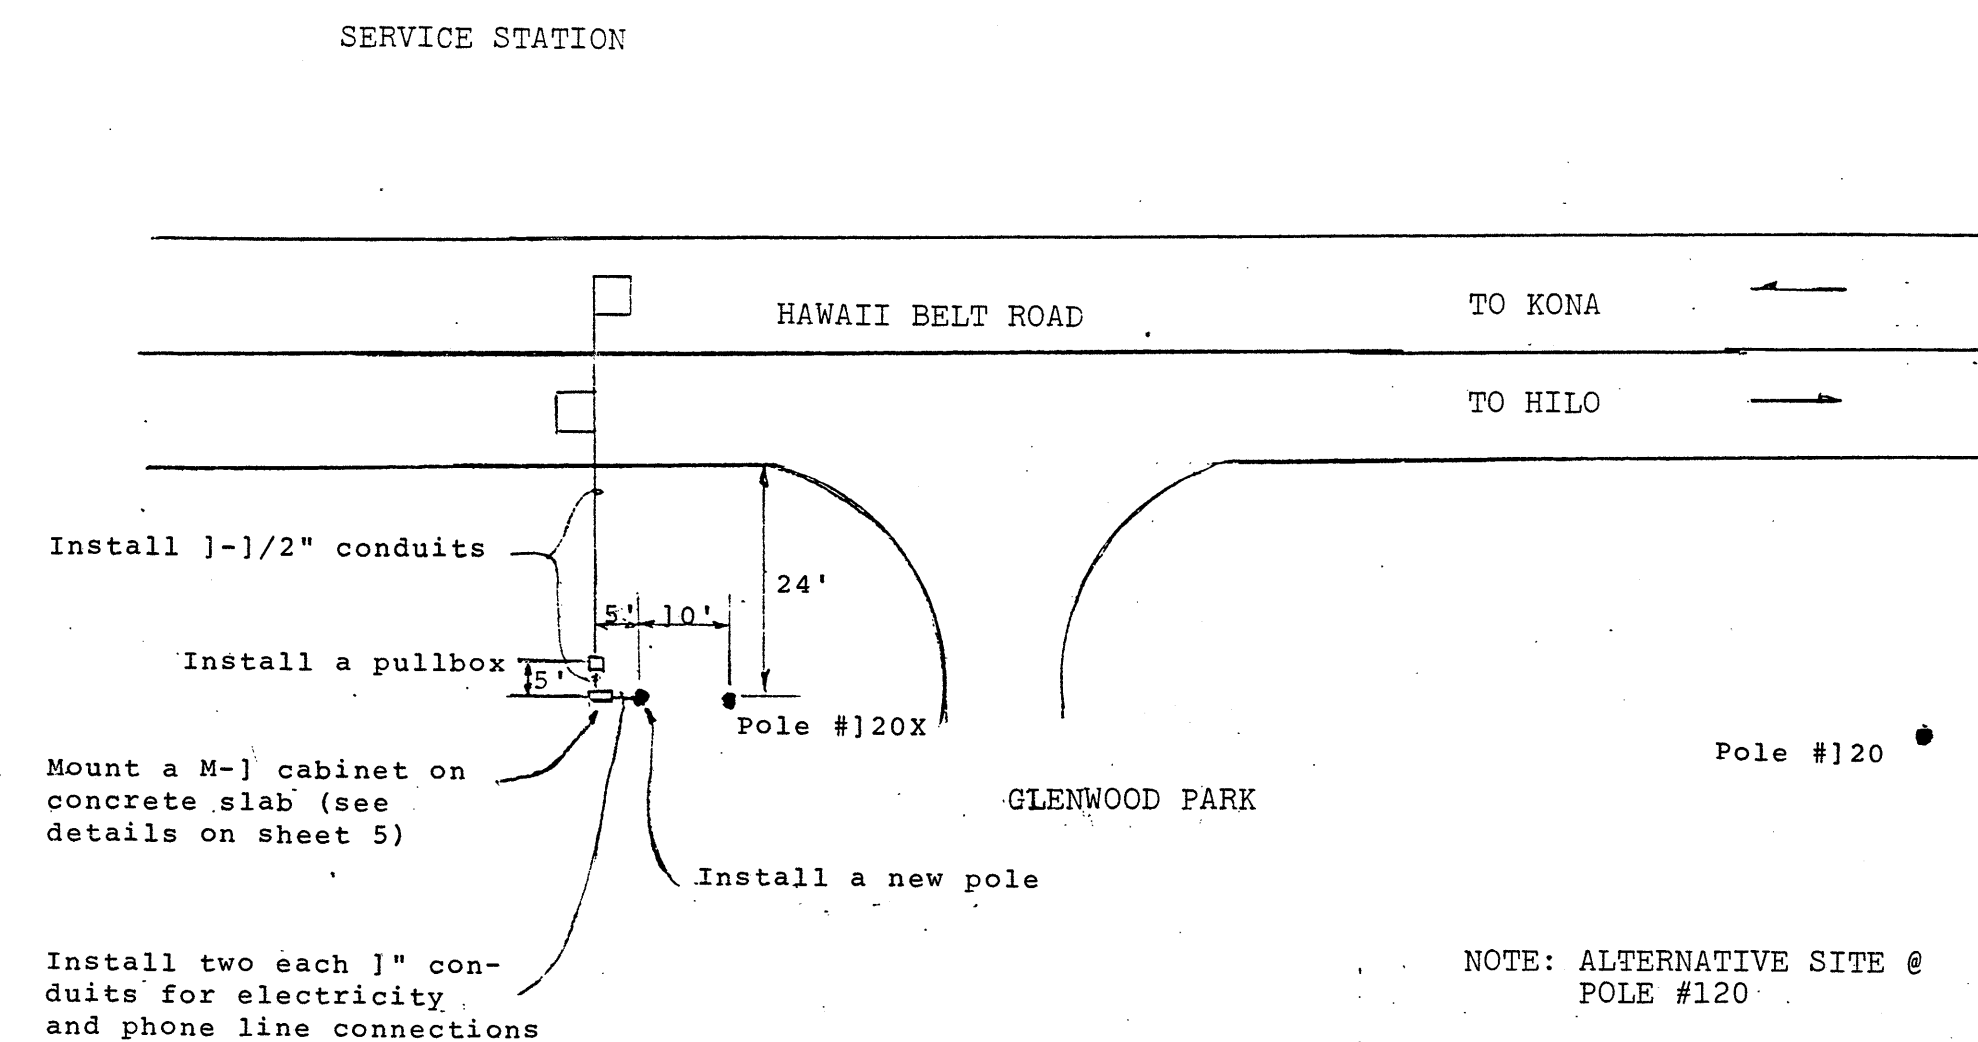



LOCATION 2

HAWAII BELT ROAD AT GLENWOOD PARK

NOTE: ALTERNATIVE SITE @
POLE #120

STATE OF HAWAII	
DEPARTMENT OF TRANSPORTATION	
HIGHWAYS DIVISION	
INSTALLATION OF VEHICLE	
DETECTOR LOOPS AT VARIOUS	
TRAFFIC COUNT STATIONS	
PROJECT NO. HPR-0010(10) U 1, 2	
SCALE: AS SHOWN	DATE
SHEET NO. 1 OF 4 SHEETS	

FED. ROAD DIST. NO.	STATE	FED. AID PROJ. NO.	FISCAL YEAR	SHEET NO.	TOTAL SHEETS
HAWAII	HAW.	HPR0010(10)U1,2	1987	25-1	8

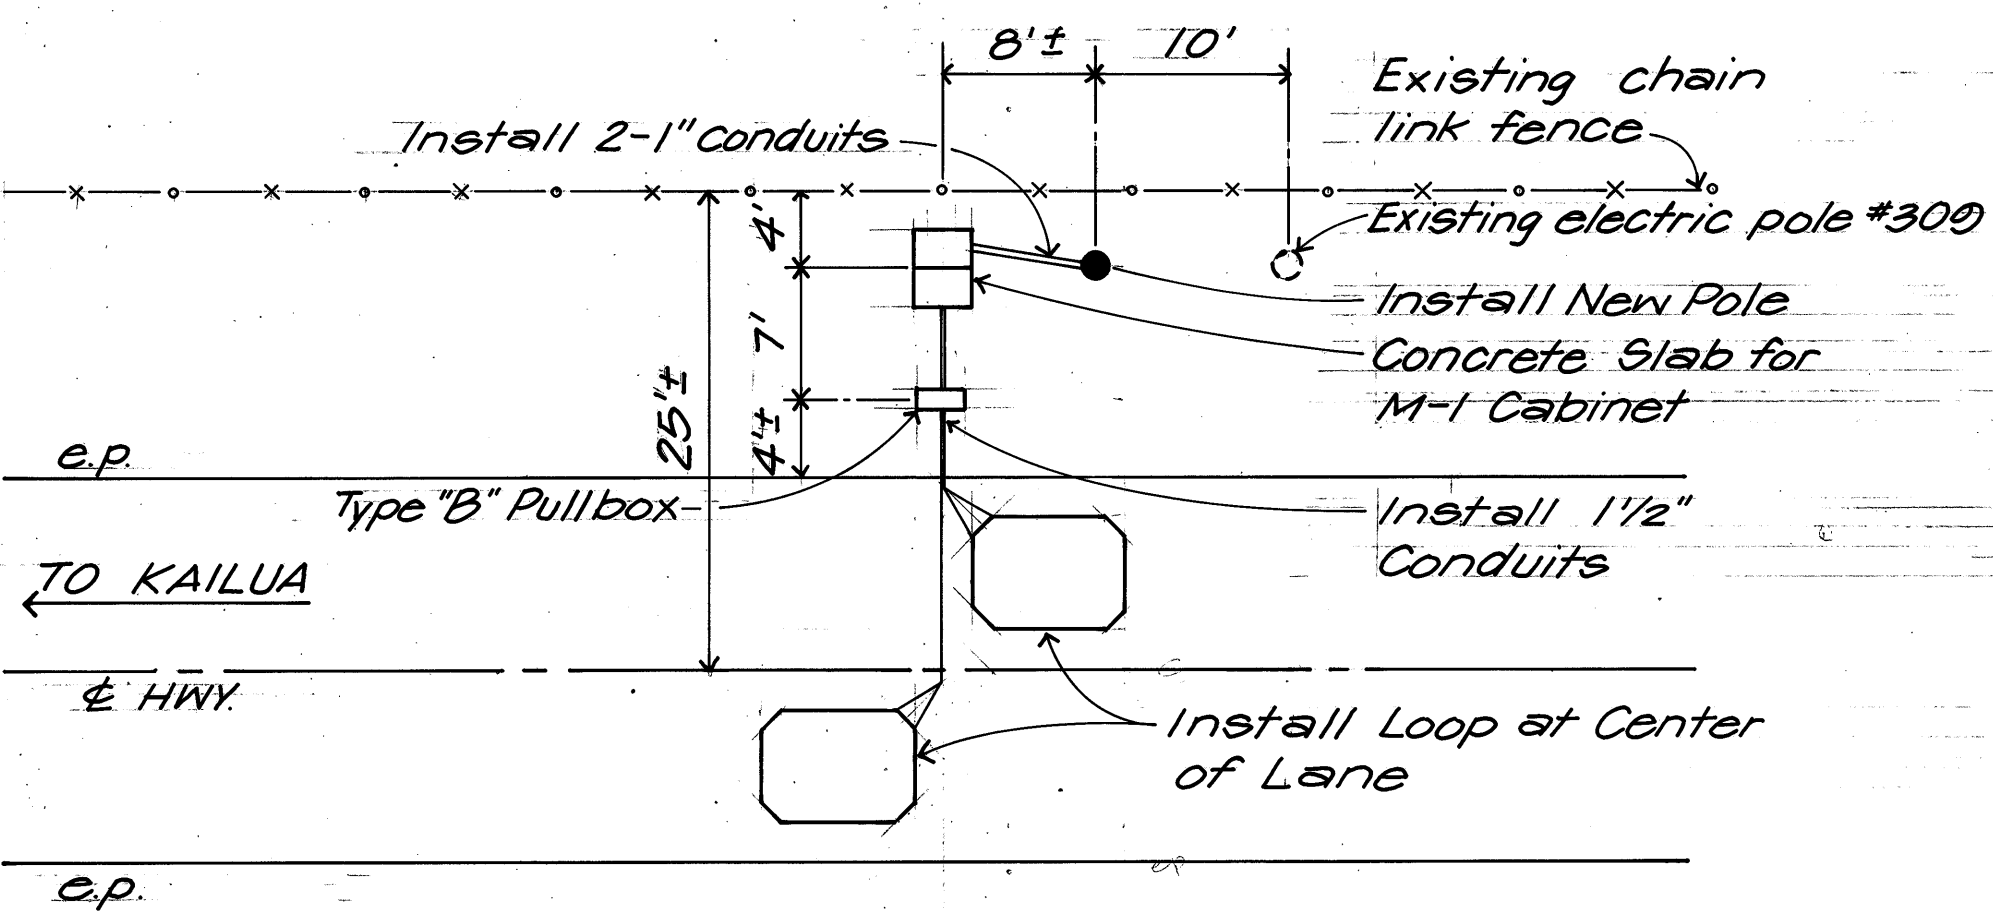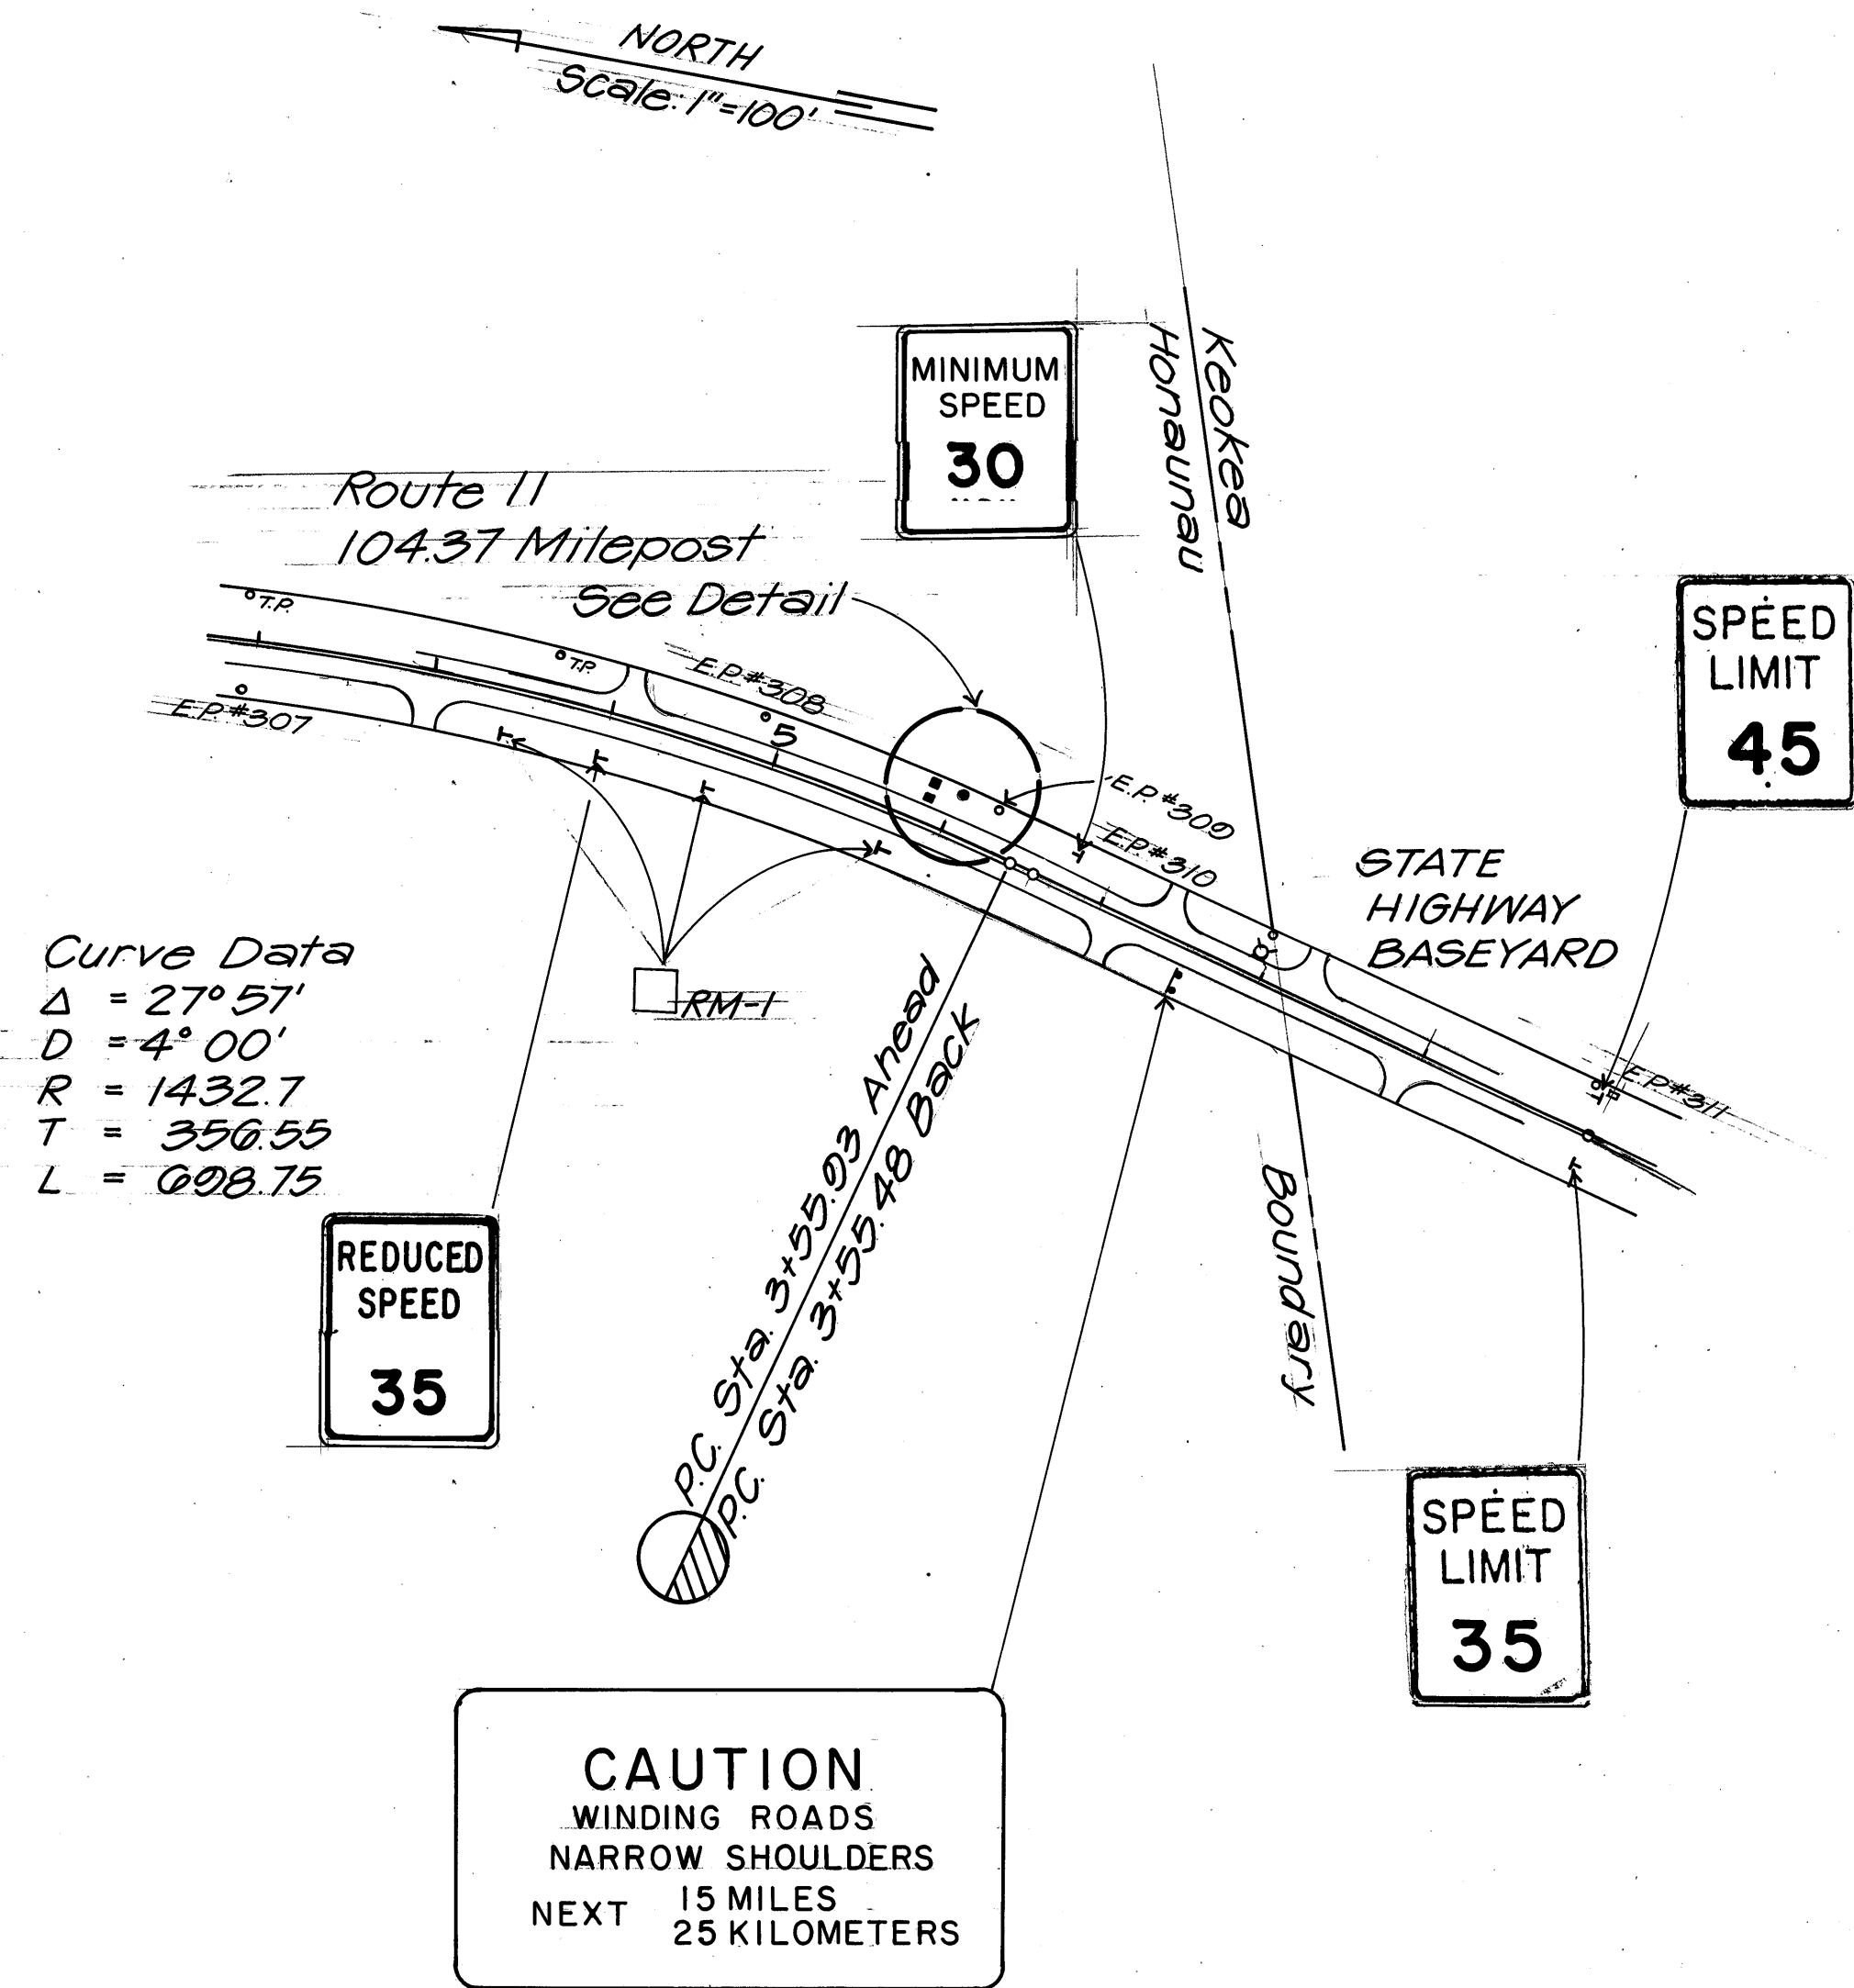

DETAIL
 Scale: 1"=10'

LOCATION 3
 Hawaii Belt Road at Milepost 104.37

Note: This tracing prepared during "As-Built" posting

STATE OF HAWAII

DEPARTMENT OF TRANSPORTATION

HIGHWAYS DIVISION

INSTALLATION OF VEHICLE

DETECTOR LOOPS AT VARIOUS




TRAFFIC COUNT STATIONS

PROJECT NO. HPR-0010(10)U1,2


Scale: As Shown Date: Sept, 1988

SHEET NO. 1 OF 1 SHEETS


FED. ROAD DIST. NO.	STATE	FED. AID PROJ. NO.	FISCAL YEAR	SHEET NO.	TOTAL SHEETS
HAWAII	HAW.	HPR-0010(10) U-1, U-2	1987	3	8

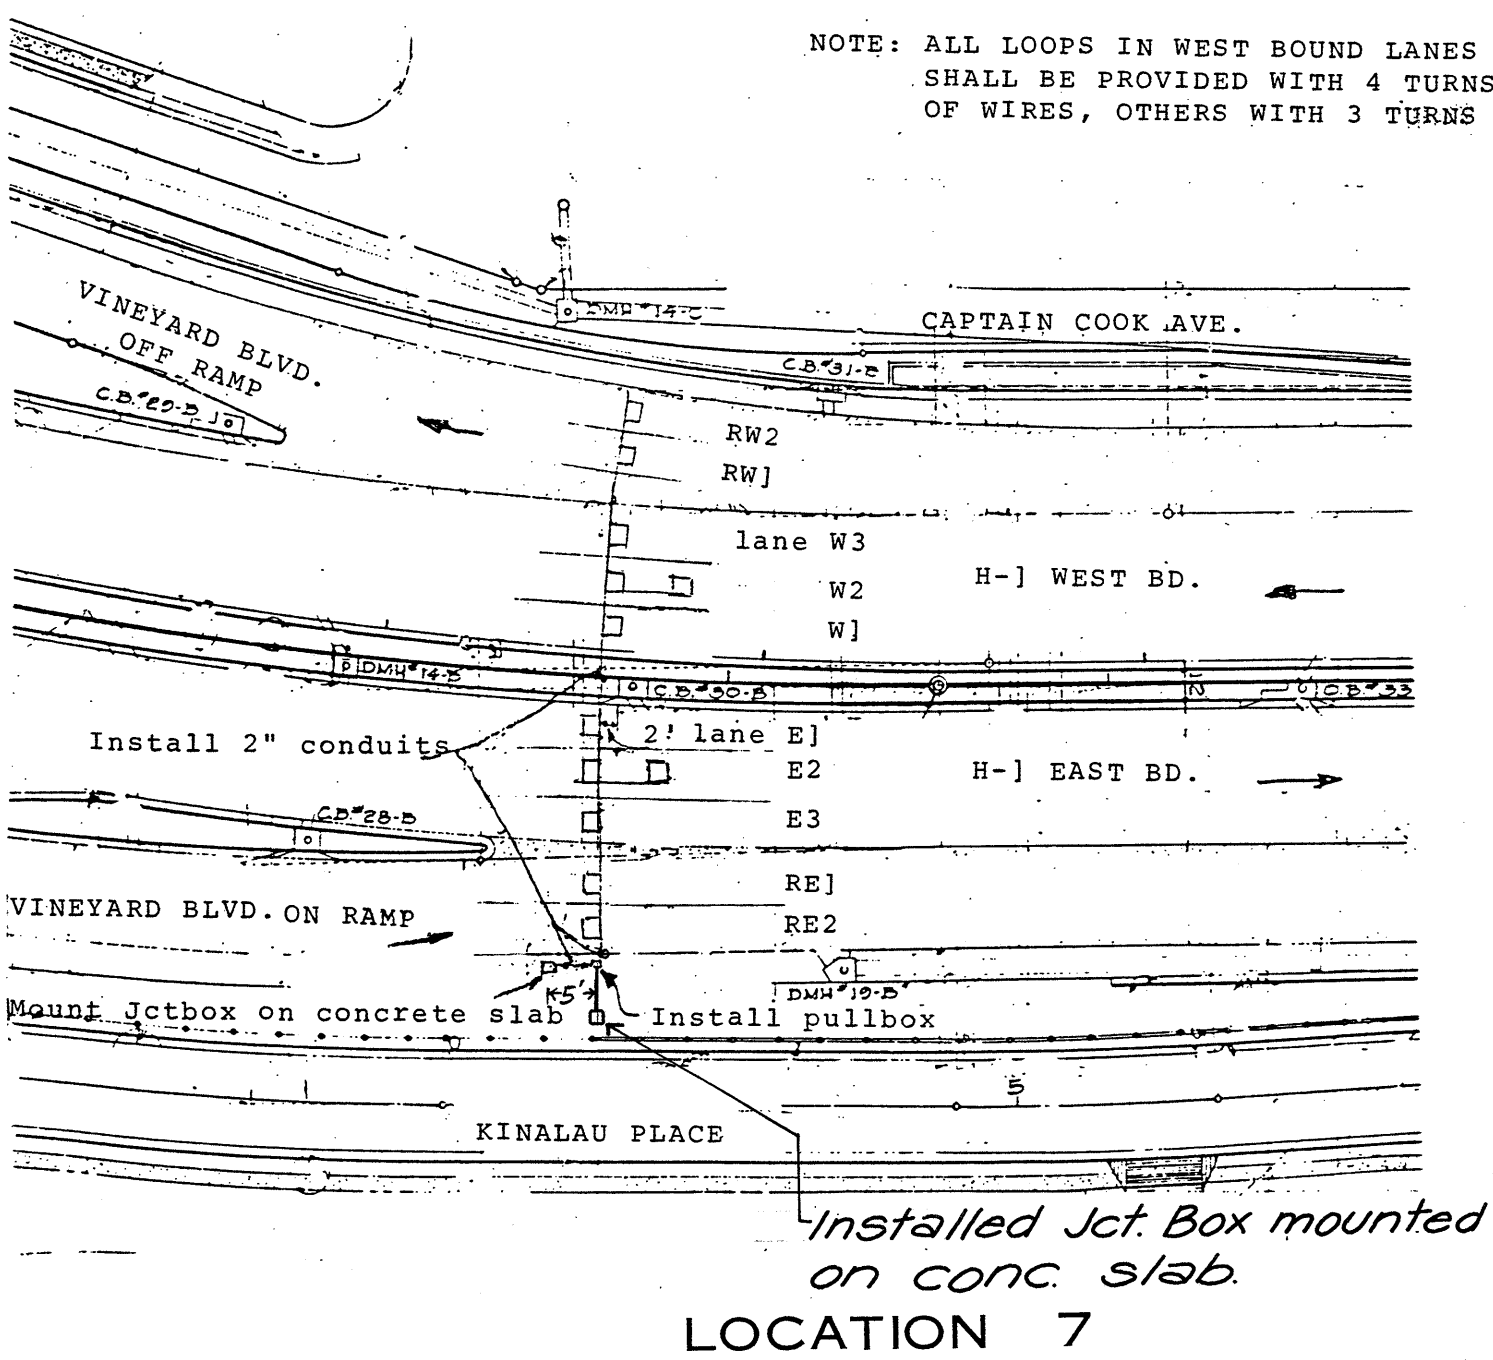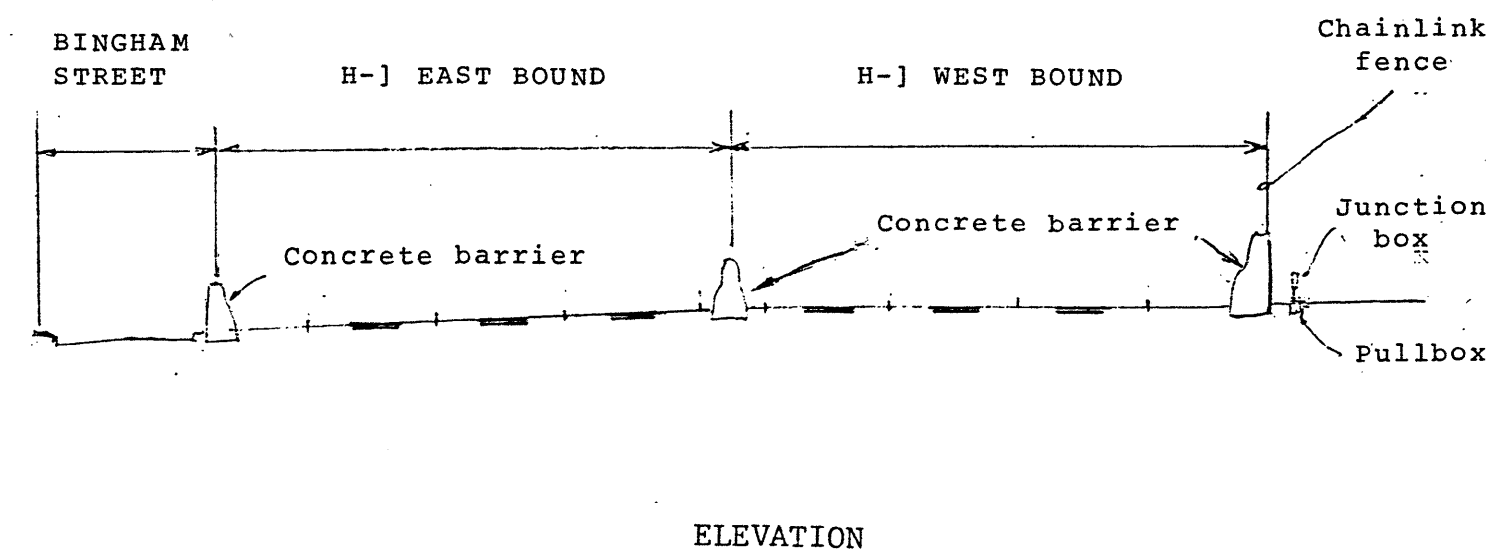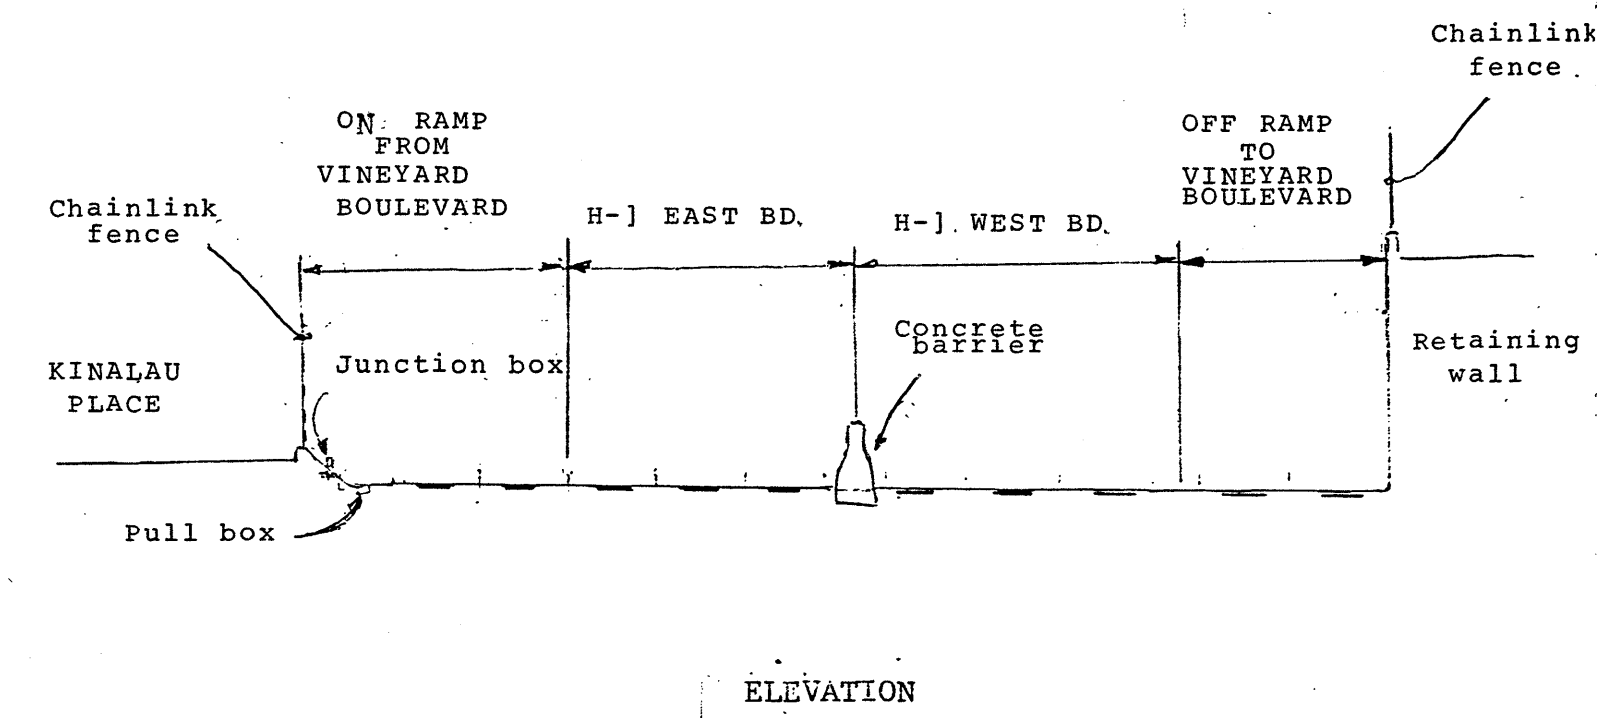


INTERSTATE ROUTE H-1 WEST OF WARD AVE. OVERPASS

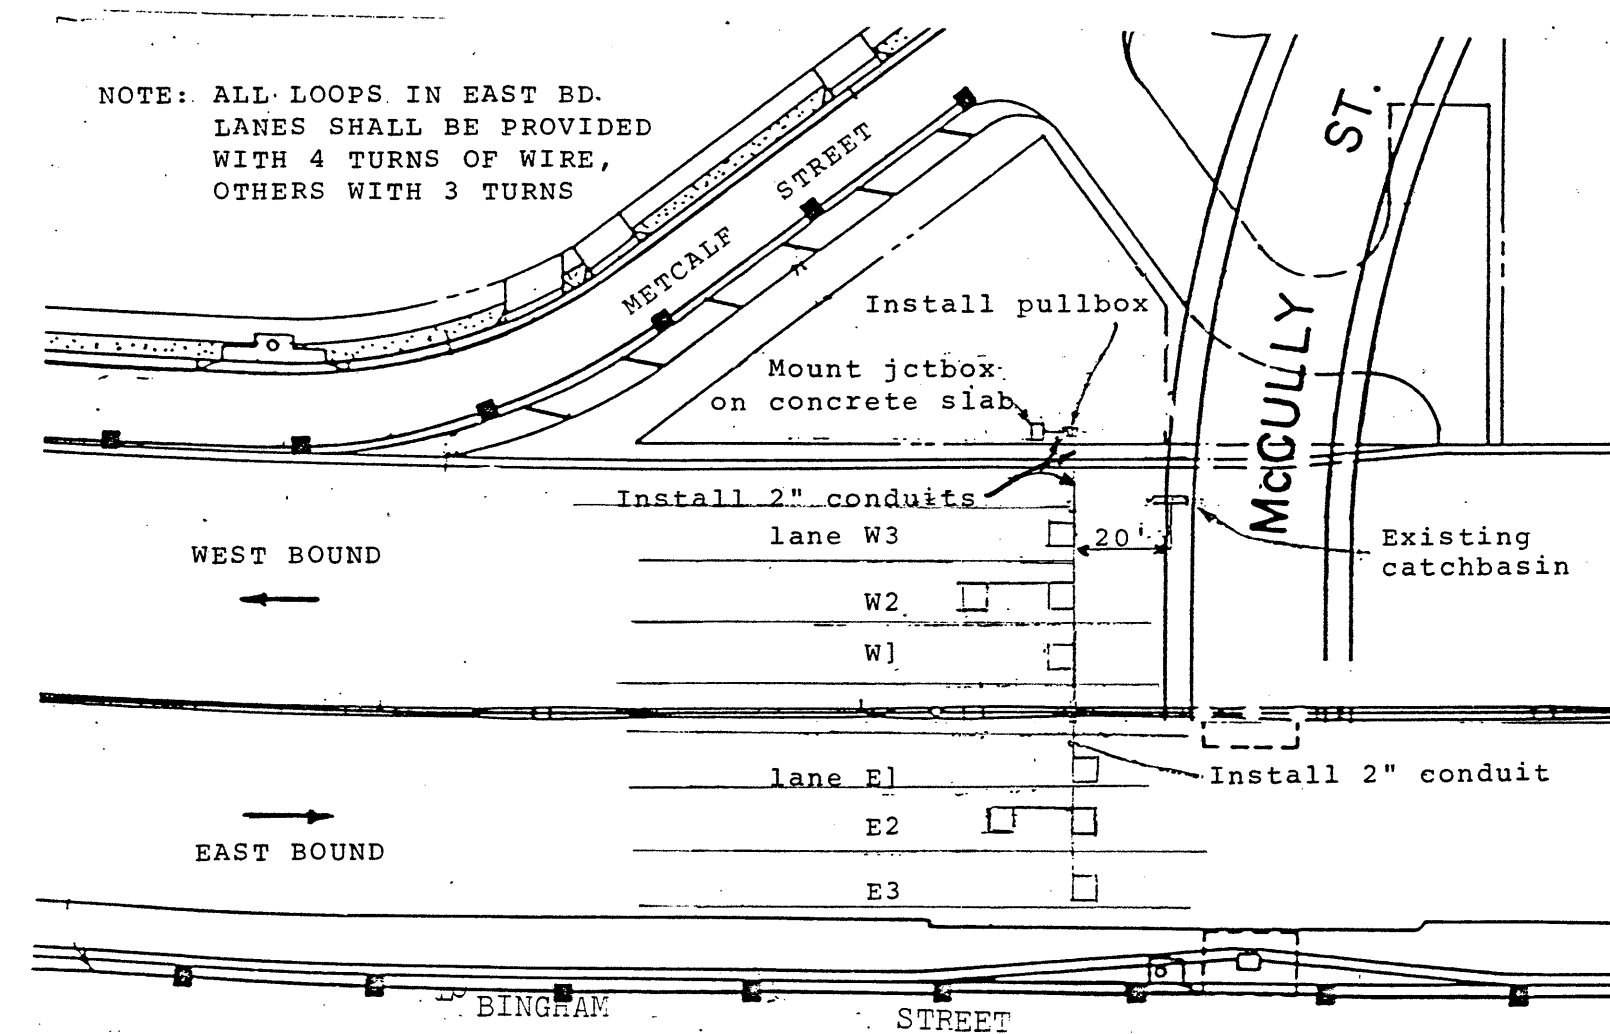


INTERSTATE ROUTE H-1 WEST OF McCULLY OVERPASS

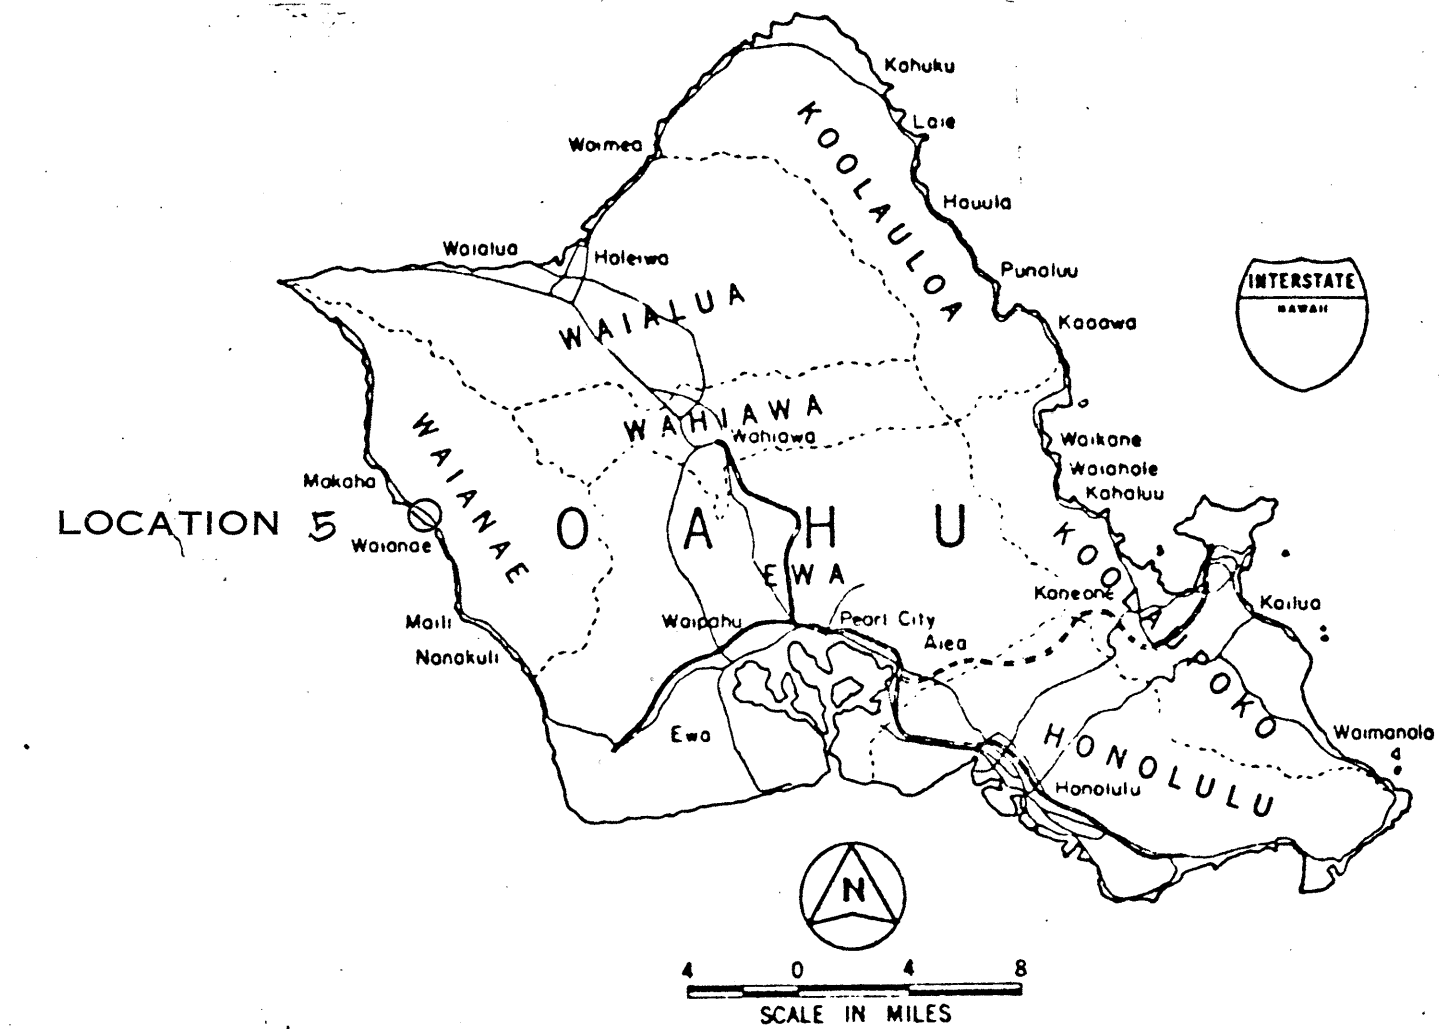

Install 1-1/2" conduits
Connection to Existing Pole #285
Install two each 1" conduits for electricity and phone line connections
Mount State-provided cabinet on conc. slab (see details on sheet 5)

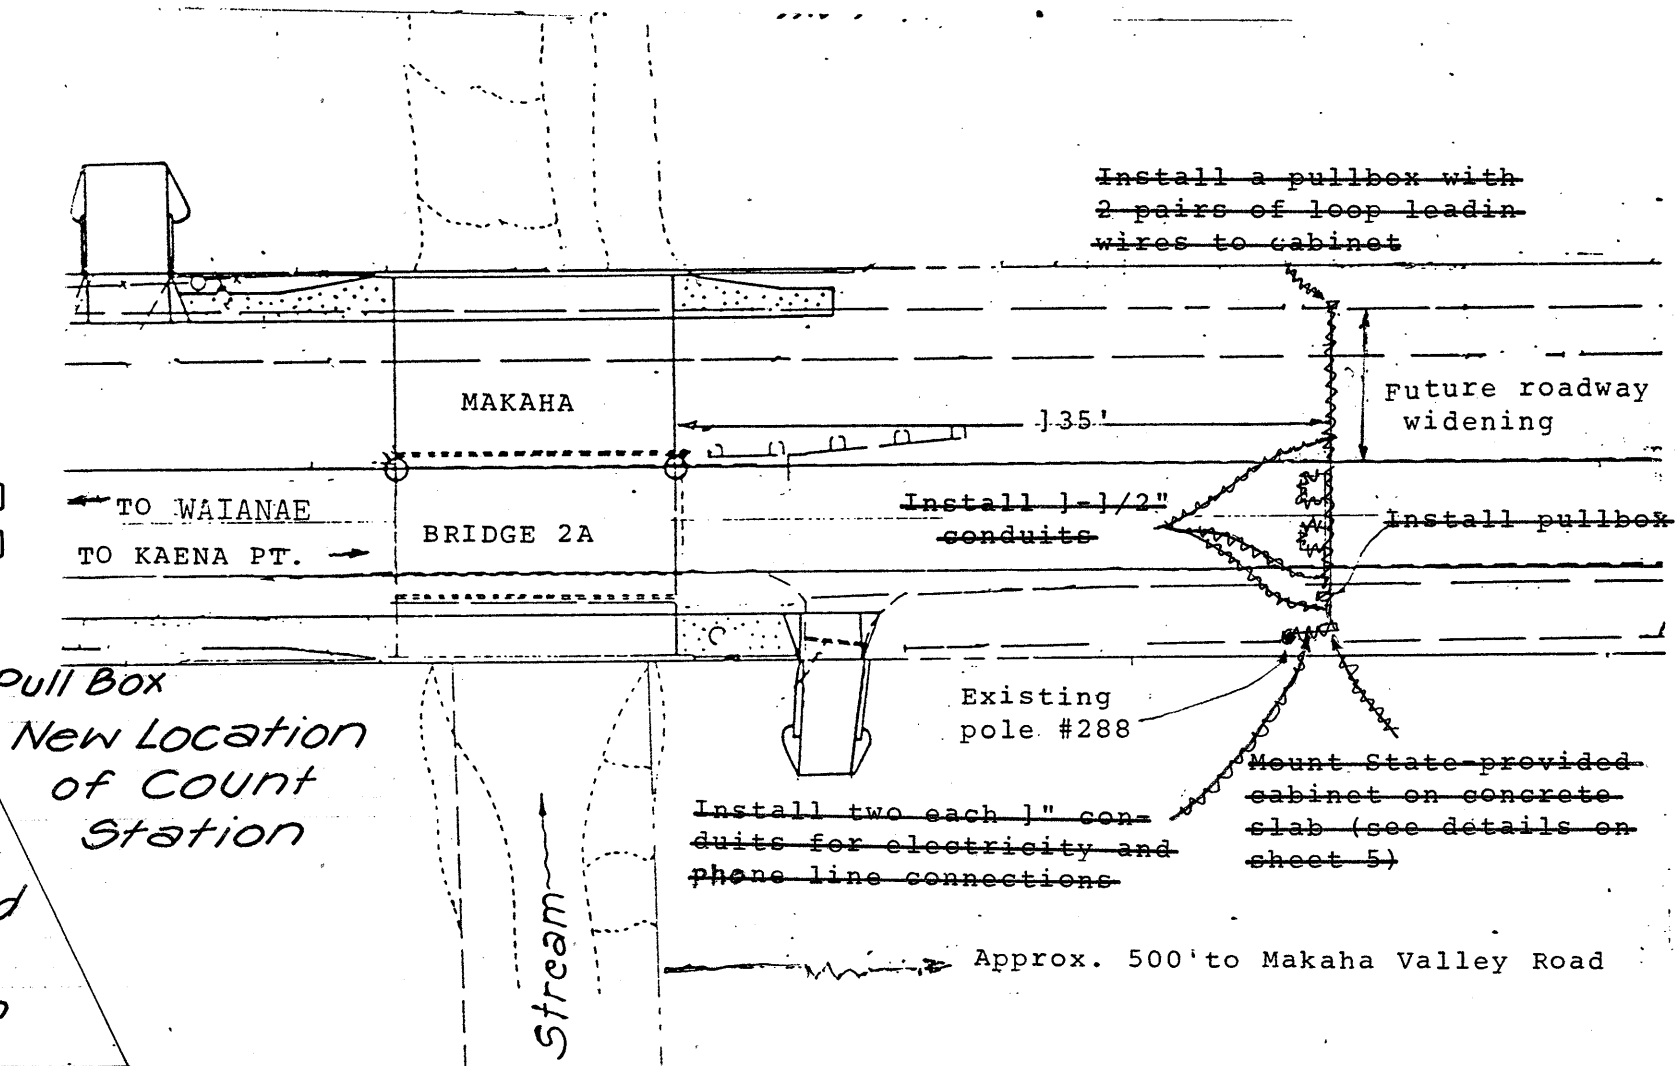

FARRINGTON HIGHWAY, FAP 93, IN THE VICINITY OF MAKAHA BRIDGE #2




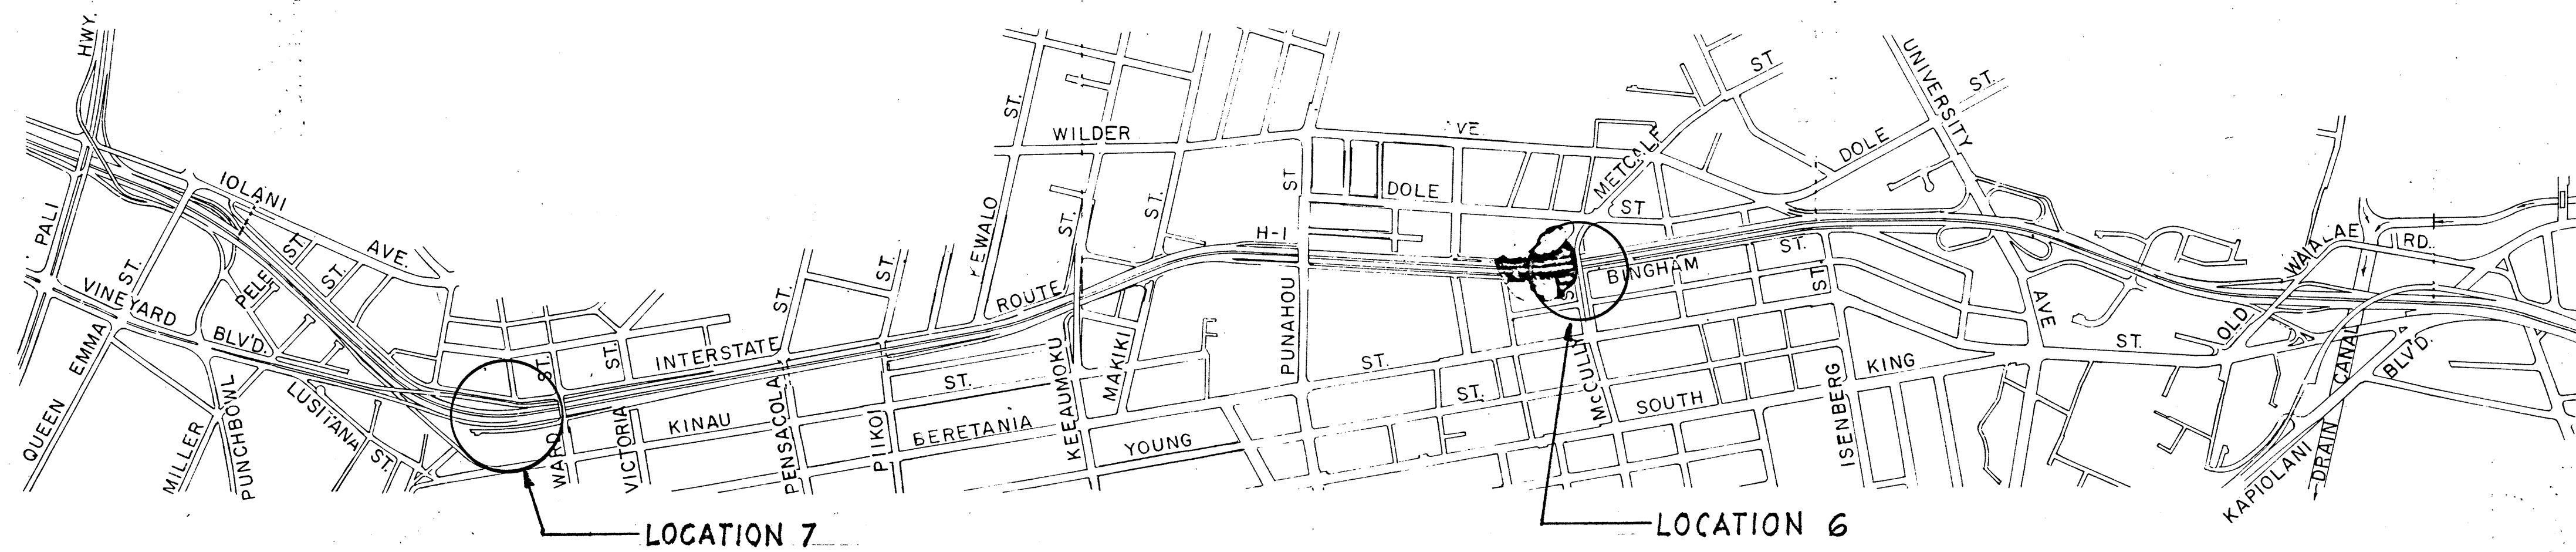


LAYOUT PLAN


8 0 8 16 24
SCALE IN HUNDRED FEET

STATE OF HAWAII
DEPARTMENT OF TRANSPORTATION
HIGHWAYS DIVISION
INSTALLATION OF VEHICLE
DETECTOR LOOPS AT VARIOUS
TRAFFIC COUNT STATIONS
PROJECT NO. HPR-0010(10) U 1, 2
SCALE: AS SHOWN DATE
SHEET NO. 2 OF 4 SHEETS


FED. ROAD DIST. NO.	STATE	FED. AID PROJ. NO.	FISCAL YEAR	SHEET NO.	TOTAL SHEETS
HAWAII	HAW.	HPR-0010(10) U-1, U-2	1987	4	8

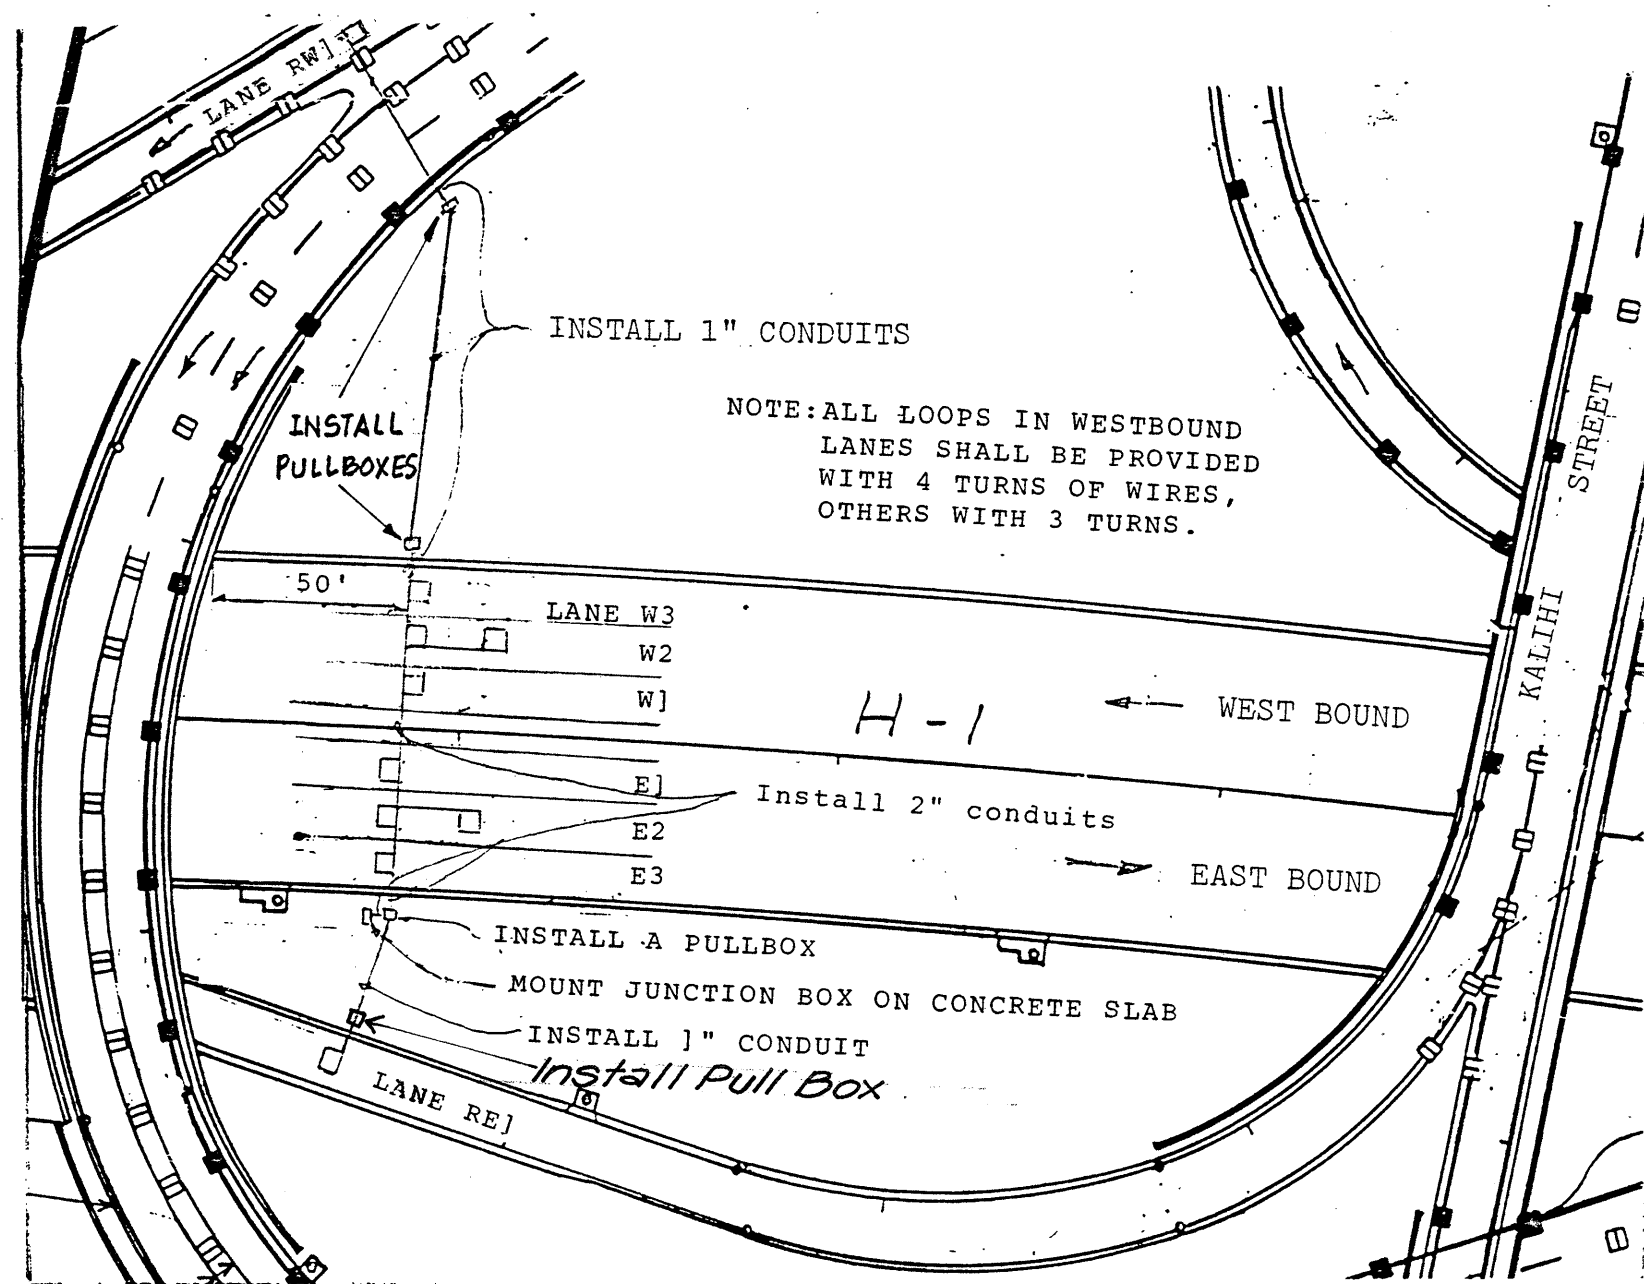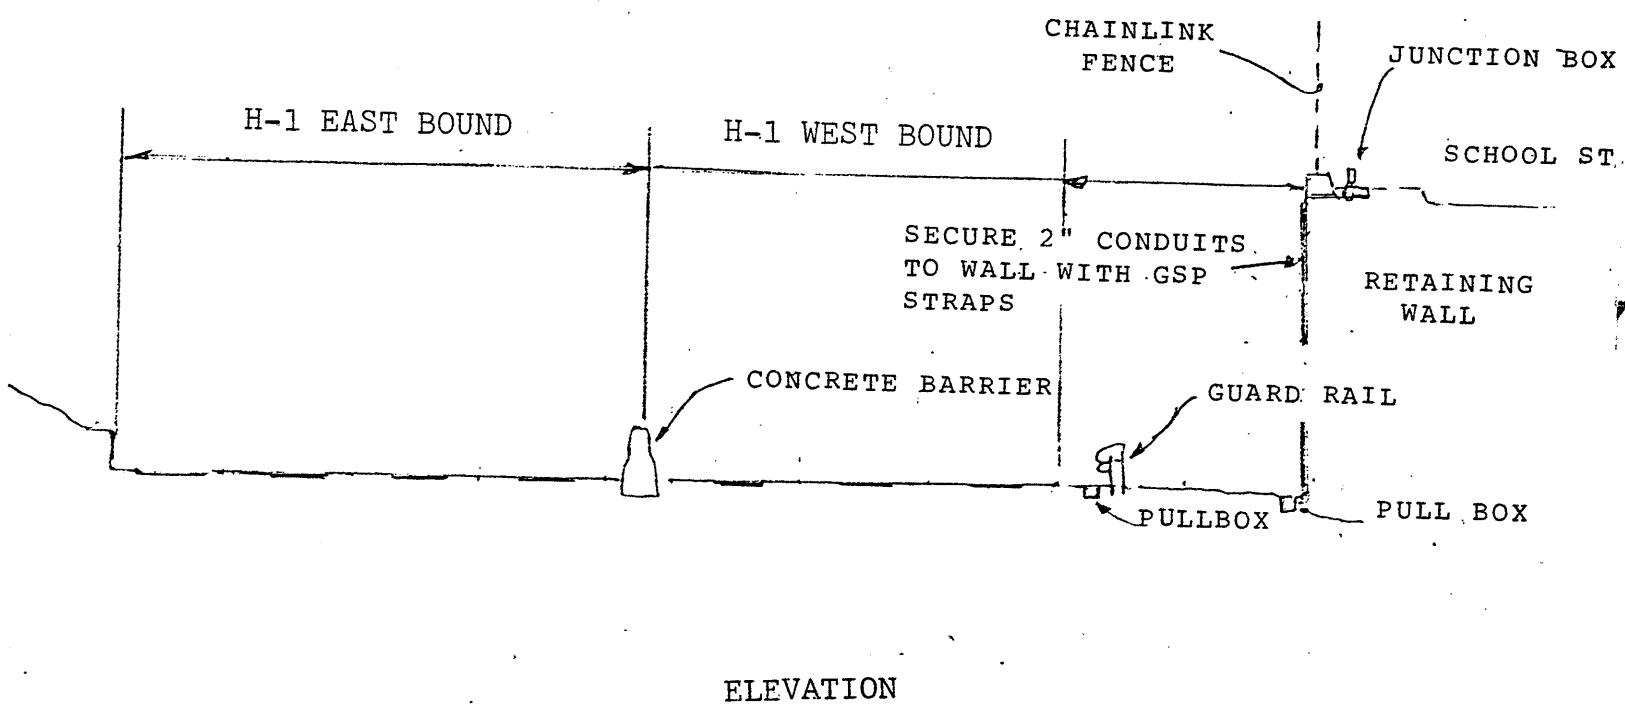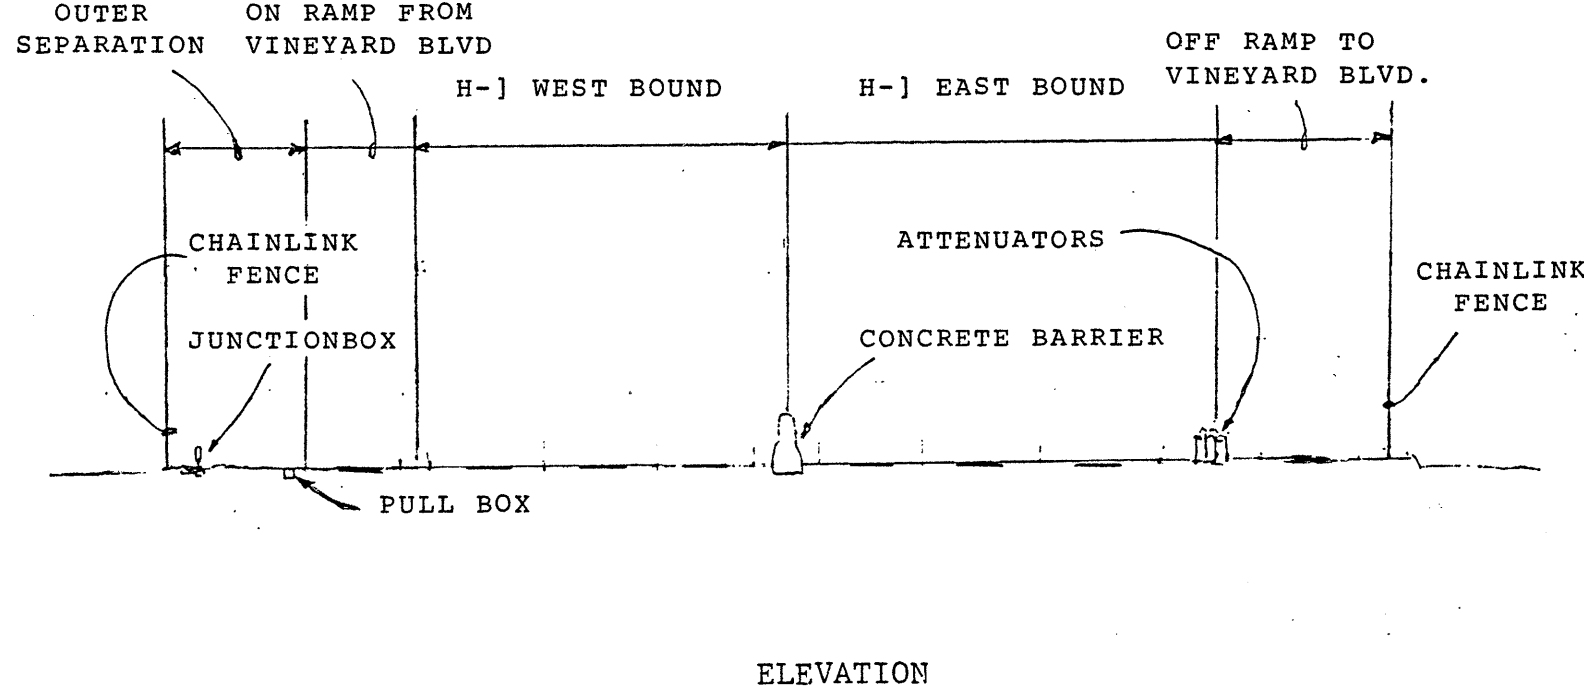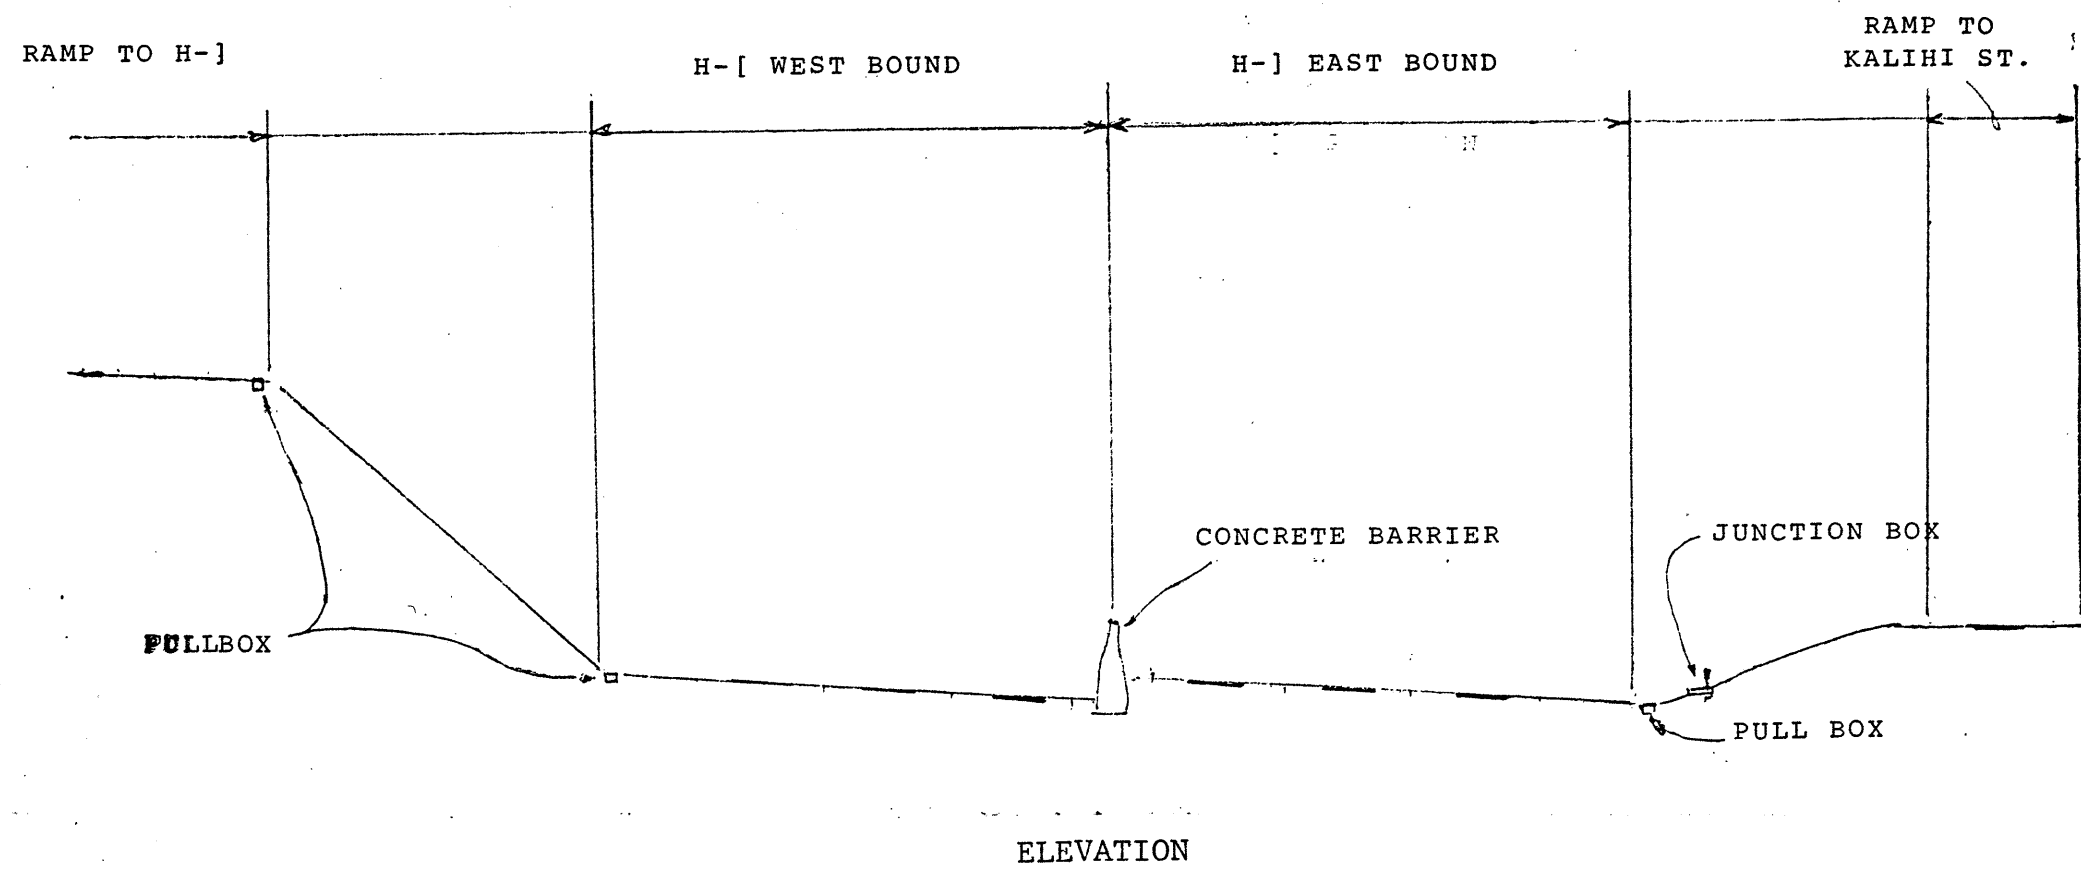


LOCATION 10
INTERSTATE ROUTE H-1 AT KALIHI INTERCHANGE

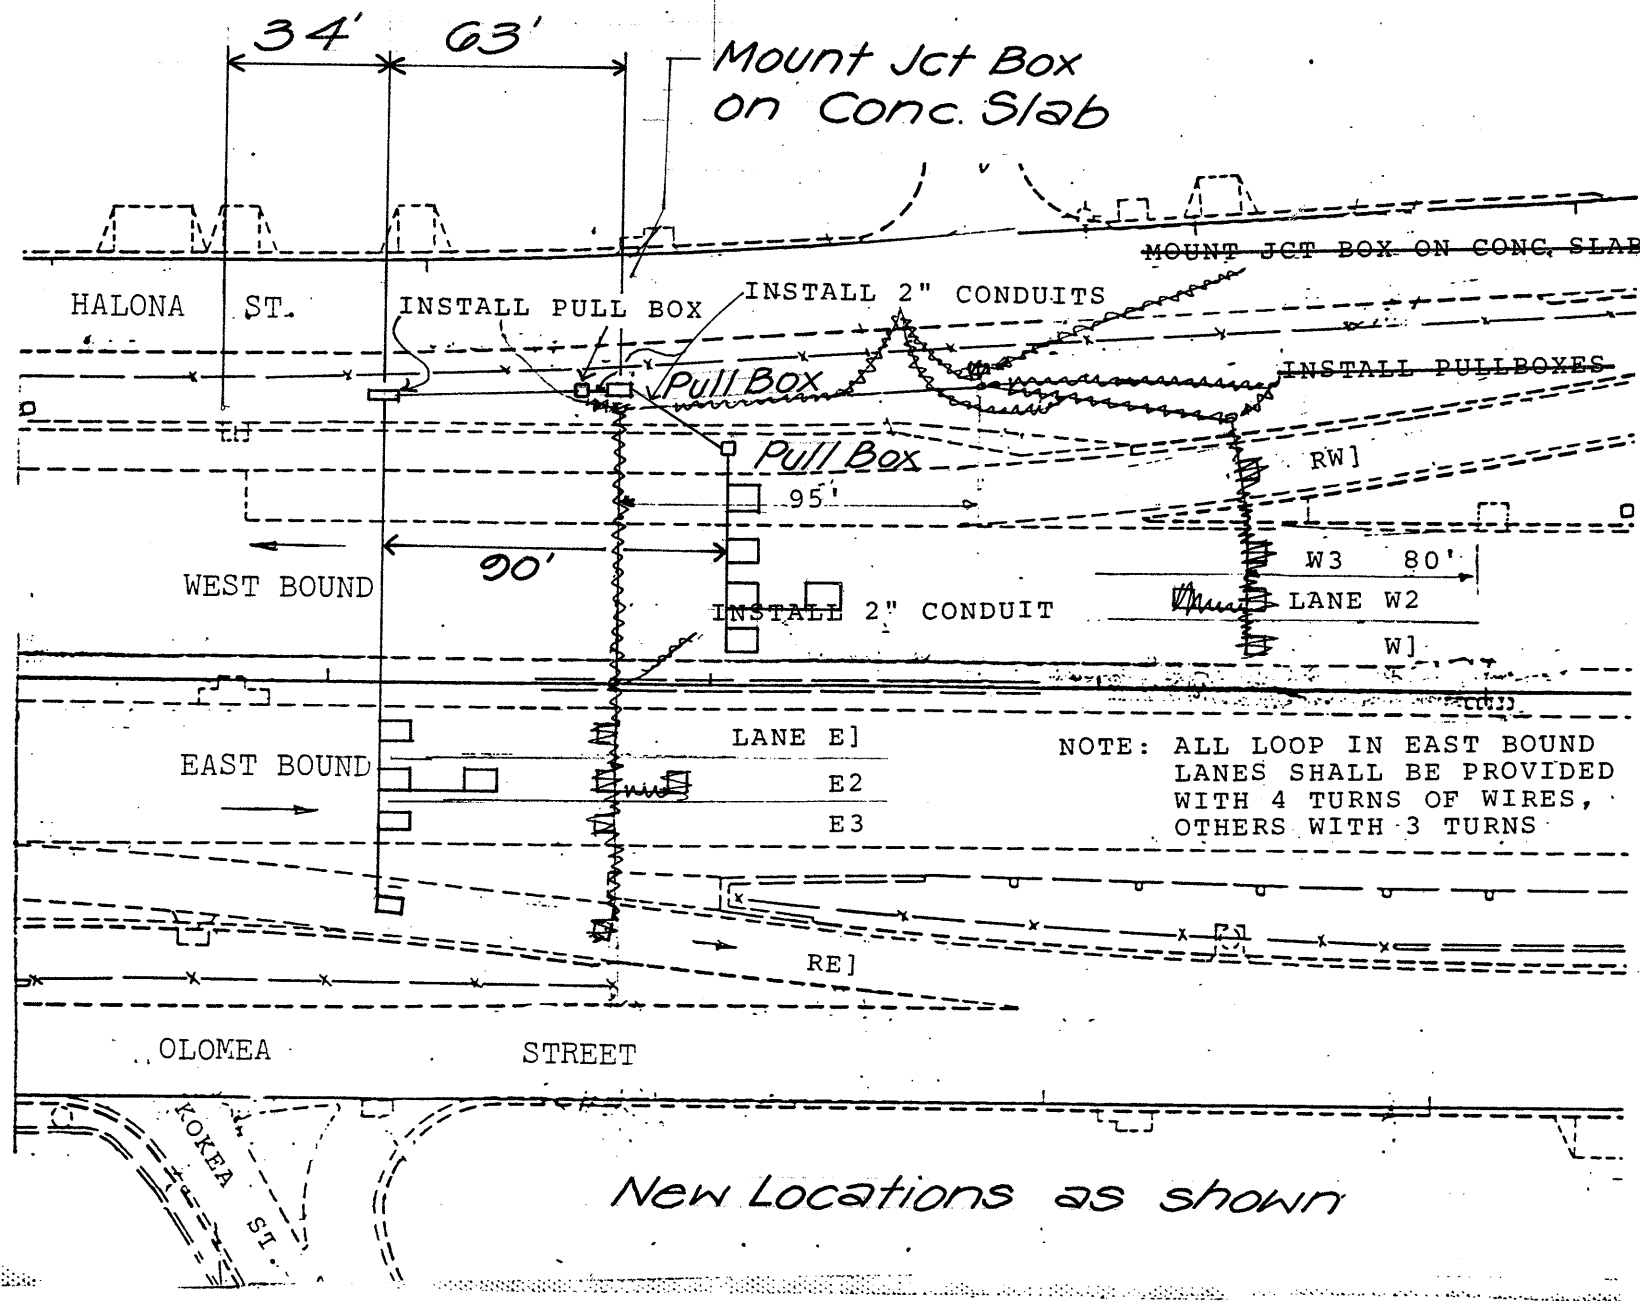

LOCATION 9
INTERSTATE ROUTE H-1 IN THE VICINITY OVER KAPALAMA STREAM

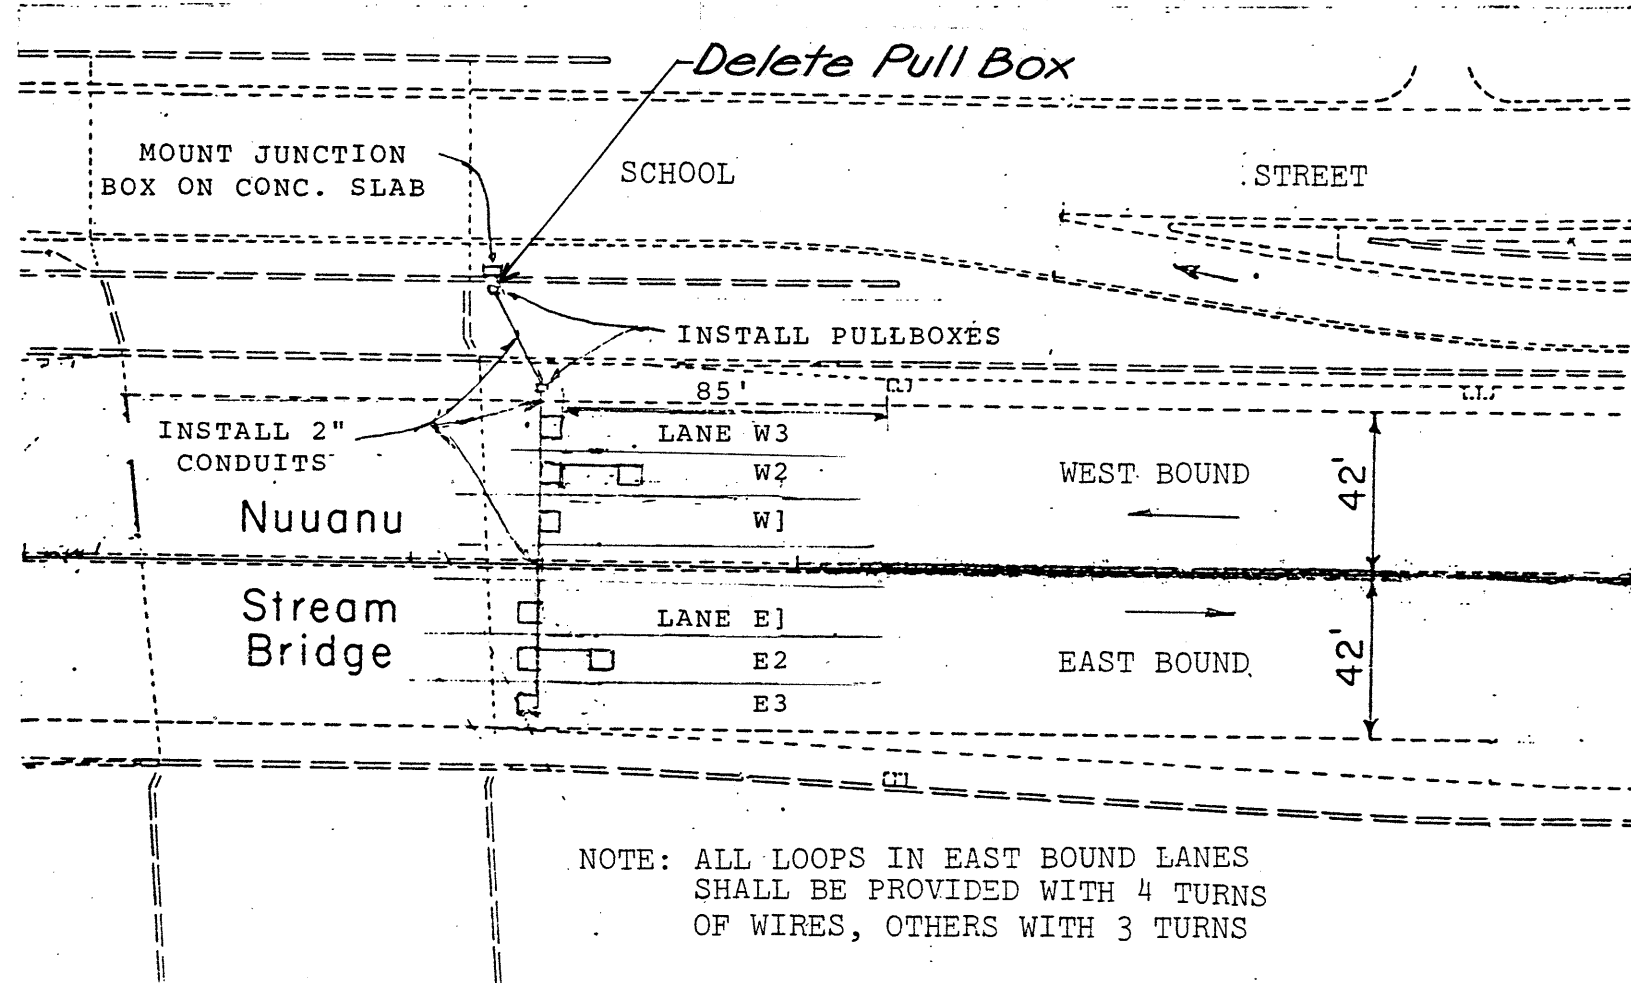

LOCATION 8
INTERSTATE ROUTE H-1 OVER NUUANU STREAM

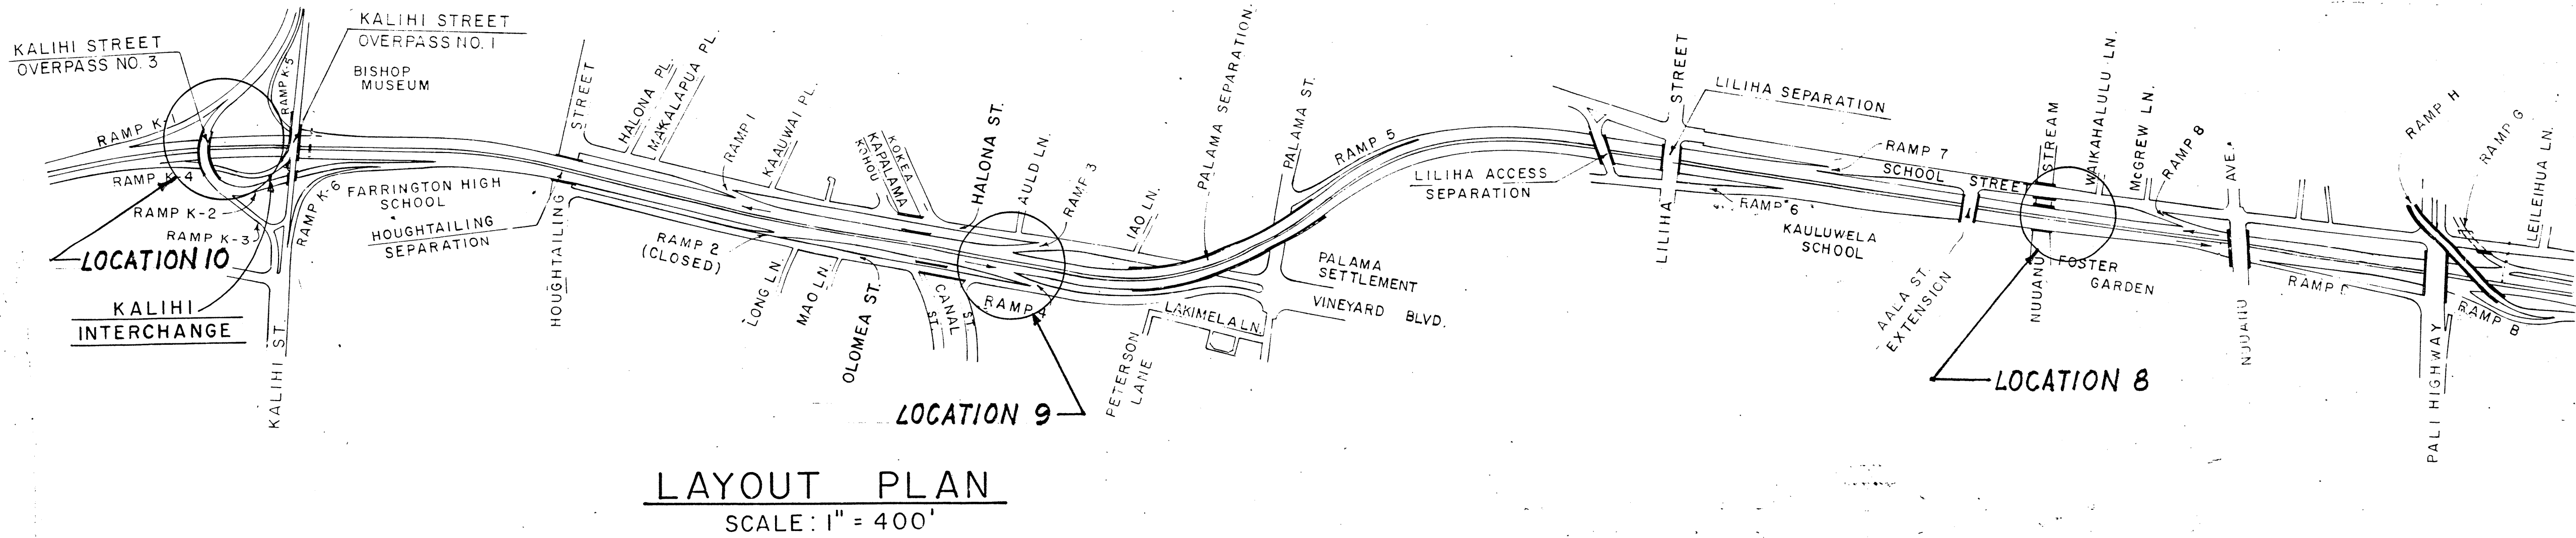

STATE OF HAWAII
DEPARTMENT OF TRANSPORTATION
HIGHWAYS DIVISION

INSTALLATION OF VEHICLE
DETECTOR LOOPS AT VARIOUS
TRAFFIC COUNT STATIONS

PROJECT NO. HPR-0010(10)U 1, 2
SCALE: AS SHOWN DATE
SHEET NO. 3 OF 4 SHEETS