	INDEX TO DRAWINGS
SHEET NO.	DESCRIPTION
1	TITLE SHEET
2-4	INSTALLATION LOCATION PLANS
5	GENERAL NOTES & DETAILS
6 – 8	STANDARD DETAILS

TO THE CONTRACT PLANS.
TOTAL = 9 SHEETS

STATE OF HAWAII


## DEPARTMENT OF TRANSPORTATION

HIGHWAYS DIVISION HONOLULU, HAWAII

"AS-BUILT" PLANS FOR

INSTALLATION OF VEHICLE DETECTOR TRAFFIC COUNT VARIOUS STATIONS ISLANDS HAWAII OF OAHU AND

> PROJECT NO. HPR - 0010 (10) UNIT 1 PROJECT NO. HPR - 0010 (10) UNIT 2

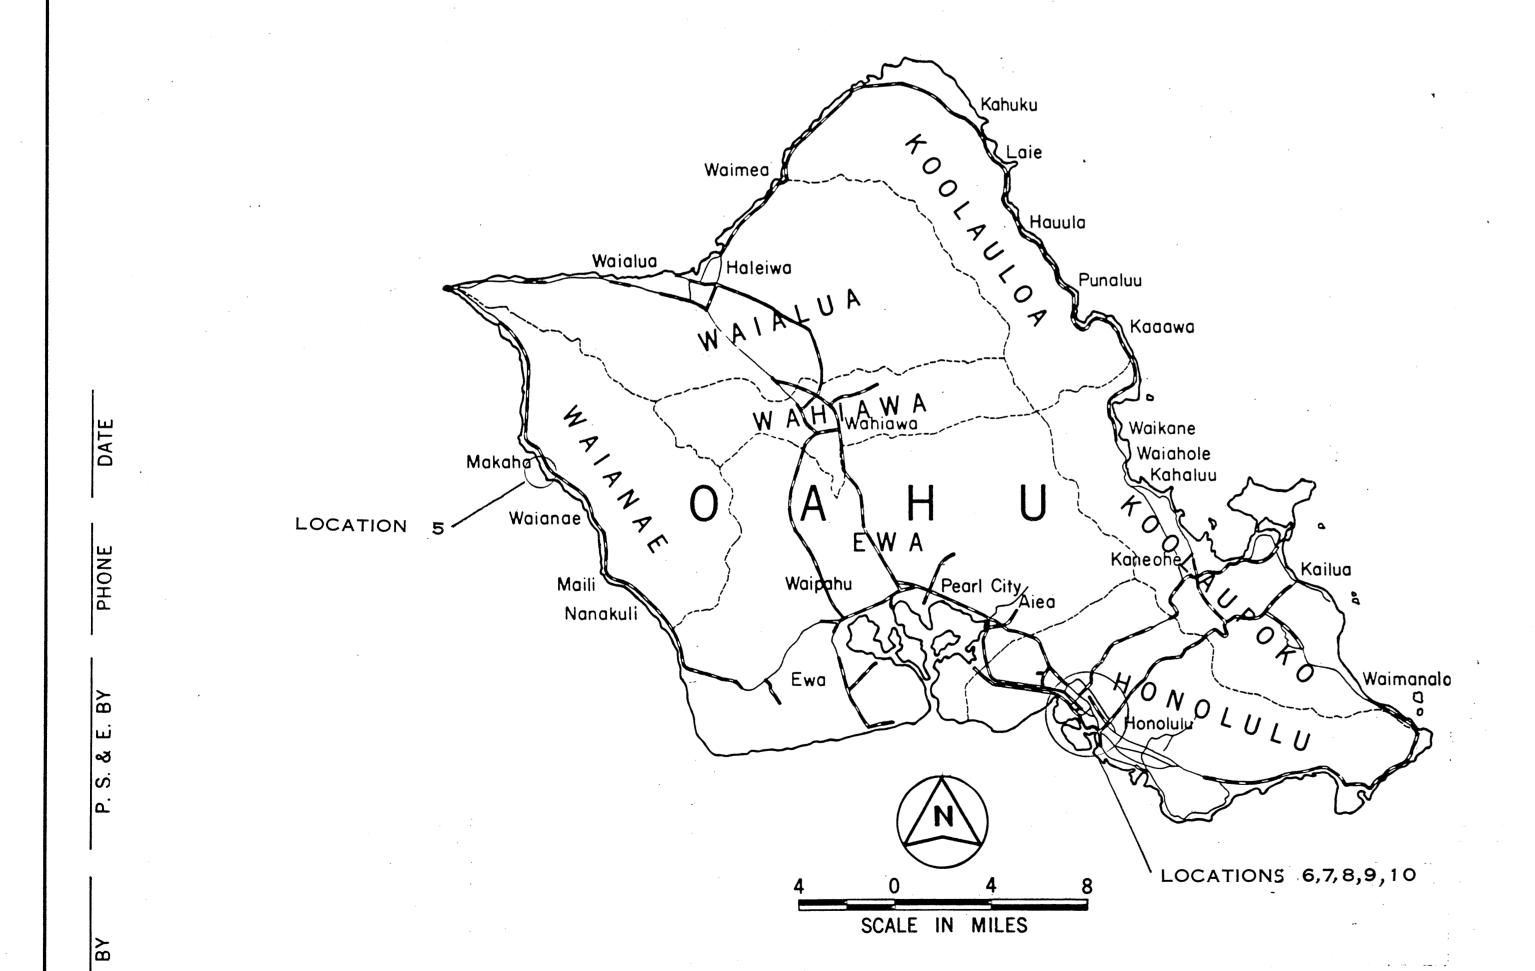

PROJECT NO. HPR - 0010 (10) UNIT 2

DISTRICTS OF HONOLULU AND WAIANAE

CHANGES MADE DURING CONSTRUCTION HAVE BEEN INCORPORATED ON THESE PLANS EXCEPT CHANGES IN THE ORIGINAL THEORETICAL QUANTITIES. FOR ACTUAL QUANTITIES, REFER TO PROJECT LEDGER AND/OR COMPUTATION BOOK.

RESIDENT ENGINEER, OAHU

RESIDENT ENGINEER, HAWAII

LOCATION

NORTH KONA

Kainaliu \_ \_ \_ Captain Cook


Honaunau

LOCATION 3

PROJECT NO. HPR - 0010 (10) UNIT 1 DISTRICTS OF SOUTH HILO, PUNA, SOUTH KONA & NORTH KONA



DEPARTMENT OF TRANSPORTATION STATE OF HAWAII APPROVED: DIR. OF TRANSPORTATION

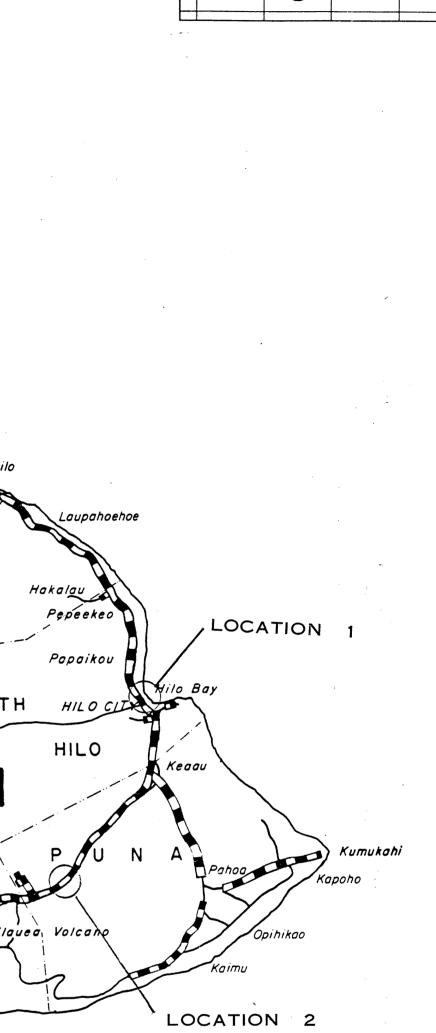

SCALE IN MILES

FED. ROAD DIST. NO.

FED. AID PROJ. NO.

HPR-0010 (10)

STATE OF HAWAII

U-1, U-2

FISCAL SHEET YEAR NO.

1987