

INDEX TO DRAWINGS	
SHEET NO.	DESCRIPTION
1	TITLE SHEET
2	STANDARD PLANS SUMMARY
3	GENERAL NOTES
4-7	TYPICAL SECTIONS & DETAILS
8-17	ROADWAY PLANS
① 18	PLAN & DETAILS
19	TRAFFIC DETOUR PLAN
② 20-23	STRUCTURAL NOTE & DETAILS
24-26	HIGHWAY LIGHTING, NOTES, SCHEDULES, AND SUMMARY
③ 27-46	SIGNING AND PAVEMENT MARKING PLANS

① C.O.18S-1, C.O.18S-2;  
 ② C.O.22S-1, C.O.22S-2, C.O.22S-3;  
 ③ C.O.ADD.4IS-1, C.O.ADD.4IS-2, C.O.ADD.4IS-3,  
 ARE SUPPLEMENT SHEETS TO THE CONTRACT PLANS.  
 NEW TOTAL = 54 SHEETS

STATE OF HAWAII

DEPARTMENT OF TRANSPORTATION

HIGHWAYS DIVISION

"AS-BUILT"

PLANS FOR

INTERSTATE ROUTE H-1


RESURFACING

KAIMAKANI STREET TO AIRPORT VIADUCT

F.A.I. PROJECT NO. IR-HI-1(207)

DISTRICT OF EWA

ISLAND OF OAHU

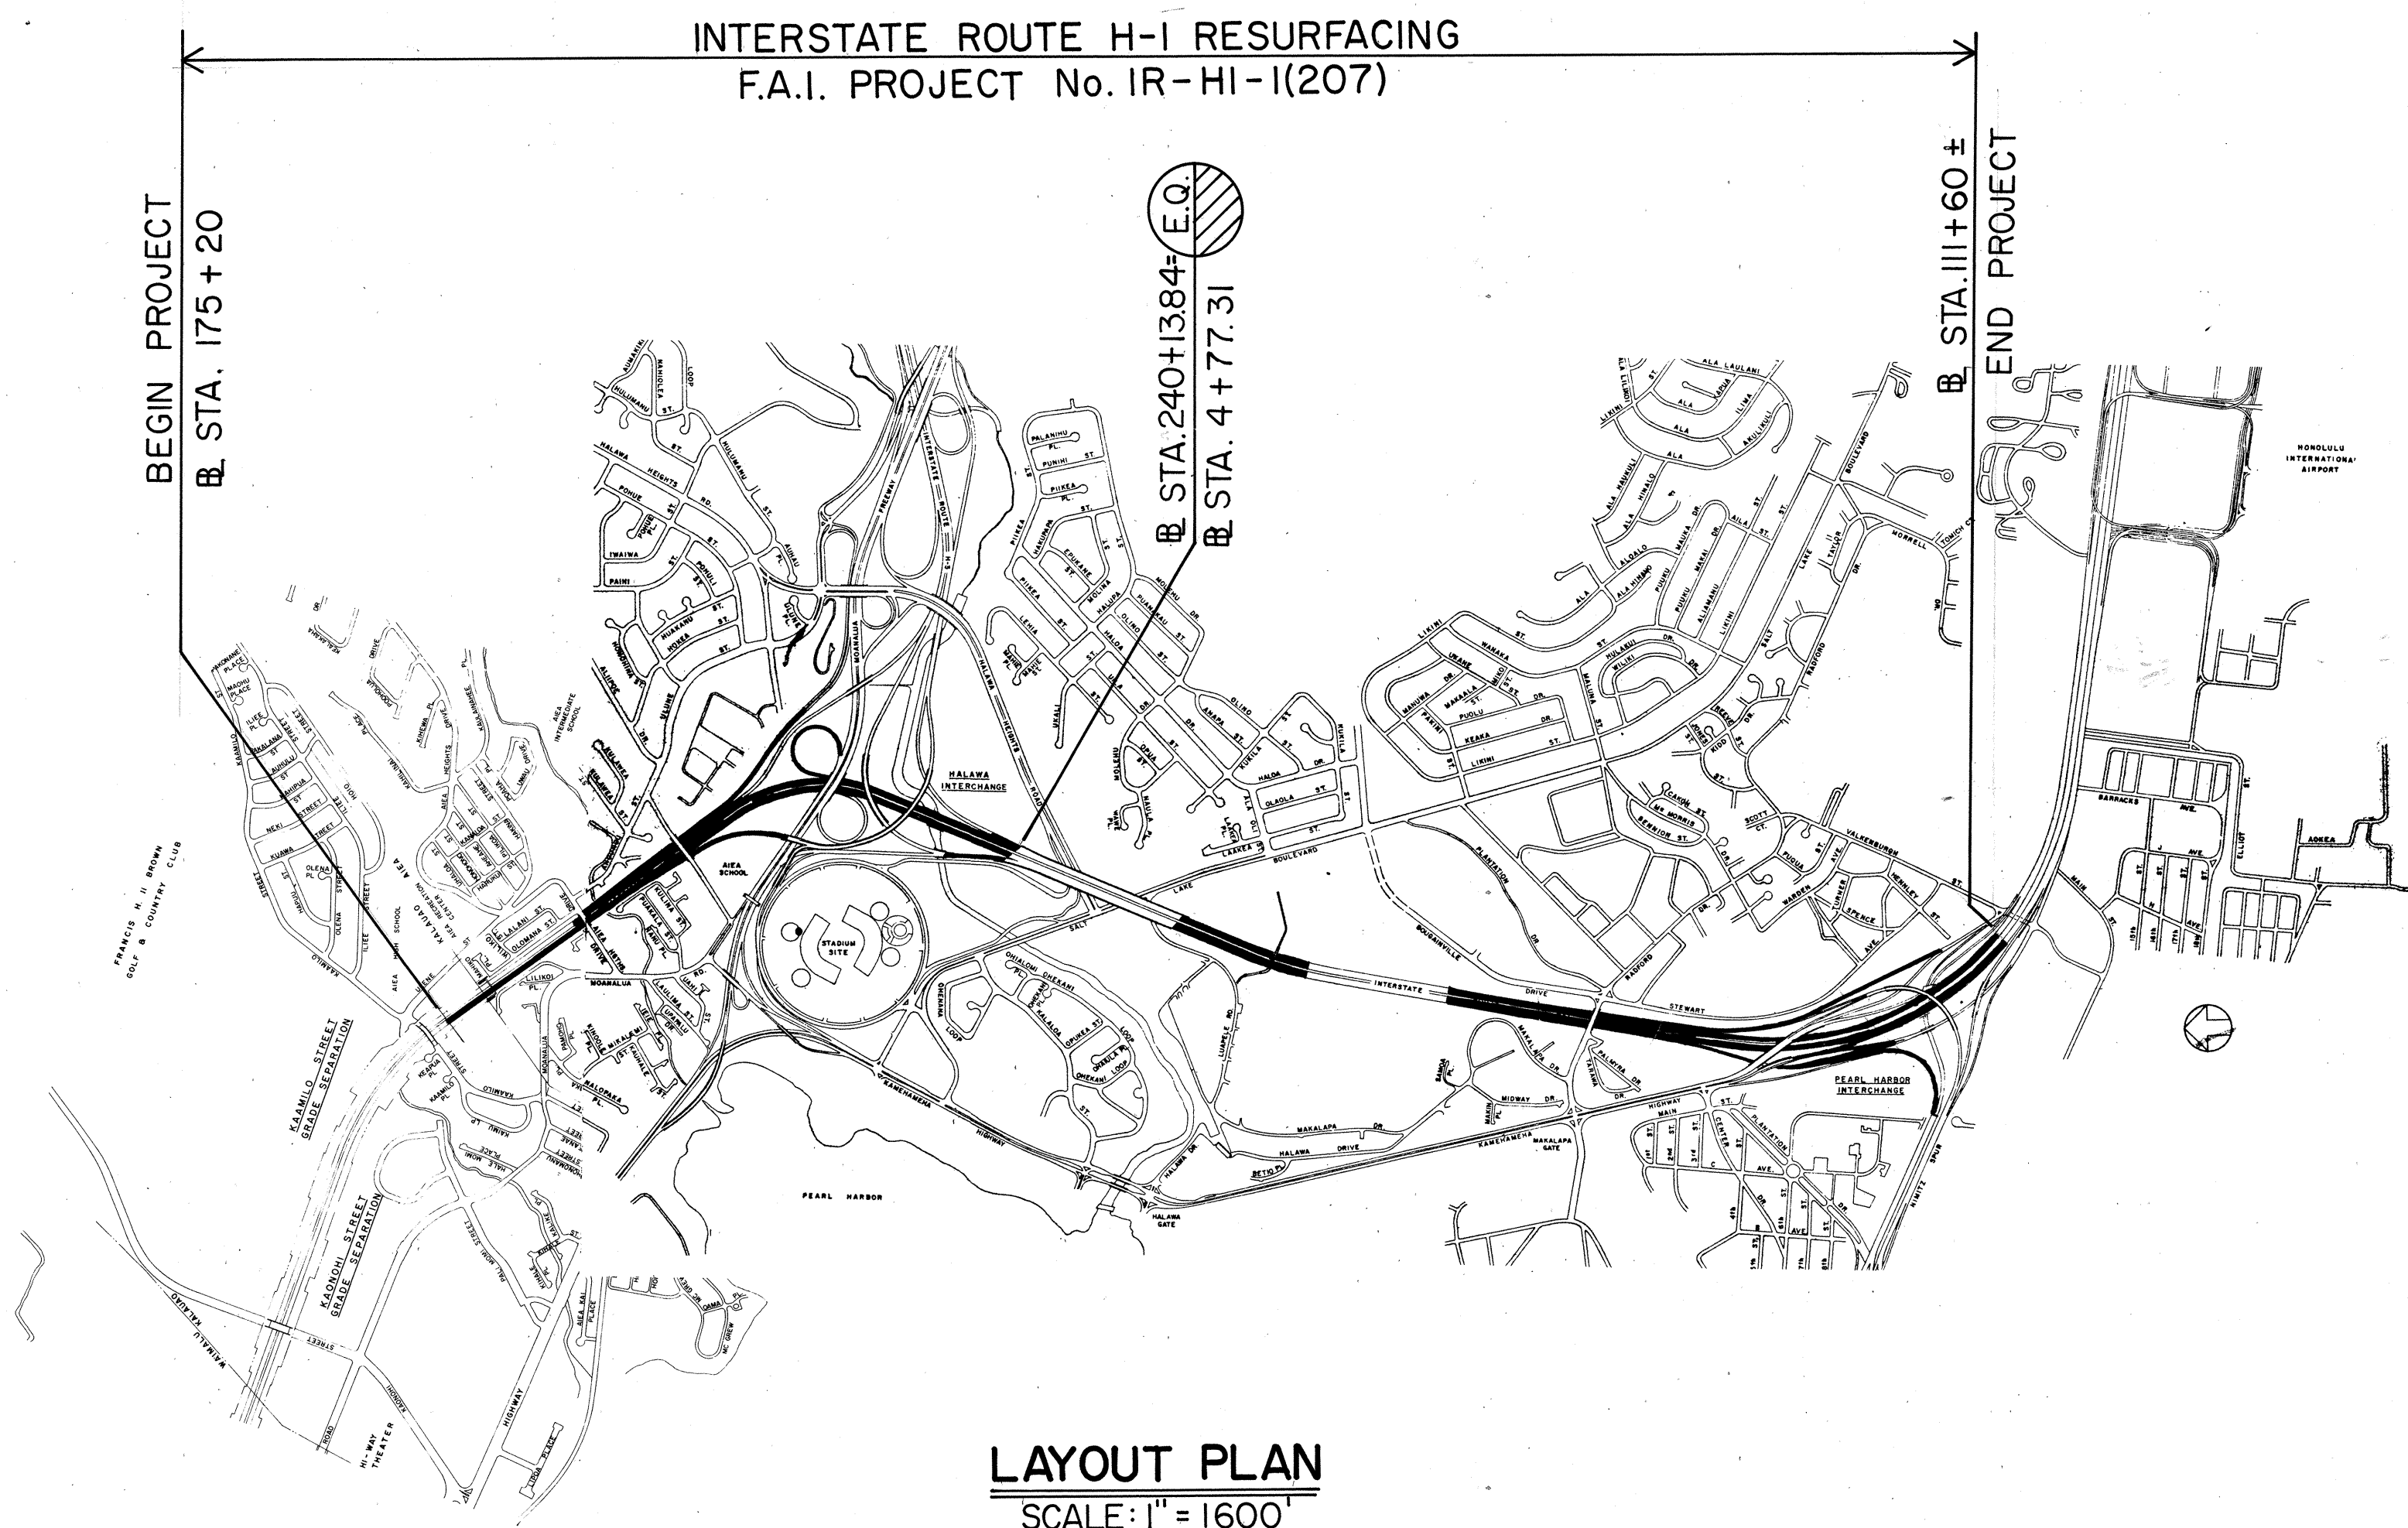

LAYOUT PLAN


SCALE: 1" = 1600'

GROSS LENGTH OF PROJECT...3.253 MI.

LENGTH OF STRUCTURES.....0.376 MI.

NET LENGTH OF PROJECT....2.877 MI.

FED. ROAD DIST. NO.	STATE	FED. AID PROJ. NO.	FISCAL YEAR	SHEET NO.	TOTAL SHEETS
HAWAII	HAW.	IR-HI-1(207)	1988	1	46

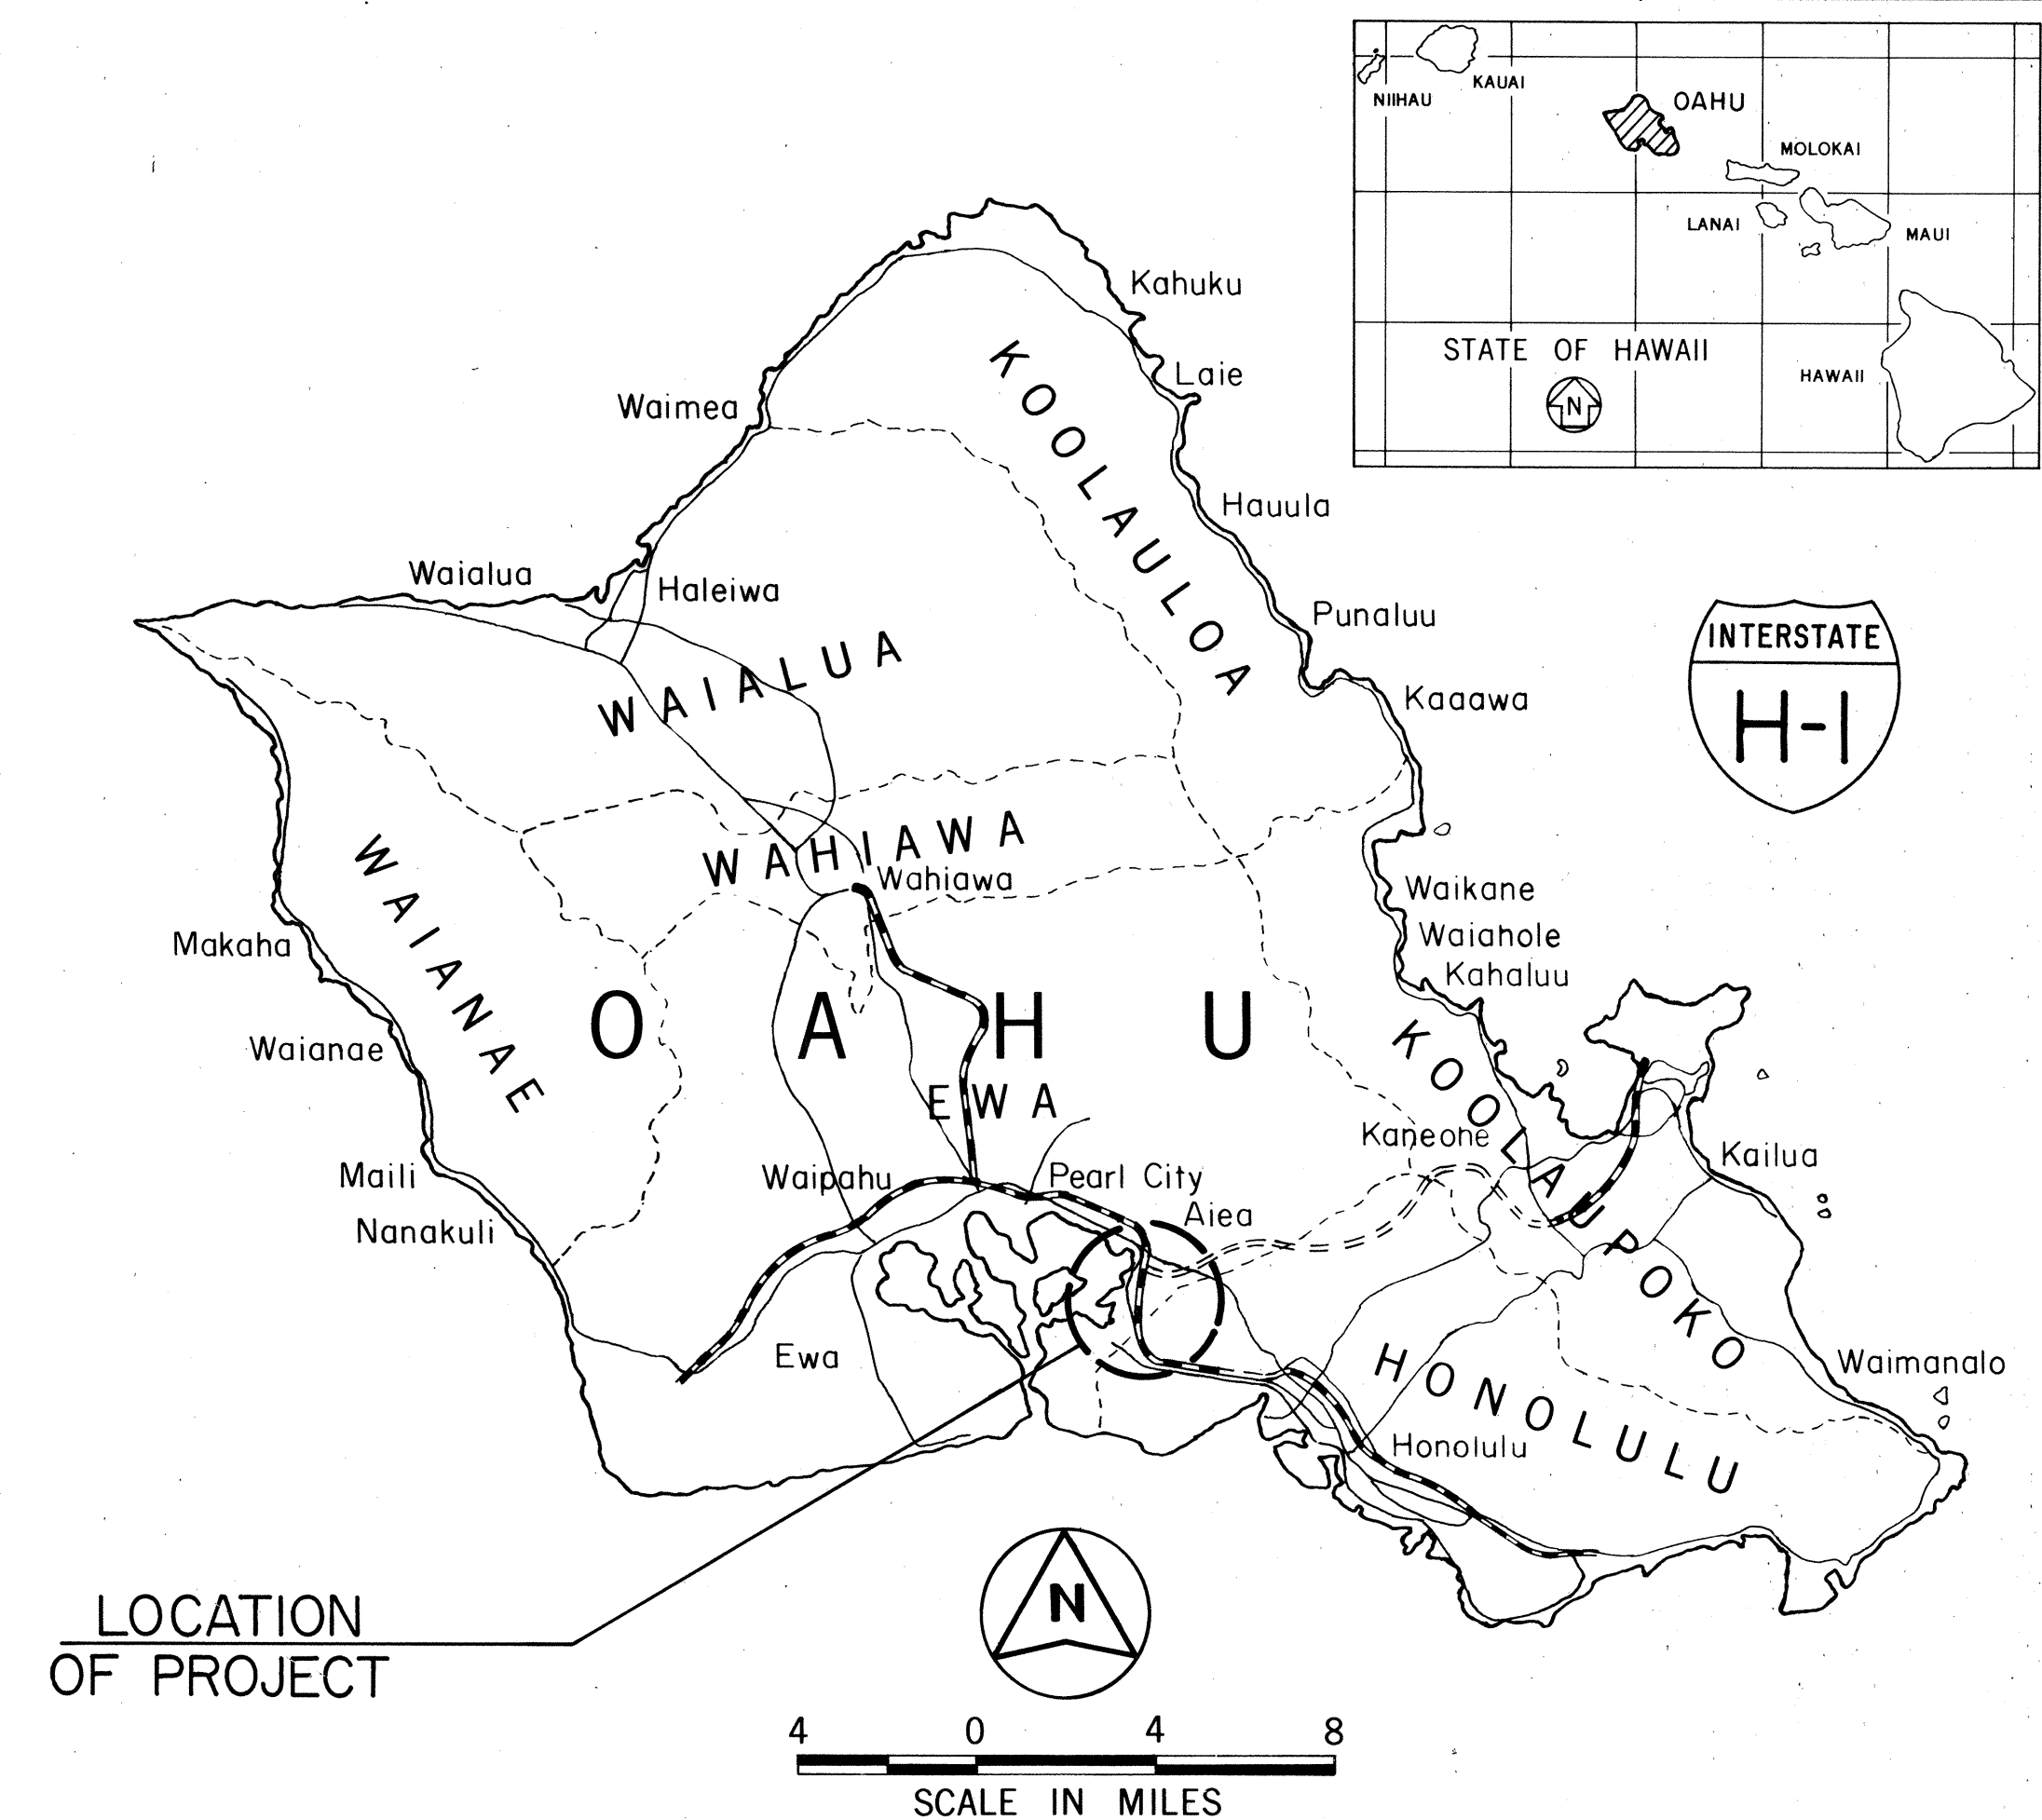

FEDERAL AID INTERSTATE PROJECTS PREVIOUSLY CONSTRUCTED OR UNDER CONSTRUCTION

CHANGES MADE DURING CONSTRUCTION HAVE BEEN INCORPORATED ON THESE PLANS EXCEPT CHANGES IN THE ORIGINAL THEORETICAL QUANTITIES. FOR ACTUAL QUANTITIES, REFER TO PROJECT LEDGER AND/OR COMPUTATION BOOK.

*Sidney S. C. Ze*

RESIDENT ENGINEER

7/24/95

DATE

DESIGN CLASSIFICATION	
ADT (1988)	79,700
DESIGN ADT (2008)	105,700
DHV	11,100
D	85/15
T	3.5%
T <sub>24</sub>	4.0%
V	60 M.P.H

DEPARTMENT OF TRANSPORTATION

FEDERAL HIGHWAY ADMINISTRATION

APPROVED:

*William A. ...*

DIVISION ADMINISTRATOR

5/25/88

DATE

DEPARTMENT OF TRANSPORTATION

STATE OF HAWAII

APPROVED:

*Edward ...*

DIR. OF TRANSPORTATION

5/20/88

DATE