
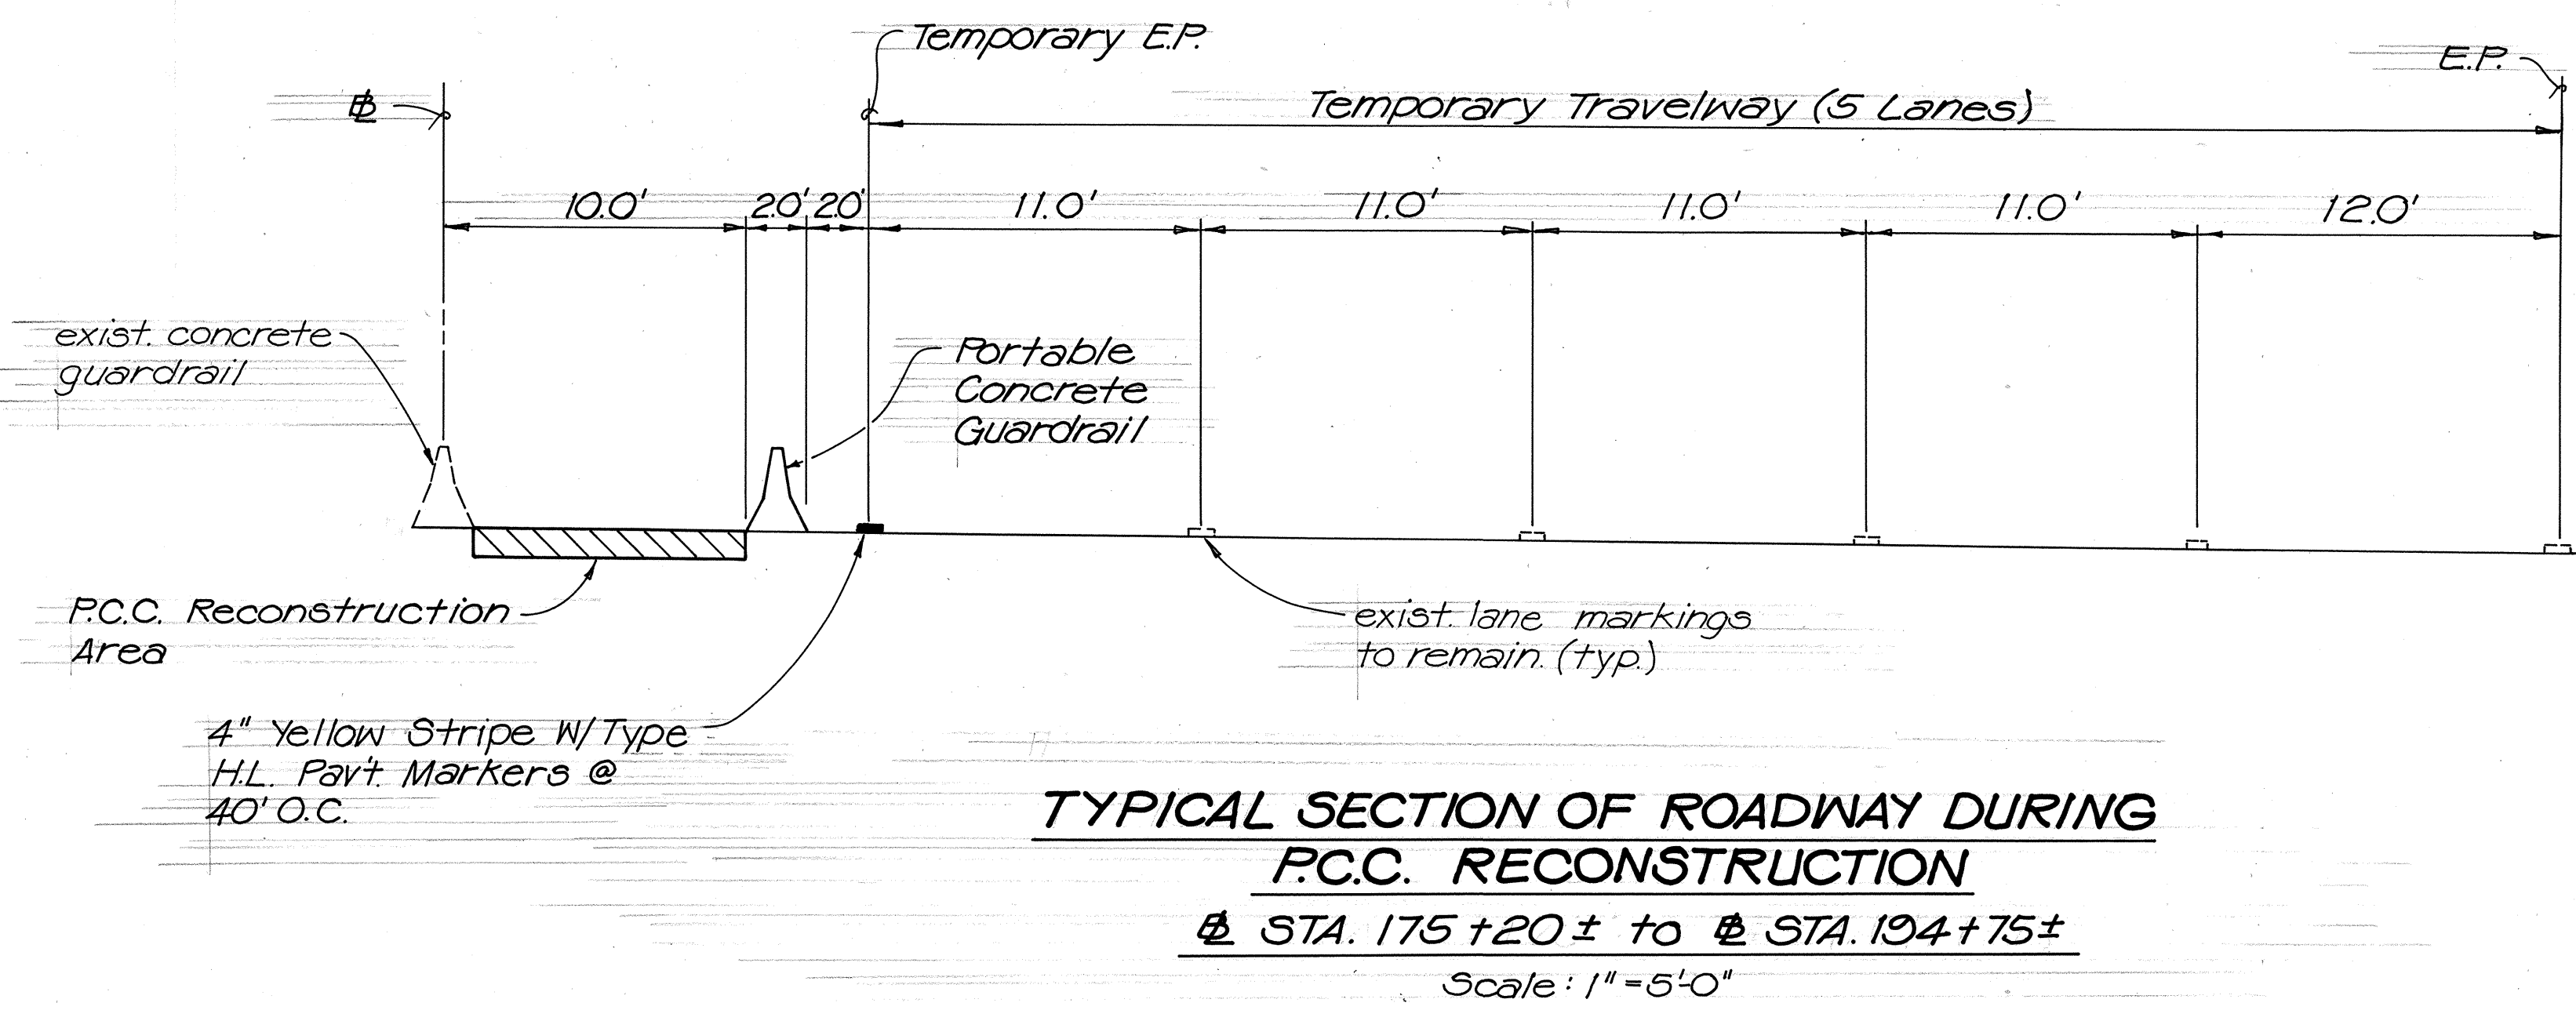


FED. ROAD DIST. NO.	STATE	FED. AID PROJ. NO.	FISCAL YEAR	SHEET NO.	TOTAL SHEETS
HAWAII	HAW.	IR-HI-1(207)	1988	19	46

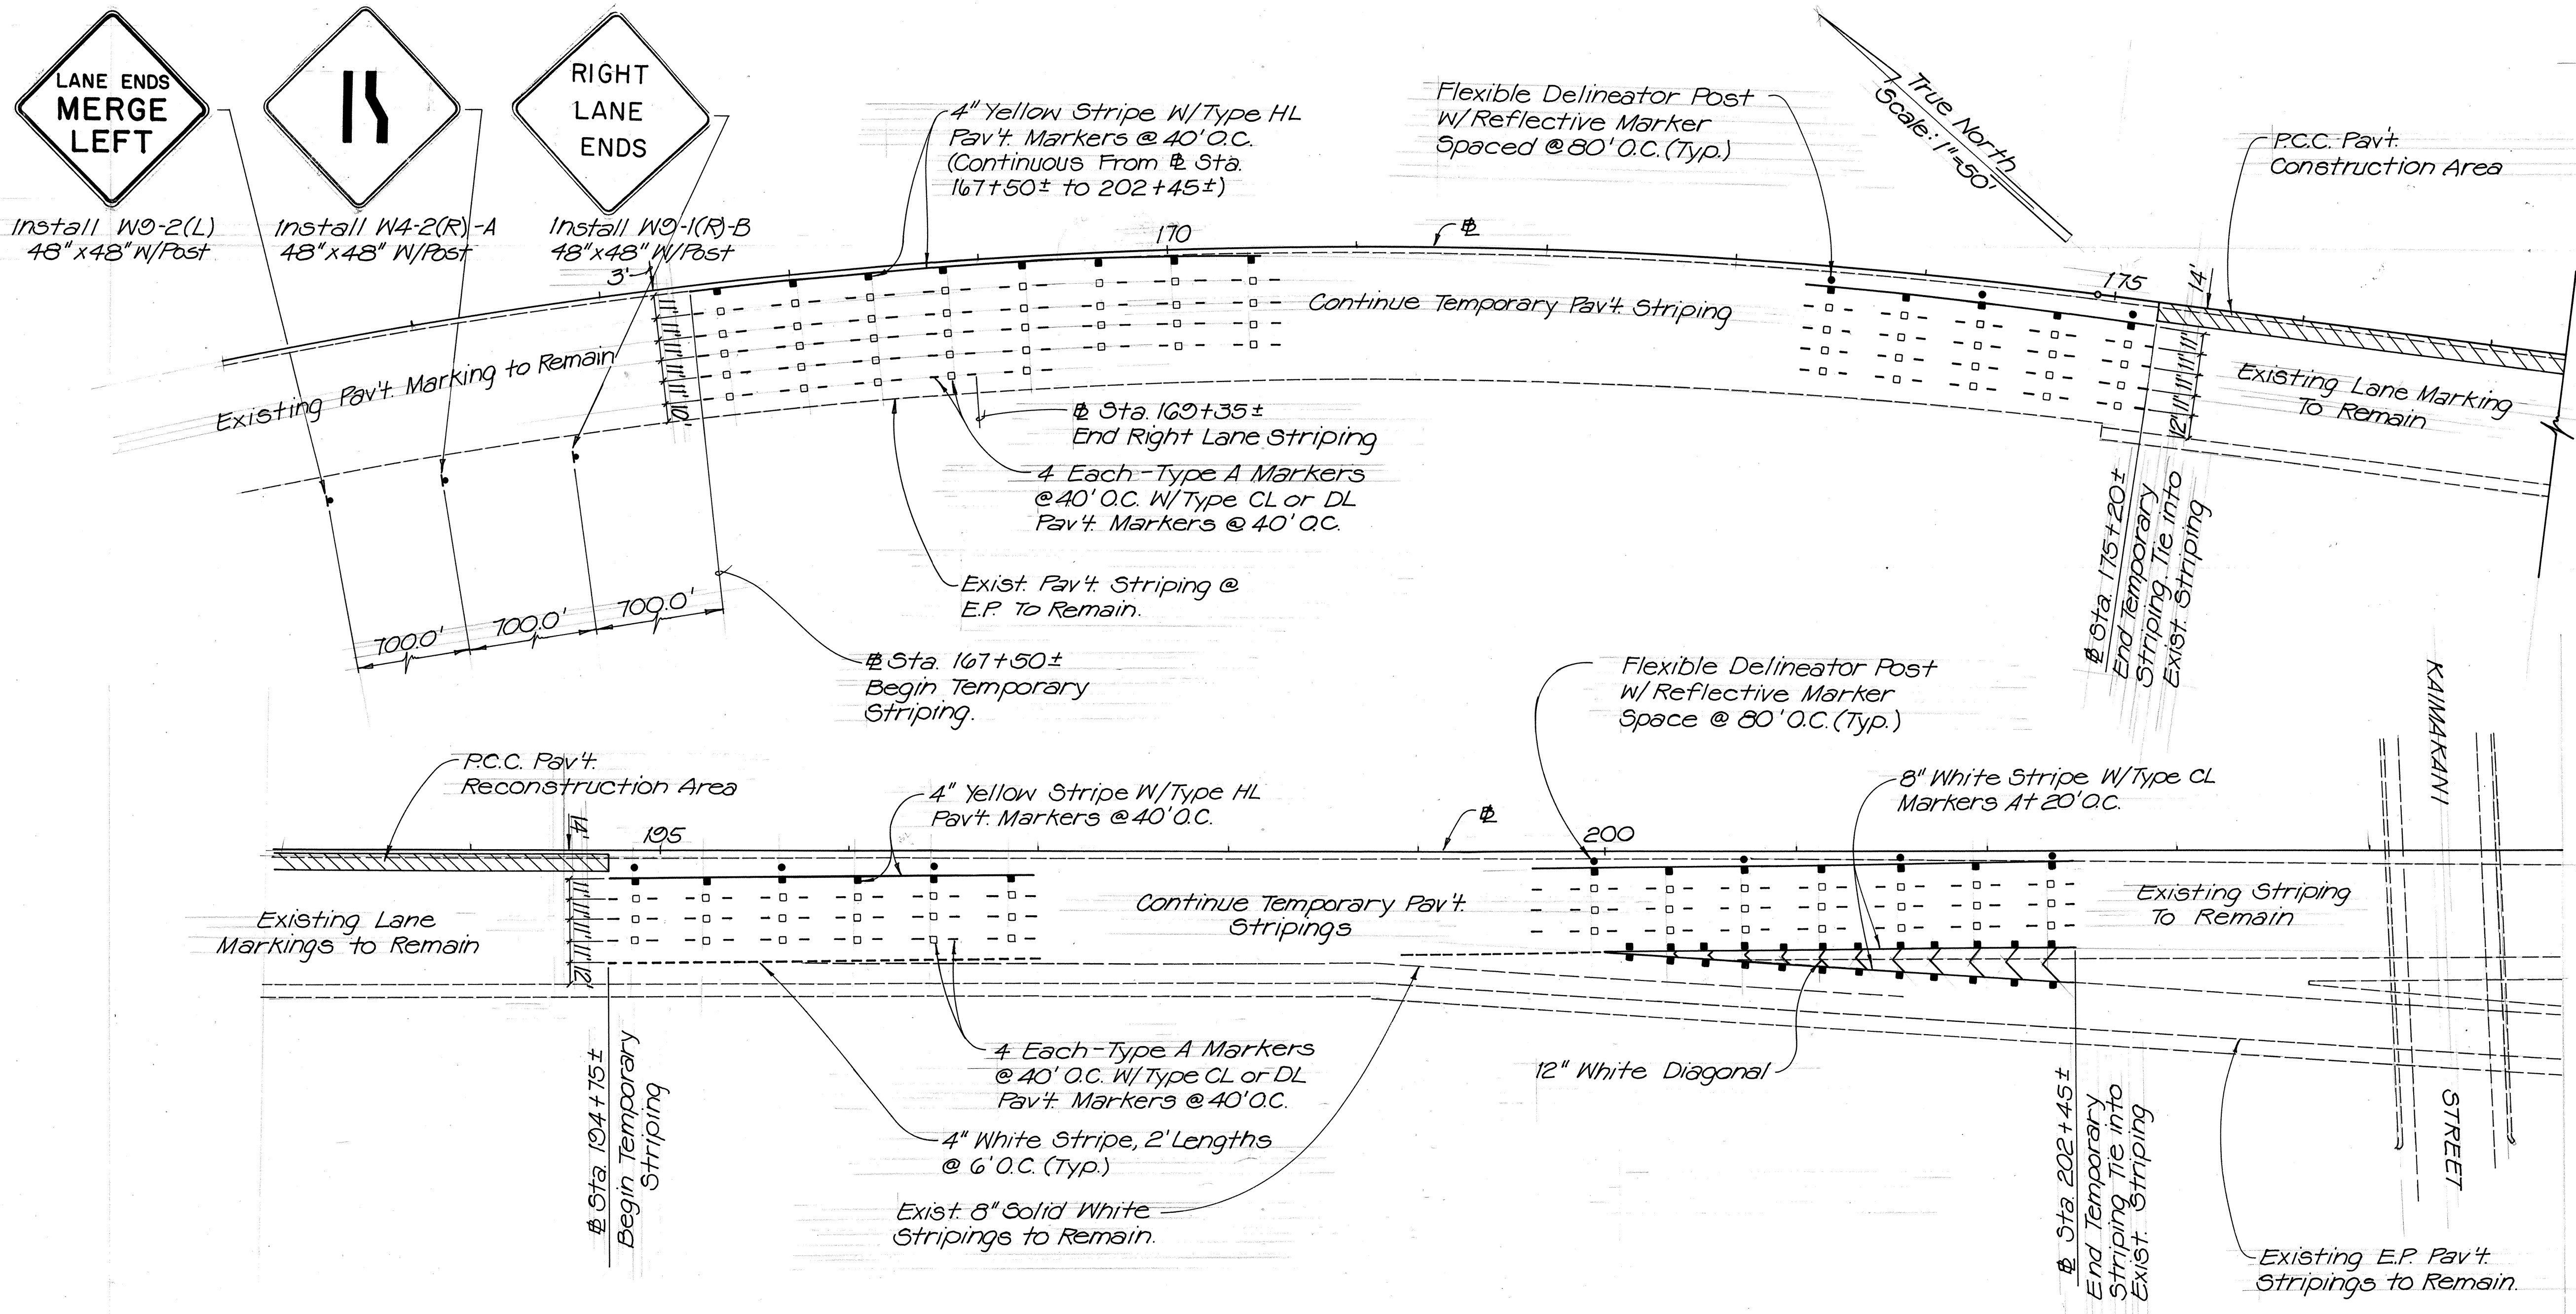

- Note:**
1. All Existing Pav't. Stripings Between Sta. 167+50± to Sta. 175+20± And Sta. 194+75± to Sta. 202+45± Shall Be Removed Prior to Installing Temporary Pav't. Striping Unless Otherwise Noted.
 2. Temporary Pavement Markers Shall be applied with an Butyl Pad as recommended by the manufacturer and as directed by the Engineer.
 3. Removal of Temporary Pavement Markers. The Contractor shall use removal methods that will cause the least possible damage to the pavement and its surface and as directed by the Engineer. The Contractor shall not cause impressions of temporary markers to remain after his removal operations.

STATE OF HAWAII
DEPARTMENT OF TRANSPORTATION
HIGHWAYS DIVISION
TRAFFIC DETOUR PLAN
INTERSTATE ROUTE H-1
RESURFACING KAIMAKANI ST.
TO AIRPORT VIADUCT
F.A.I. PROJECT No. IR-HI-1(207)
Scale: As Shown Date: June, 1988
SHEET No. 1 OF 1 SHEETS

19