

[illegible]

① 5 S-1, IS SUPPLEMENT SHEET TO THE  
CONTRACT PLANS. TOTAL = 6

DESIGNED BY HWY-DB R. TAKAESU 548-4125 APRIL, 1989  
PHONE DATE  
P. S. & E. BY

DATE 11, 1981

57

**8-4**

1

**SE**

**TA**

100

3Y

WY

1	2	3	466
---	---	---	---	---	---	---	---	---	----	----	-----	-----	
---

STATE OF HAWAII  
DEPARTMENT OF TRANSPORTATION  
HIGHWAYS DIVISION  
HONOLULU, HAWAII  
" AS BUILT "  
PLANS FOR  
INTERSTATE ROUTE H-1  
HALAWA INTERCHANGE

HIGHWAYS DIVISION  
HONOLULU, HAWAII

" AS BUILT "  
PLANS FOR


# INTERSTATE ROUTE H-1 HALAWA INTERCHANGE

# HALAWA INTERCHANGE

# REPAIR HALAWA STREAM CONCRETE LINING




## PROJECT NO. HIF - 01 - 89M

PROJECT NO. HIF - 01 - 89M

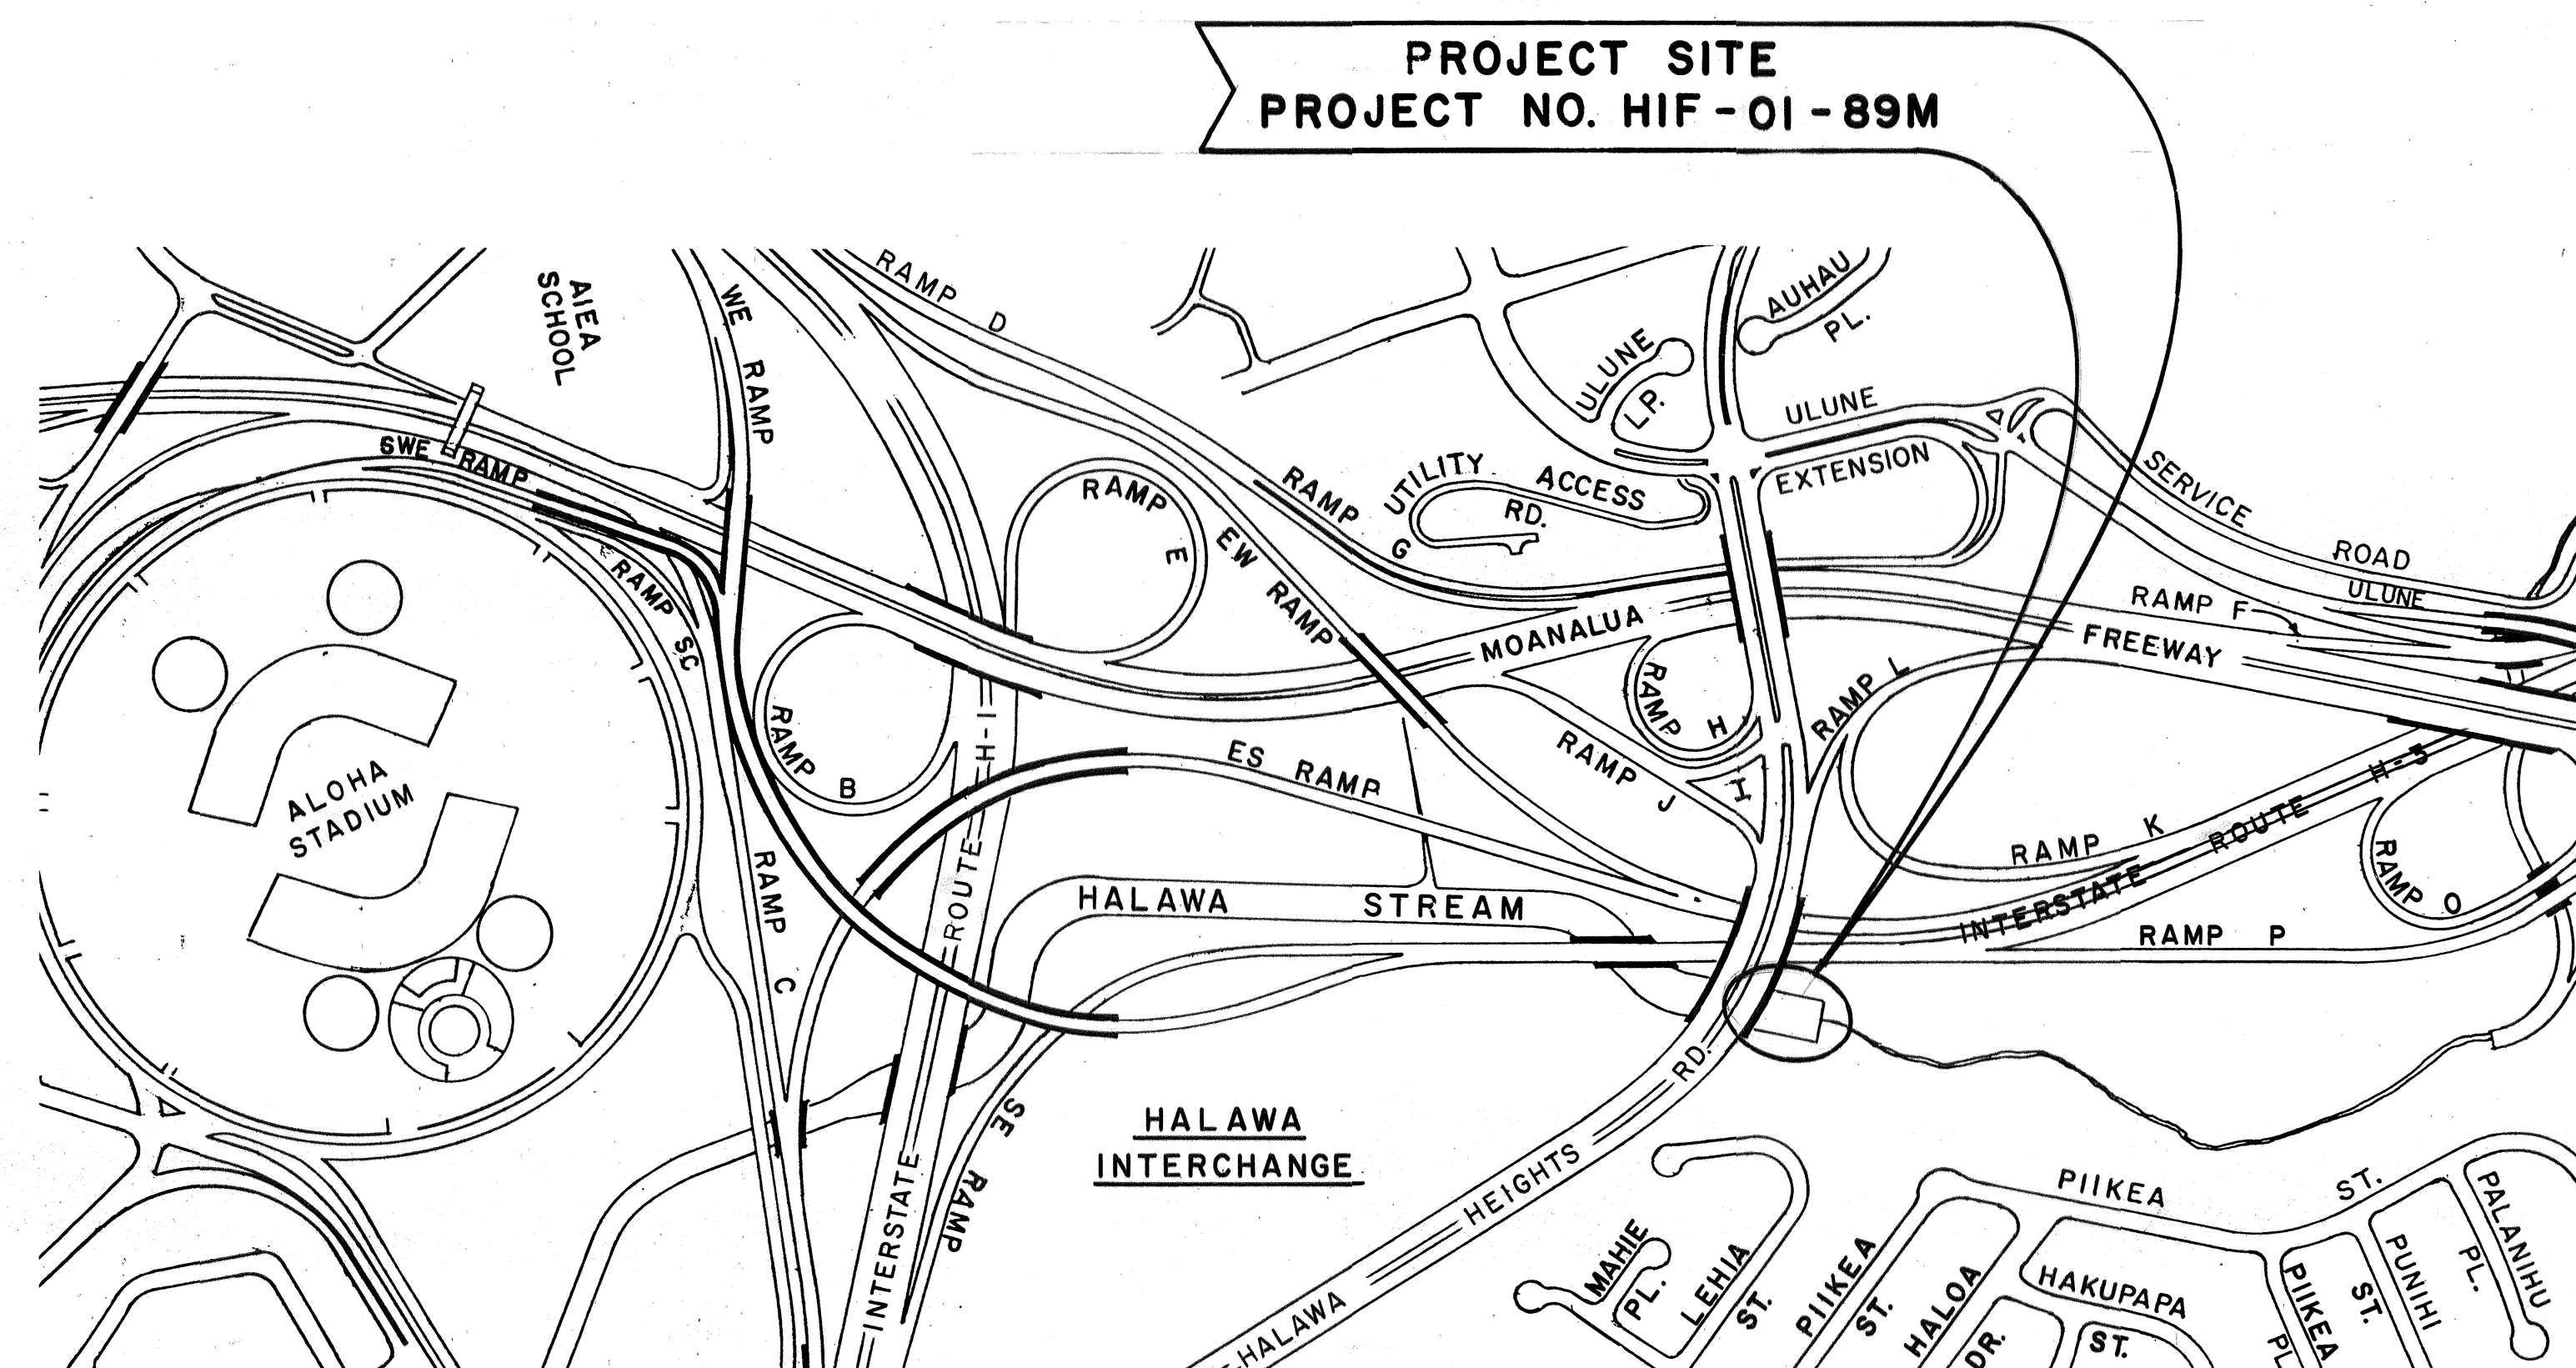DISTRICT OF EWA  
ISLAND OF OAHU

## LAYOUT PLAN

FED. ROAD DIST. NO.	STATE	PROJ. NO.	FISCAL YEAR	SHEET NO.	TOTAL SHEETS
HAWAII	HAW.	HIF - 01 - 89M	1989	1	5

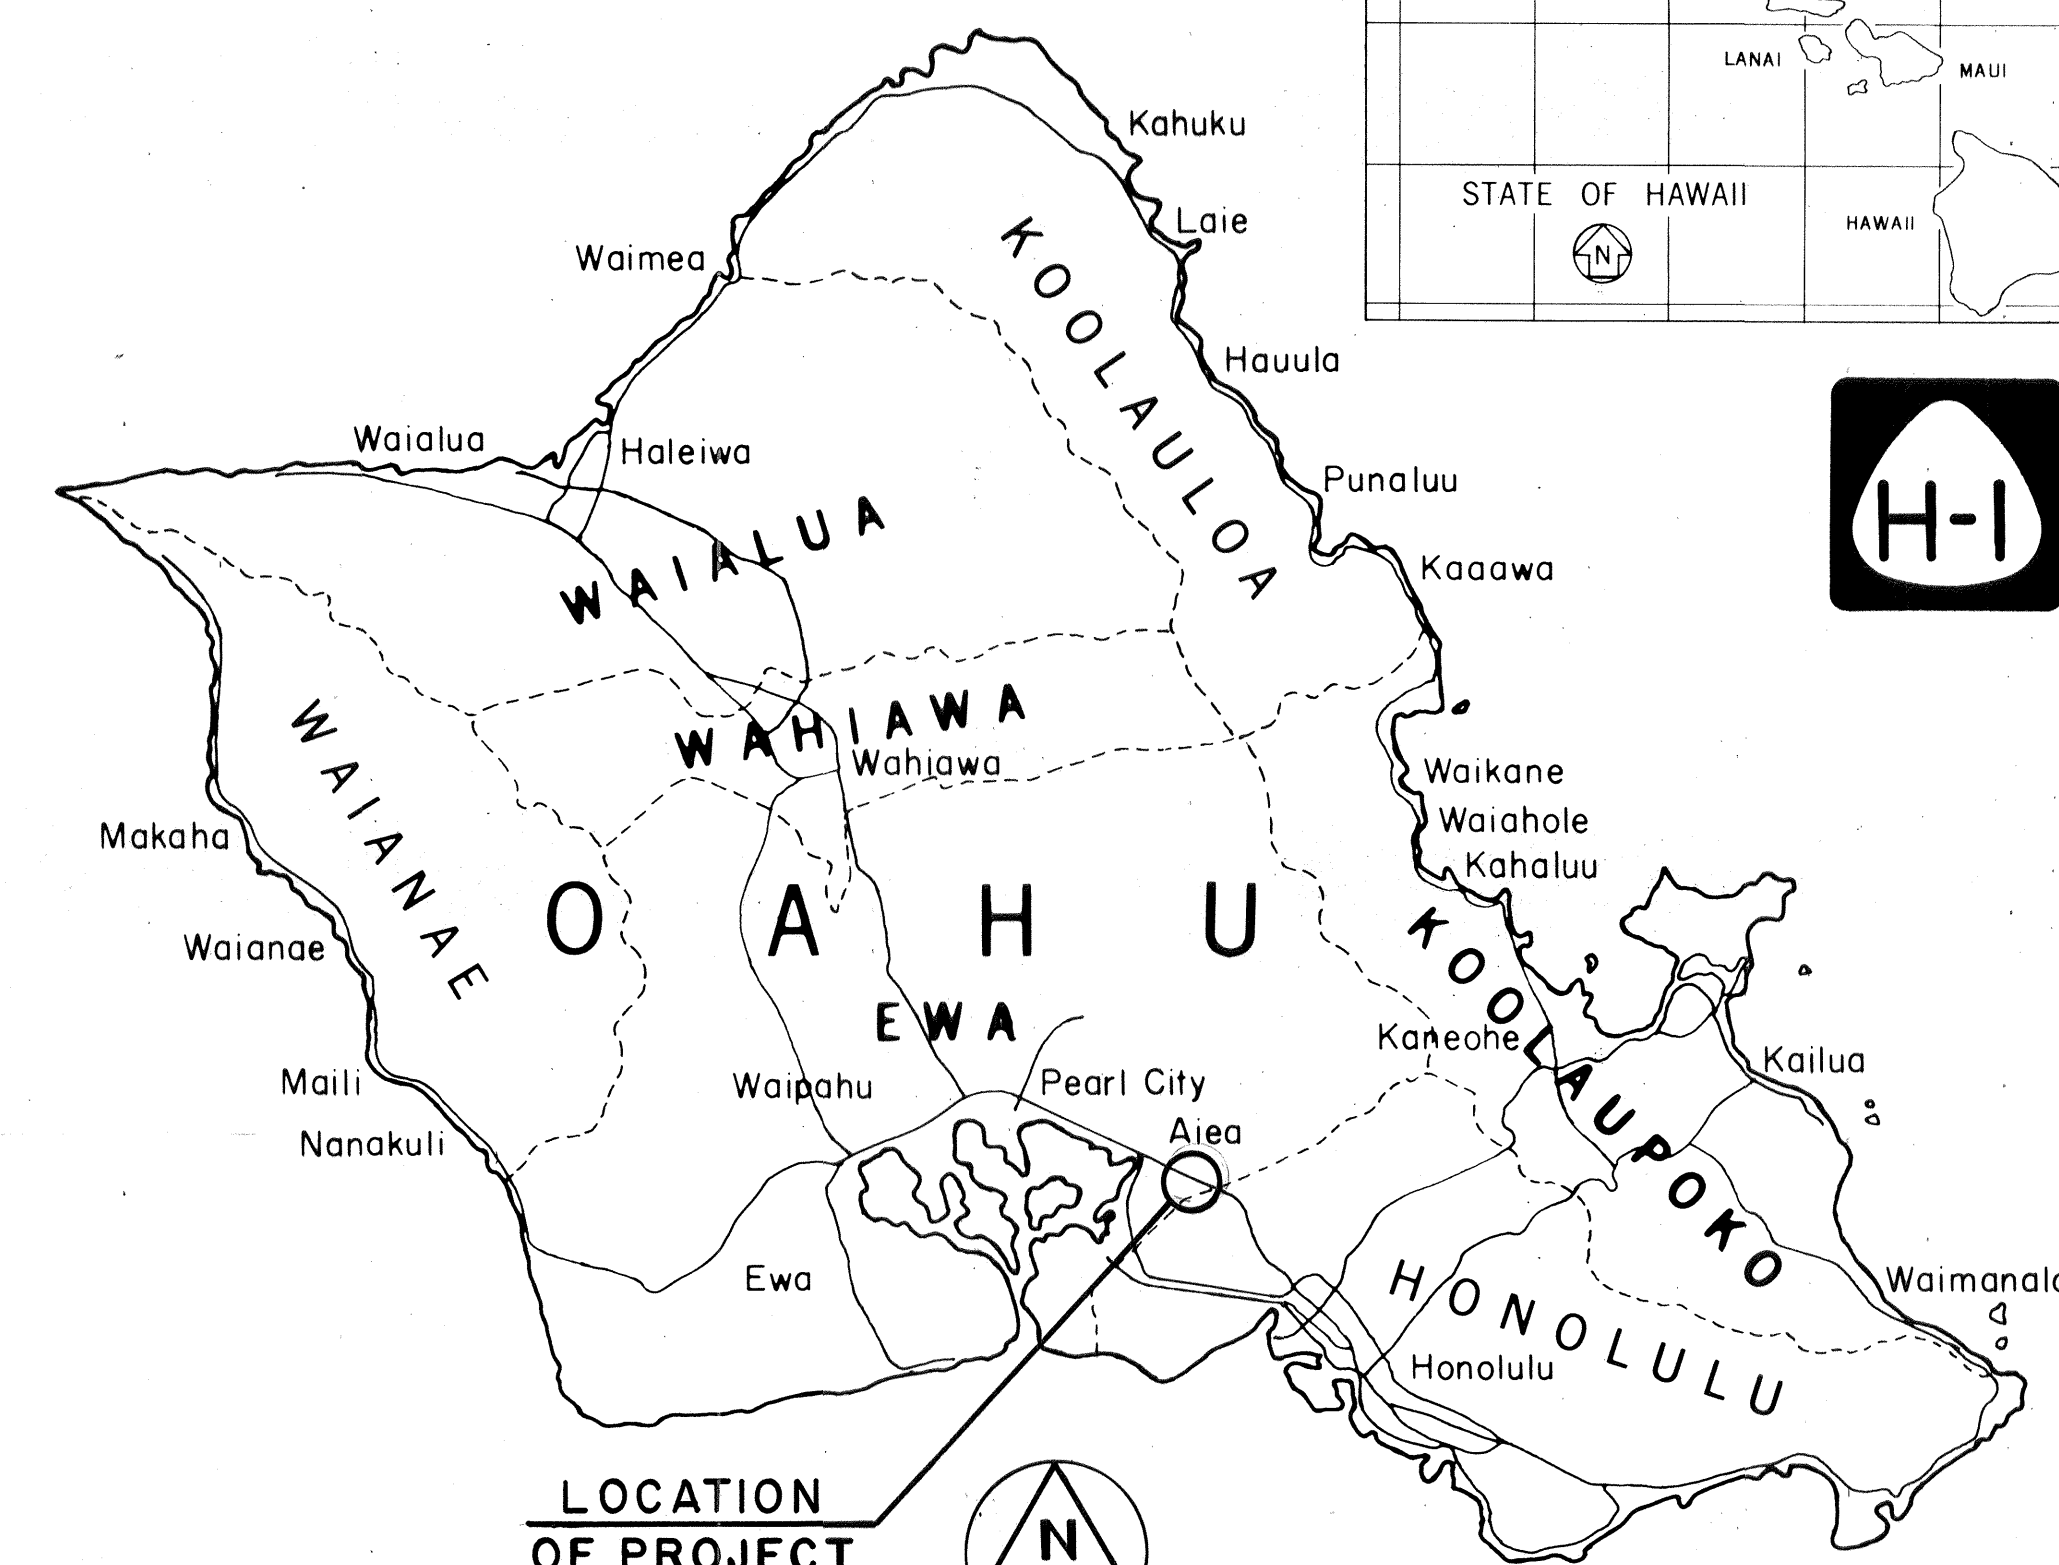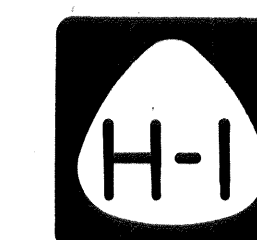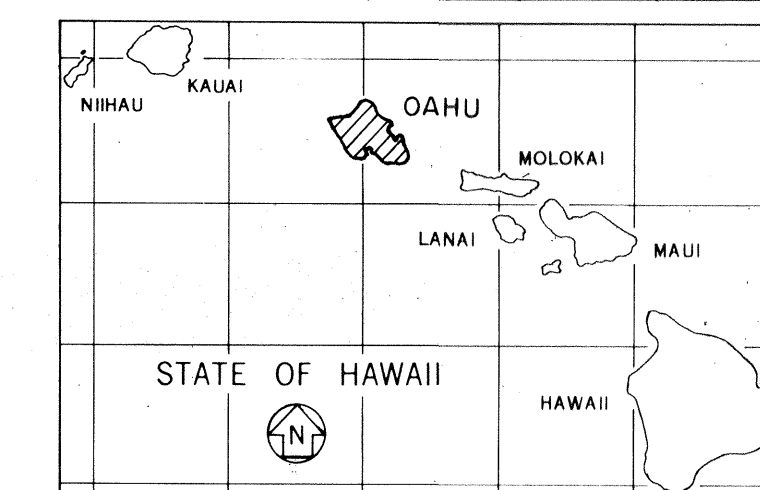

LOCATION  
OF PROJECT



4 0 4

SCALE IN MILES

MILE POST		TO MILE POST	
1	2	3	4
5	6	7	8
9	10	11	12
13	14	15	16
17	18	19	20
21	22	23	24
25	26	27	28
29	30	31	32
33	34	35	36
37	38	39	40
41	42	43	44
45	46	47	48
49	50	51	52
53	54	55	56
57	58	59	60
61	62	63	64
65	66	67	68
69	70	71	72
73	74	75	76
77	78	79	80
81	82	83	84
85	86	87	88
89	90	91	92
93	94	95	96
97	98	99	100

CHANGES MADE DURING CONSTRUCTION HAVE BEEN INCORPORATED ON THESE PLANS EXCEPT CHANGES IN THE ORIGINAL THEORETICAL QUANTITIES. FOR ACTUAL QUANTITIES, REFER TO PROJECT LEDGER AND/OR COMPUTATION BOOK.

Howard C. Y. Young  
RESIDENT ENGINEER

6-5-90  
DATE

DEPARTMENT OF TRANSPORTATION  
STATE OF HAWAII

APPROVED:

Edward J. Pratt 5/2/89  
DIR. OF TRANSPORTATION DATE

Edward J. ...  
DIR. OF TRANSPORTATION

5/2/89  
DATE