

INDEX TO DRAWINGS	
SHEET NO.	DESCRIPTION
1	TITLE SHEET
2	STANDARD PLANS SUMMARY
3	GENERAL NOTES, TYPICAL DETAILS, AND LEGEND
4 & 5	ROADWAY PLANS
6	PAVEMENT MARKING, LEGEND, DETAIL & NOTES
7	LOOP DETECTOR DETAIL
* 8 & 9	SIGNING & PAVEMENT MARKING PLAN

* 8S-1 IS A SUPPLEMENT SHEET TO THE CONTRACT PLANS
TOTAL = 10 SHEETS

STATE OF HAWAII

DEPARTMENT OF TRANSPORTATION

HIGHWAYS DIVISION

HONOLULU, HAWAII

"AS-BUILT"

PLANS FOR

H-1 KAPIOLANI INTERCHANGE



RESURFACING OF SOUTH KING ST, HARDING AVE,

KAPIOLANI BLVD, AND KAPAHULU AVE

PROJECT NO. HIJ-01-89M

DISTRICT OF HONOLULU

ISLAND OF OAHU

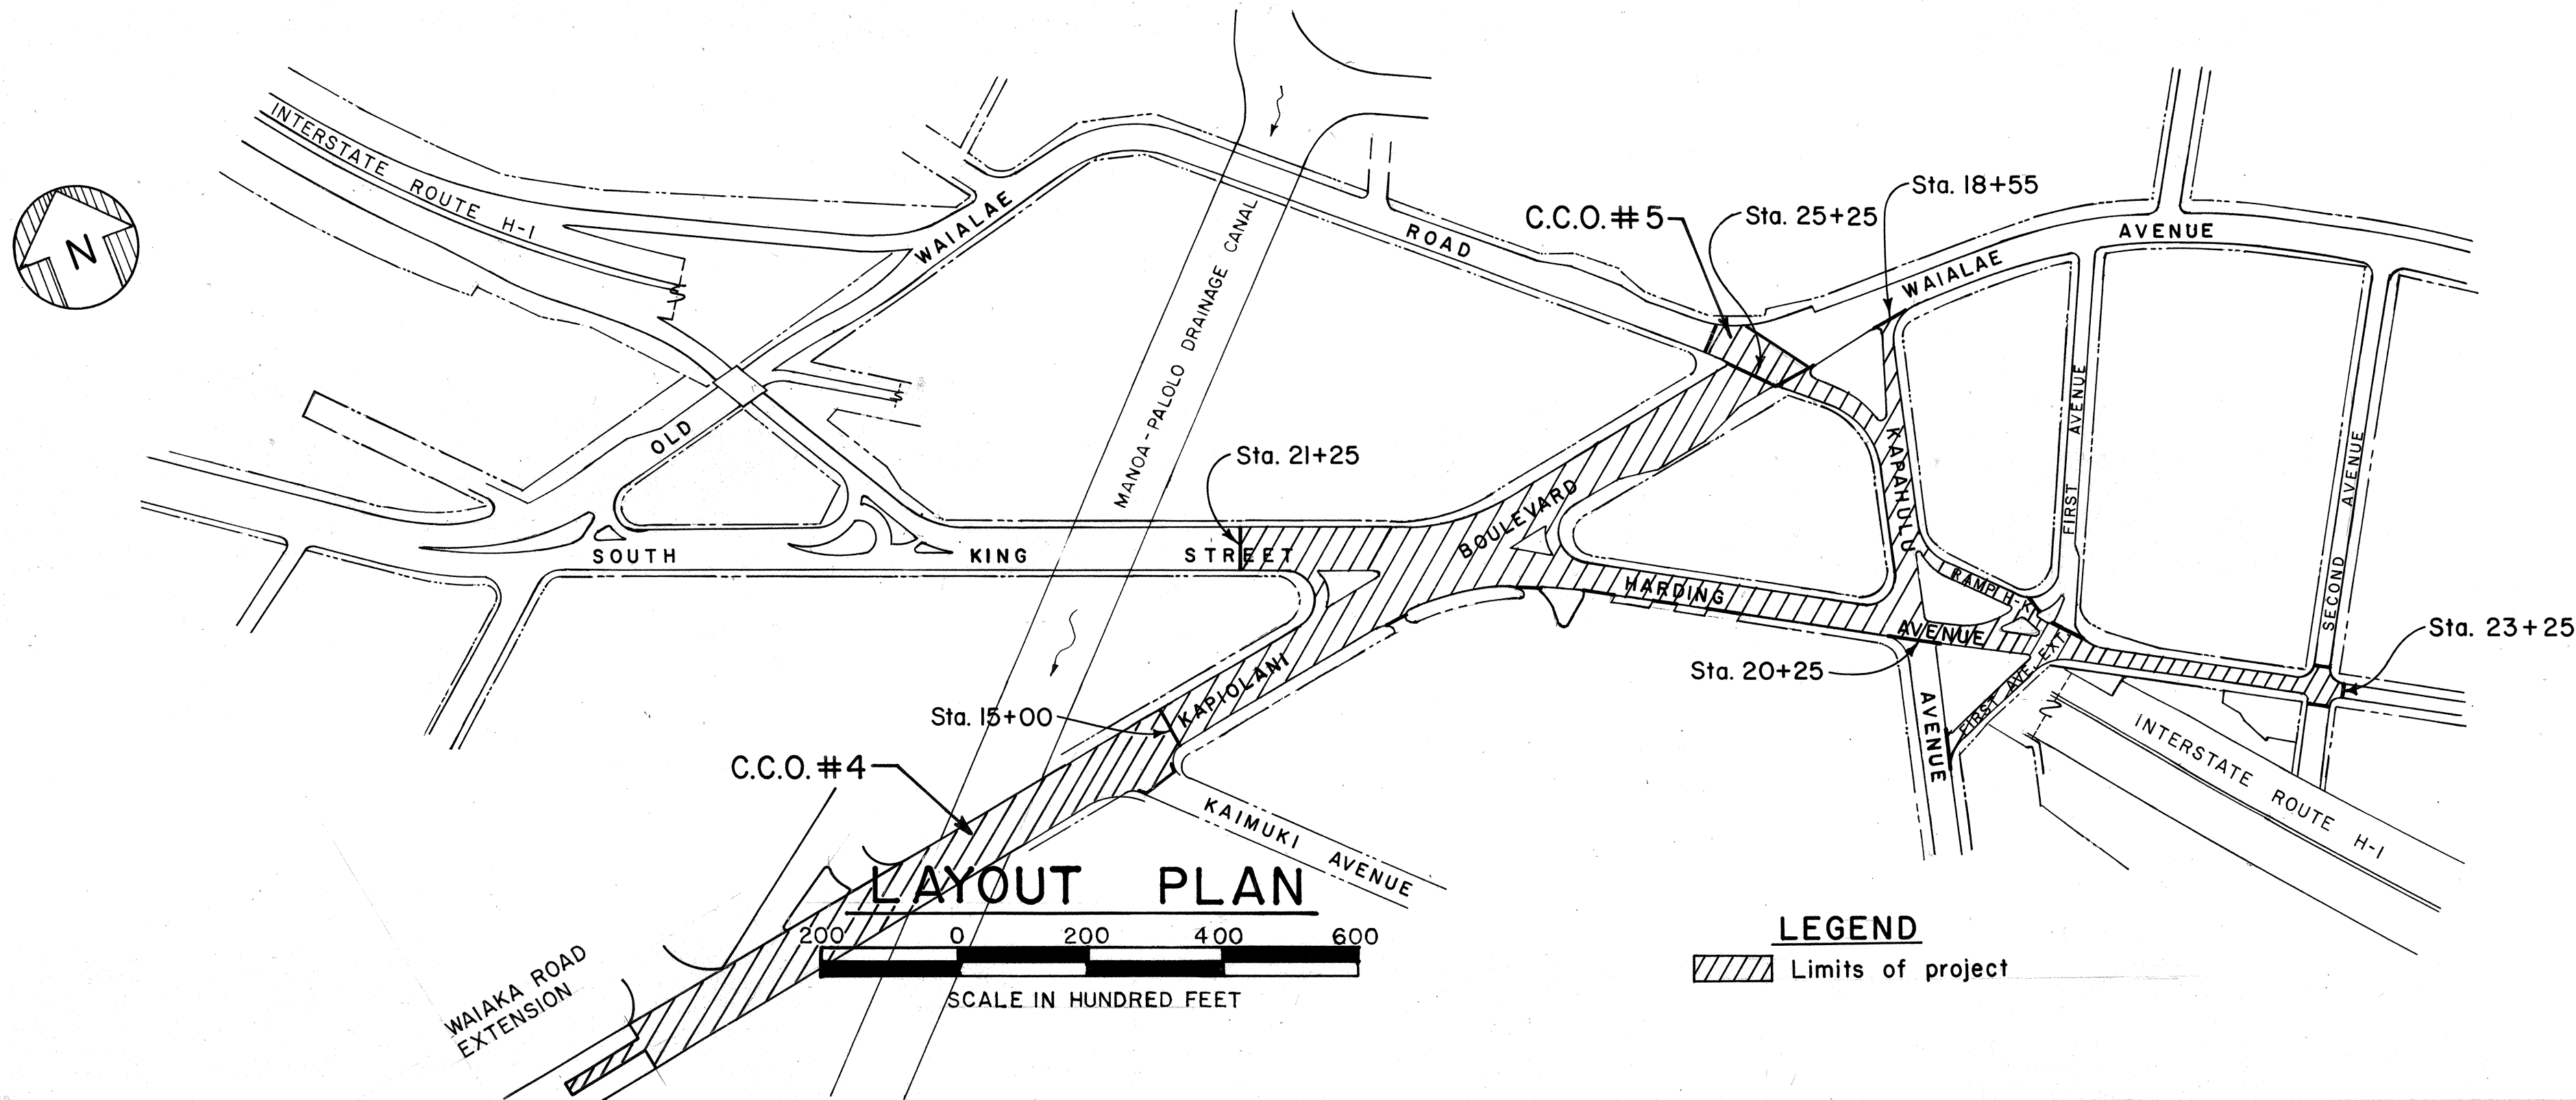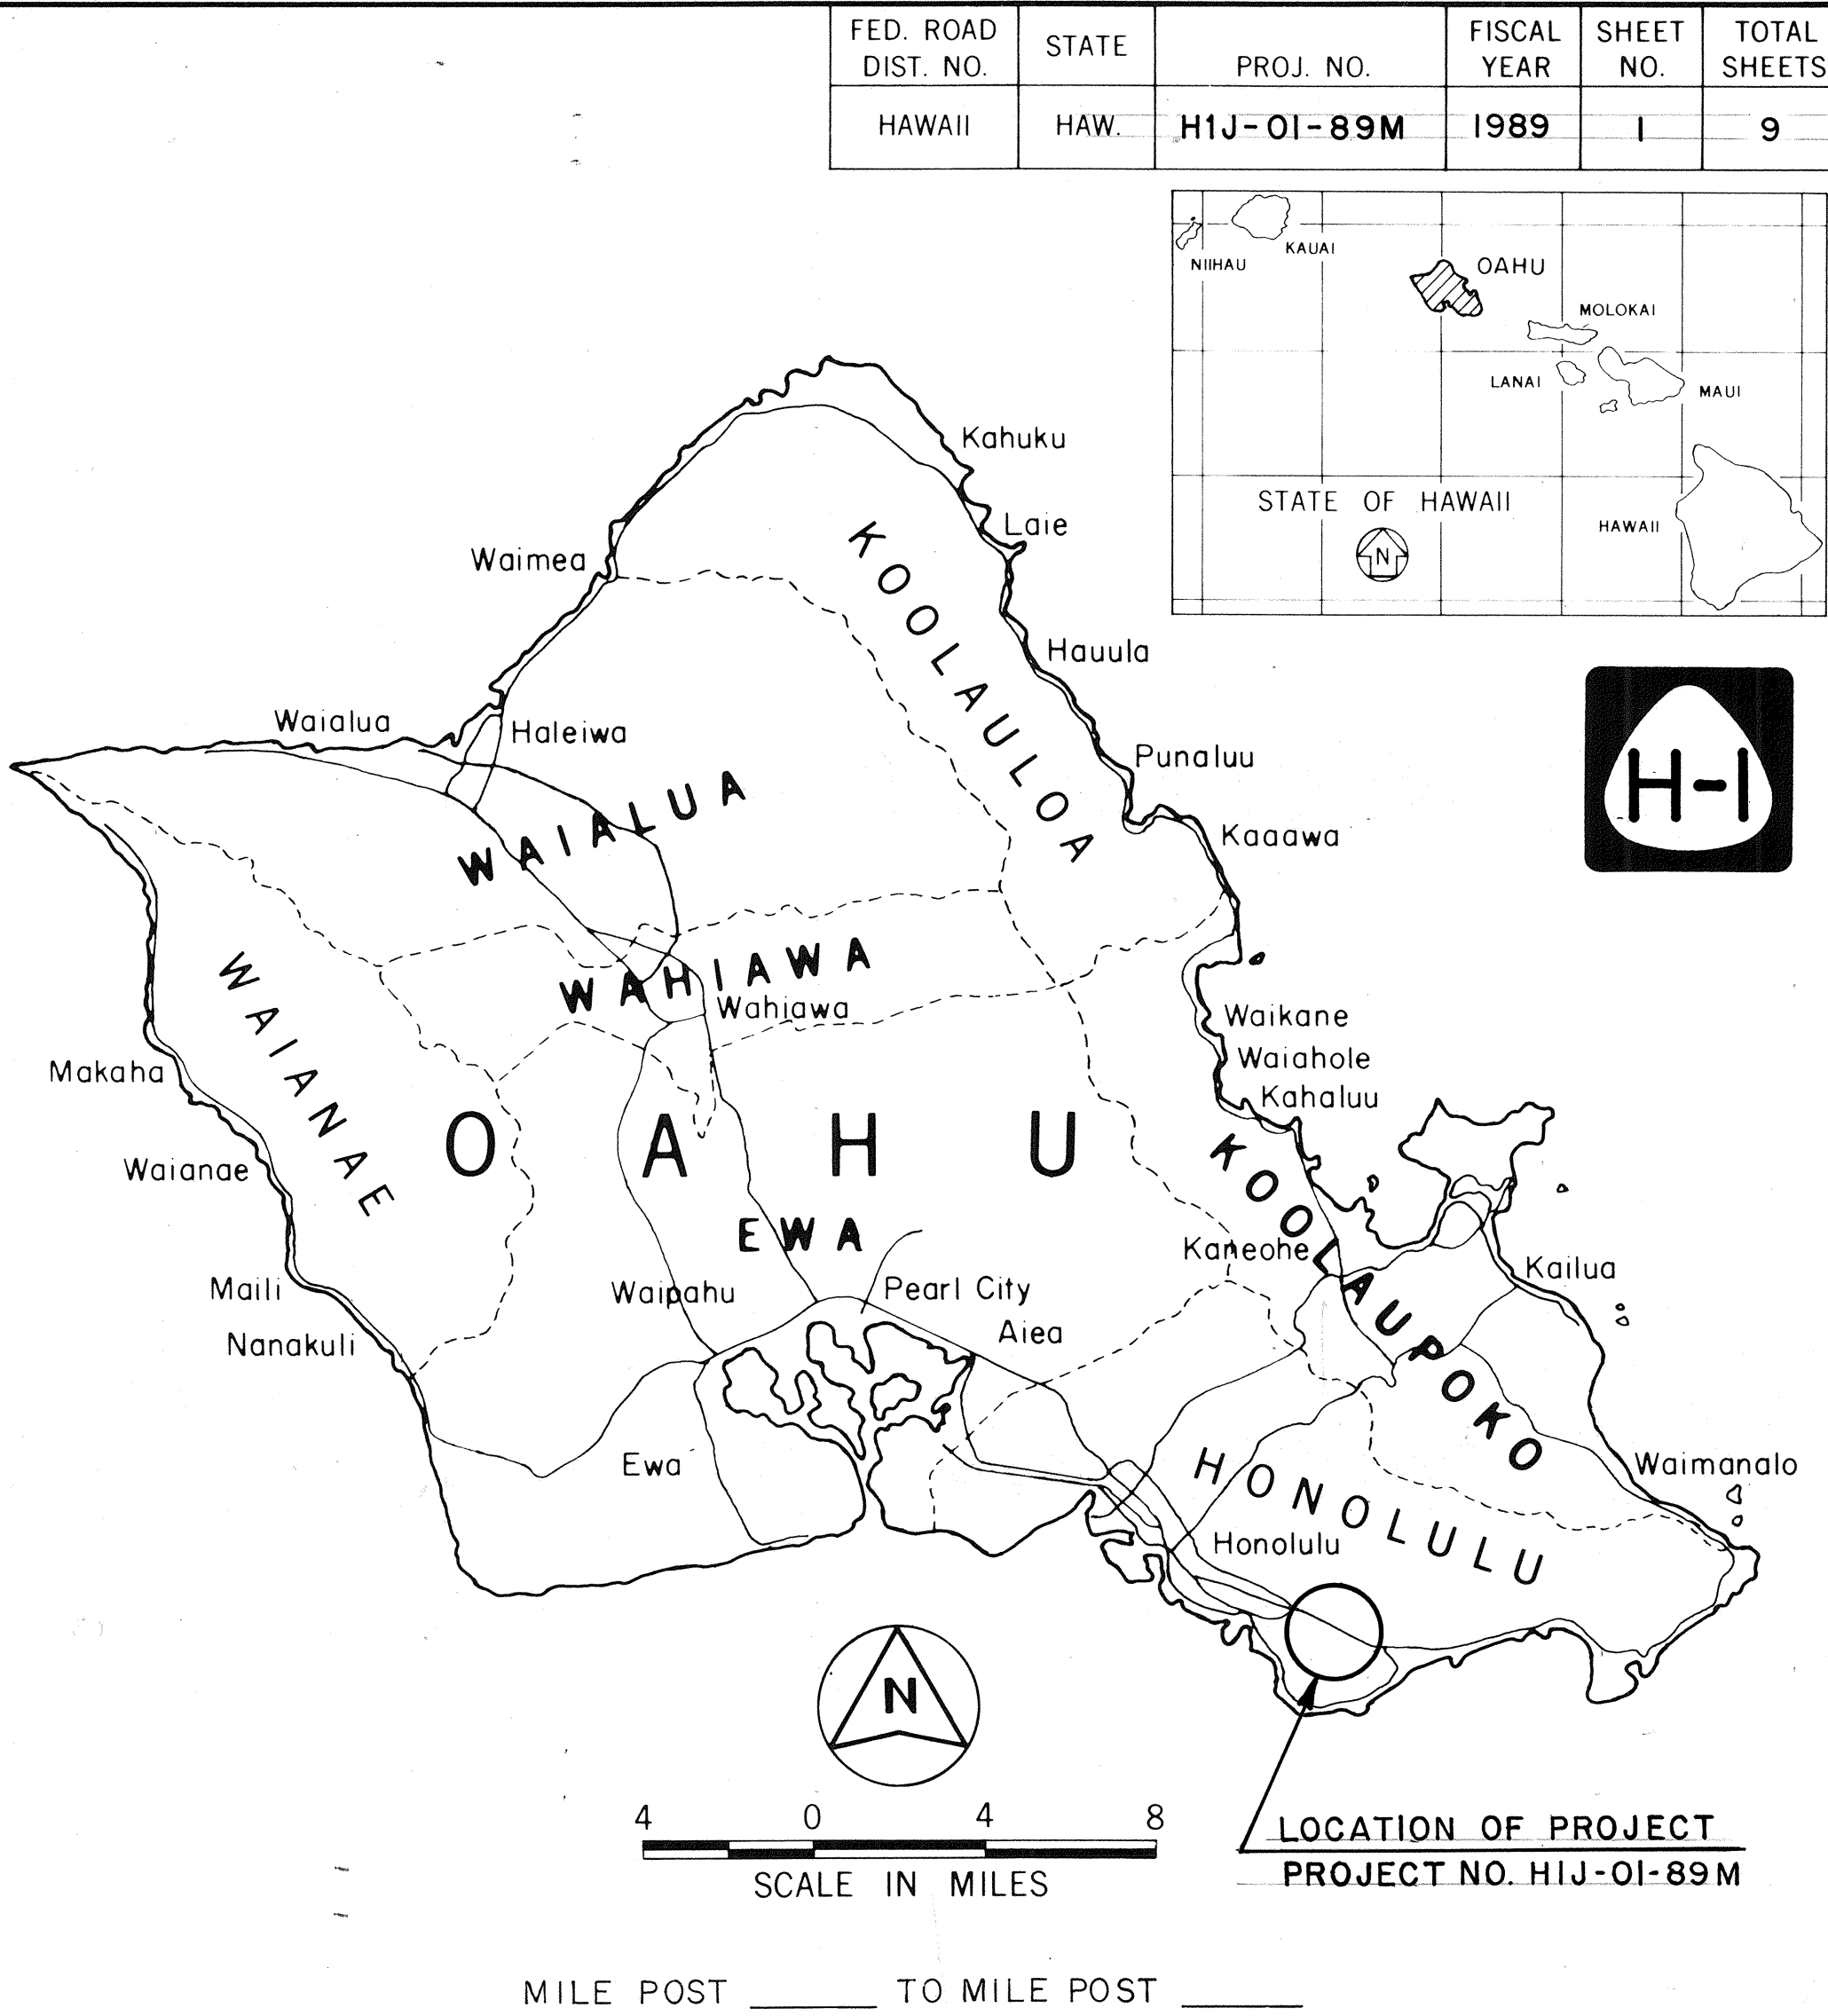

CHANGES MADE DURING CONSTRUCTION HAVE BEEN INCORPORATED ON THESE PLANS EXCEPT CHANGES IN THE ORIGINAL THEORETICAL QUANTITIES. FOR ACTUAL QUANTITIES, REFER TO PROJECT LEDGER AND/OR COMPUTATION BOOK.

Sidney S.C. Fu
RESIDENT ENGINEER
7/6/93
DATE

DEPARTMENT OF TRANSPORTATION
STATE OF HAWAII
APPROVED:
Edmund J. ... 5/19/89
DIR. OF TRANSPORTATION DATE

UNIT "C" DESIGNED BY J. KASAMOTO P. S. & E. BY 548-7537 PHONE APR. 1989 DATE

DD-C-6-6