


FED. ROAD DIST. NO.	STATE	FED. AID PROJ. NO.	FISCAL YEAR	SHEET NO.	TOTAL SHEETS
HAWAII	HAW.	HIC-01-90	1991	52	109

FOR PAIWA STREET EXTENSION
SIGNING AND STRIPING PLAN
SEE SHEET 51

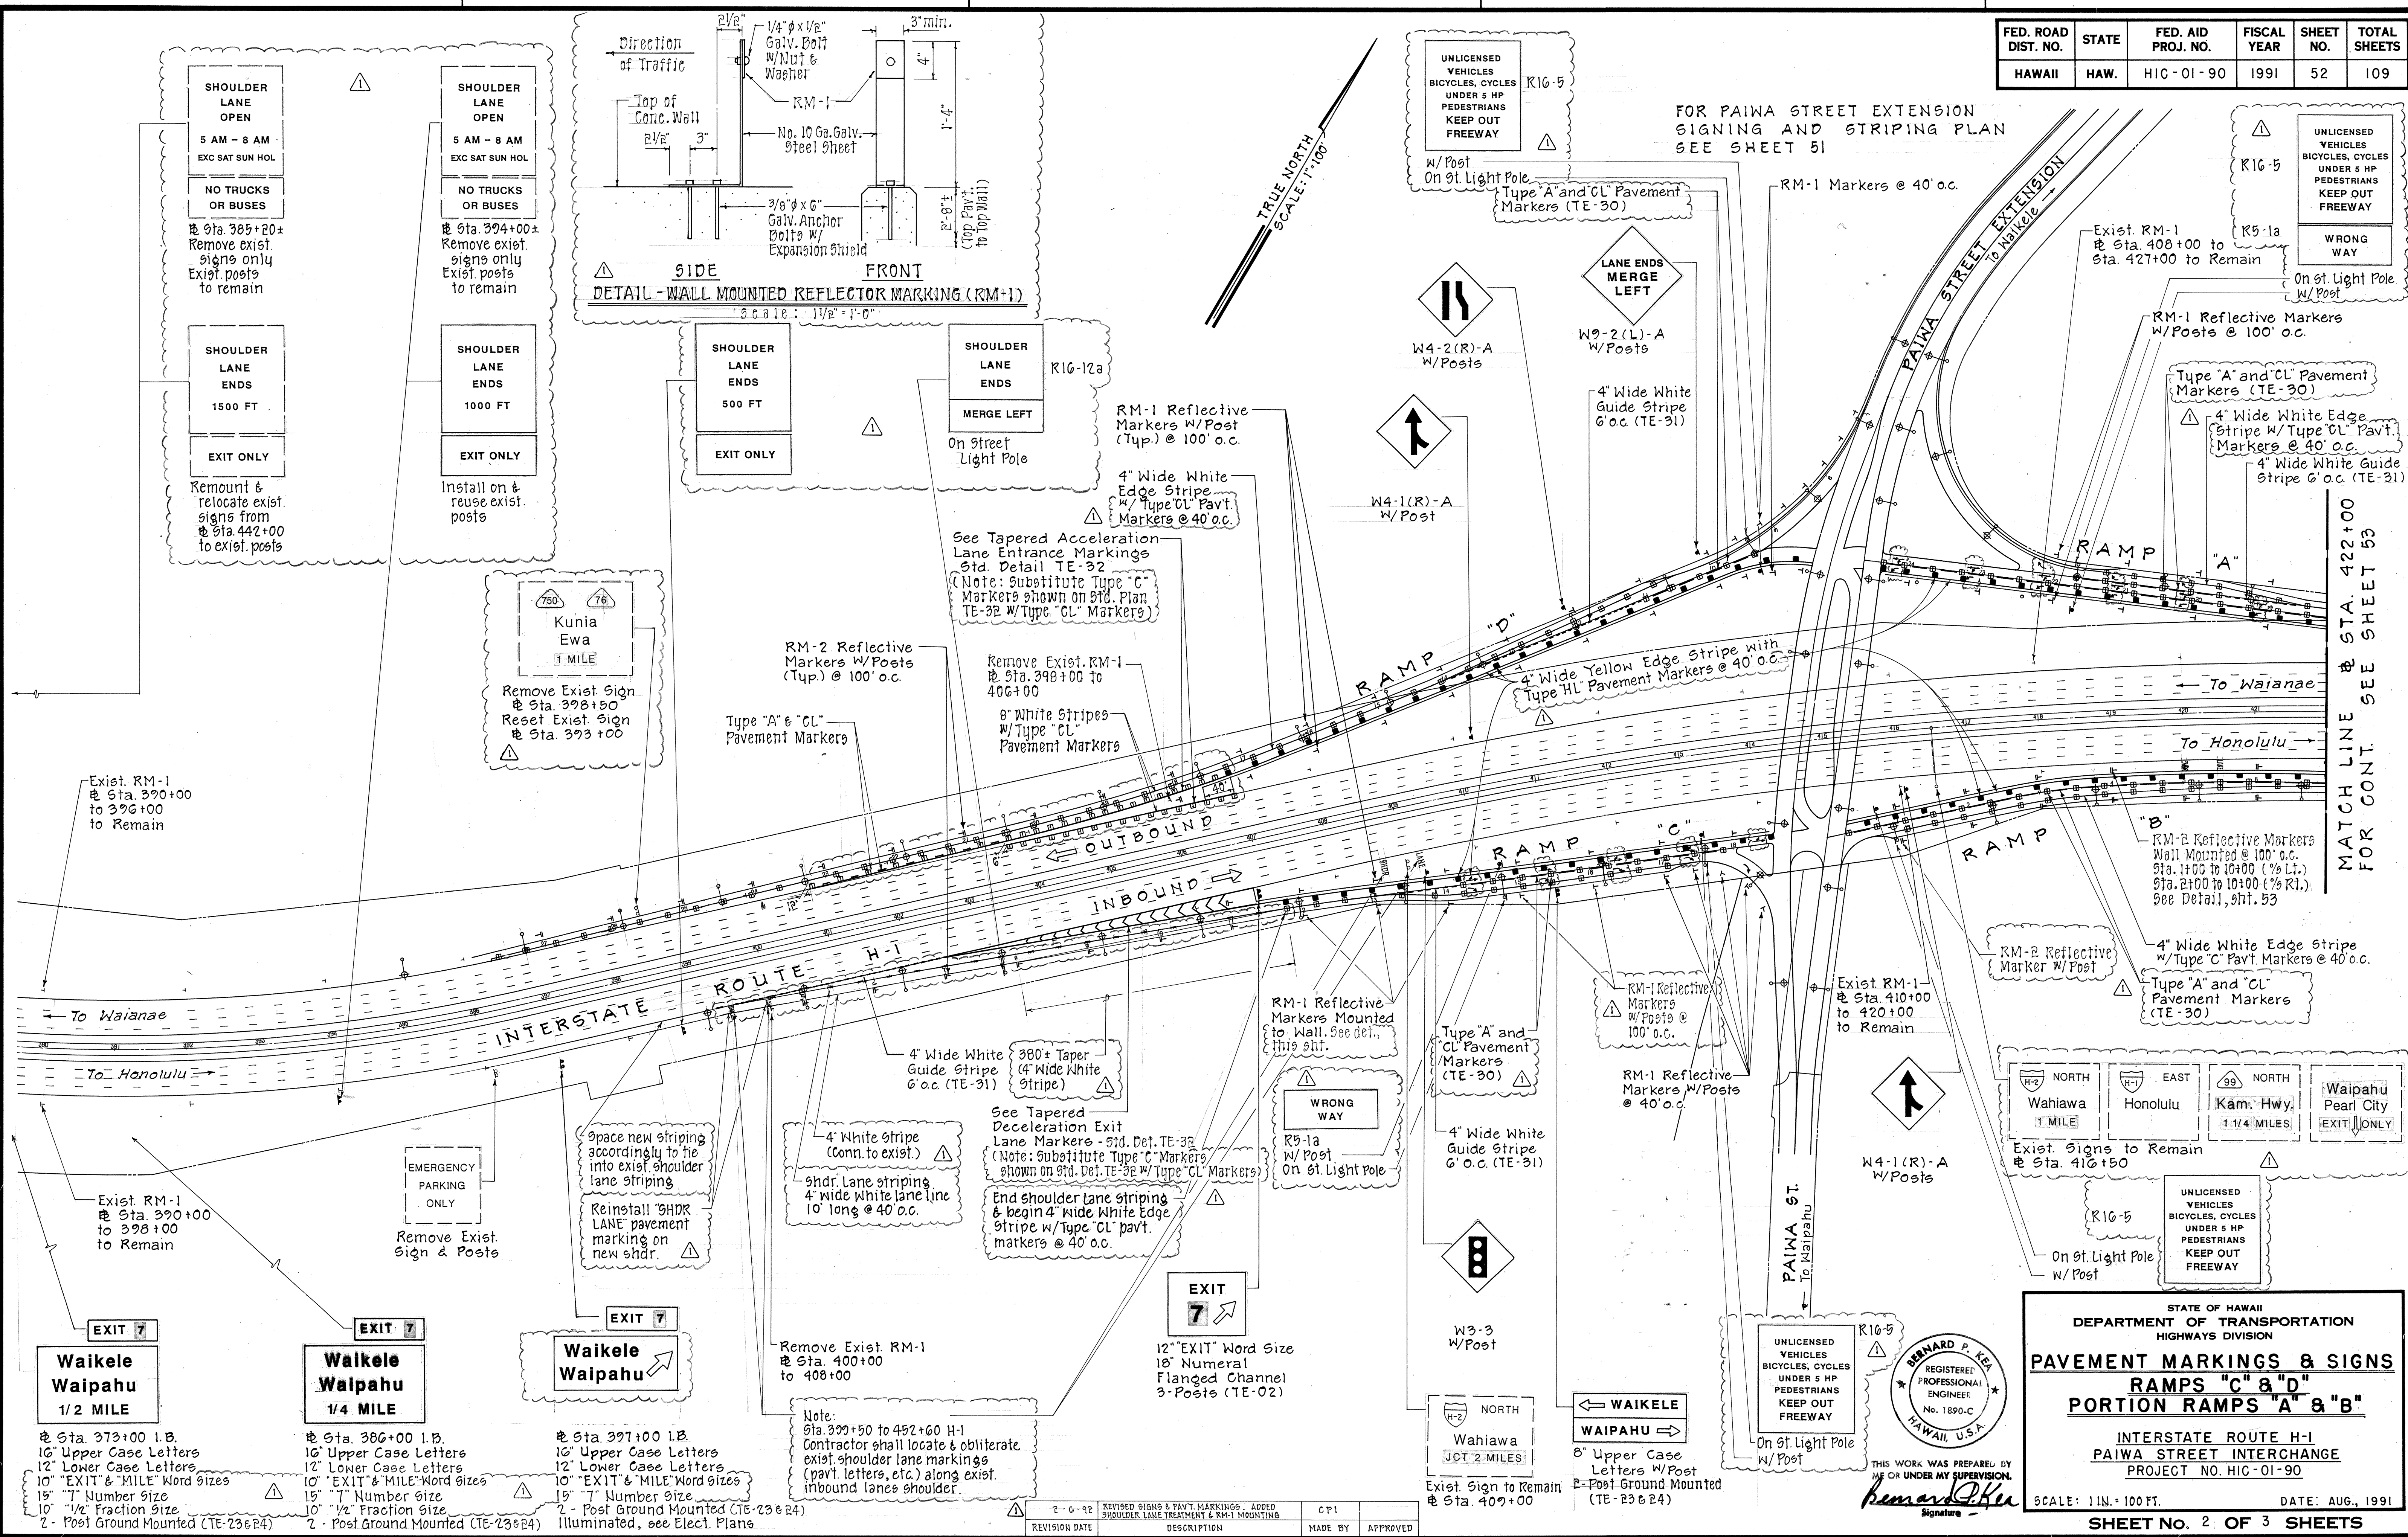

DATE	DESIGNED BY	CHECKED BY
PLANNED BY	TRACED BY	QUANTITIES BY
NO.	NO.	NO.

STATE OF HAWAII
DEPARTMENT OF TRANSPORTATION
HIGHWAYS DIVISION

PAVEMENT MARKINGS & SIGNS
RAMP "C" & "D"
PORTION RAMP "A" & "B"


INTERSTATE ROUTE H-1
PAIWA STREET INTERCHANGE
PROJECT NO. HIC-01-90

SCALE: 1 IN. = 100 FT. DATE: AUG., 1991
SHEET NO. 2 OF 3 SHEETS

52



REVISION	DATE	DESCRIPTION	MADE BY	APPROVED
2	6-92	REVISED SIGNS & PAVT. MARKINGS, ADDED SHOULDER LANE TREATMENT & RM-1 MOUNTING	CP1	

FED. ROAD DIST. NO.	STATE	FED. AID PROJ. NO.	FISCAL YEAR	SHEET NO.	TOTAL SHEETS
HAWAII	HAW.	HIC-01-90	1991	53	109

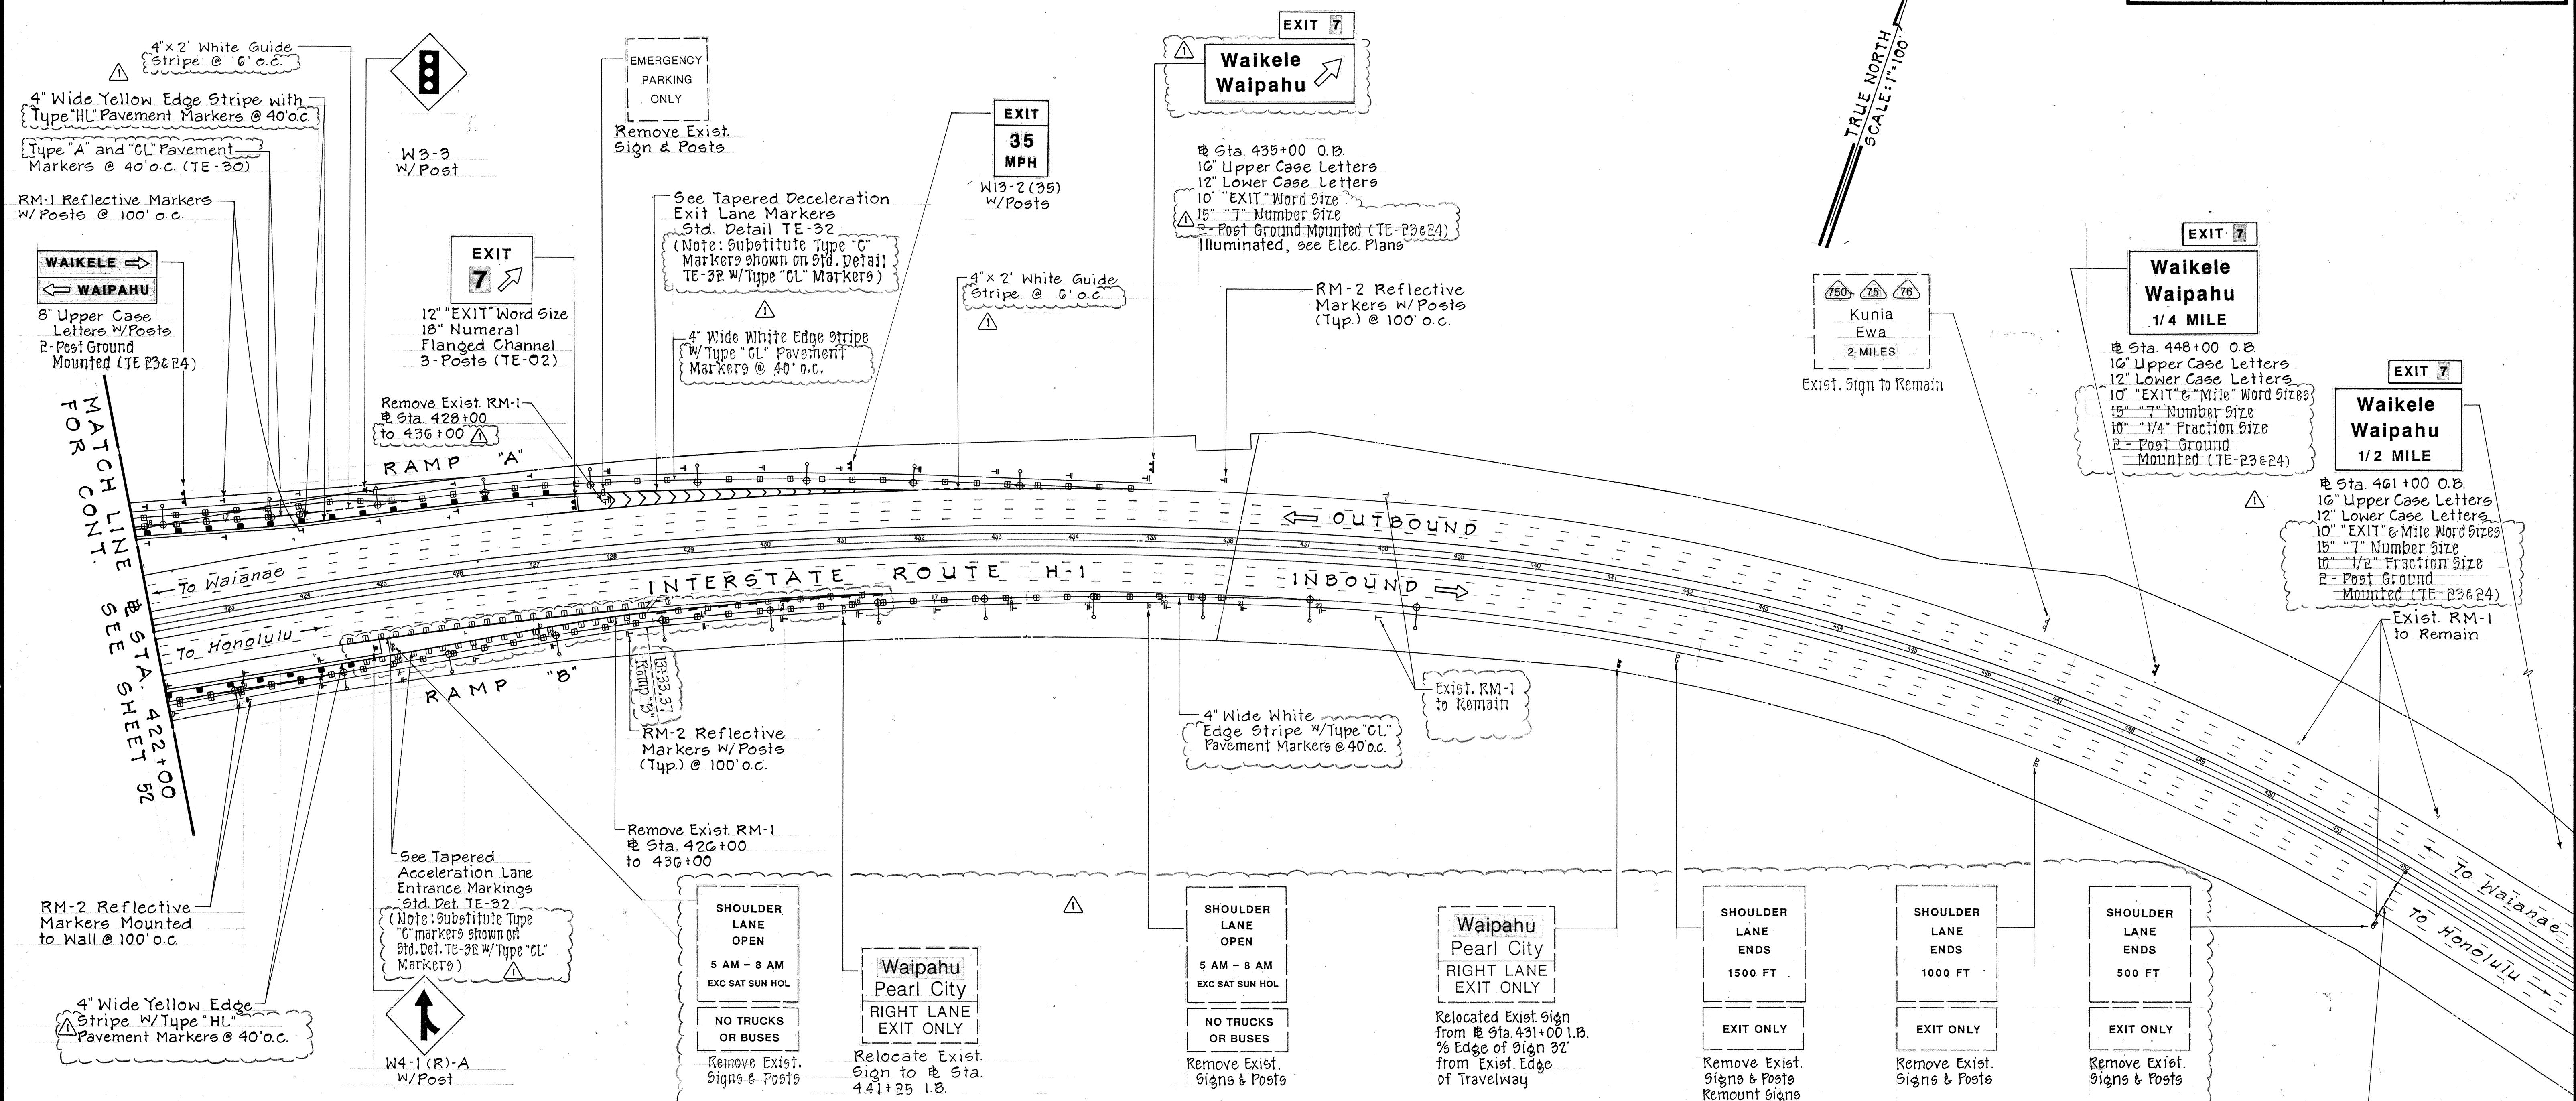

DATE	DESIGNED BY	CHECKED BY
NO.	NO.	NO.

Note:
Sta. 399+50 to 452+60 H-1
Contractor shall locate & obliterate
exist. shoulder lane markings
(pavement letters, etc.) along exist.
inbound lanes shoulder & from
0+00 to 9+00 exist. Ramp "D"
(Pearl City off-ramp)

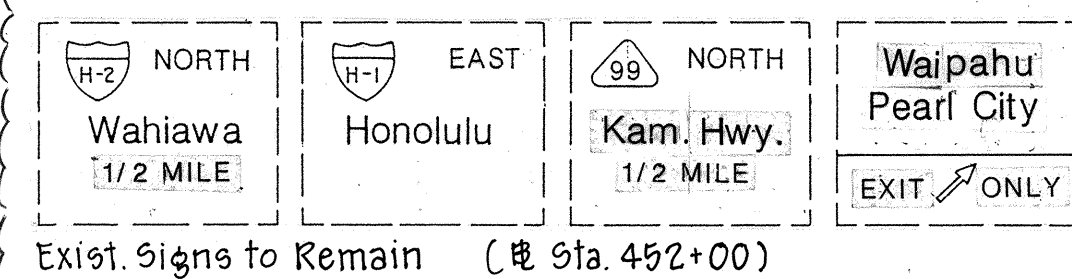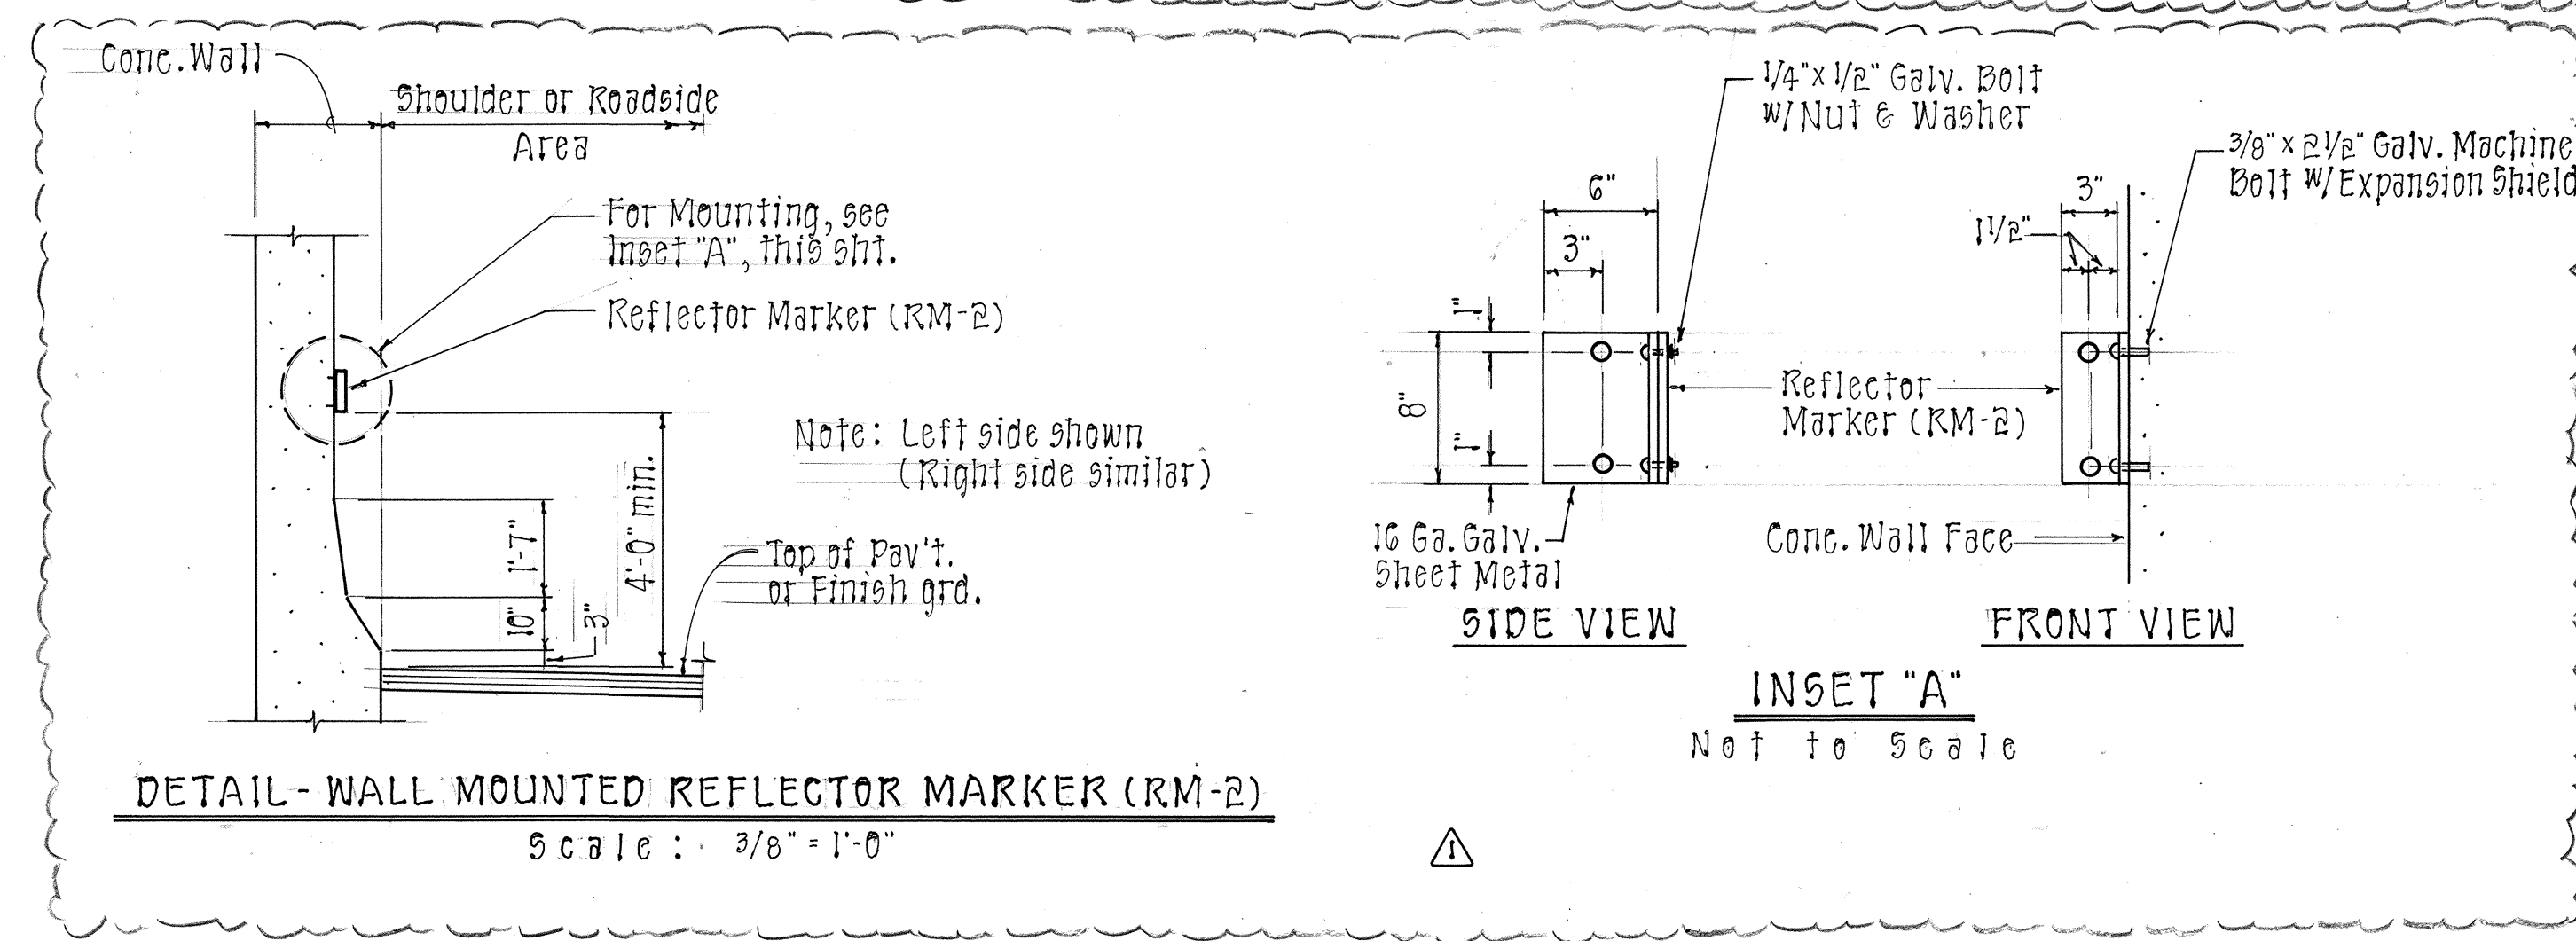

THIS WORK WAS PREPARED BY
ME OR UNDER MY SUPERVISION.
Bernard P. Kea
REGISTERED PROFESSIONAL ENGINEER
No. 1890-C
HAWAII, U.S.A.

2-G-98	REVISION DATE	DESCRIPTION	MADE BY	APPROVED
STATE OF HAWAII DEPARTMENT OF TRANSPORTATION HIGHWAYS DIVISION PAVEMENT MARKINGS & SIGNS RAMPS "A" & "B" INTERSTATE ROUTE H-1 PAIWA STREET INTERCHANGE PROJECT NO. HIC-01-90 SCALE: 1/4" = 100 FT. DATE: AUG., 1991 SHEET NO. 3 OF 3 SHEETS				