



FED. ROAD DIST. NO.	STATE	FED. AID PROJ. NO.	FISCAL YEAR	SHEET NO.	TOTAL SHEETS
HAWAII	HAW.	HIC-01-90	1991	5	109

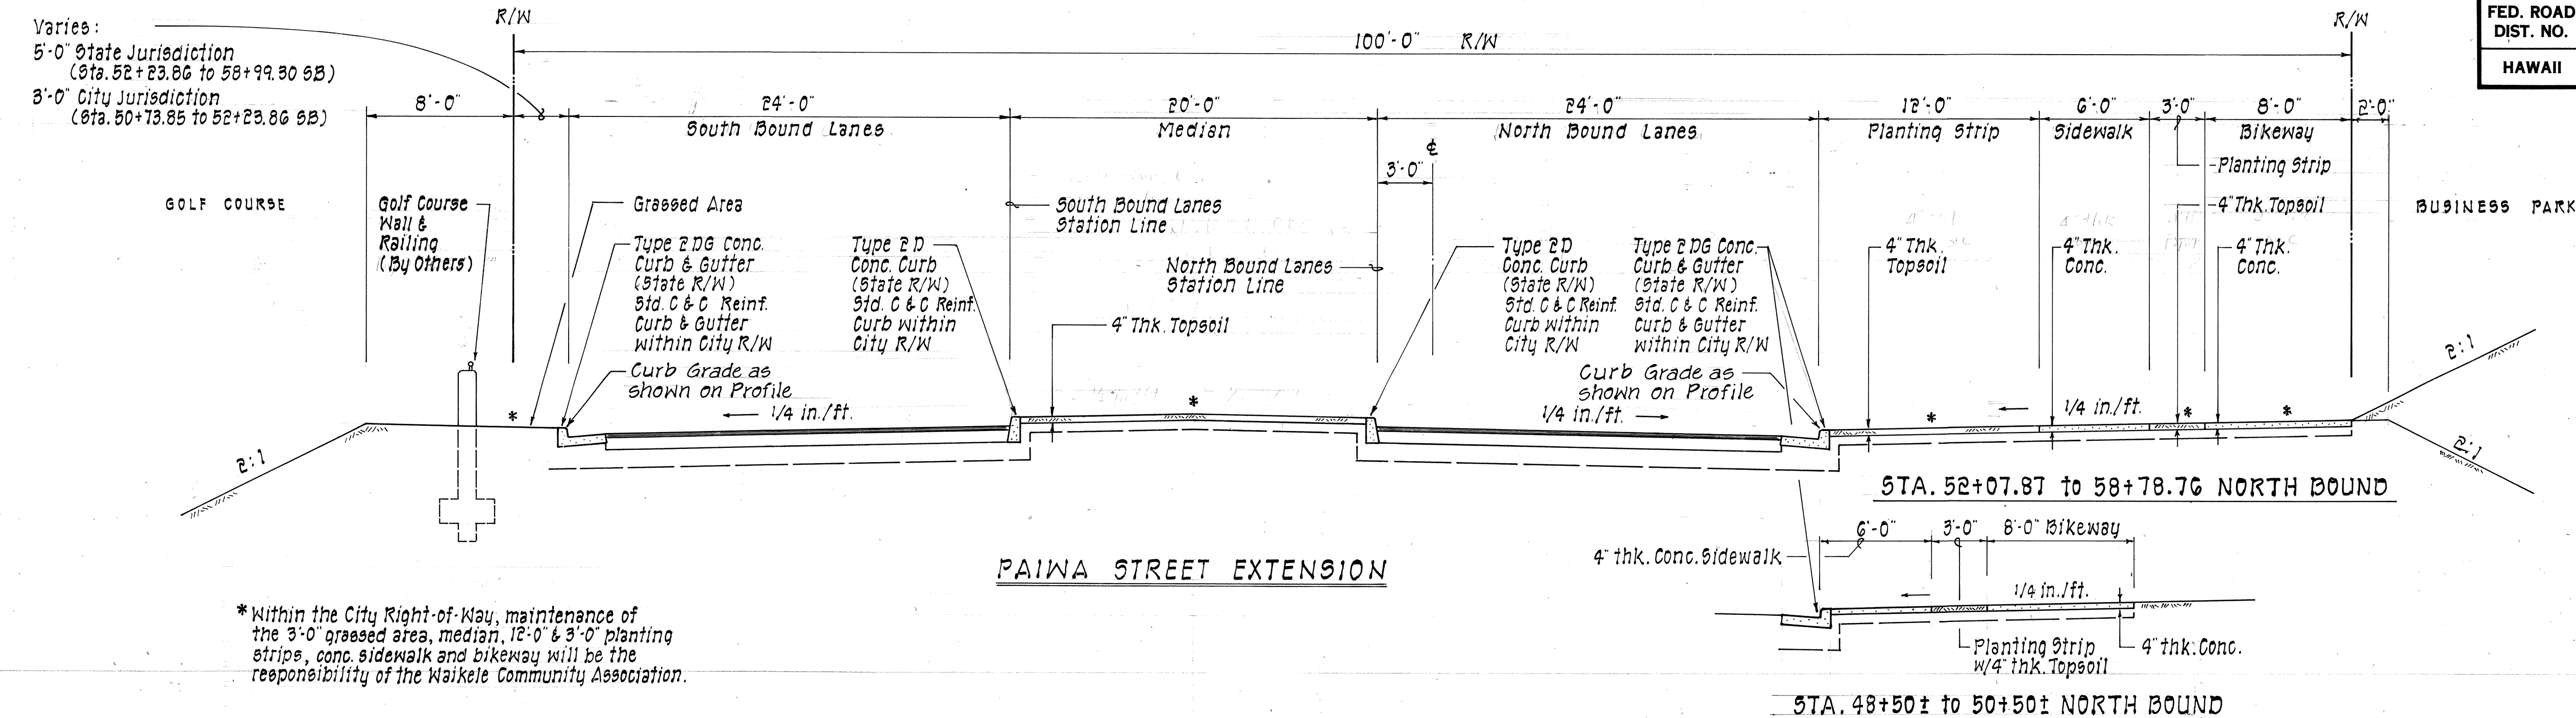


PAVEMENT SECTION
 State R/W
 4" A.C. Pavement, Mix No. IV
 8" Asphalt Concrete Base (ACB)
 12" Aggregate Subbase (shown)

CITY R/W
 2 1/2" A.C. Pavement
 6" Aggregate Base Course
 18" Select Borrow Subbase unless Soil Test Data indicates otherwise

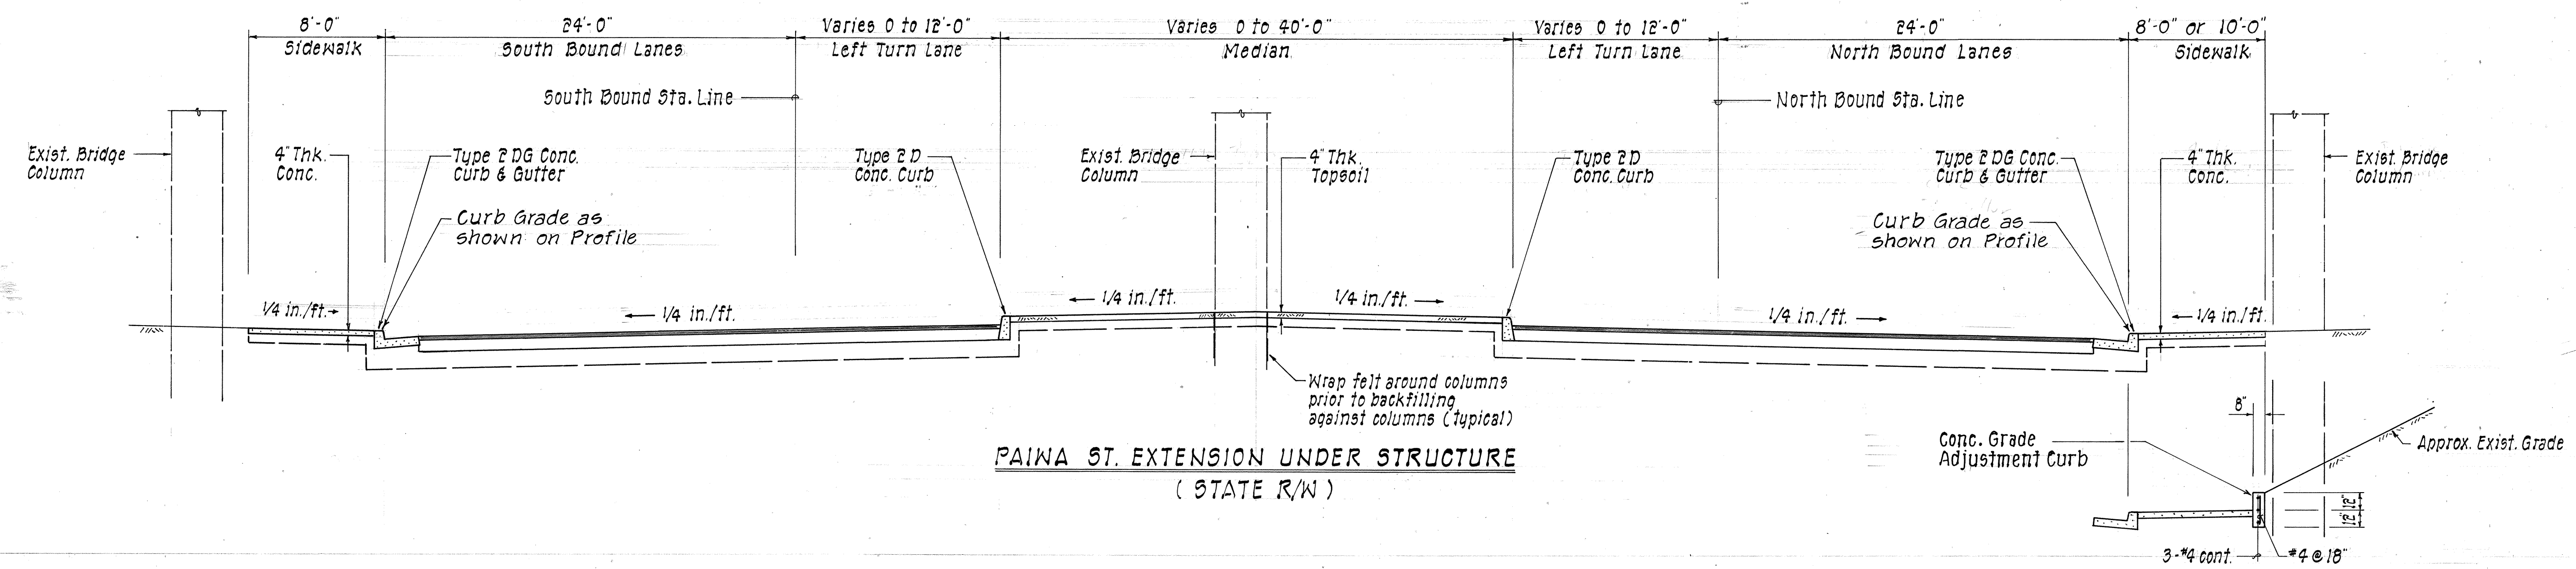


PAVEMENT SECTION (State R/W)
 4" A.C. Pavement, Mix No. IV
 8" Asphalt Concrete Base (ACB)
 12" Aggregate Subbase (shown)

GRADE ADJUSTMENT CURB
 STA. 44+75± to 46+80 (NORTH BOUND)

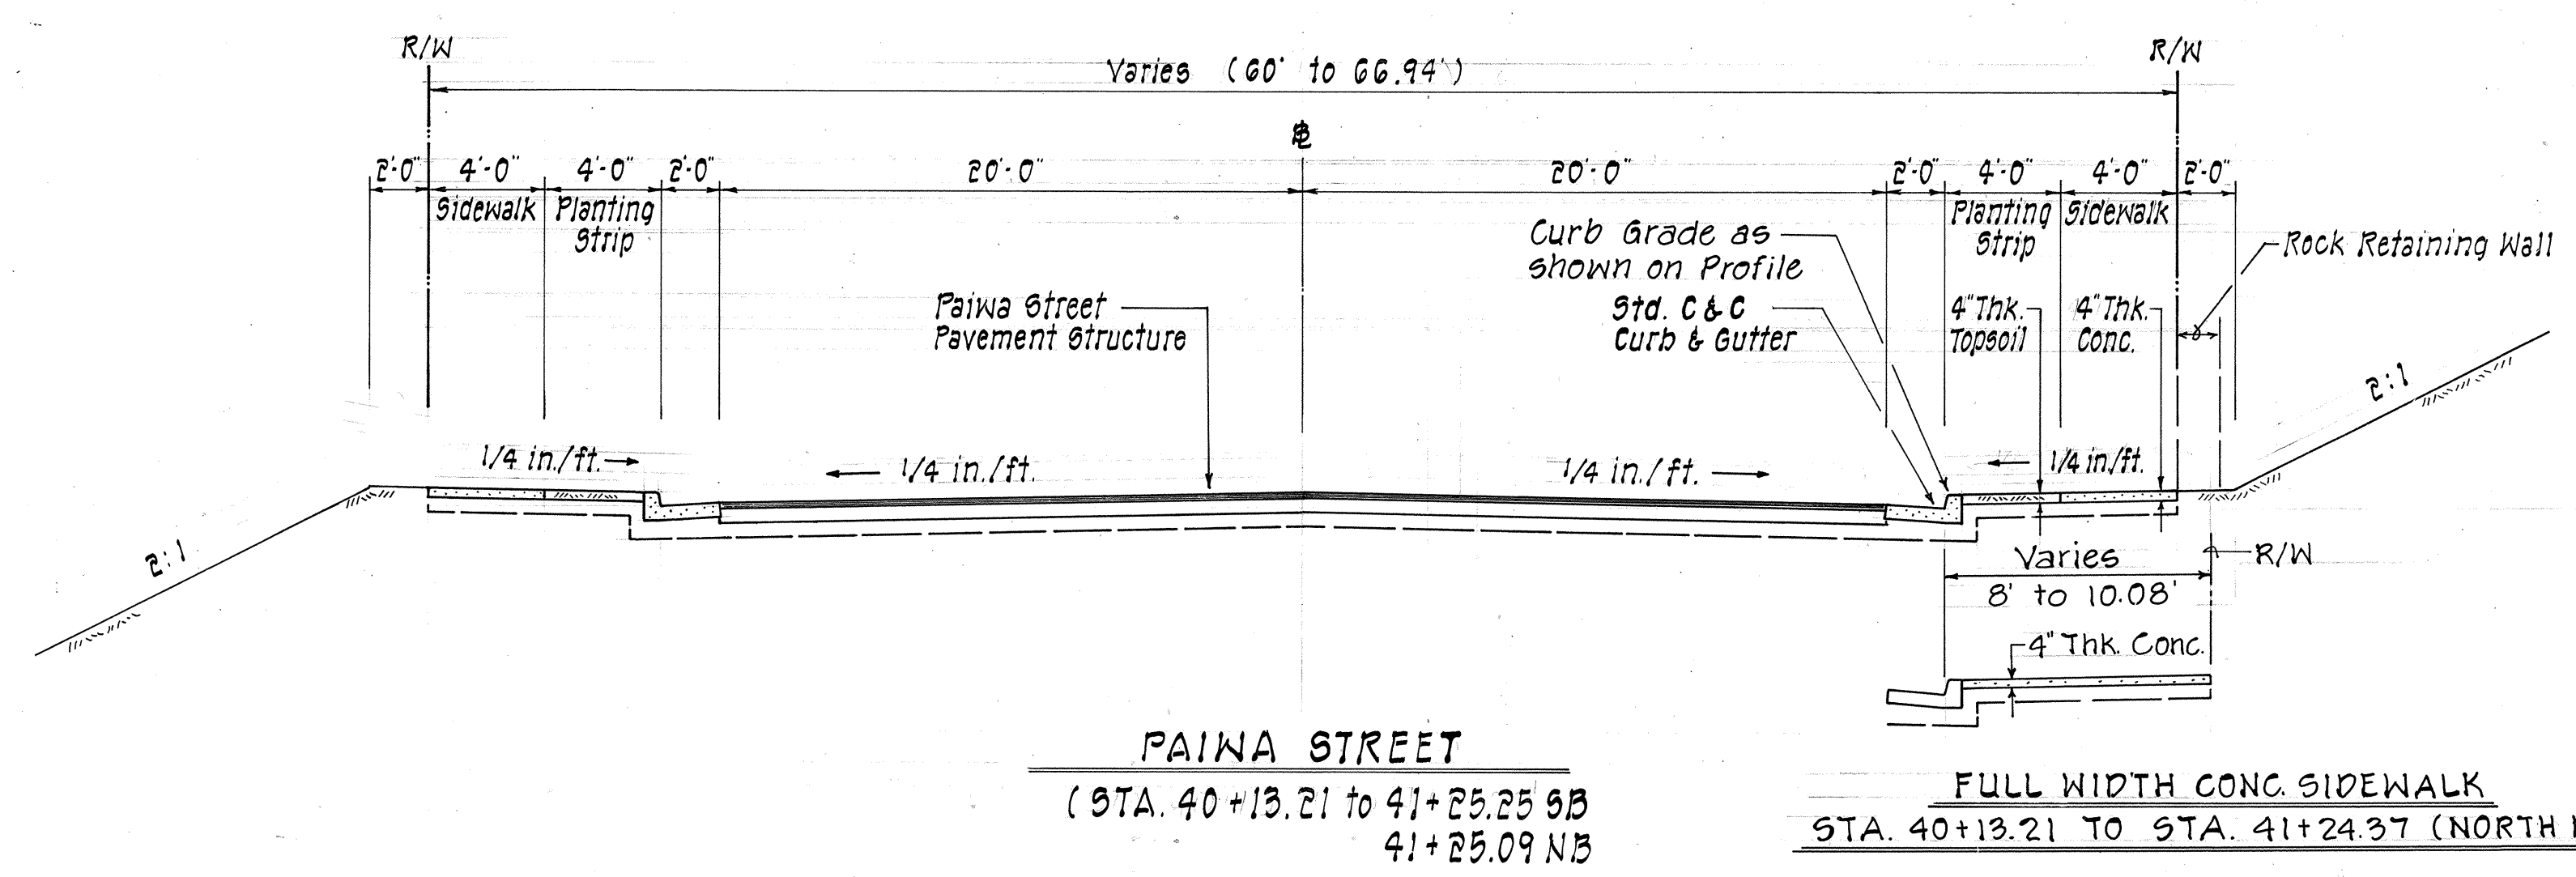

PAIWA ST. PAVEMENT SECTION
 2 1/2" min. A.C. Pavement
 6" min. Base Course
 6" min. Select Borrow Subbase
 or
 Match Existing Section
 Whichever is greater

APPROVED: *M. Fukagawa* 9/9/91
 CHIEF, DIVISION OF ENGINEERING, DPW
 (FOR CONSTRUCTION WITHIN CITY R/W ONLY)

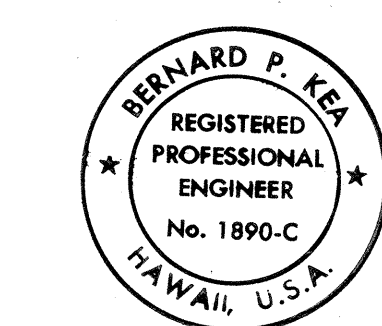

THIS WORK WAS PREPARED BY
 ME OR UNDER MY SUPERVISION
Bernard P. Lee
 Signature

STATE OF HAWAII
 DEPARTMENT OF TRANSPORTATION
 HIGHWAYS DIVISION












TYPICAL SECTIONS

INTERSTATE ROUTE H-1
 PAIWA STREET INTERCHANGE
 PROJECT NO. HIC-01-90

SCALE: 3/16" = 1'-0" DATE: AUG., 1991
 SHEET NO. 1 OF 3 SHEETS

DATE	DESIGNED BY	CHECKED BY
PLANNED BY	TRACED BY	DESIGNED BY
NOTE BOOK	QUANTITIES BY	CHECKED BY
No.		

FED. ROAD DIST. NO.	STATE	FED. AID PROJ. NO.	FISCAL YEAR	SHEET NO.	TOTAL SHEETS
HAWAII	HAW.	HIC-01-90	1991	6	109

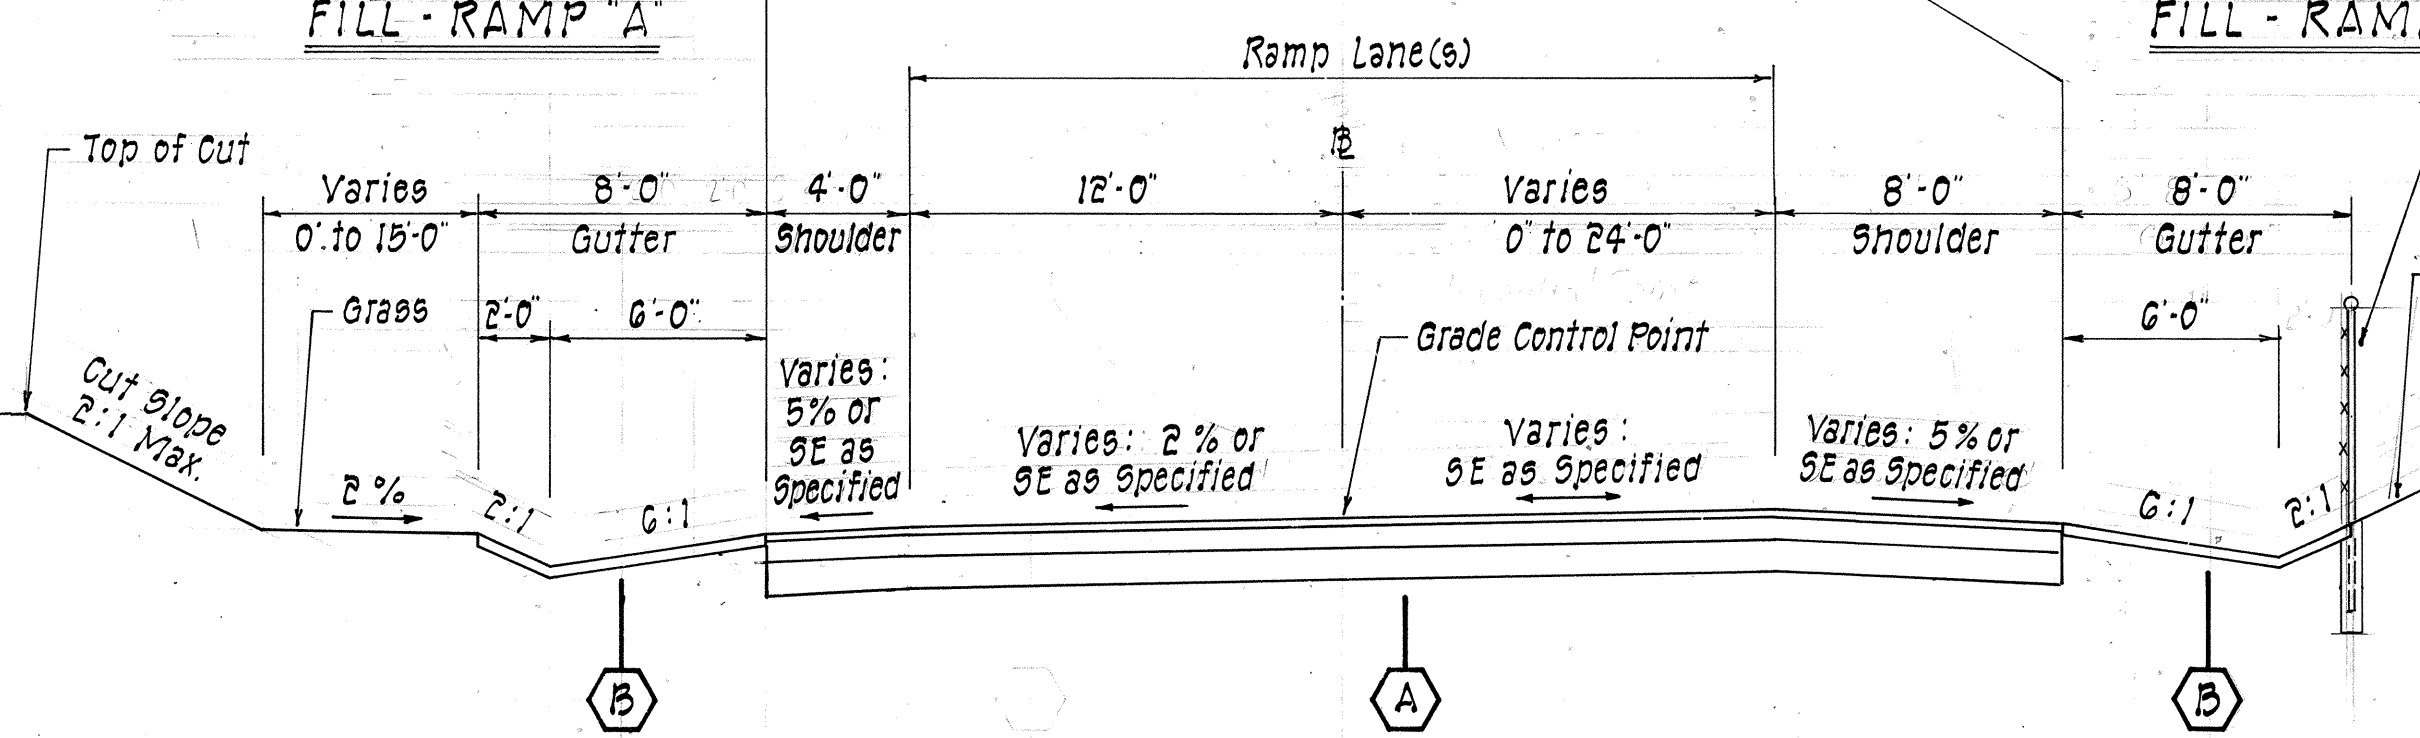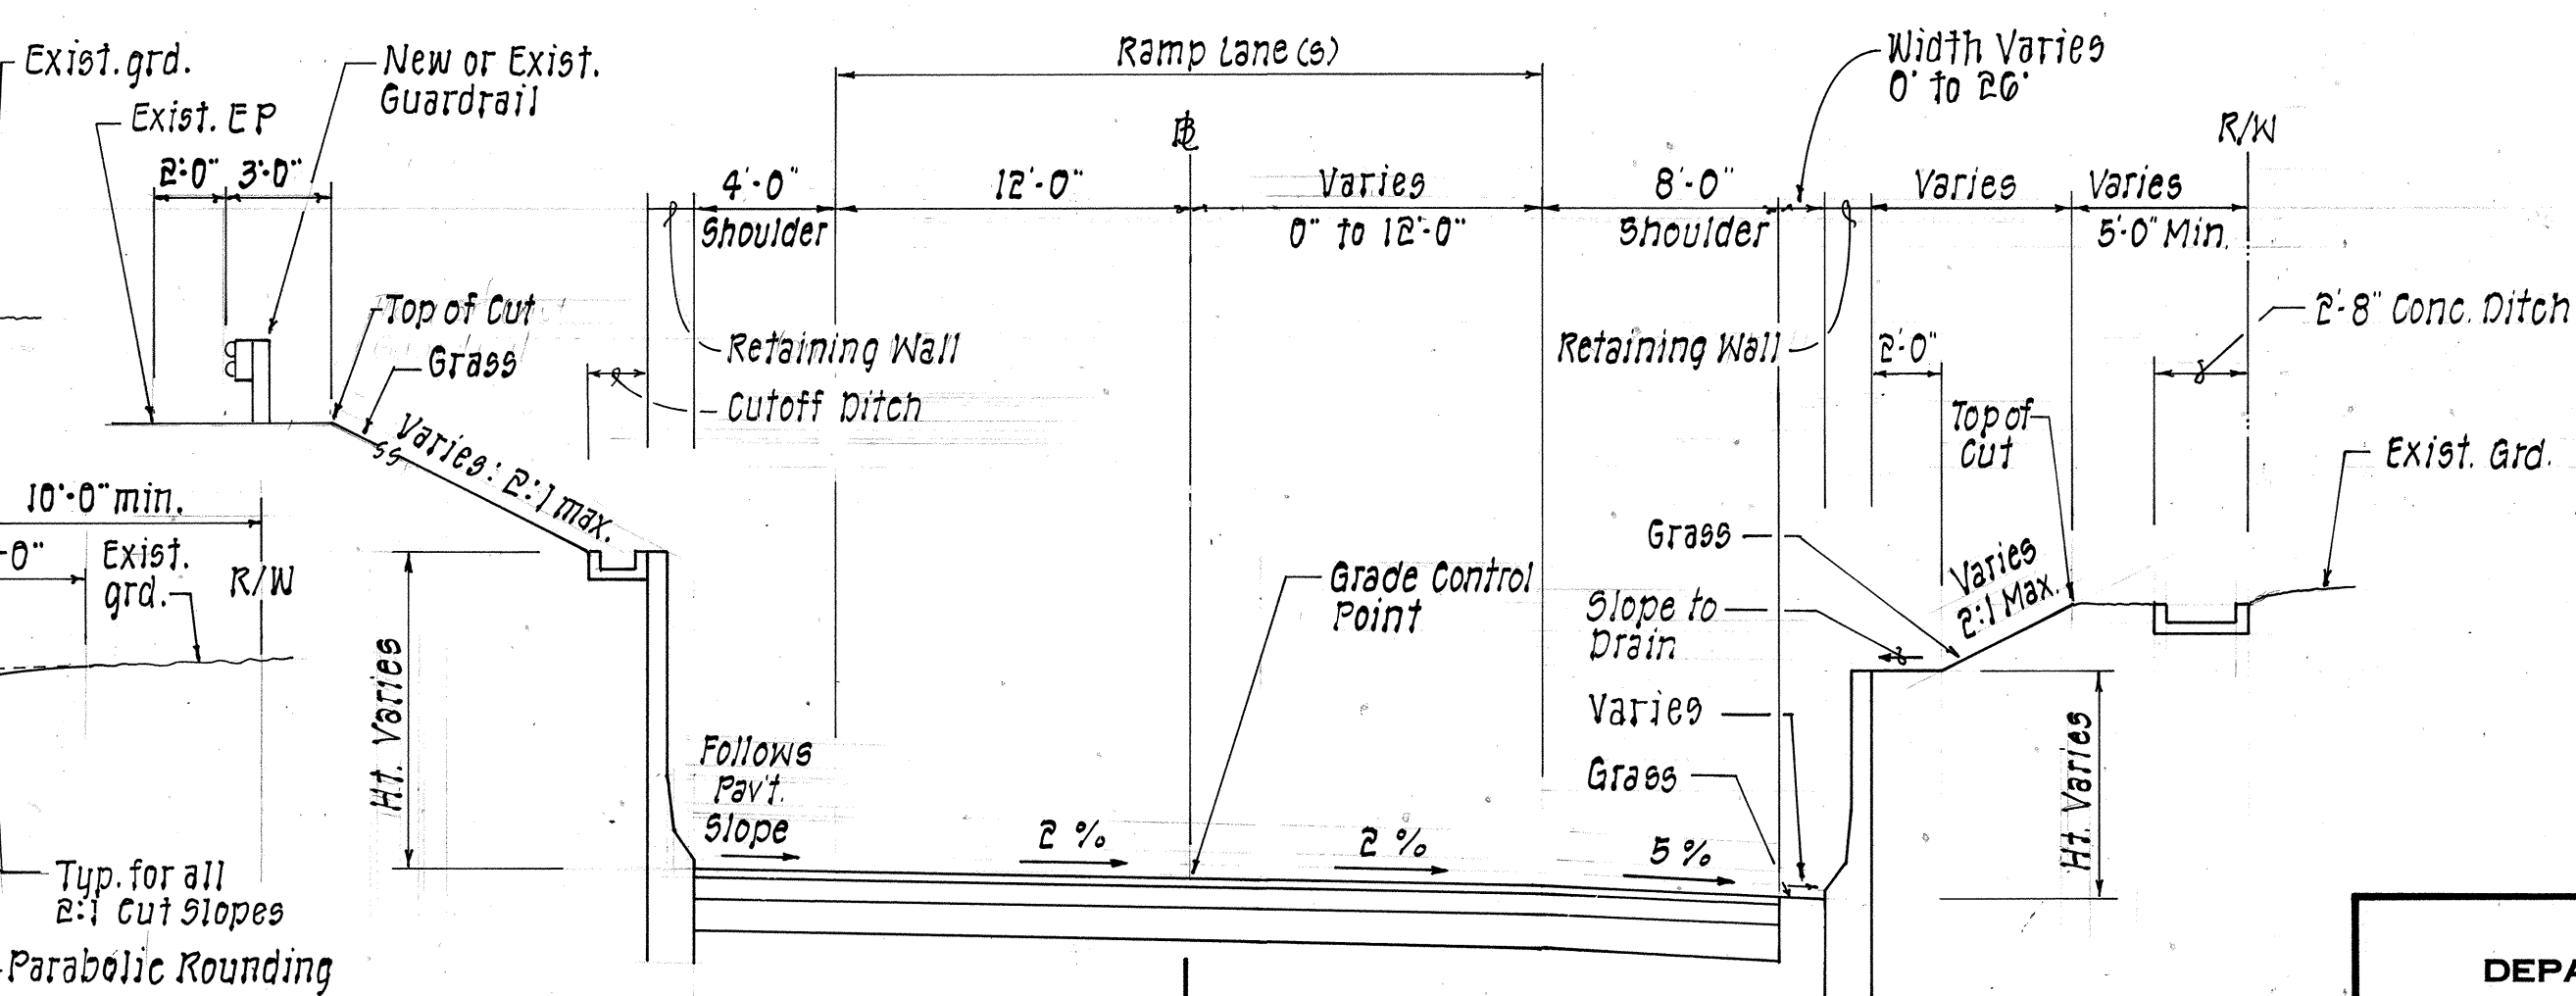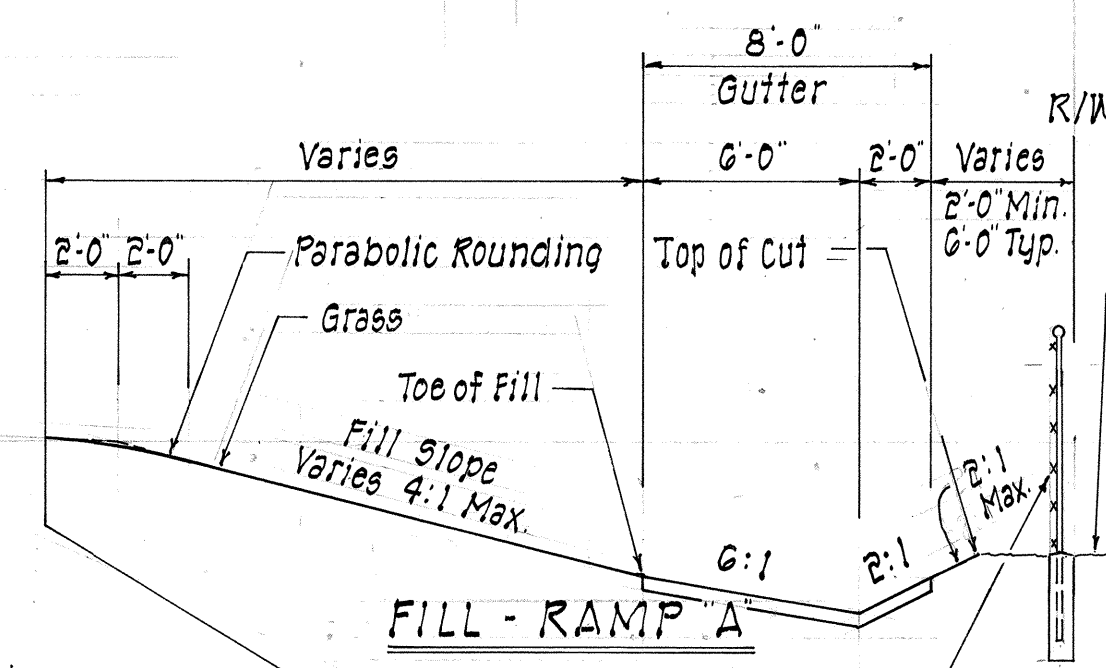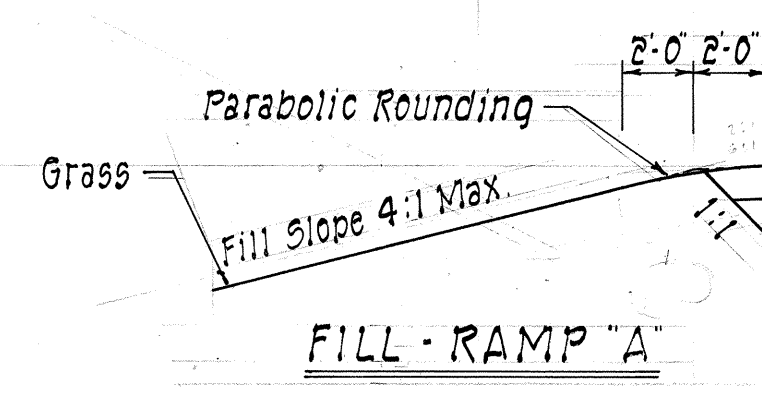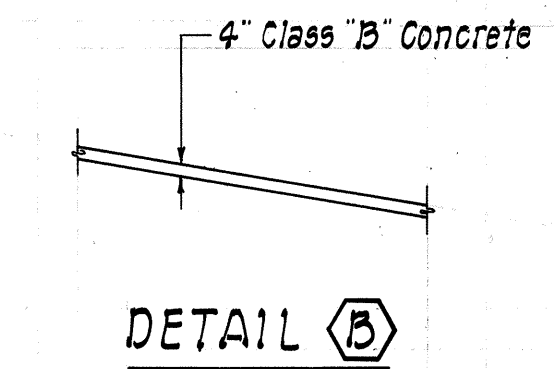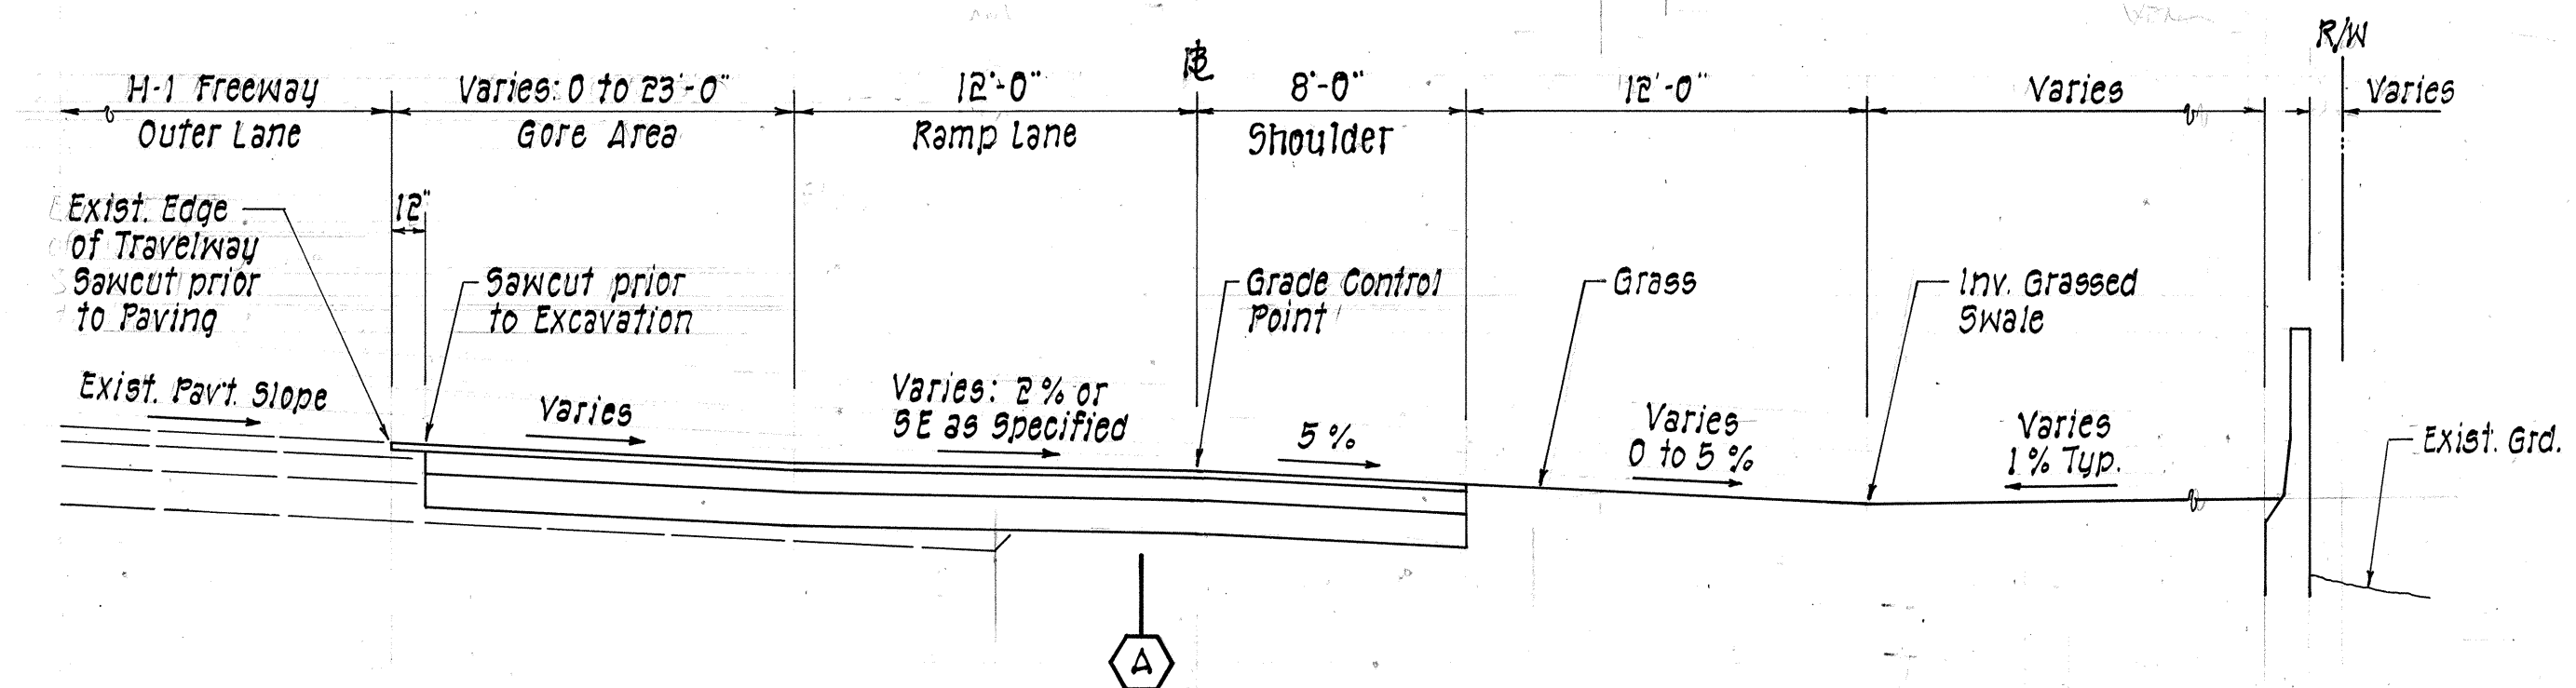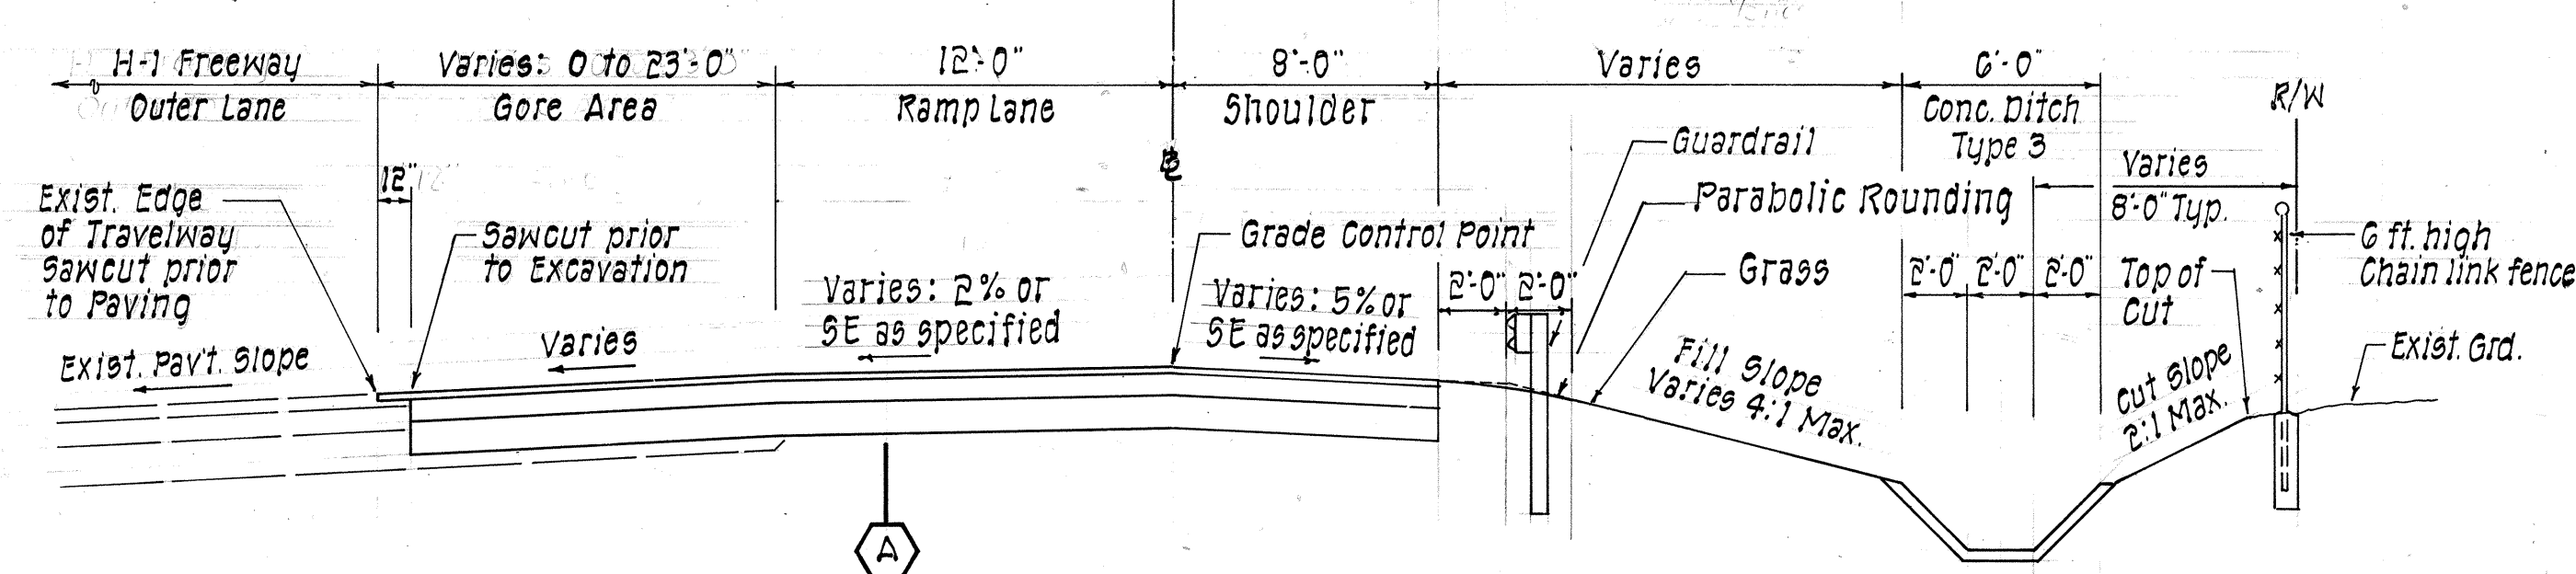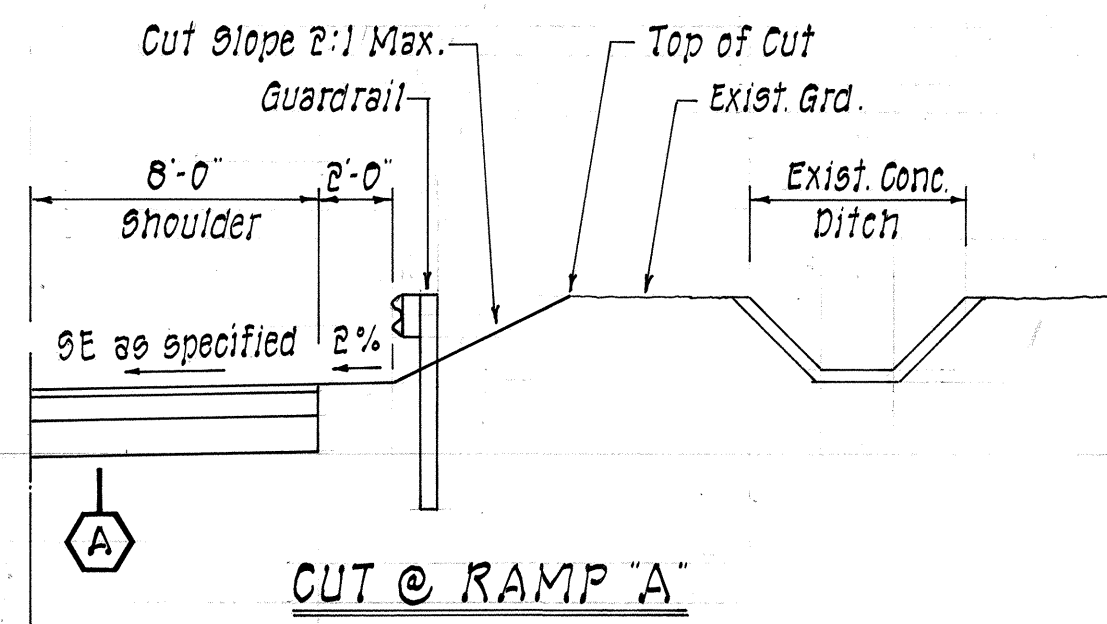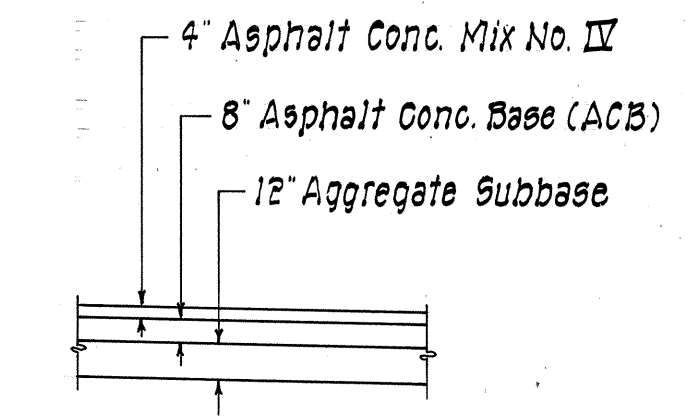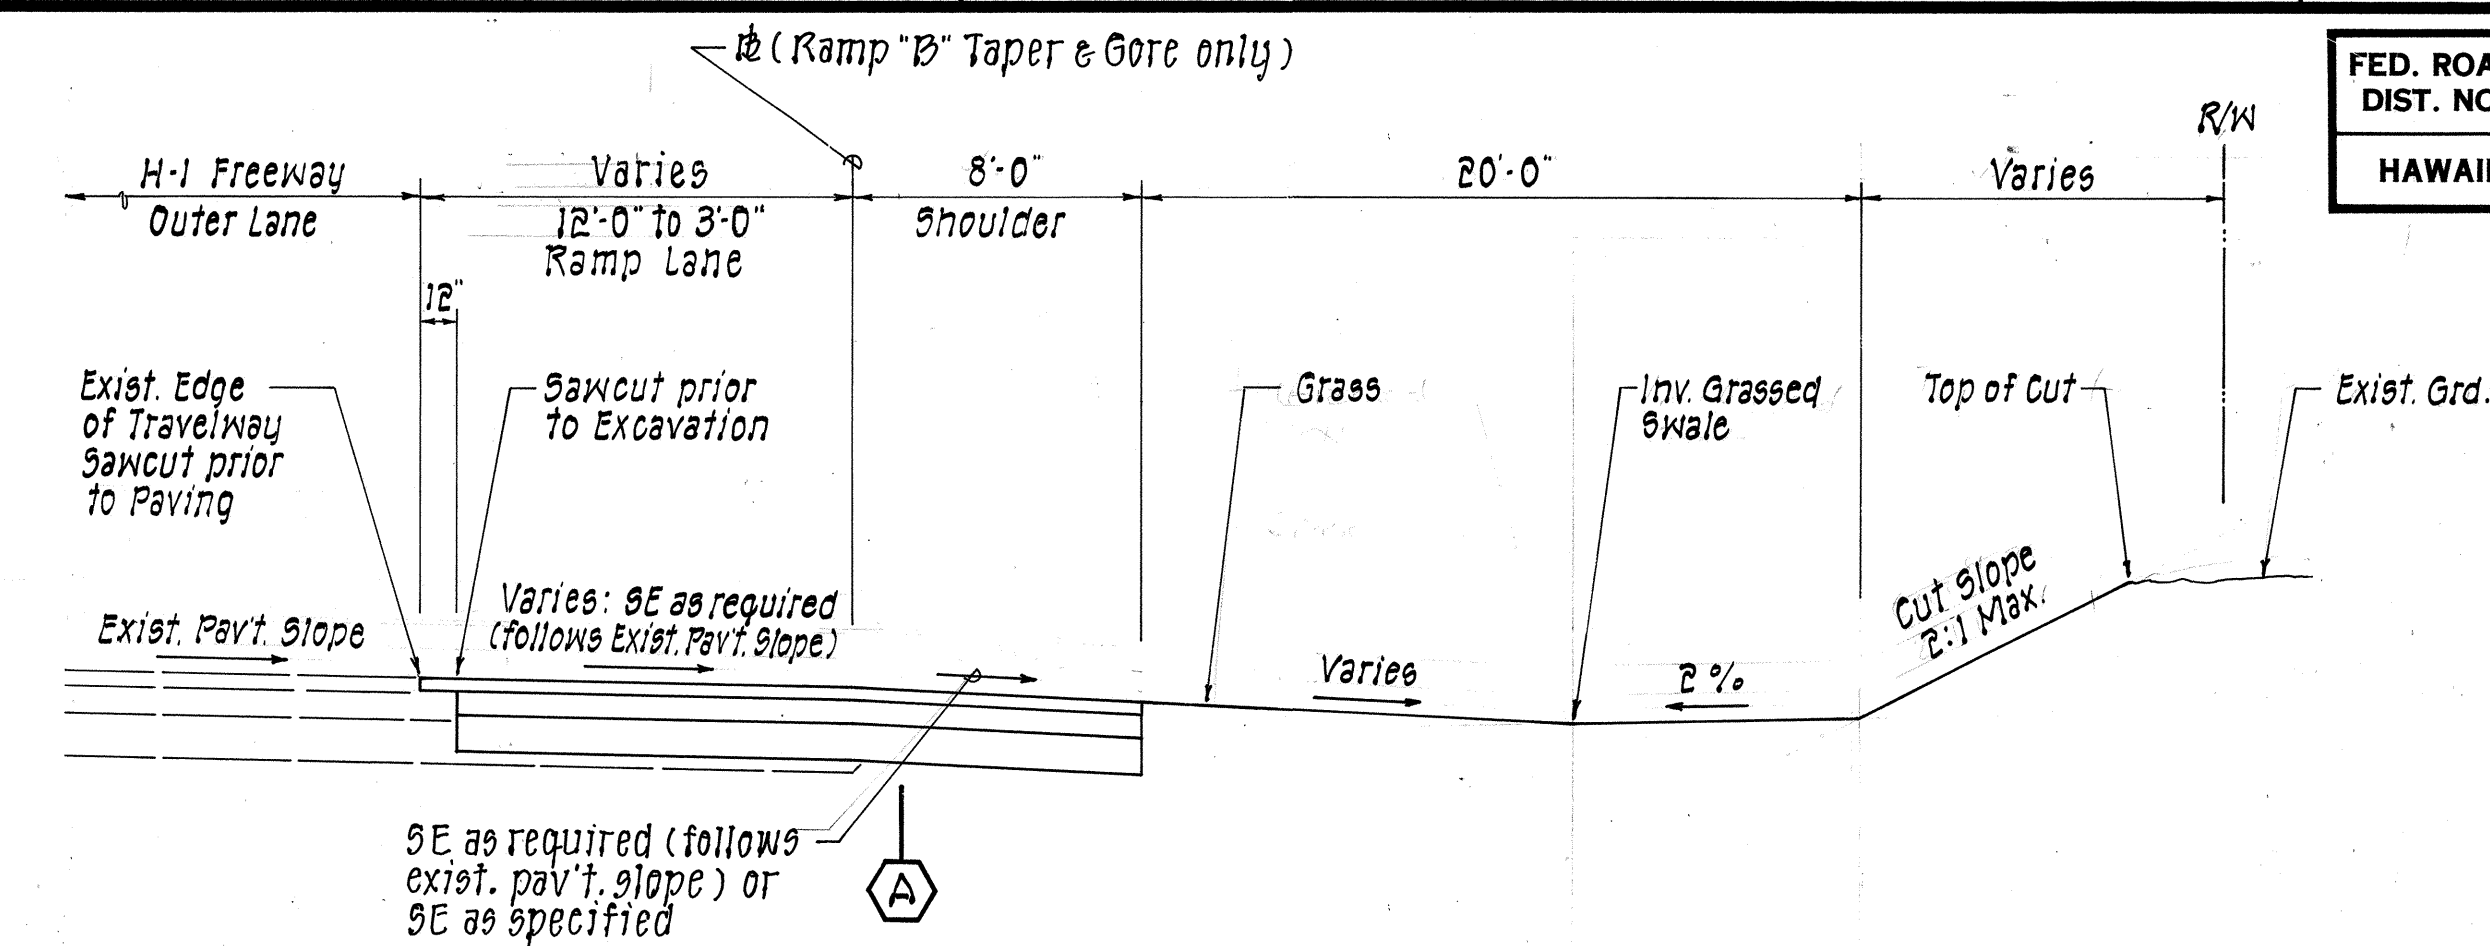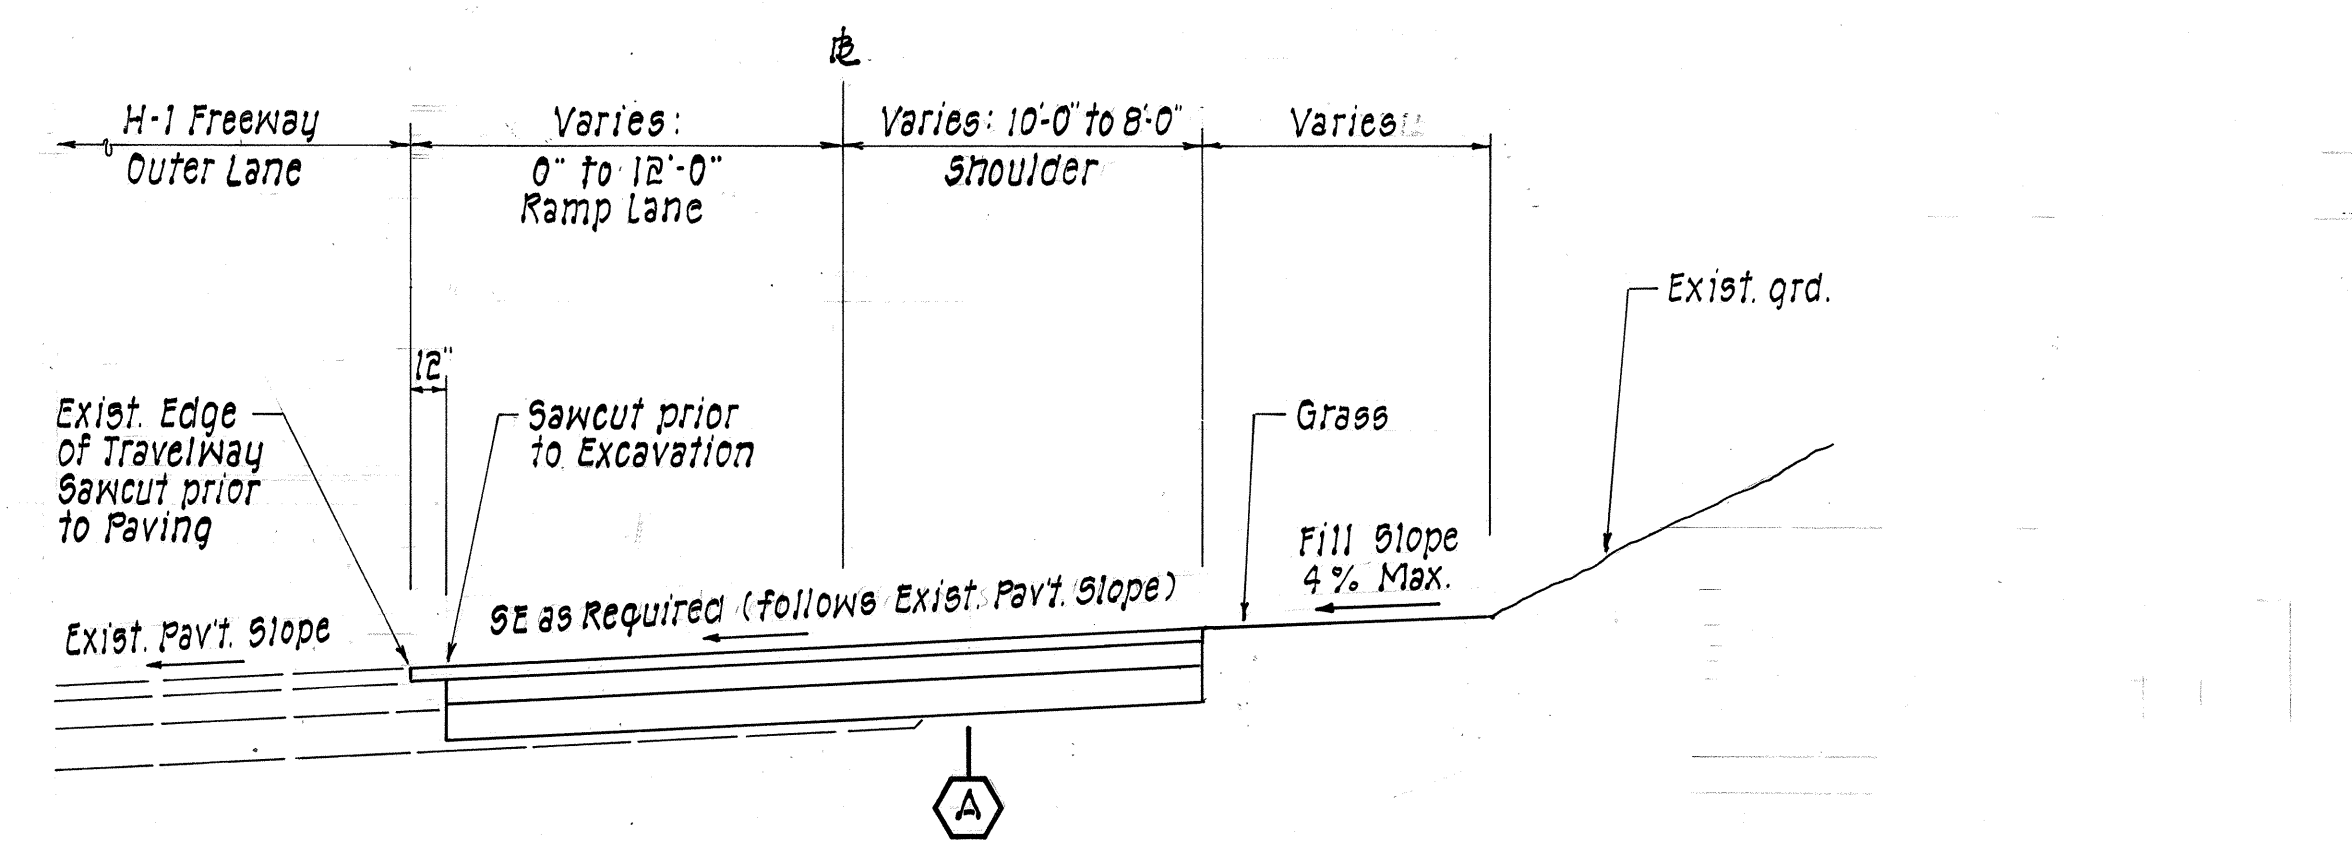

THIS WORK WAS PREPARED BY ME OR UNDER MY SUPERVISION.
 Signature: *Bernard P. Kea*

STATE OF HAWAII
 DEPARTMENT OF TRANSPORTATION
 HIGHWAYS DIVISION

TYPICAL SECTIONS

INTERSTATE ROUTE H-1
 PAIWA STREET INTERCHANGE
 PROJECT NO. HIC-01-90


SCALE: 3/16" = 1'-0"

DATE: AUG., 1991


SHEET No. 2 OF 3 SHEETS

DATE	DESIGNED BY	CHECKED BY
DESIGNED BY	TRACED BY	NOTED BY
NOTED BY	QUANTITIES BY	CHECKED BY
QUANTITIES BY	CHECKED BY	



FED. ROAD DIST. NO.	STATE	FED. AID PROJ. NO.	FISCAL YEAR	SHEET NO.	TOTAL SHEETS
HAWAII	HAW.	HIC-01-90	1991	7	109

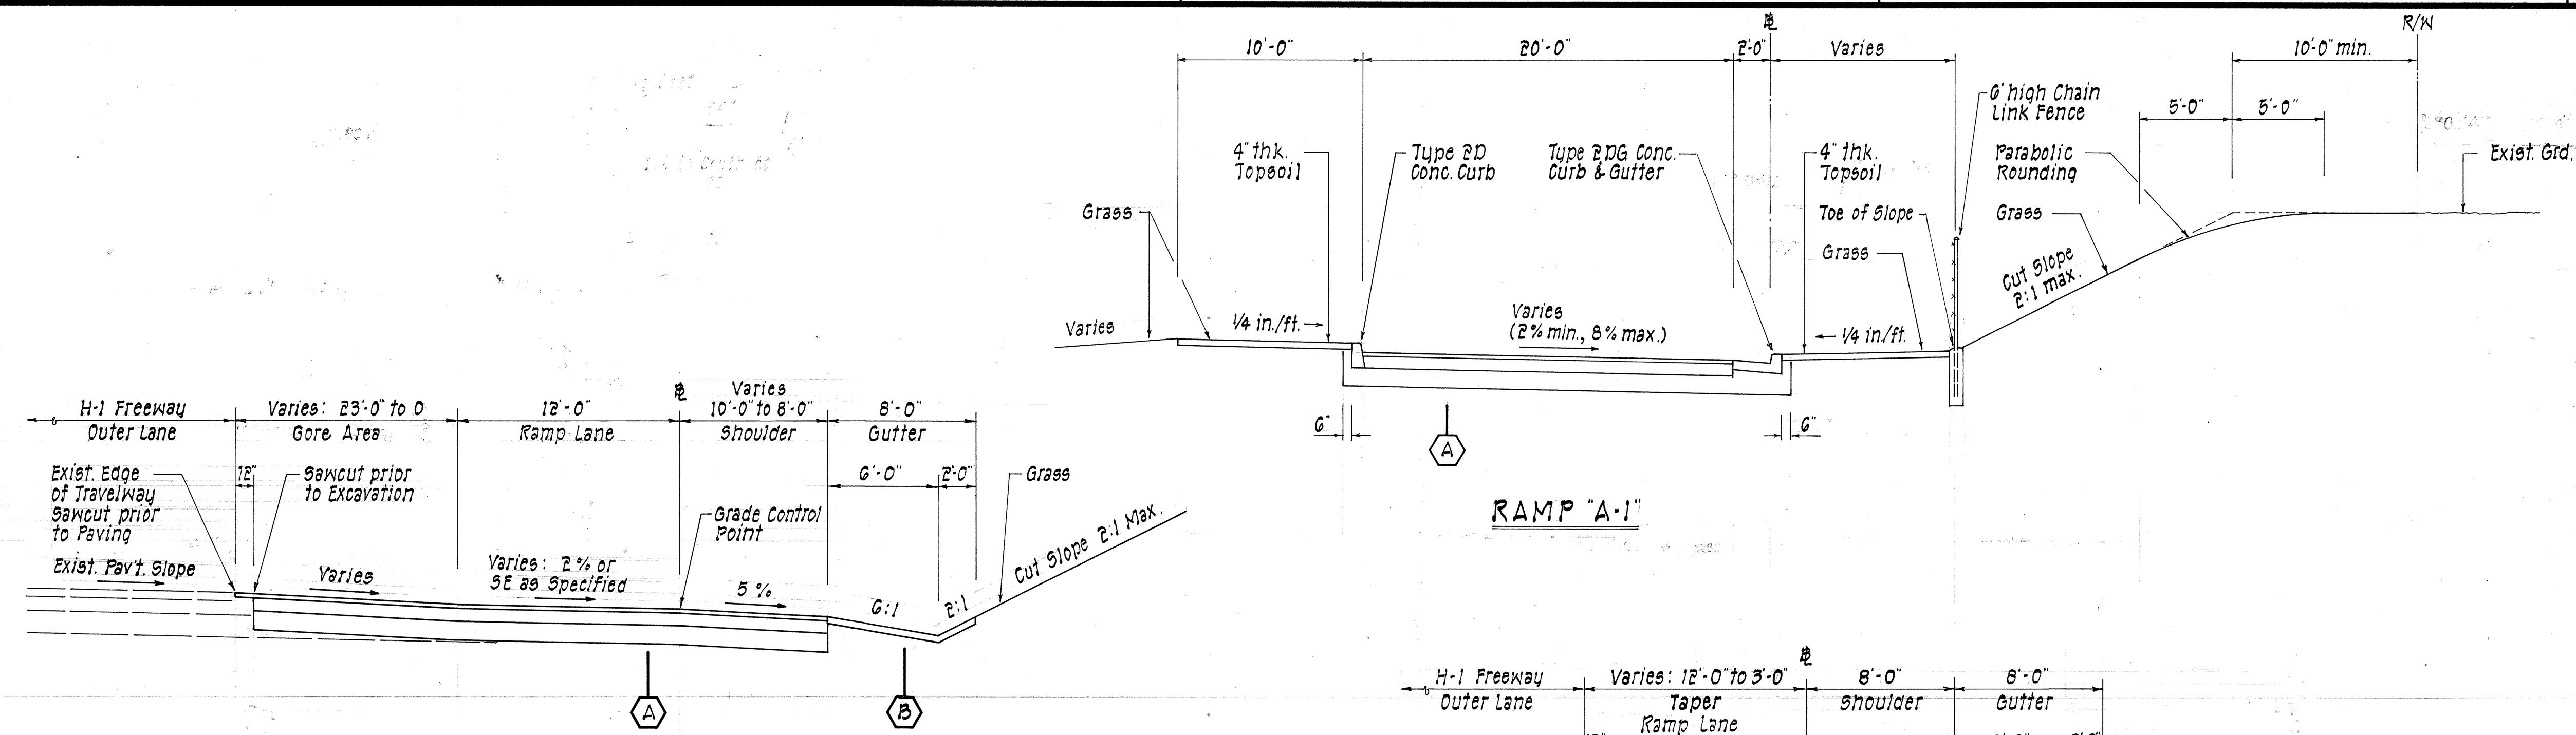


GORE AREA - RAMPS 'C' & 'D'

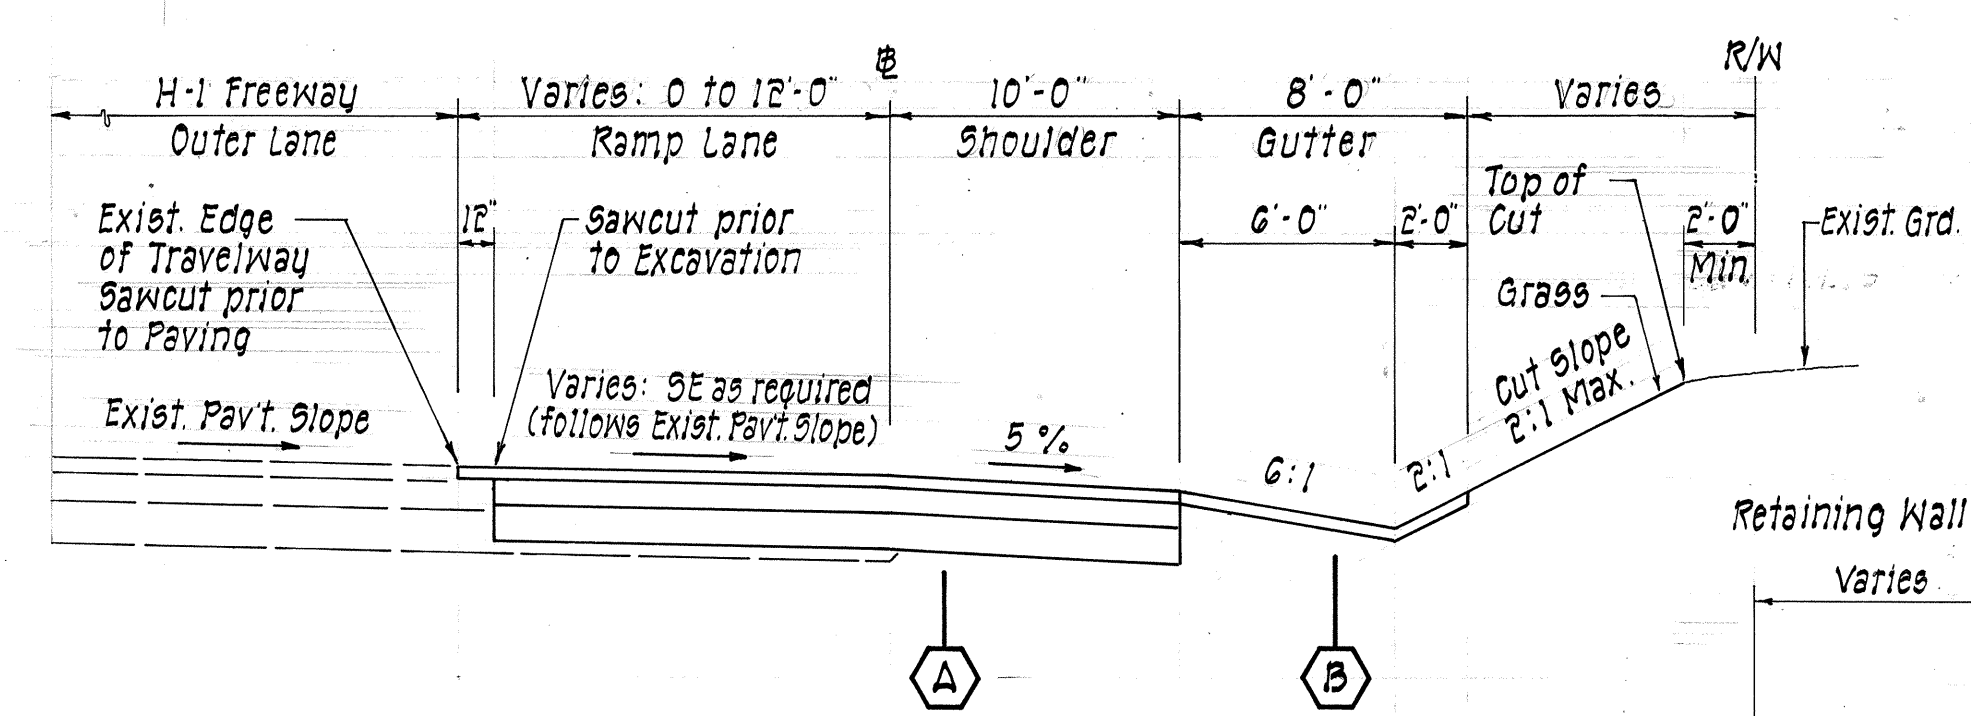


TAPER - RAMP 'C'
(N.T.S.)

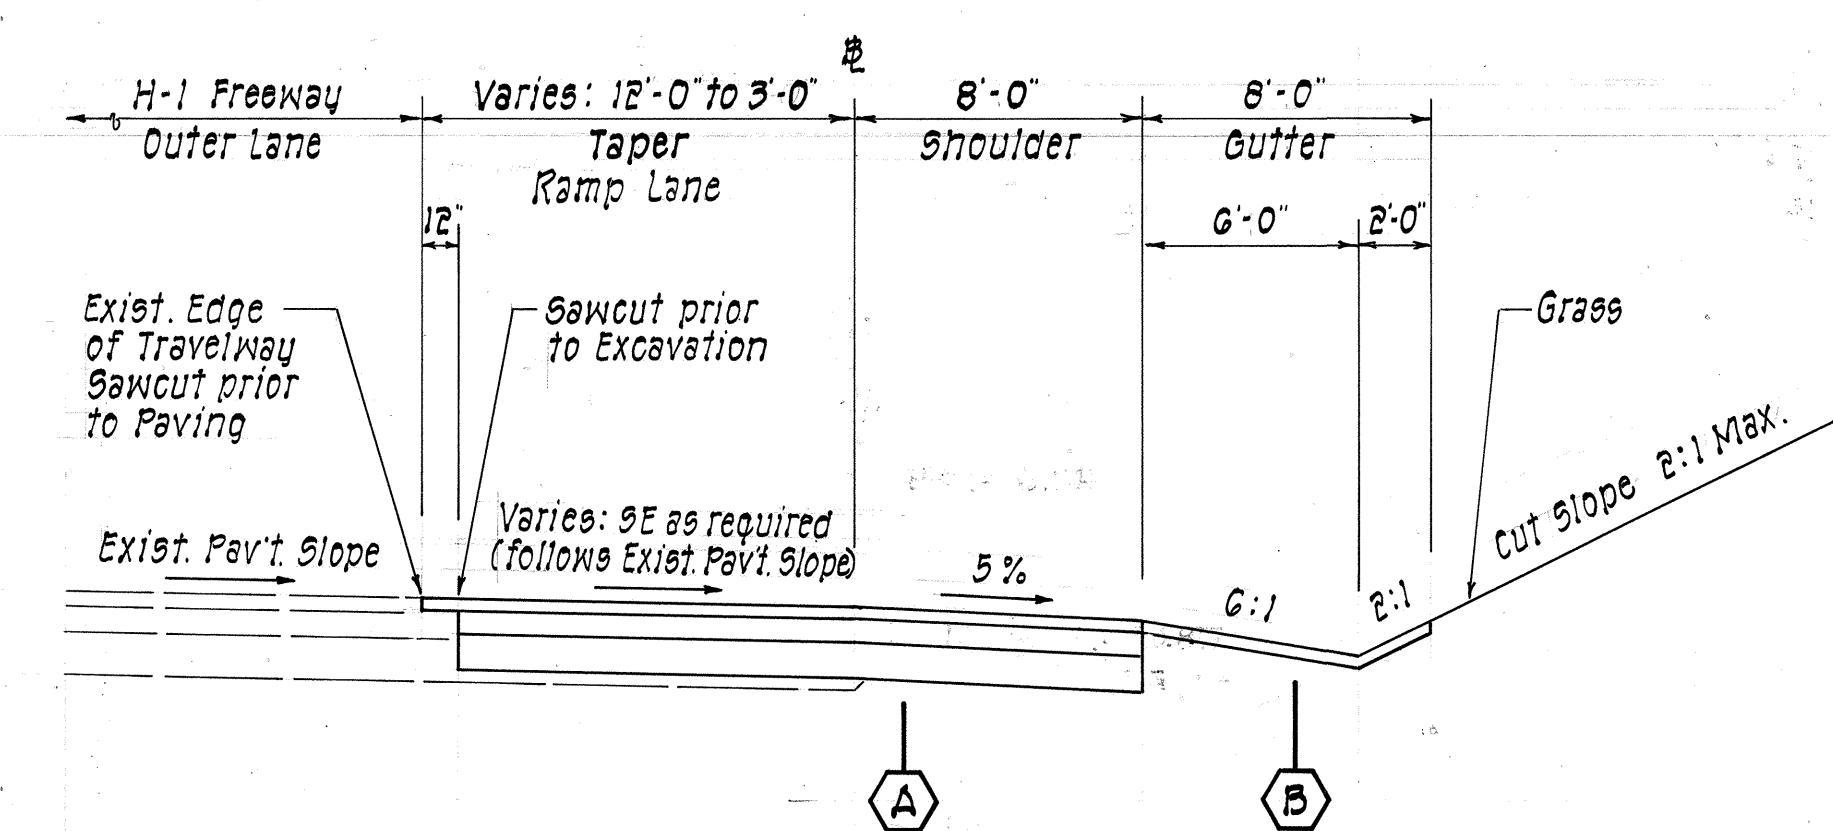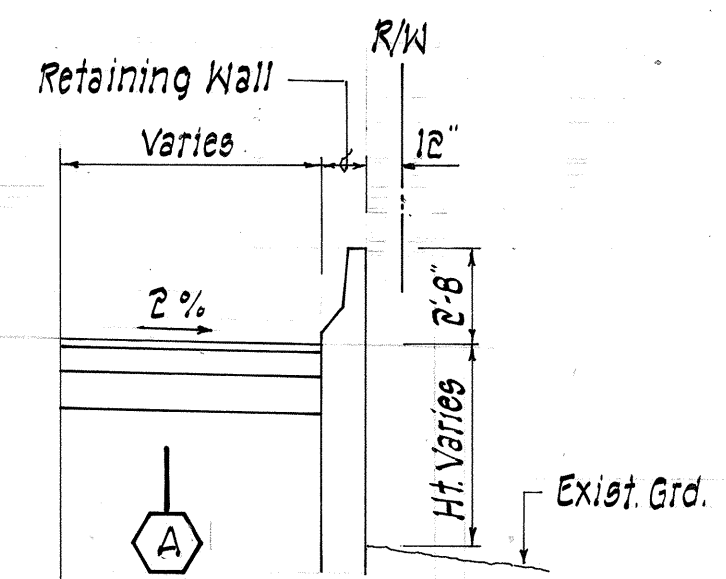

TAPER - RAMP 'D'

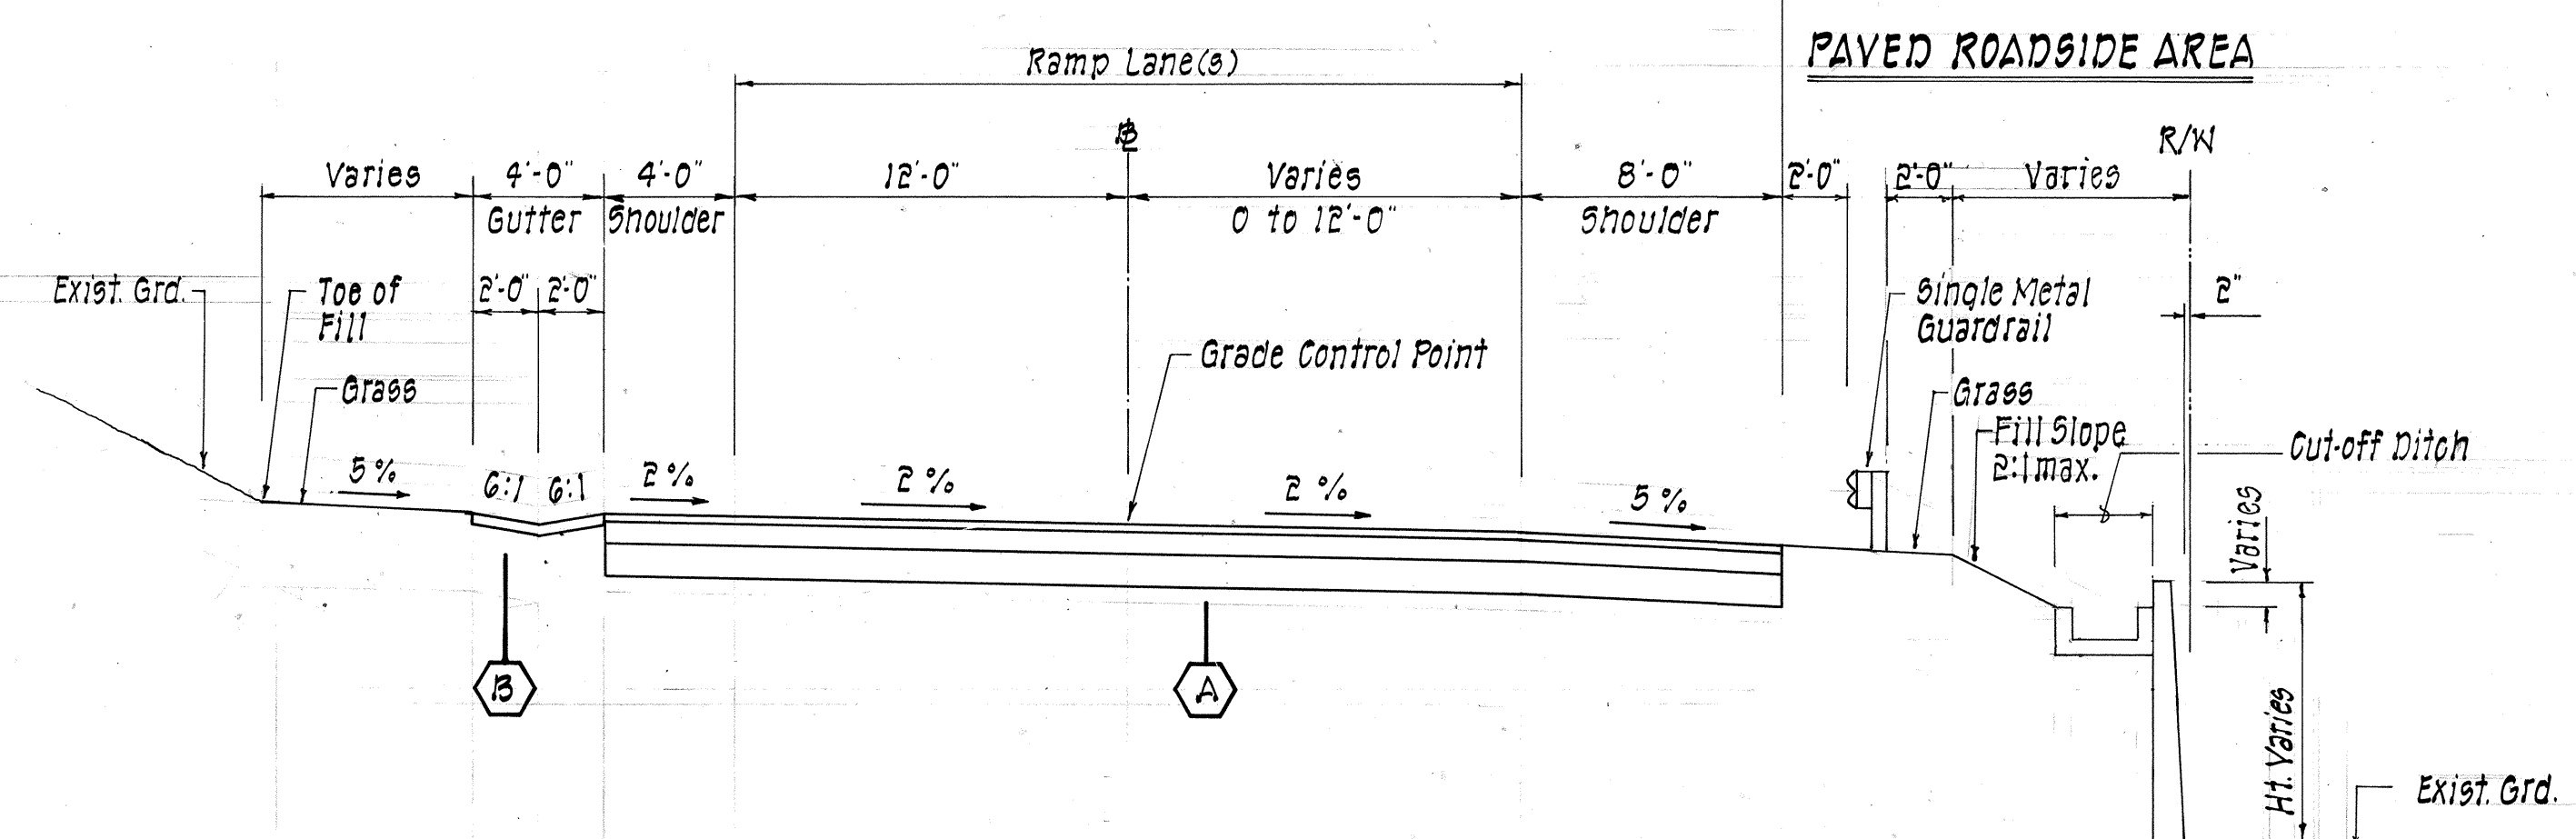

RAMP 'C'

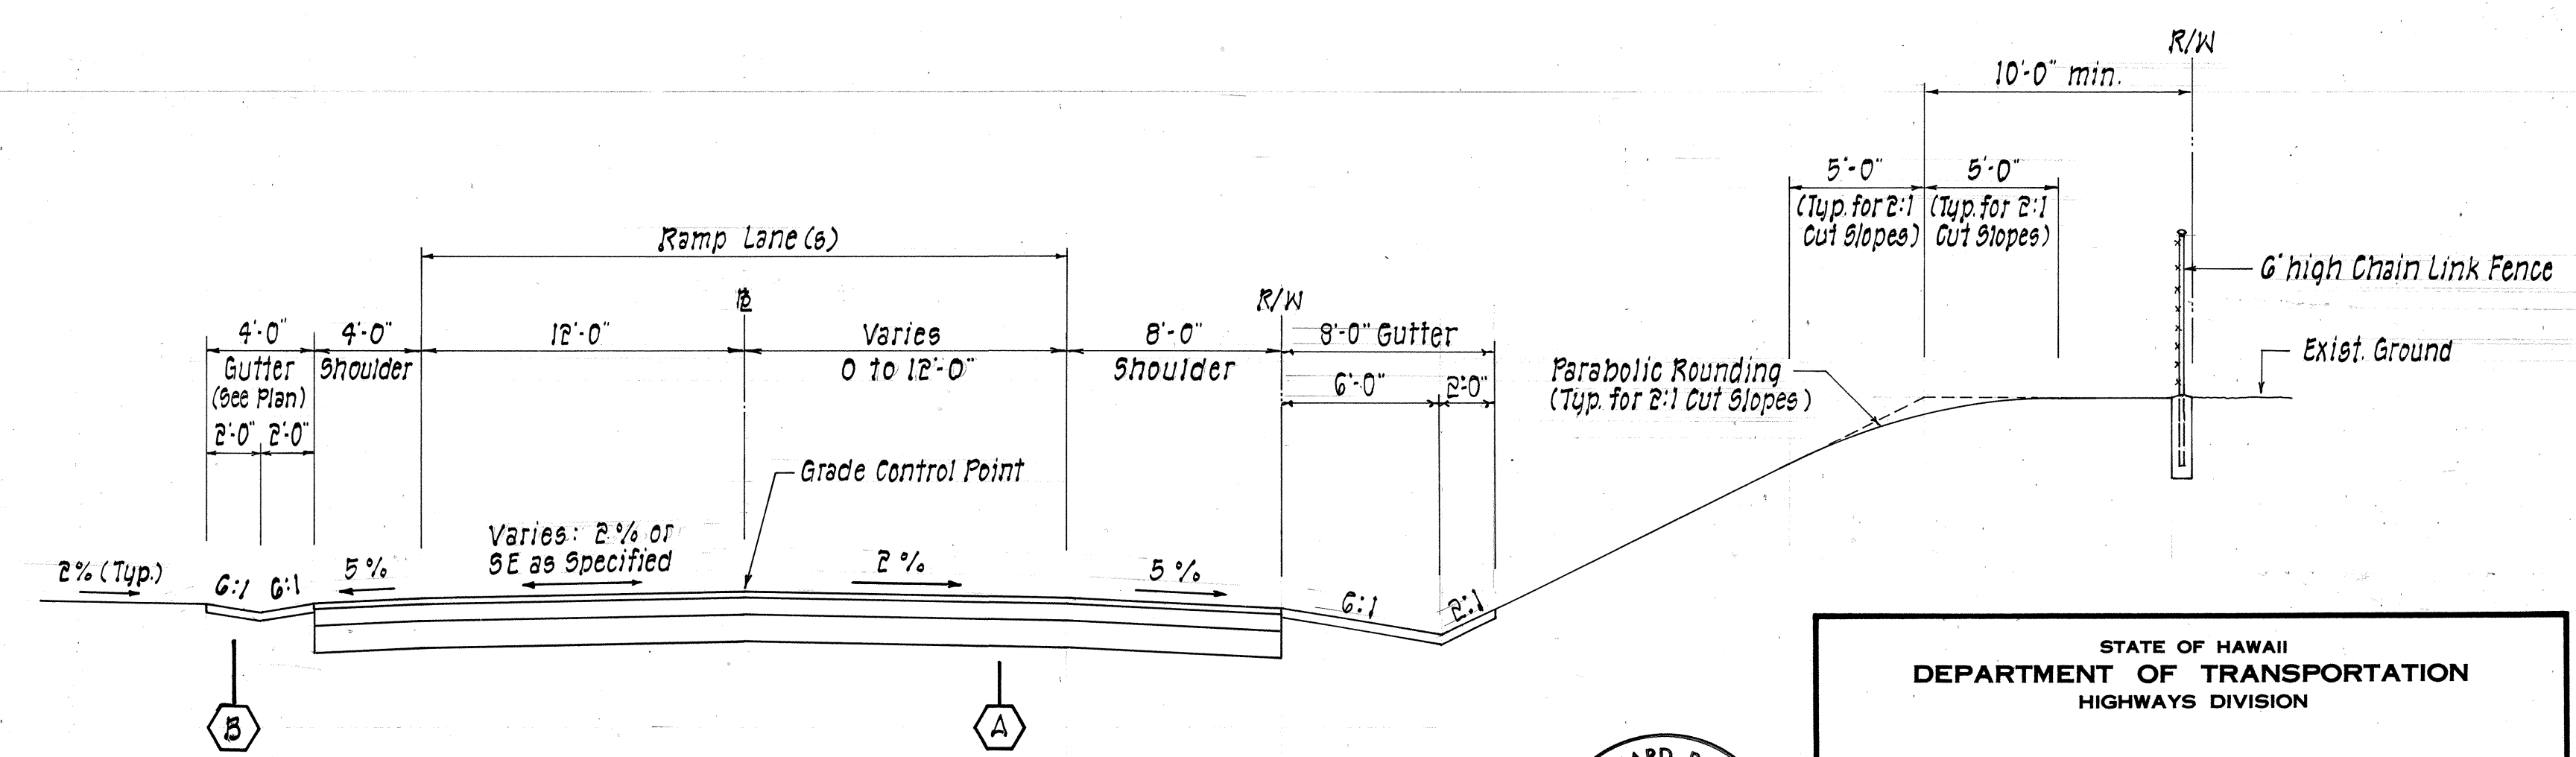

RAMP 'D'

DATE	DESIGNED BY	CHECKED BY
NO.	NOTED BY	NOTED BY
	QUANTITIES BY	QUANTITIES BY
	TRACED BY	TRACED BY
	ORIGINAL PLAN	ORIGINAL PLAN

BERNARD P. KEA
REGISTERED PROFESSIONAL ENGINEER
No. 1890-C
HAWAII, U.S.A.

THIS WORK WAS PREPARED BY
ME UNDER MY SUPERVISION
Bernard P. Kea
Signature

STATE OF HAWAII
DEPARTMENT OF TRANSPORTATION
HIGHWAYS DIVISION

TYPICAL SECTIONS

INTERSTATE ROUTE H-1
PAIWA STREET INTERCHANGE
PROJECT NO. HIC-01-90

SCALE: 3/16" = 1'-0"

DATE: AUG., 1991

SHEET NO. 3 OF 3 SHEETS