INDEX TO DRAWINGS
DESCRIPTION
TITLE SHEET
STANDARD PLANS SUMMMARY
GENERAL NOTES AND LEGEND
TYPICAL SECTIONS AND
MISCELLANEOUS DETAILS
PLANS
CURVE DATA
PAVEMENT MARKING AND SIGNING
PLANS, DETAILS AND SCHEDULES

STATE OF HAWAII

DEPARTMENT OF TRANSPORTATION

HIGHWAYS DIVISION HONOLULU, HAWAII

"AS-BUILT"


PLANS FOR


INTERSTATE ROUTE H-1

WAIAU INTERCHANGE RESURFACING, ON AND OFF RAMPS AND MOANALUA ROAD

FEDERAL AID INTERSTATE PROJ. NO. IM-H1-1(217)

DISTRICT OF EWA ISLAND OF OAHU

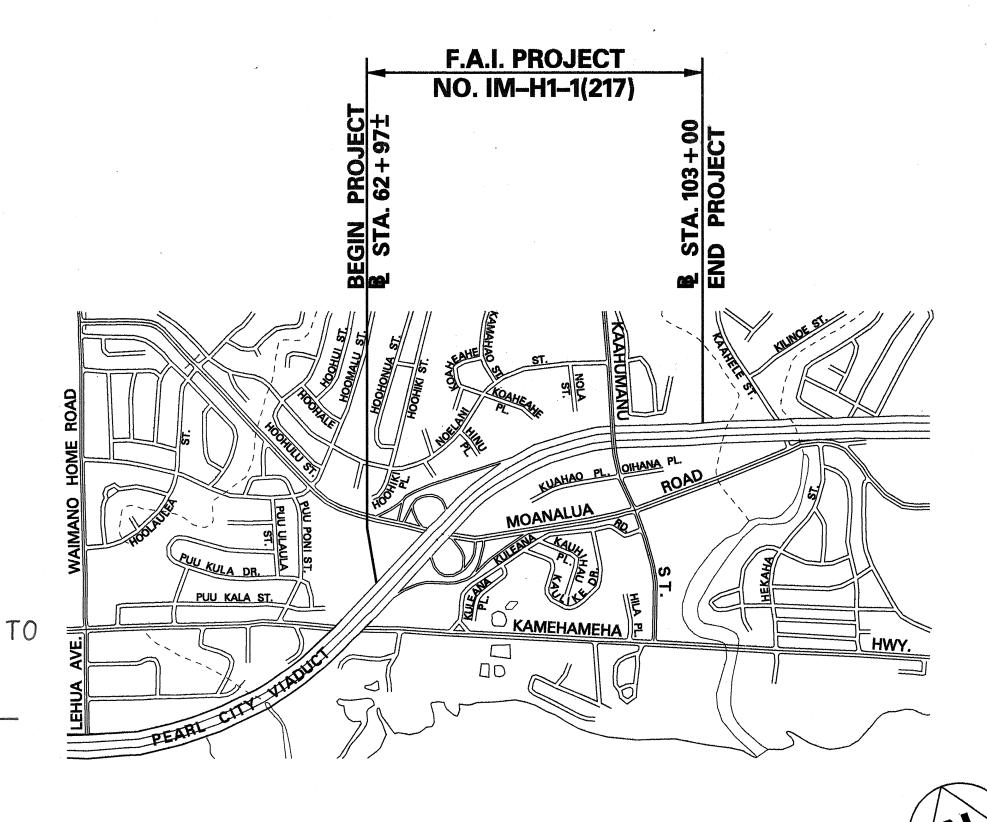

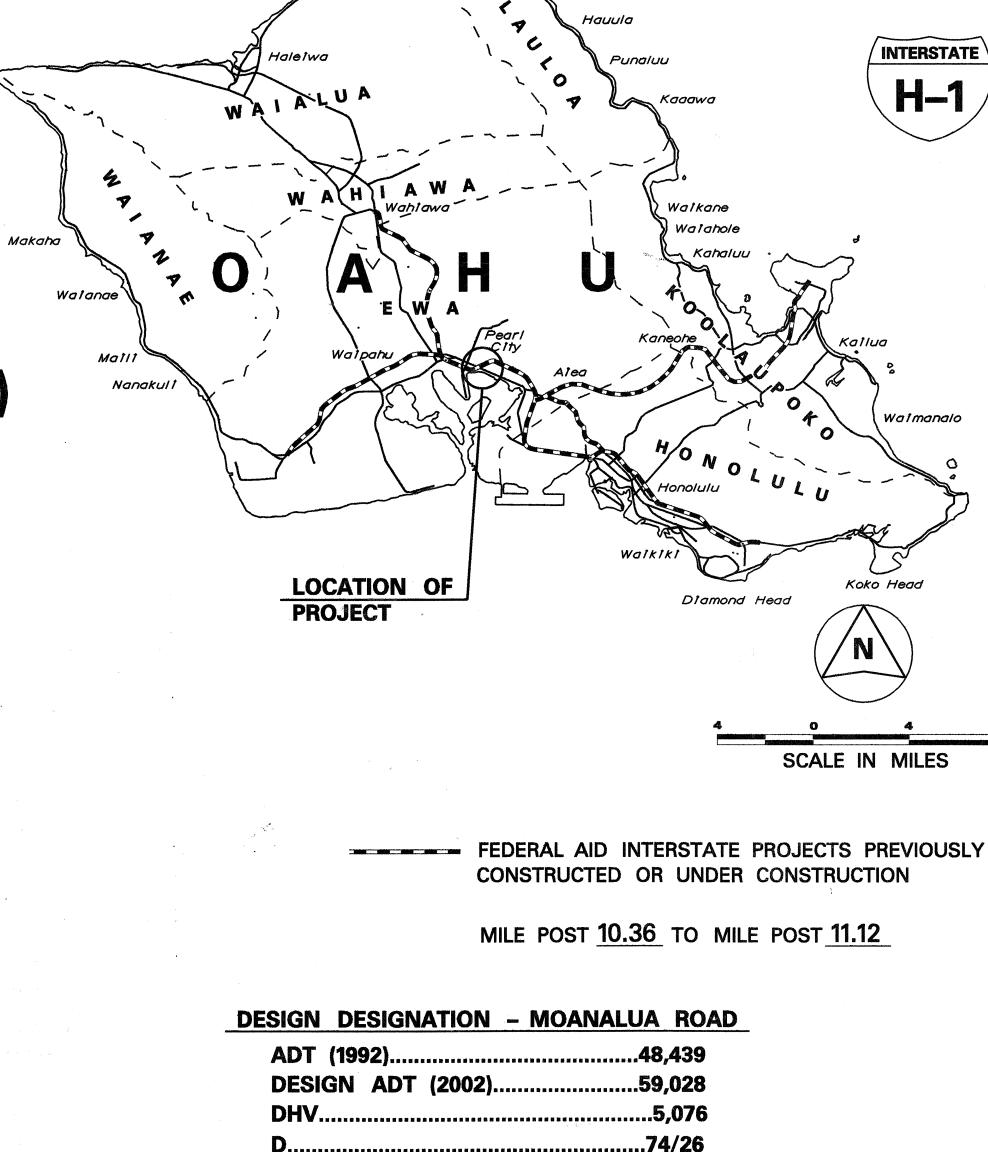

FED. ROAD DIST. NO.

HAW. IM-H1-1(217)

STATE OF HAWAII

H-1

CHANGES MADE DURING CONSTRUCTION HAVE CHANGES IN THE ORIGINAL THEORETICAL QUANTITIES. FOR ACTUAL QUANTITIES, REFER TO PROJECT LEDGER AND/OR COMPUTATION BOOK.

Robert Shin RESIDENT ENGINEER

LAYOUT PLAN

DEPARTMENT OF TRANSPORTATION

FEDERAL HIGHWAY ADMINISTRATION

5/7/96 DATE

4/30/92

DEPARTMENT OF TRANSPORTATION

STATE OF HAWAII

APPROVED:

Hurano

FOR DIR. OF TRANSPORTATION