

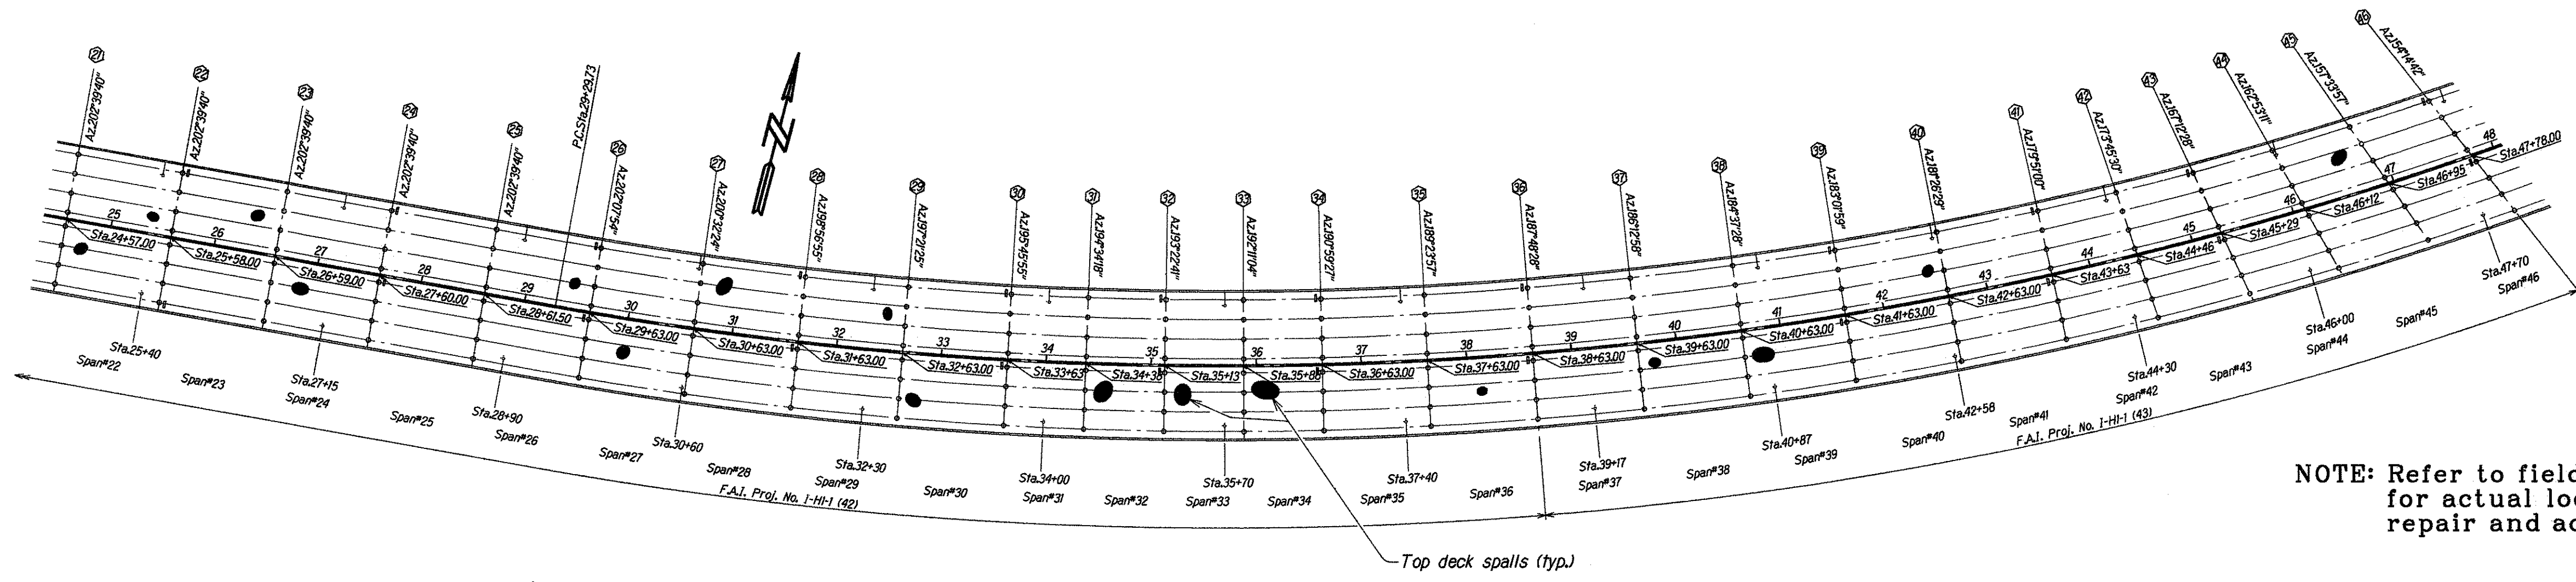


FED. ROAD DIST. NO.	STATE	PROJ. NO.	FISCAL YEAR	SHEET NO.	TOTAL SHEETS
HAWAII	HAW.	HIE-01-92M	1992	4	6

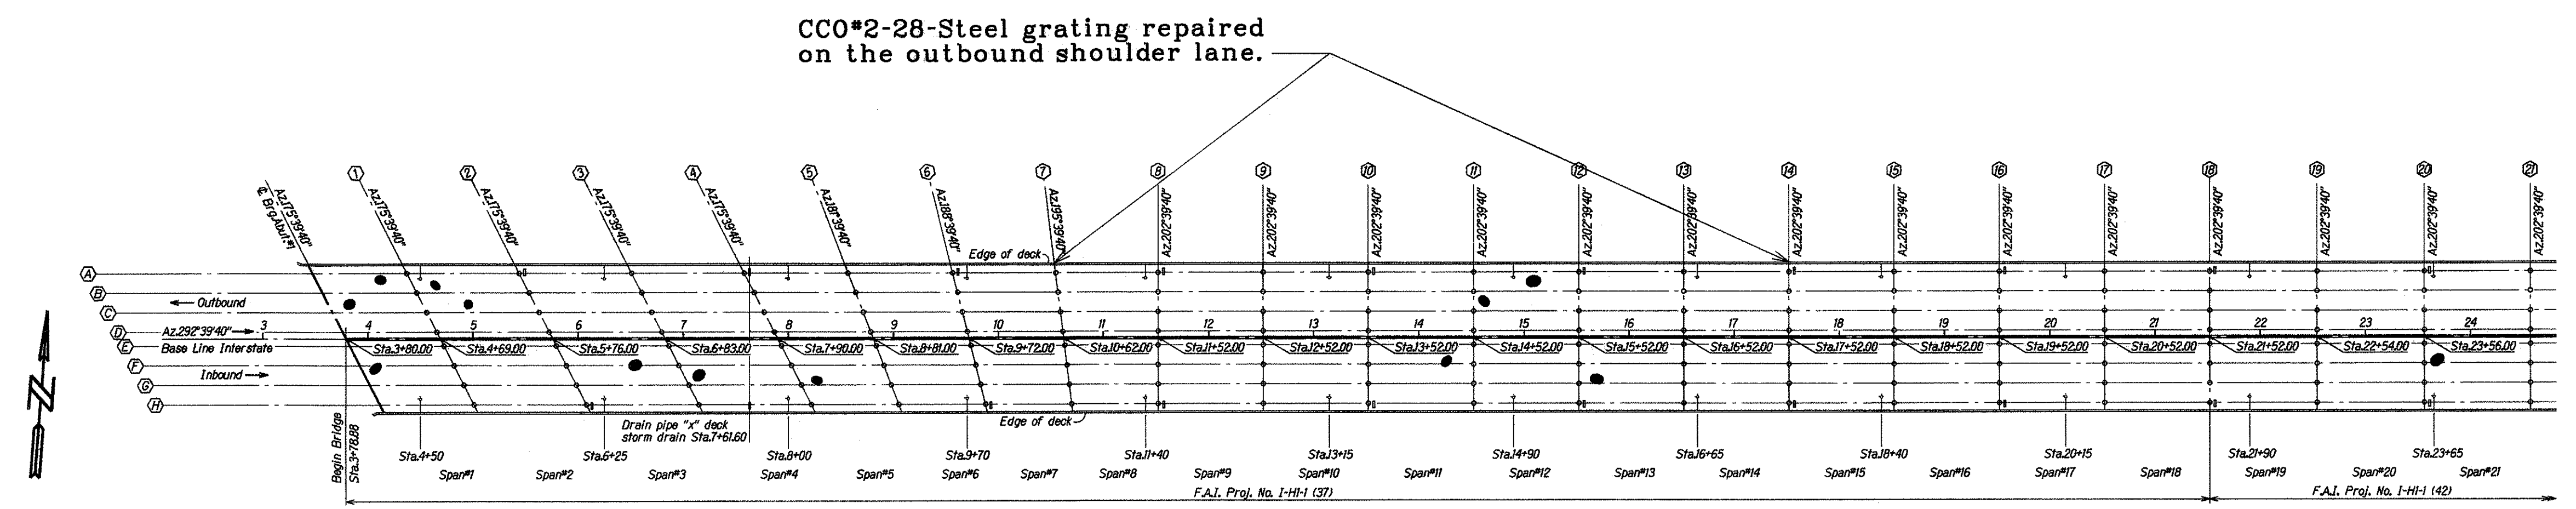

NOTE: Refer to field measurement book for actual locations of spall repair and actual quantities.

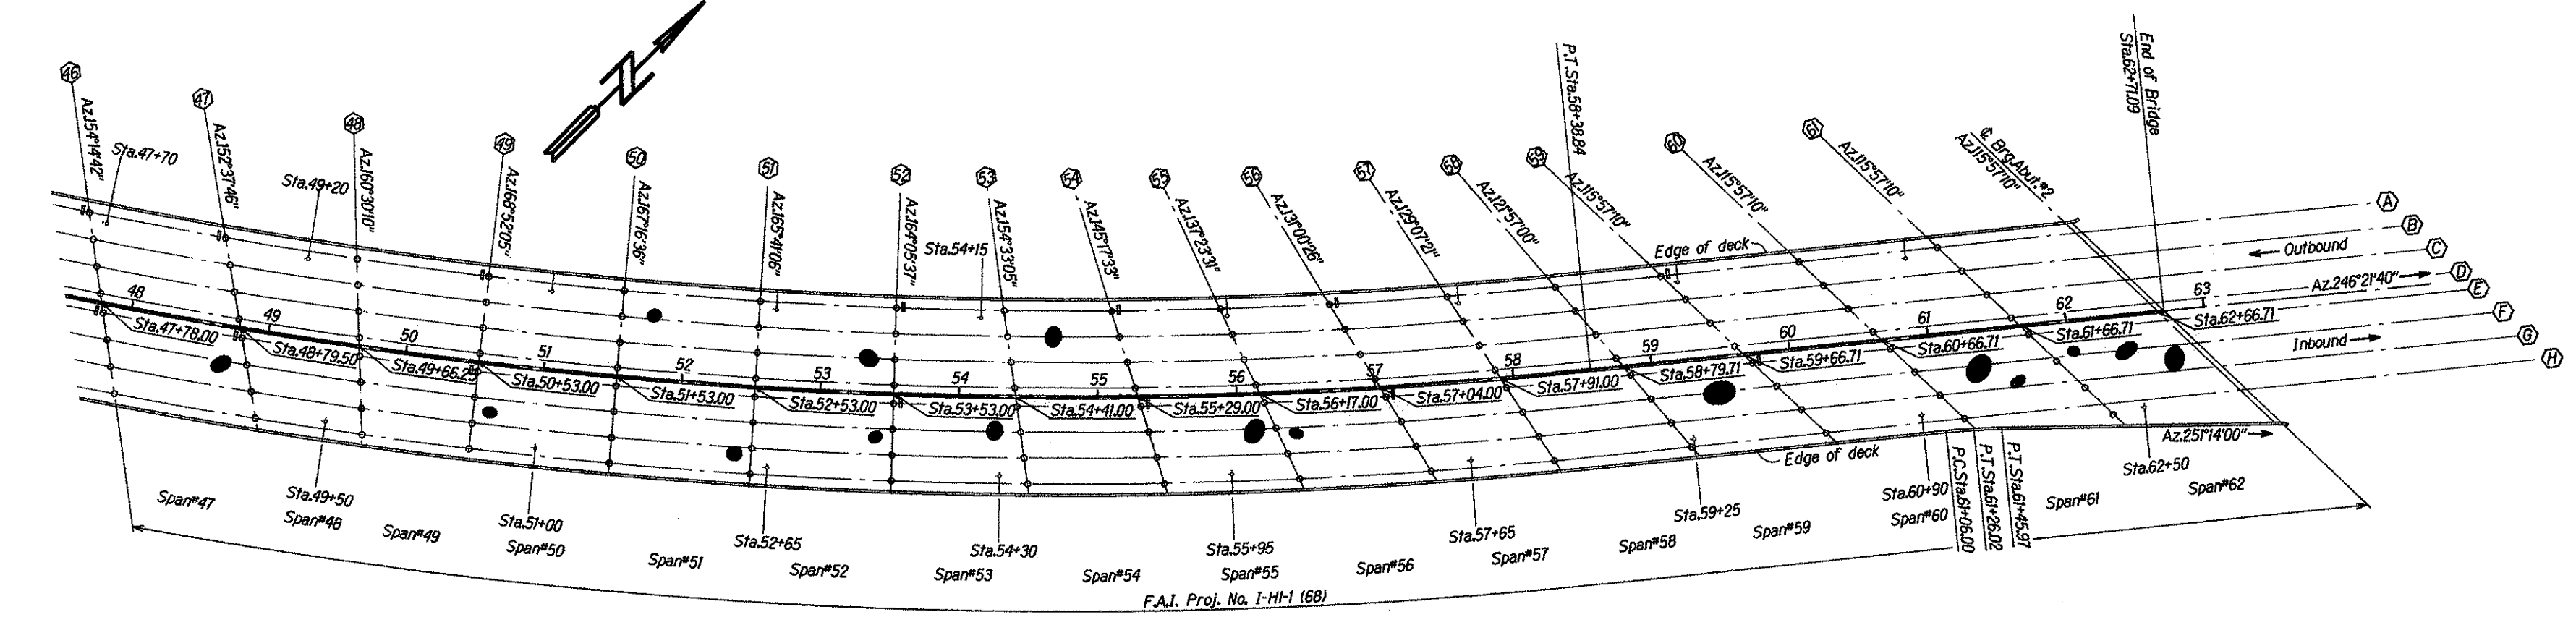

LAYOUT PLAN
Scale: 1" = 100'

NOTE:
Spall locations are for illustration purpose only. Actual locations to be determined by the Engineer in the field.

- SYMBOLS:
- Spall location
 - Light Std. Location
 - Deck storm drain, grate and frame location
 - 48"Ø Column

LEGEND FOR AS-BUILT POSTINGS	
	Squiggly line for as-built deletion
	Double line for as-built deletion
Roadway	Text for as-built posting

STATE OF HAWAII
DEPARTMENT OF TRANSPORTATION
HIGHWAYS DIVISION

PEARL CITY VIADUCT
LAYOUT PLAN SHOWING SPALL LOCATIONS
Sta. 3+78.88 to Sta. 62+71.09
INTERSTATE ROUTE H-1
Project No. HIE-01-92M

Scale: As Noted Date: Jan, 1992

SHEET No. 51 OF 2 SHEETS

ORIGINAL PLAN	DATE: NOV 1991
DESIGNED BY	DESIGNED BY
DRAWN BY	DRAWN BY
CHECKED BY	CHECKED BY