INDEX TO DRAWINGS	
SHEET NO	DESCRIPTION
1	TITLE SHEET
2	STANDARD PLANS SUMMARY
3	GENERAL NOTES AND LEGEND
4	PLAN
5	REPAIR DETAILS
6	TRAFFIC DETAILS

STATE OF HAWAII

## DEPARTMENT OF TRANSPORTATION

HIGHWAYS DIVISION
HONOLULU, HAWAII


"AS-BUILT"


PLANS FOR

## INTERSTATE ROUTE H-1 PEARL CITY VIADUCT REPAIRS

PROJECT NO. H1E-01-92M

DISTRICT OF EWA ISLAND OF OAHU

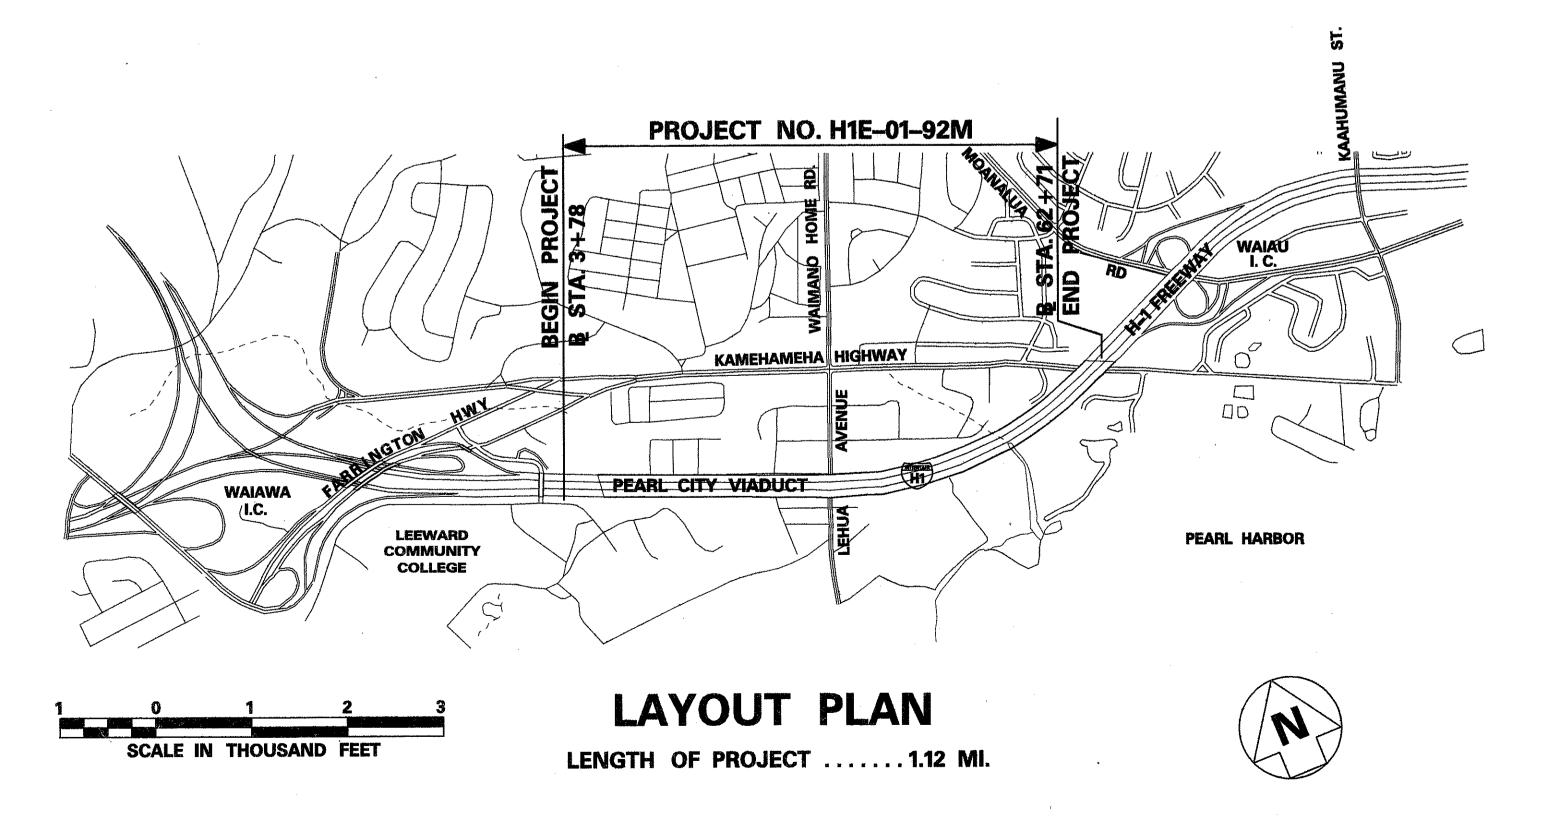

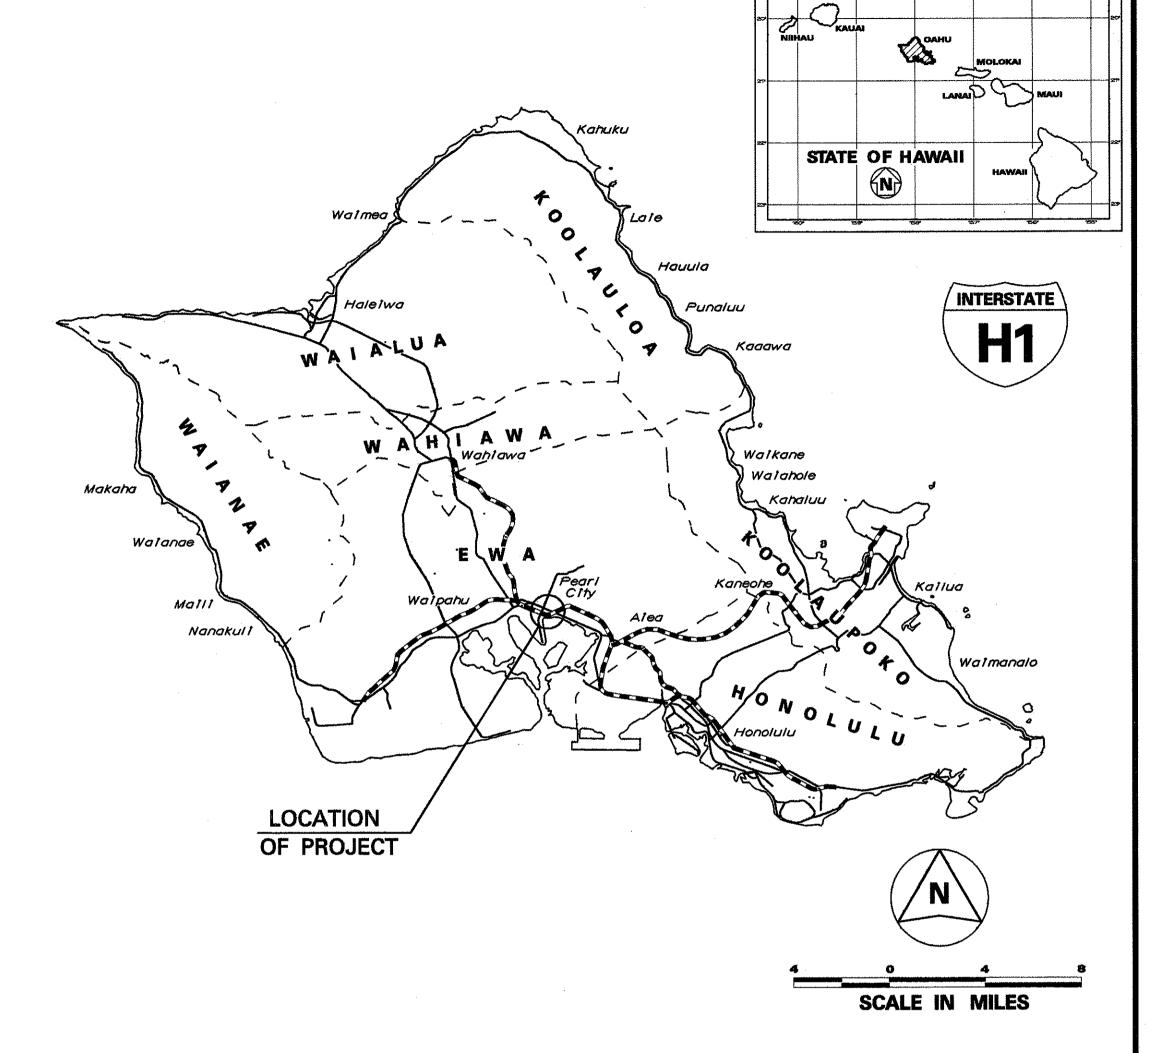

---- FEDERAL AID INTERSTATE PROJECTS PREVIOUSLY CONSTRUCTED OR UNDER CONSTRUCTION

HAW. H1E-01-92M 1992

MILE POST 9.21 TO MILE POST 10.33

ALL CHANGES MADE DURING CONSTRUCTION HAVE BEEN NOTED IN RED ON THESE TRACINGS AND CHECKED BY

RESIDENT ENGINEER DATE

DEPARTMENT OF TRANSPORTATION STATE OF HAWAII

APPROVED:

DIR. OF TRANSPORTATION DATE

FEB., 1992 **DATE** 

ALLAN NISHIMURA P. S. & E. BY