


FED. ROAD DIST. NO.	STATE	FED. AID PROJ. NO.	FISCAL YEAR	SHEET NO.	TOTAL SHEETS
HAWAII	HAW.	IM-IR-HI-1(216)	1994	8	32

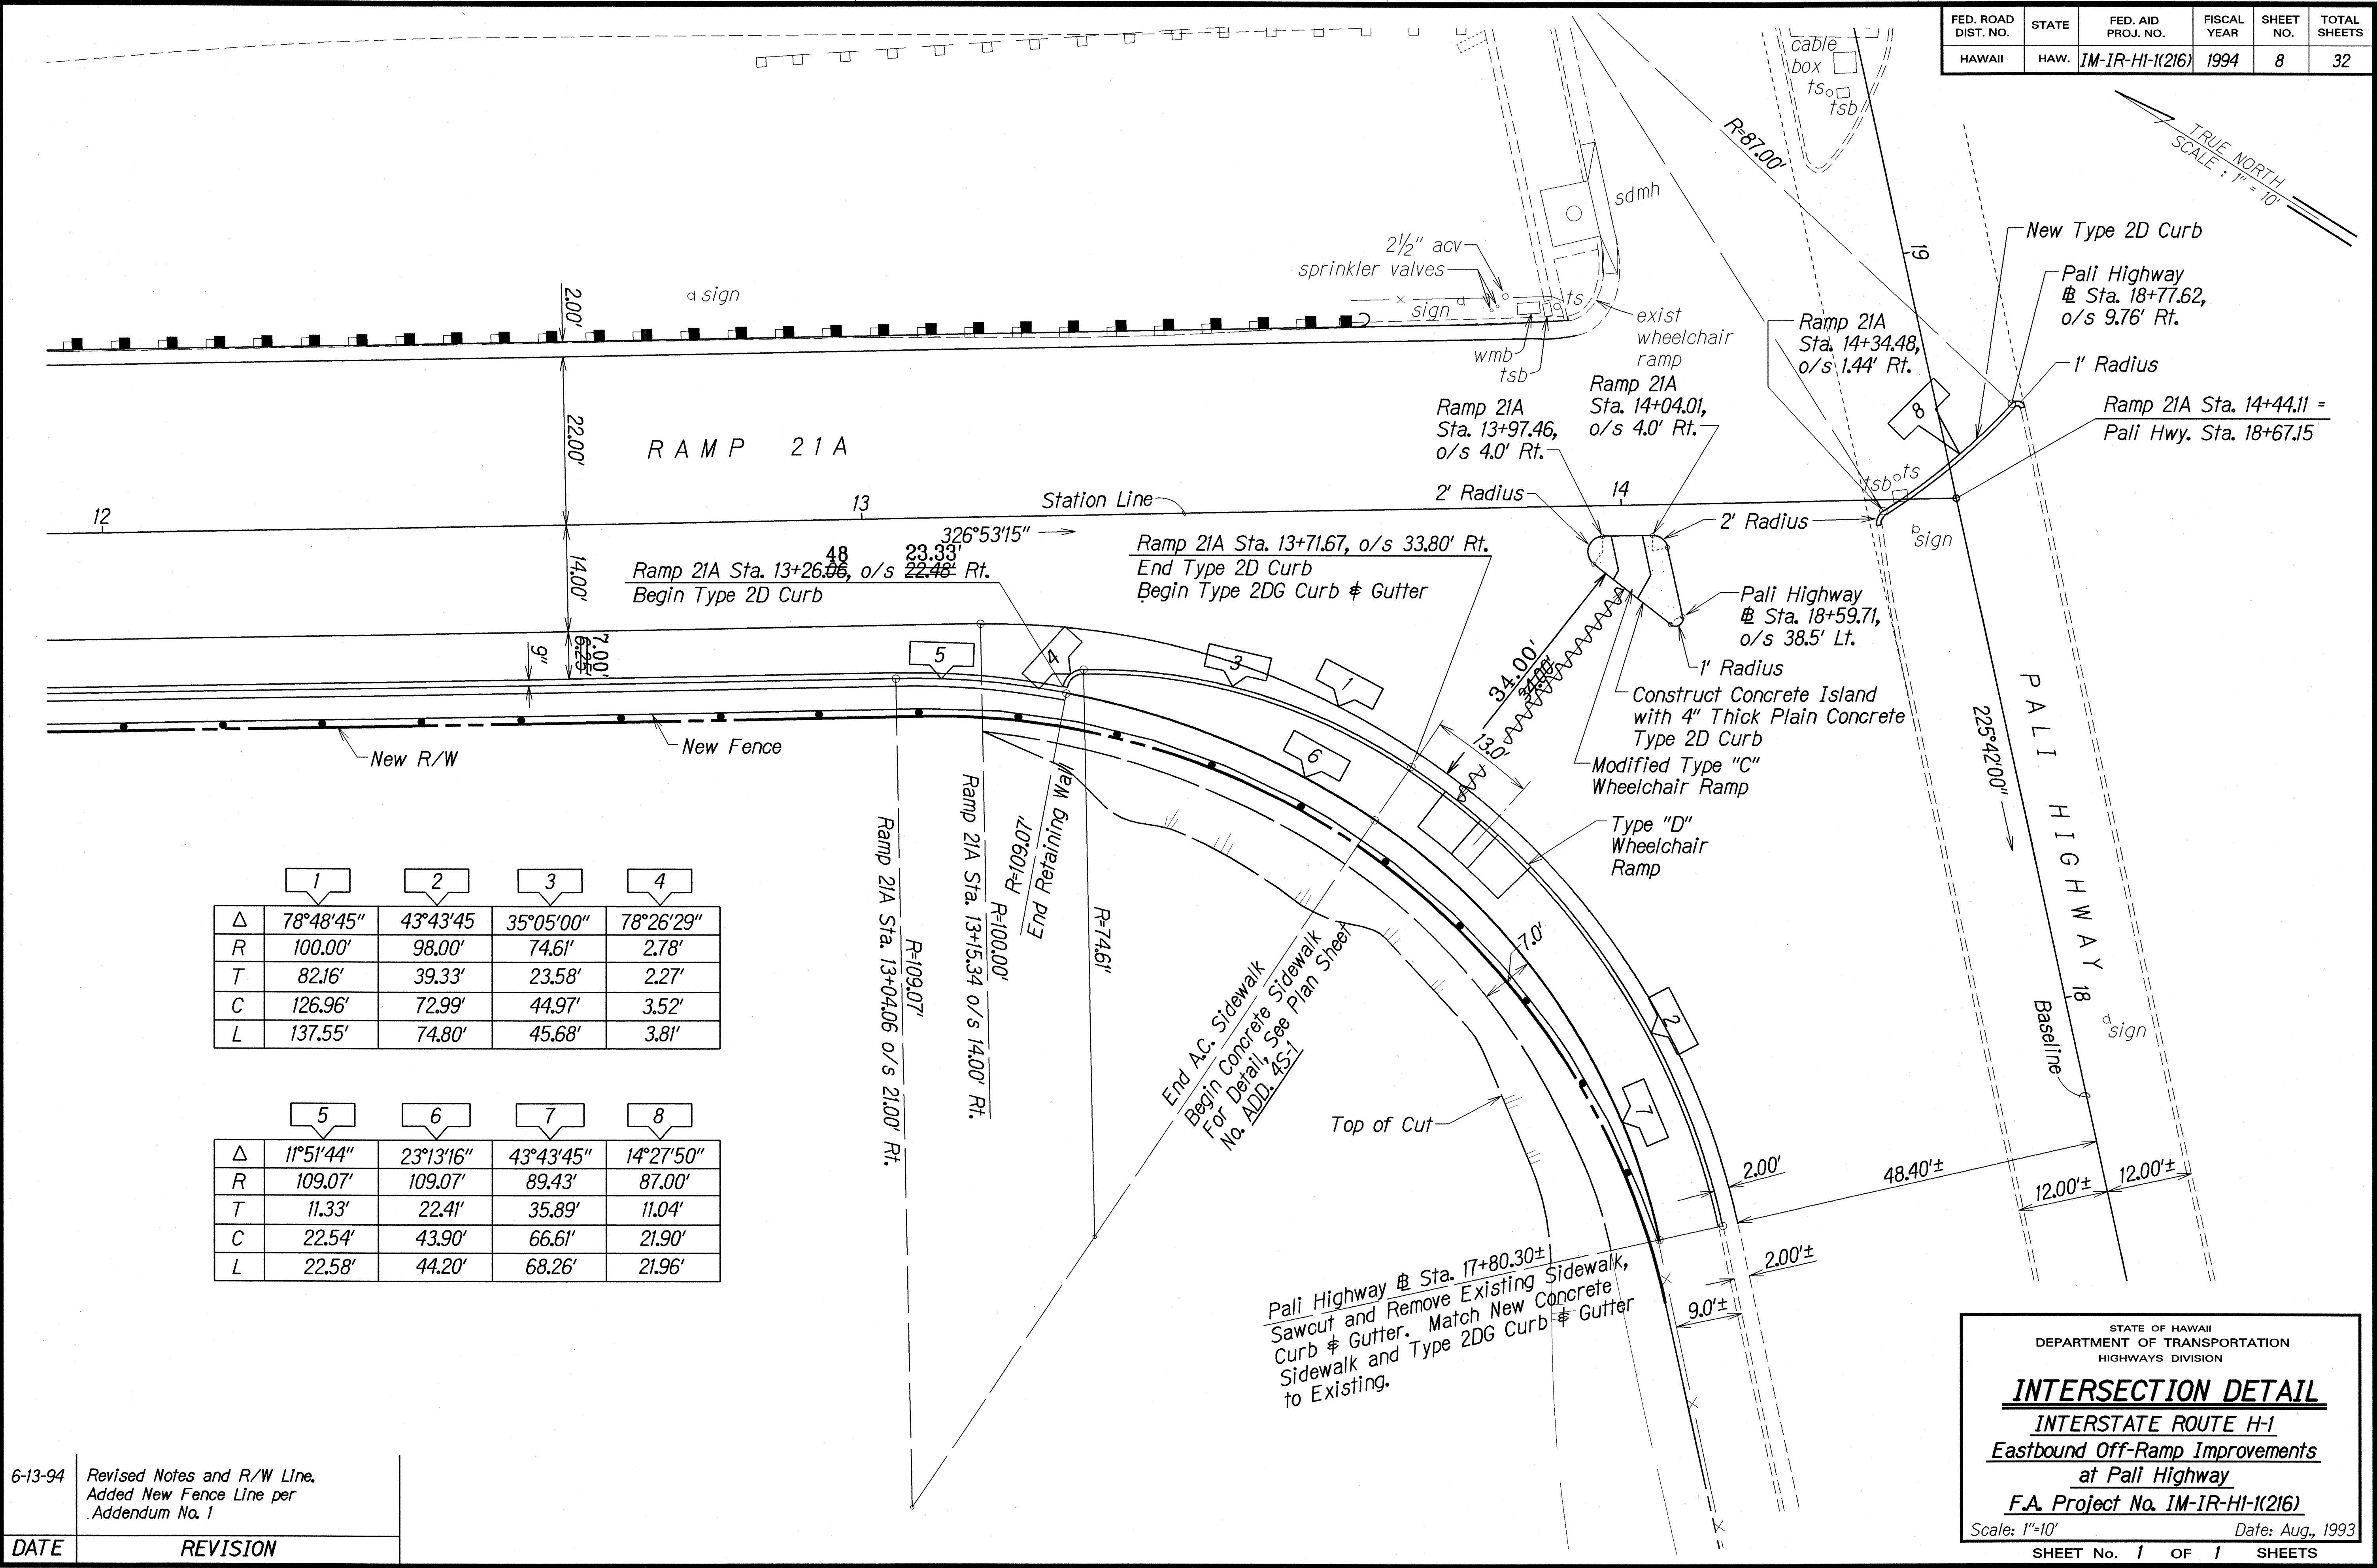

	1	2	3	4
Δ	78°48'45"	43°43'45"	35°05'00"	78°26'29"
R	100.00'	98.00'	74.61'	2.78'
T	82.16'	39.33'	23.58'	2.27'
C	126.96'	72.99'	44.97'	3.52'
L	137.55'	74.80'	45.68'	3.81'

	5	6	7	8
Δ	11°51'44"	23°13'16"	43°43'45"	14°27'50"
R	109.07'	109.07'	89.43'	87.00'
T	11.33'	22.41'	35.89'	11.04'
C	22.54'	43.90'	66.61'	21.90'
L	22.58'	44.20'	68.26'	21.96'

SURVEY PLOTTED BY	DATE
DESIGNED BY	
TRACED BY	
NOTED BY	
QUANTITIES BY	
CHECKED BY	

6-13-94	Revised Notes and R/W Line. Added New Fence Line per Addendum No. 1
DATE	REVISION

Pali Highway Sta. 17+80.30±
Sawcut and Remove Existing Sidewalk,
Curb & Gutter. Match New Concrete
Sidewalk and Type 2DG Curb & Gutter
to Existing.

STATE OF HAWAII
DEPARTMENT OF TRANSPORTATION
HIGHWAYS DIVISION

INTERSECTION DETAIL
INTERSTATE ROUTE H-1
Eastbound Off-Ramp Improvements
at Pali Highway
F.A. Project No. IM-IR-HI-1(216)

Scale: 1"=10' Date: Aug., 1993

SHEET No. 1 OF 1 SHEETS