


PLANT LIST				
Quantity	Common Name	Botanical Name	Size	Specifics
As Needed	Wedelia Syngonium	Wedelia Trilobata Syngonium Species	6" Pots	Rooted Cuttings, 12" O.C. 12" O.C.

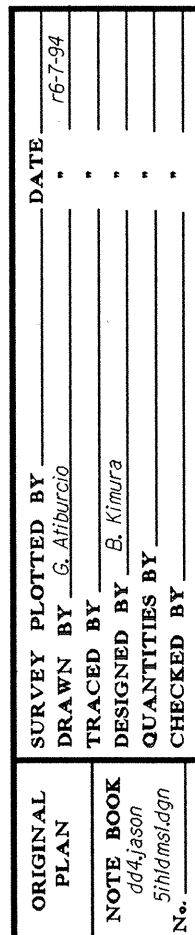

STATE OF HAWAII
DEPARTMENT OF TRANSPORTATION
HIGHWAYS DIVISION

SITE PREPARATION PLAN

INTERSTATE ROUTE H-1

Eastbound Off-Ramp Improvements

at Pali Highway

F.A. Project No. 1M-IR-H1-(216)

Scale: 1"=20' **Date: Aug., 1993**

SHEET No. 1 OF 1 SHEETS