H - 1

H - 1

STATE OF HAWAII

DEPARTMENT OF TRANSPORTATION

HIGHWAYS DIVISION HONOLULU, HAWAII

"AS-BUILT"

PLANS FOR

INTERSTATE ROUTE H-1

EASTBOUND OFF-RAMP IMPROVEMENTS AT PALI HIGHWAY FEDERAL AID PROJECT NO. IM-IR-H1-1(216)

> DISTRICT OF HONOLULU ISLAND OF OAHU

SCHOOL

LANES

LANES

EASTBOUND RAMP 21A

F.A.P. NO. IM-IR-H1-1(216)

LENGTH OF PROJECT = 0.14 MI.

WESTBOUND


EASTBOUND

WESTBOUND RAMP 21B

SCHOOL STREET

- WESTBOUND RAMP 21B

AVENUE

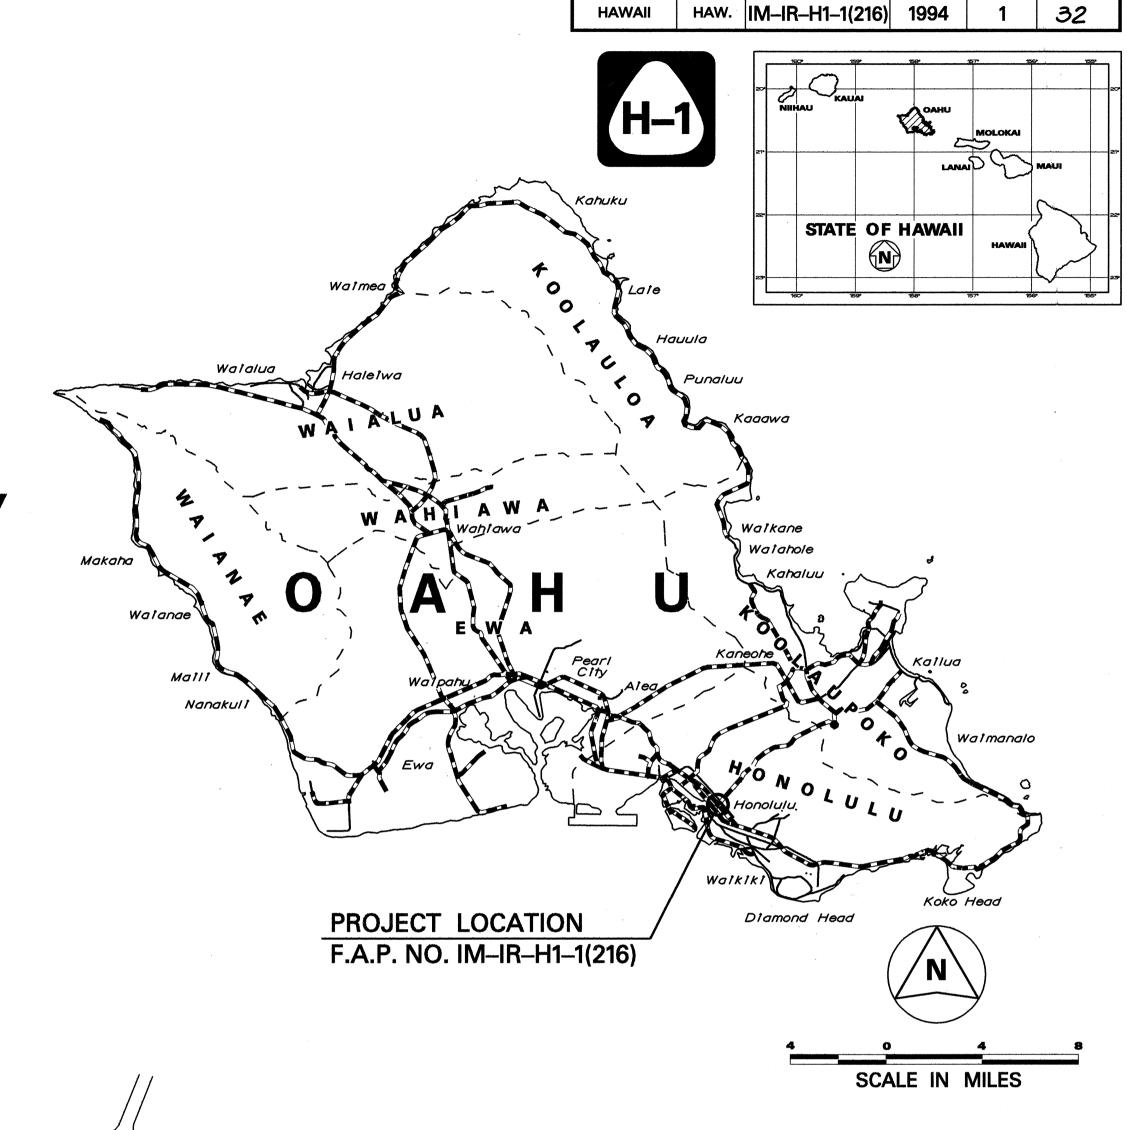

FED. ROAD DIST. NO.

FED. AID PROJ. NO.

FEDERAL AID PROJECTS PREVIOUSLY CONSTRUCTED OR UNDER CONSTRUCTION

MILE POST 21.30 TO MILE POST 21.44

DESIGN DESIGNATION

Al	DT (1993)	15381
Al	DT (2013)	19014
	DHV	1236
	D	100%
CHANGES MADE DURING CONSTRUCTION HAVE BEEN INCORPORATED ON THESE PLANS EXCEPT CHANGES IN THE ORIGINAL THEORETICAL QUANTITIES. FOR ACTUAL QUANTITIES, REFER TO PROJECT LEDGER	Т	3.0%
	V	30 M.P.H
AND/OR COMPUTATION BOOK.		

Sidney S.C. Tu-

DEPARTMENT OF TRANSPORTATION FEDERAL HIGHWAY ADMINISTRATION **APPROVED:** S/RY/Ny DATE

M DIVISION ADMINISTRATOR

DEPARTMENT OF TRANSPORTATION STATE OF HAWAII		
APPROVED:		
Harano	5/24/94	

常之DIR. OF TRANSPORTATION

LOCATION PLAN SCALE IN HUNDRED FEET