


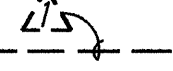
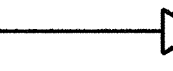
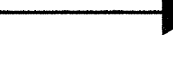





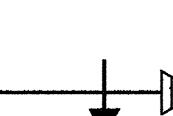

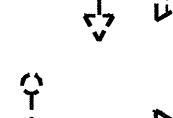
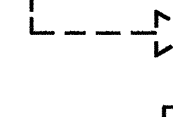


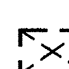
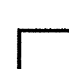
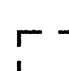





FED. ROAD DIST. NO.	STATE	PROJ. NO.	FISCAL YEAR	SHEET NO.	TOTAL SHEETS
HAWAII	HAW.	IM-IR-HI-1(216)	1994	14	32

TRAFFIC SIGNAL NOTES

1. The locations of the traffic signal standards, traffic signal standards with mast-arm, pedestrian push buttons, traffic controller, pullboxes, conduits and loop detectors shall be staked out in the field by the Contractor and approval of the locations shall be obtained from the Engineer prior to construction and installation.
2. All traffic signal controller equipment shall be completely wired in the cabinet and shall control the traffic signals as called for in the plans.
3. All splicing shall be done in the pullboxes.
4. Furnishing and installing conduit stubouts (pullboxes to edge of pavement) will not be paid for separately but shall be considered incidental to the various contract items.
5. A solid #8 bare copper wire shall be pulled with the traffic signal control cable for equipment ground. Cost shall be incidental to the installation of the control cable.
6. All existing Pull Boxes, Traffic Signal Poles and Controller Bases not incorporated into the new Traffic Signal System shall be removed to 6 inches below grade and shall be restored to match existing conditions. This work will not be paid for separately but shall be considered incidental to the various contract items.
7. Existing Loop Detectors and conduits not incorporated into the new Traffic Signal System shall be abandoned in place. Abandoned conduits shall be plugged with concrete. Remove unused existing cables.
8. Existing Traffic Signal Poles, Mast Arms, Heads and Controllers which are removed and not incorporated into the new Traffic Signal System shall be delivered to the Highways Maui Baseyard or as directed by the Engineer.
9. The Contractor shall clean and/or repair the existing traffic signal pullboxes to be used prior to installing conduits and cables. This work will not be paid for separately but shall be considered incidental to the various contract items.
10. Locations of existing underground structures and utilities such as pipe lines, conduits, cables, etc., shown on plans are approximate only. It is not the intent of these plans to show the exact location of all underground utilities and structures. It is the responsibility of the Contractor to verify the locations of all existing utilities with the respective owners. Existing utilities damaged by the Contractor shall be repaired by the Contractor at his own cost.
11. The Traffic Signals shall be kept operational during construction. Any relocation required shall be approved by the Engineer and paid for by the Contractor.

TRAFFIC SIGNAL LEGEND

	New Traffic Signal Controller
	Existing Traffic Signal Controller
	New Traffic Signal Conduits and Cables
	Existing Traffic Signal Conduits and Cables
	New 12" RYG Traffic Signal Head
	New 12" RY↑ Traffic Signal Head
	Existing 12" RYG Traffic Signal Head
	New 12" RYG Traffic Signal Head w/Back Plate
	New 12" RY↑ Traffic Signal Head w/Back Plate
	New 12" RY← Traffic Signal Head
	New 12" RY→ Traffic Signal Head
	New Type II Traffic Signal Standard w/Mast Arm and Traffic Signal Heads
	New 12" RY← Traffic Signal Head (Programmable Visibility)
	Exist. 12" RY← Traffic Signal Head (Programmable Visibility)
	Existing Type II Traffic Signal Standard w/Mast Arm and Traffic Signal Heads
	New Pedestrian Signal Head
	Existing Pedestrian Signal Head
	New Type A Pullbox
	Existing Type A Pullbox
	New Type B Pullbox (Traffic Signal)
	Existing Type B Pullbox
	New Loop Detector
	Existing Loop Detector

ORIGINAL PLAN	SURVEY PLOTTED BY	DATE
NOTE BOOK	DESIGNED BY	5/94
10/20/96	CHECKED BY	
12/11/96		

STATE OF HAWAII  
DEPARTMENT OF TRANSPORTATION  
HIGHWAYS DIVISION

TRAFFIC SIGNAL LEGEND & NOTES

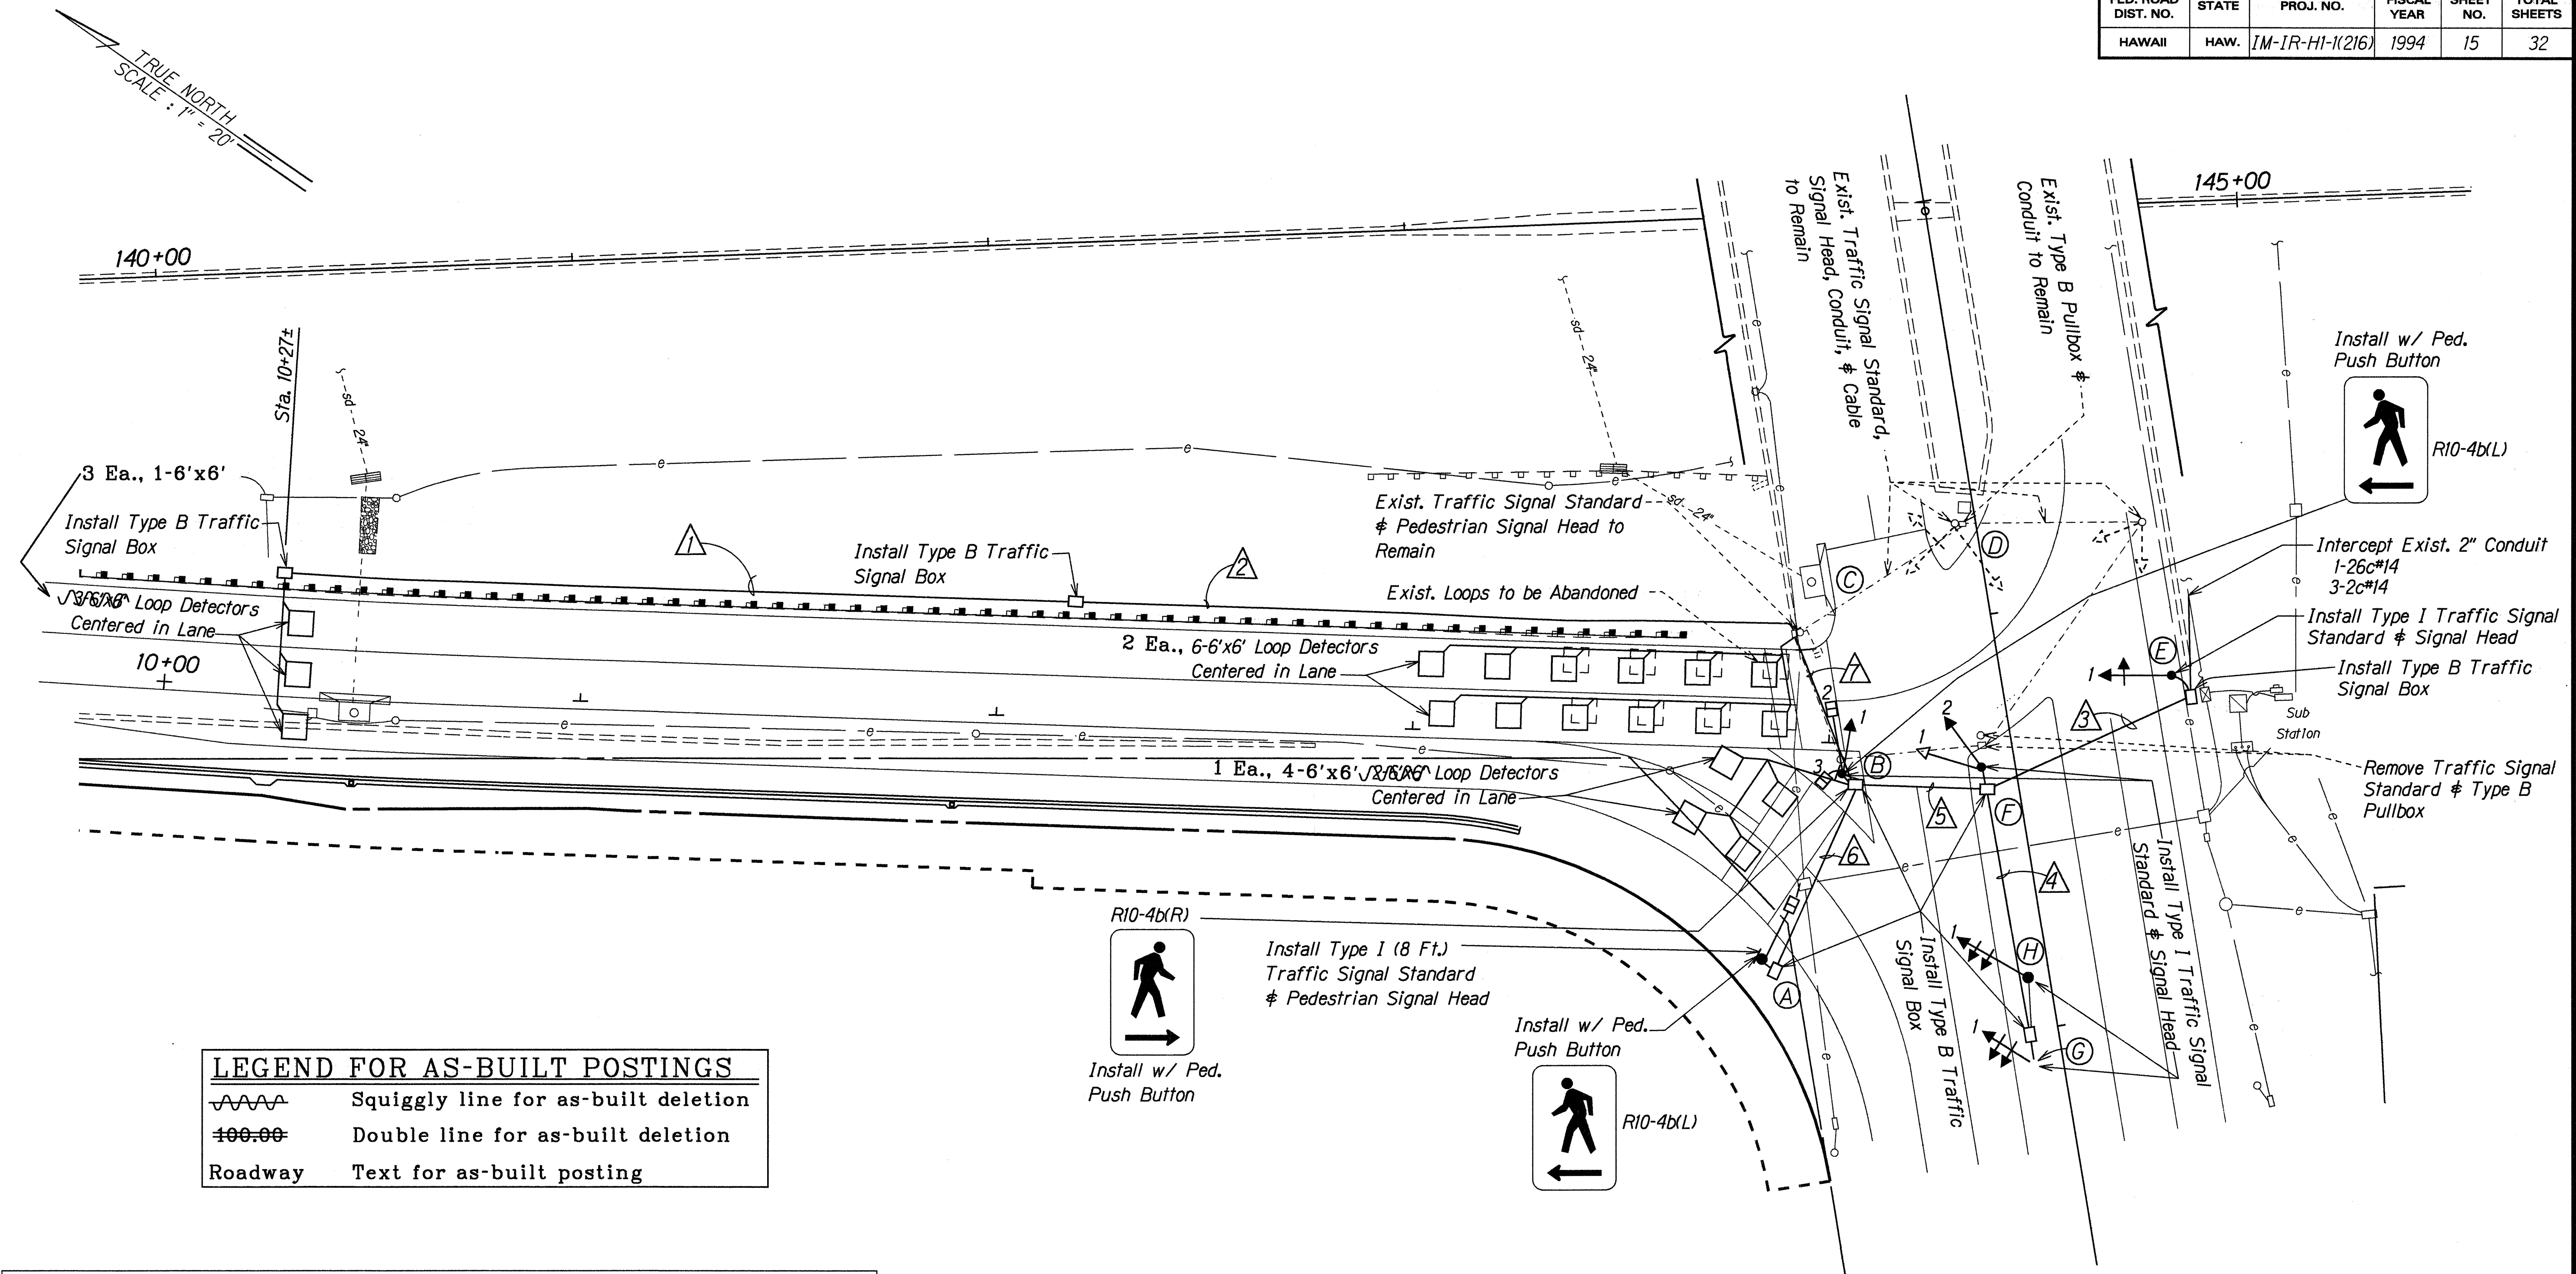
INTERSTATE ROUTE H-1

Eastbound Off Ramp Improvements  
at Pali Highway  
Project No. IM-IR-HI-1(216)

Scale: 1"=20'      Date: May, 1994

SHEET No. 14 OF 10 SHEETS

FED. ROAD DIST. NO.	STATE	FED. AID PROJ. NO.	FISCAL YEAR	SHEET NO.	TOTAL SHEETS
HAWAII	HAW.	IM-IR-HI-1(216)	1994	15	32



LEGEND FOR AS-BUILT POSTINGS	
	Squiggly line for as-built deletion
	Double line for as-built deletion
Roadway	Text for as-built posting

TRAFFIC SIGNAL HEAD SCHEDULE					
Traffic Signal Head Type and Description					
Pole Letter Signal Head Number	F-1	B-1 F-2	E-1	G-1 H-1	A-1 B-2 B-3
* With Programmed Visibility					

TRAFFIC SIGNAL SYSTEM CONDUIT AND CABLE SCHEDULE							
	DELTA ITEM NO. (Δ)						
	Δ1	Δ2	Δ3	Δ4	Δ5	Δ6	Δ7
QUANTITY OF 2" C, SEE NOTE NO. 1	1	1	2	2	2	1	3
SPARE				1			1
QUANTITY OF 26/C #14 CONTROL CABLE			1	1	1	1	1
QUANTITY OF 2/C #14 SHIELDED LOOP DETECTOR AND PEDESTRIAN PB CABLE	1	1	3		3	1	3
NOTE: 1. ALL CONDUITS SHALL BE SCHEDULE 80 PVC, UNLESS OTHERWISE NOTED.							

1/10/95	Revise location on new traffic signal standard and add an additional standard. Revise conduit & cable schedule.
DATE	REVISION

STATE OF HAWAII DEPARTMENT OF TRANSPORTATION HIGHWAYS DIVISION
<b>TRAFFIC SIGNAL PLAN</b>
<b>INTERSTATE ROUTE H-1</b>
Eastbound Off Ramp Improvements at Pali Highway F. A. Project No. IM-IR-HI-1(216)
Scale: 1"=20' Date: Jan. 1992
SHEET No. T7 OF 10 SHEETS

ORIGINAL PLAN	DATE
DESIGNED BY	3/94
NOTED BY	
CHECKED BY	
APPROVED BY	