



| FED. ROAD DIST. NO. | STATE | FED. AID PROJ. NO. | FISCAL YEAR | SHEET NO. | TOTAL SHEETS |
|---------------------|-------|--------------------|-------------|-----------|--------------|
| HAWAII              | HAW.  | IM-IR-H1-1(216)    | 1994        | 4         | 32           |

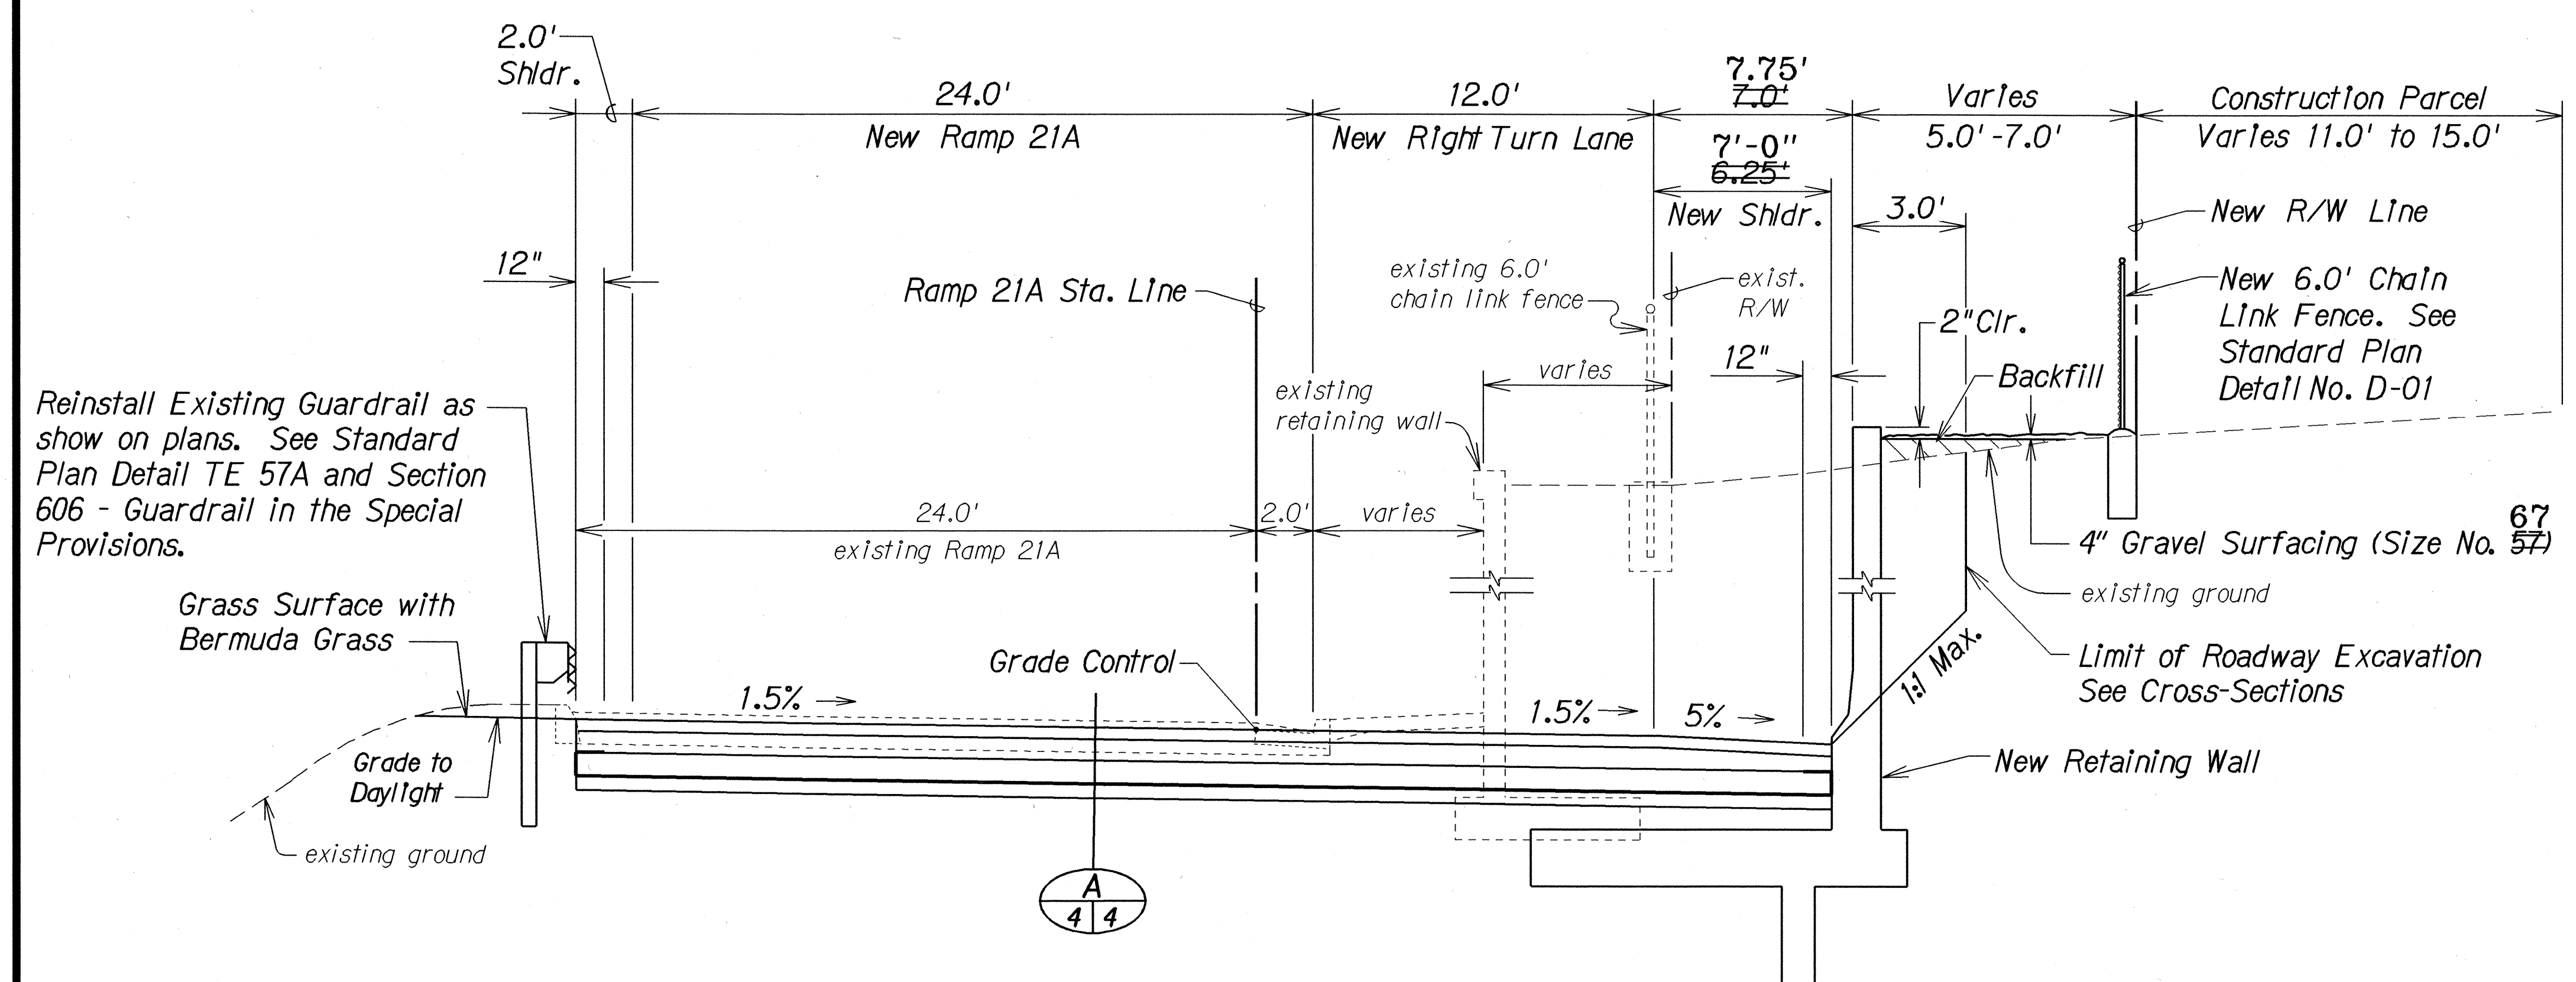


Reinstall Existing Guardrail as show on plans. See Standard Plan Detail TE 57A and Section 606 - Guardrail in the Special Provisions.

Note:  
1. The Gravel Surfacing shall meet the Requirements specified in Subsection 703.02 - Coarse Aggregate for Concrete.

**TYPICAL SECTION - RAMP 21A**  
Scale: 1/4" = 1' - 0"

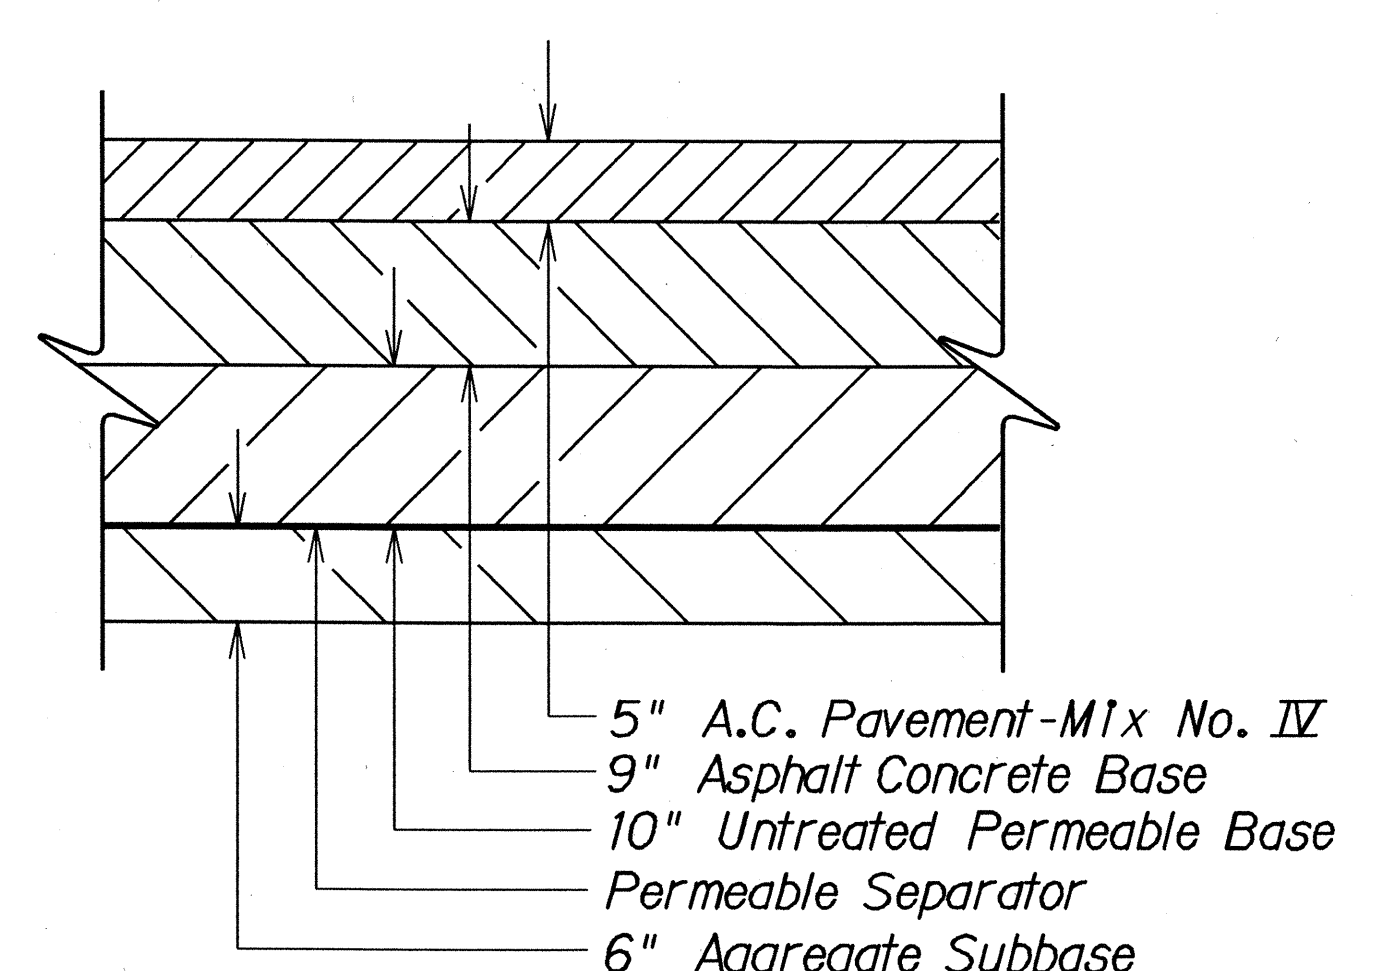

**DETAIL**  
Scale: 1" = 1' - 0"

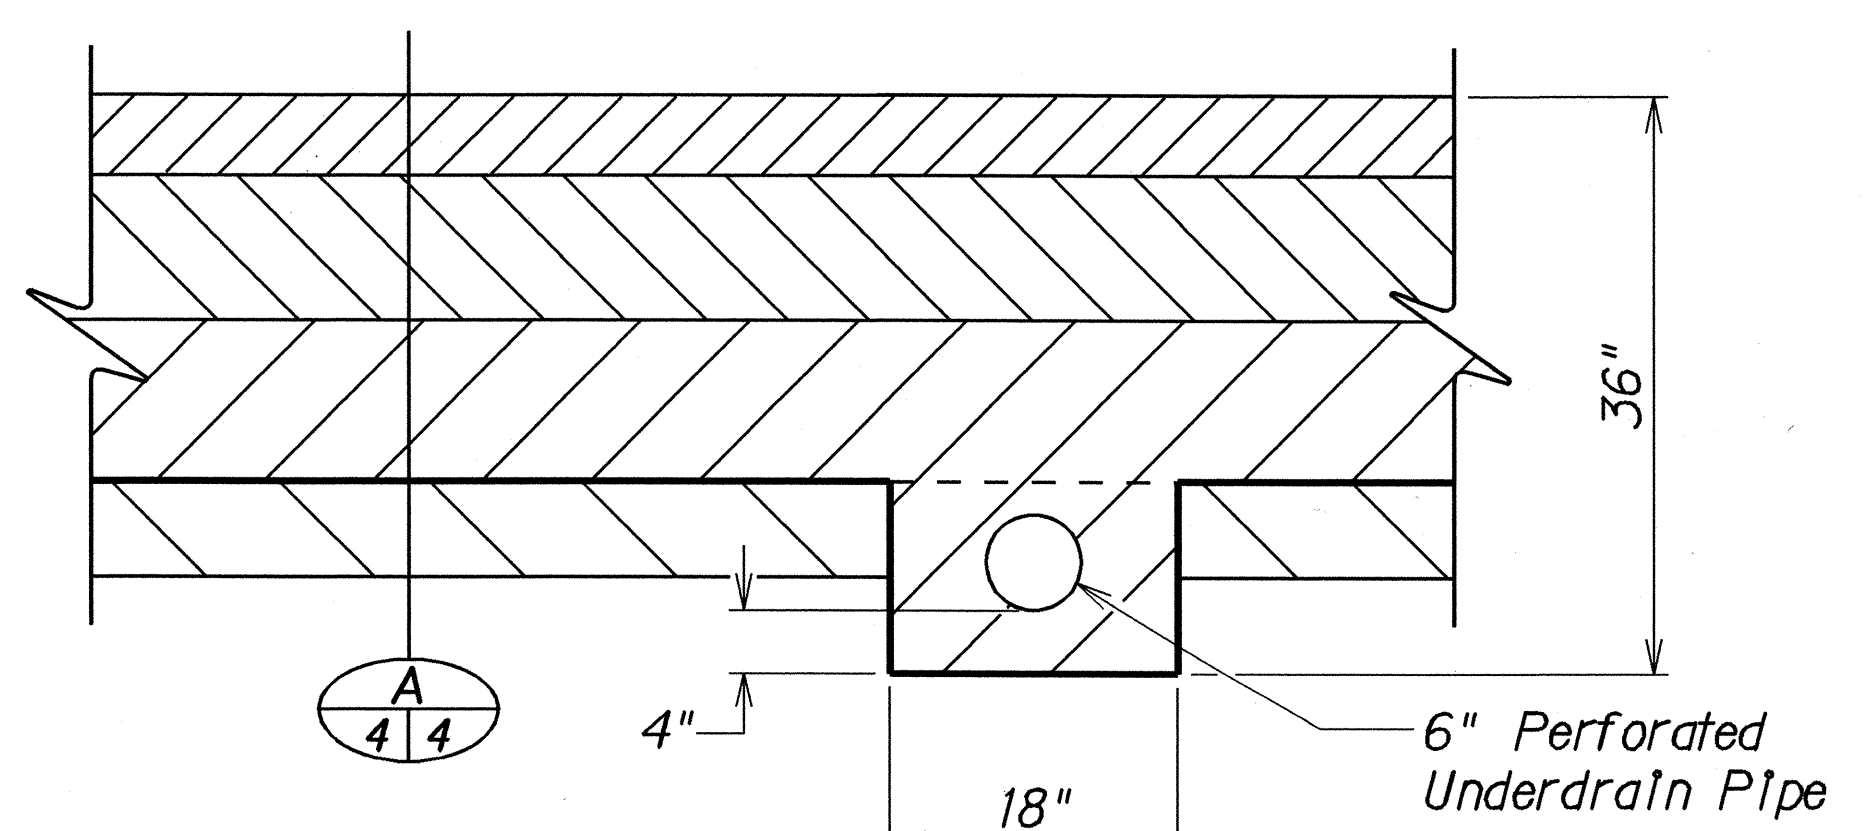


**TYPICAL DETAILS FOR TRANSVERSE DRAINS**  
AT STA. 7+40± & STA. 10+45±  
Scale: 1" = 1' - 0"

| LEGEND FOR AS-BUILT POSTINGS |                                     |
|------------------------------|-------------------------------------|
|                              | Squiggly line for as-built deletion |
|                              | Double line for as-built deletion   |
| Roadway                      | Text for as-built posting           |

| 6-6-94                                                                                                                                                                                                                                                           | Revised Typical Section and Added Note 1 per Addendum No. 1. |
|------------------------------------------------------------------------------------------------------------------------------------------------------------------------------------------------------------------------------------------------------------------|--------------------------------------------------------------|
| DATE                                                                                                                                                                                                                                                             | REVISION                                                     |
| STATE OF HAWAII<br>DEPARTMENT OF TRANSPORTATION<br>HIGHWAYS DIVISION<br><b>TYPICAL SECTIONS</b><br><b>INTERSTATE ROUTE H-1</b><br><b>Eastbound Off-Ramp Improvements</b><br><b>at Pal Highway</b><br><b>F.A. Project No. IM-IR-H1-1(216)</b><br>Date: Dec., 1992 |                                                              |
| SHEET No. 1 OF 1 SHEETS                                                                                                                                                                                                                                          |                                                              |




| FED. ROAD DIST. NO. | STATE | FED. AID PROJ. NO. | FISCAL YEAR | SHEET NO. | TOTAL SHEETS |
|---------------------|-------|--------------------|-------------|-----------|--------------|
| HAWAII              | HAW.  | IM-IR-HI-1(216)    | 1994        | ADD.4S-1  | 32           |

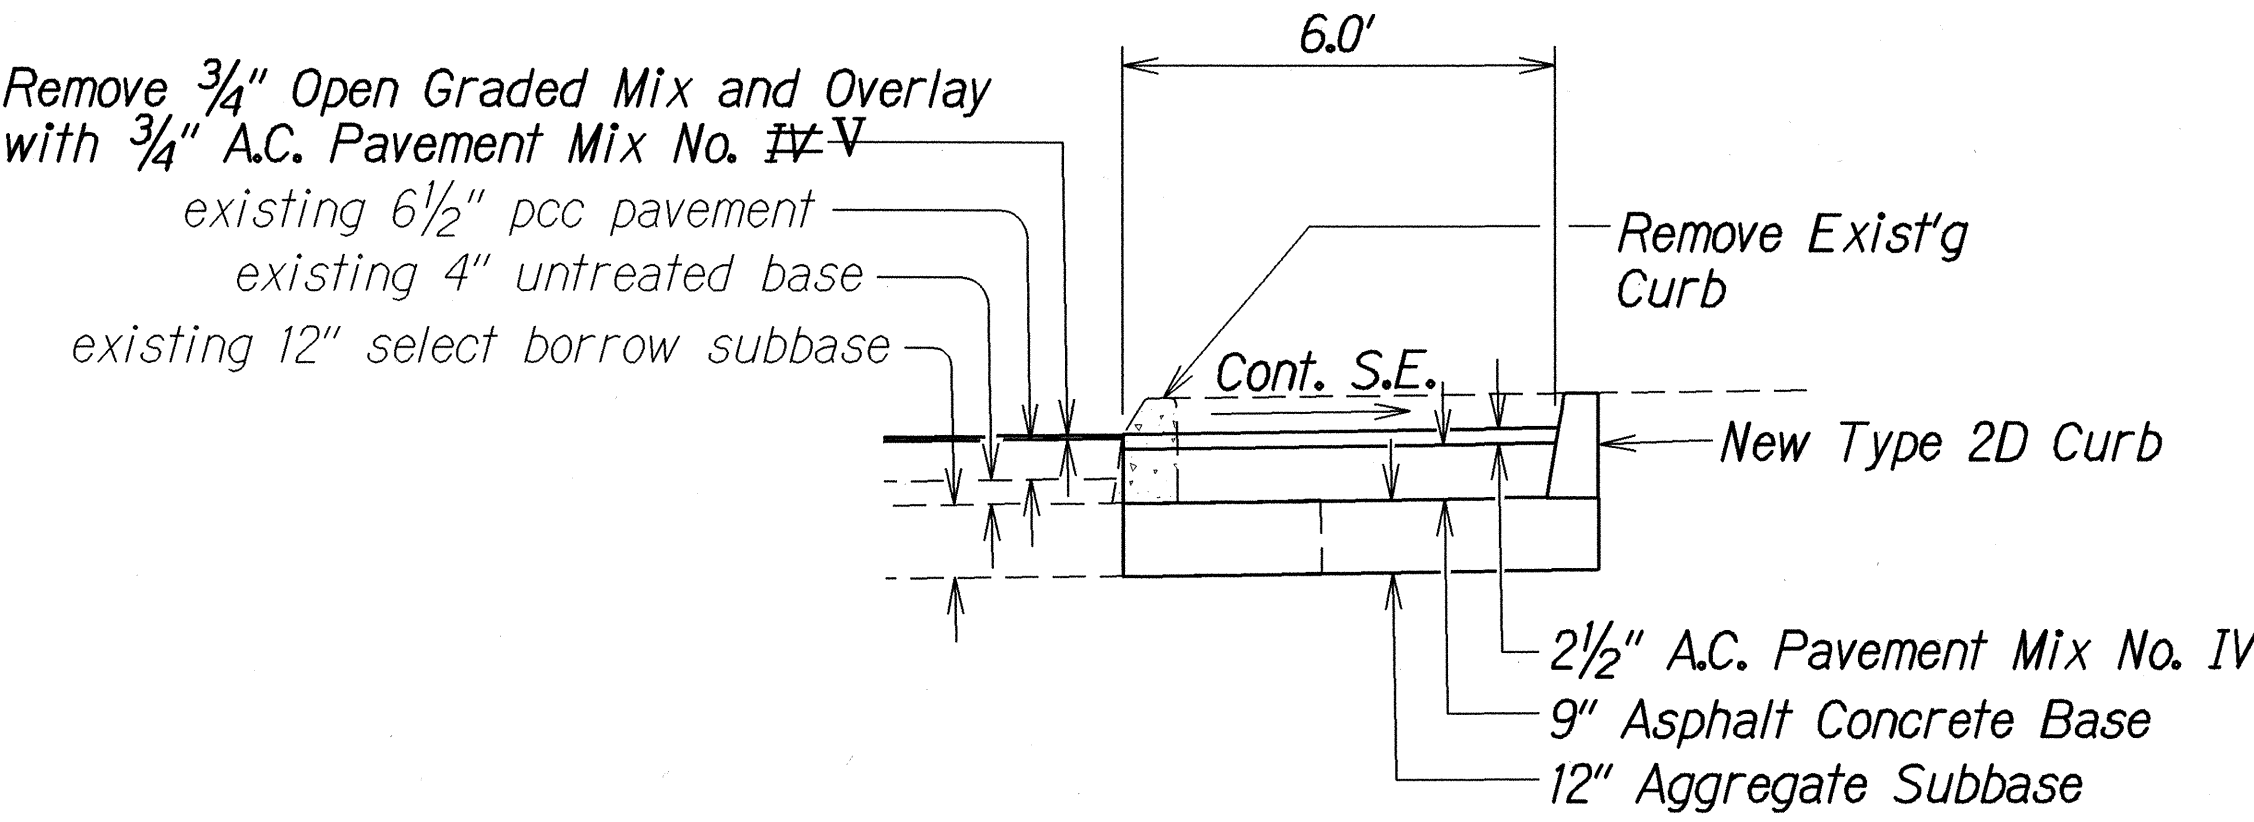

**MEDIAN OPENING DETAIL**

Scale: 3/8"=1'-0"

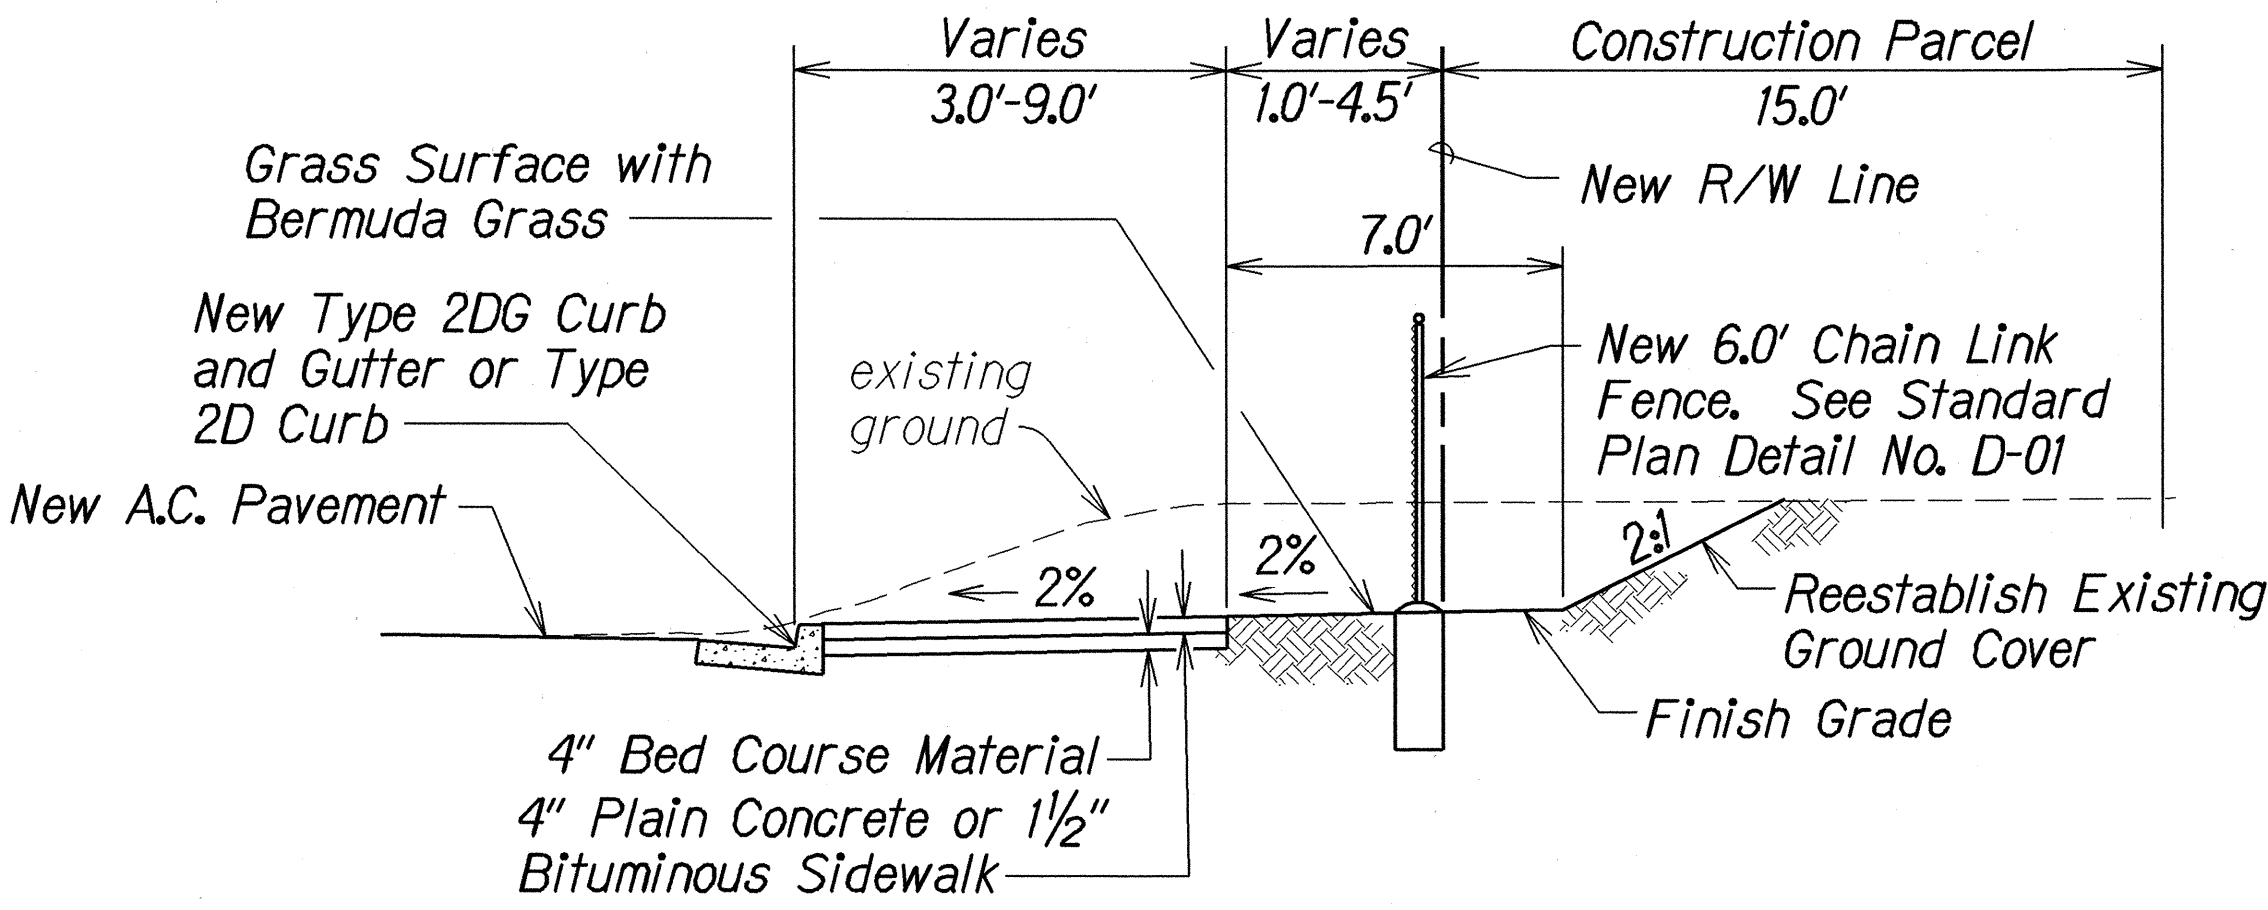

**TYPICAL SECTION - CURB RETURN**

Scale: 1/4"=1'-0"

| LEGEND FOR AS-BUILT POSTINGS |                                     |
|------------------------------|-------------------------------------|
|                              | Squiggly line for as-built deletion |
|                              | Double line for as-built deletion   |
| Roadway                      | Text for as-built posting           |

6-13-94      Added Sheet per Addendum No. 1

DATE      REVISION

STATE OF HAWAII  
DEPARTMENT OF TRANSPORTATION  
HIGHWAYS DIVISION

**TYPICAL SECTIONS**  
INTERSTATE ROUTE H-1  
Eastbound Off-Ramp Improvements  
at Pali Highway  
F.A. Project No. IM-IR-HI-1(216)

Date: June, 1994

SHEET No. 1 OF 1 SHEETS

|               |                   |      |
|---------------|-------------------|------|
| ORIGINAL PLAN | SURVEY PLOTTED BY | DATE |
| NOTE BOOK     | DESIGNED BY       |      |
| QUANTITIES BY | CHECKED BY        |      |
| IN.           |                   |      |

AS-BUILT

ADD. 4S-1