


FED. ROAD DIST. NO.	STATE	PROJ. NO.	FISCAL YEAR	SHEET NO.	TOTAL SHEETS
HAWAII	HAW.	HIK-01-94M	1994	6	6

LEGEND




4 each Type A Raised Pavement Markers  
Type C Raised Pavement Markers @ 40'-0" o.c.

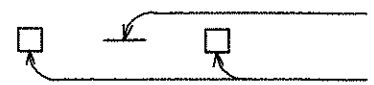

4 each Type J Raised Pavement Markers  
Type D Raised Pavement Markers @ 40'-0" o.c.



8" White Stripe with Type C Raised Pavement  
Markers @ 20'-0" o.c. (Tape, Type I or  
Thermoplastic Extrusion)

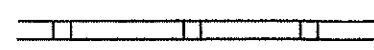

4" Double Solid Yellow with Type D  
Raised Pavement Markers @ 20'-0" o.c.  
(Tape, Type I or Thermoplastic Extrusion)




4" Double Solid Yellow Stripes with Type H  
Raised Pavement Markers @ 20'-0" o.c.  
(Tape, Type II or Thermoplastic Extrusion)



4" Yellow Edge Stripe with Type H Raised  
Pavement Markers @ 40'-0" o.c.  
(Tape, Type II or Thermoplastic Extrusion)




4" Double Solid White Stripes with Type C  
Raised Pavement Markers @ 20'-0" o.c.  
(Tape, Type I or Thermoplastic Extrusion)

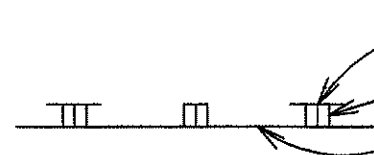


Lane Change Restriction Marking  
4 each Type A Raised Pavement Markers  
Type C Raised Pavement Markers @ 20'-0" o.c.  
4" White Stripe (Tape, Type I or Thermoplastic  
Extrusion)




4" or 8" White Edge Stripe with Type C Raised  
Pavement Markers @ 40'-0" o.c. (Tape, Type II or  
Thermoplastic Extrusion)

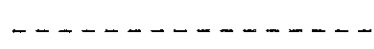


4" White Guide Lines (Tape, Type III or  
Thermoplastic Extrusion except for bus bays)

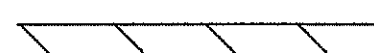


Transverse Median Marking (Tape, Type II or  
Thermoplastic Extrusion)

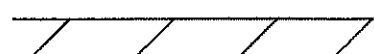

Transverse Shoulder Marking (Tape, Type II or  
Thermoplastic Extrusion)

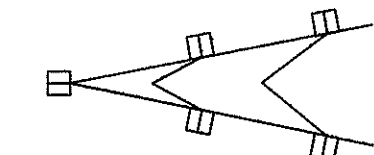

Channelizing Island or Deceleration Lane Gore  
(Tape, Type II or Thermoplastic Extrusion)

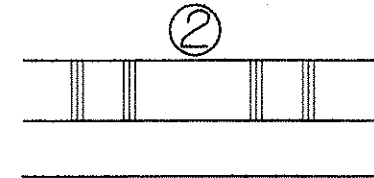


Crosswalk and Stop Line. All Stop Lines  
shall be 10'-0" from Crosswalk unless  
otherwise noted. The circled number  
indicates the number of lanes for payment  
(Tape, Type III or Thermoplastic Extrusion)




Pavement Arrow (Tape, Type III or Thermoplastic  
Extrusion)

STOP

Pavement Word (Tape, Type III or Thermoplastic  
Extrusion)

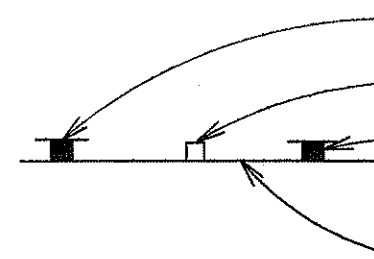

4 Each Type J Raised Pavement Markers  
Type D Raised Pavement Markers @ 40'-0" o.c.  
Type H Raised Pavement Markers (Reflective  
Surface facing no-passing direction)  
4" Single Solid Yellow Stripe (Tape, Type I or  
Thermoplastic Extrusion)

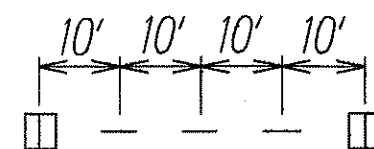

Extension of Edge Line, 4" Wide x 2'-0" Long White  
Stripe @ 10'-0" o.c. w/Type C Markers @ 40'-0" o.c.  
(Tape, Type III or Thermoplastic Extrusion)

NOTES

- Layout of pavement markings and striping shall be done by the Contractor and approved by the Engineer prior to any installation work.
- Existing pavement markings not incorporated in the final traffic pattern shall be removed as directed by the Engineer. Costs shall be incidental to the various pavement marking items.
- Raised pavement markers shall not be installed within crosswalks.
- Final locations of all signs shall be approved by the Engineer prior to any installation work.
- Existing signs not shown on these plans shall remain as posted unless otherwise directed by the Engineer. Removal and disposal of existing signs and/or posts as designated on these plans shall be incidental to the various signing items.
- Final locations of all Stop Lines shall be approved by the Engineer prior to installation.
- All pavement striping shall be as noted on the Legend or plans.
- All preformed pavement marking tapes over existing pavement shall be applied with an approved primer as recommended by the tape manufacturer and as approved by the Engineer. The primer shall be allowed to dry to the tacky stage prior to tape application.
- Quantities of new pavement markings and striping are estimates for bid purposes only. Actual pavement marker type or stripe and respective quantities shall be verified in the field by the contractor prior to spall repair work and approved by the Engineer.

CONSTRUCTION SIGN SUMMARY

SIGN NO.	LOCATION	MESSAGE	W/POST
CG20-2	Ramp WA $\pm$ Sta. (-)1+40 $\pm$ Lt.	END CONSTRUCTION	1
CG20-2	$\pm$ Sta. 136+06 $\pm$ Lt.	END CONSTRUCTION	1
CG20-1d	$\pm$ Sta. 136+06 $\pm$ Rt.	ROAD CONSTRUCTION AHEAD	1
CG20-2	$\pm$ Sta 167+63 $\pm$ Rt.	END CONSTRUCTION	1
CG20-1d	$\pm$ Sta 167+63 $\pm$ Lt.	ROAD CONSTRUCTION AHEAD	1
		TOTAL	5

PAVEMENT MARKING SUMMARY

DESCRIPTION	QUANTITY
PAVEMENT MARKERS	
TYPE A	800 EA.
TYPE C	200 EA.
TYPE H	110 EA.
TAPE - TYPE II OR THERMOPLASTIC EXTRUSION	
4-INCH EDGE STRIPE (YELLOW)	4,320 L.F.
4-INCH EDGE STRIPE (WHITE)	4,320 L.F.

STATE OF HAWAII  
DEPARTMENT OF TRANSPORTATION  
HIGHWAYS DIVISION  
**PAVEMENT MARKING**  
**LEGEND, DETAILS & NOTES**  
INTERSTATE ROUTE H-1 WAIALAE VIADUCT  
Repair Expansion Joints  
Project No. HIK-01-94M

Scale: Not to Scale Date: Nov. 1993  
SHEET No. 11 OF 1 SHEETS