

| INDEX TO DRAWINGS | |
|-------------------|--|
| SHEET NO. | DESCRIPTION |
| 1 | TITLE SHEET |
| 2 | STANDARD PLAN SUMMARY |
| 3 | TYPICAL CONCRETE REPAIRS, GENERAL NOTES AND ESTIMATED QUANTITIES |
| 4 | PLAN - PEARL CITY VIADUCT |
| 5 | PLAN - AIRPORT VIADUCT |
| | |
| | |

STATE OF HAWAII

DEPARTMENT OF TRANSPORTATION
HIGHWAYS DIVISION
HONOLULU, HAWAII



"AS-BUILT"
PLANS FOR

**H-1 FREEWAY RESURFACING
PEARL CITY AND AIRPORT VIADUCTS**


PROJECT NO. H1-EG-01-95M

DISTRICT OF HONOLULU
ISLAND OF OAHU

| FED. ROAD DIST. NO. | STATE | PROJ. NO. | FISCAL YEAR | SHEET NO. | TOTAL SHEETS |
|------------------------|-------|--------------|----------------|--------------|-----------------|
| HAWAII | HAW. | H1-EG-01-95M | 1995 | 1 | 5 |

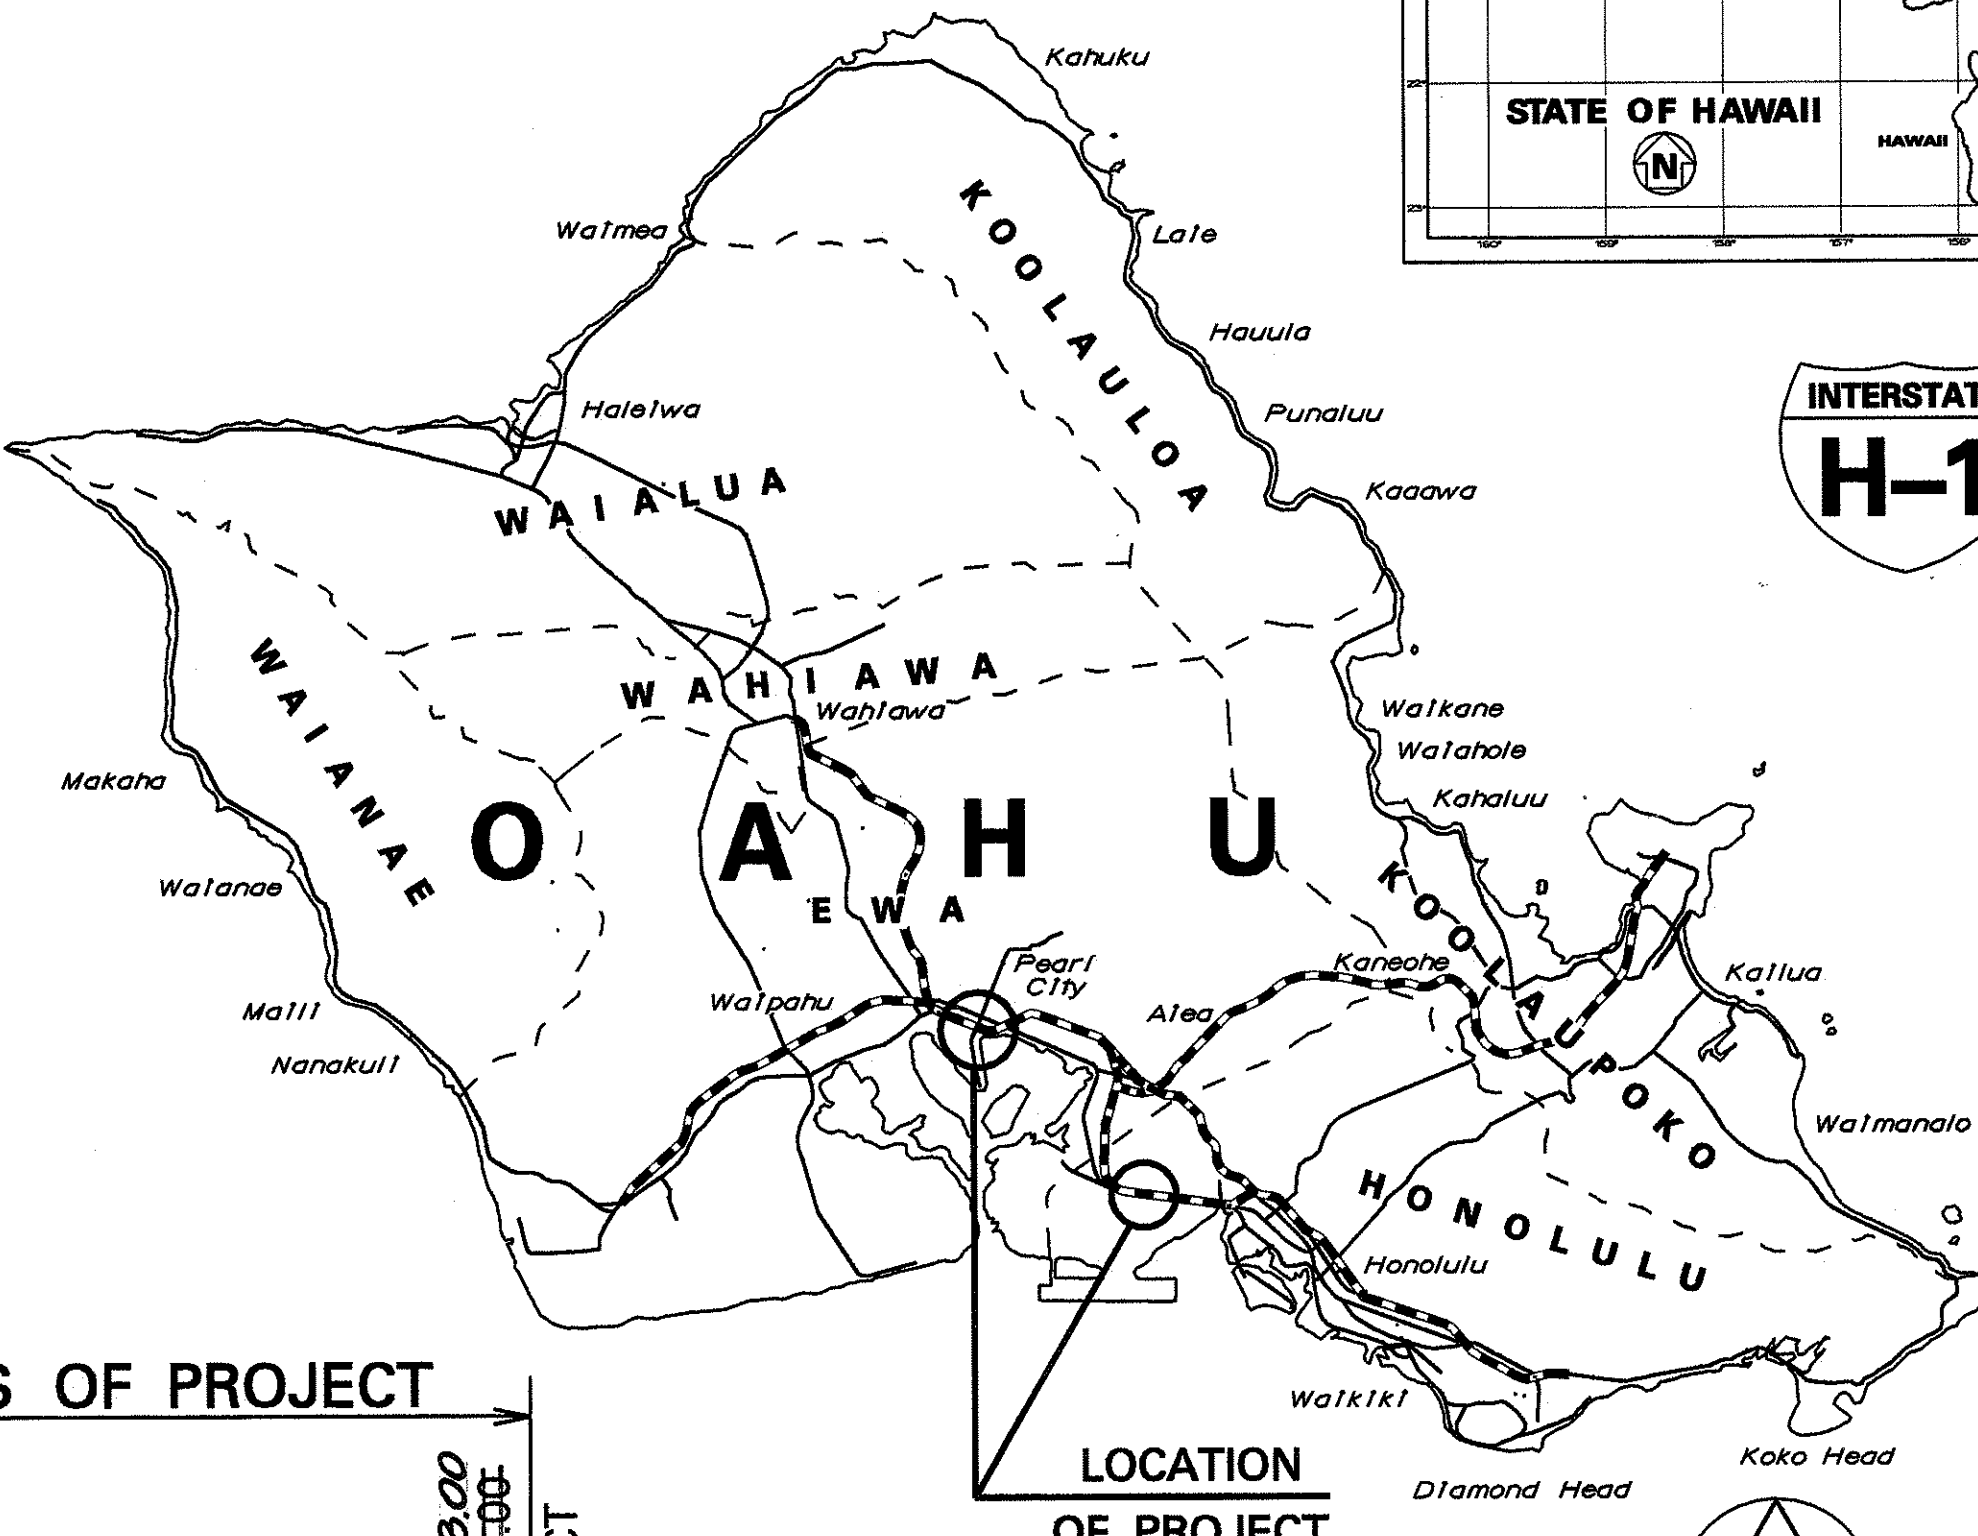
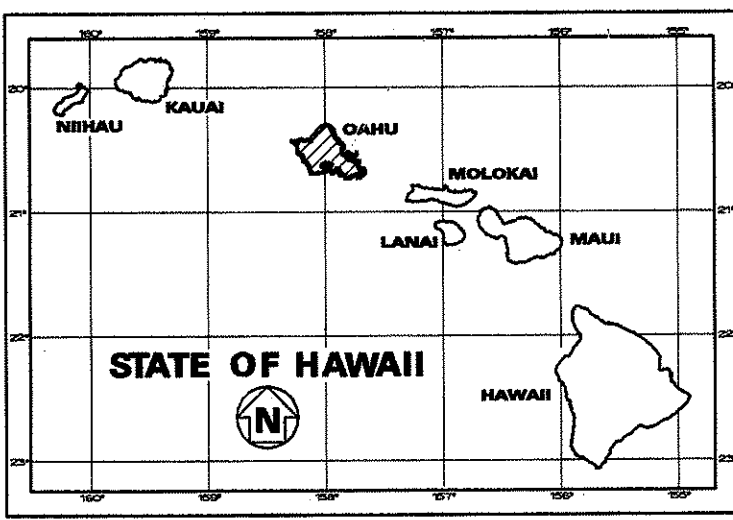


SCALE IN MILES

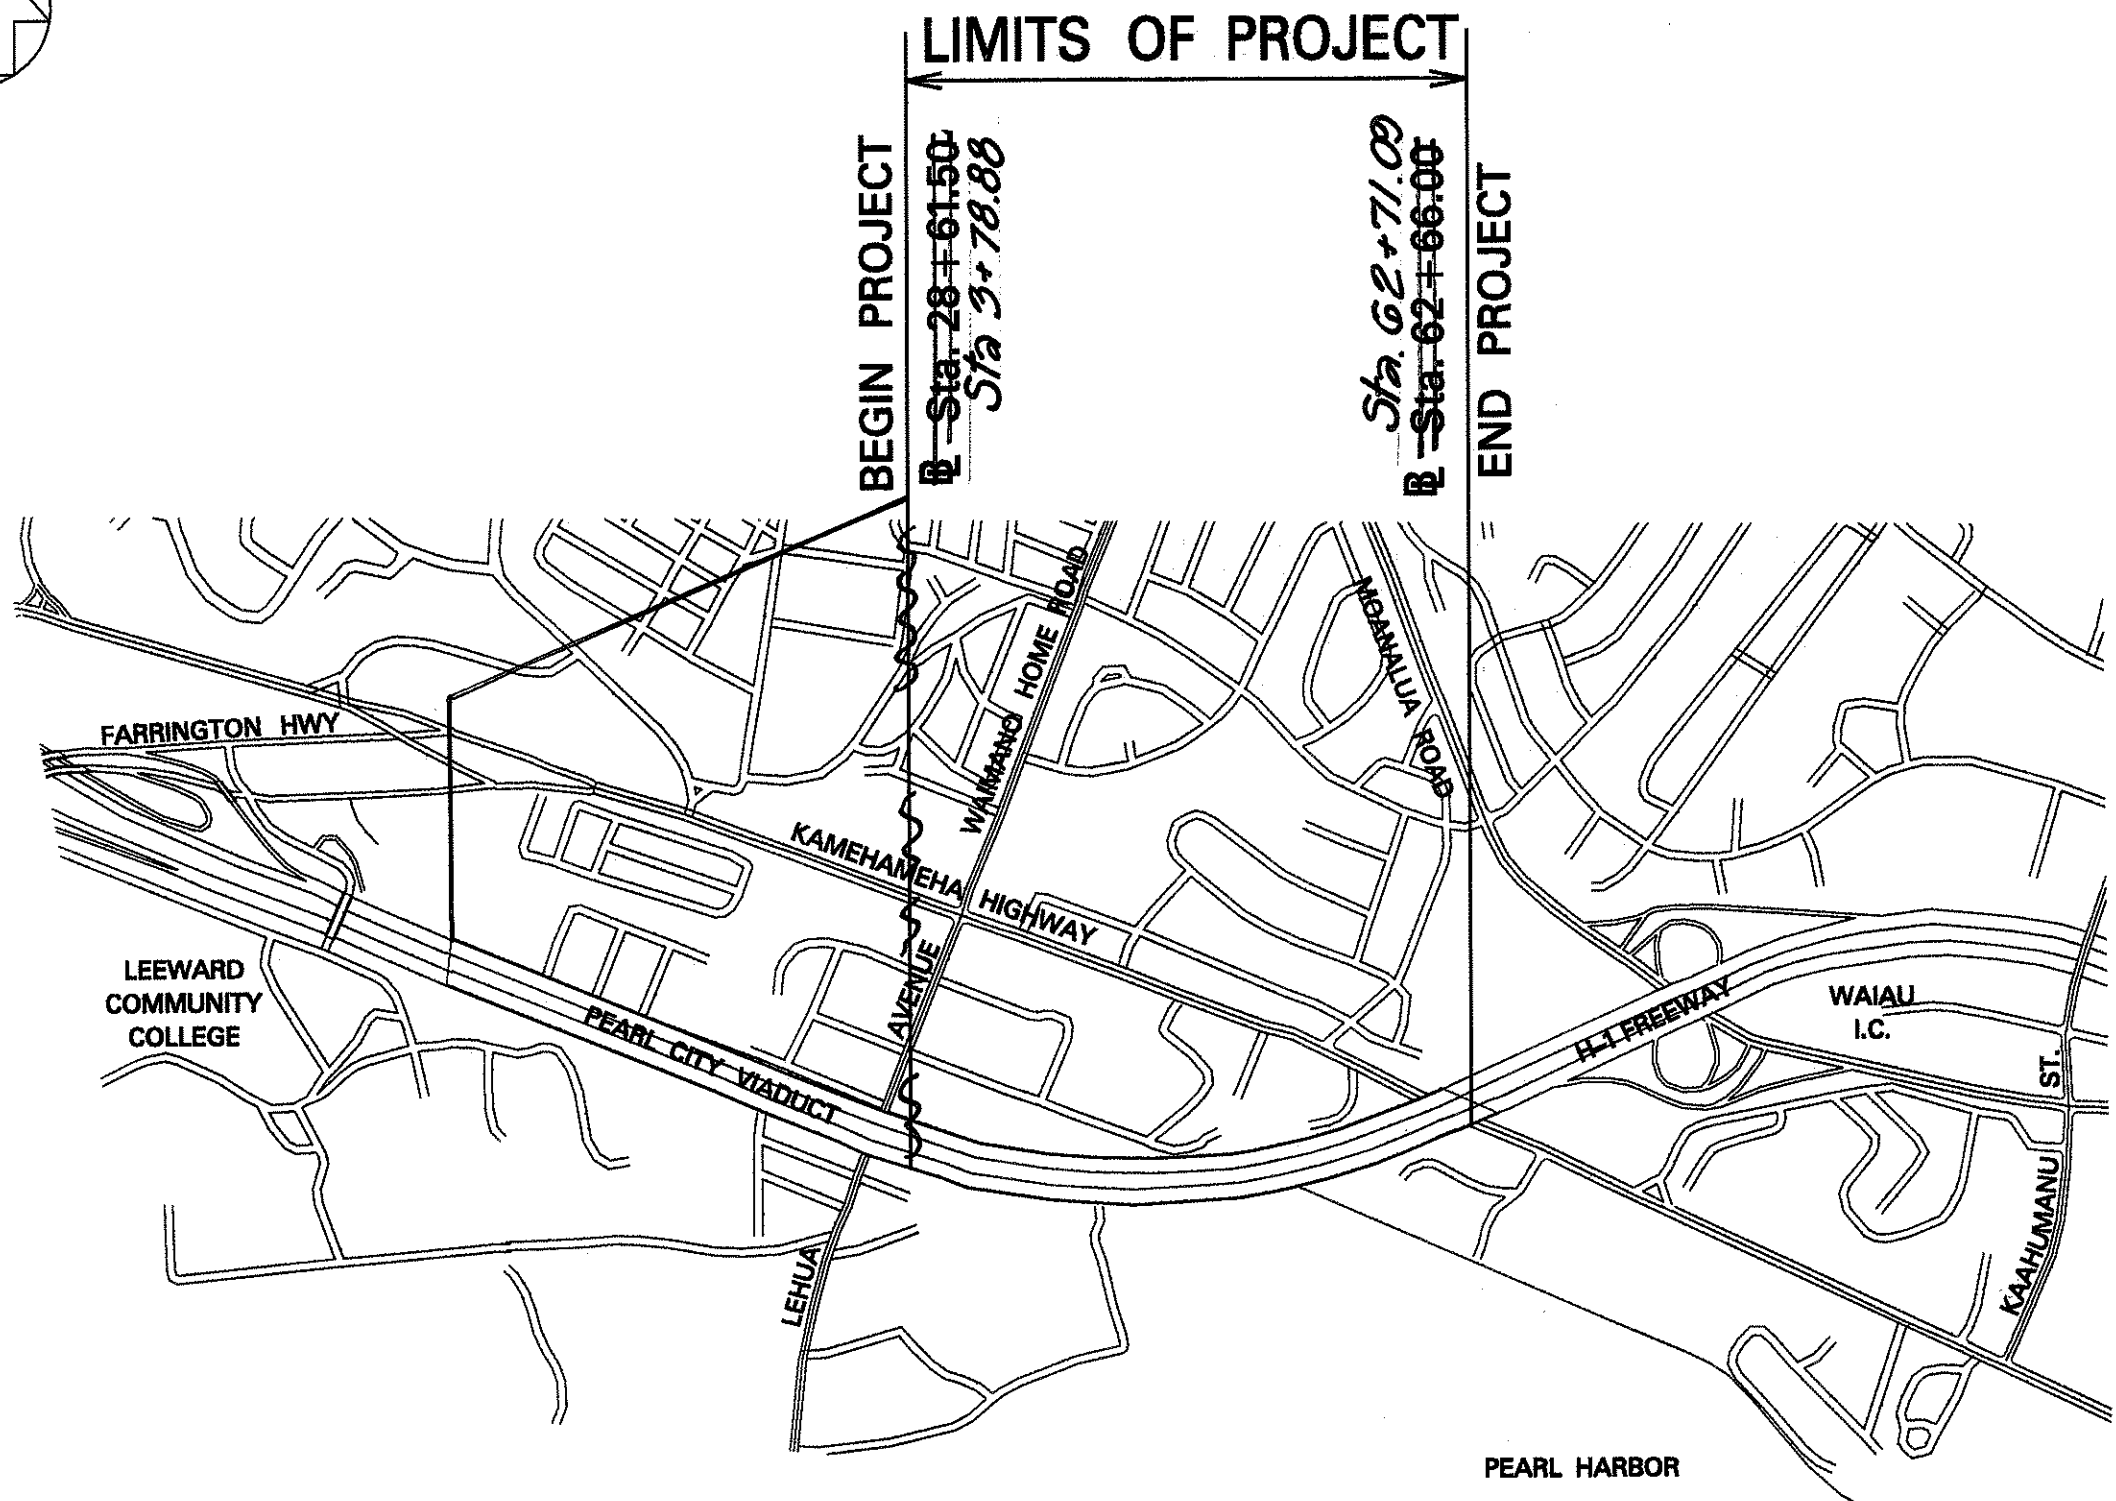


LAYOUT PLAN

GROSS LENGTH OF PROJECT.....1.10 MILES
NET LENGTH OF PROJECT.....1.10 MILES

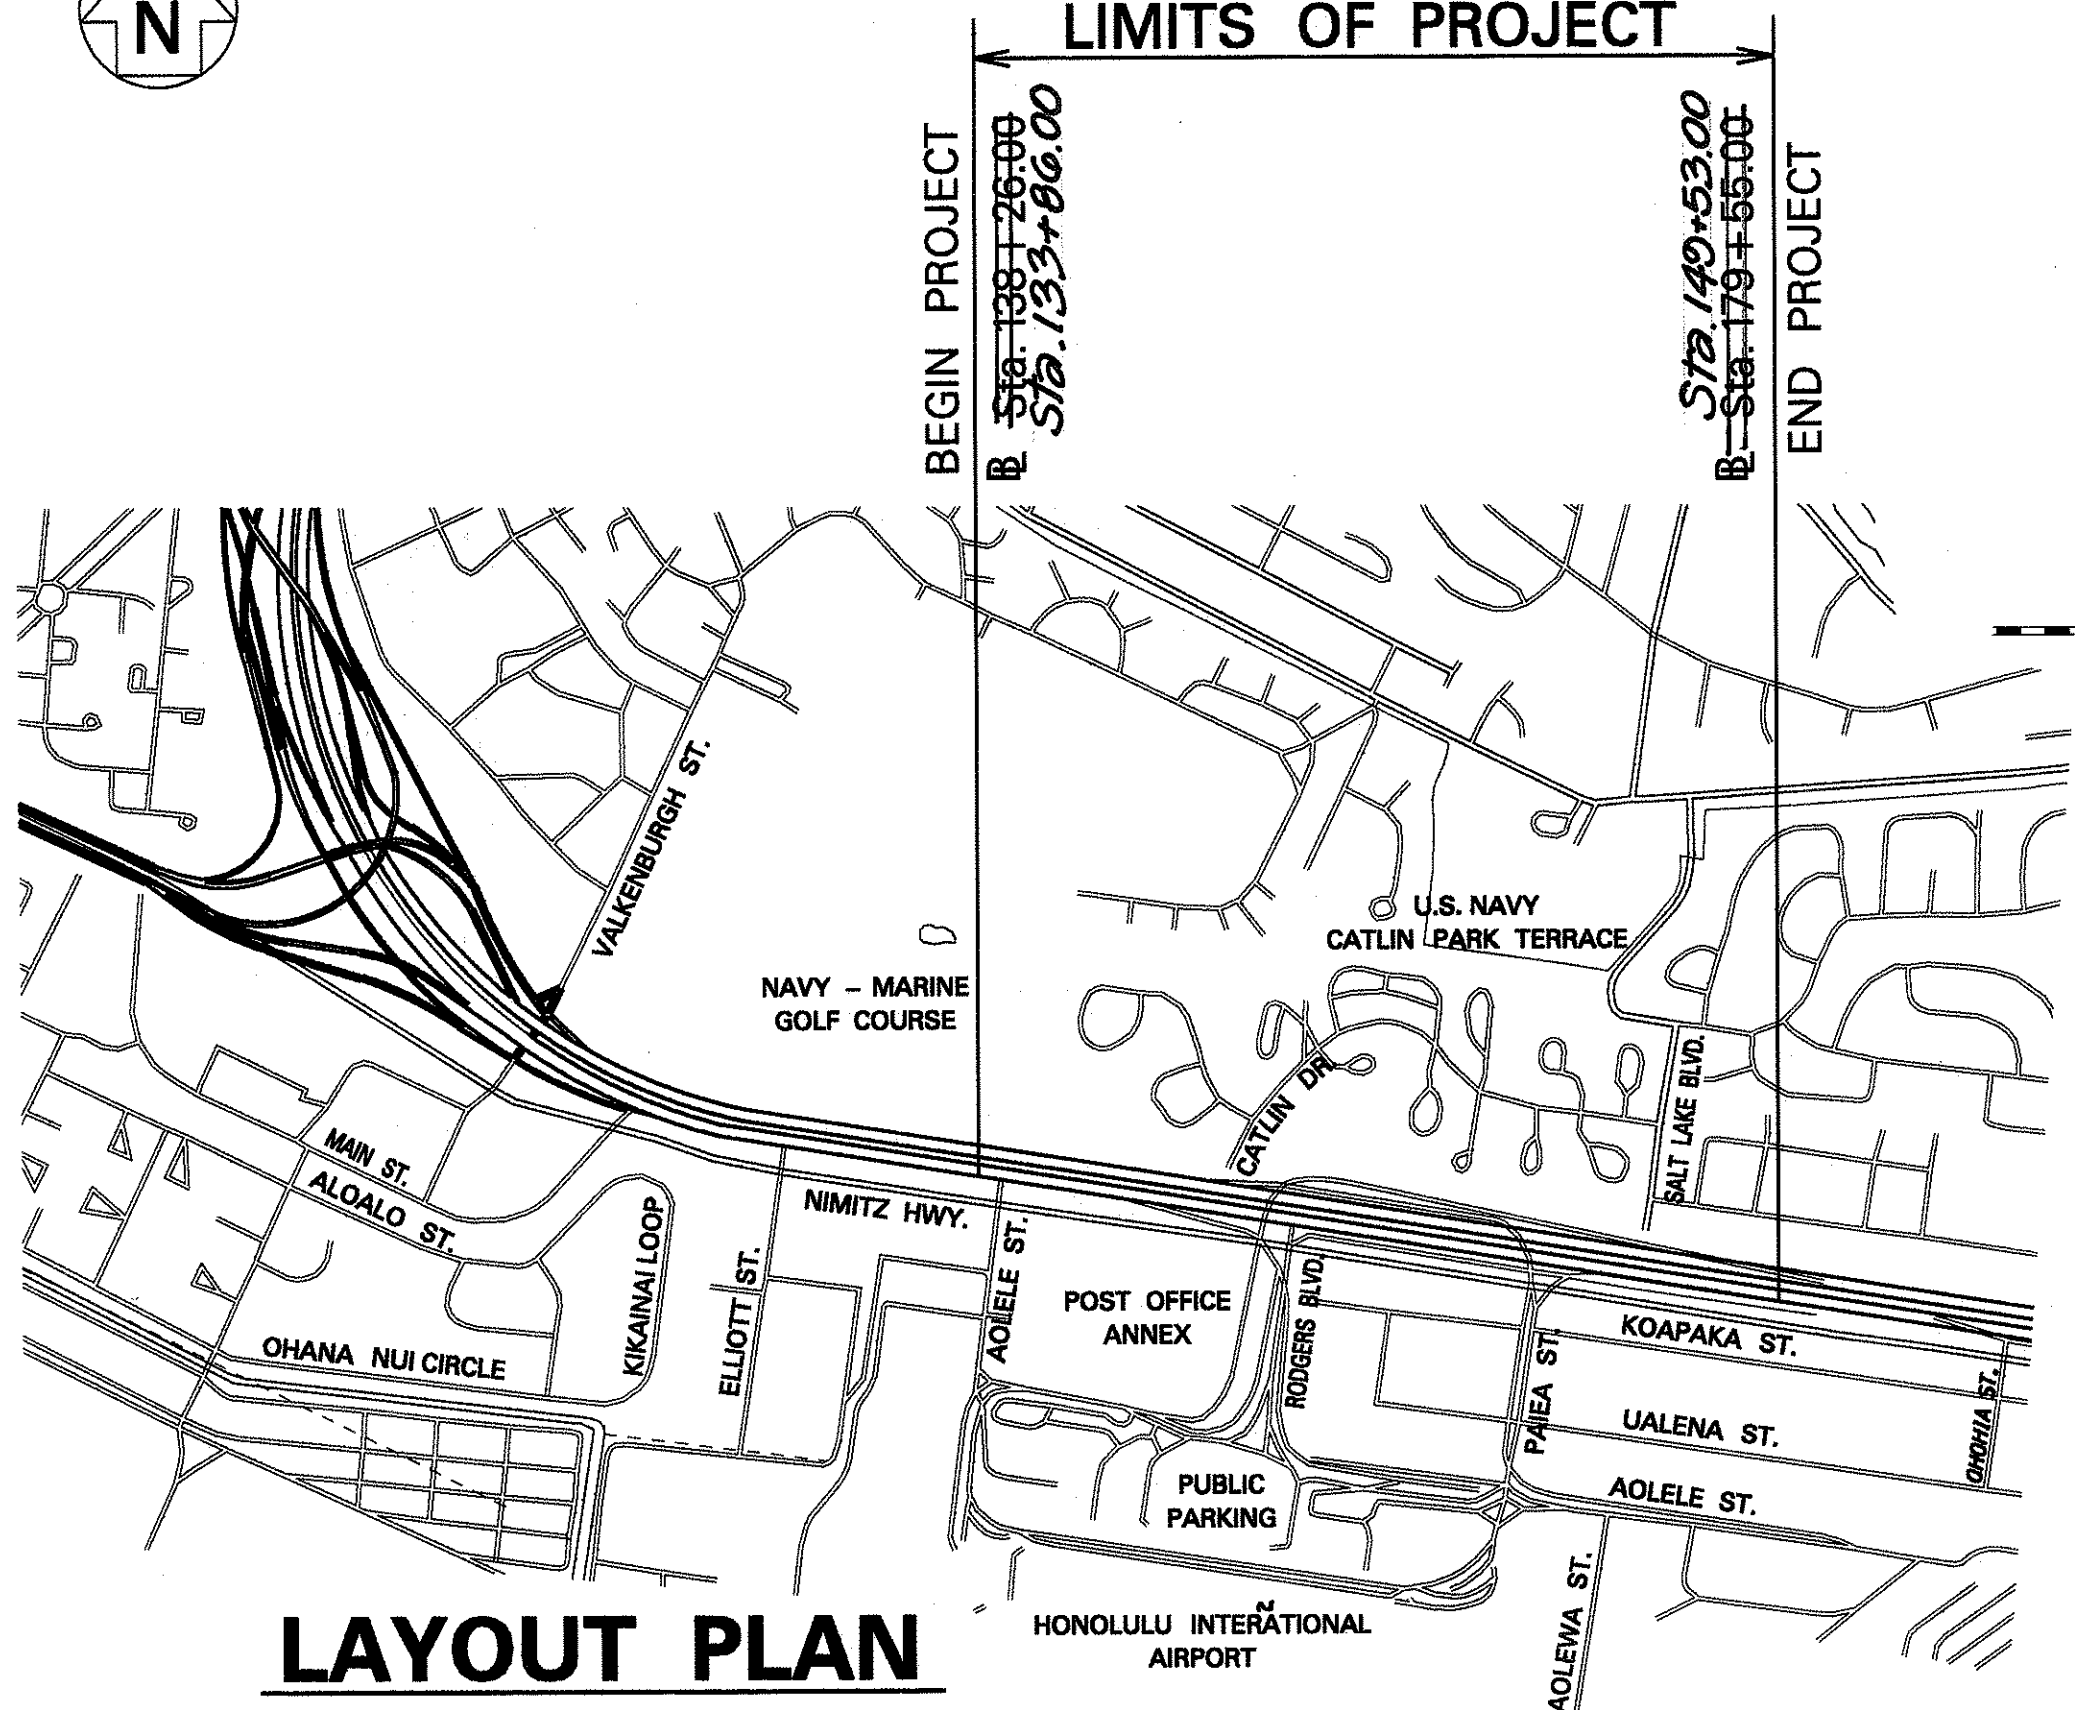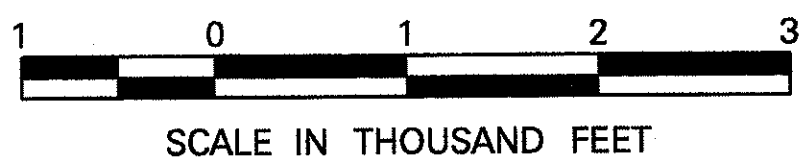

LAYOUT PLAN

GROSS LENGTH OF PROJECT.....0.78 MILES
NET LENGTH OF PROJECT.....0.78 MILES

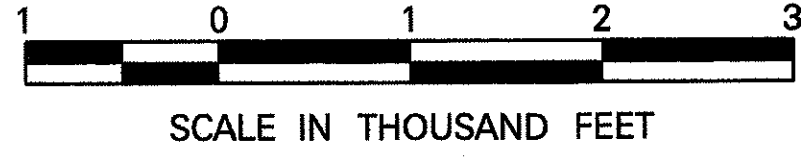

FEDERAL AID INTERSTATE PROJECTS PREVIOUSLY
CONSTRUCTED OR UNDER CONSTRUCTION

MILE POST 9.00 TO MILE POST 10.30
AND
MILE POST 16.23 TO MILE POST 17.00

CHANGES MADE DURING CONSTRUCTION HAVE BEEN
INCORPORATED ON THESE PLANS EXCEPT CHANGES
IN THE ORIGINAL THEORETICAL QUANTITIES. FOR
ACTUAL QUANTITIES, REFER TO PROJECT LEDGER
AND/OR COMPUTATION BOOK.

RESIDENT ENGINEER 11-19-01
DATE

| DEPARTMENT OF TRANSPORTATION STATE OF HAWAII | |
|---|---------|
| APPROVED: | 5/15/95 |
| DIR. OF TRANSPORTATION | DATE |

DESIGN UNIT "C"
DESIGNED BY

R. HIRONAKA
P. S. & E. BY

587-2250
PHONE

MARCH 1995
DATE