


FED. ROAD DIST. NO.	STATE	FED. AID PROJ. NO.	FISCAL YEAR	SHEET NO.	TOTAL SHEETS
HAWAII	HAW.	IM-HI-K(220)	1995	11	37

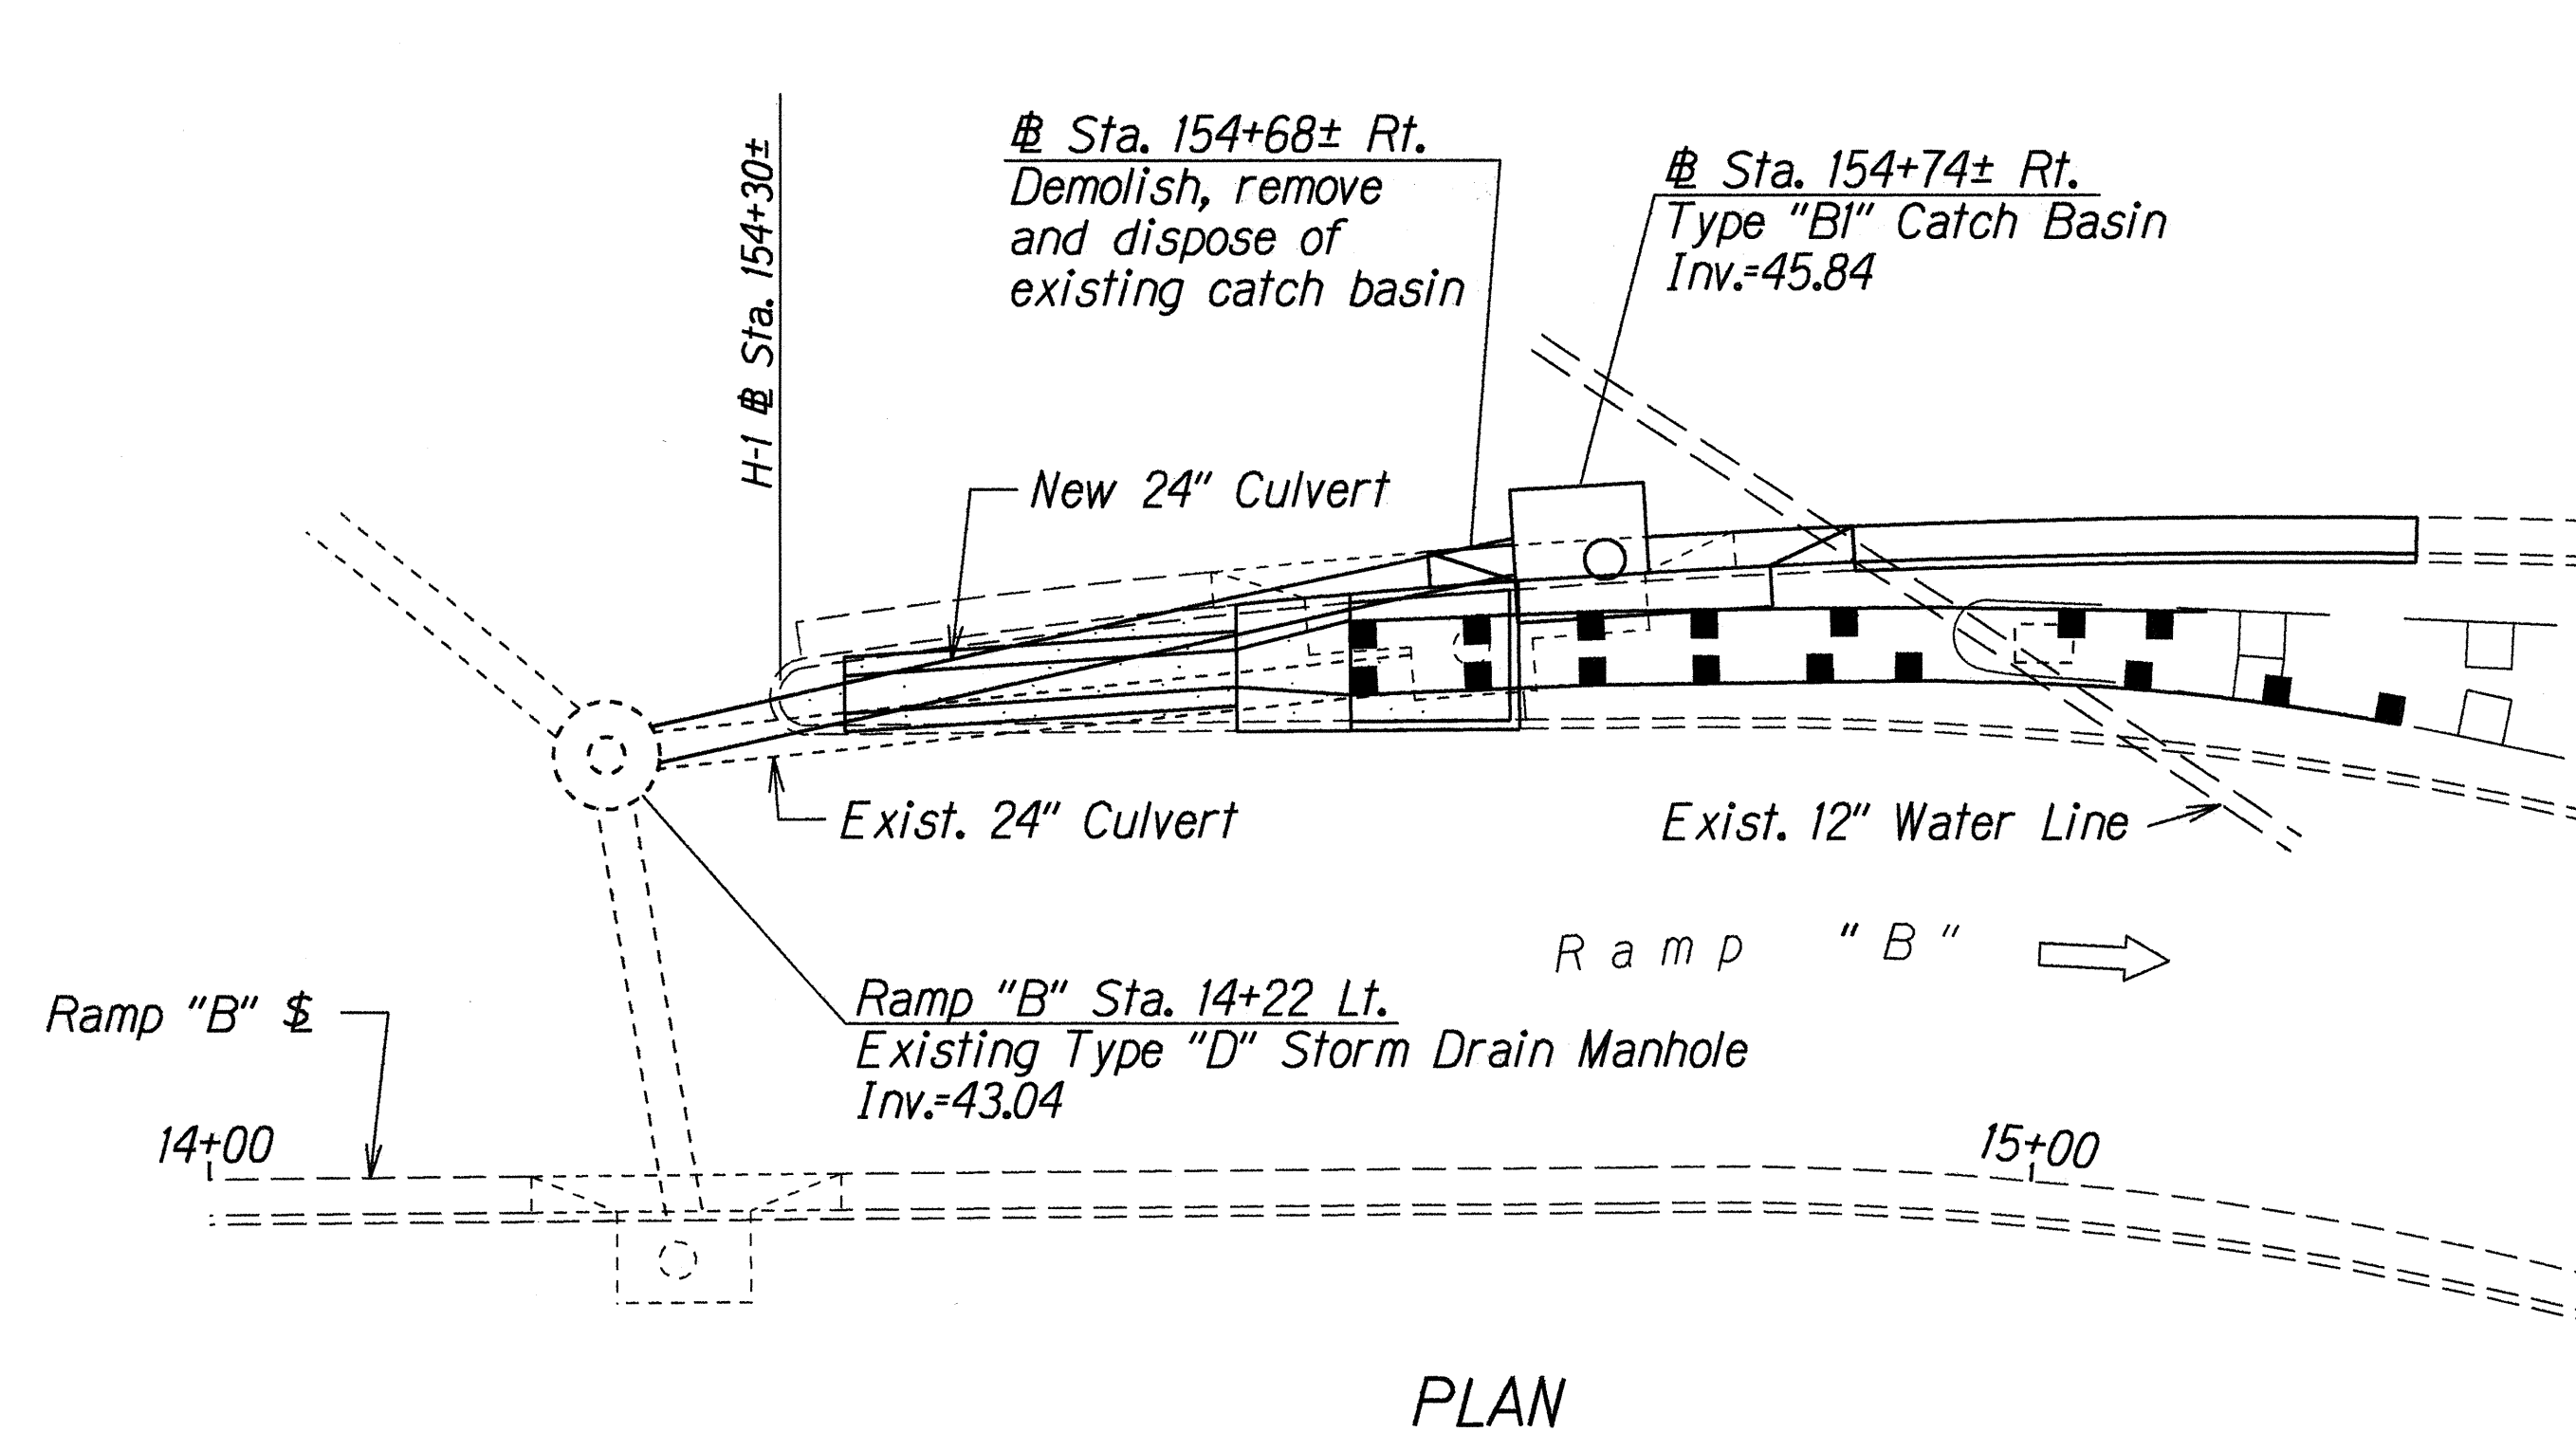

@ Sta. 154+74± Rt.
 Construct: Type "B1" Catch Basin
 Install: 24" RCP

Estimated Quantities
 Structure Excavation for
 Drainage System = 62 C.Y.
 24" RCP, Cl. III = 48 L.F.
 Type "B1" Catch Basin
 6.00 ft. to 6.99 ft. = 1 Ea.

RELOCATION OF CATCH BASIN TO @ STA. 154+74± RT.

SURVEY PLOTTED BY	DATE
DRAWN BY A. KAMURA	5/17/95
DESIGNED BY B. SAKAMOTO	
QUANTITIES BY	
CHECKED BY	
ORIGINAL PLAN	
NOTE BOOK	
dhia	
dhia	

6/21/96	Relocated catch basin.
DATE	REVISION
STATE OF HAWAII DEPARTMENT OF TRANSPORTATION HIGHWAYS DIVISION DRAINAGE DETAILS INTERSTATE ROUTE H-1 Pav't. Repair and Rehab. Kalihi St. to Vic. of Pali Hwy. and Kinau Off-Ramp F.A.I. Proj. No. IM-HI-K(220) Scale: 1"=10' Date: May 1995	
SHEET No. HI OF 1 SHEETS	