INDEX TO DRAWINGS			
SHEET NO.	DESCRIPTION		
1	TITLE SHEET		
2	STANDARD PLANS SUMMARY		
3	GENERAL NOTES AND LEGEND		
4	NPDES GENERAL NOTES		
5 – 8	TYPICAL SECTIONS AND DETAILS		
9 – 10	GUARDRAIL AND G.R.E.A.T. DETAILS		
① 11	DRAINAGE DETAILS		
12 – 22	ROADWAY PLANS		
23 – 37	PAVEMENT MARKING AND SIGNING PLANS, DETAILS AND SCHEDULES		
	· ·		
	^		

① Plan Sht. Nos. IIS-I and IIS-2 are Supplementary sheets to this project. TOTAL SHEET COUNT after "AS-BUILT" postings 39 Sheets.

SCALE IN HUNDRED FEET

STATE OF HAWAII

DEPARTMENT OF TRANSPORTATION

HIGHWAYS DIVISION HONOLULU, HAWAII


> "AS-BUILT" PLANS FOR

INTERSTATE ROUTE H-1

PAVEMENT REPAIR AND REHABILITATION KALIHI STREET TO VICINITY OF PALI HIGHWAY AND KINAU OFF-RAMP

F. A. I. PROJECT NO. IM-H1-1(220)


DISTRICT OF HONOLULU ISLAND OF OAHU

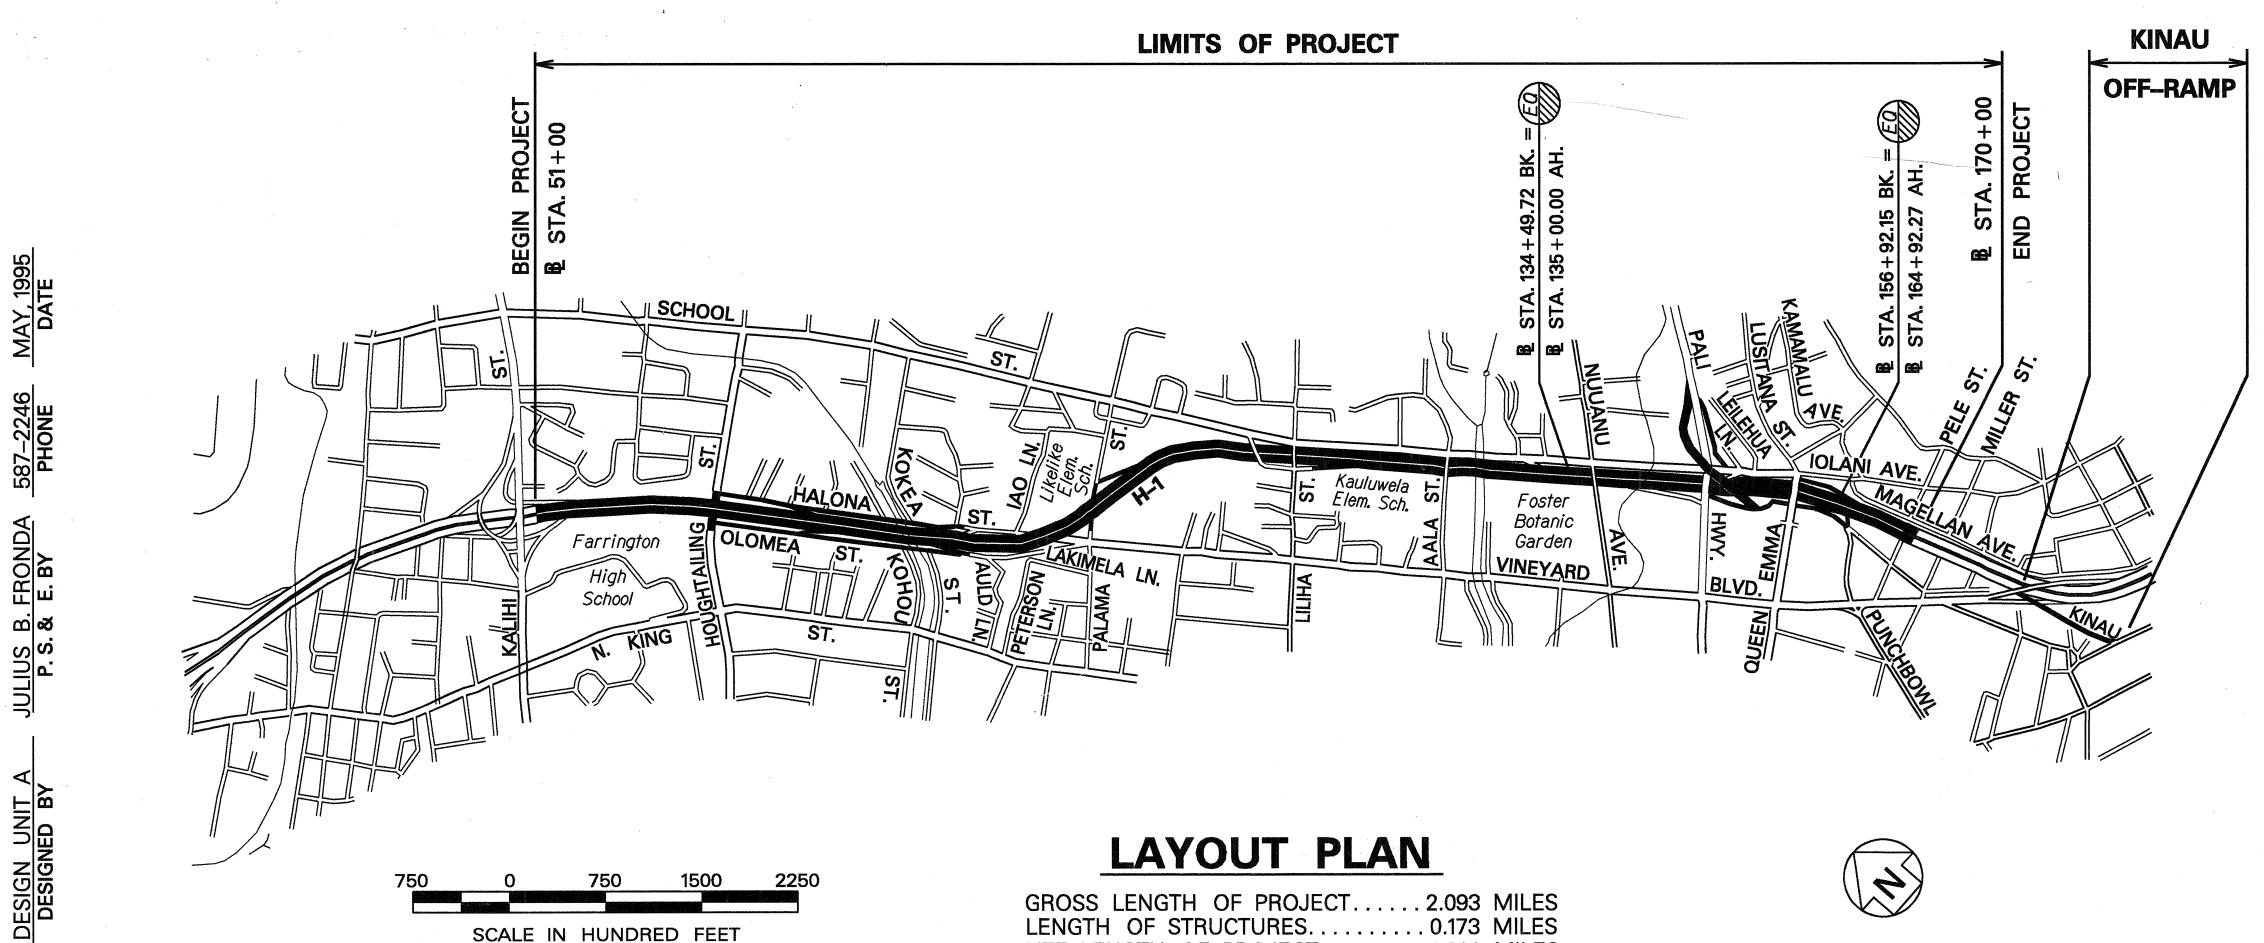

LAYOUT PLAN

GROSS LENGTH OF PROJECT..... 2.093 MILES LENGTH OF STRUCTURES.....0.173 MILES

NET LENGTH OF PROJECT.....1.920 MILES

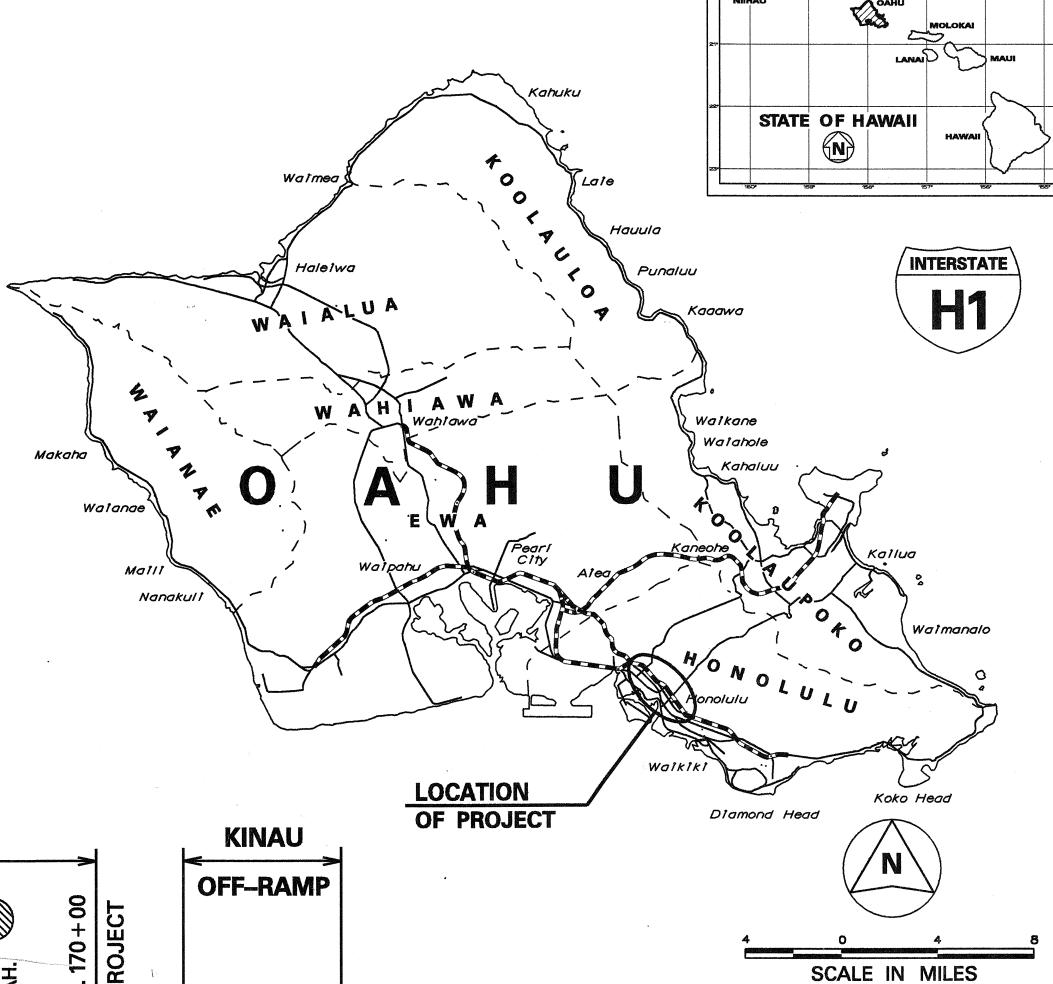

FEDERAL AID INTERSTATE PROJECTS PREVIOUSLY CONSTRUCTED OR UNDER CONSTRUCTION

MILE POST 19.629 TO MILE POST 21.721

DESIGN DESIGNATION

ADT	(1995)	. 223,400
ADT	(2005)	. 276,600
DHV		19,400
D		50/50
Т		2.5 %

CHANGES MADE DURING CONSTRUCTION HAVE BEEN INCORPORATED ON THESE PLANS EXCEPT CHANGES IN THE ORIGINAL THEORETICAL QUANTITIES.

RESIDENT ENGINEER

DEPARTMENT OF TRANSPORTATION STATE OF HAWAII

APPROVED:

DIR. OF TRANSPORTATION DATE