


FED. ROAD DIST. NO.	STATE	FED. AID PROJ. NO.	FISCAL YEAR	SHEET NO.	TOTAL SHEETS
HAWAII	HAW.	IR-HI-1(214)	1991	5	14

ORIGINAL PLAN	SURVEY PLOTTED BY	DATE
DESIGNED BY	DRAWN BY	
CHECKED BY	NOTED BY	
NO.		

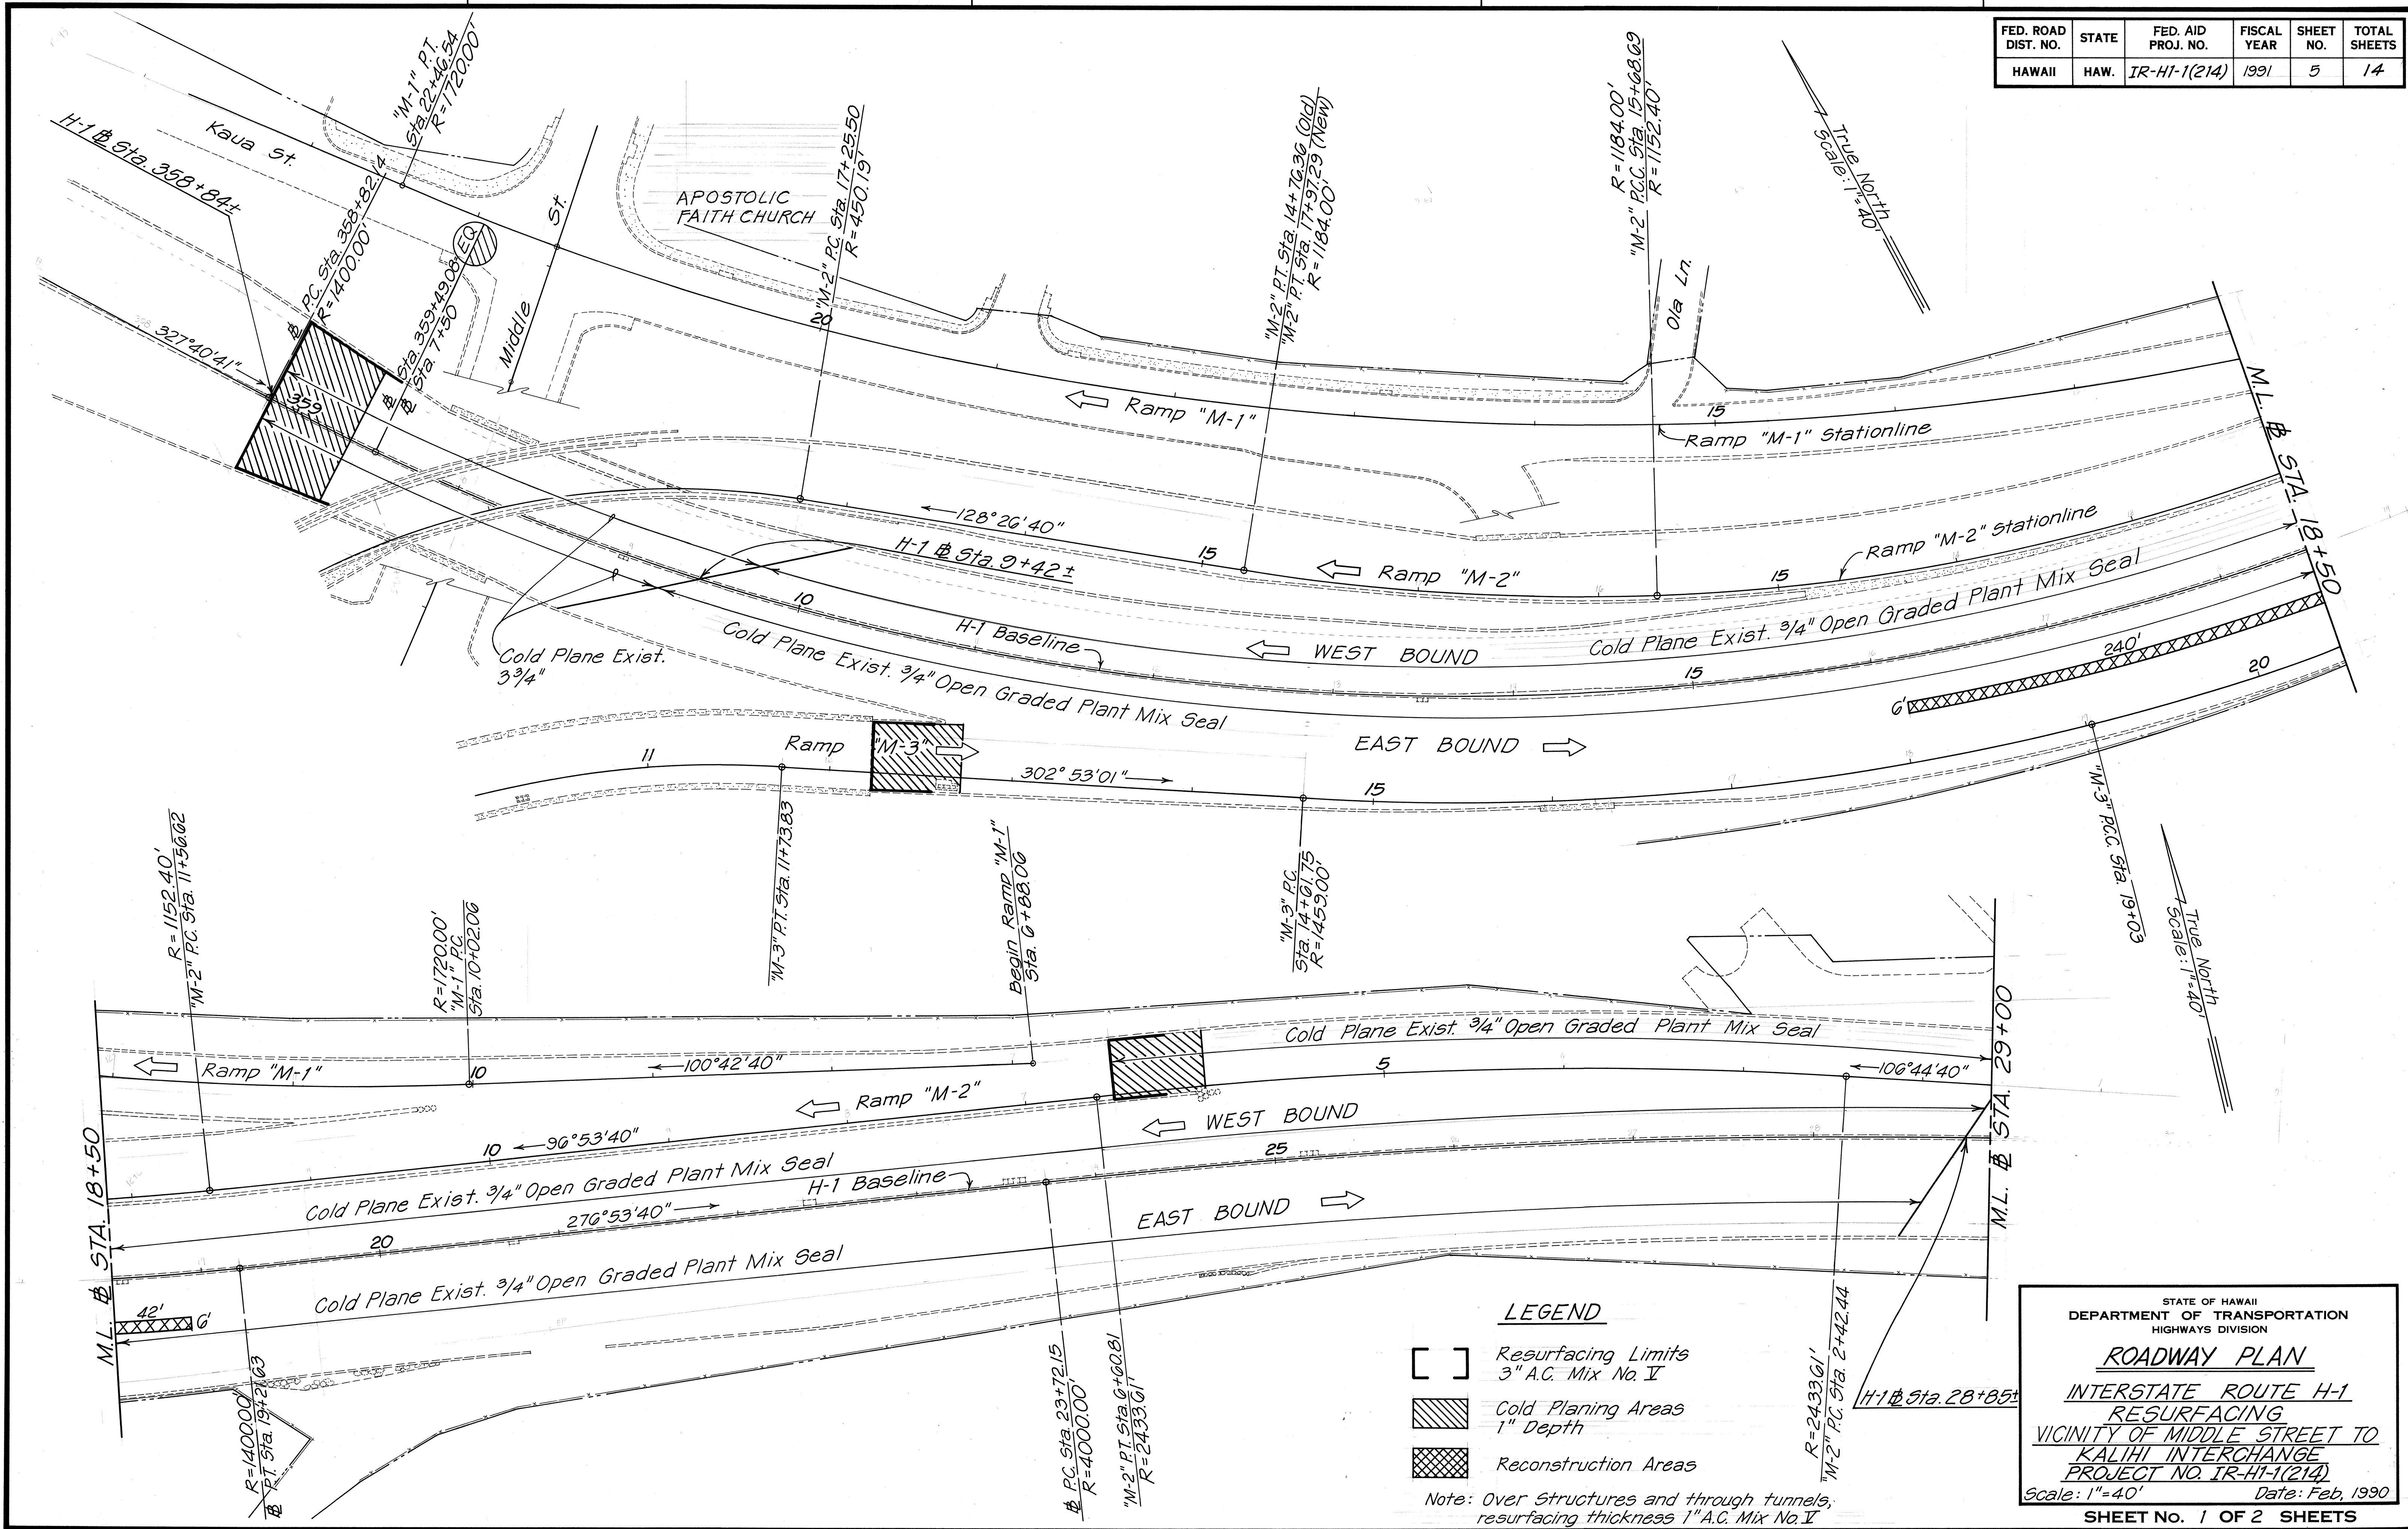

LEGEND

- [] Resurfacing Limits
3" A.C. Mix No. II
- [Hatched Box] Cold Planing Areas
1" Depth
- [Cross-hatched Box] Reconstruction Areas

Note: Over structures and through tunnels,
resurfacing thickness 1" A.C. Mix No. II

STATE OF HAWAII
DEPARTMENT OF TRANSPORTATION
HIGHWAYS DIVISION

ROADWAY PLAN

**INTERSTATE ROUTE H-1
RESURFACING**


**VICINITY OF MIDDLE STREET TO
KALIHI INTERCHANGE**

PROJECT NO. IR-HI-1(214)


Scale: 1"=40' Date: Feb, 1990

SHEET NO. 1 OF 2 SHEETS

FED. ROAD DIST. NO.	STATE	FED. AID PROJ. NO.	FISCAL YEAR	SHEET NO.	TOTAL SHEETS
HAWAII	HAW.	IR-H1-1(214)	1991	C.O.G	14

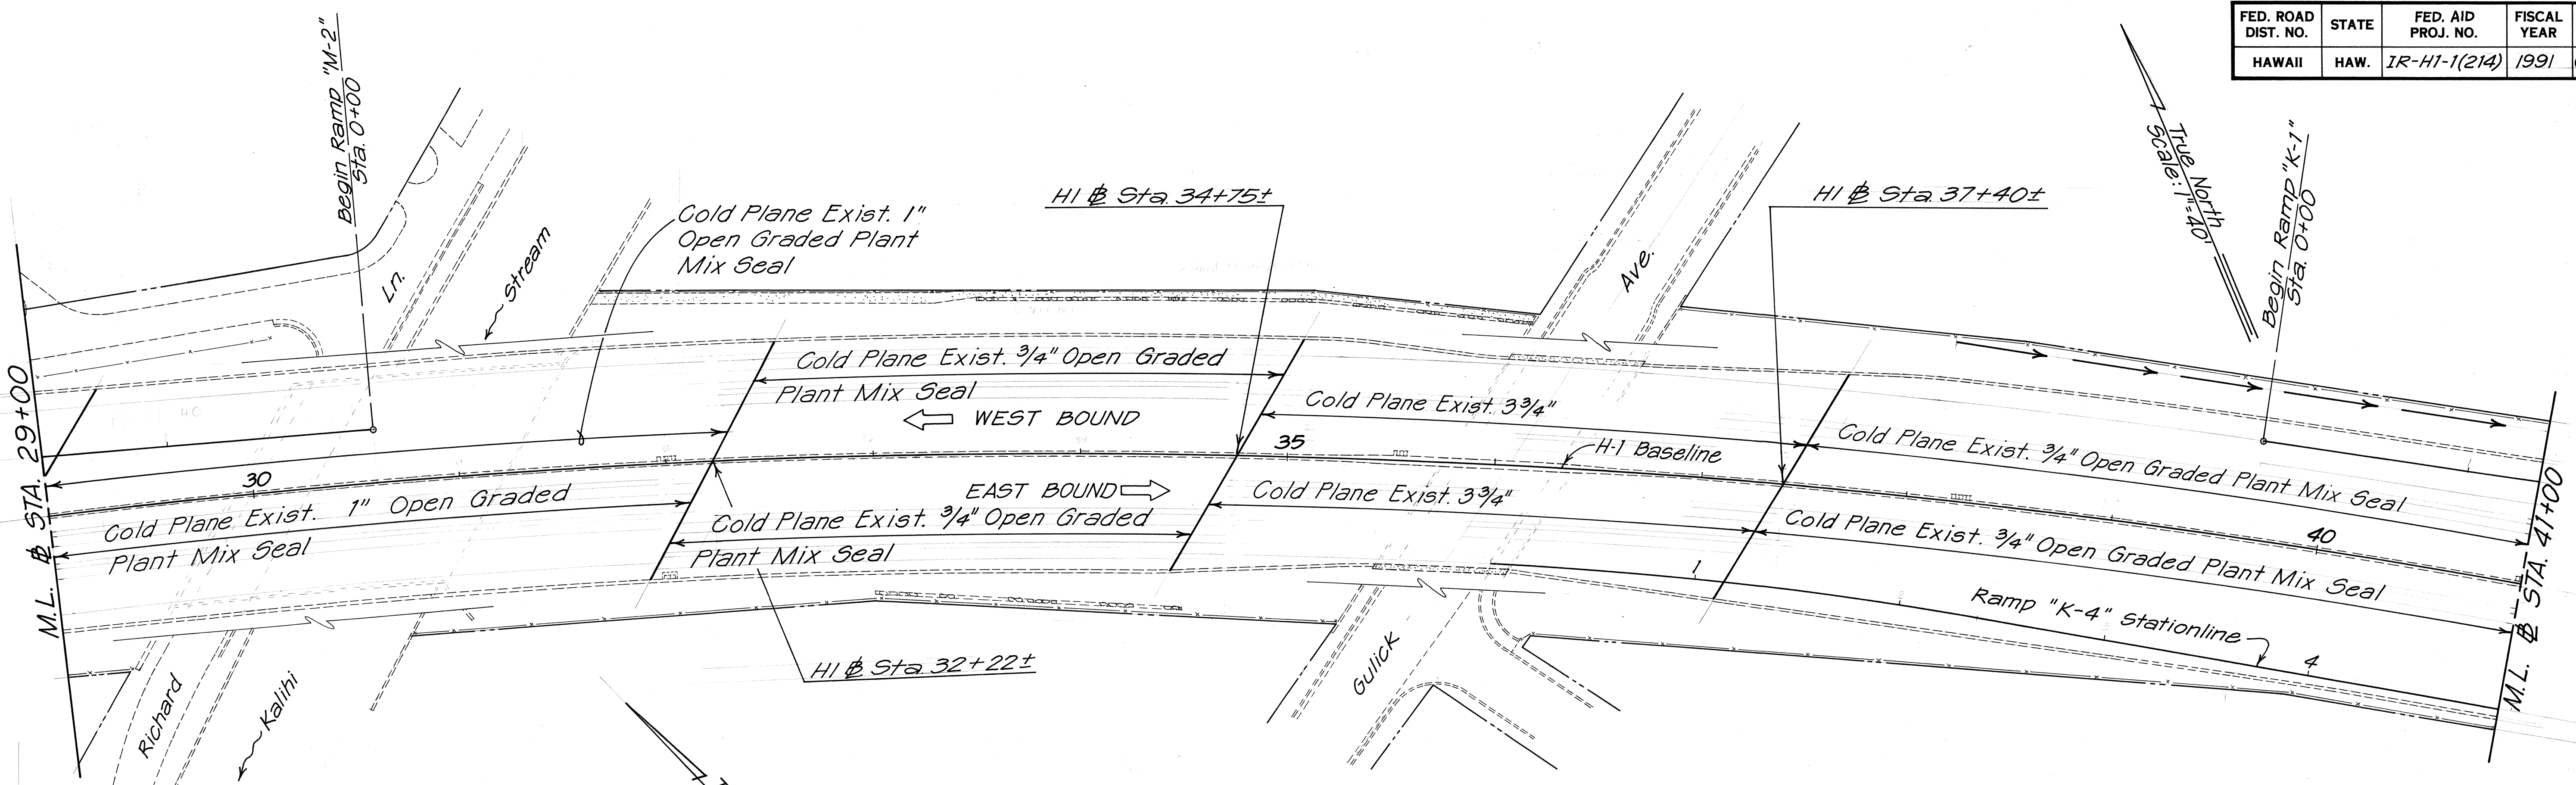

K-1 Sta. 1466.83± To
K-1 Sta. 3+24± % 28'-2" Left
Construct Lined Trapezoidal
Drainage Ditch and new chain link
Fence. For details see plan sheets
no. C.O. 4, C.O. 45-1.
All demolished and excavated
material shall be disposed
payment for which shall be
considered incidental to the
various contract items.

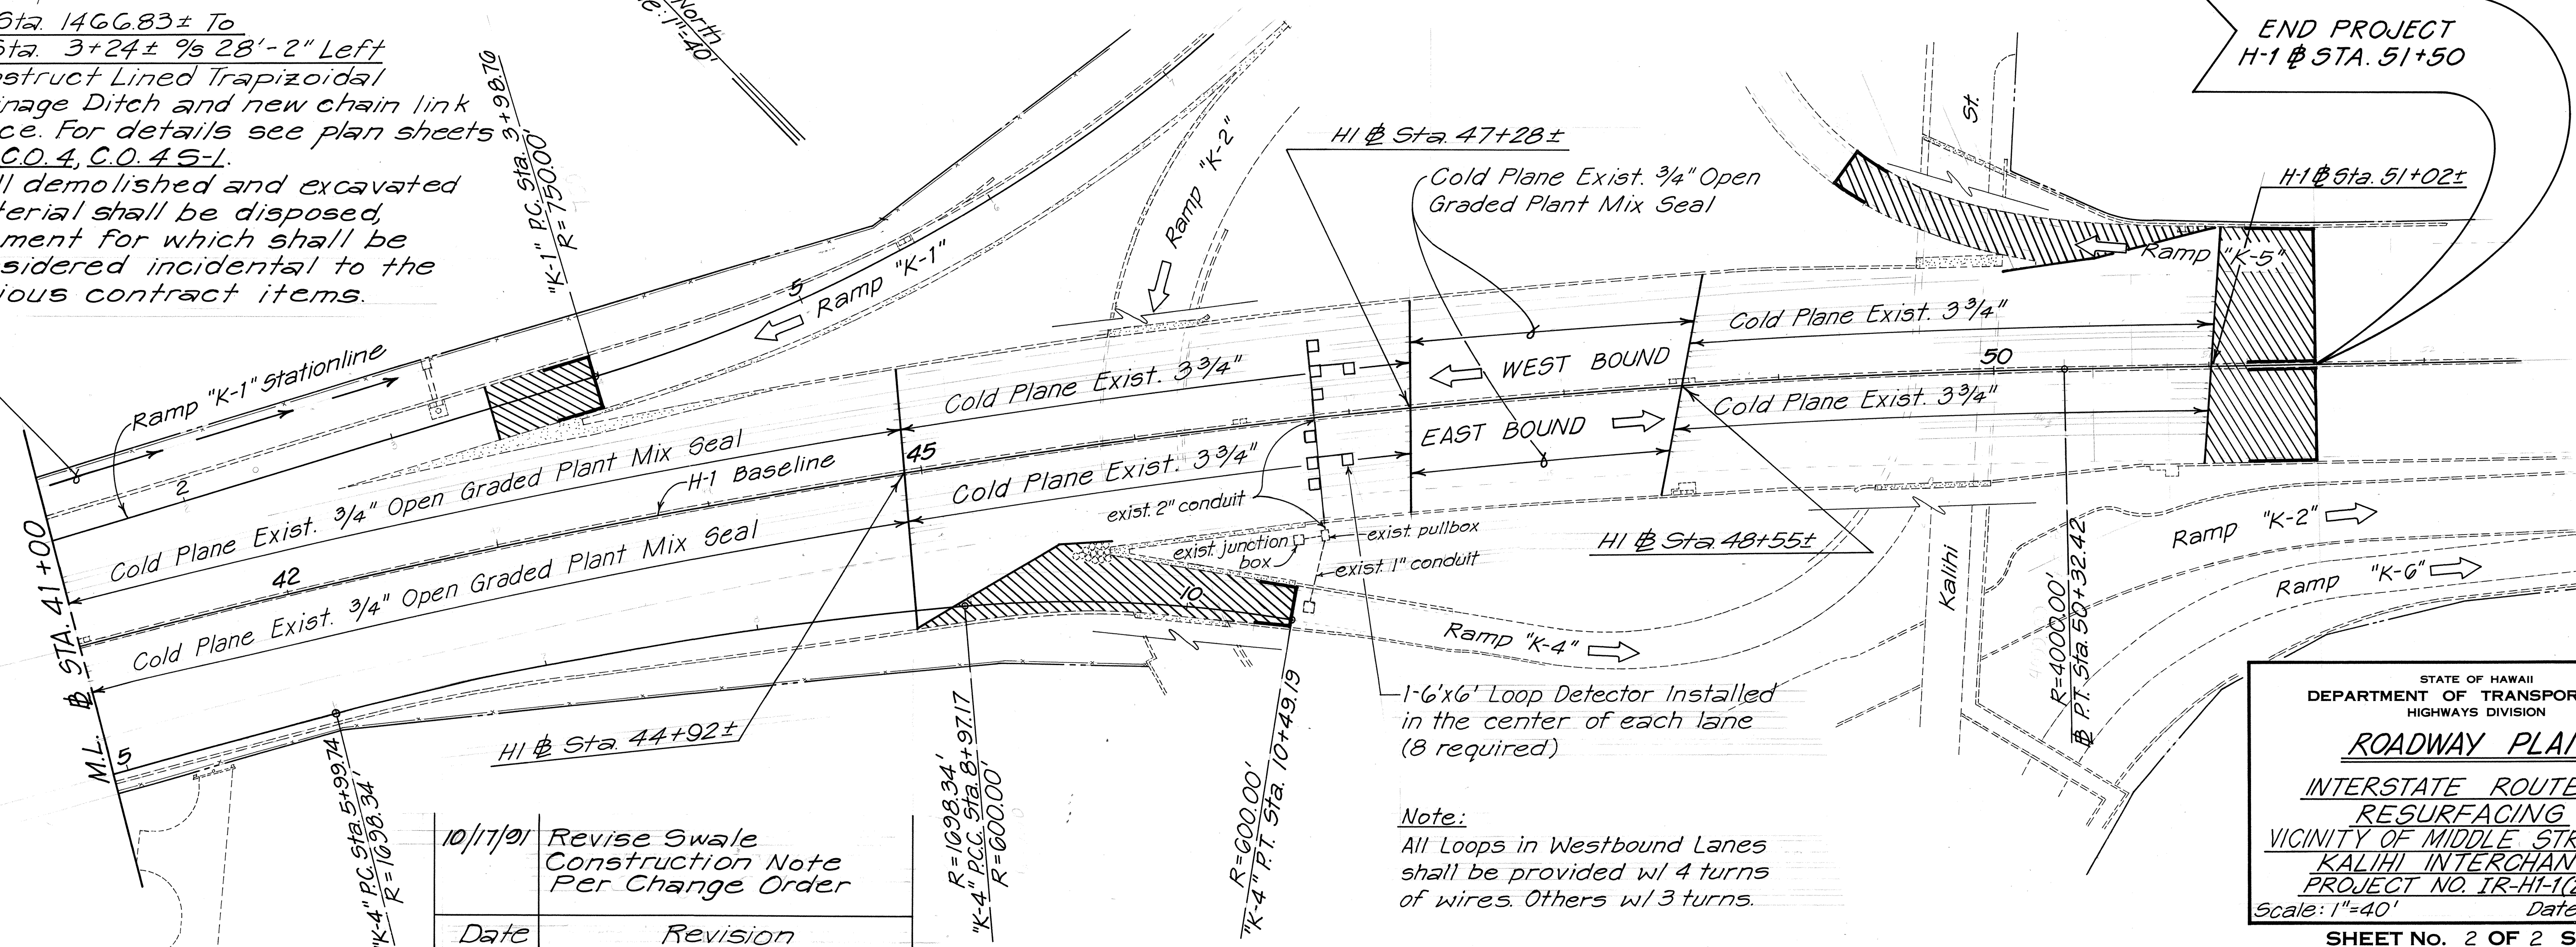

Date	Revision
10/17/91	Revise Swale Construction Note Per Change Order

Note:
All Loops in Westbound Lanes
shall be provided w/ 4 turns
of wires. Others w/ 3 turns.

STATE OF HAWAII
DEPARTMENT OF TRANSPORTATION
HIGHWAYS DIVISION

ROADWAY PLAN
INTERSTATE ROUTE H-1
RESURFACING
VICINITY OF MIDDLE STREET TO
KALIHI INTERCHANGE
PROJECT NO. IR-H1-1(214)
Scale: 1"=40' Date: Feb, 1990

SHEET No. 2 OF 2 SHEETS