




FED. ROAD DIST. No.	STATE	FED. AID PROJ. No.	FISCAL YEAR	SHEET No.	TOTAL SHEETS
HAWAII	HAW.	IR-H1-1 (213)	1994	27	38

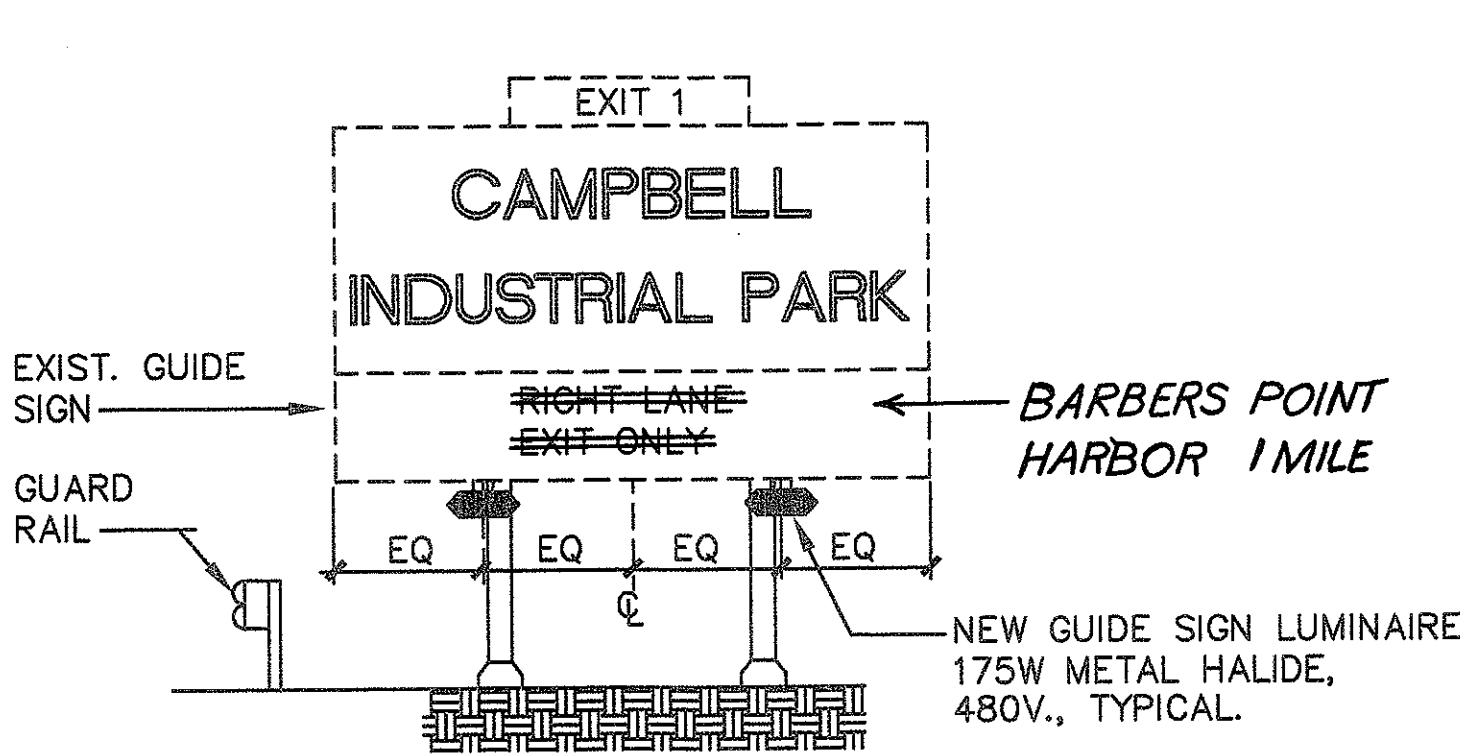


EXISTING SIGN (NO. 1)
(STA. 92+99 OUTBOUND)
NOT TO SCALE

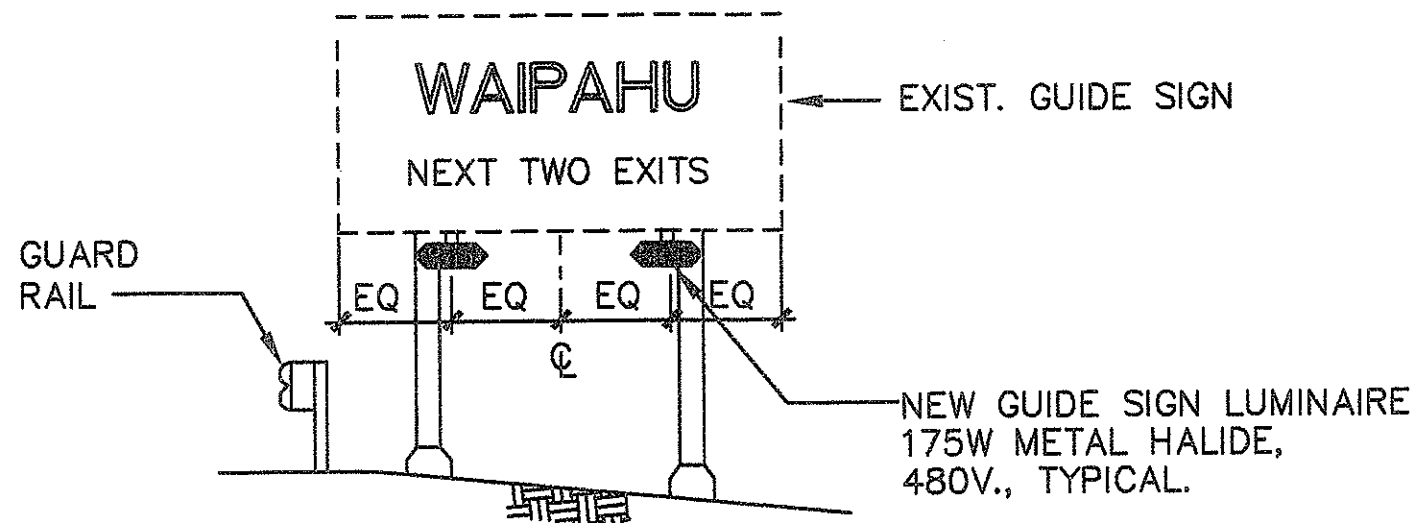


EXISTING SIGN (NO. 4)
(STA. 187 + 33 INBOUND)
NOT TO SCALE

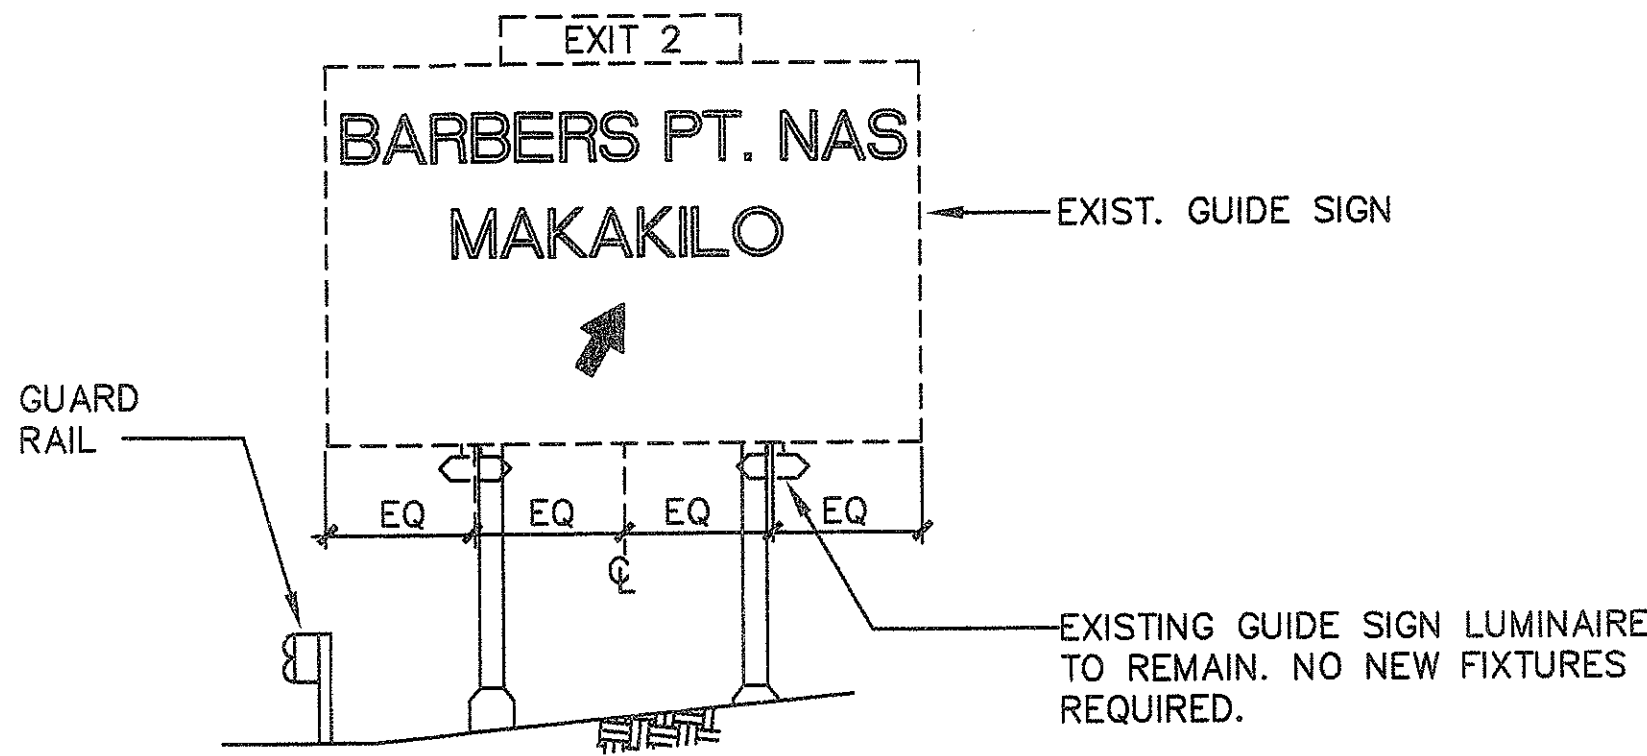


EXISTING SIGN (NO. 2)
(STA. 114 + 96 OUTBOUND)
NOT TO SCALE

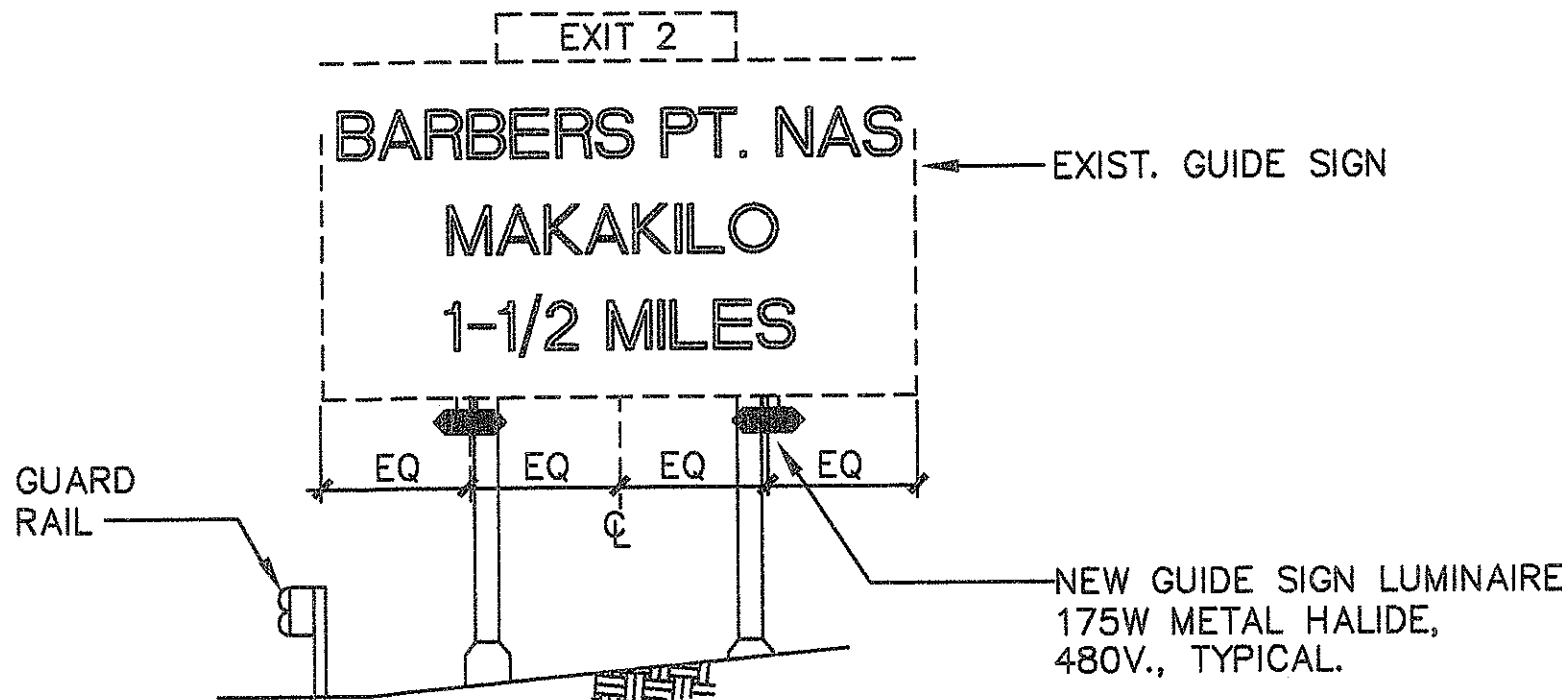

EXISTING SIGN (NO. 5)
(STA. 196 + 90 OUTBOUND)
NOT TO SCALE

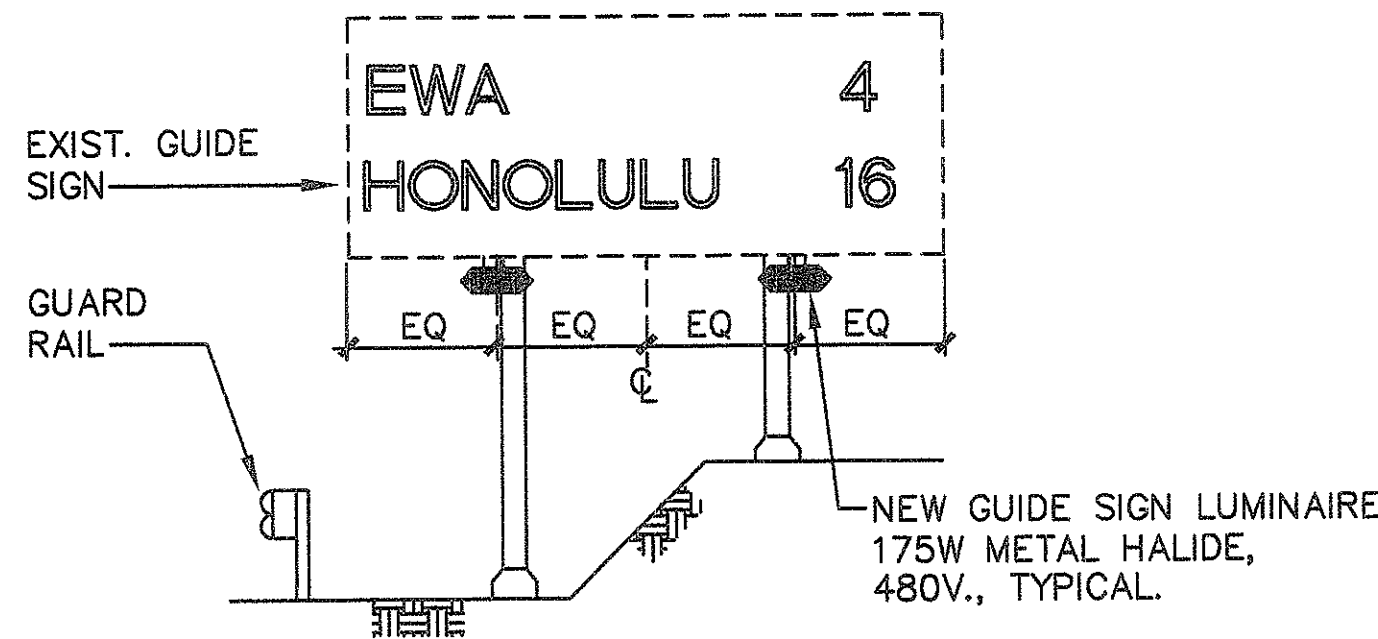

EXISTING SIGN (NO. 3)
(STA. 138+76 INBOUND)
NOT TO SCALE

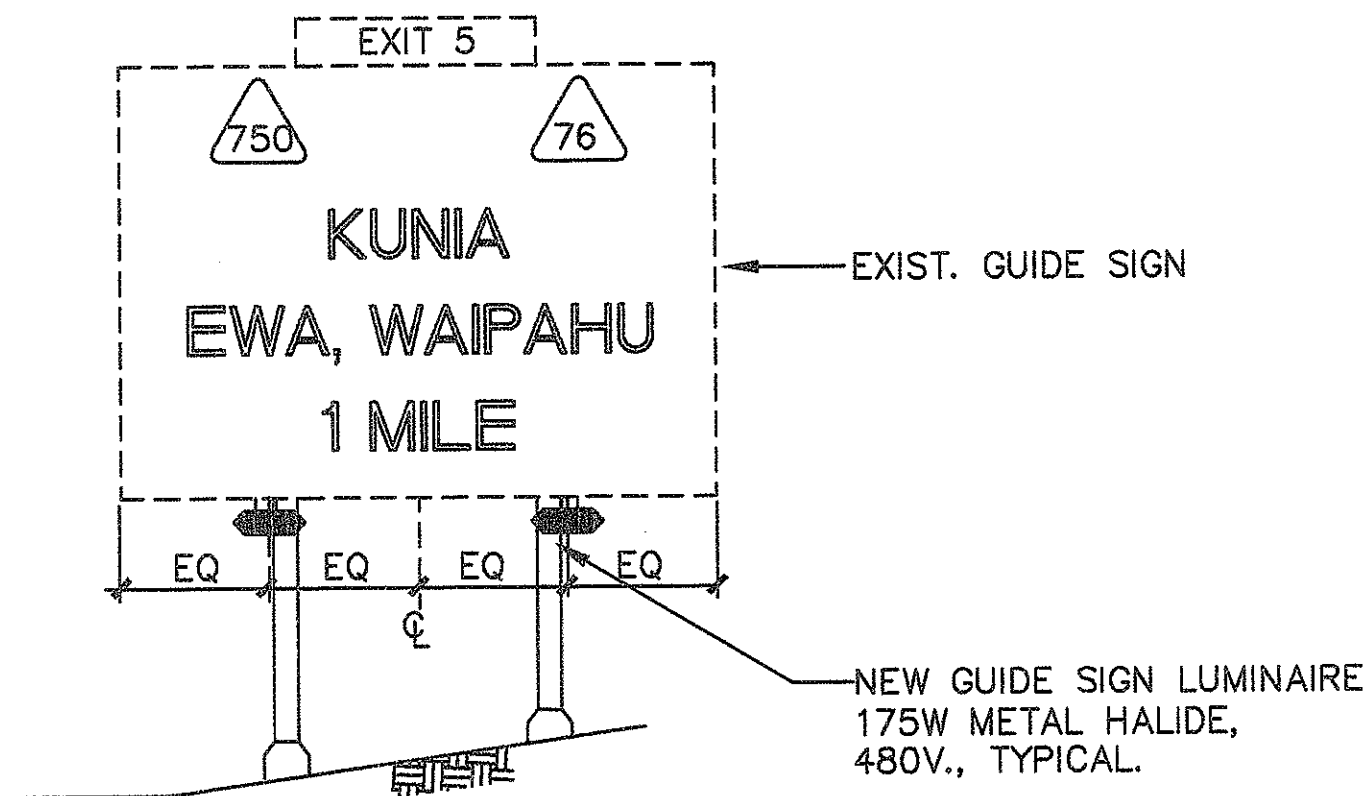


EXISTING SIGN (NO. 6)
(STA. 271 + 95 INBOUND)
NOT TO SCALE

1. New Luminaire w/ Bracket Installed per contract; however due to safety concerns, Hwy-TD directed it to be removed.
2. Missing Sign D-13 Installed.

NOTES:

1. PROVIDE ALL NECESSARY EQUIPMENT AND HARDWARE AS REQUIRED FOR A COMPLETE GUIDE SIGN LIGHTING SYSTEM.
2. REFER TO SHEETS E-28, E-26, E-27 FOR INSTALLATION REQUIREMENTS OF GUIDE SIGN LUMINAIRES.
3. SEE DETAIL B/E-23 FOR INSTALLATION REQUIREMENTS OF JUNCTION BOX MTD. ON SIGN POST.
4. VERIFY EXACT CIRCUITING FOR EXISTING LIGHTED SIGNS. CONDUITS AND CABLES SERVING SIGN LIGHTS TO BE REMOVED SHALL ALSO BE DISCONNECTED AND REMOVED. PROVIDE NECESSARY HARDWARE TO MAINTAIN CIRCUIT CONTINUITY TO EQUIPMENT OUTSIDE OF PROJECT LIMITS.

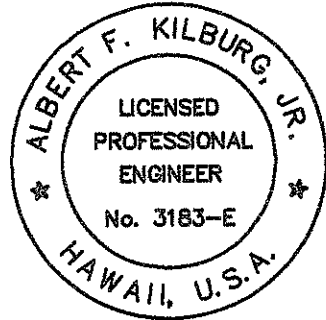

Albert F. Kilburg, Jr.
THIS WORK WAS PREPARED BY
ME OR UNDER MY SUPERVISION

E-25

DVM JOB No.: 89104.01
CAD FILE No.: E-25/3

DATE REVISION

STATE OF HAWAII
DEPARTMENT OF TRANSPORTATION
HIGHWAYS DIVISION
**EXIST. SIGN AND
NEW LUMINAIRE DETAILS**
INTERSTATE ROUTE H-1
PALAILAI I.C. TO KUNIA I.C.
PROJECT No. IR-H1-1(213)

SCALE: AS NOTED

SHEET No. 12 OF 18 SHEETS