

INDEX TO DRAWINGS	
SHEET NO.	DESCRIPTION
1	TITLE SHEET
2	STANDARD PLANS SUMMARY
3	GENERAL NOTES AND LEGEND
4	NPDES GENERAL NOTES
5 - 9	TYPICAL SECTIONS AND DETAILS
10 - 18	PLANS
19 - 21	DRAINAGE PLANS
① 22 - 23	DRAINAGE DETAILS
24	TRAFFIC LEGEND, DETAILS, AND NOTES
25 - 33	PAVEMENT MARKING & SIGNING PLAN
34 - 35	SIGN DETAILS AND NOTES
36	TRAFFIC SUMMARIES

① Plan Sht. No. C.O. 23 S-I is a supplemental sheet to this project. TOTAL SHEET COUNT after "AS-Built" posting 37 Sheets

STATE OF HAWAII



DEPARTMENT OF TRANSPORTATION  
HIGHWAYS DIVISION  
HONOLULU, HAWAII

"AS-BUILT"  
PLANS FOR




# INTERSTATE ROUTE H-1 RESURFACING SALT LAKE BOULEVARD TO VALKENBURGH STREET F.A.I. PROJECT NO. IM-H1-1(221)

DISTRICT OF EWA  
ISLAND OF OAHU

FED. ROAD DIST. NO.	STATE	F.A.I. PROJ. NO.	FISCAL YEAR	SHEET NO.	TOTAL SHEETS
HAWAII	HAW.	IM-H1-1(221)	1996	1	36

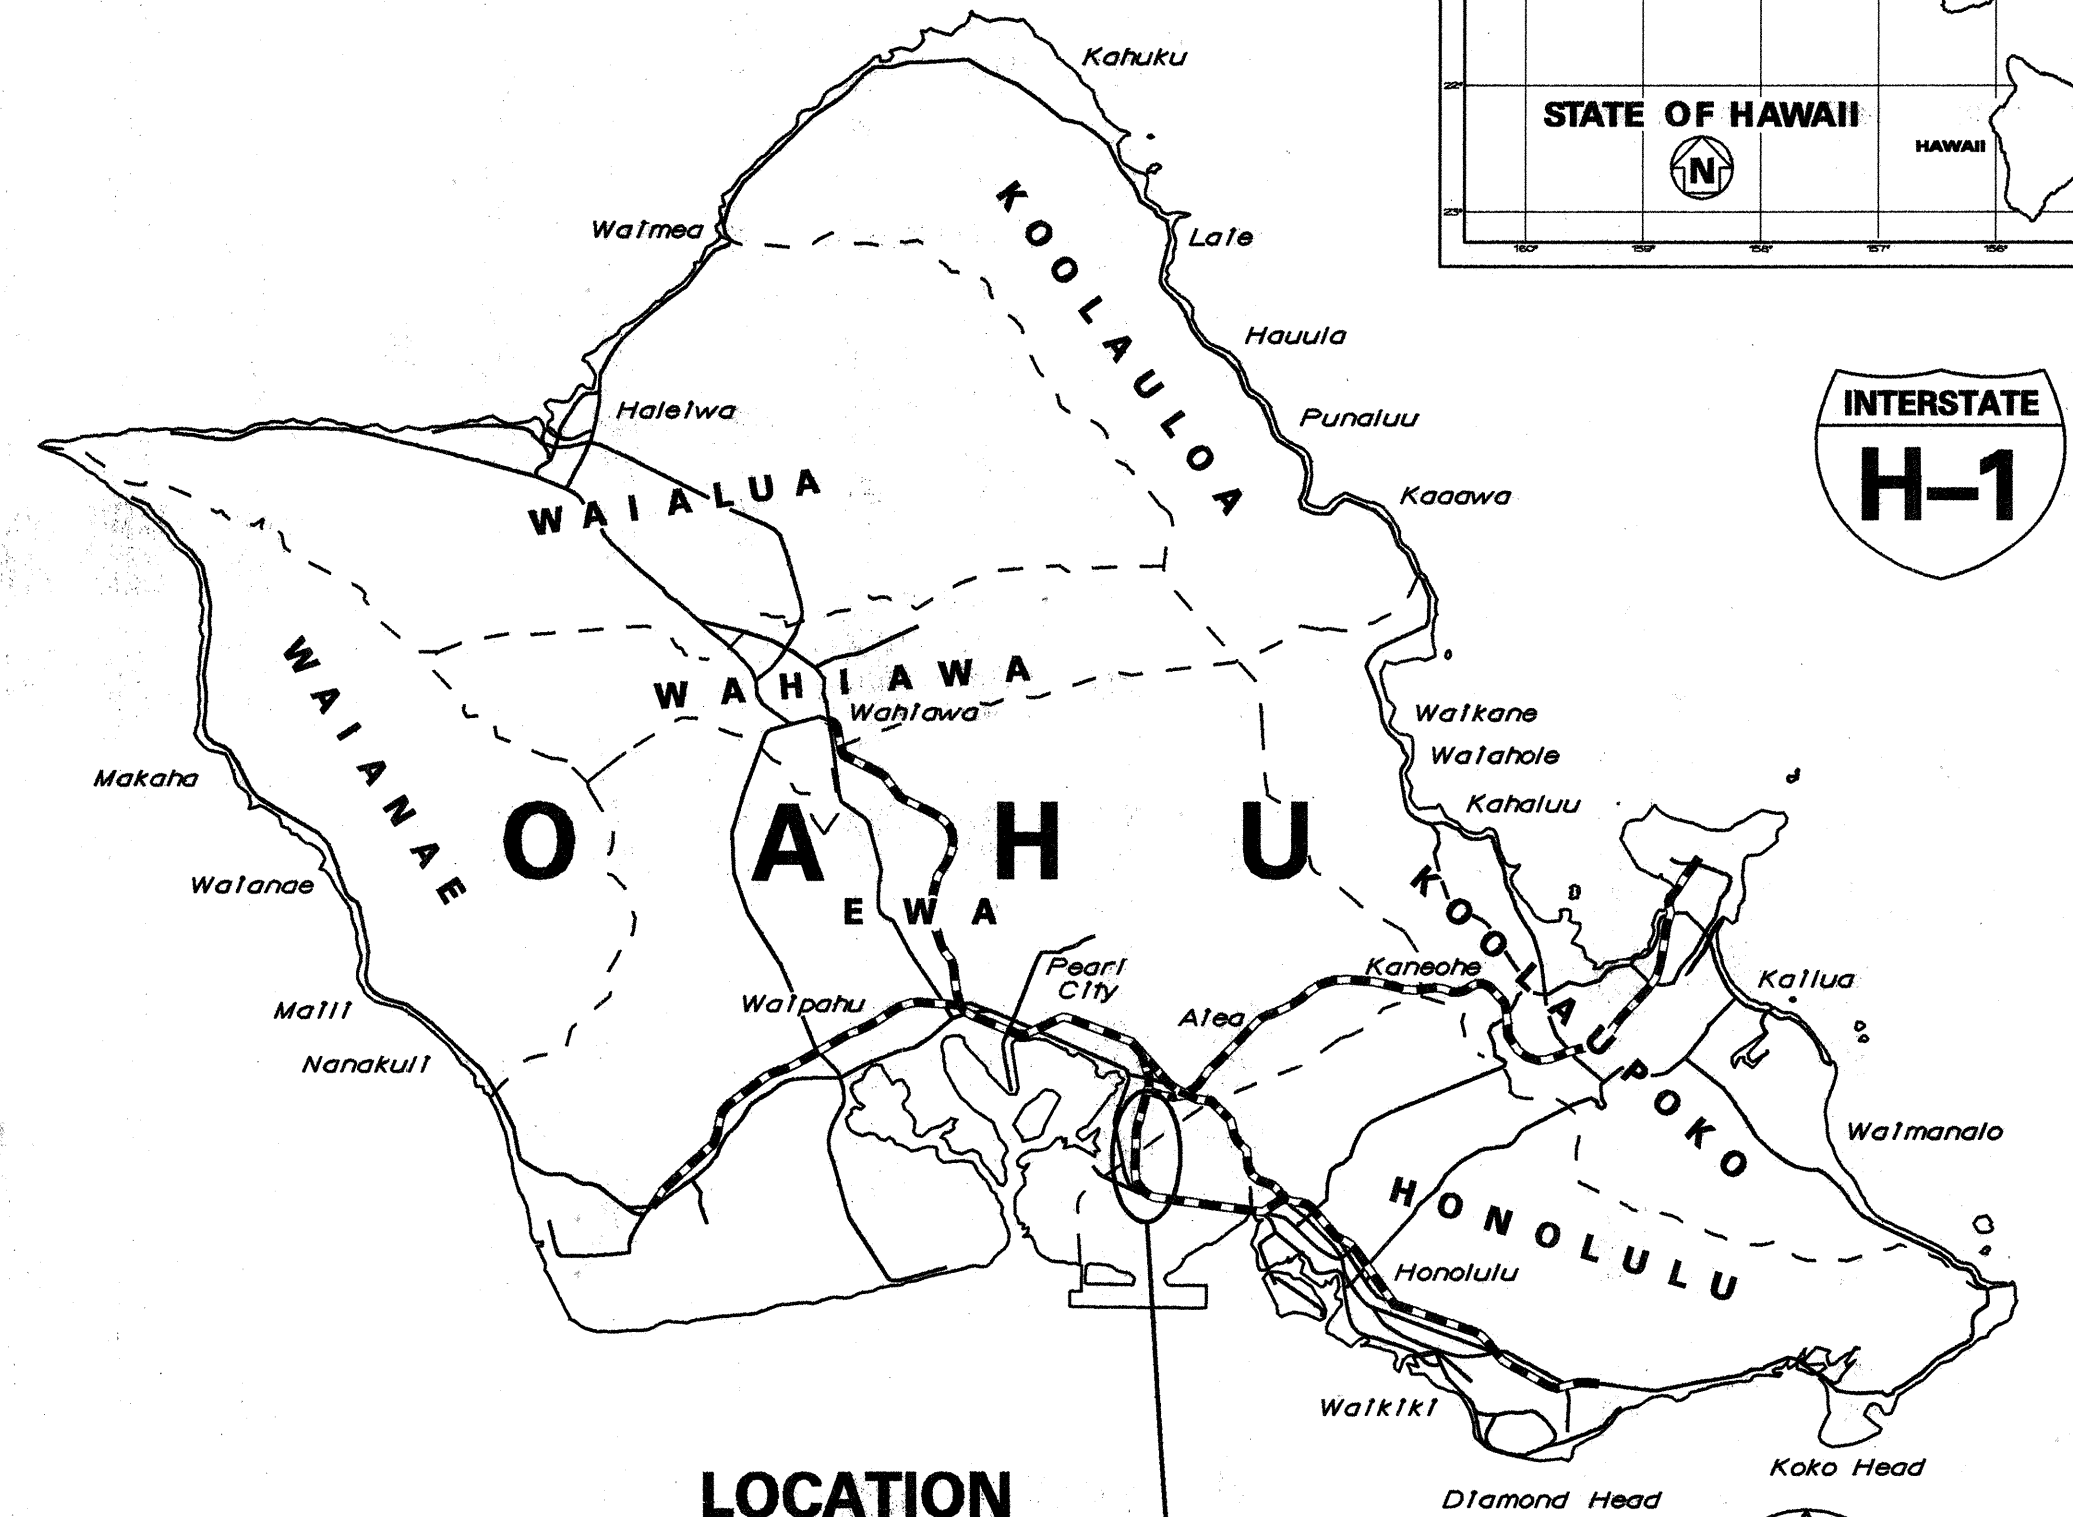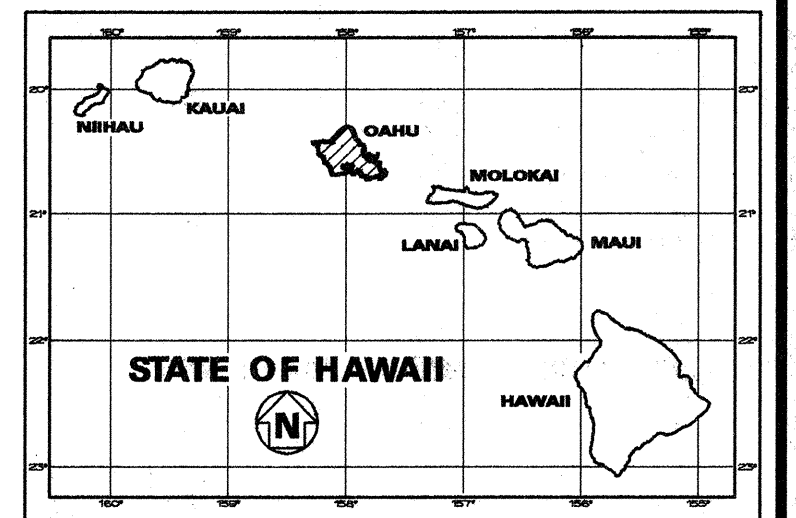

LOCATION  
OF PROJECT

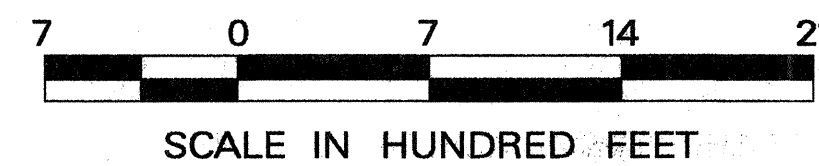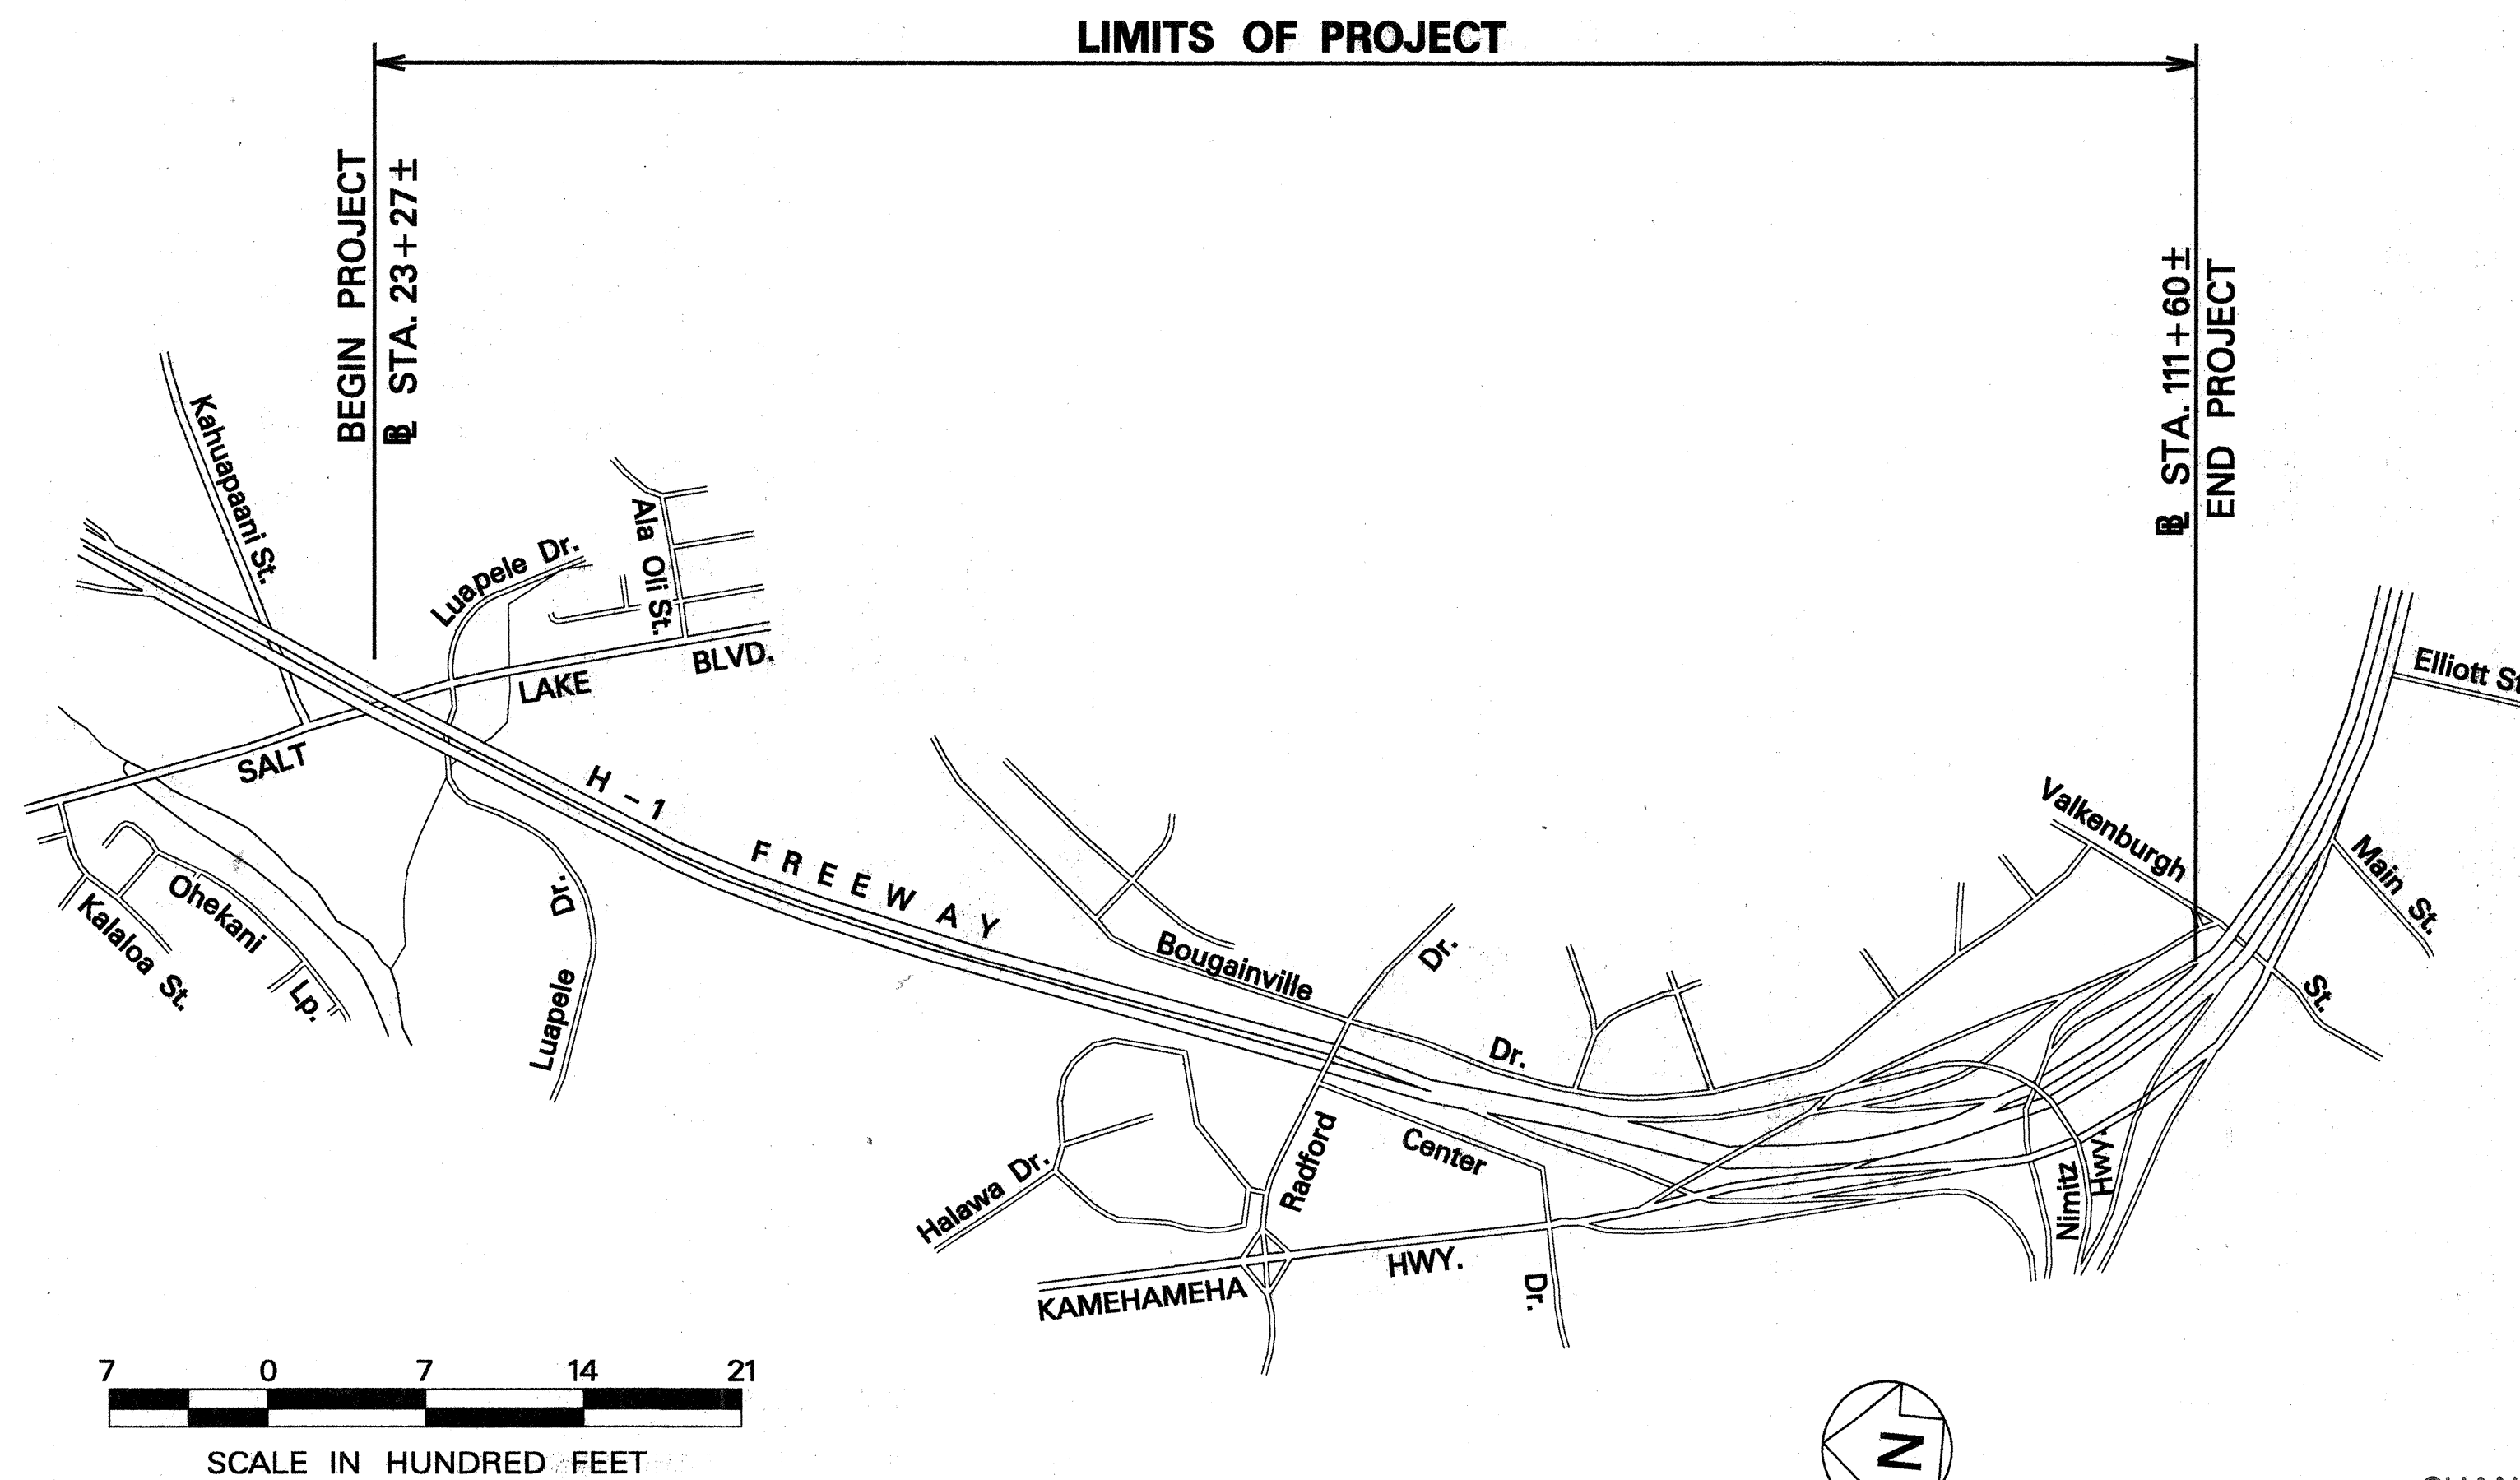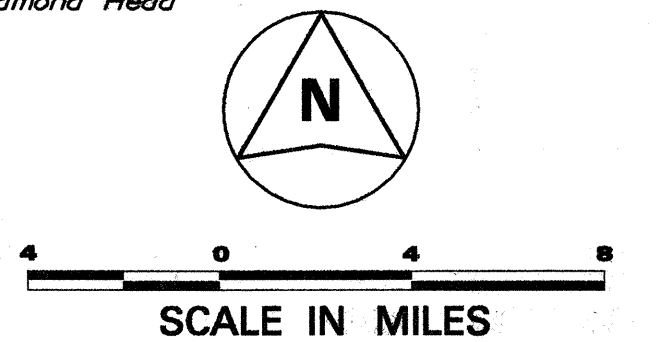

LAYOUT PLAN

LENGTH OF PROJECT.....0.95 MILES

FEDERAL AID INTERSTATE PROJECTS PREVIOUSLY  
CONSTRUCTED OR UNDER CONSTRUCTION

MILE POST 14.06 TO MILE POST 15.73

## DESIGN DESIGNATION

ADT (1996).....	122,400
ADT (2006).....	127,460
DHV.....	12,110
D.....	85/15
T.....	4.0%
V.....	60 M.P.H.

CHANGES MADE DURING CONSTRUCTION HAVE BEEN  
INCORPORATED ON THESE PLANS EXCEPT CHANGES IN THE  
ORIGINAL THEORETICAL QUANTITIES.

*Silvery S. C. Lee* 9/28/98  
RESIDENT ENGINEER DATE

DEPARTMENT OF TRANSPORTATION  
STATE OF HAWAII

APPROVED:

*Dir. Hayashida* 5/29/96  
DIR. OF TRANSPORTATION DATE

HWY-DD UNIT A  
DESIGNED BY J. FRONDA  
P.S. & E. BY MAY, 1996  
DATE 587-2246  
PHONE