

FED. ROAD DIST. No.	STATE	FED. AID PROJ. No.	FISCAL YEAR	SHEET No.	TOTAL SHEETS
HAWAII	HAW.	IR-H1-1 (212)	1992	24	29

NOTE:
1. SCHEDULE OF SIGNS IS FOR GENERAL INFORMATION PURPOSES ONLY. CONTRACTOR SHALL FIELD VERIFY EACH SPECIFIC LIGHT STANDARD LOCATION AND PROVIDE THE NECESSARY POLE BASE, PULLBOX AND CONDUIT INSTALLATION.

SCHEDULE OF LIGHT STANDARD BASE					
	TYPE OF LIGHT STANDARD BASE				FIELD OBSERVATION OF ABOVE GROUND CONDITION
	TYPE 1	TYPE 2	TYPE 3	TYPE 4	
BASELINE STATION (INBOUND)	351+30				FILL
		353+35			FILL, EROSION OF EXIST. FILL VISIBLE
		355+40			FILL
		357+40			FILL
		359+50			FILL
	361+50				FILL
	363+55				DIRT, LEVEL GROUND
			365+50		DIRT CUT
			367+65		ROCK VISIBLE
			369+70		COBBLES VISIBLE
			371+75		COBBLES
			373+80		COBBLES
	375+80				ROCK VISIBLE
	BASELINE STATION (OUTBOUND)		349+70		
		351+65			FILL
		353+60			FILL
		355+55			FILL
		357+50			FILL
		359+45			FILL
361+50					DIRT, LEVEL GROUND
			363+60		DIRT AND COBBLES
			365+70		ROCK VISIBLE
			367+80		ROCK VISIBLE
			369+90		ROCK VISIBLE
			372+00		ROCK VISIBLE
			374+10		ROCK VISIBLE
			376+10		ROCK VISIBLE

(REFERENCE SHT. E-2)


SCHEDULE OF LIGHT STANDARD BASE					FIELD OBSERVATION OF ABOVE GROUND CONDITION
TYPE OF LIGHT STANDARD BASE					
TYPE 1	TYPE 2	TYPE 3	TYPE 4		
				377+35 WAIKELE BRIDGE	
				379+25 WAIKELE BRIDGE	
				381+15 WAIKELE BRIDGE	
				383+05 WAIKELE BRIDGE	
385+20				DIRT	
		387+00		DIRT CUT	
		388+80		DIRT CUT, ROCKS VISIBLE	
		391+00		DIRT CUT, ROCKS VISIBLE	
		393+00		DIRT CUT, ROCKS VISIBLE	
		395+00		DIRT CUT, ROCKS VISIBLE	
		397+00		DIRT CUT, ROCKS VISIBLE	
		DELETE			
				377+35 WAIKELE BRIDGE	
				379+25 WAIKELE BRIDGE	
				381+15 WAIKELE BRIDGE	
				383+05 WAIKELE BRIDGE	
		385+20		DIRT CUT	
		387+00		DIRT CUT	
		388+80		DIRT CUT	
		391+00		DIRT CUT	
		393+20		DIRT CUT	

(REFERENCE SHT. E-3)

SCHEDULE OF LIGHT STANDARD BASE					
	TYPE OF LIGHT STANDARD BASE				FIELD OBSERVATION OF ABOVE GROUND CONDITION
	TYPE 1	TYPE 2	TYPE 3	TYPE 4	
BASELINE STATION (INBOUND)		452+20			FILL SCOPE, ERODED CONDITION
		454+10			FILL SLOPE
		456+00			FILL SLOPE
		457+00			FILL SLOPE
		459+80			FILL SLOPE
		461+70			FILL SLOPE
	463+60				LEVEL GROUND
	465+50				LEVEL GROUND
BASELINE STATION (OUTBOUND)					
	451+80		451+80		FILL
	453+70				DIRT, LEVEL GROUND
			455+60		DIRT, LEVEL GROUND
	457+50				DIRT, LEVEL GROUND
	459+40				DIRT, LEVEL GROUND
	461+30				DIRT, LEVEL GROUND
			463+20		DIRT CUT, ROCKS VISIBLE
			465+10		DIRT CUT, ROCKS VISIBLE

(REFERENCE SHT. E-5)

NOTE:
1. CIRCUIT PHASE CONDUCTORS NOT SHOWN FOR CLARITY.

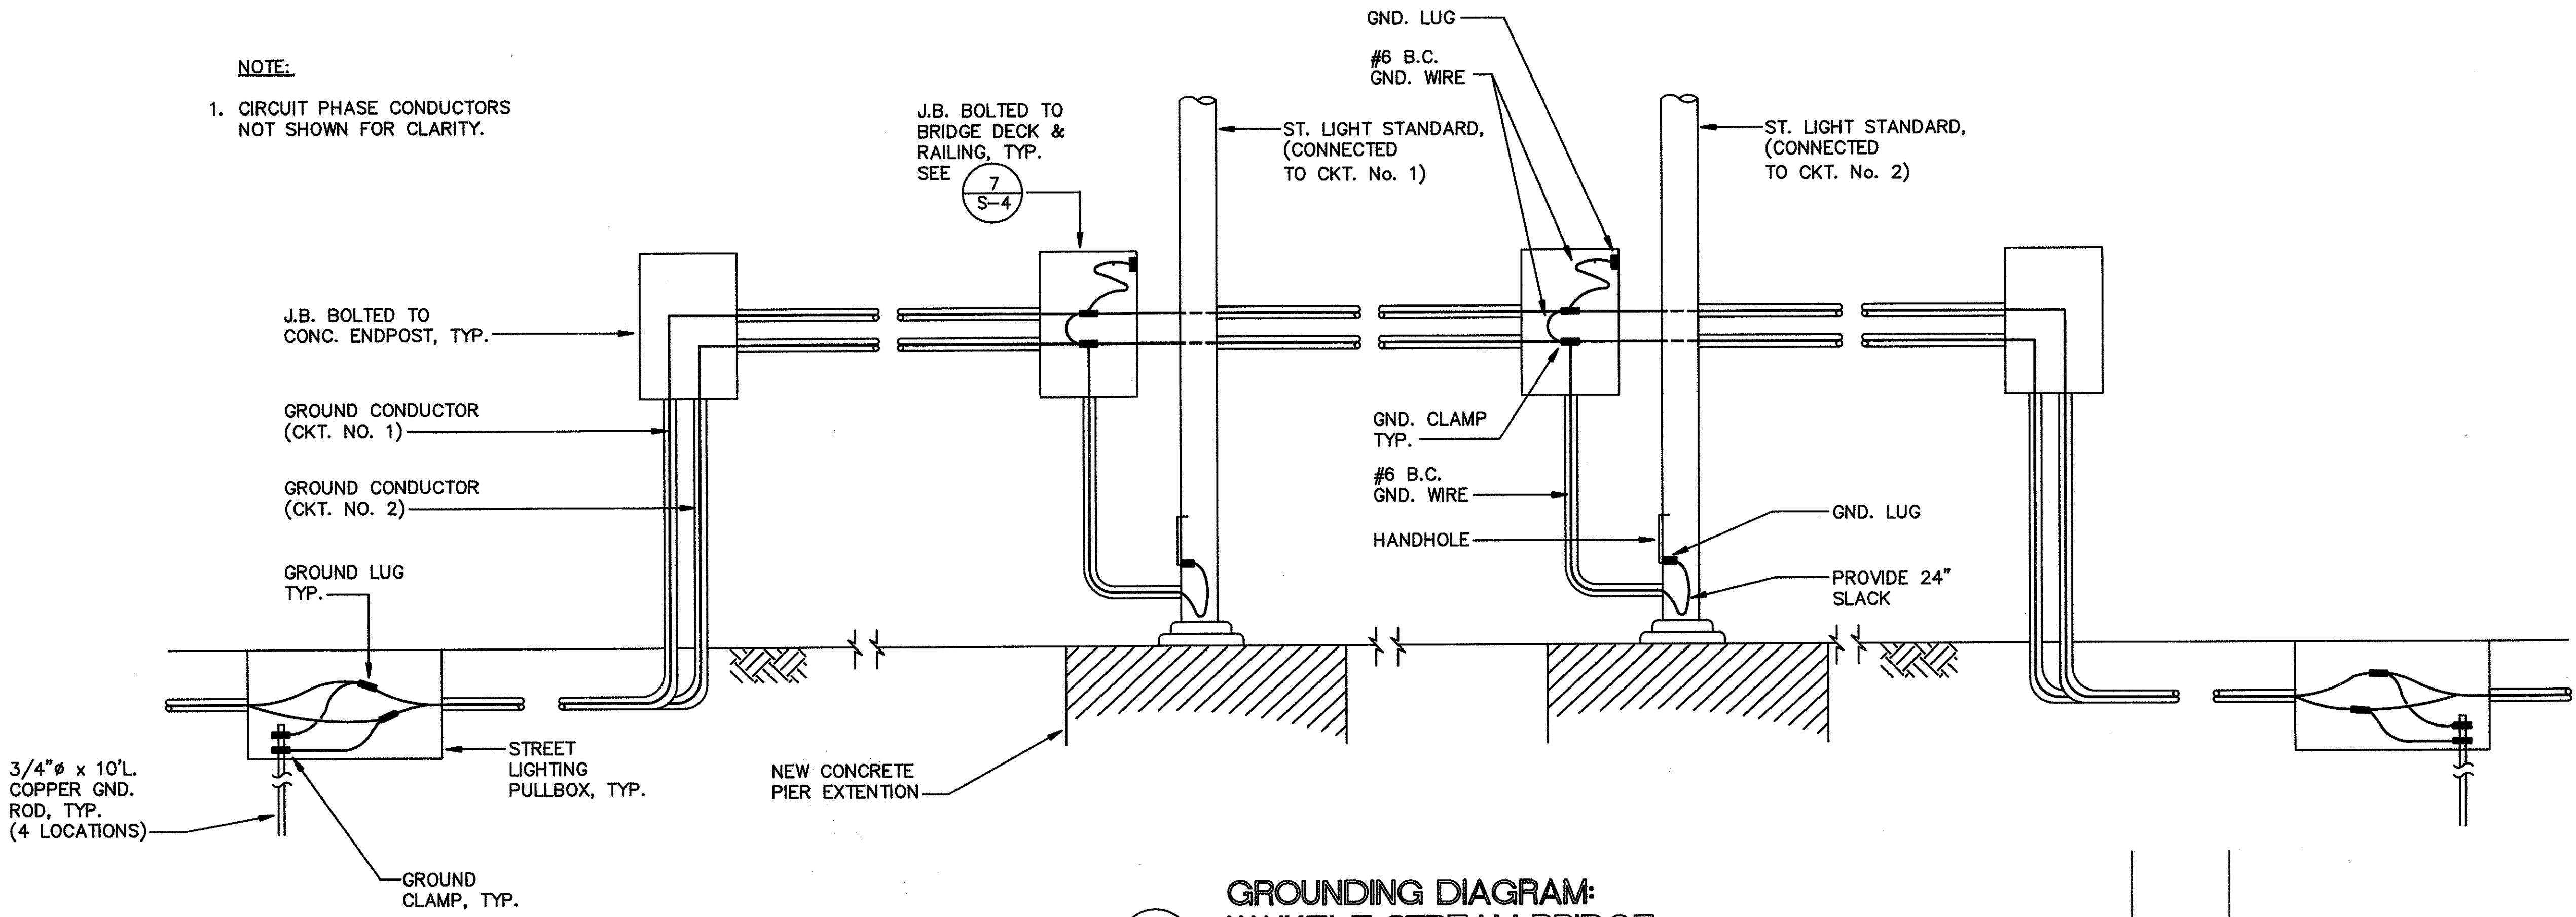

GROUNDING DIAGRAM:
WAIKELE STREAM BRIDGE
NOT TO SCALE



STATE OF HAWAII
DEPARTMENT OF TRANSPORTATION
HIGHWAYS DIVISION

**SCHEDULE OF
LIGHT STANDARD BASES**

INTERSTATE ROUTE H-1
KUNIA I.C. TO WAIKALE I.C.
PROJECT No. IR-H1-1(212)

SCALE: AS NOTED

SHEET No. 14 OF 14 SHEETS

PJM JOB NO: 89104
CAD FILE NO: 89104E17

DATE	1/21/93
REVISION	DELETE SCHEDULE OF LIGHT STANDARD BASE AND NOTE 1. SO INFORMATION DOESN'T CONFLICT WITH PLANS