
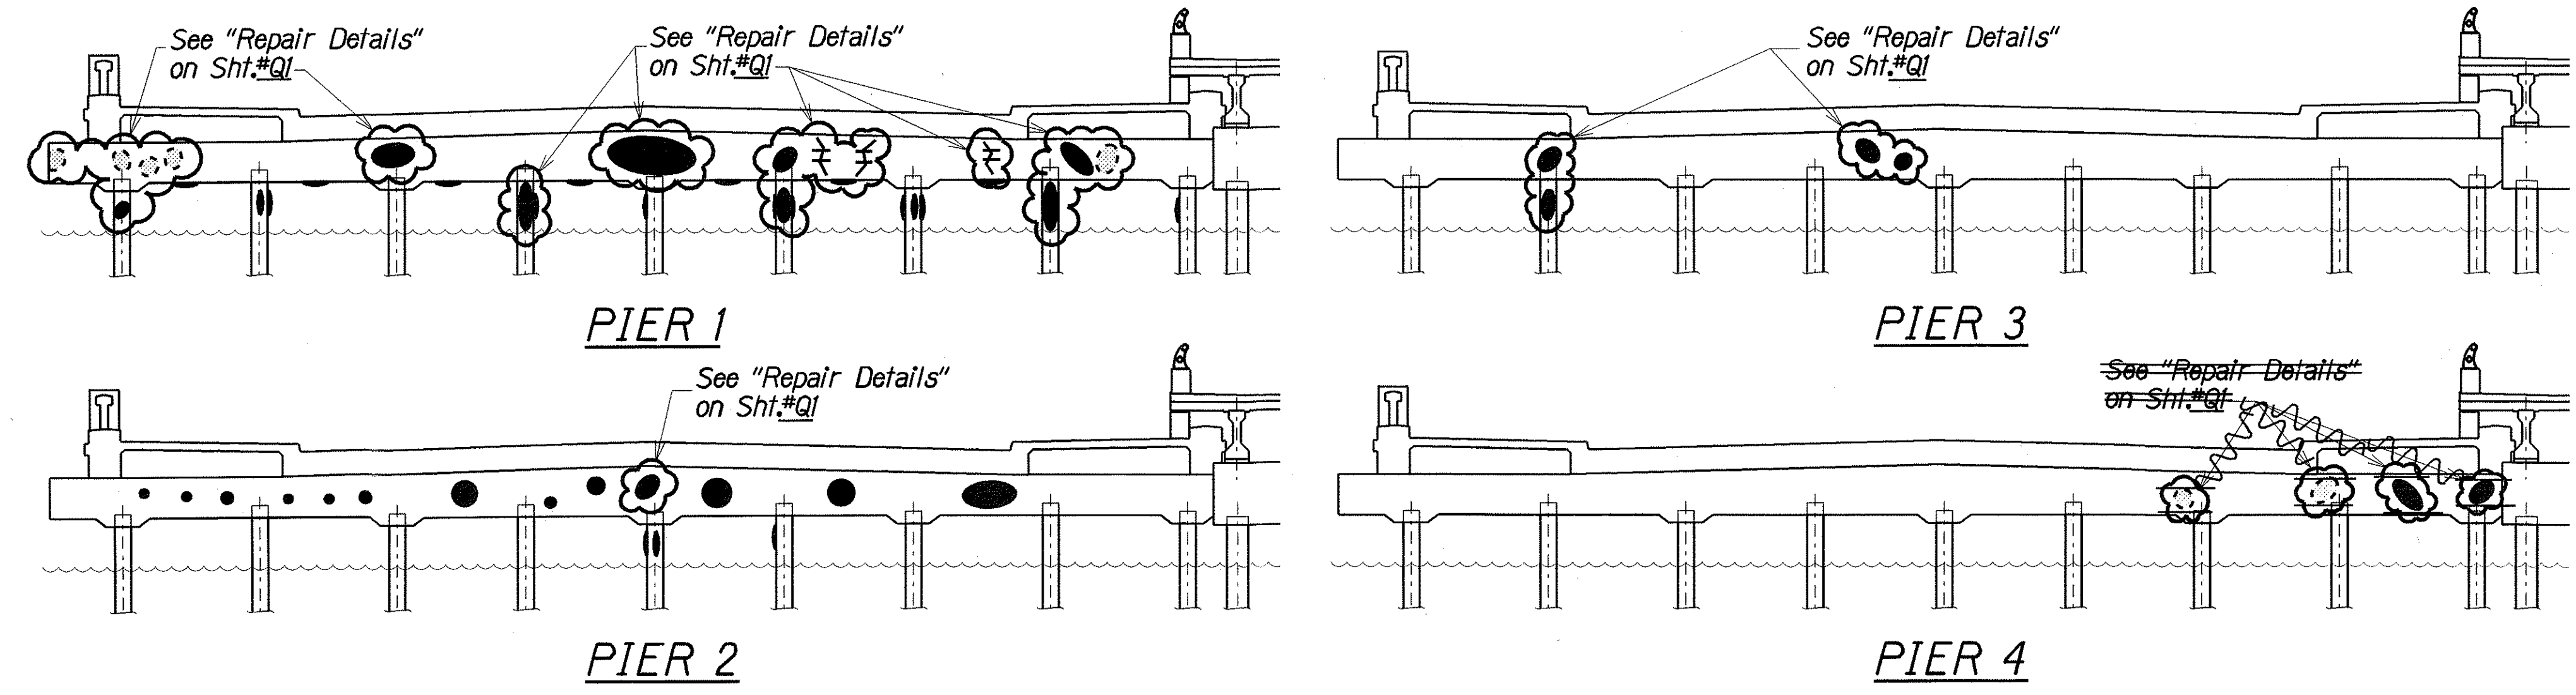


FED. ROAD DIST. NO.	STATE	PROJ. NO.	FISCAL YEAR	SHEET NO.	TOTAL SHEETS
HAWAII	HAW.	H11-03-96M	1996	3	3

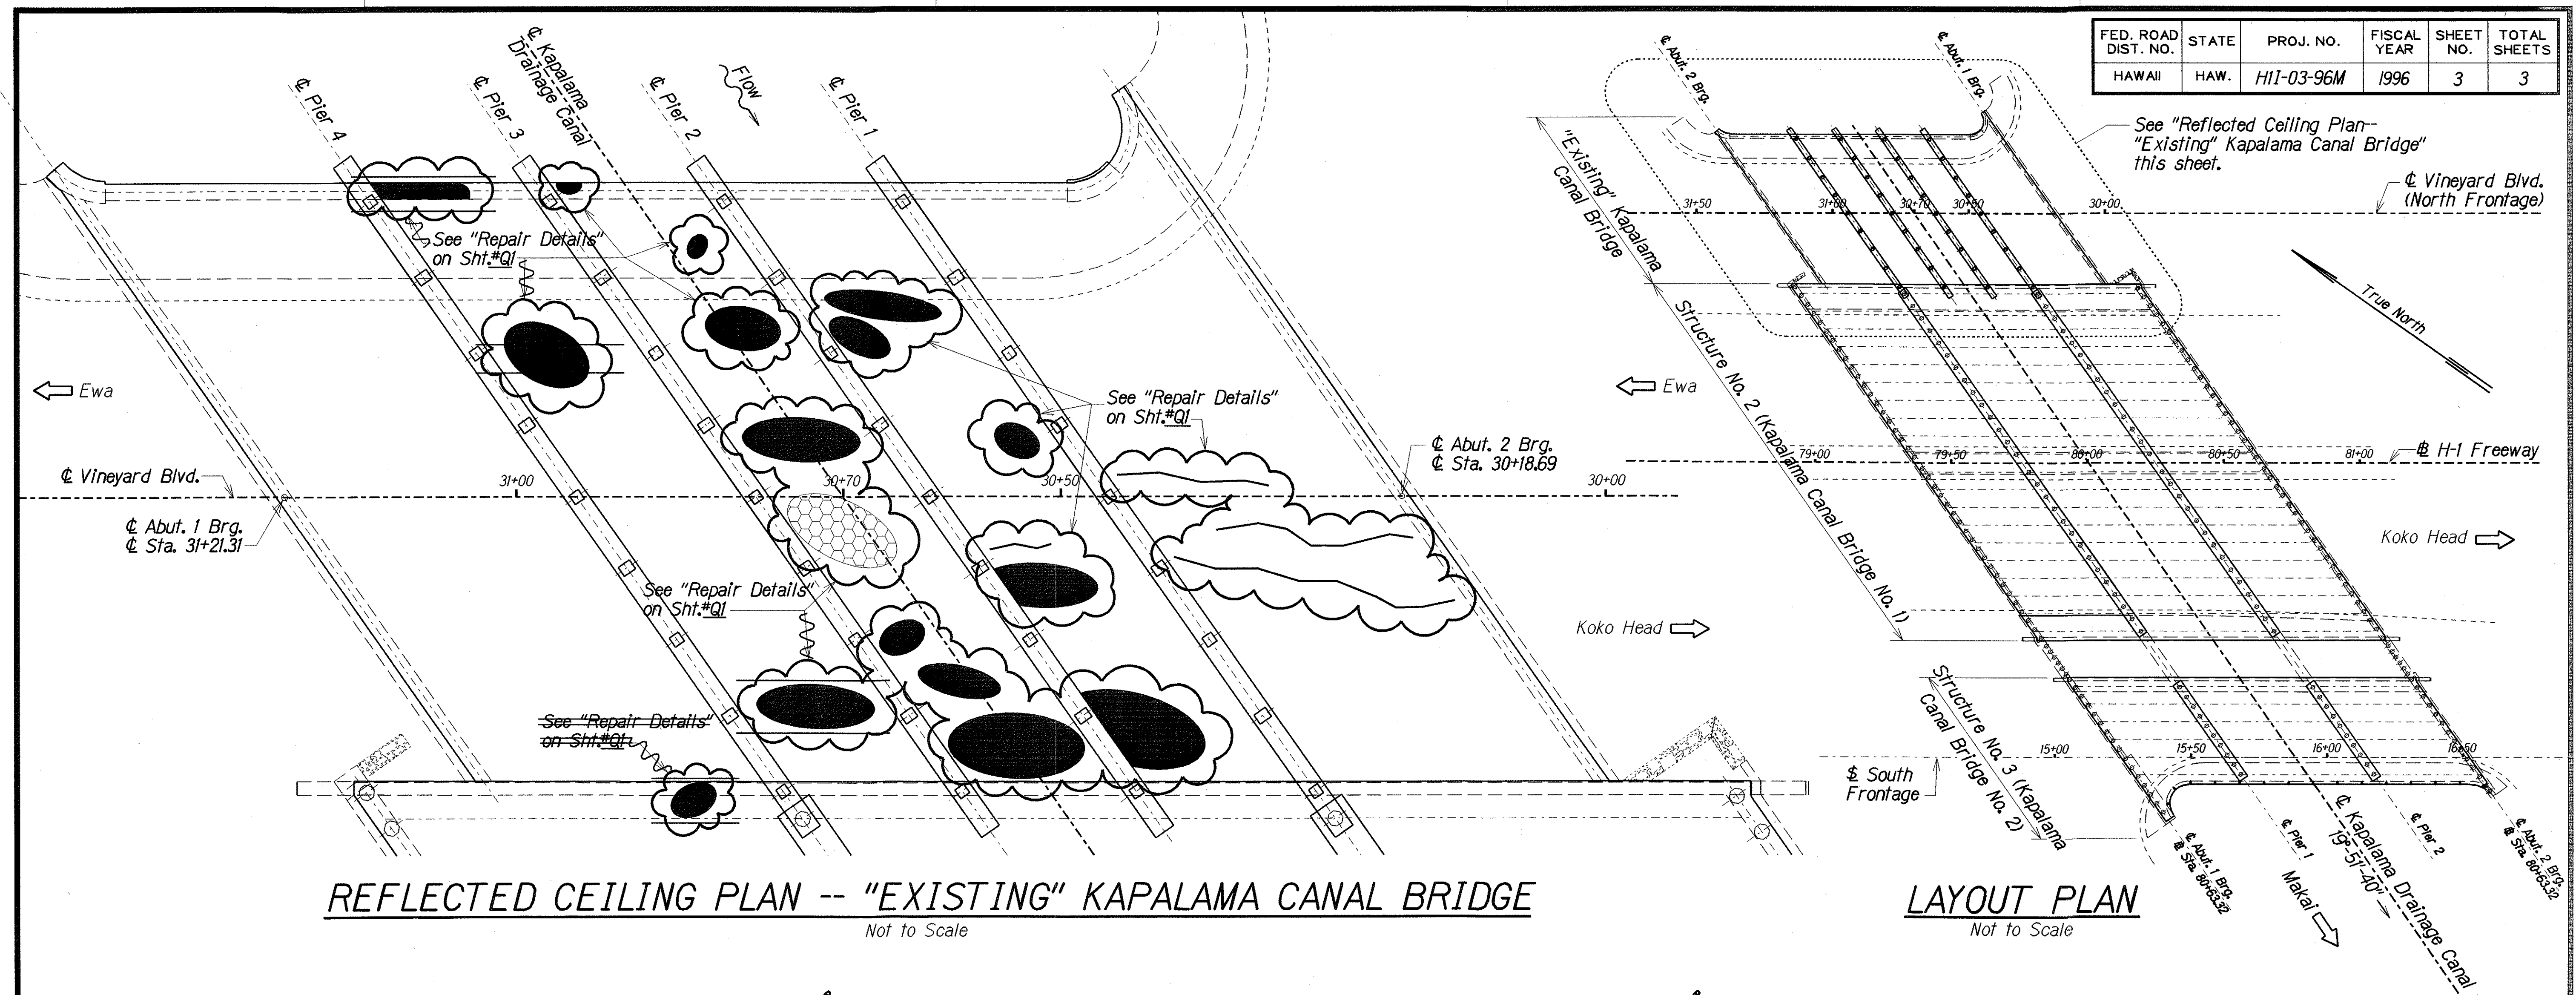

- Indicates Approximate Crack Location
- Indicates Approximate Honeycombed Spall Location
- Indicates Approximate Hidden Spall Location
- Indicates Approximate Spall Location

Note: Spall locations are for illustrative purposes only. Actual location to be determined by the Engineer in the field.

LEGEND FOR AS-BUILT POSTINGS	
	Squiggly line for as-built deletion
	Double line for as-built deletion
Roadway	Text for as-built posting

STATE OF HAWAII
DEPARTMENT OF TRANSPORTATION
HIGHWAYS DIVISION

SPALL REPAIR LOCATIONS
INTERSTATE ROUTE H-1
Repair Spalls at Soffit, Piles and Pier Caps
on Kapalama Canal Bridge
Proj. No. H11-03-96M

Scale: As Noted
Date: Feb, 1996

ORIGINAL PLAN	DATE	1996
DESIGNED BY	DATE	1996
CHECKED BY	DATE	1996
APPROVED BY	DATE	1996

"AS-BUILT"