STATE OF HAWAII

## DEPARTMENT OF TRANSPORTATION

HIGHWAYS DIVISION
HONOLULU, HAWAII

"AS-BUILT"

PLANS FOR

## INTERSTATE ROUTE H-1

REPAIR SPALLS AT SOFFIT, PILES AND PIER CAPS
ON KAPALAMA CANAL BRIDGE
PROJECT NO. H1I-03-96M

DISTRICT OF HONOLULU ISLAND OF OAHU

STREET

LAKIMELA

VINEYARD |

ROUTE

H-1

Kauluwela Elem. Sch.

BLVD.

PROJECT LOCATION —

HALONA STREET

OLOMEA STREET


CANAL BRIDGE

STREET


KAPALAMA

SCHOOL

KING

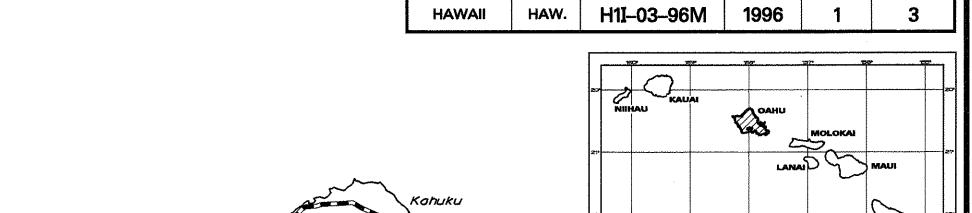

FED. ROAD DIST. NO. FED. AID PROJ. NO.

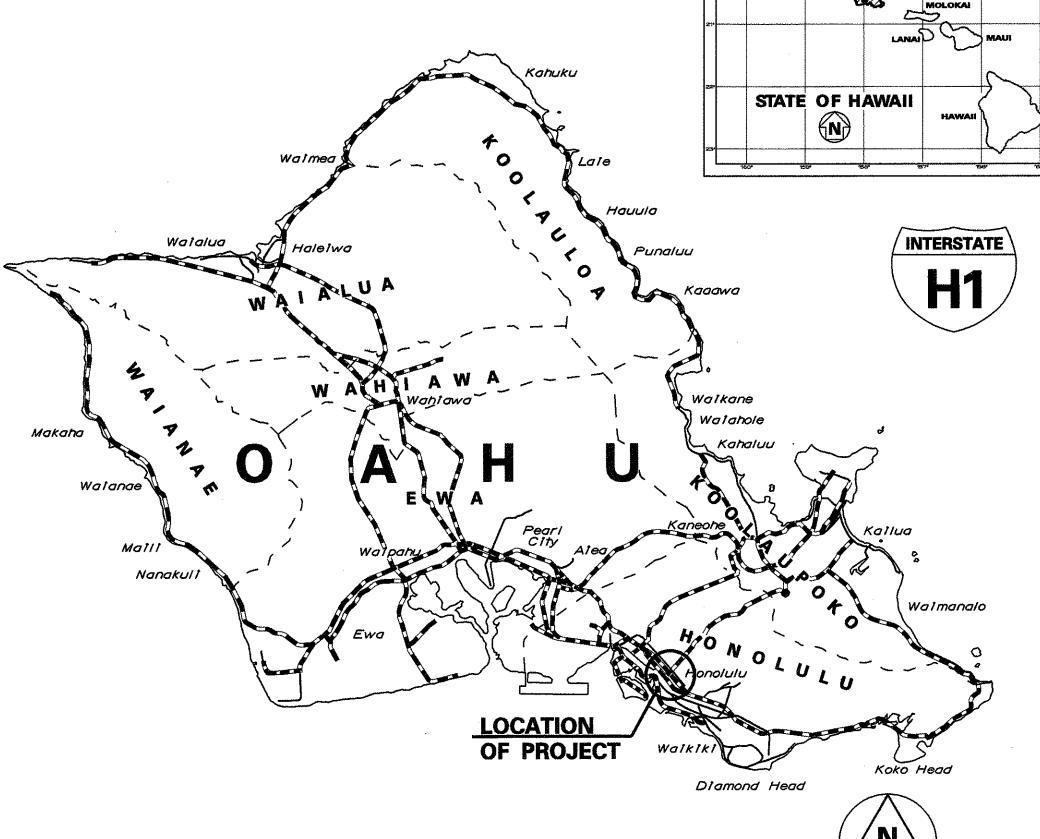

FEDERAL AID PROJECTS PREVIOUSLY CONSTRUCTED OR UNDER CONSTRUCTION


MILE POST <u>20.75</u>

CHANGES MADE DURING CONSTRUCTION HAVE
BEEN INCORPORATED ON THESE PLANS EXCEPT
CHANGES IN THE ORIGINAL THEORETICAL
QUANTITIES. FOR ACTUAL QUANTITIES, REFER TO
PROJECT LEDGER AND/OR COMPUTATION BOOK.

Kelvin Akazawa FOR RESIDENT ENGINEER

12 - 10 - 01 DATE

SCALE IN MILES

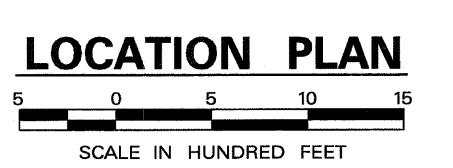

FEB., 1996 DATE

587-2249 PHONE

J. FUJIMOTO P. S. & E. BY

HWY-DB DESIGNED BY

DEPARTMENT OF TRANSPORTATION STATE OF HAWAII

APPROVED:

DIR. OF TRANSPORTATION

N DAT