

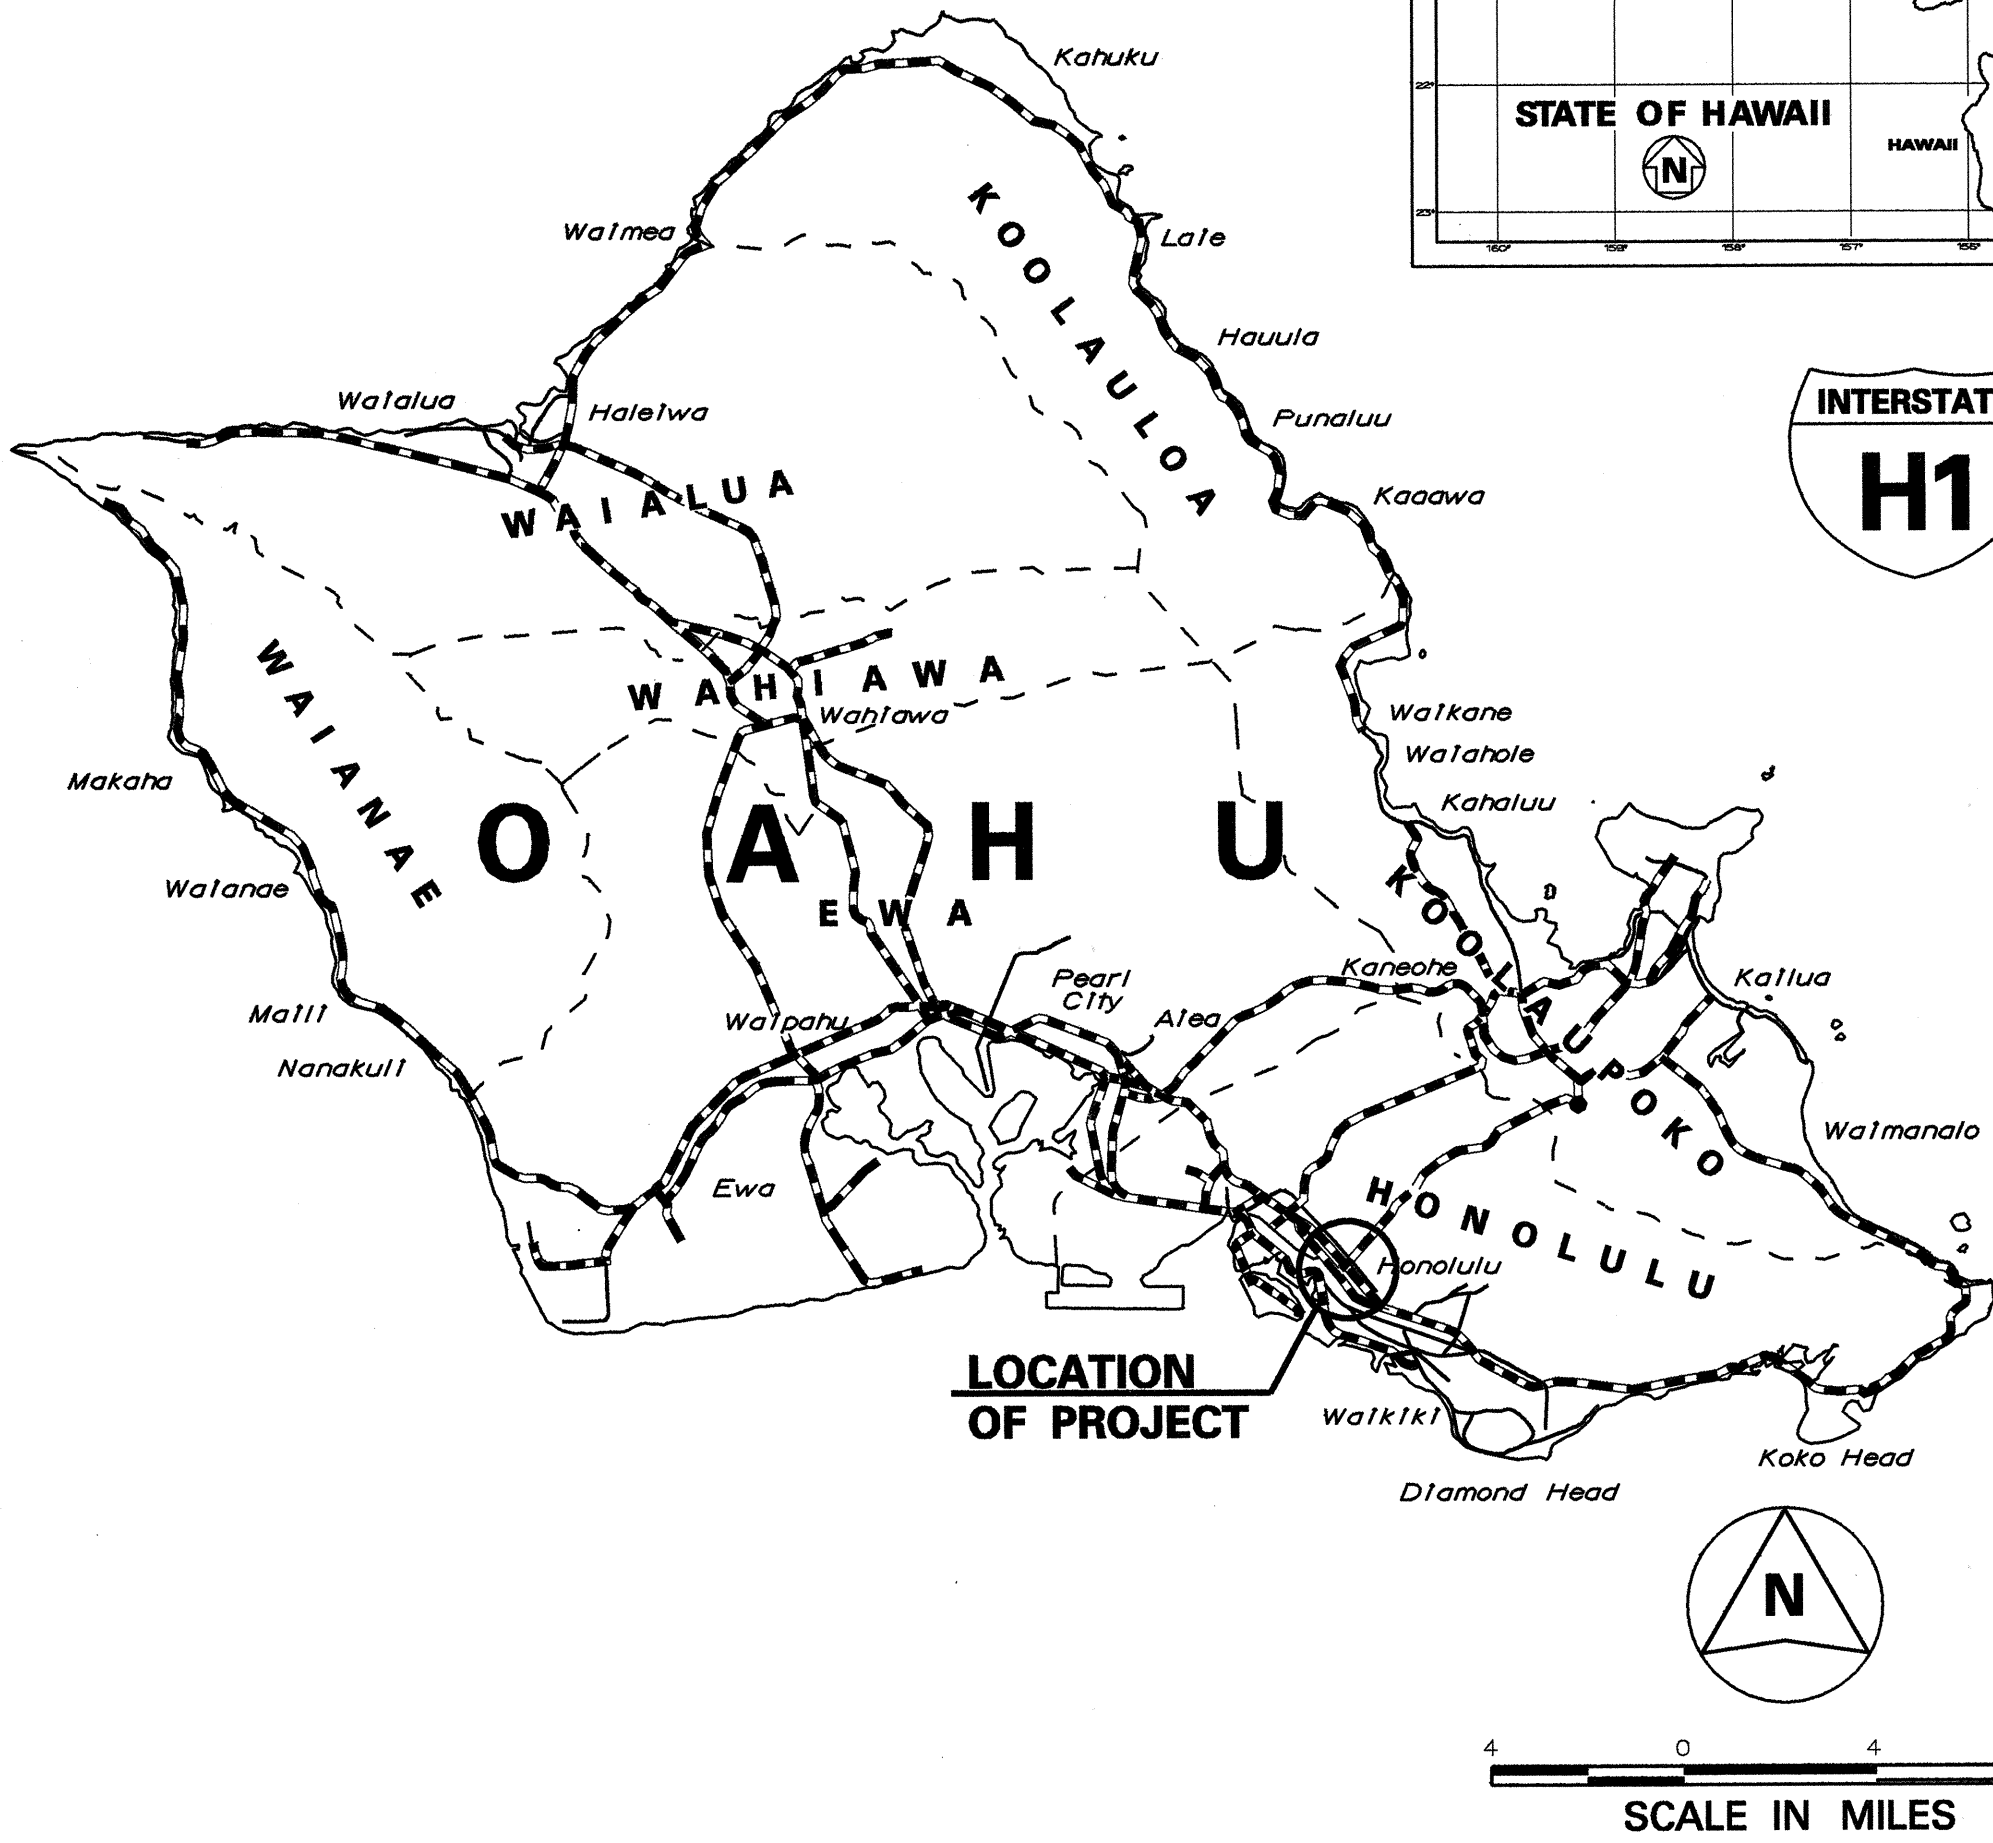


INDEX TO DRAWINGS	
SHEET NO.	DESCRIPTION
1	TITLE SHEET
2	STANDARD PLAN SUMMARY
3	TYPICAL CONCRETE REPAIRS, GENERAL NOTES AND ESTIMATED QUANTITIES
4	GULICK AVENUE OVERPASS, SPALL REPAIR LOCATIONS
5	AALA STREET EXTENSION SEPARATION, SPALL REPAIR LOCATIONS
6	TRAFFIC NOTES & SIGN DETAILS

FED. ROAD DIST. NO.	STATE	FED. AID PROJ. NO.	FISCAL YEAR	SHEET NO.	TOTAL SHEETS
HAWAII	HAW.	H1I-01-96M	1996	1	6

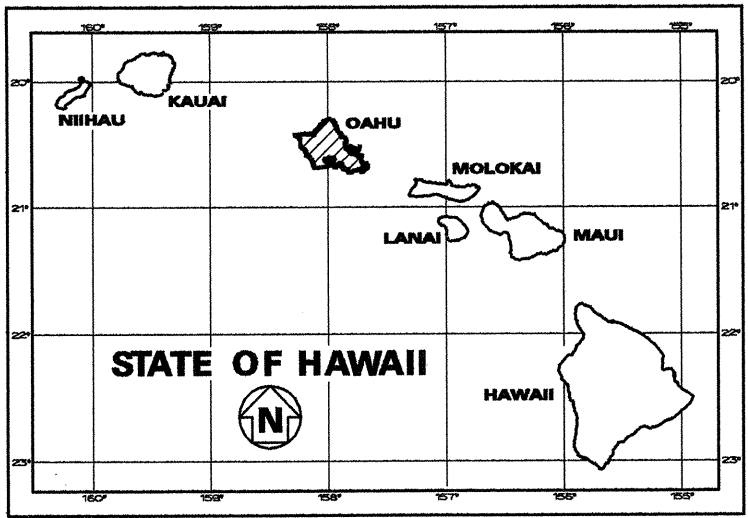

LOCATION OF PROJECT

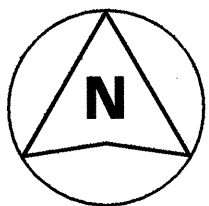

SCALE IN MILES

FEDERAL AID PROJECTS PREVIOUSLY CONSTRUCTED OR UNDER CONSTRUCTION

MILE POST 19.90 TO MILE POST 21.57

CHANGES MADE DURING CONSTRUCTION HAVE BEEN INCORPORATED ON THESE PLANS EXCEPT CHANGES IN THE ORIGINAL THEORETICAL QUANTITIES. FOR ACTUAL QUANTITIES, REFER TO PROJECT LEDGER AND/OR COMPUTATION BOOK.

*Kelvin Okagawa* 11-28-01  
FOR RESIDENT ENGINEER DATE

DEPARTMENT OF TRANSPORTATION  
STATE OF HAWAII  
APPROVED: *Kevin Okagawa* 1/22/96  
DIR. OF TRANSPORTATION DATE

STATE OF HAWAII

DEPARTMENT OF TRANSPORTATION

HIGHWAYS DIVISION

HONOLULU, HAWAII

"AS-BUILT"

PLANS FOR

H-1 GULICK AVENUE OVERPASS AND  
AALA STREET EXTENSION SEPARATION

REPAIR BEAM DAMAGE

PROJECT NO. H1I-01-96M


DISTRICT OF HONOLULU

ISLAND OF OAHU




GULICK AVENUE  
OVERPASS  
M.P. 19.90

AALA ST.  
EXTENSION  
SEPARATION  
M.P. 21.57

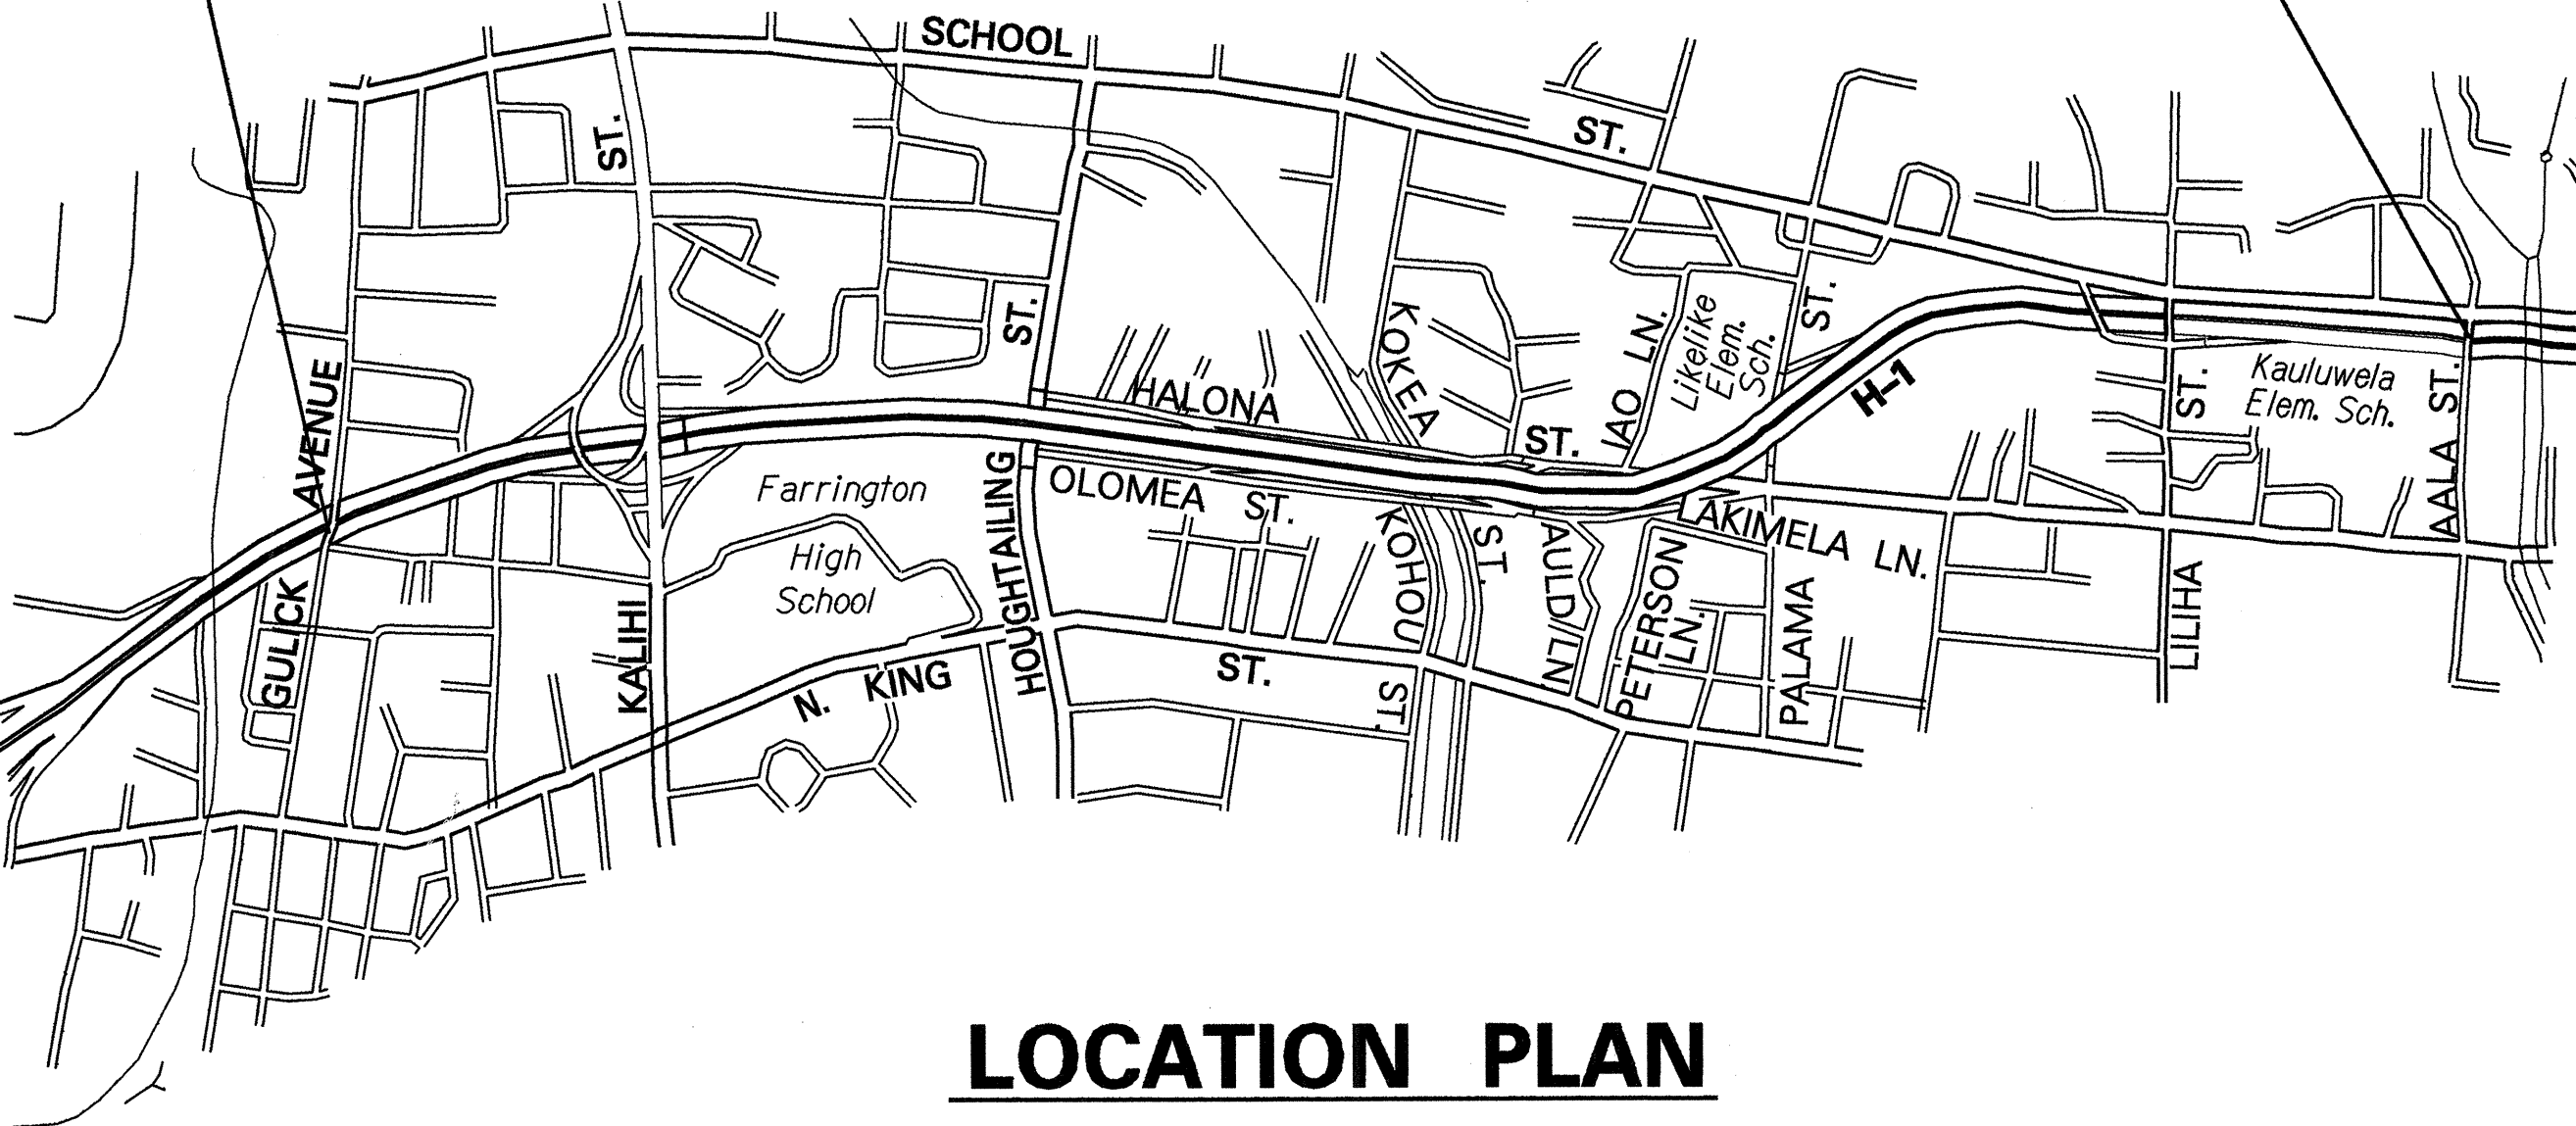

LOCATION PLAN

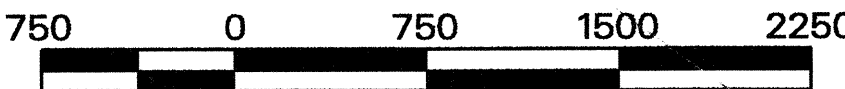

SCALE IN HUNDRED FEET

HWY-DB  
DESIGNED BY  
R. HIRONAKA  
P.S. & E. BY  
587-2250  
PHONE  
1/96  
DATE