

FED. ROAD
DIST. NO.STATEFED. AID
PROJ. NO.FISCAL
YEARSHEET
NO.TOTAL
SHEETSHAWAIIHAW.H1I-01-96M199666

Background - Yellow (Reflective) Legend - Black (Non-reflective)

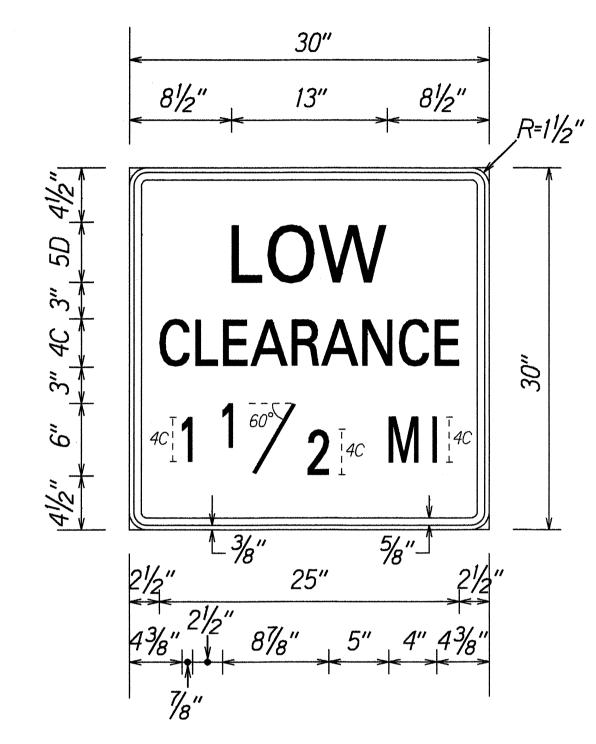

<u>W12-3b</u> Not to Scale

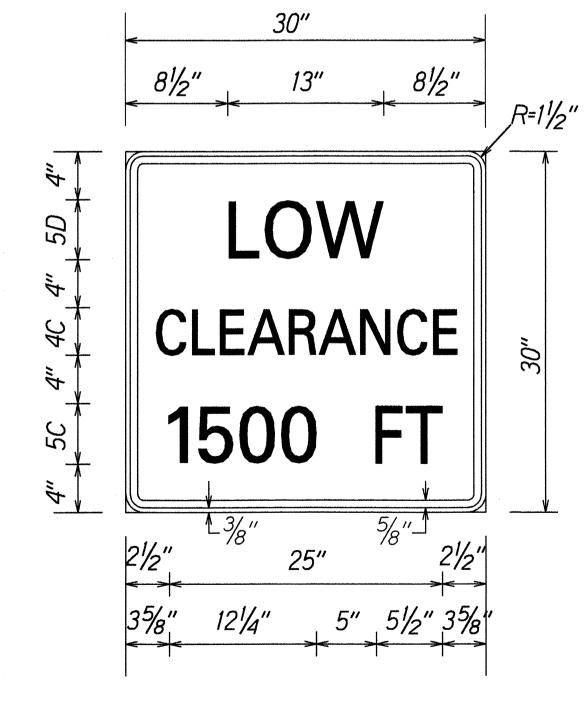

W12-2a

Not to Scale

TRAFFIC NOTES

- 1. Existing signs that are to be replaced shall not be removed until the new signs are installed as replacements.
- 2. The Contractor shall remove existing W12-2 signs and install new W12-2 signs (36" x 36") with supplementary Low Clearance signs (24" x 18"), 8 each, on the existing median pilar and road side structural walls. The Contractor shall verify the clearance height to the nearest inch not exceeding the actual clearance prior to manufacturing the new W12-2 signs. The Contractor shall also install a new W12-2 (48" x 48") \$\pm\$ W12-2a sign with posts at H-1 \$\mathbb{L}\$ Sta. 140+00± Lt. and sign W12-2 (48" x 48") \$\pm\$ W12-\frac{2}{2}b sign with posts at Moanalua Freeway \$\mathbb{L}\$ Sta. 304+00 Rt. The Contractor shall receive Engineer's approval prior to manufacturing \$\pm\$ installing the new W12-2 signs. The supplementary Low Clearance, W12-2a, \$\pm\$ W12-2b signs shall not be paid for separately but considered incidental to the W12-2 signs.
- 3. The Contractor shall erect at the beginning of the project and at the end of the project advance construction warning signs with posts as indicated below or as directed by the Engineer for the duration of the highway project and shall be maintained by the Contractor. These signs shall be placed in addition to the required traffic control signs called for in Section 645-Traffic Control. The advance construction warning signs shall be new and become the property of the State. The Contractor shall remove, clean, and deliver the signs and posts to the Oahu District Baseyard or as directed by the Engineer at the end of the project.

SIGN NO.	<u>LOCATION</u>
CW20-1Ad (ROAD WORK AHEAD -CW20-1d)) H-1 趣 Sta. 30+80± Rt.
CG20-2A (END ROAD WORK)	H-1 ₺ Sta. 30+80± Lt.
CW20-1Ad (ROAD WORK AHEAD CW20-1d))) H-1 ₺ Sta. 41+40± Lt.
CG20-2A (END ROAD WORK) CW20-2	H-1 ₺ Sta. 41+40± Rt.
CW20-1Ad (ROAD WORK AHEAD CW20-1d)) H-1 ₺ Sta. 119+15± Rt.
CG20-2A (END ROAD WORK)	H-1 ₺ Sta. 119+15± Lt.
CW20-1Ad (ROAD WORK AHEAD)) H-1
CG20-2A (END ROAD WORK) CW20-2	H-1 ₺ Sta. 129+75± Rt.

LEGEND FOR AS-BUILT POSTINGS

Squiggly line for as-built deletion

Double line for as-built deletion

Roadway Text for as-built posting

STATE OF HAWAII
DEPARTMENT OF TRANSPORTATION

TRAFFIC NOTES & SIGN DETAILS


H-1 GULICK AVENUE OVERPASS AND

AALA STREET EXTENSION SEPARATION

REPAIR BEAM DAMAGE

Project No. H1I-01-96M

Scale: As Shown Date: Feb., 1996

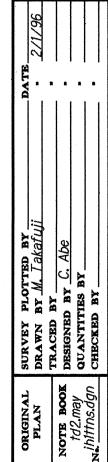

SHEET No. 1 OF 1 SHEETS