

STATE OF HAWAII

DEPARTMENT OF TRANSPORTATION


HIGHWAYS DIVISION HONOLULU, HAWAII "AS-BUILT"

PLANS FOR

INTERSTATE ROUTE H-1

PEARL CITY VIADUCT, REPAIR DECK SPALLS PROJECT NO. H1E-02-97M


> DISTRICT OF EWA ISLAND OF OAHU

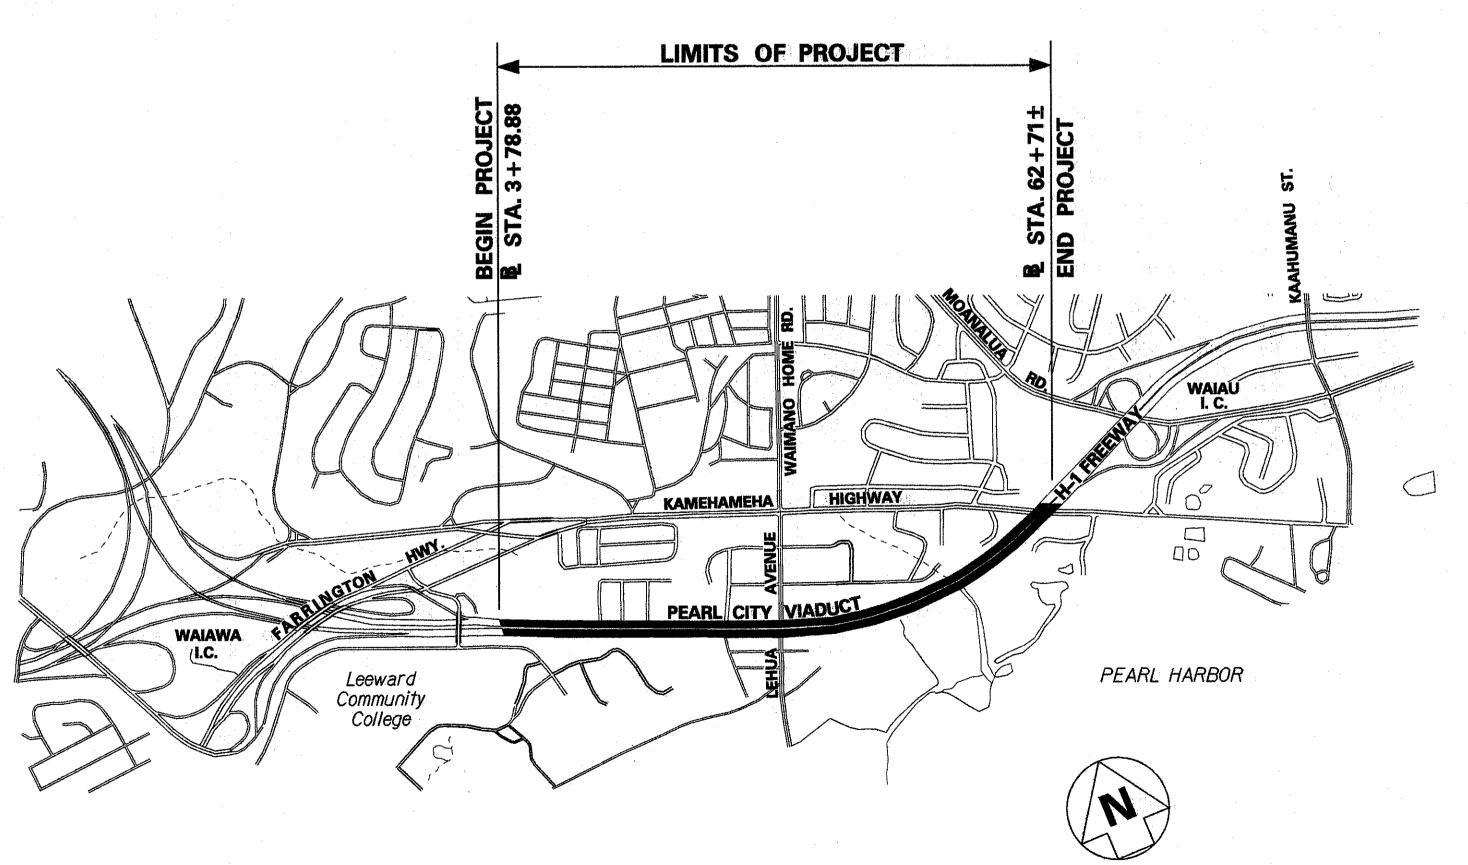

STATE OF HAWAII

FED. ROAD DIST. NO.

H1E-O2-97M

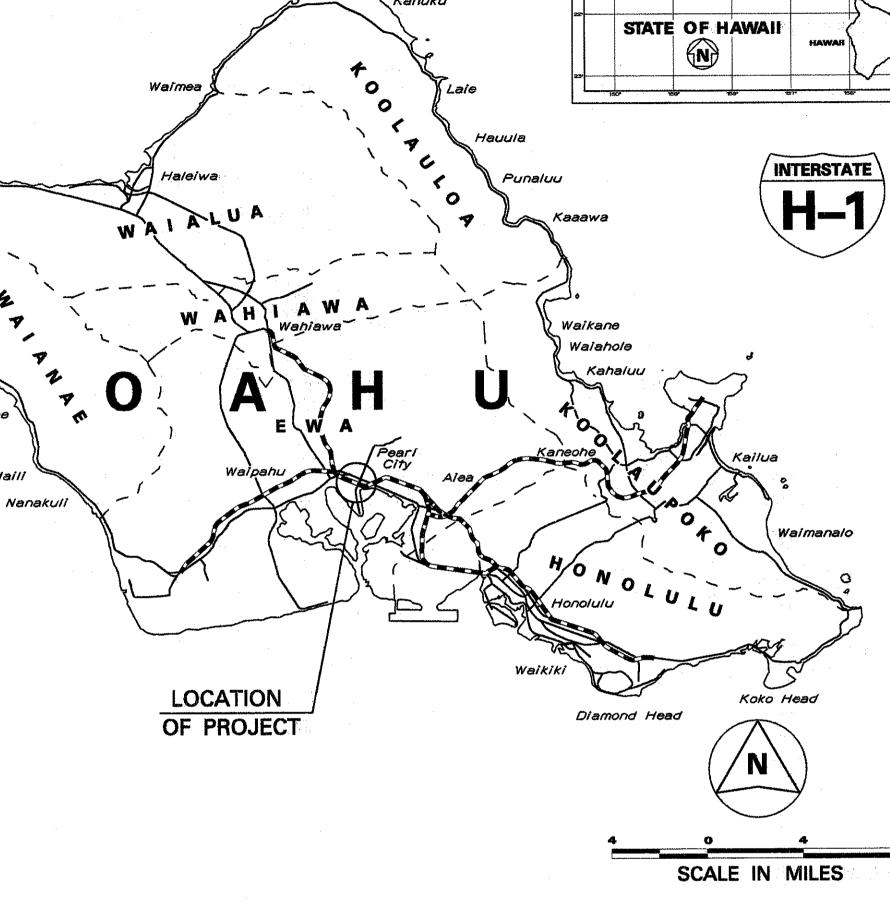

MILE POST 9.23 TO MILE POST 10.34

NO SIGNIFICANT CHANGES WERE MADE DURING CONSTRUCTION ON THESE PLANS EXCEPT CHANGES IN THE ORIGINAL THEORETICAL QUANTITIES. FOR ACTUAL QUANTITIES, REFER TO PROJECT LEDGER AND/OR COMPUTATION BOOK.

RESIDENT ENGINEER

DEPARTMENT OF TRANSPORTATION STATE OF HAWAII APPROVED: DIR. OF TRANSPORTATION

LAYOUT PLAN

SCALE IN THOUSAND FEET

LENGTH OF PROJECT..... 1.11 MILES