
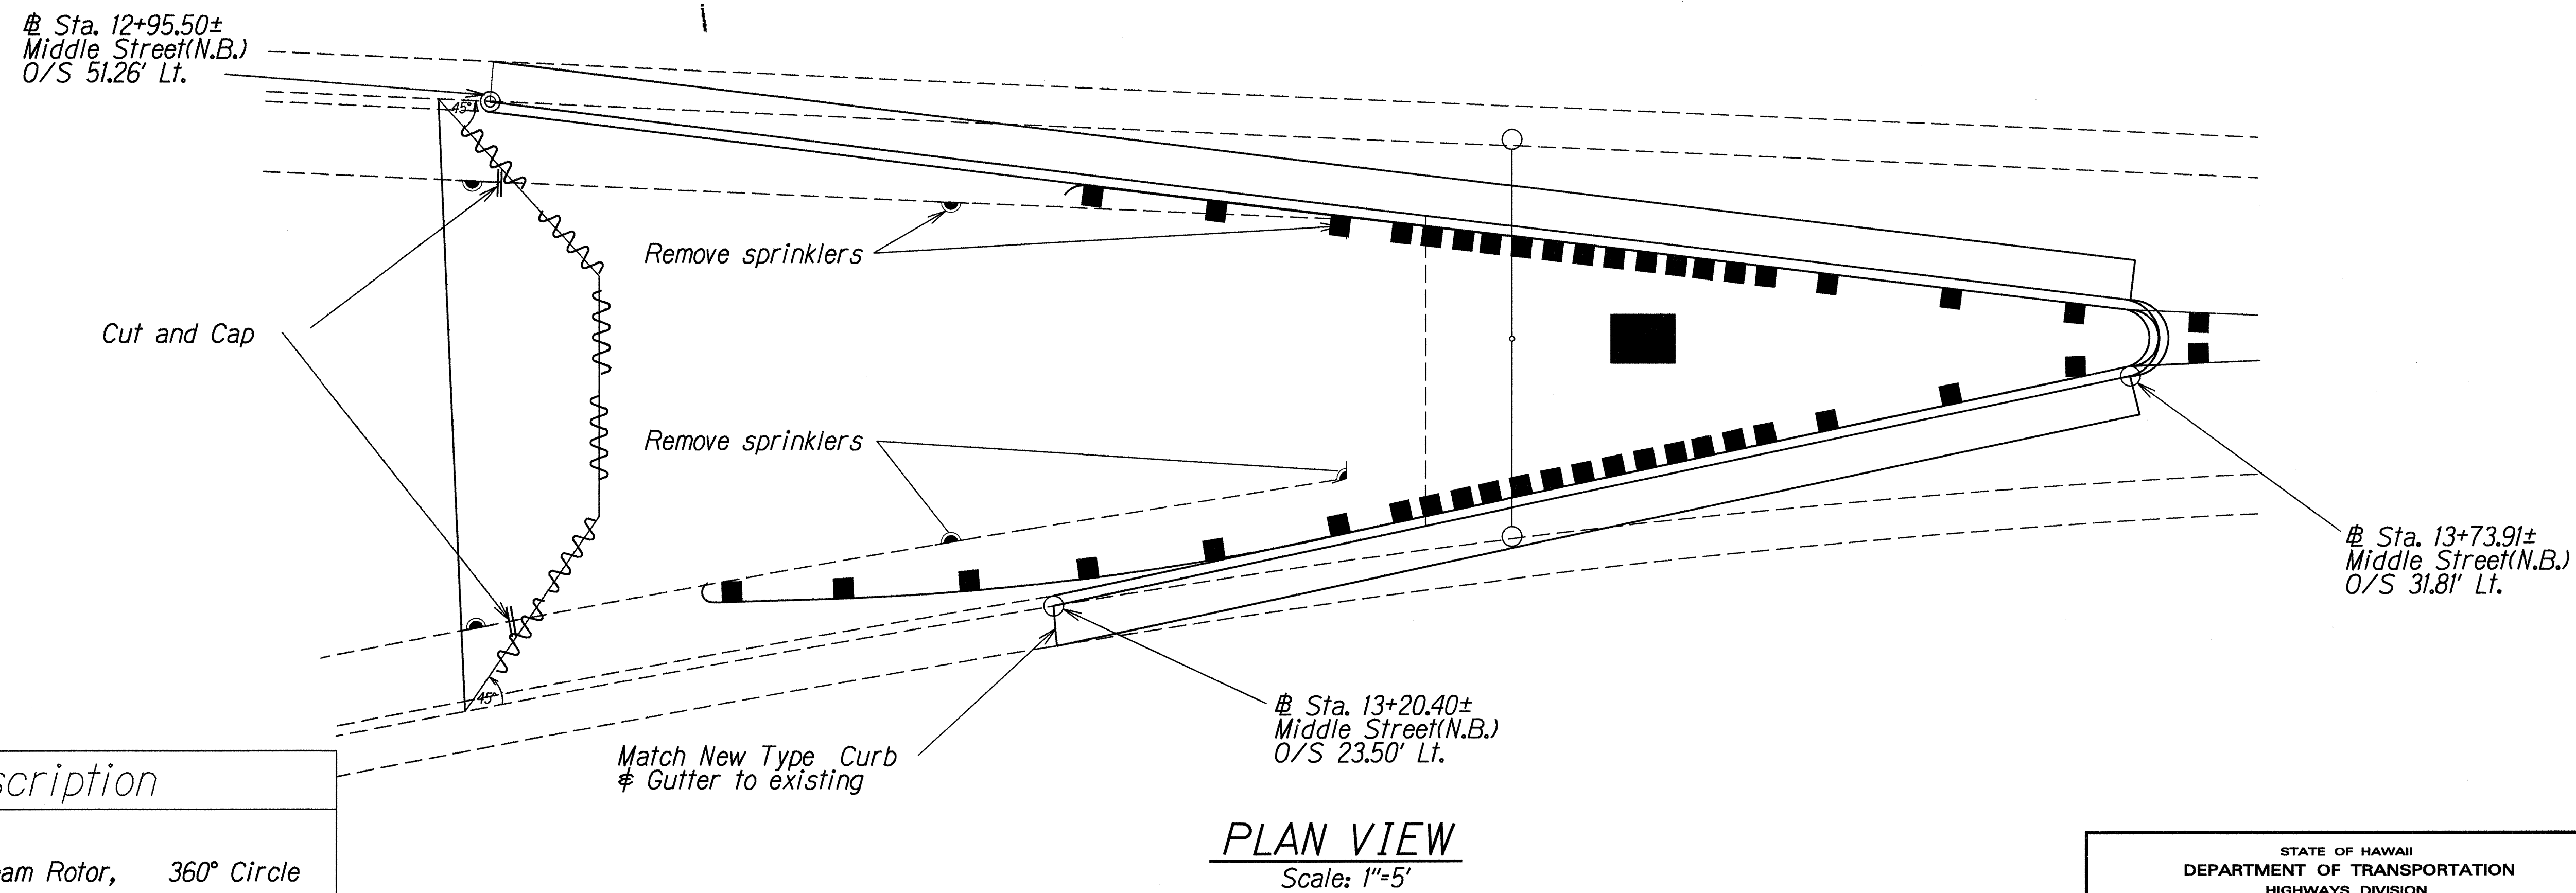


FED. ROAD DIST. NO.	STATE	PROJ. NO.	FISCAL YEAR	SHEET NO.	TOTAL SHEETS
HAWAII	HAW.	HIH-01-97M	1997	25	26

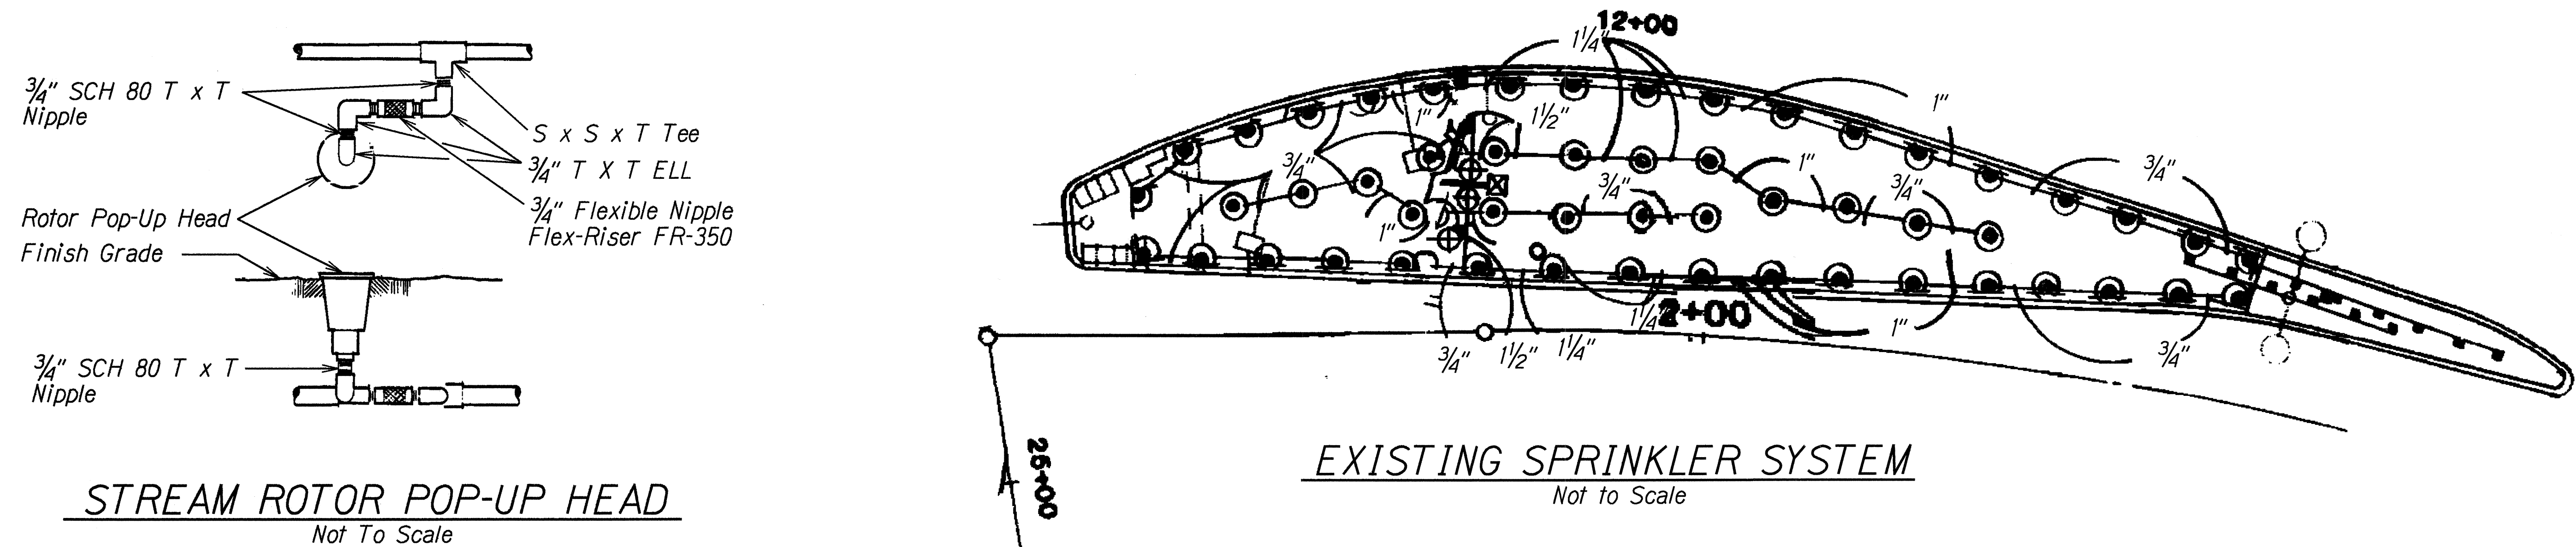

Symbol	Description
	3' Pop-Up Stream Rotor, 360° Circle
	3' Pop-Up Stream Rotor, 180° Circle
	3' Pop-Up Stream Rotor, 120° Circle
	3' Pop-Up Stream Rotor, 90° Circle

LEGEND FOR AS-BUILT POSTINGS	
	Squiggly line for as-built deletion
	Double line for as-built deletion
Roadway	Text for as-built posting

STATE OF HAWAII
DEPARTMENT OF TRANSPORTATION
HIGHWAYS DIVISION

SPRINKLER SYSTEM MODIFICATION DETAIL
INTERSTATE ROUTE H-1
AND MIDDLE STREET RESURFACING
North King St. to Kamehameha Hwy.
Project No. HIH-01-97M
Not to Scale Date: May, 1997

SHEET No. 1 OF 1 SHEETS

ORIGINAL PLAN	SURVEY PLOTTED BY	DATE
NOTE BOOK	DRAWN BY	3/10/99
QUANTITIES BY	DESIGNED BY	
CHECKED BY	APPROVED BY	