

INDEX TO DRAWINGS	
SHEET NO.	DESCRIPTION
1	TITLE SHEET
2	STANDARD PLANS SUMMARY
3	GENERAL NOTES AND LEGEND
4	UTILITY NOTES
5 - 6	TYPICAL SECTIONS
7	CURB RAMP DETAIL
8 - 12	ROADWAY PLANS
13 - 14	MEDIAN, GUARDRAIL & QUADGUARD RECONSTRUCTION DETAIL
15	DRAINAGE DETAIL
16	PAVEMENT MARKING LEGEND, DETAILS & NOTES
17 - 20	PAVEMENT MARKING & SIGNING PLANS
21	LOOP DETECTOR PLAN
22	TRAFFIC SUMMARIES
23 - 24	LOOP DETECTOR DETAILS
25	SPRINKLER SYSTEM MODIFICATION DETAIL
26	NPDES NOTES

STATE OF HAWAII

DEPARTMENT OF TRANSPORTATION

HIGHWAYS DIVISION

HONOLULU, HAWAII

"AS-BUILT"

PLANS FOR

INTERSTATE ROUTE H-1


AND MIDDLE STREET RESURFACING

NORTH KING STREET TO KAMEHAMEHA HIGHWAY



PROJECT NO. H1H-01-97M

DISTRICT OF HONOLULU

ISLAND OF OAHU

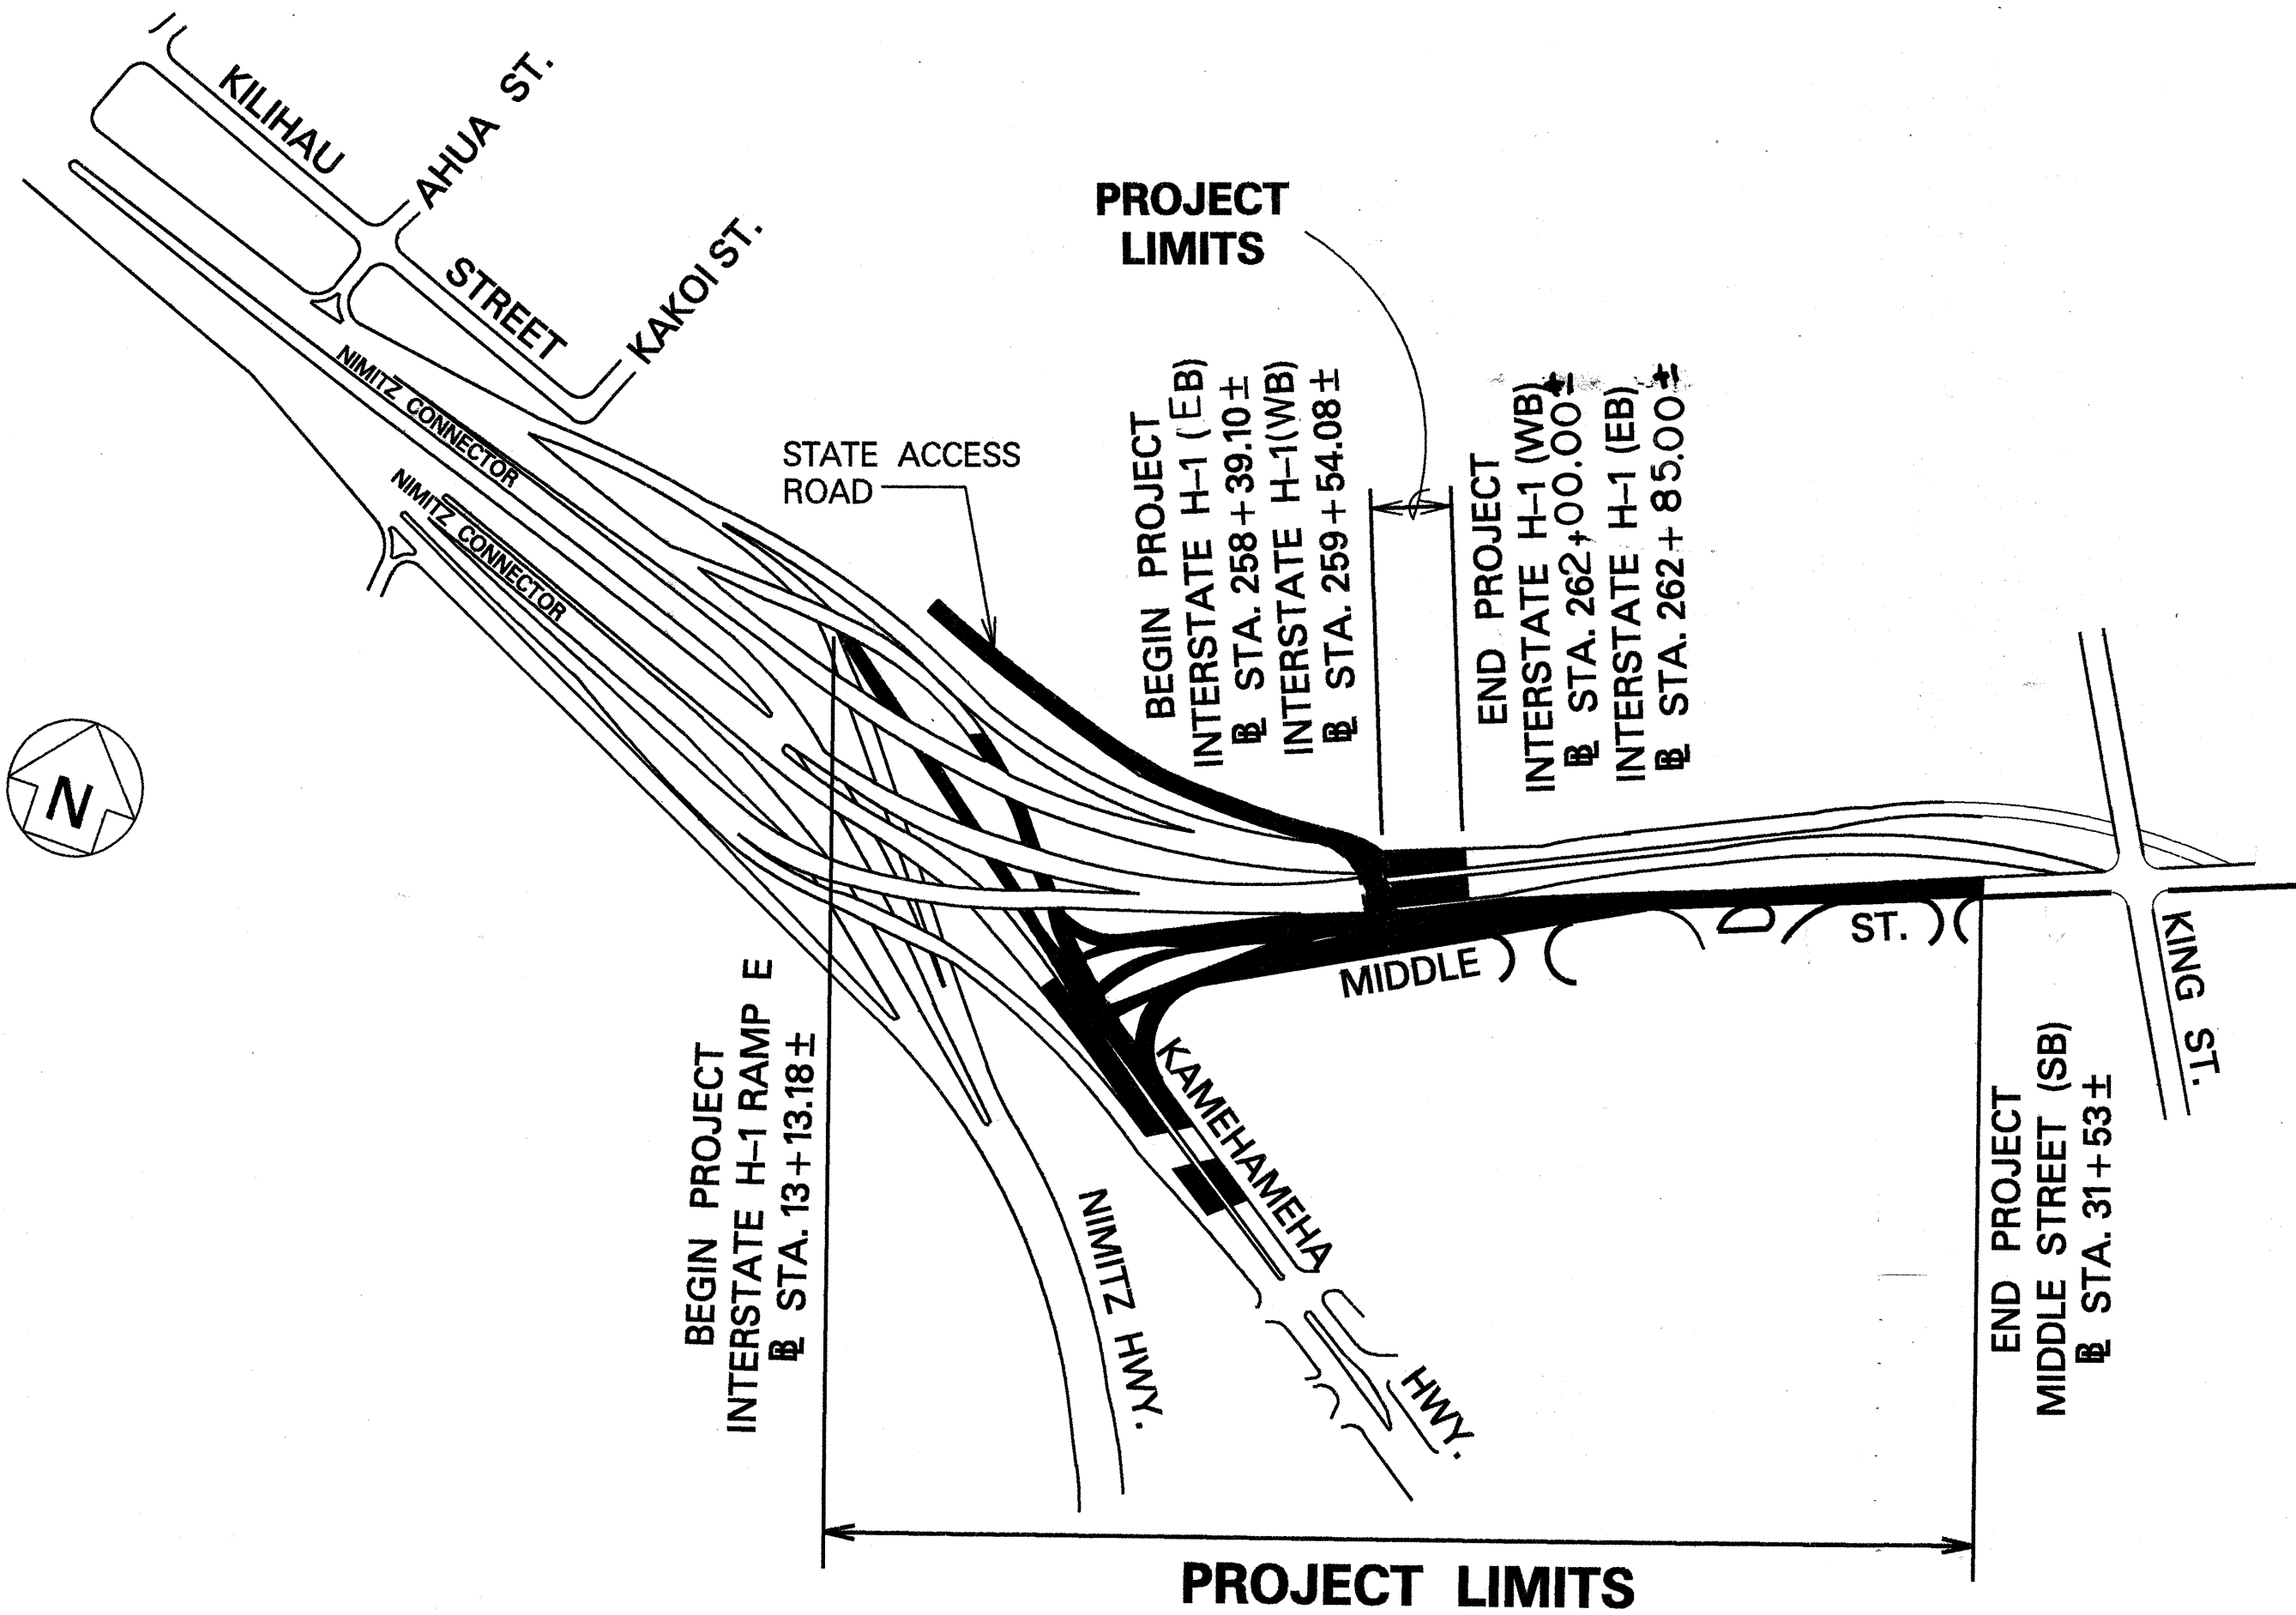

FED. ROAD DIST. NO.	STATE	PROJ. NO.	FISCAL YEAR	SHEET NO.	TOTAL SHEETS
HAWAII	HAW.	H1H-01-97M	1997	1	26

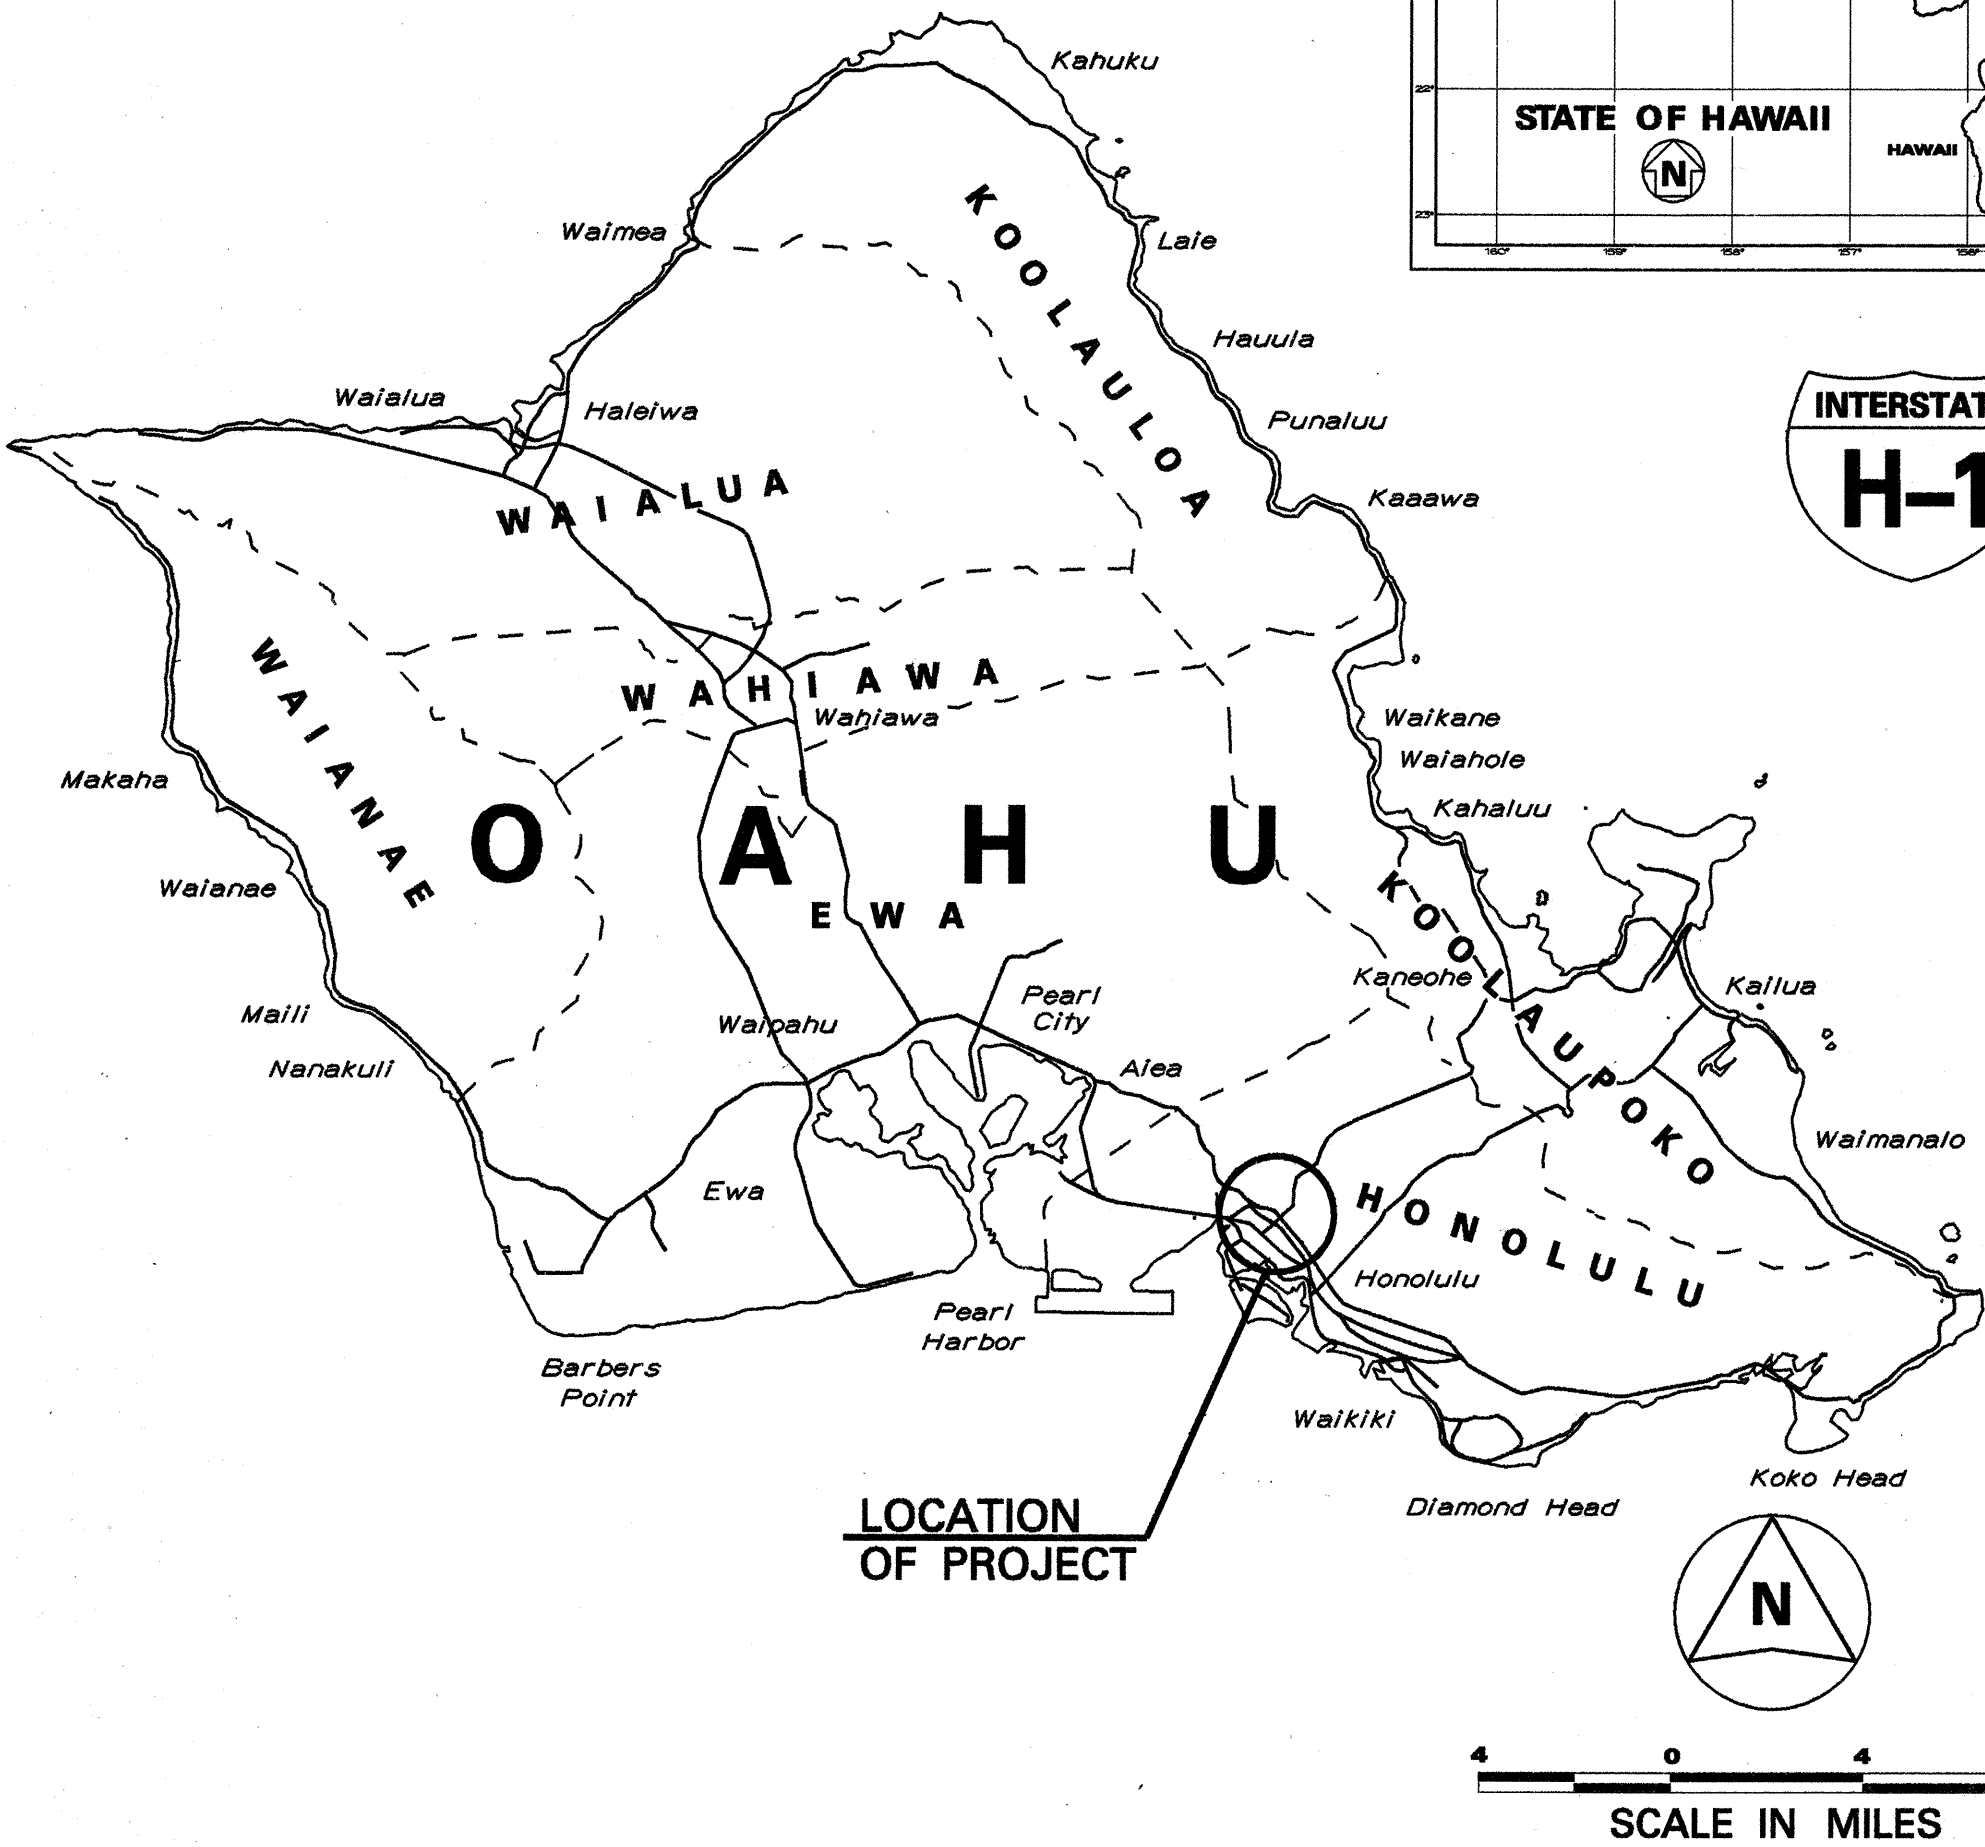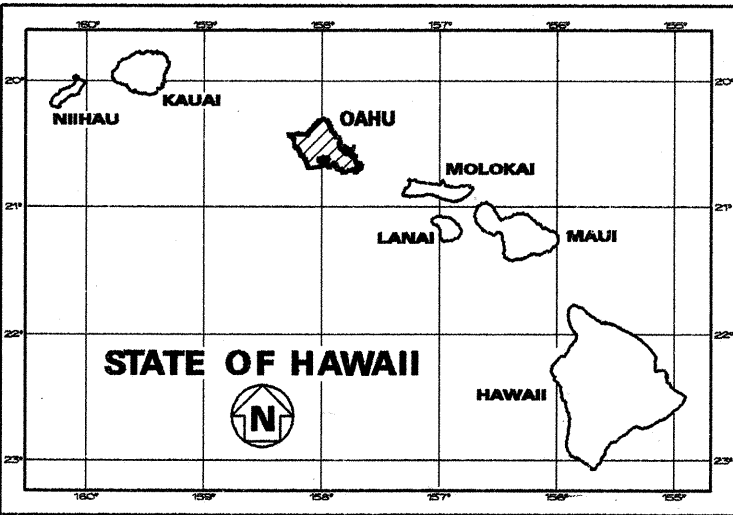

H-1 MILE POST 18.55 TO MILE POST 18.62
MIDDLE STREET MILE POST 0 TO MILE POST 2.84

CHANGES MADE DURING CONSTRUCTION HAVE BEEN INCORPORATED ON THESE PLANS EXCEPT CHANGES IN THE ORIGINAL THEORETICAL QUANTITIES. FOR ACTUAL QUANTITIES, REFER TO PROJECT LEDGER AND/OR COMPUTATION BOOK.

RESIDENT ENGINEER 4/5/99
DATE

DEPARTMENT OF TRANSPORTATION STATE OF HAWAII	
APPROVED:	5/30/97
DIR. OF TRANSPORTATION	DATE

HWY-DD, UNIT "E" DESIGNED BY J. FUJIMOTO P.S. & E. BY 587-2249 PHONE MAY 1997 DATE