



FED. ROAD DIST. NO.	STATE	FED. AID PROJ. NO.	FISCAL YEAR	SHEET NO.	TOTAL SHEETS
HAWAII	HAW.	IM-HI-1(222)	1997	4	104

MAKAKILO KAPOLEI MAKAKILO G-PLAN DGN

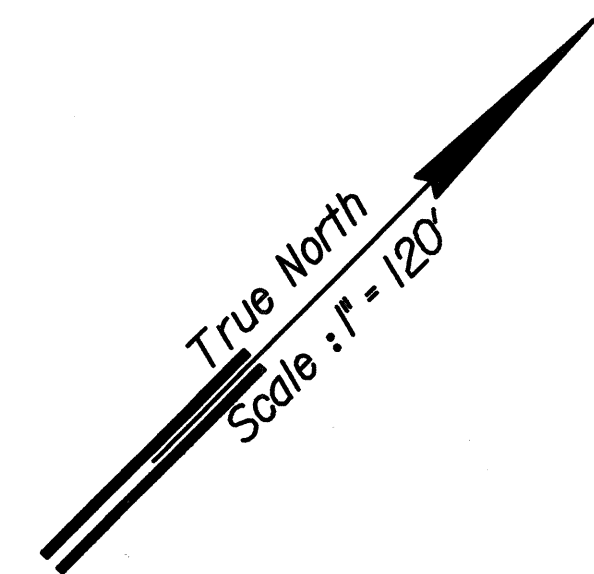


MAKAKILO SUBDIVISION

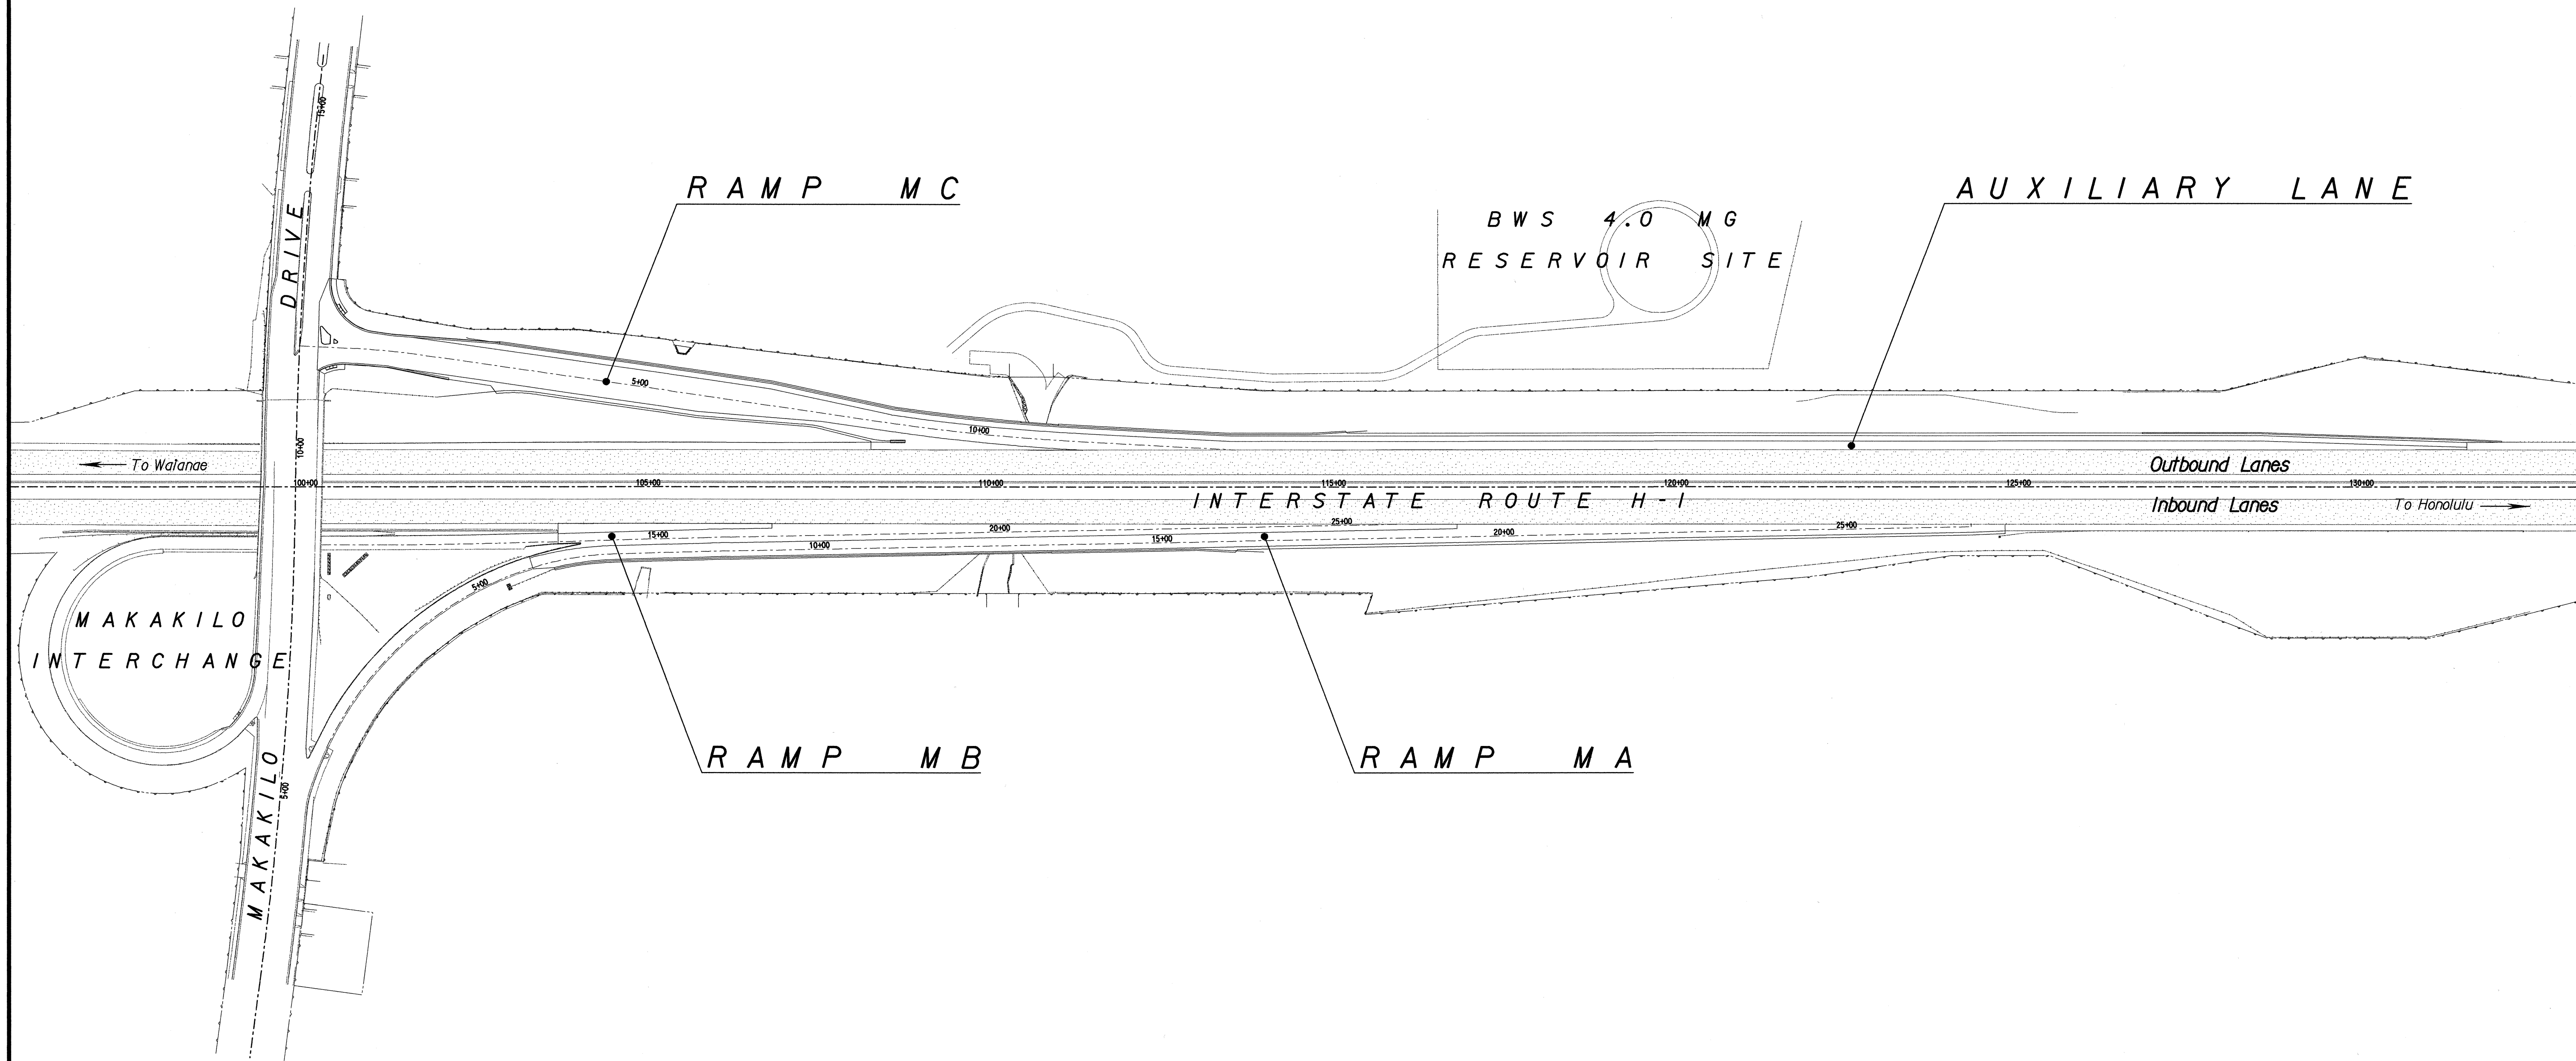

KAPOLEI SUBDIVISION

ORIGINAL PLAN	DATE
SURVEY PLOTTED BY	
DRAWN BY	
TRACED BY	
CHECKED BY	
NOTED BY	
QUANTITIES BY	
CHECKED BY	

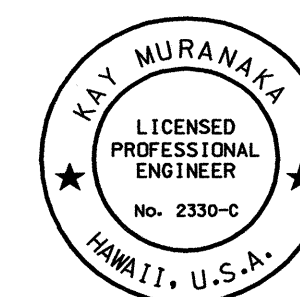

THIS WORK WAS PREPARED BY ME OR UNDER MY SUPERVISION

Kay Muranaka

STATE OF HAWAII
DEPARTMENT OF TRANSPORTATION
HIGHWAYS DIVISION


GENERAL PLAN

*INTERSTATE ROUTE H-1
Makakilo Interchange Improvements
to Westbound Off-Ramp and
Eastbound On-Ramps*

Scale: 1" = 120' Date: May 9, 1997

SHEET No. C-1 OF 4 SHEETS

M:\DGN\KAPOLEI\MAKAKILO\TYPESECTION

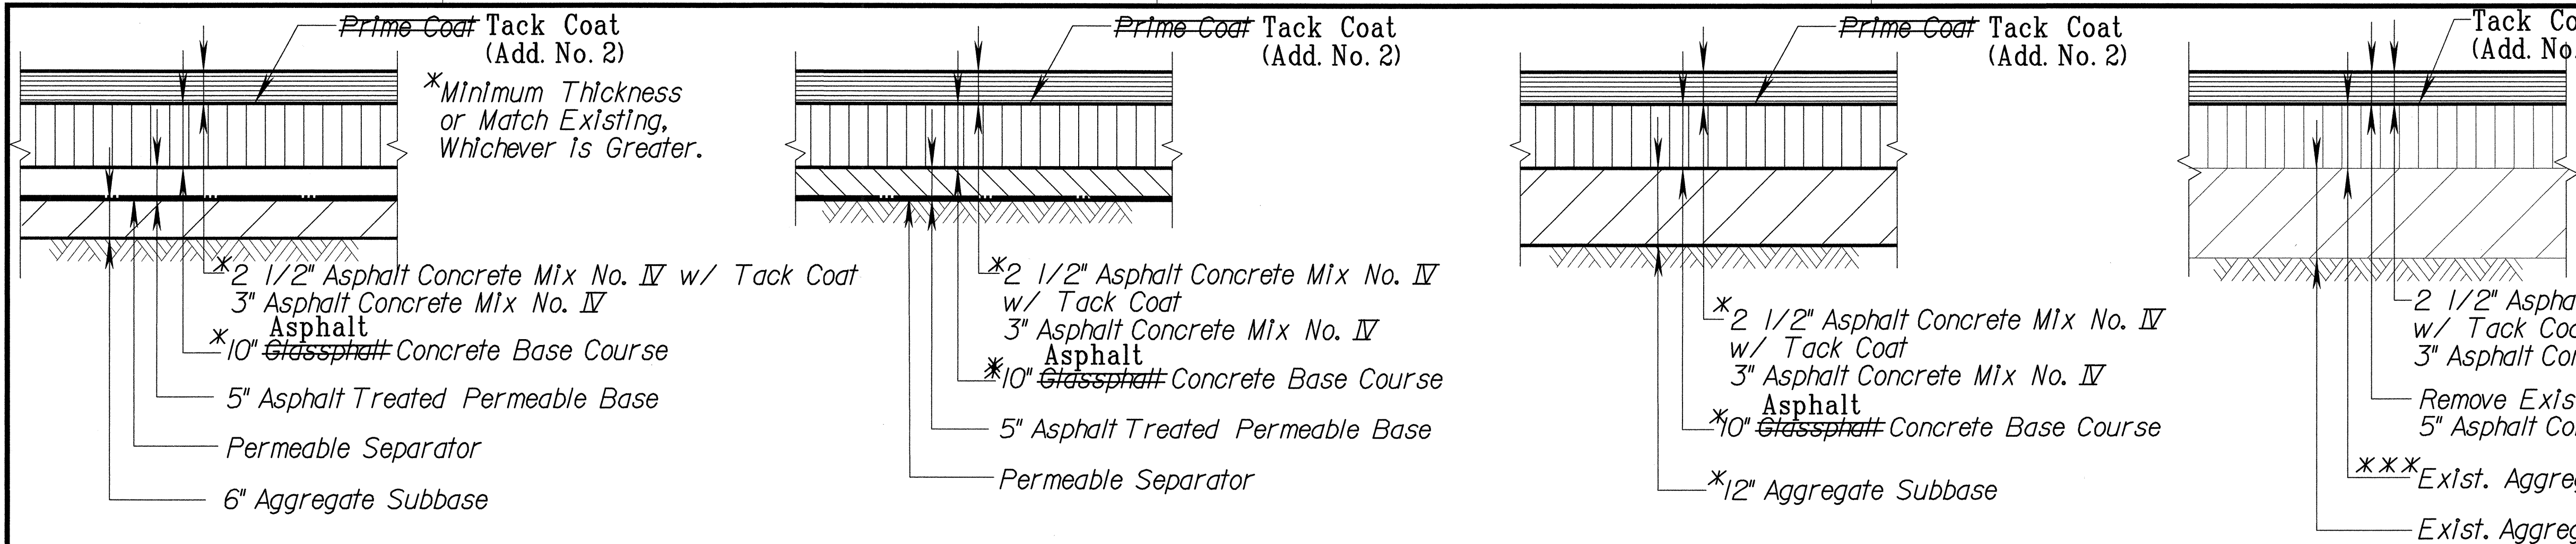

FED. ROAD DIST. NO.	STATE	FED. AID PROJ. NO.	FISCAL YEAR	SHEET NO.	TOTAL SHEETS
HAWAII	HAW.	IM-HI-1(222)	1997	5	104

RAMP MA (H-1 STA. 102+00 TO STA. 114+00)
RAMP MB (H-1 STA. 102+50 TO STA. 112+50)
RAMP MC (STA. 0+27 TO STA. 13+75.20)
AUX. LANE (H-1 STA. 113+57 TO STA. 115+00 & H-1 STA. 126+00 TO STA. 132+07)

RAMP MA (H-1 STA. 114+00 TO STA. 124+80)
AUX. LANE (H-1 STA. 115+00 TO STA. 126+00)

RAMP MC (STA. 0+27 TO STA. 13+75.20)


PAVEMENT STRUCTURE **A**
No Scale

PAVEMENT STRUCTURE **B**
No Scale


PAVEMENT STRUCTURE **C**
No Scale

***Scarify Exposed Aggregate Base Course & Add Aggregate Base Course as Necessary to Maintain Pre-Existing Grades & Compact to 95% Minimum. This Work Is Incidental to the Removal of Existing Asphalt Concrete Pavement.
RAMP MA (H-1 STA. 102+50 TO STA. 115+80)
RAMP MB (H-1 STA. 103+68 TO STA. 115+00)
RAMP MC (H-1 STA. 100+00 TO STA. 114+00)



(RESURFACING)
PAVEMENT STRUCTURE **D**
No Scale

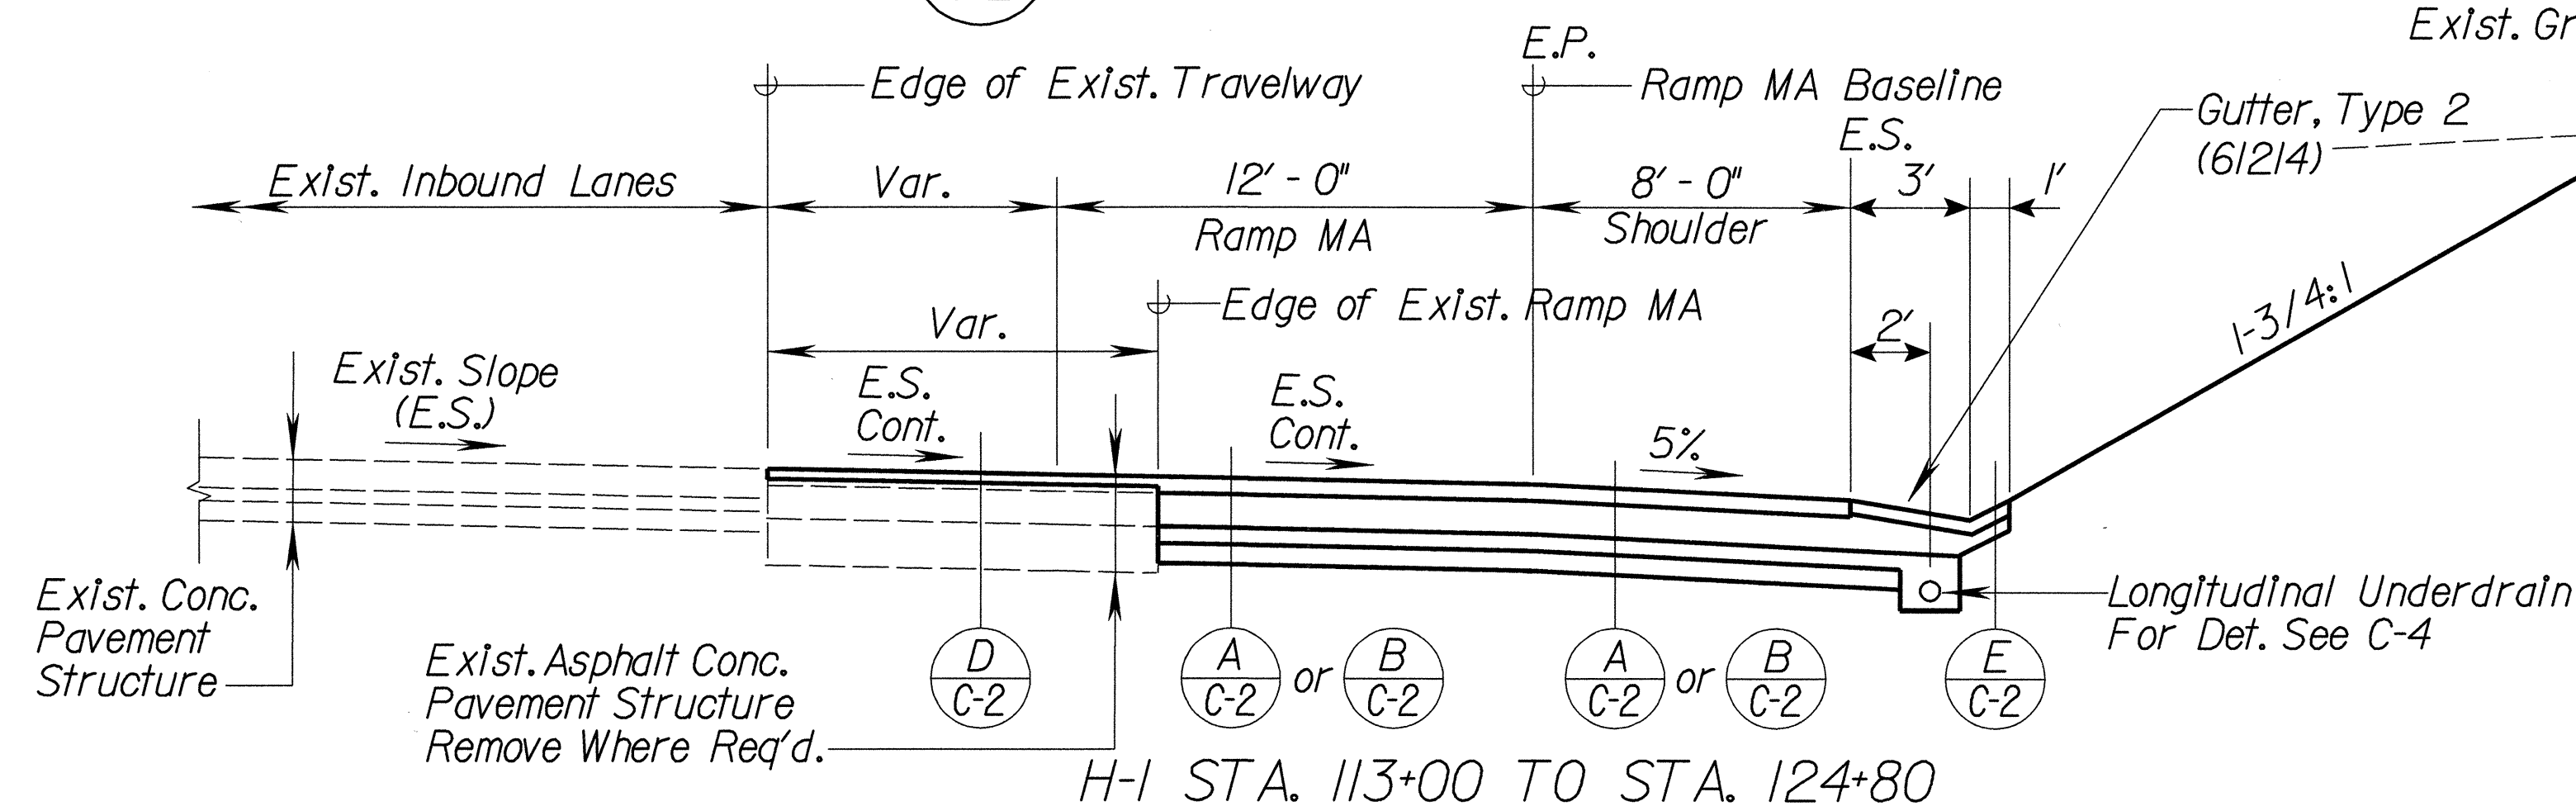

PAVEMENT STRUCTURE **E**
No Scale

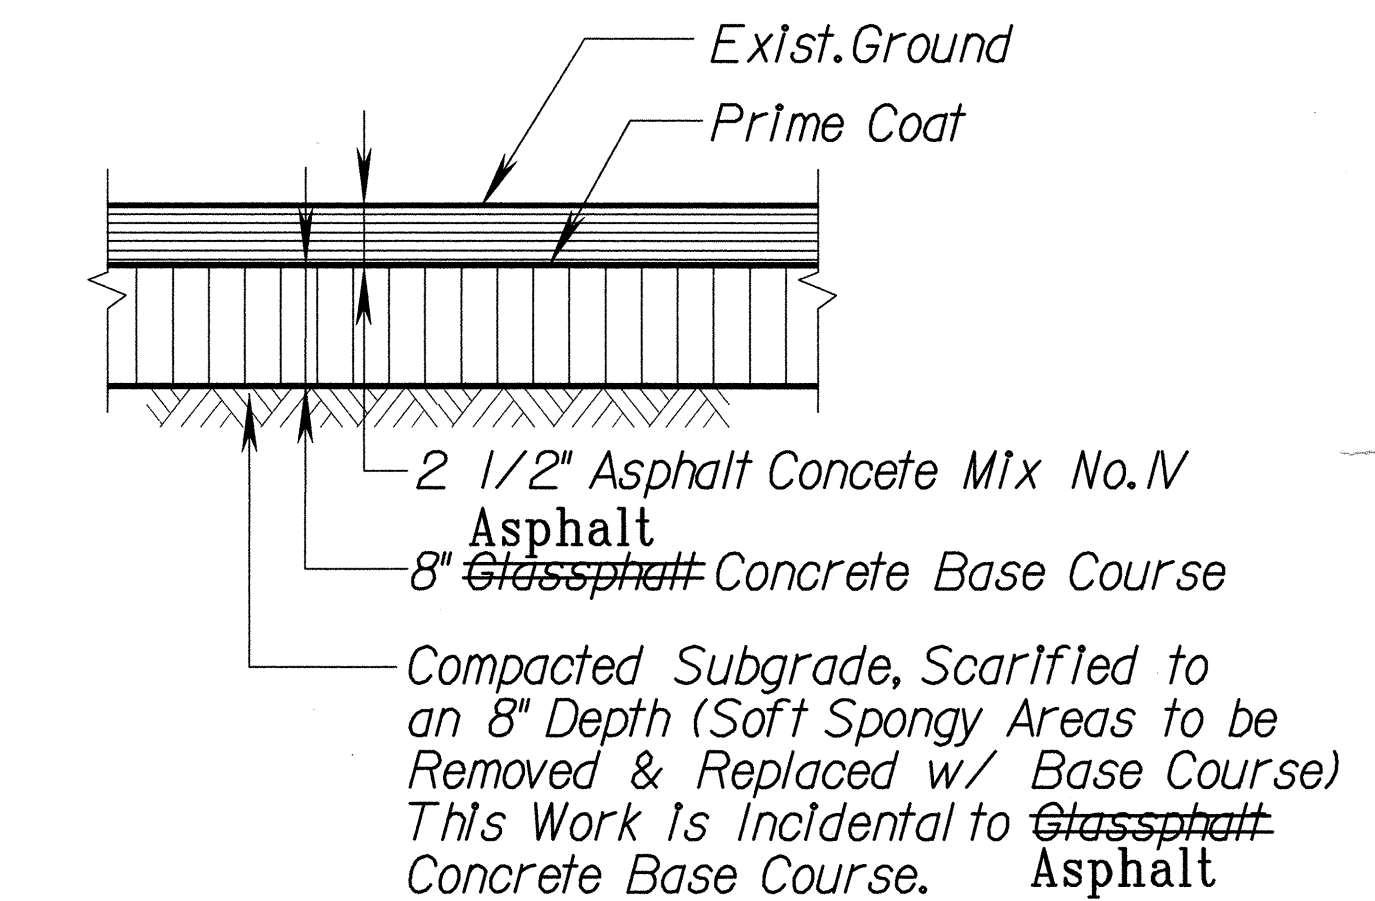

(TEMPORARY)
PAVEMENT STRUCTURE **F**
No Scale

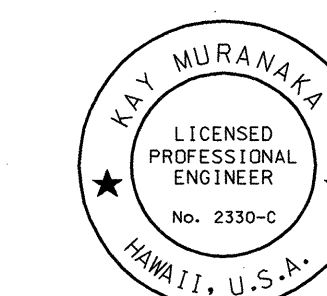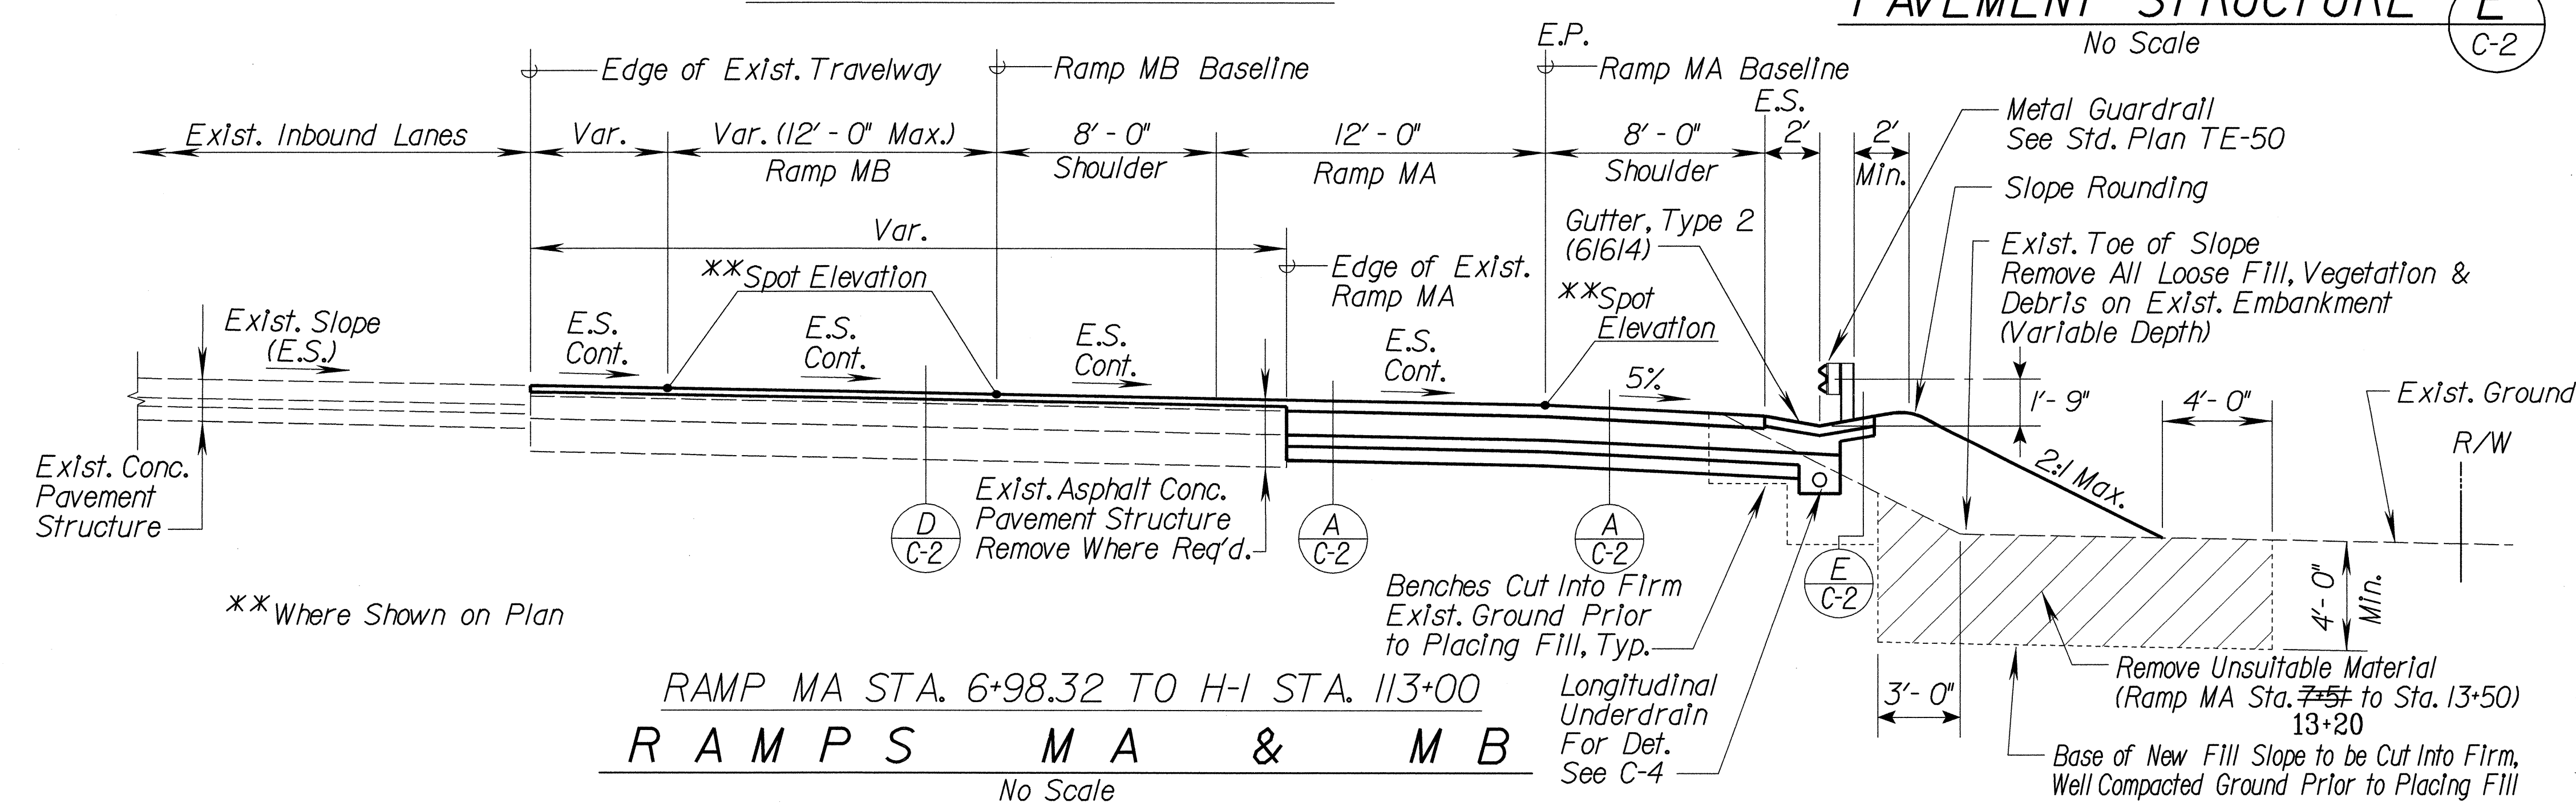

THIS WORK WAS PREPARED BY ME OR UNDER MY SUPERVISION

Kay Murakami

STATE OF HAWAII
DEPARTMENT OF TRANSPORTATION
HIGHWAYS DIVISION


TYPICAL ROADWAY SECTIONS

INTERSTATE ROUTE H-1
Makakilo Interchange Improvements
to Westbound Off-Ramp and
Eastbound On-Ramps

Scale: None Date: May 9, 1997


SHEET NO. C-2 OF 4 SHEETS

FED. ROAD DIST. NO.	STATE	FED. AID PROJ. NO.	FISCAL YEAR	SHEET NO.	TOTAL SHEETS
HAWAII	HAW.	IM-HI-1(222)	1997	6	104

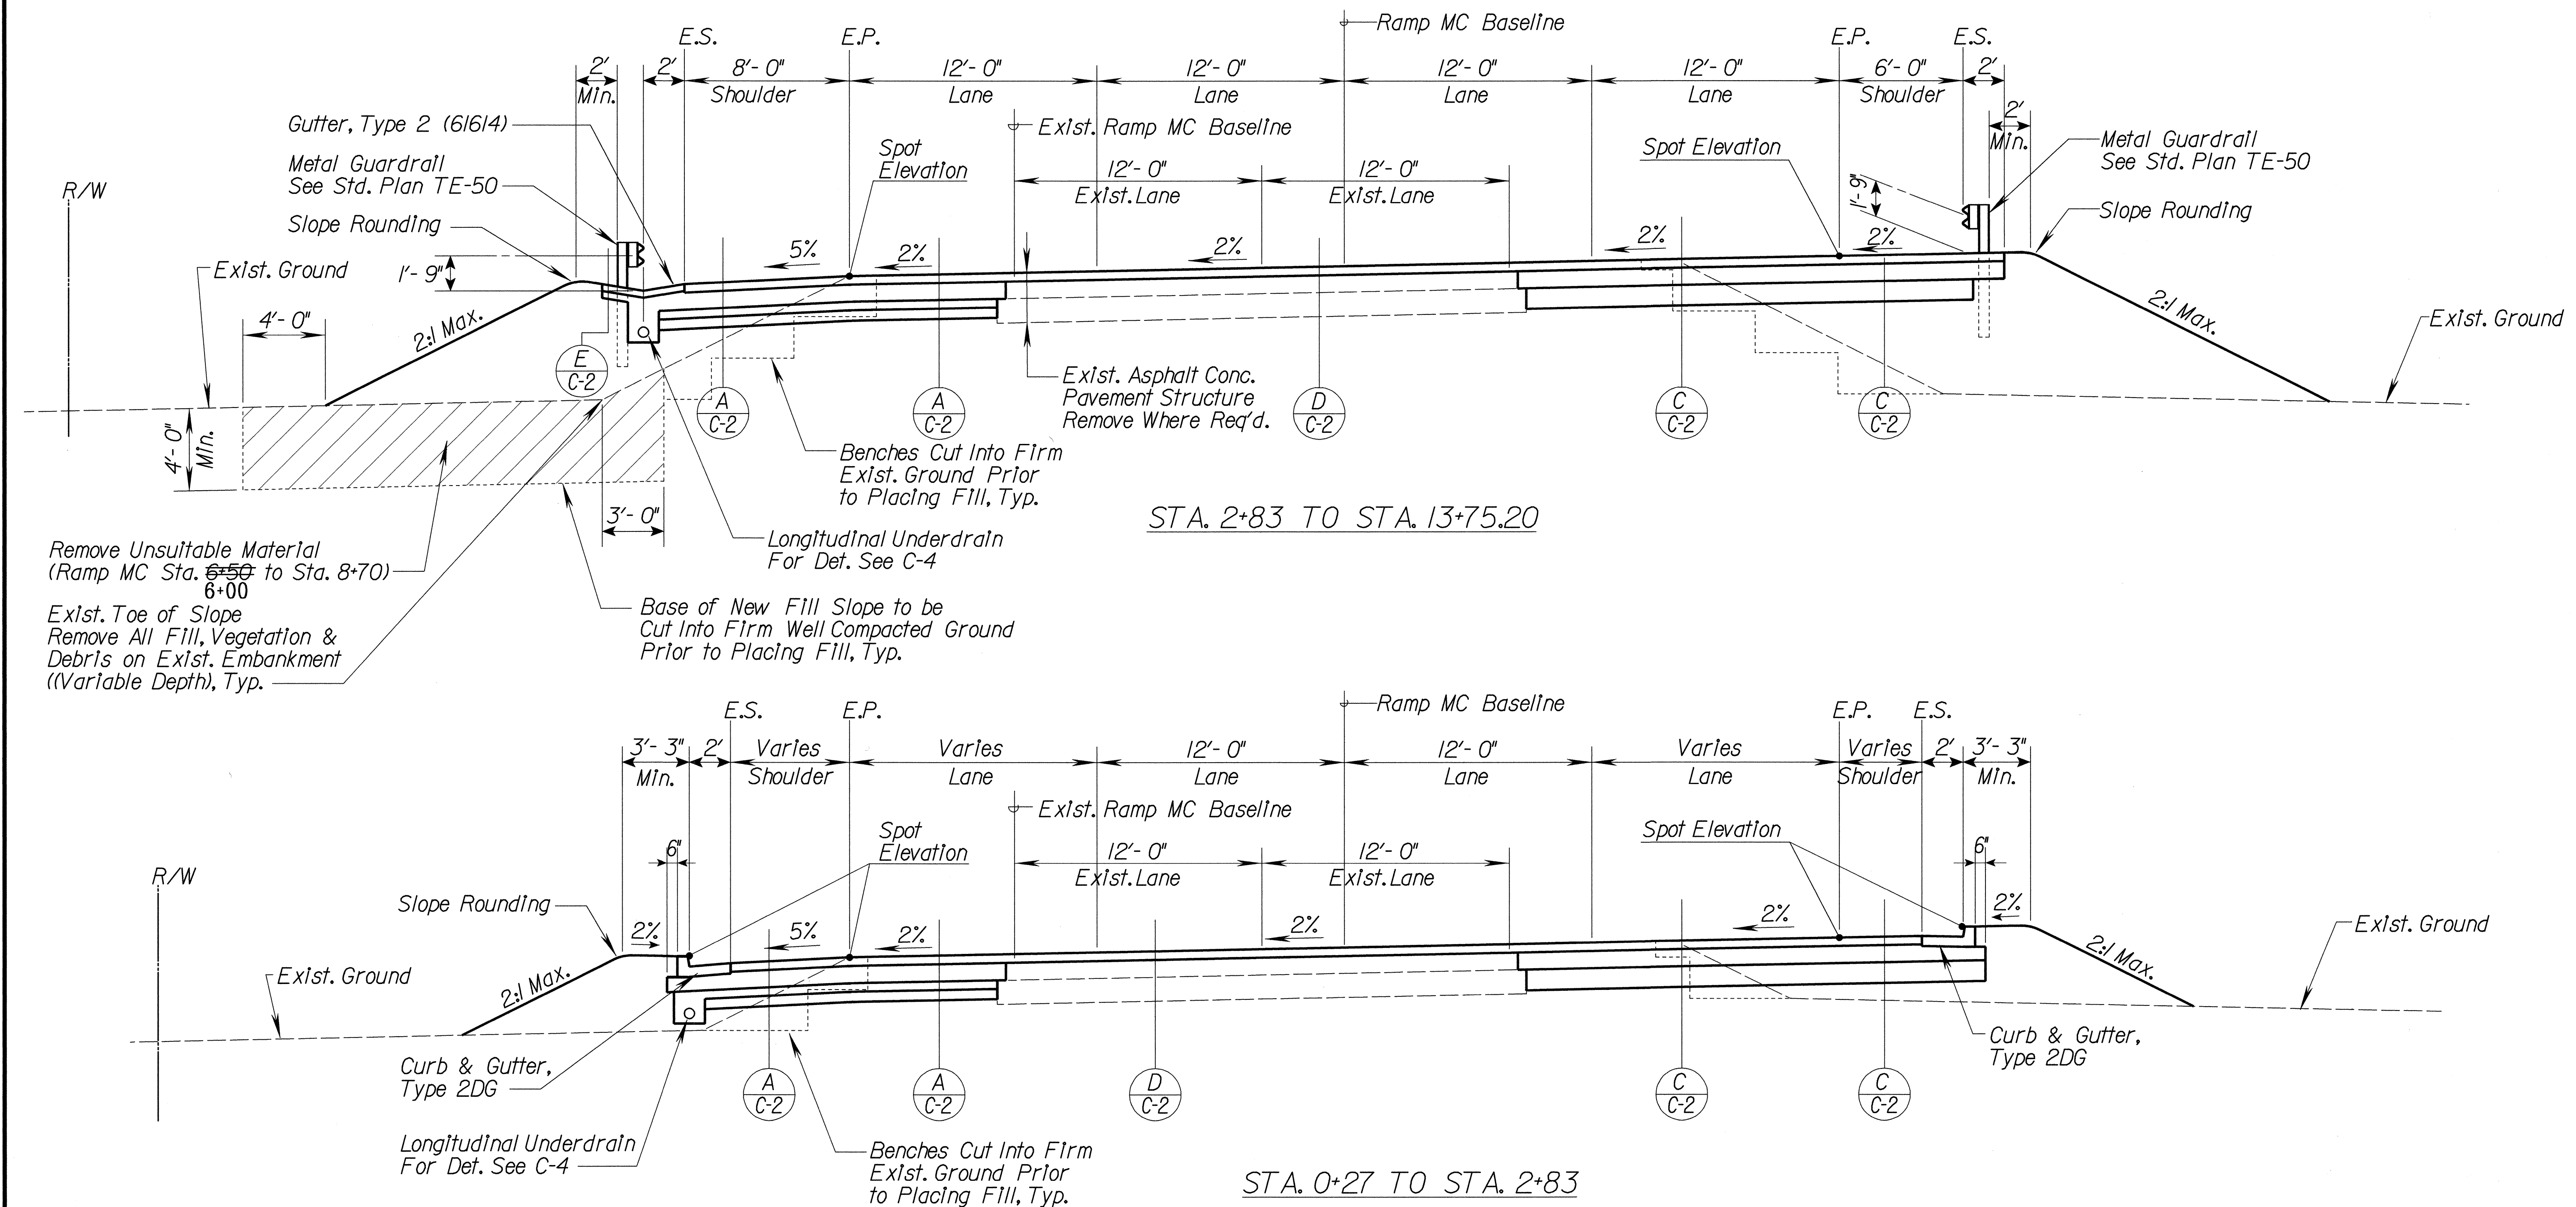

R A M P M C
No Scale

DATE	
SURVEY PLOTTED BY	
DRAWN BY	
DESIGNED BY	
CHECKED BY	
NOTE BOOK	
N ^o .	

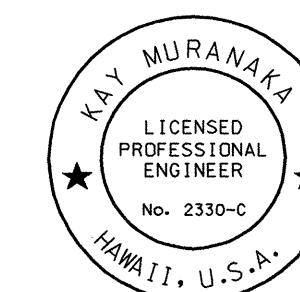

THIS WORK WAS PREPARED BY ME
OR UNDER MY SUPERVISION

Kay Muranaka

STATE OF HAWAII
DEPARTMENT OF TRANSPORTATION
HIGHWAYS DIVISION

TYPICAL ROADWAY SECTIONS

INTERSTATE ROUTE H-1
Makakilo Interchange Improvements
to Westbound Off-Ramp and
Eastbound On-Ramps

Scale: None Date: May 9, 1997

SHEET NO. C-3 OF 4 SHEETS

