


FED. ROAD DIST. NO.	STATE	FED. AID PROJ. NO.	FISCAL YEAR	SHEET NO.	TOTAL SHEETS
HAWAII	HAW.	IM-HI-1(231)	1998	20	23

BEGIN PROJECT
F.A. Proj. No. IM-HI-1(231)
H-1 @ Sta. 191+85.49

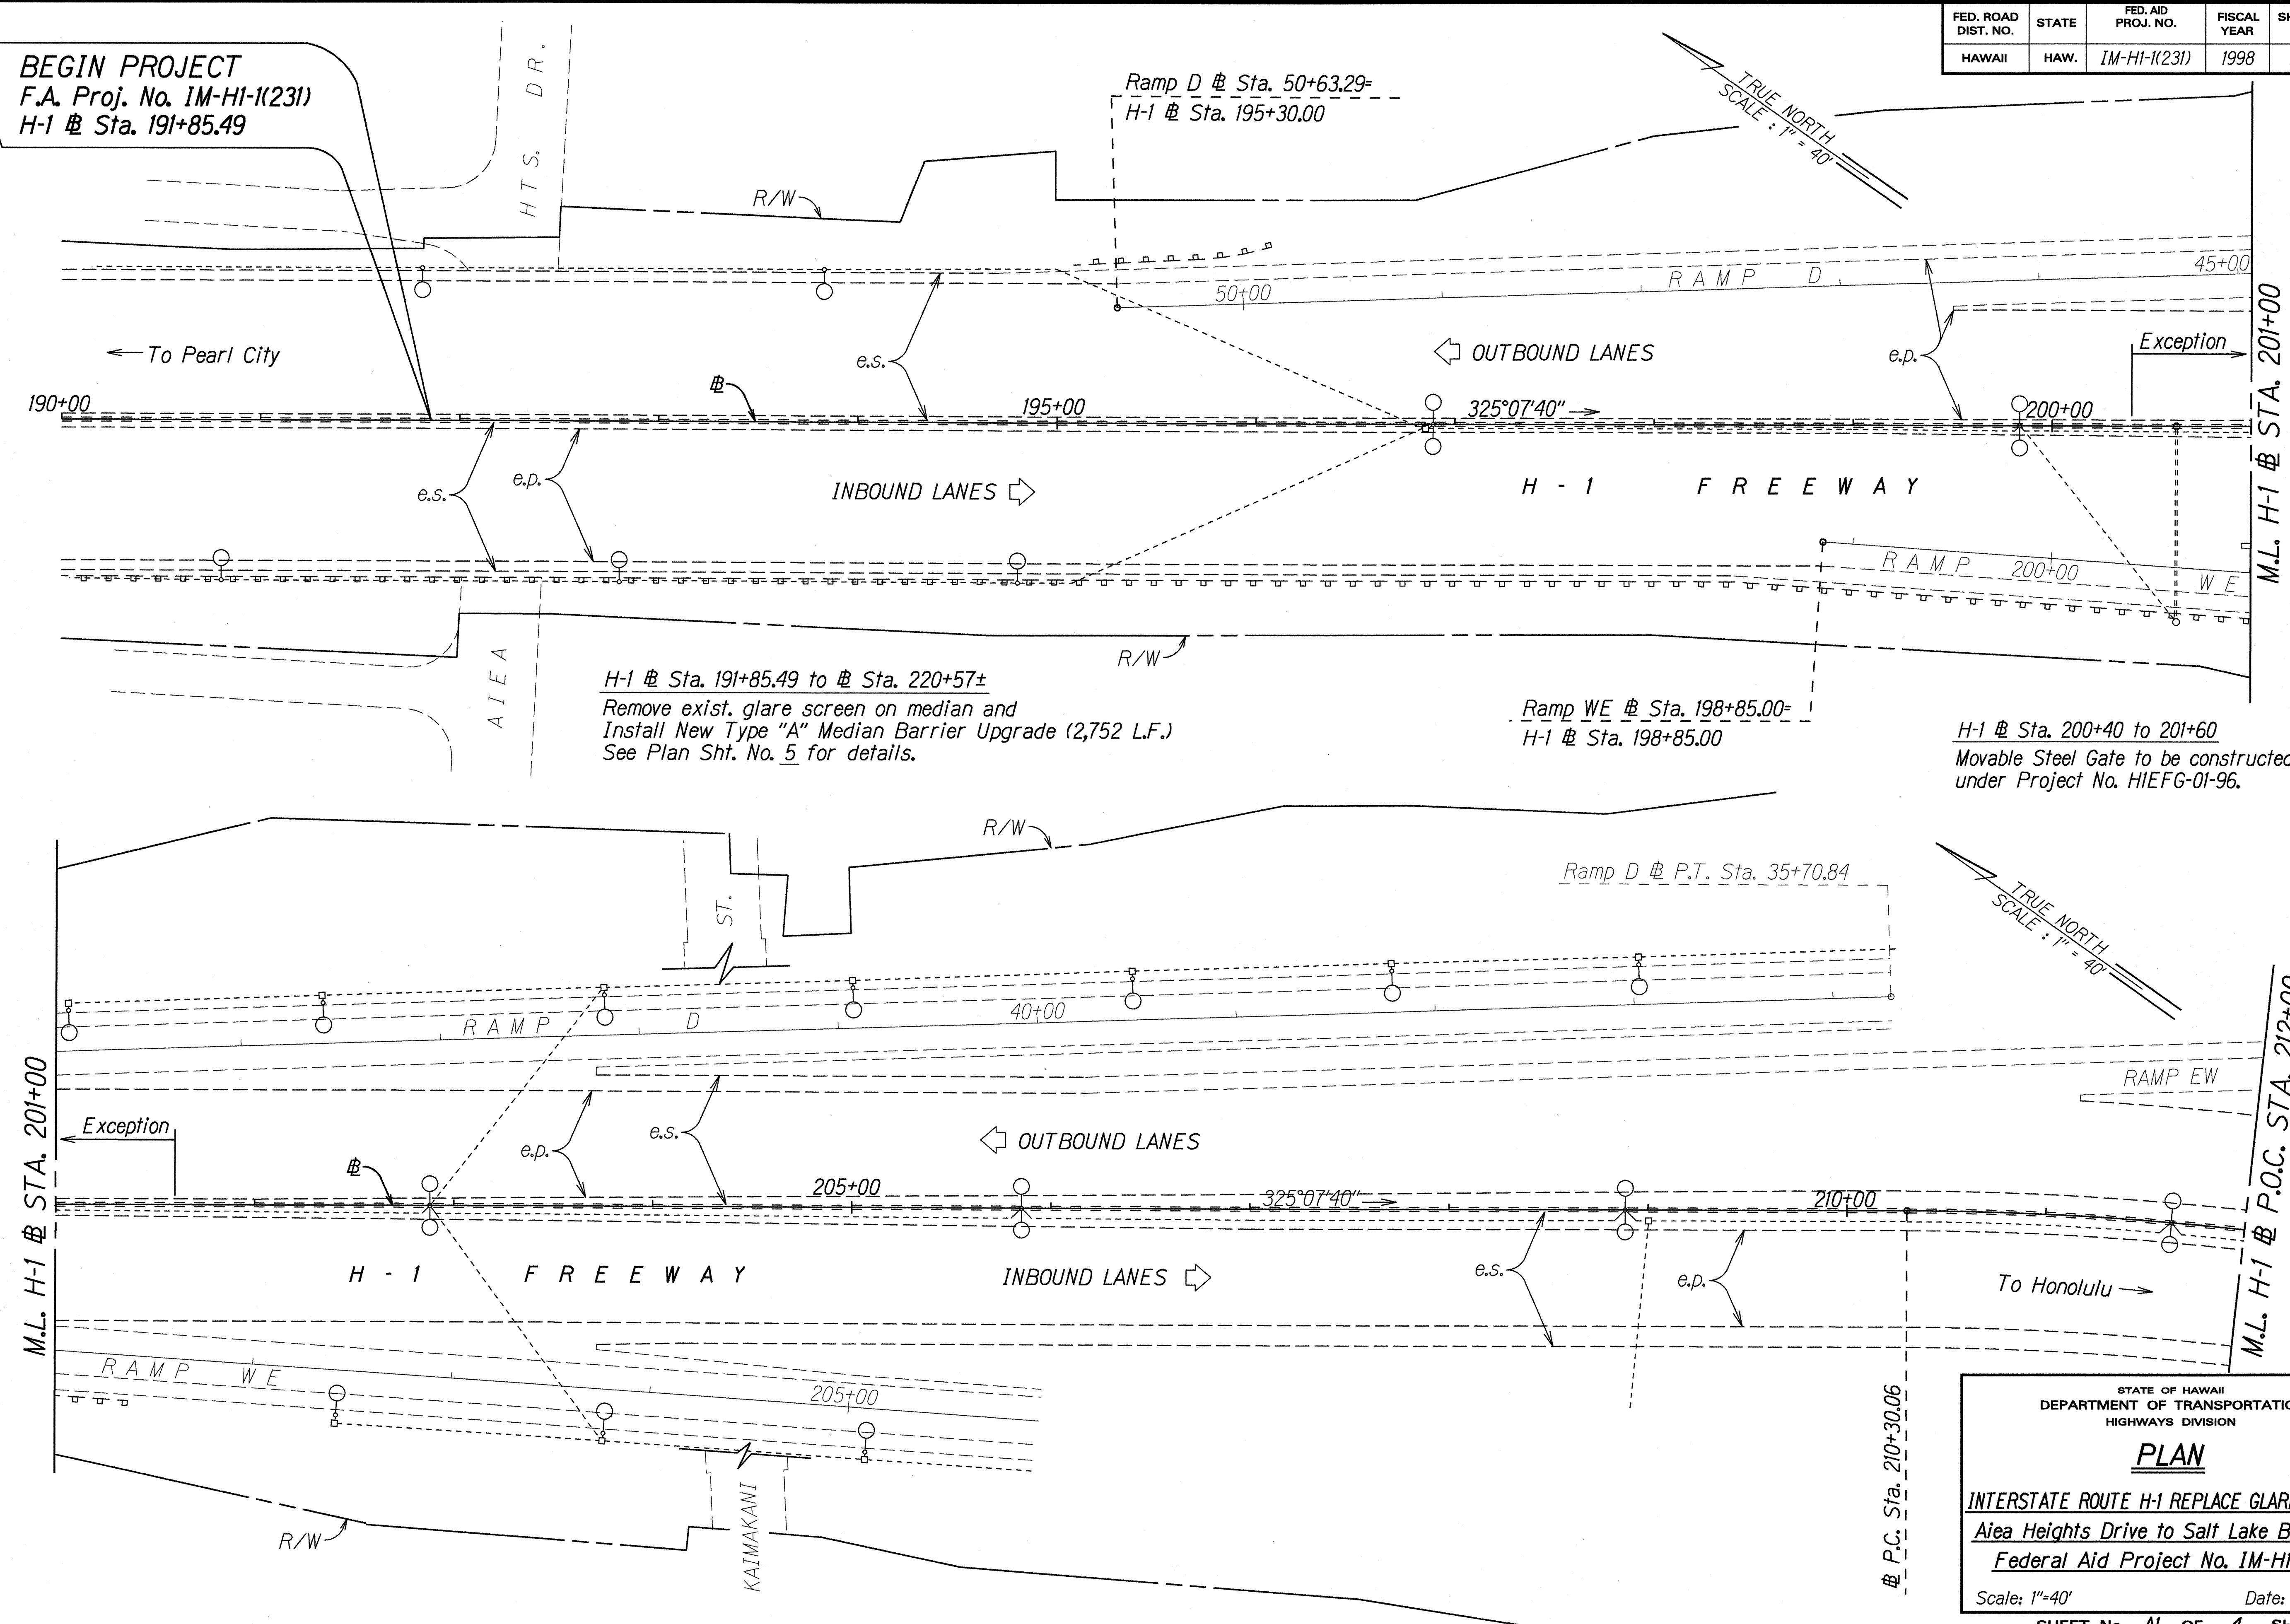

H-1 @ Sta. 191+85.49 to @ Sta. 220+57±
Remove exist. glare screen on median and
Install New Type "A" Median Barrier Upgrade (2,752 L.F.)
See Plan Sht. No. 5 for details.

Ramp WE @ Sta. 198+85.00=
H-1 @ Sta. 198+85.00

H-1 @ Sta. 200+40 to 201+60
Movable Steel Gate to be constructed
under Project No. HIEFG-01-96.


Ramp D @ P.T. Sta. 35+70.84

STATE OF HAWAII
DEPARTMENT OF TRANSPORTATION
HIGHWAYS DIVISION
PLAN
INTERSTATE ROUTE H-1 REPLACE GLARESCREENS
Aiea Heights Drive to Salt Lake Boulevard
Federal Aid Project No. IM-HI-1(231)
Scale: 1"=40' Date: Nov. 1997
SHEET No. A1 OF 4 SHEETS

ADD. 20

DESIGNED BY	DATE
NOTED BY	1/26/99
QUANTITIES BY	
CHECKED BY	

FED. ROAD DIST. NO.	STATE	FED. AID PROJ. NO.	FISCAL YEAR	SHEET NO.	TOTAL SHEETS
HAWAII	HAW.	IM-HI-1(231)	1998	21	23

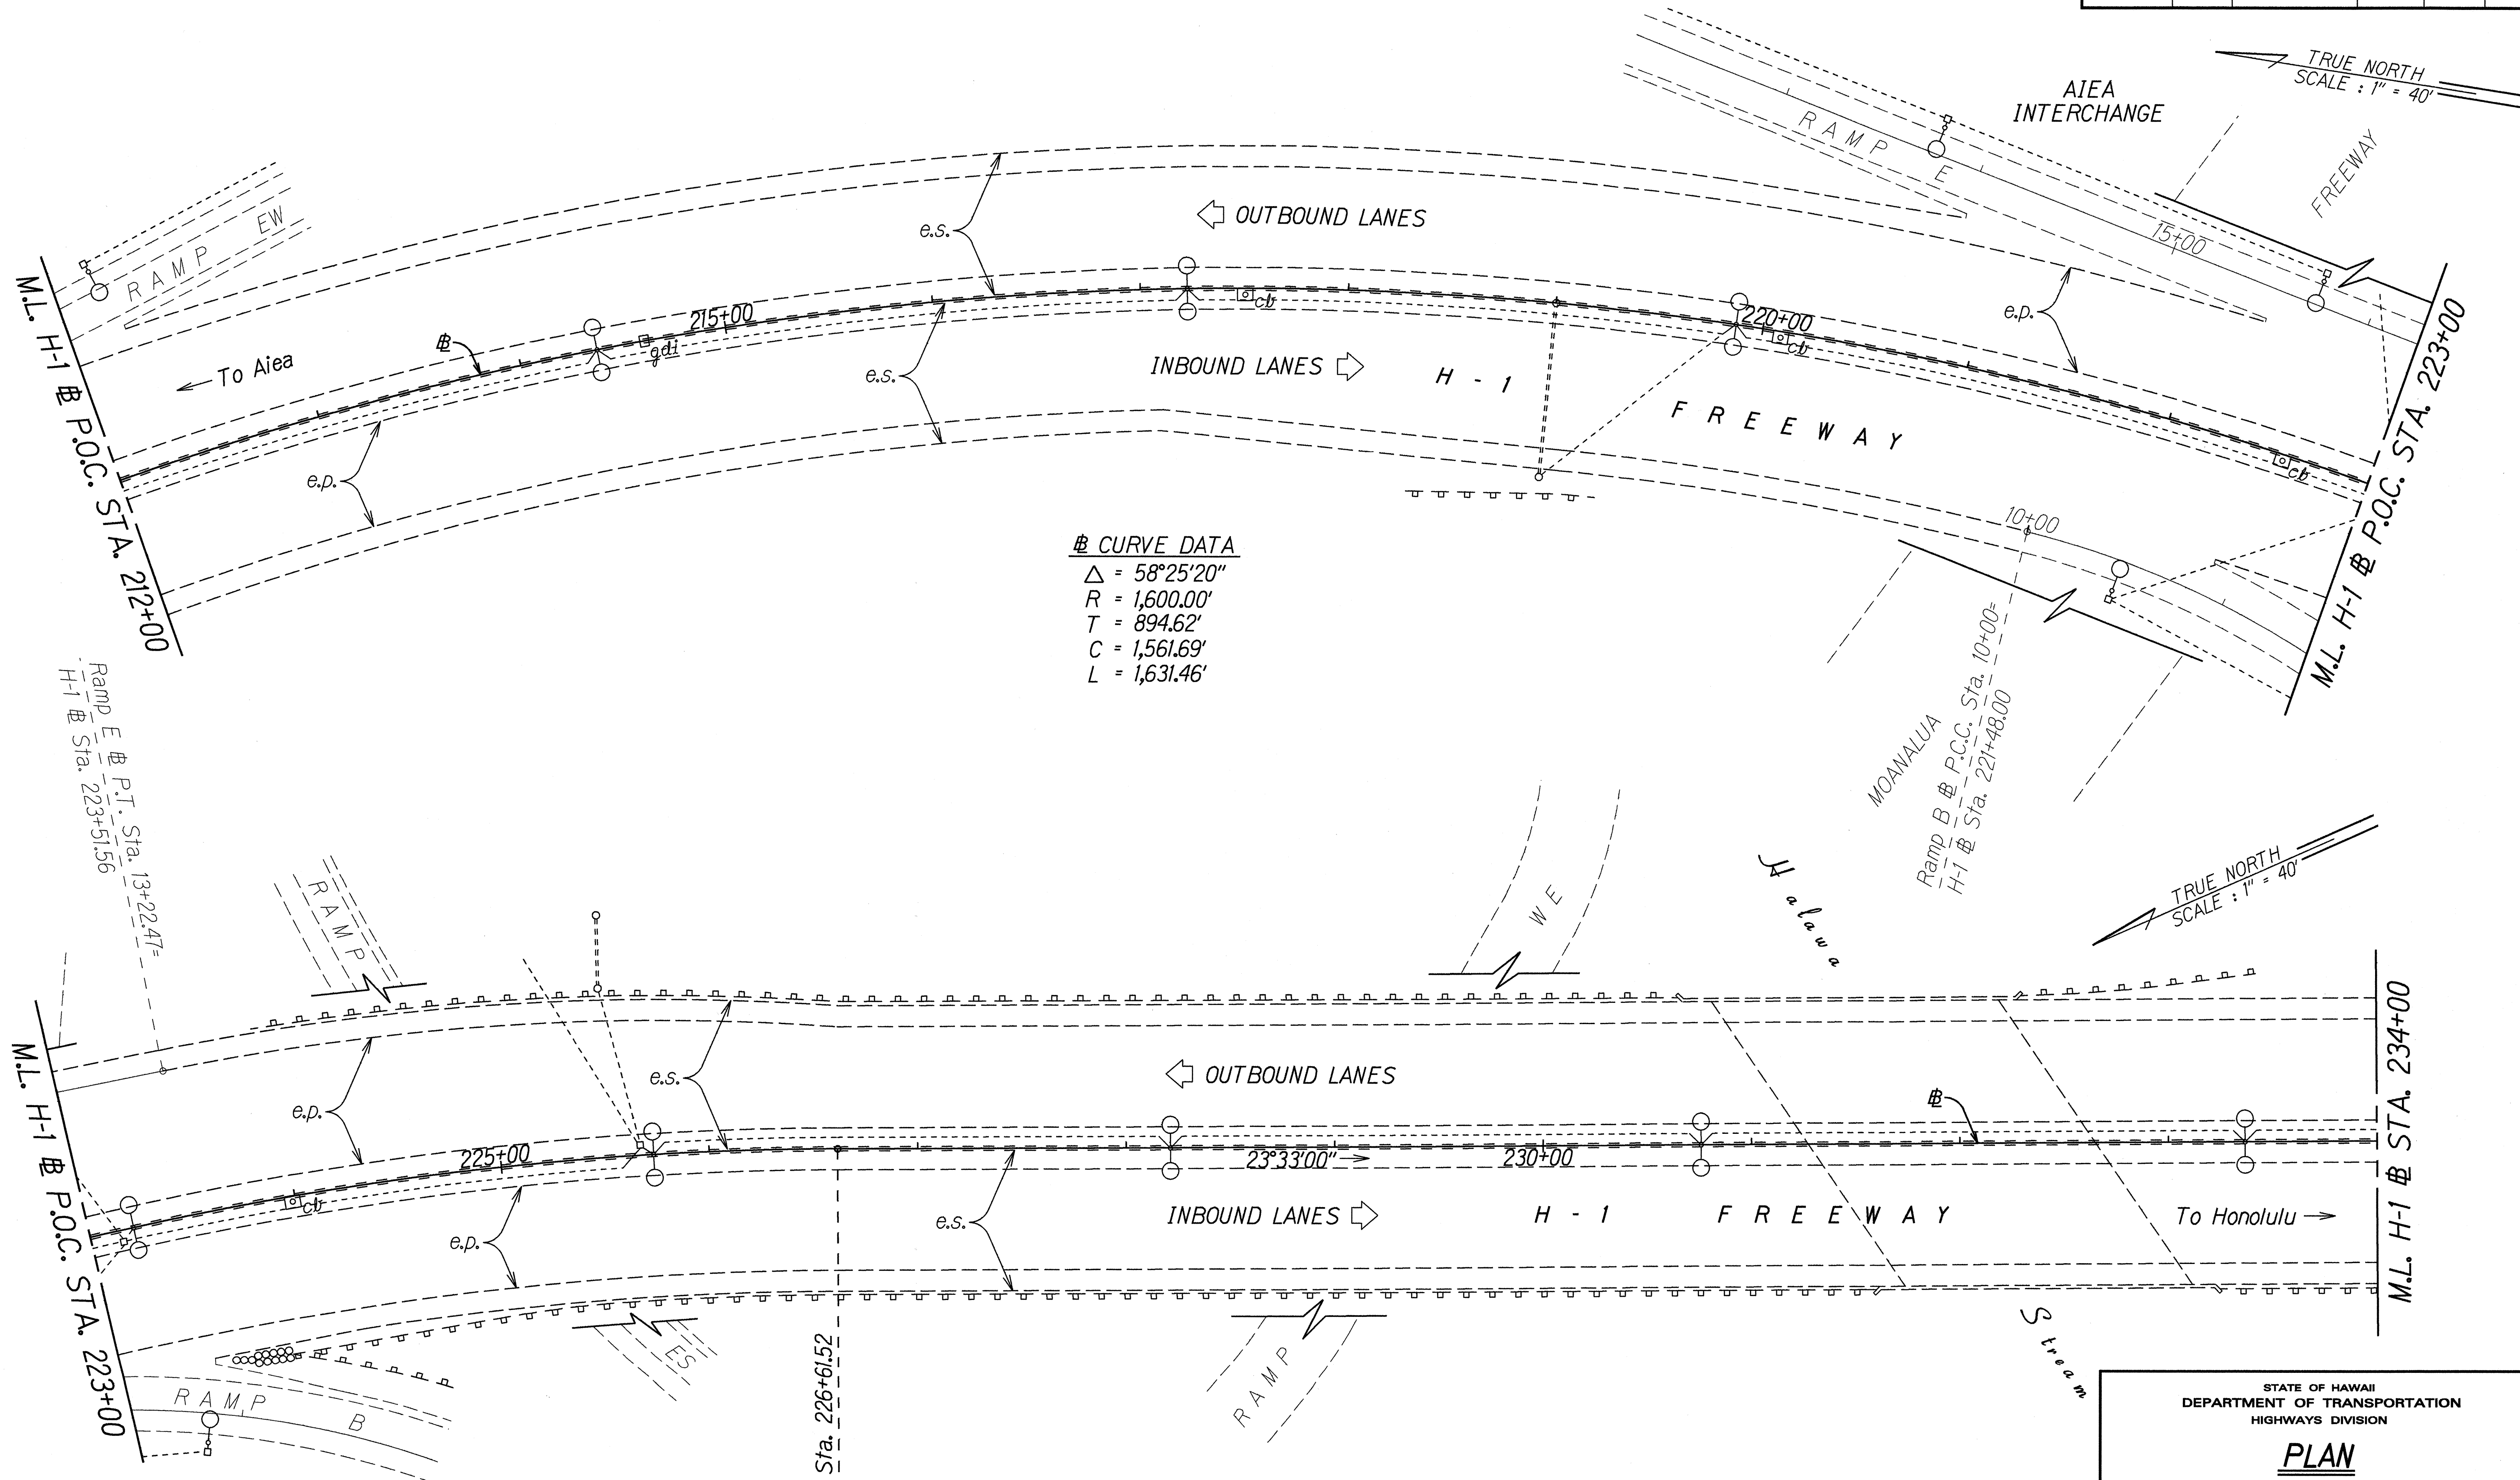

CURVE DATA
 $\Delta = 58^{\circ}25'20''$
 $R = 1,600.00'$
 $T = 894.62'$
 $C = 1,561.69'$
 $L = 1,631.46'$

H-1 Sta. 224+79± to Sta. 258+63.53
 Remove exist. glare screen on median and
 Install New Type "A" Median Barrier Upgrade (3385 L.F.)
 See Plan Sht. No. 5 for details

H-1 Sta. 225+70± To Sta. 228+20±
 Remove and dispose of exist. traffic light
 conduit and appurtenances. Install new
 highway lighting interconnecting system.
 See Plan Sheet No. 5 for details.

DESIGNED BY	DATE
DRAWN BY	
CHECKED BY	
NOTED BY	
QUANTITIES BY	
ORIGINAL PLAN	

STATE OF HAWAII
 DEPARTMENT OF TRANSPORTATION
 HIGHWAYS DIVISION

PLAN


INTERSTATE ROUTE H-1 REPLACE GLARESCREENS
Aiea Heights Drive to Salt Lake Boulevard
Federal Aid Project No. IM-HI-1(231)

Scale: 1"=40' Date: Nov. 1997

SHEET No. A2 OF 4 SHEETS

LEGEND FOR AS-BUILT POSTINGS	
	Squiggly line for as-built deletion
	Double line for as-built deletion
Roadway	Text for as-built posting

FED. ROAD DIST. NO.	STATE	FED. AID PROJ. NO.	FISCAL YEAR	SHEET NO.	TOTAL SHEETS
HAWAII	HAW.	IM-HI-1(231)	1998	22	23

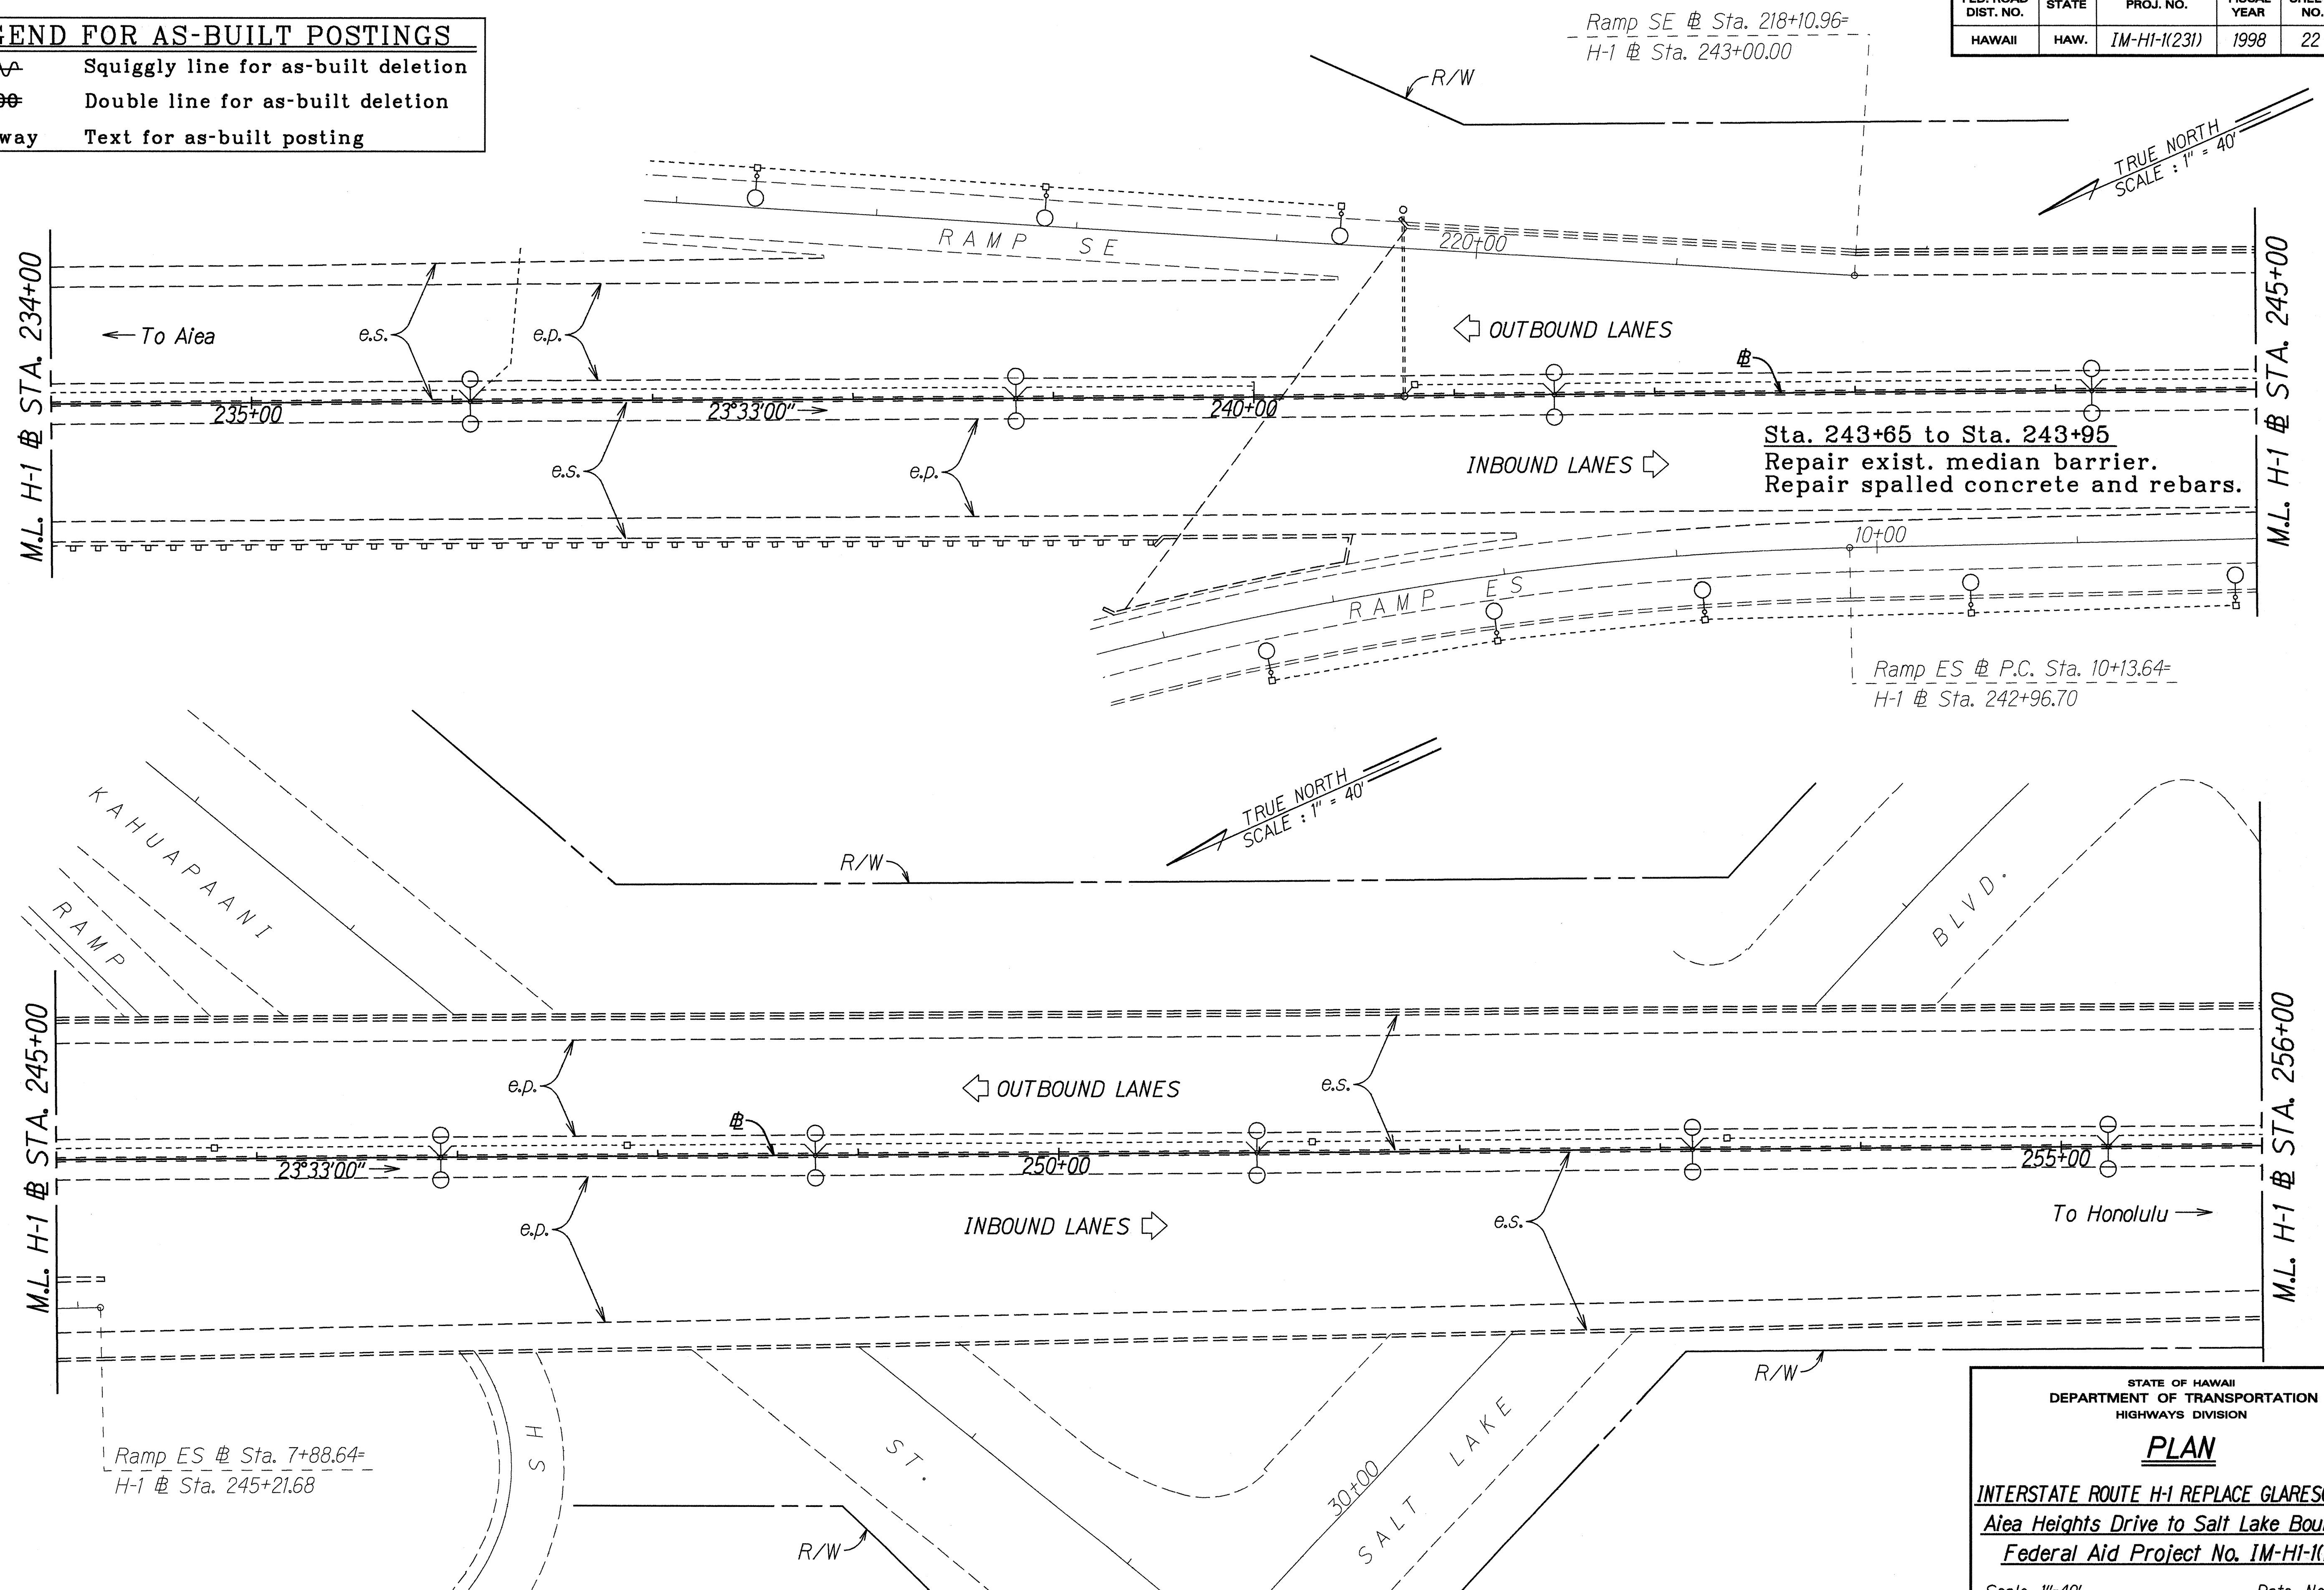

DESIGNED BY	DATE
TRACED BY	11/13/97
DESIGNED BY	
QUANTITIES BY	
CHECKED BY	
NOTE BOOK	
PLAN	
NO.	0101003

STATE OF HAWAII
DEPARTMENT OF TRANSPORTATION
HIGHWAYS DIVISION

PLAN


INTERSTATE ROUTE H-1 REPLACE GLARESCREENS
Aiea Heights Drive to Salt Lake Boulevard
Federal Aid Project No. IM-HI-1(231)

Scale: 1"=40' Date: Nov. 1997

SHEET No. A3 OF 4 SHEETS

"AS-BUILT"

FED. ROAD DIST. NO.	STATE	FED. AID PROJ. NO.	FISCAL YEAR	SHEET NO.	TOTAL SHEETS
HAWAII	HAW.	IM-HI-1(231)	1998	23	23

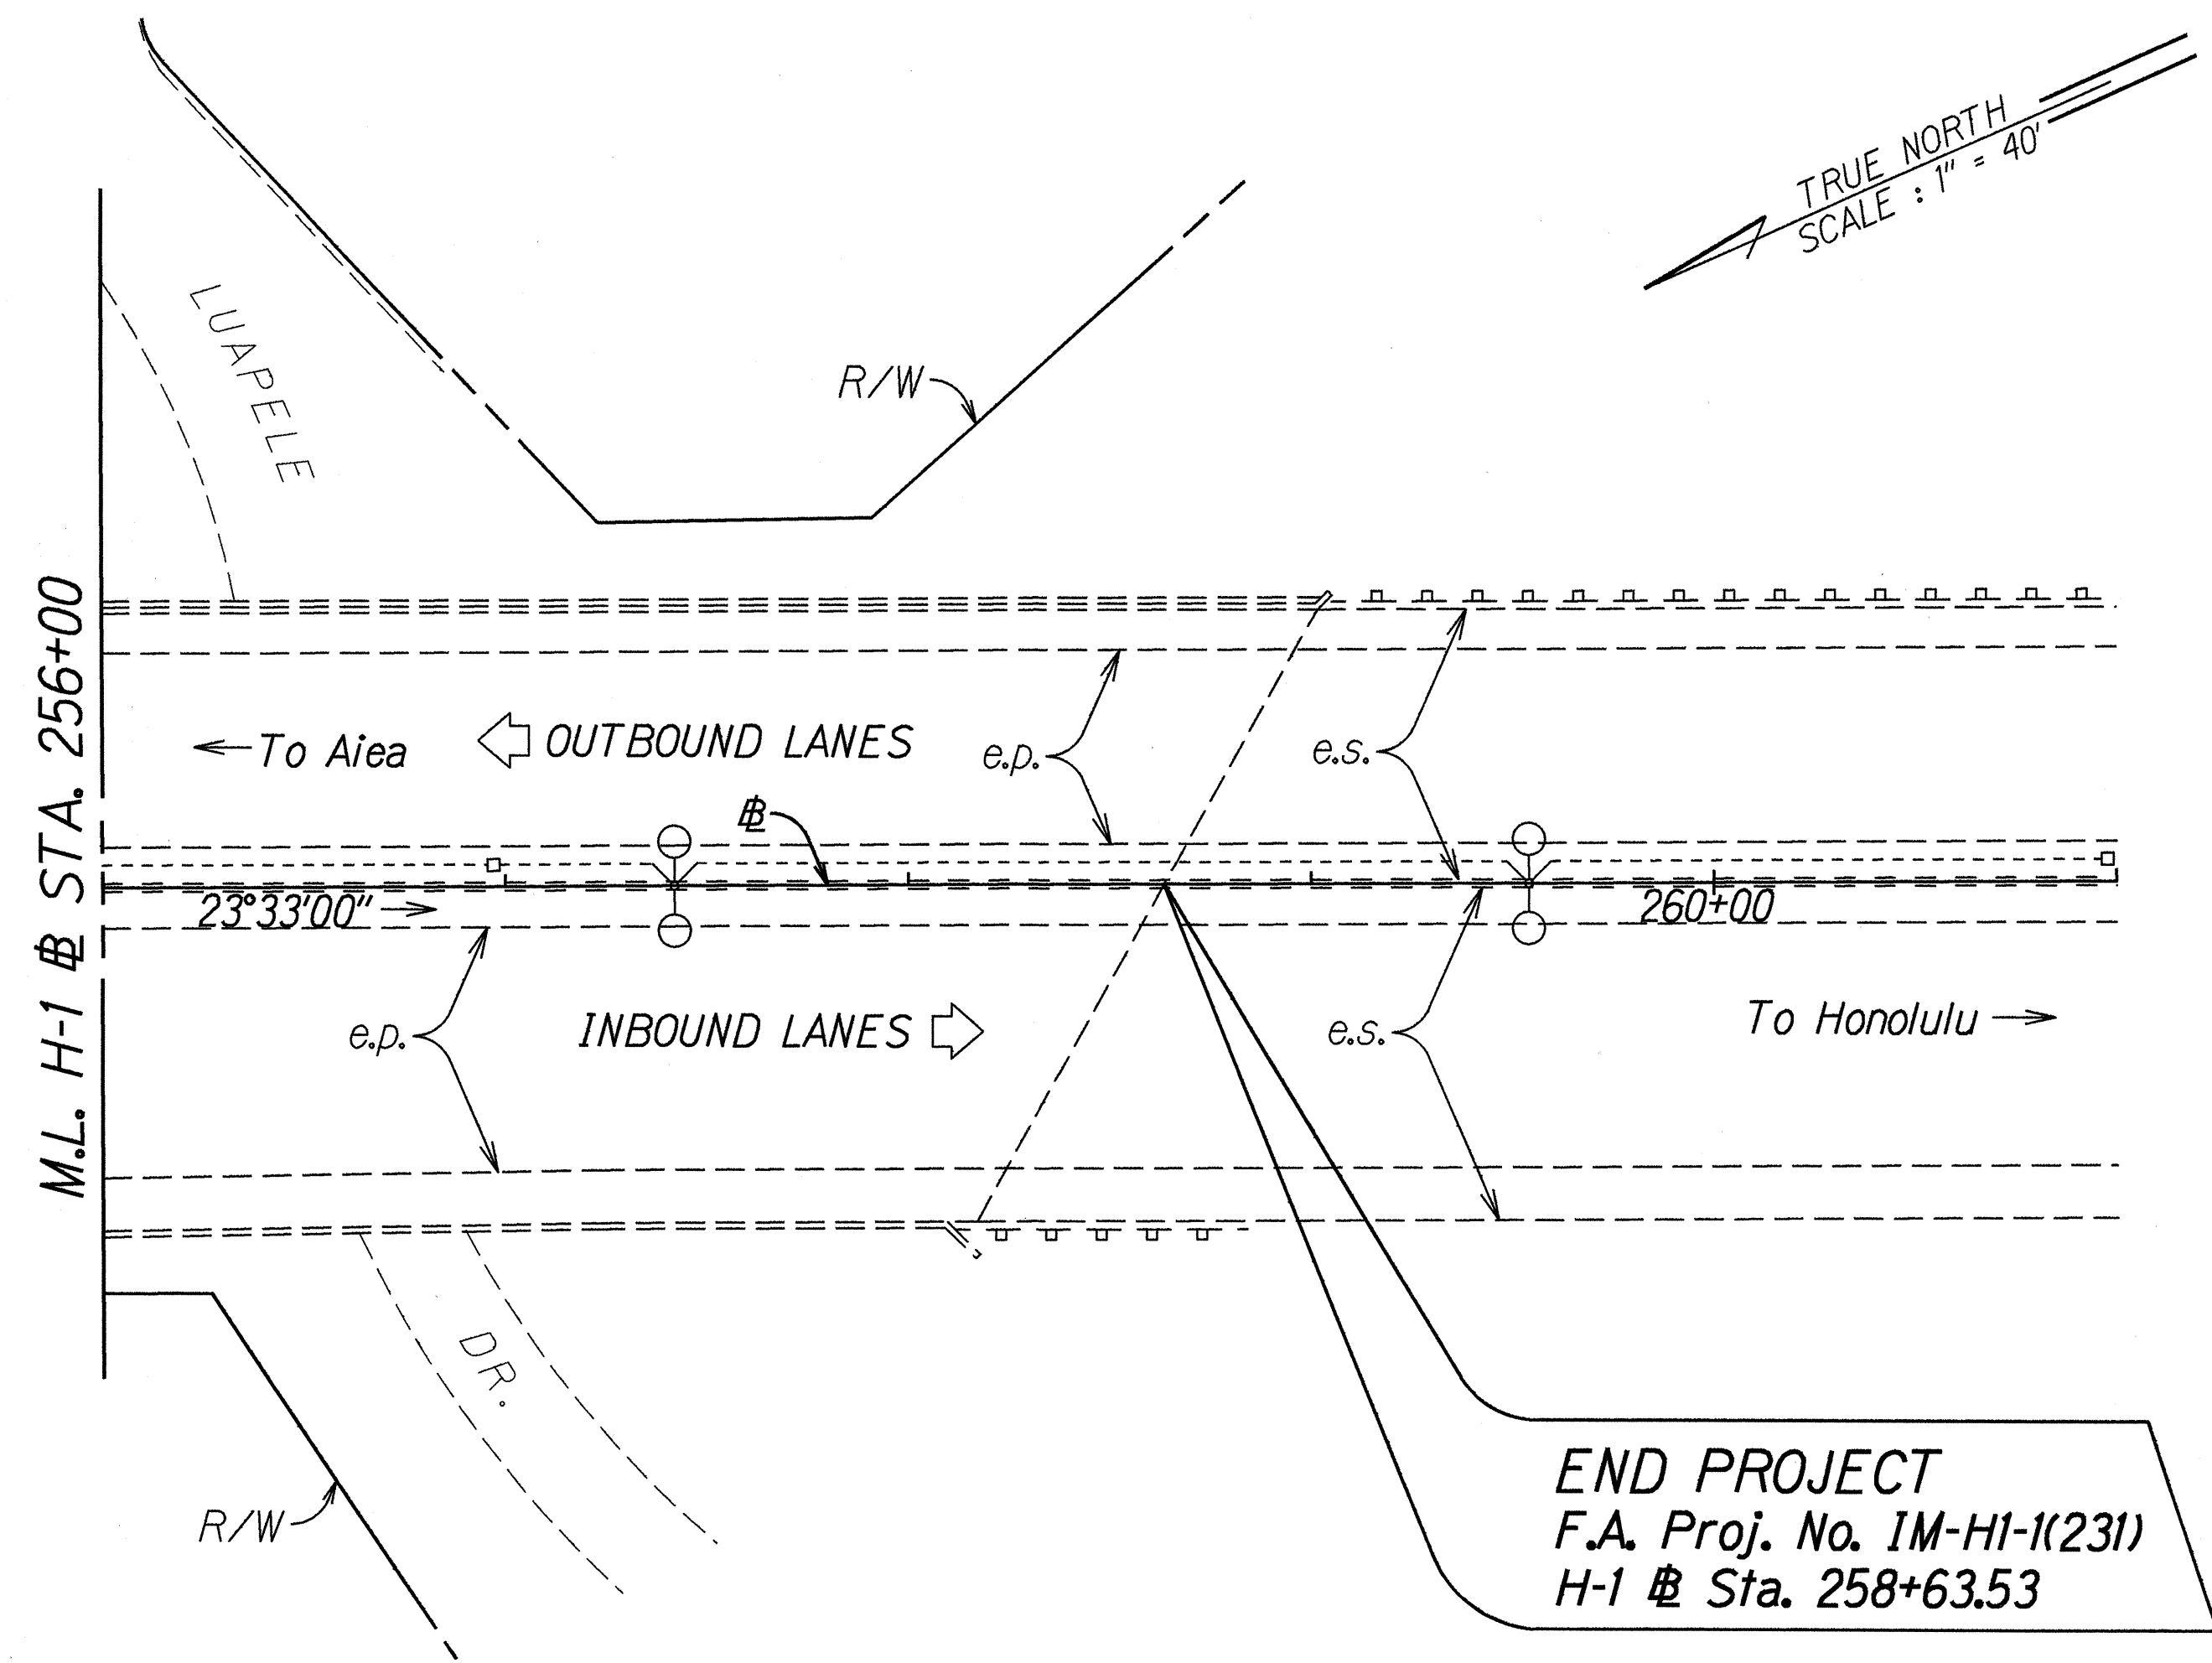

DESIGNED BY	DATE
TRACED BY	11/13/97
NOTED BY	
QUANTITIES BY	
CHECKED BY	

STATE OF HAWAII
DEPARTMENT OF TRANSPORTATION
HIGHWAYS DIVISION

PLAN

INTERSTATE ROUTE H-1 REPLACE GLARESCREENS
Aiea Heights Drive to Salt Lake Boulevard
Federal Aid Project No. IM-HI-1(231)

Scale: 1"=40' Date: Nov. 1997

SHEET No. A4 OF 4 SHEETS