


FED. ROAD DIST. NO.	STATE	FED. AID PROJ. NO.	FISCAL YEAR	SHEET NO.	TOTAL SHEETS
HAWAII	HAW.	STP-H201(2)	1998	8	23

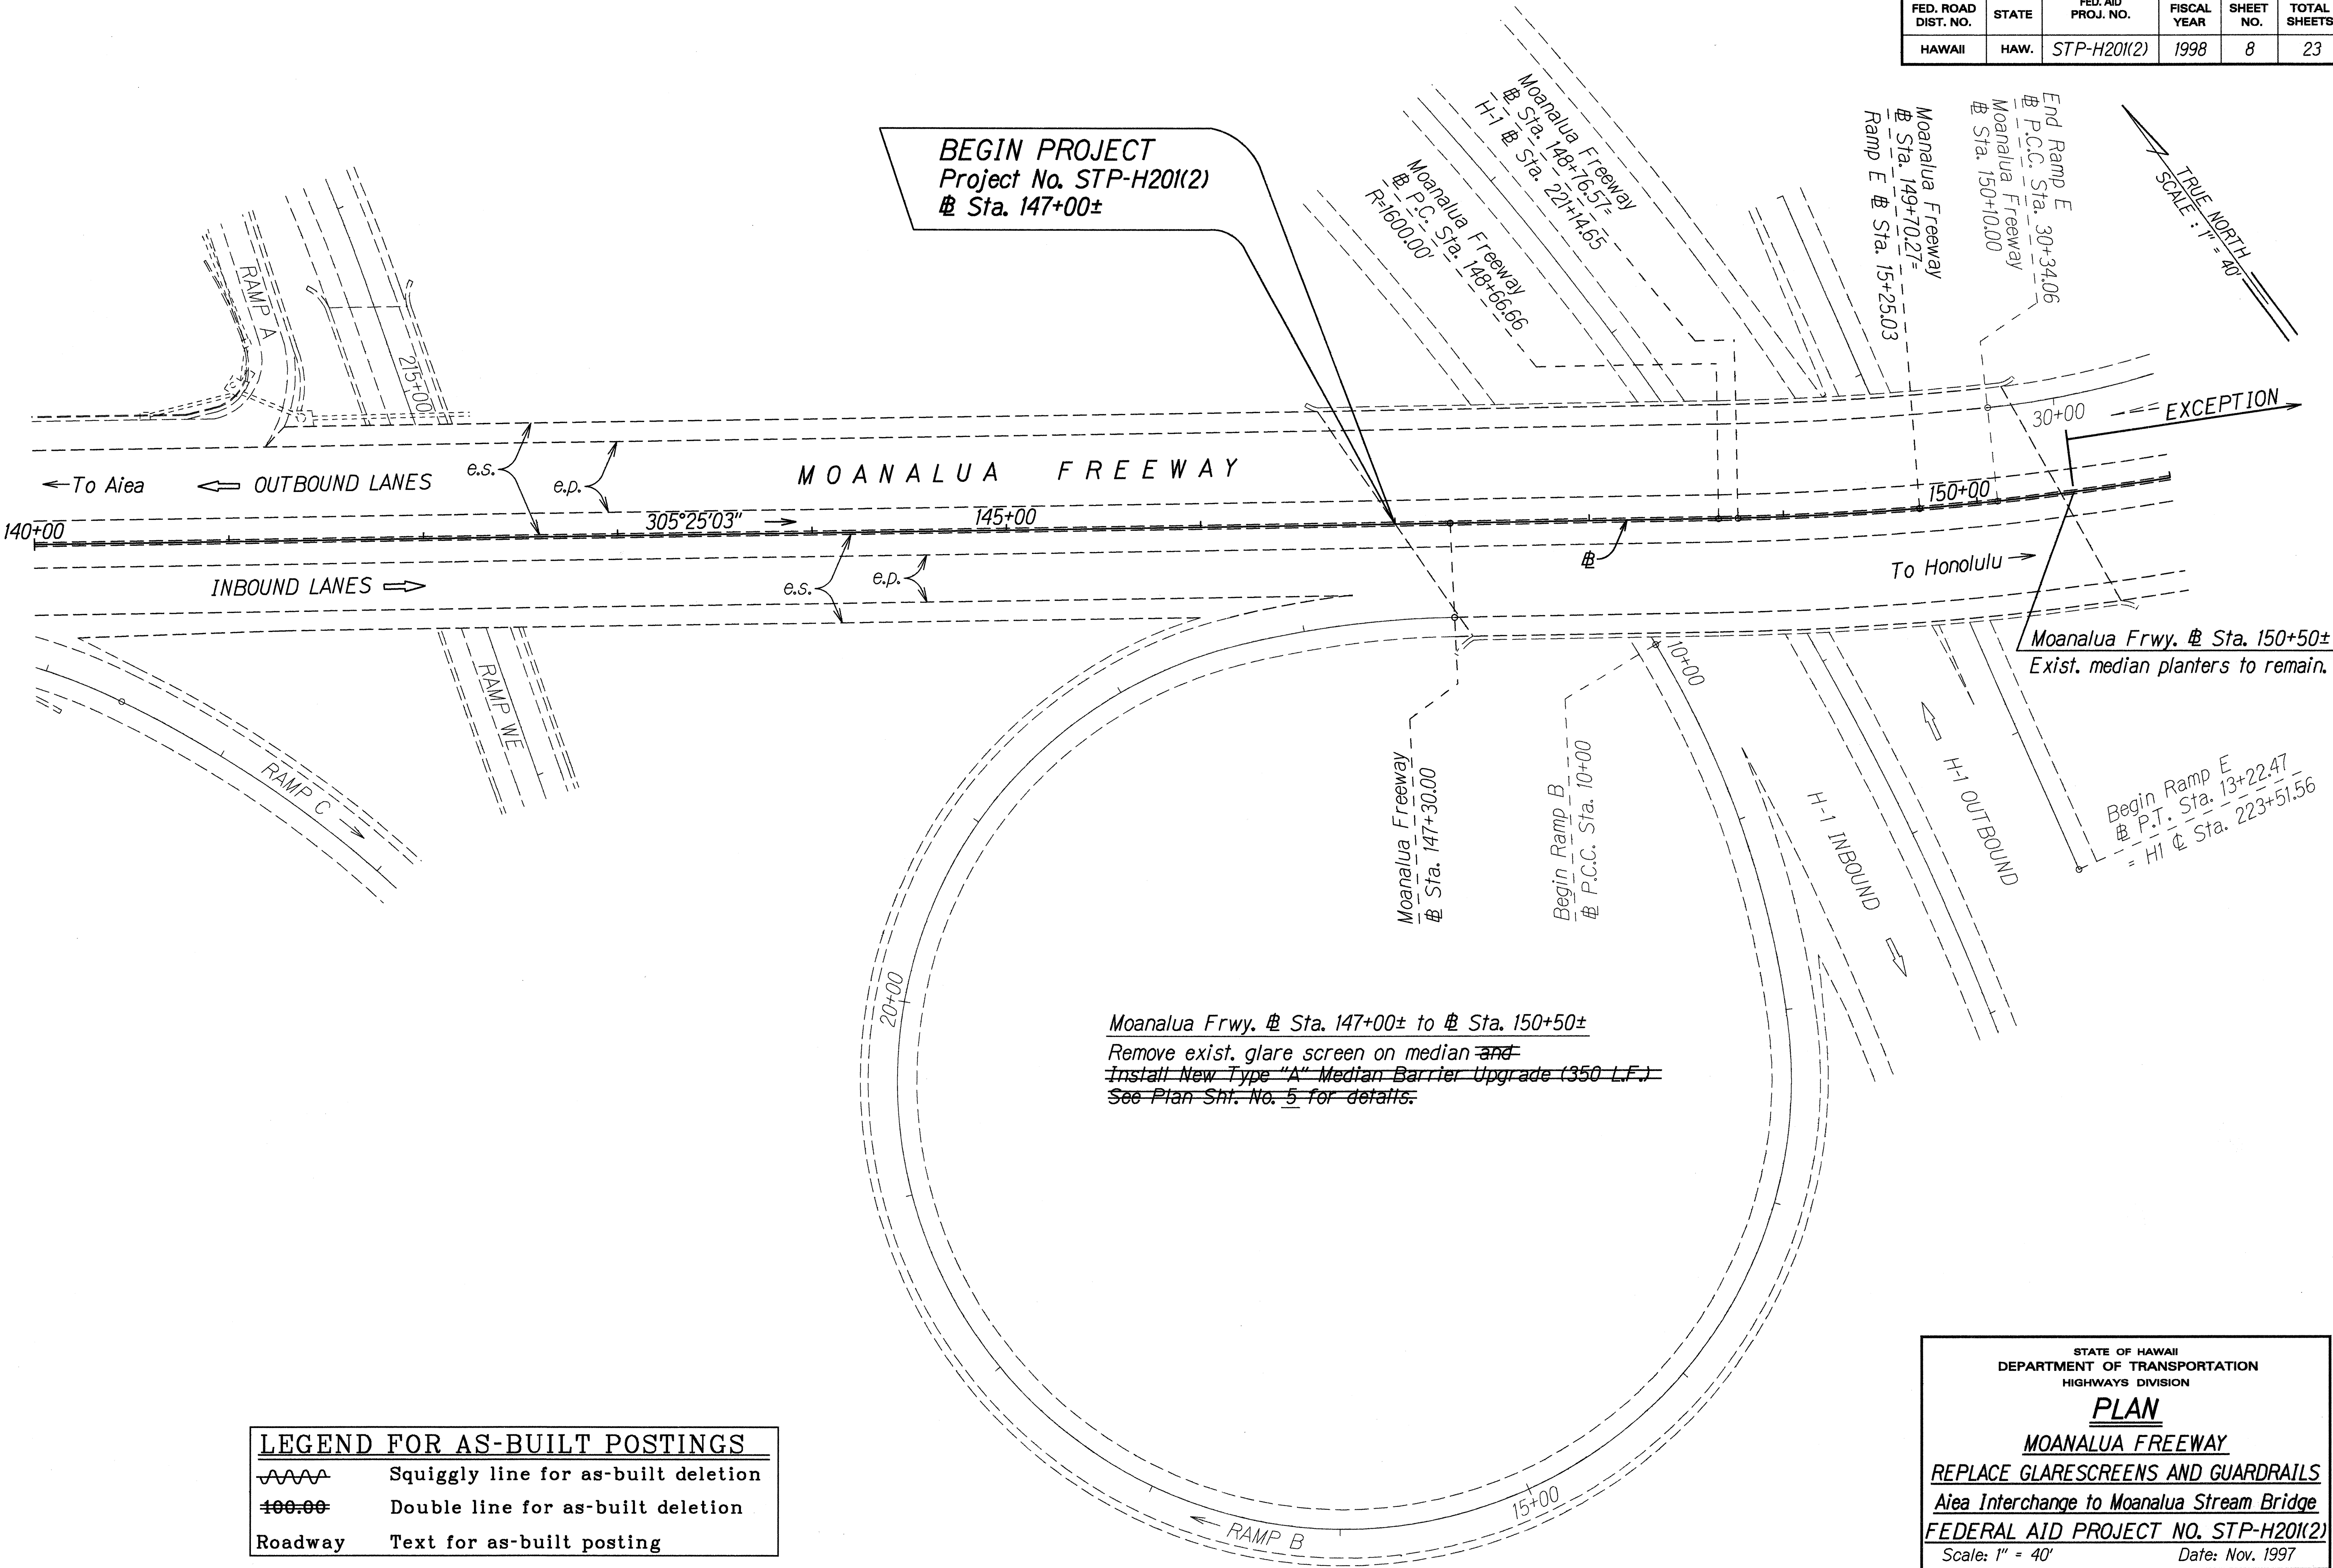


DESIGNED BY	DATE
TRACED BY	11-4-97
NOTED BY	
QUANTITIES BY	
CHECKED BY	

LEGEND FOR AS-BUILT POSTINGS	
	Squiggly line for as-built deletion
	Double line for as-built deletion
Roadway	Text for as-built posting

STATE OF HAWAII DEPARTMENT OF TRANSPORTATION HIGHWAYS DIVISION	
PLAN	
MOANALUA FREEWAY	
REPLACE GLARESCREENS AND GUARDRAILS	
Aiea Interchange to Moanalua Stream Bridge	
FEDERAL AID PROJECT NO. STP-H201(2)	
Scale: 1" = 40'	Date: Nov. 1997
SHEET No. 1 OF 12 SHEETS	

FED. ROAD DIST. NO.	STATE	FED. AID PROJ. NO.	FISCAL YEAR	SHEET NO.	TOTAL SHEETS
HAWAII	HAW.	STP-H201(2)	1998	10	23

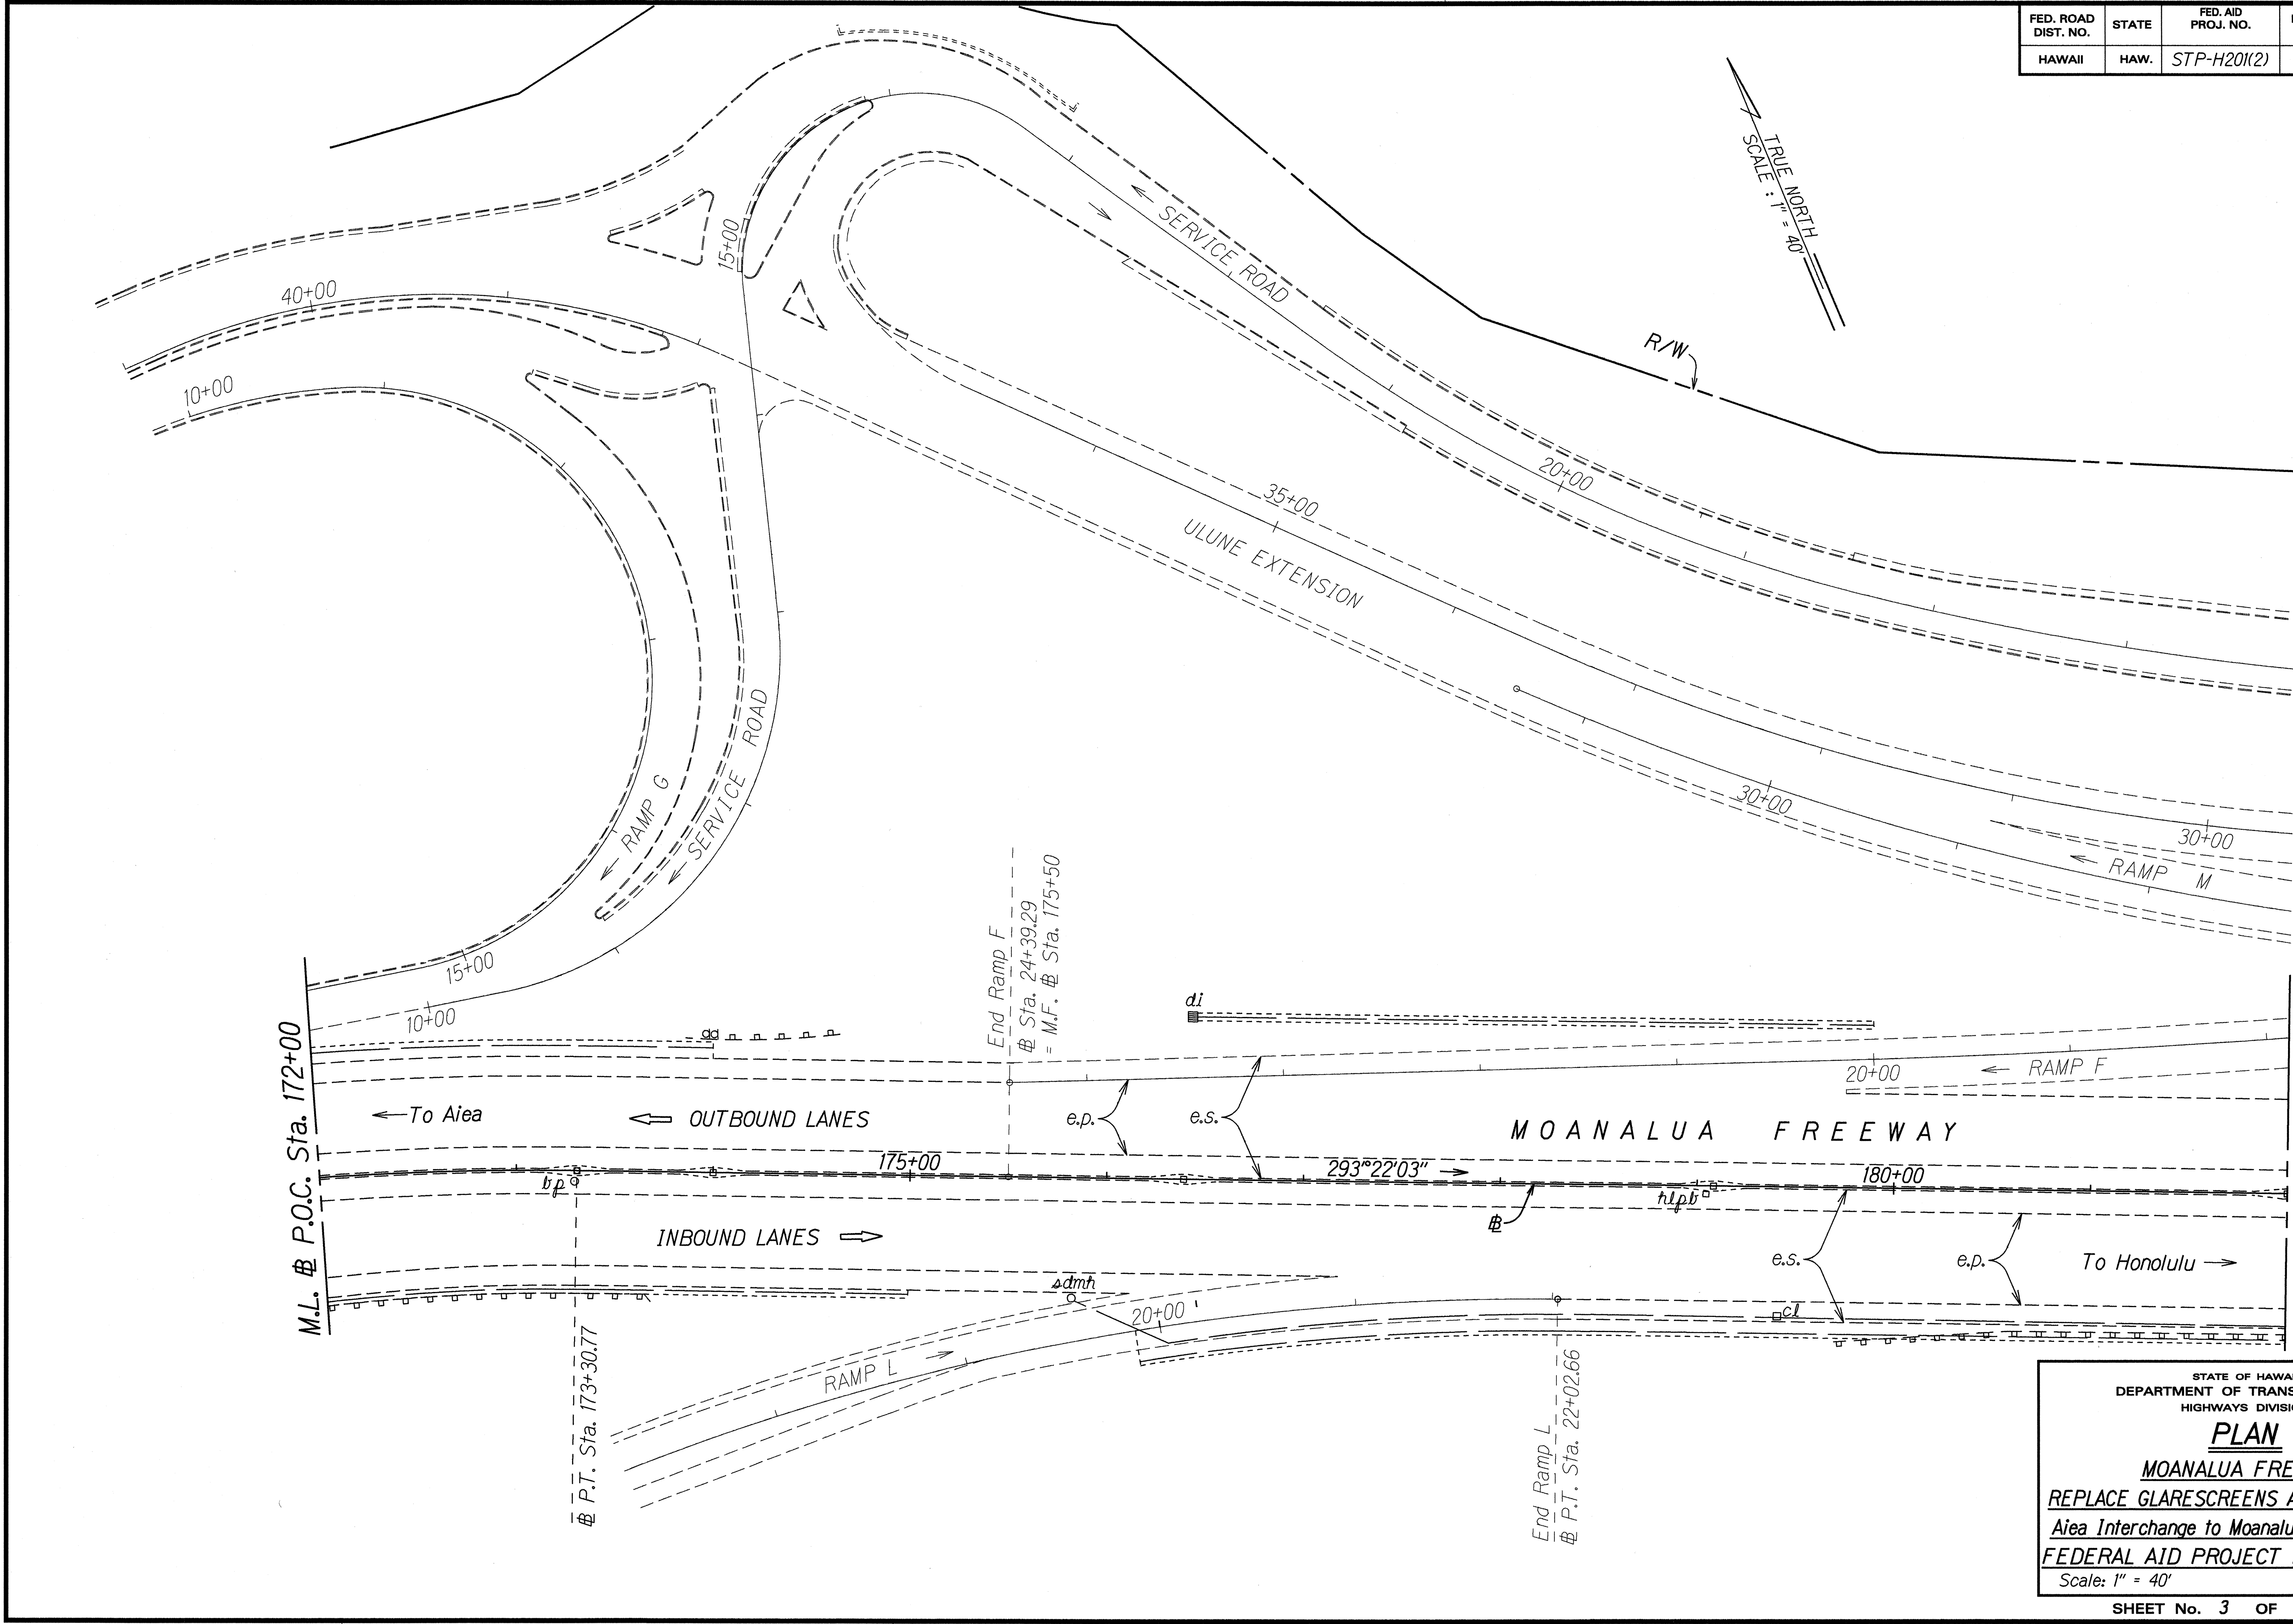


DESIGNED BY	DATE
TRACED BY	11-4-97
DESIGNED BY	
QUANTITIES BY	
CHECKED BY	

STATE OF HAWAII
DEPARTMENT OF TRANSPORTATION
HIGHWAYS DIVISION

PLAN
MOANALUA FREEWAY
REPLACE GLARESCREENS AND GUARDRAILS
Aiea Interchange to Moanalua Stream Bridge
FEDERAL AID PROJECT NO. STP-H201(2)
Scale: 1" = 40' Date: Nov. 1997

FED. ROAD DIST. NO.	STATE	FED. AID PROJ. NO.	FISCAL YEAR	SHEET NO.	TOTAL SHEETS
HAWAII	HAW.	STP-H201(2)	1998	11	23

CITY & COUNTY JURISDICTION
STATE JURISDICTION

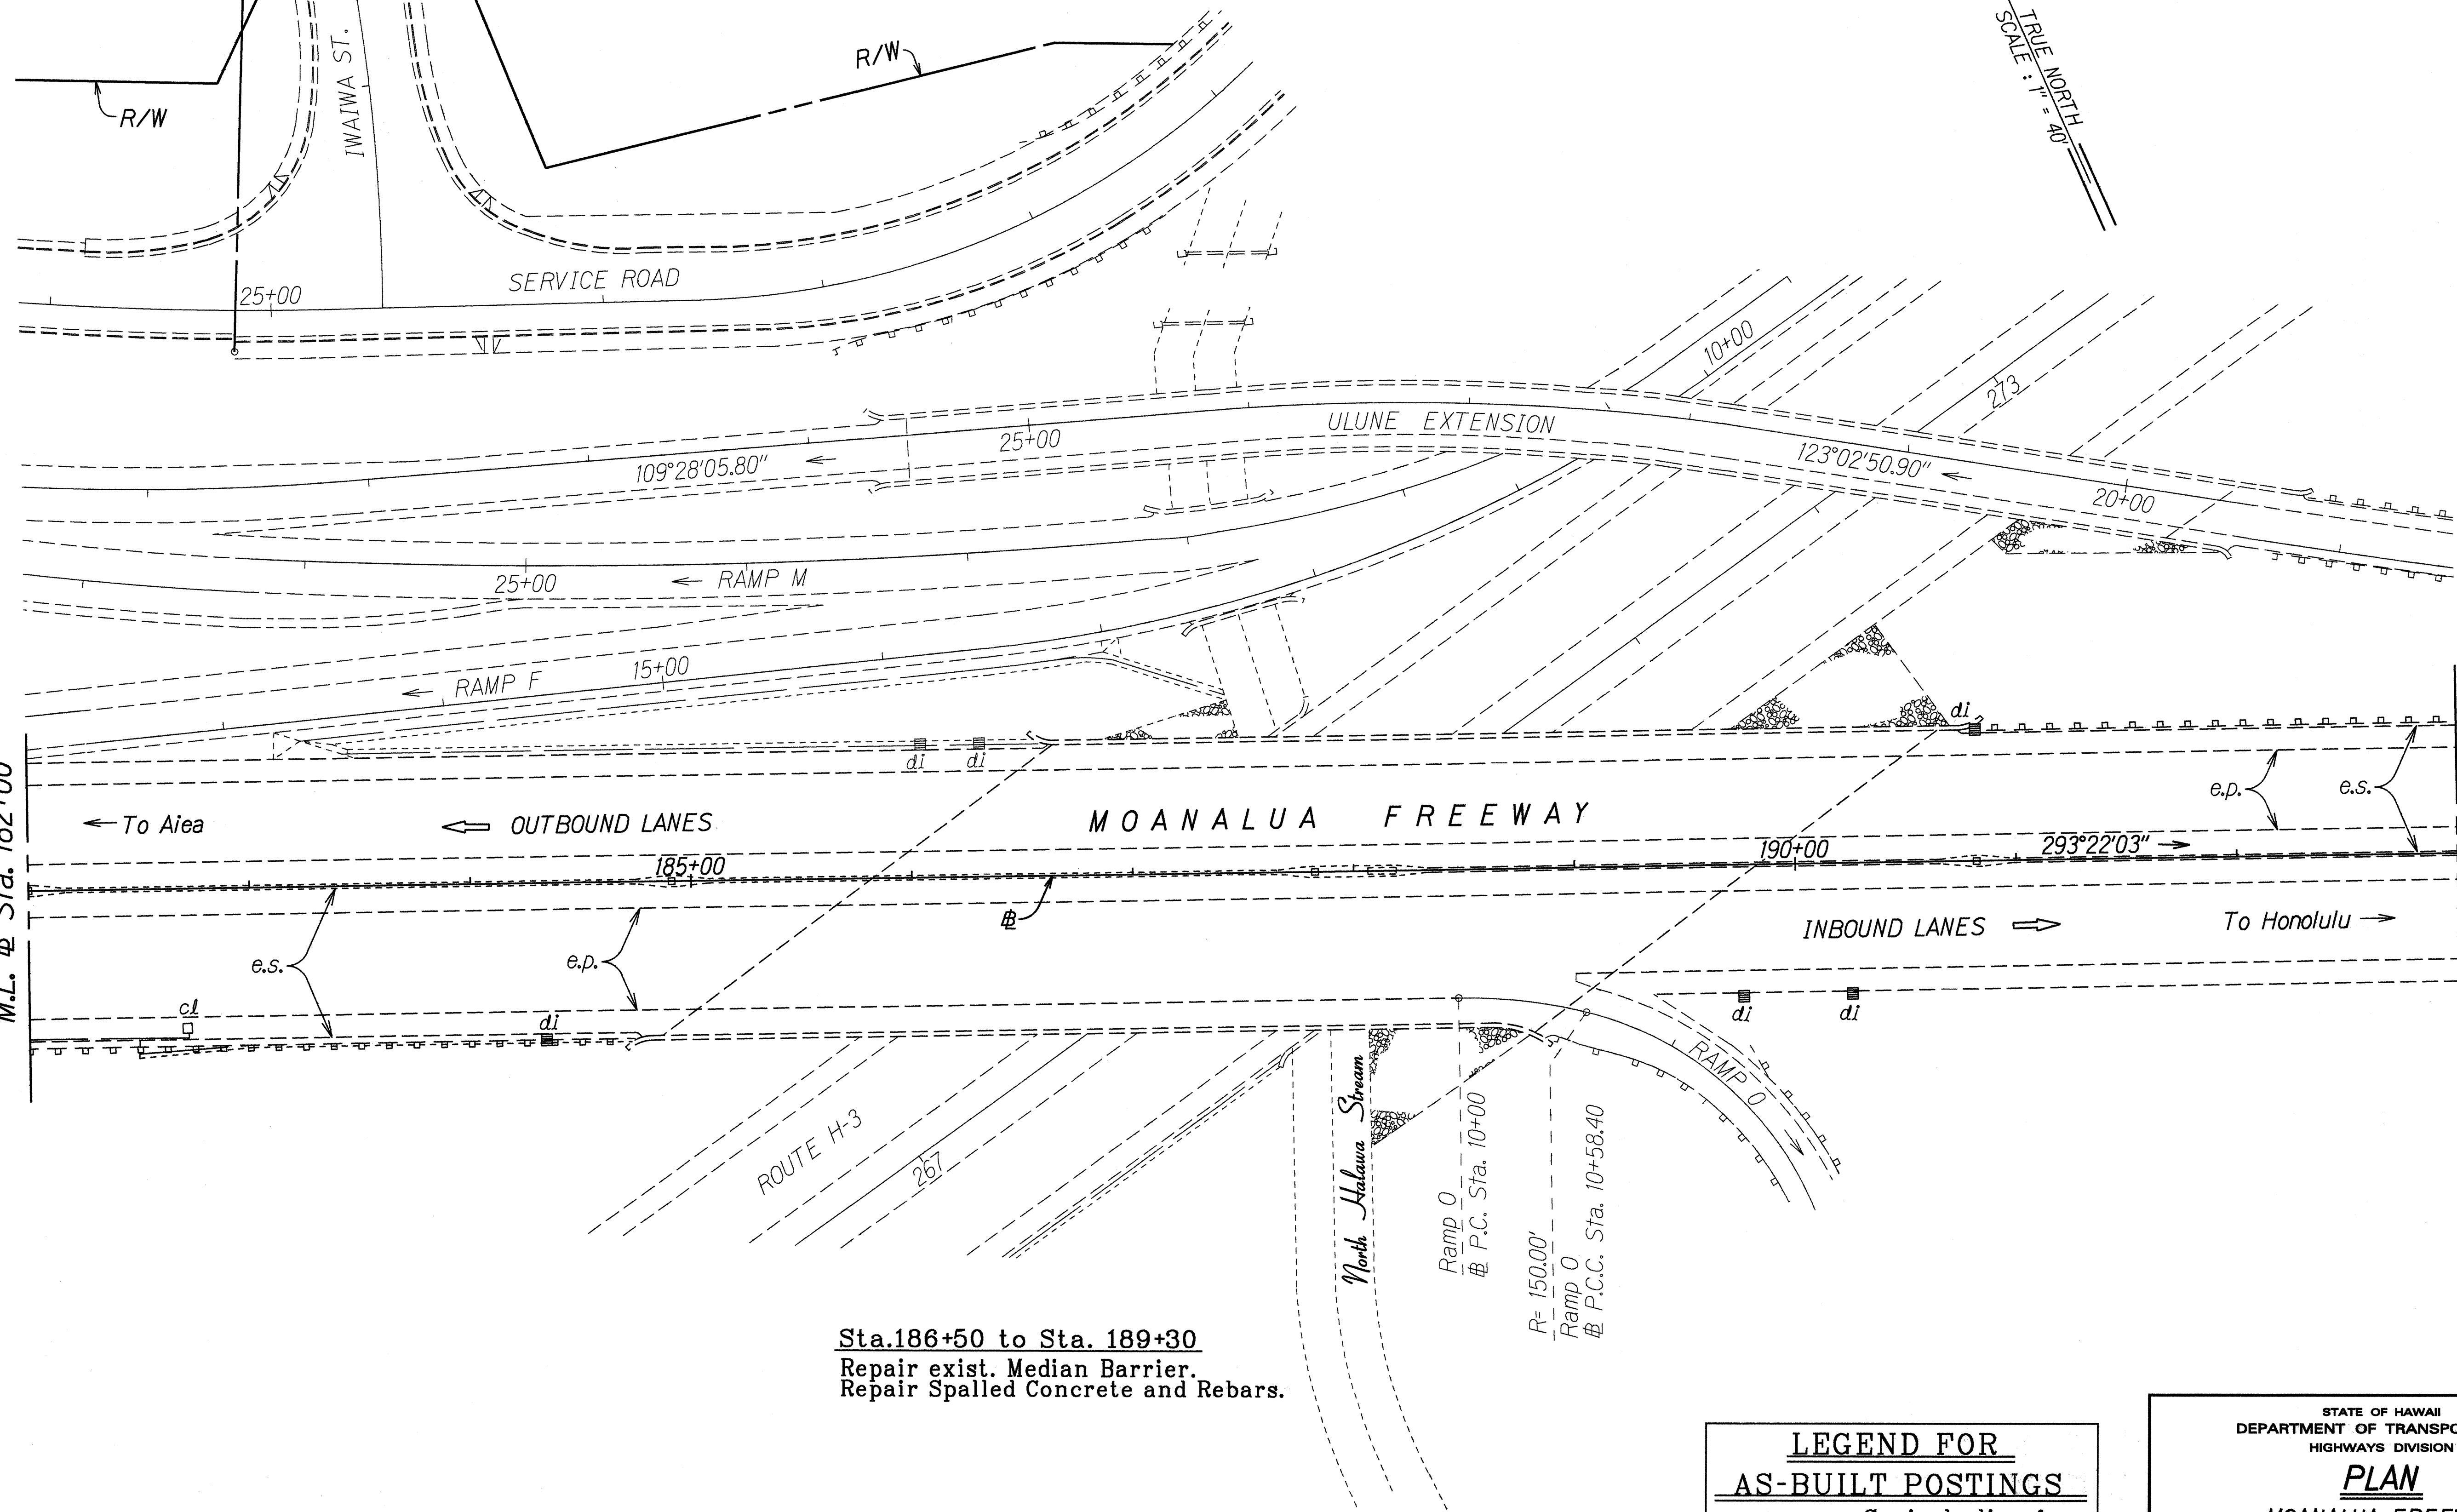

Sta.186+50 to Sta. 189+30
Repair exist. Median Barrier.
Repair Spalled Concrete and Rebars.

LEGEND FOR AS-BUILT POSTINGS	
	Squiggly line for as-built deletion
	Double line for as-built deletion
Roadway	Text for as-built posting

STATE OF HAWAII
DEPARTMENT OF TRANSPORTATION
HIGHWAYS DIVISION

PLAN
MOANALUA FREEWAY
REPLACE GLARESCREENS AND GUARDRAILS
Aiea Interchange to Moanalua Stream Bridge
FEDERAL AID PROJECT NO. STP-H201(2)
Scale: 1" = 40' Date: Nov. 1997


SHEET No. 4 OF 12 SHEETS

ORIGINAL PLAN	DATE
SURVEY ELABORATED BY	11-20-97
DRAWN BY	P. Wong, M.H.
NOTED BY	
DESIGNED BY	L. Suzuki
CHECKED BY	
APPROVED BY	

"AS-BUILT"

FED. ROAD DIST. NO.	STATE	FED. AID PROJ. NO.	FISCAL YEAR	SHEET NO.	TOTAL SHEETS
HAWAII	HAW.	STP-H201(2)	1998	12	23

TRUE NORTH
SCALE: 1" = 40'

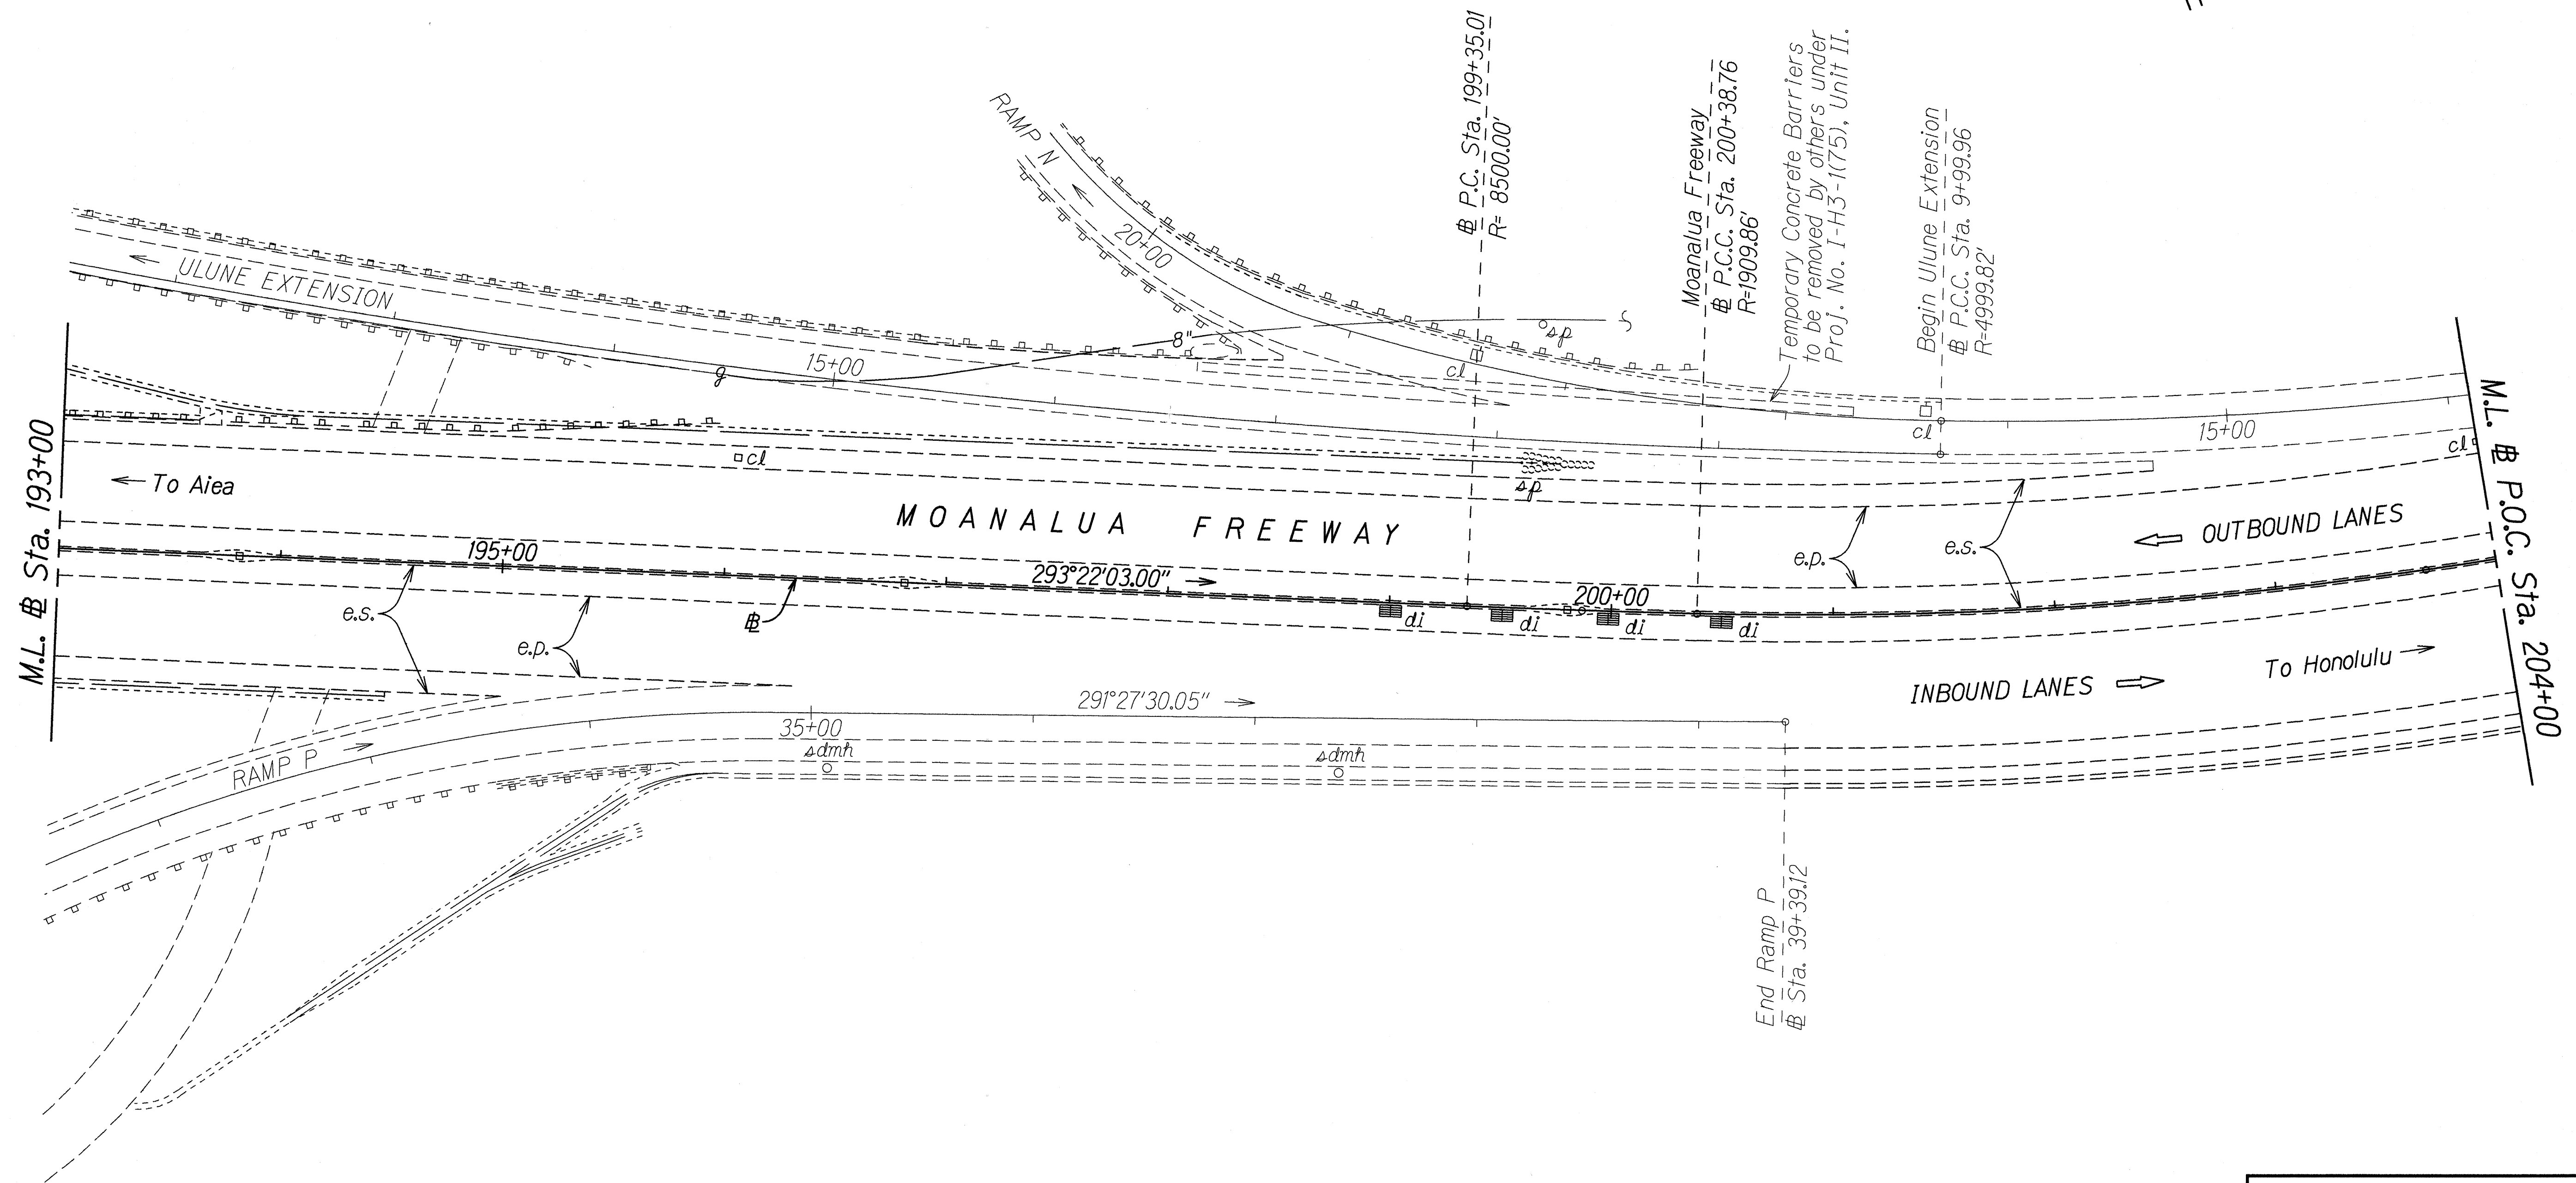


GENERAL	DESIGNED BY	DATE
PLAN	TRACED BY	11-4-97
	DESIGNED BY	
	QUANTITIES BY	
	CHECKED BY	

STATE OF HAWAII
DEPARTMENT OF TRANSPORTATION
HIGHWAYS DIVISION
PLAN
MOANALUA FREEWAY
REPLACE GLARESCREENS AND GUARDRAILS
Aiea Interchange to Moanalua Stream Bridge
FEDERAL AID PROJECT NO. STP-H201(2)
Scale: 1" = 40' Date: Nov. 1997

SHEET No. 5 OF 12 SHEETS

FED. ROAD DIST. NO.	STATE	FED. AID PROJ. NO.	FISCAL YEAR	SHEET NO.	TOTAL SHEETS
HAWAII	HAW.	STP-H201(2)	1998	13	23

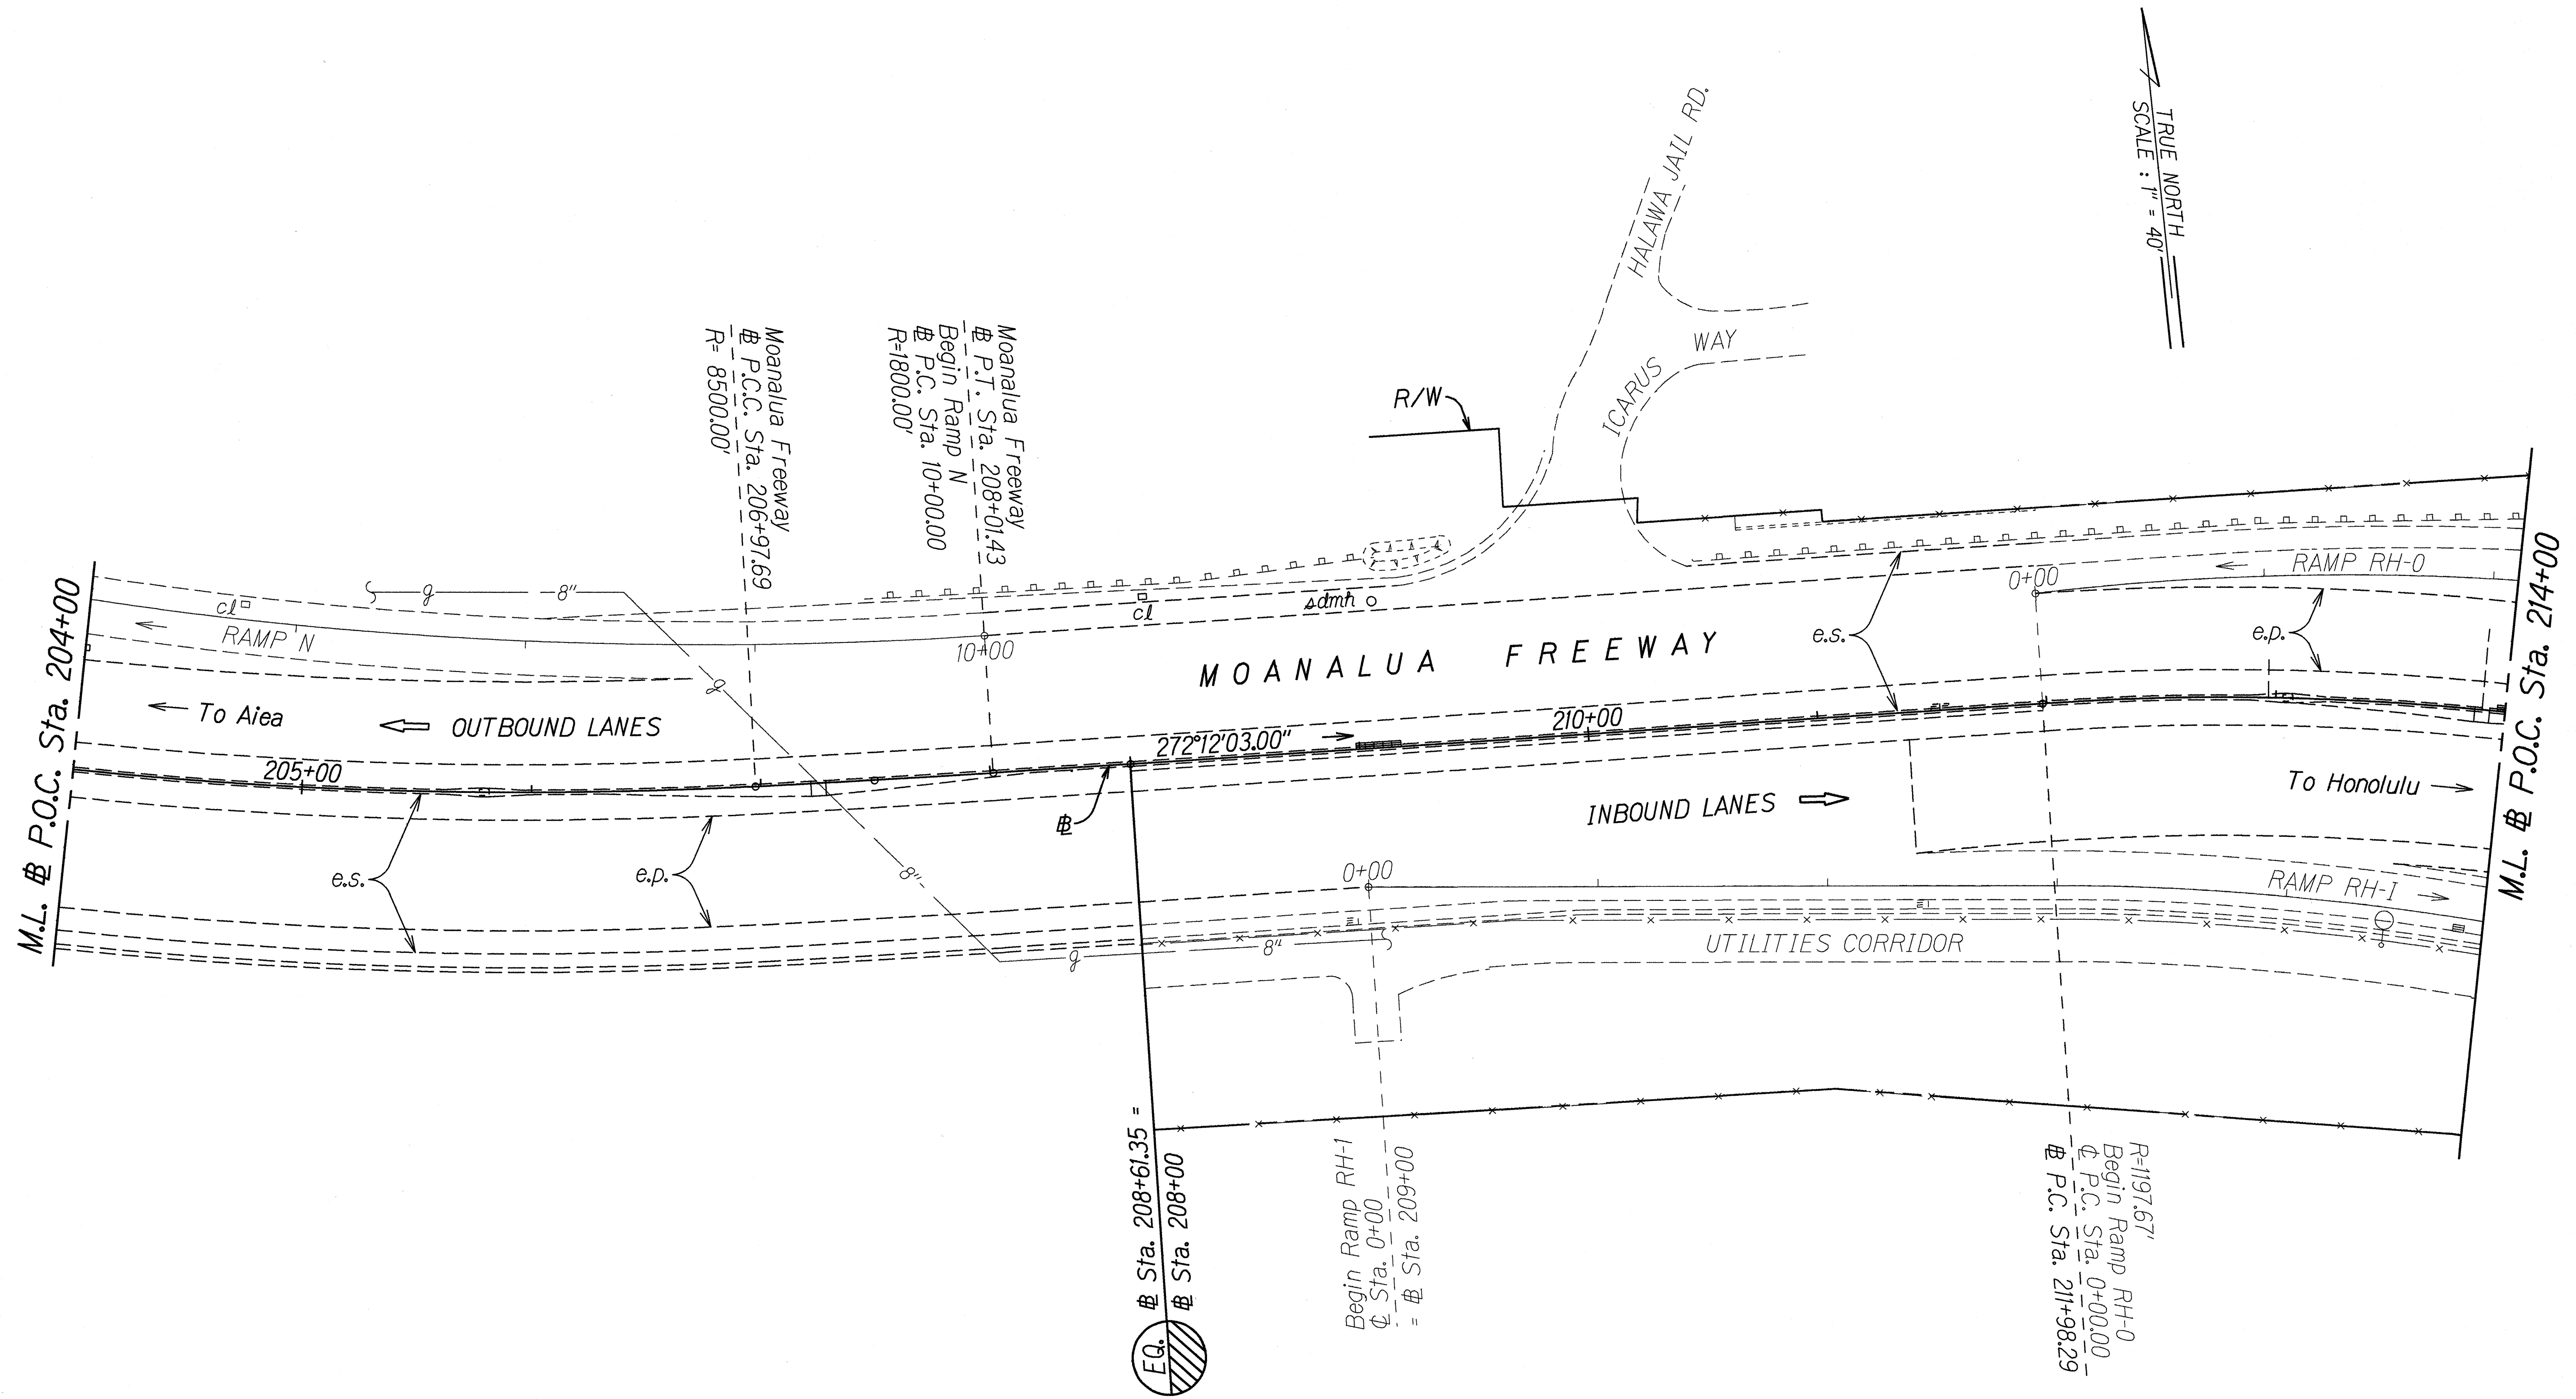

TRUE NORTH
SCALE: 1" = 40'

ORIGINAL PLAN	DATE
DESIGNED BY L. Suzuki	11/20/97
DRAWN BY L. Suzuki	
CHECKED BY	
APPROVED BY	

STATE OF HAWAII
DEPARTMENT OF TRANSPORTATION
HIGHWAYS DIVISION

PLAN

MOANALUA FREEWAY

REPLACE GLARESCREENS AND GUARDRAILS


Aiea Interchange to Moanalua Stream Bridge

FEDERAL AID PROJECT NO. STP-H201(2)

Scale: 1" = 40' Date: Nov. 1997

SHEET No. 6 OF 12 SHEETS

FED. ROAD DIST. NO.	STATE	FED. AID PROJ. NO.	FISCAL YEAR	SHEET NO.	TOTAL SHEETS
HAWAII	HAW.	STP-H201(2)	1998	14	23

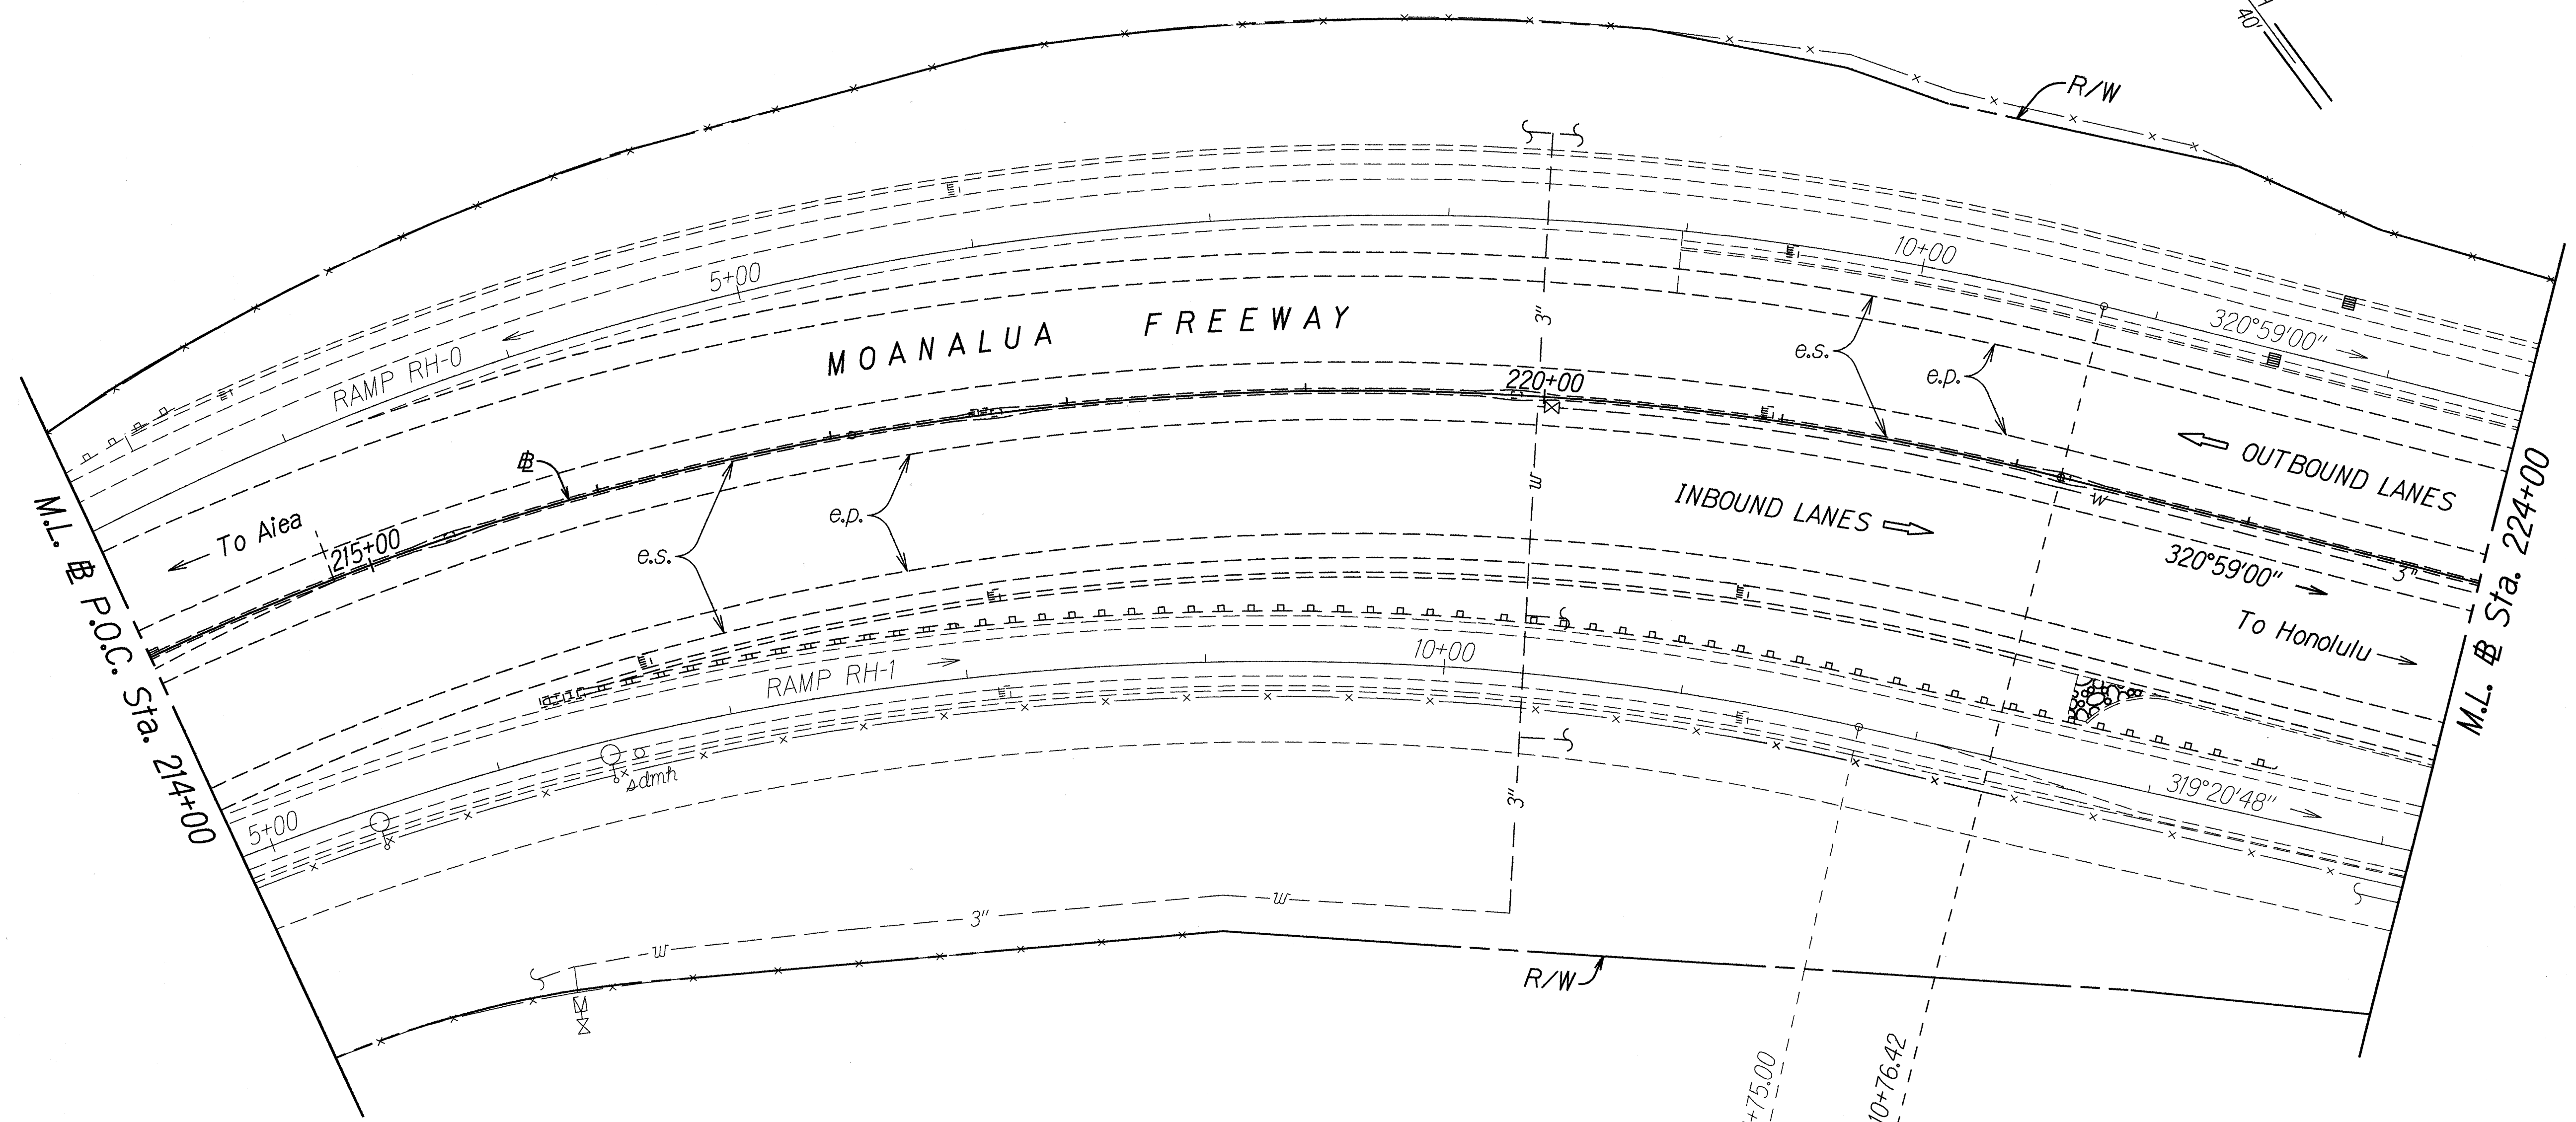


TRUE NORTH
SCALE: 1" = 40'

Ramp RH-1 P.T. Sta. 11+75.00
R=1150.00'
= 1197.67'
Ramp RH-0 P.T. Sta. 10+76.42
Moanalua Freeway
P.T. Sta. 222+19.30
R=1200.00'

DESIGNED BY	DATE
TRACED BY	11/20/97
DESIGNED BY	
QUANTITIES BY	
CHECKED BY	

STATE OF HAWAII
DEPARTMENT OF TRANSPORTATION
HIGHWAYS DIVISION
PLAN
MOANALUA FREEWAY
REPLACE GLARESCREENS AND GUARDRAILS
Aiea Interchange to Moanalua Stream Bridge
FEDERAL AID PROJECT NO. STP-H201(2)
Scale: 1" = 40' Date: Nov. 1997

FED. ROAD DIST. NO.	STATE	FED. AID PROJ. NO.	FISCAL YEAR	SHEET NO.	TOTAL SHEETS
HAWAII	HAW.	STP-H201(2)	1998	15	23

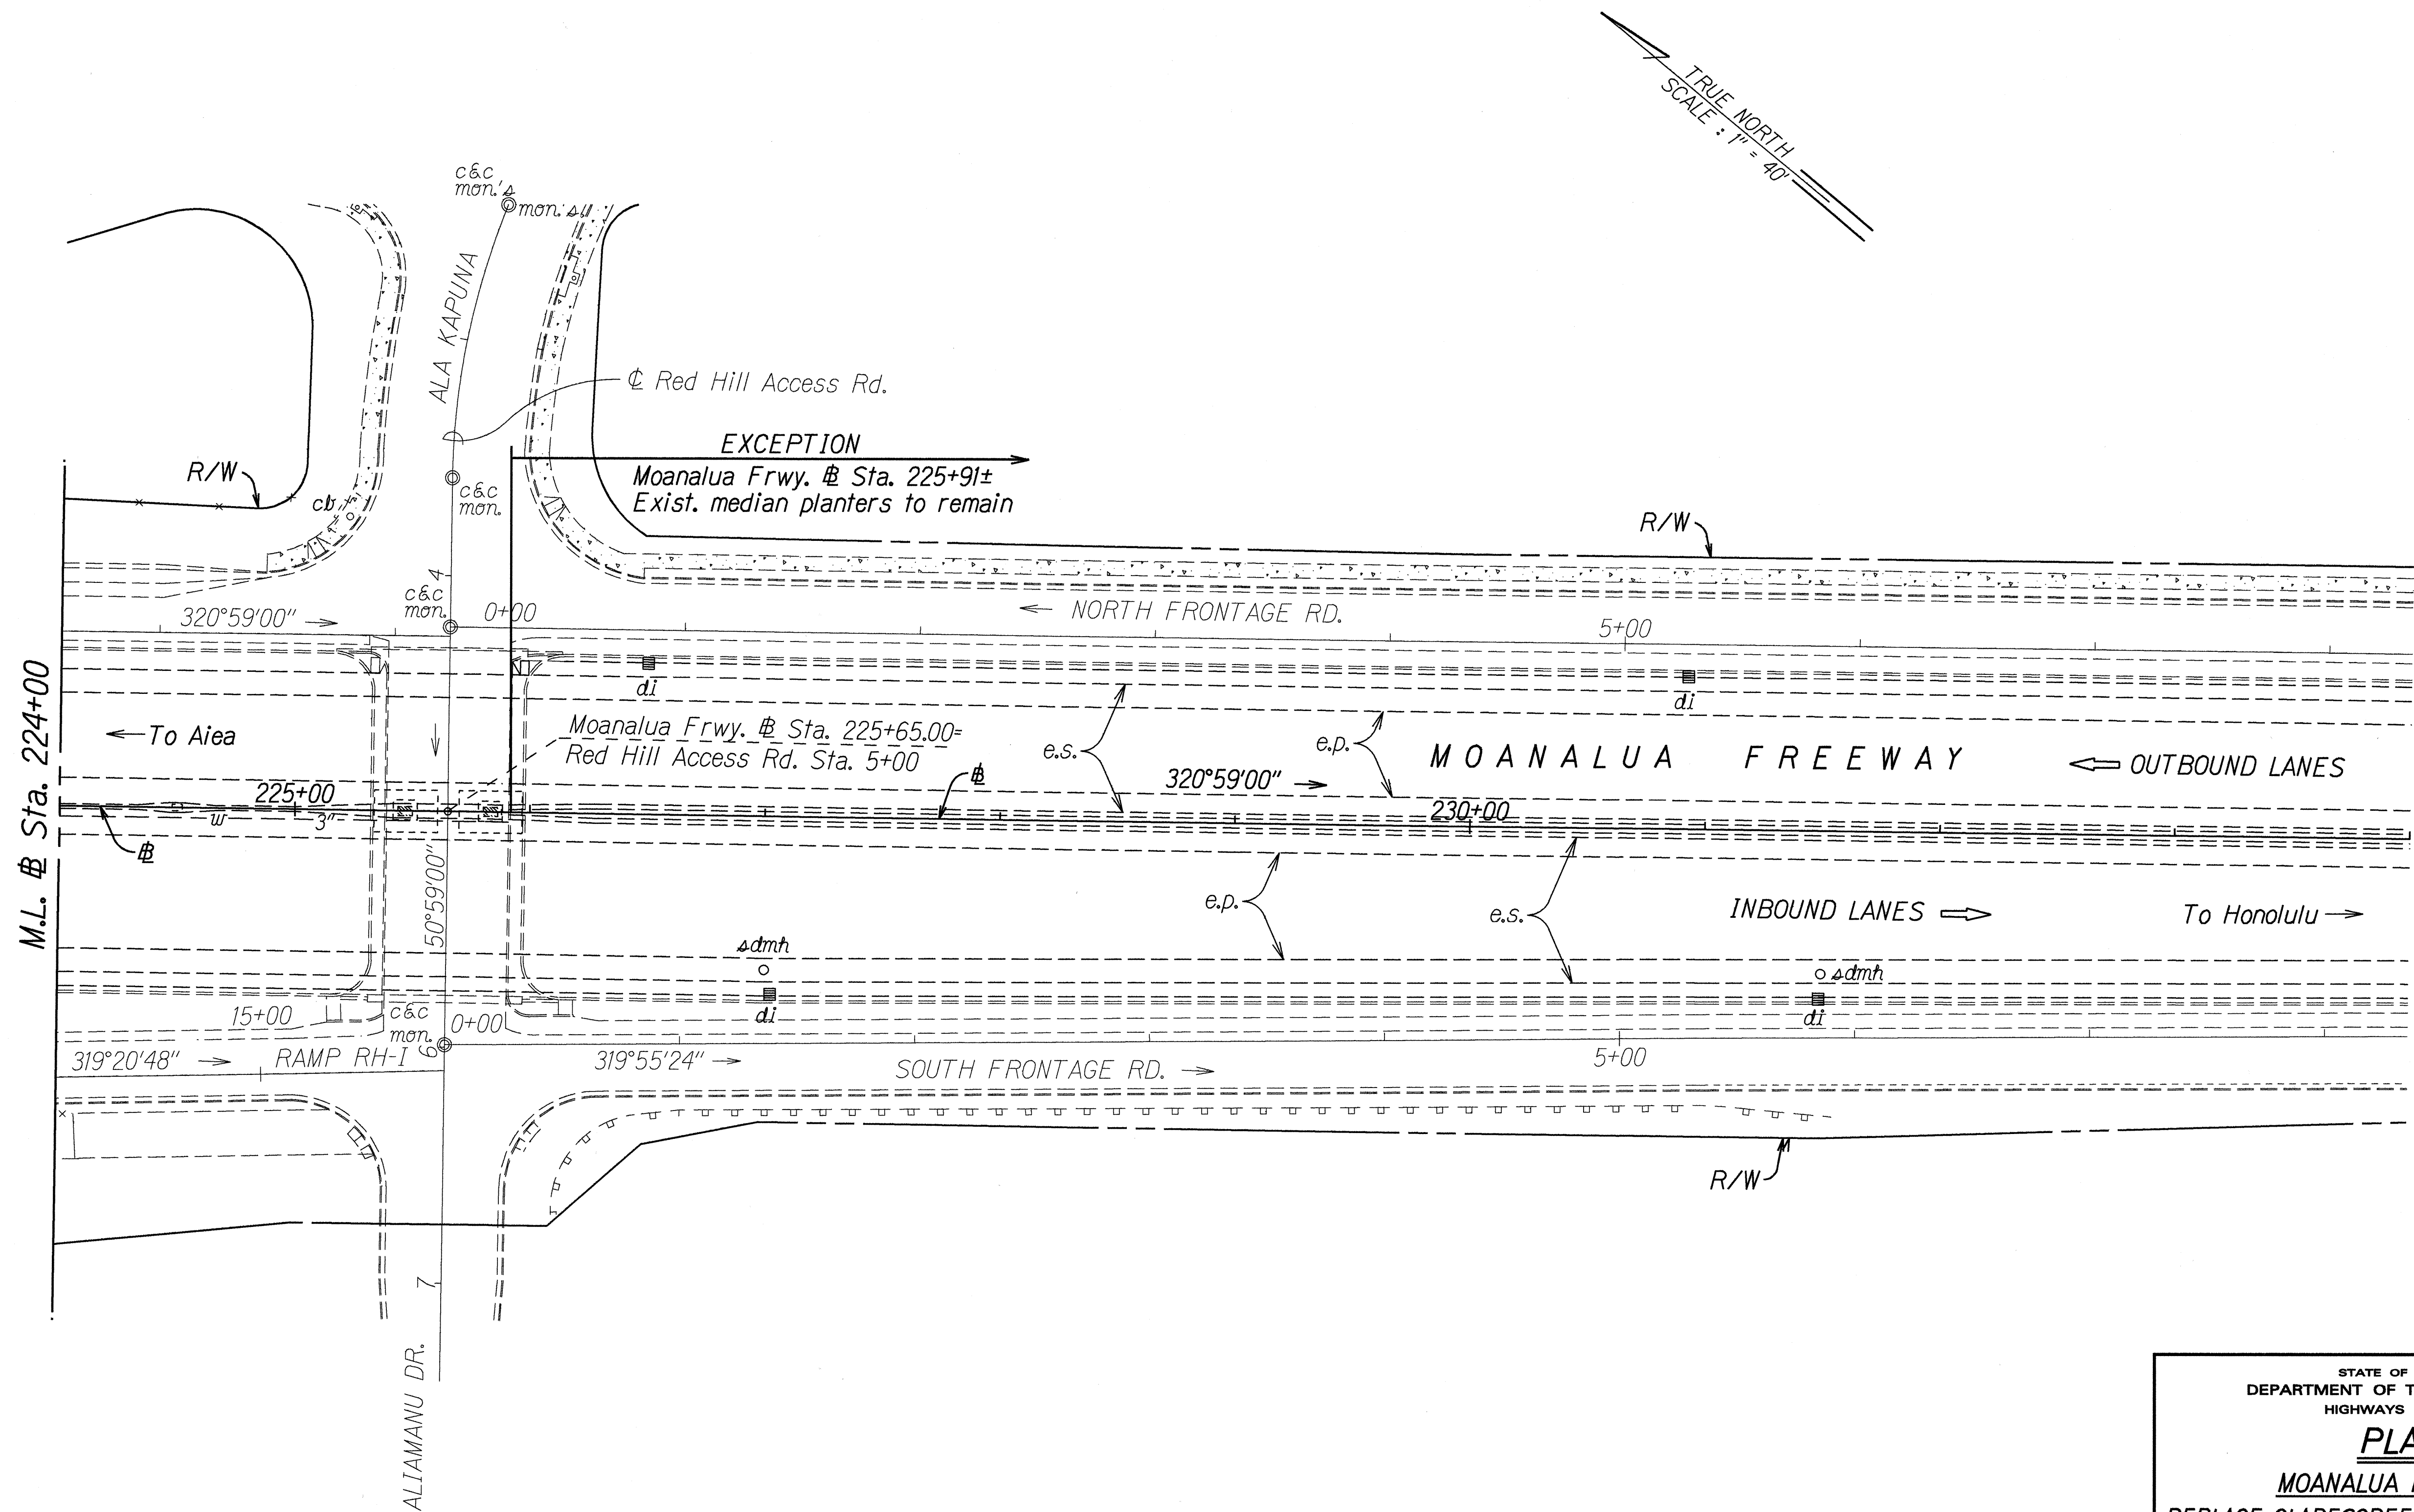


ORIGINAL PLAN	DATE
DESIGNED BY	11-4-97
DRAWN BY	
CHECKED BY	
APPROVED BY	

STATE OF HAWAII
DEPARTMENT OF TRANSPORTATION
HIGHWAYS DIVISION

PLAN
MOANALUA FREEWAY
REPLACE GLARESCREENS AND GUARDRAILS
Aiea Interchange to Moanalua Stream Bridge
FEDERAL AID PROJECT NO. STP-H201(2)
Scale: 1" = 40' Date: Nov. 1997

SHEET No. 8 OF 12 SHEETS

FED. ROAD DIST. NO.	STATE	FED. AID PROJ. NO.	FISCAL YEAR	SHEET NO.	TOTAL SHEETS
HAWAII	HAW.	STP-H201(2)	1998	16	23

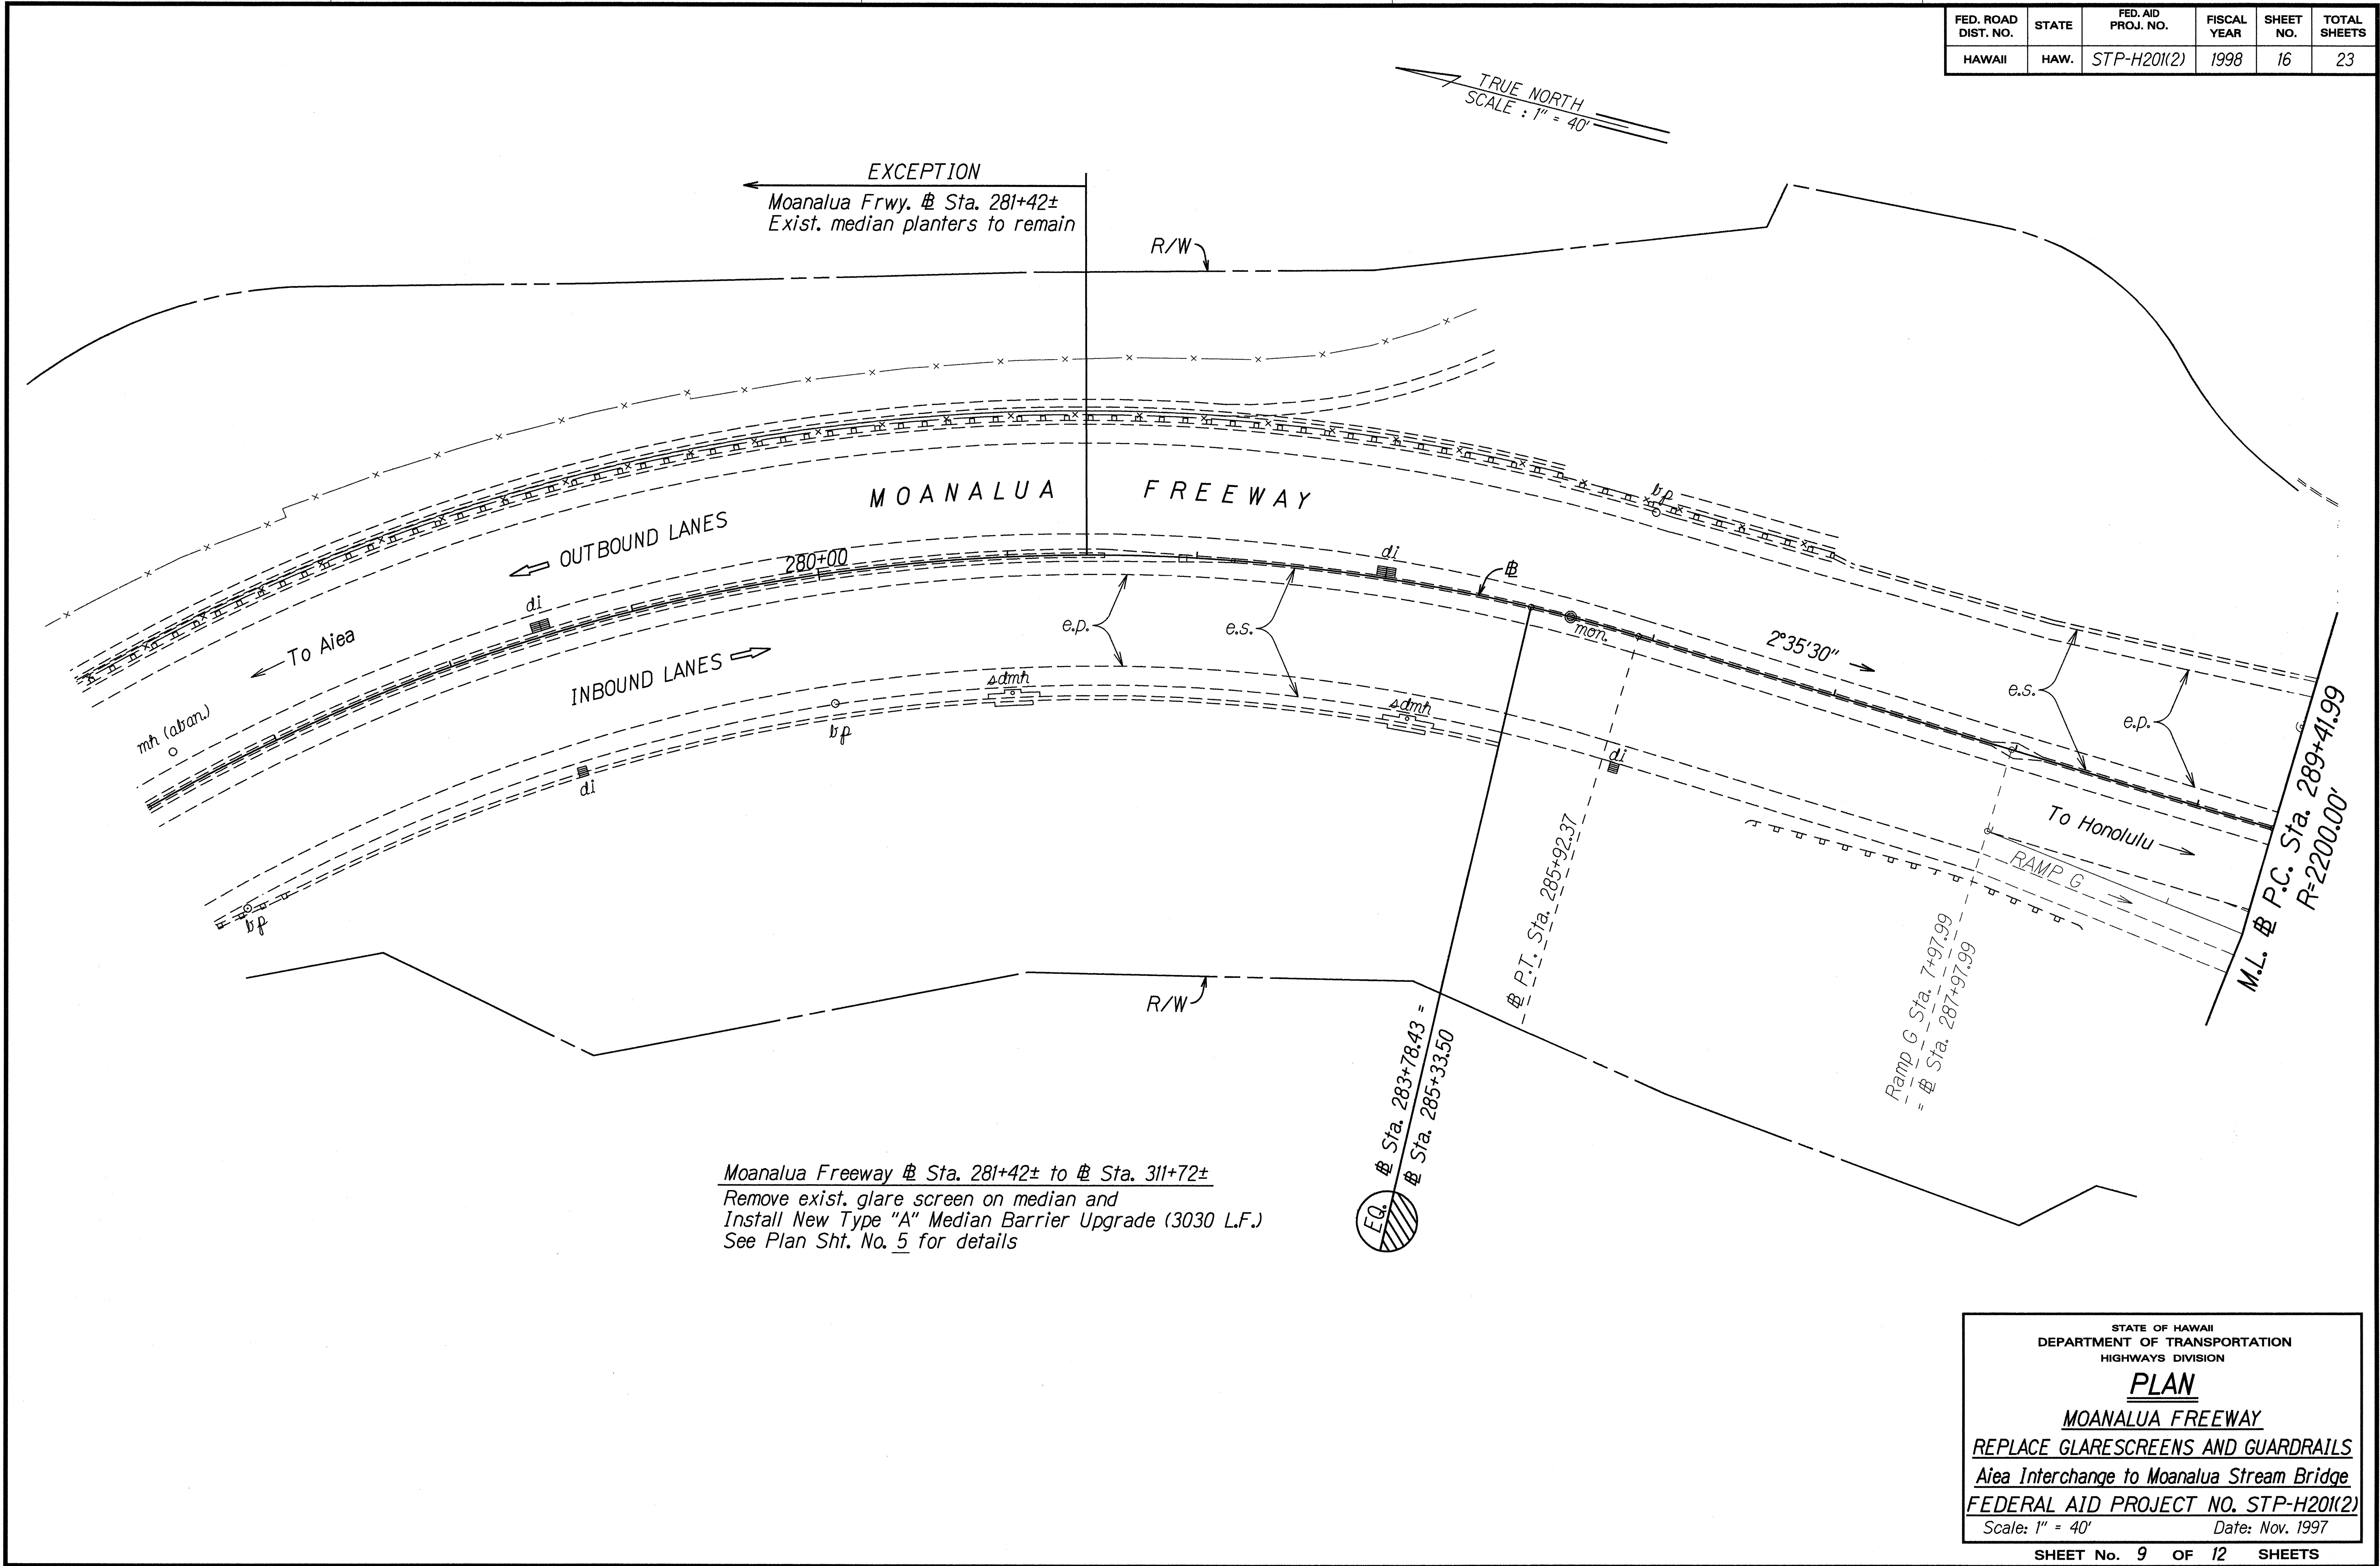

ORIGINAL PLAN	DATE
DESIGNED BY	11-4-97
DRAWN BY	
CHECKED BY	
APPROVED BY	
NOTED BY	
QUANTITIES BY	
CHECKED BY	


STATE OF HAWAII
 DEPARTMENT OF TRANSPORTATION
 HIGHWAYS DIVISION

PLAN
 MOANALUA FREEWAY
 REPLACE GLARESCREENS AND GUARDRAILS
 Aiea Interchange to Moanalua Stream Bridge
 FEDERAL AID PROJECT NO. STP-H201(2)
 Scale: 1" = 40' Date: Nov. 1997

SHEET No. 9 OF 12 SHEETS

FED. ROAD DIST. NO.	STATE	FED. AID PROJ. NO.	FISCAL YEAR	SHEET NO.	TOTAL SHEETS
HAWAII	HAW.	STP-H20(2)	1998	17	23

TRUE NORTH
SCALE: 1" = 40'

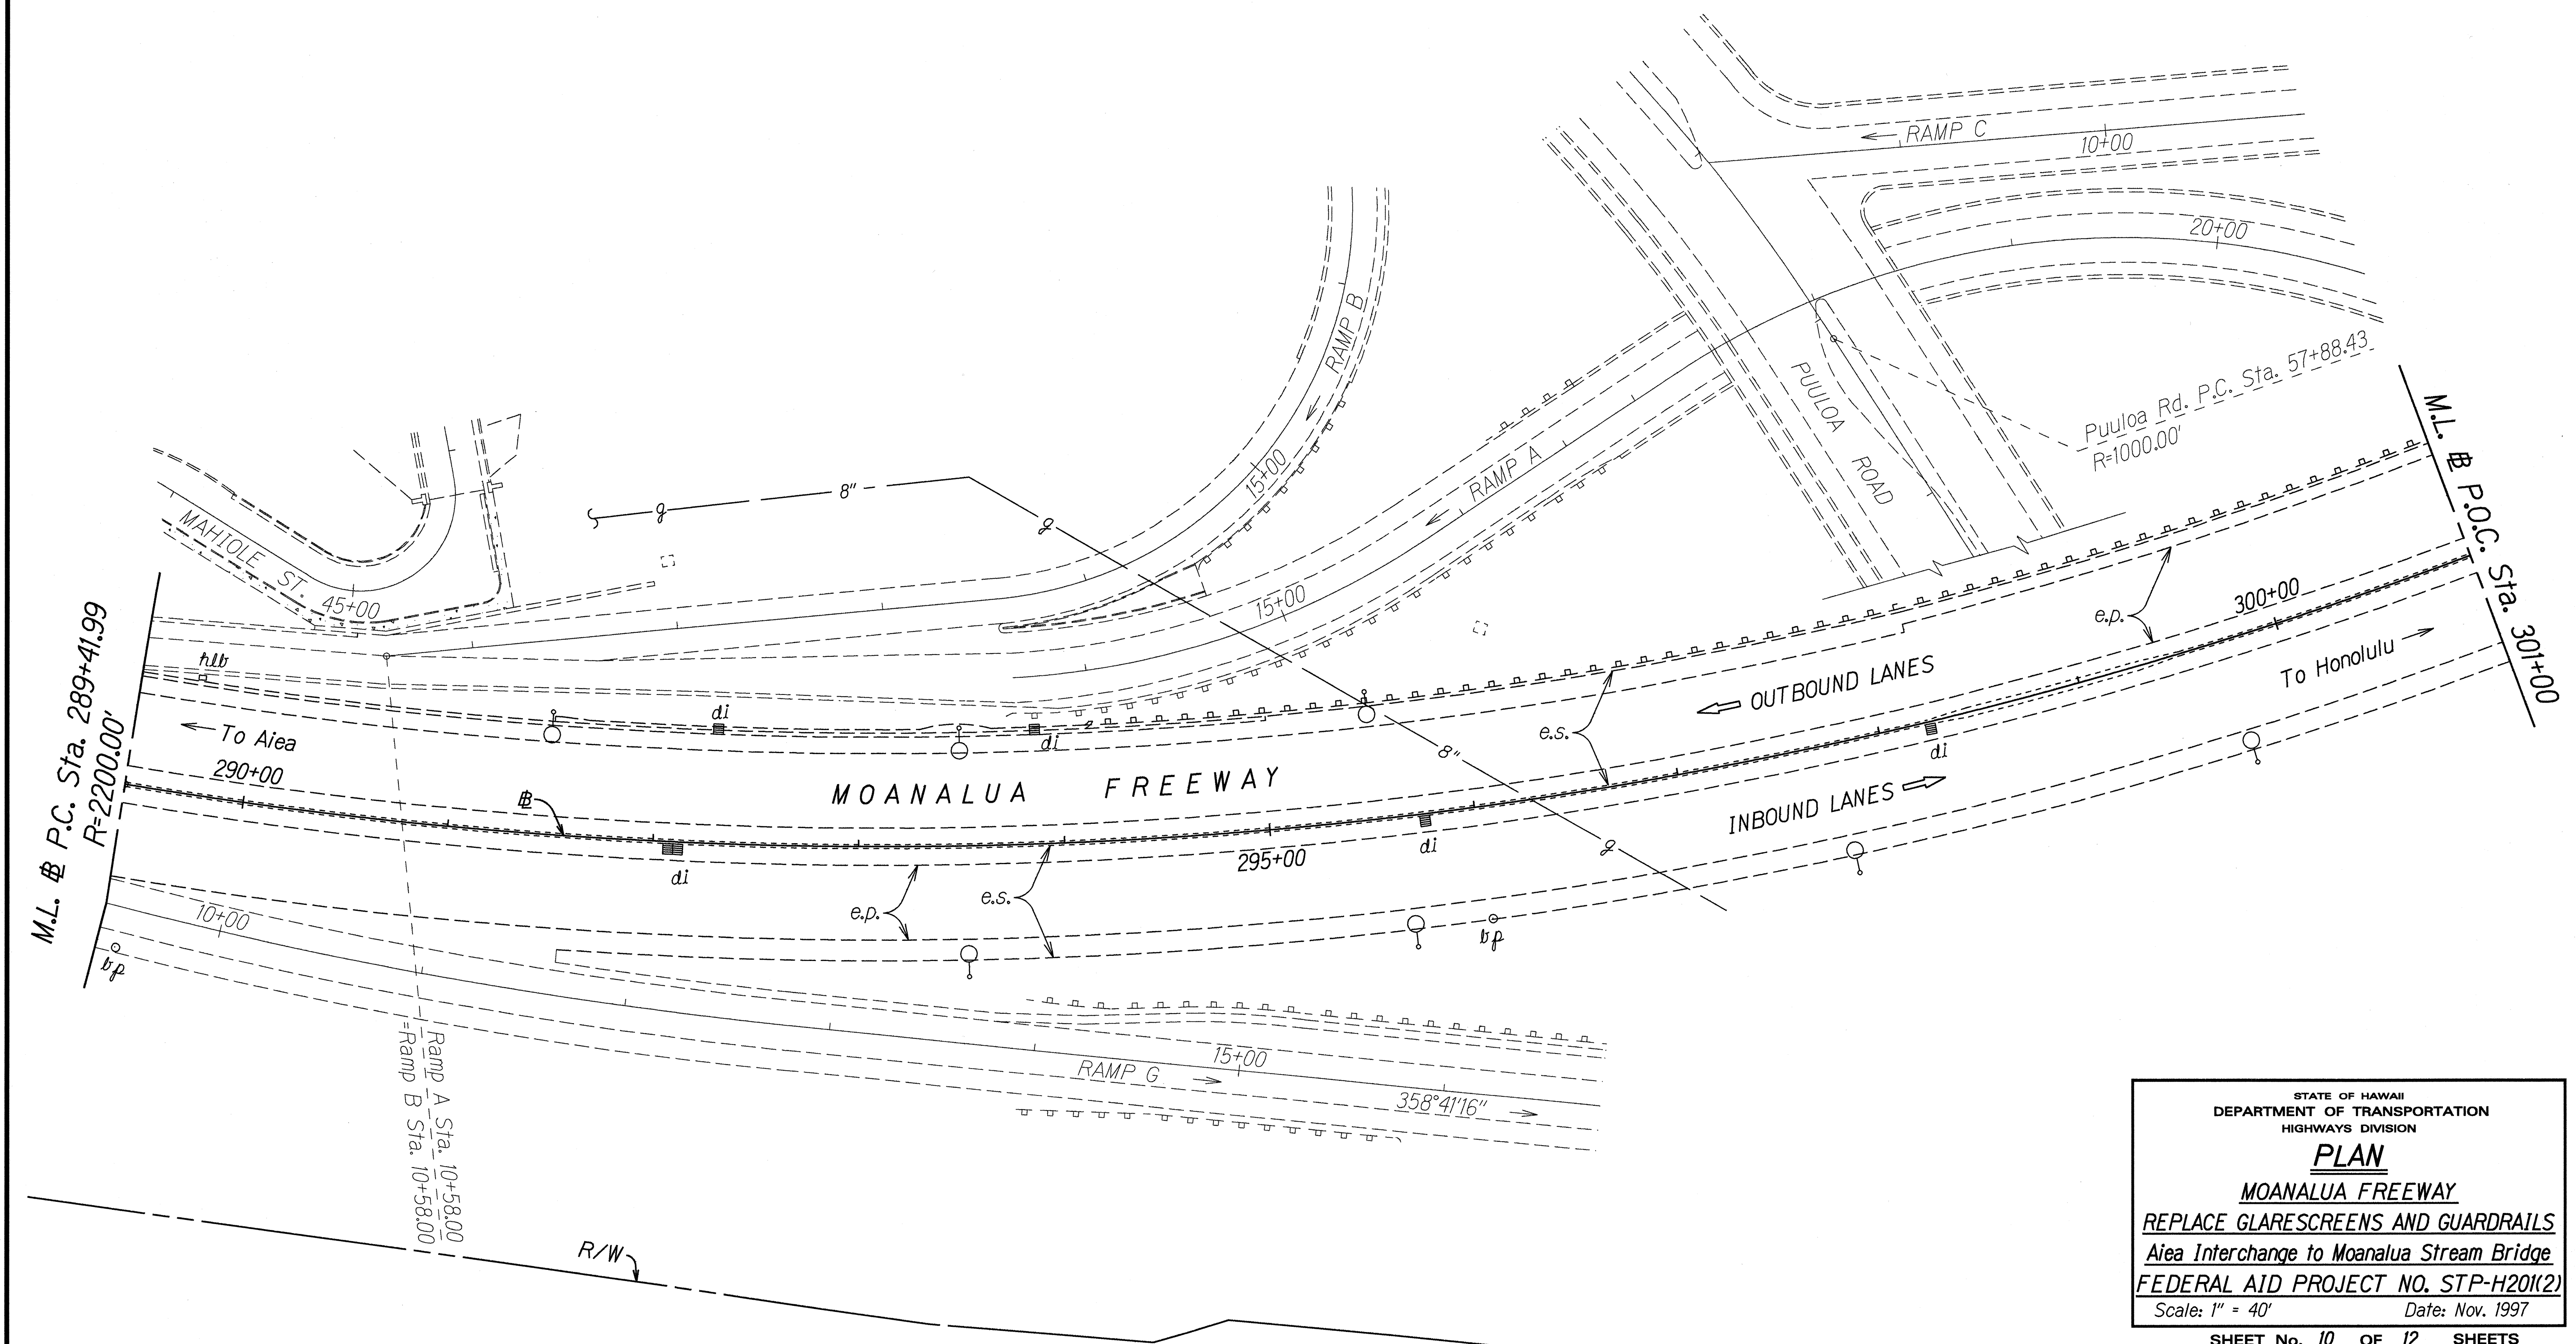

DESIGNED BY	DATE
DRIVEN BY	11-4-97
DESIGNED BY	
QUANTITY BY	
CHECKED BY	

STATE OF HAWAII
DEPARTMENT OF TRANSPORTATION
HIGHWAYS DIVISION

PLAN


MOANALUA FREEWAY

REPLACE GLARESCREENS AND GUARDRAILS
Aiea Interchange to Moanalua Stream Bridge
FEDERAL AID PROJECT NO. STP-H20(2)

Scale: 1" = 40' Date: Nov. 1997

SHEET No. 10 OF 12 SHEETS

FED. ROAD DIST. NO.	STATE	FED. AID PROJ. NO.	FISCAL YEAR	SHEET NO.	TOTAL SHEETS
HAWAII	HAW.	STP-H201(2)	1998	19	23

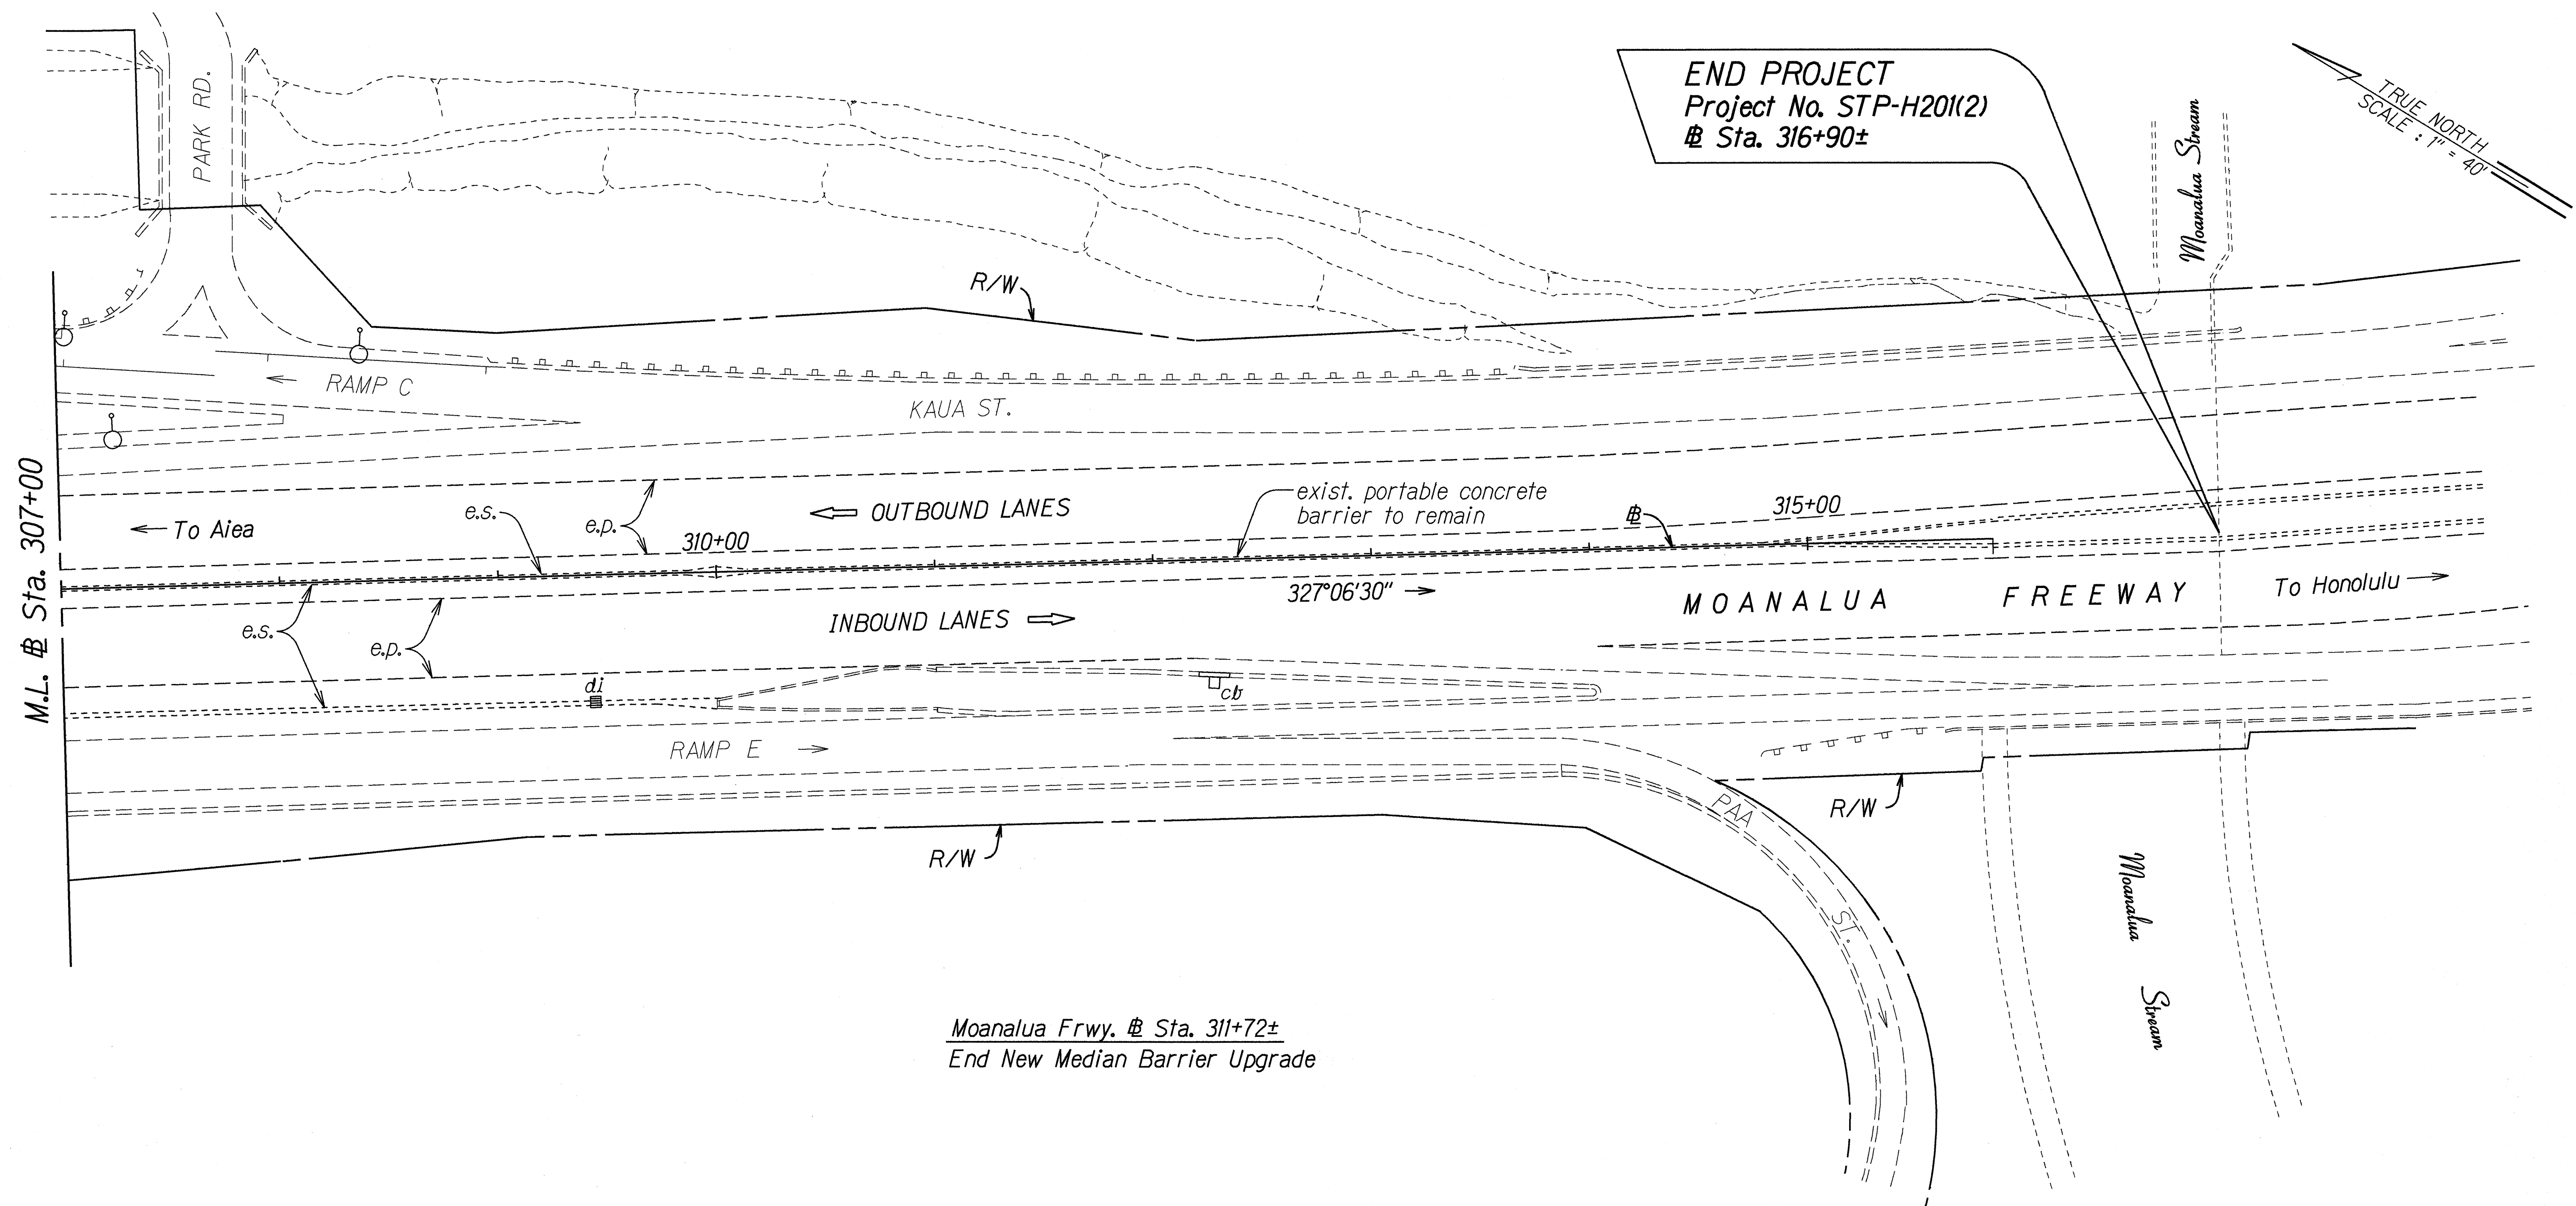

DESIGNED BY	DATE
TRACED BY	11-4-97
DESIGNED BY L. Suzuki	
QUANTITIES BY	
CHECKED BY	

STATE OF HAWAII
DEPARTMENT OF TRANSPORTATION
HIGHWAYS DIVISION

PLAN

MOANALUA FREEWAY

REPLACE GLARESCREENS AND GUARDRAILS

Aiea Interchange to Moanalua Stream Bridge

FEDERAL AID PROJECT NO. STP-H201(2)

Scale: 1" = 40' Date: Nov. 1997

SHEET No. 12 OF 12 SHEETS