




FED. ROAD DIST. NO.	STATE	PROJ. NO.	FISCAL YEAR	SHEET NO.	TOTAL SHEETS
HAWAII	HAW.	BR-0300(42)	1997	4	8

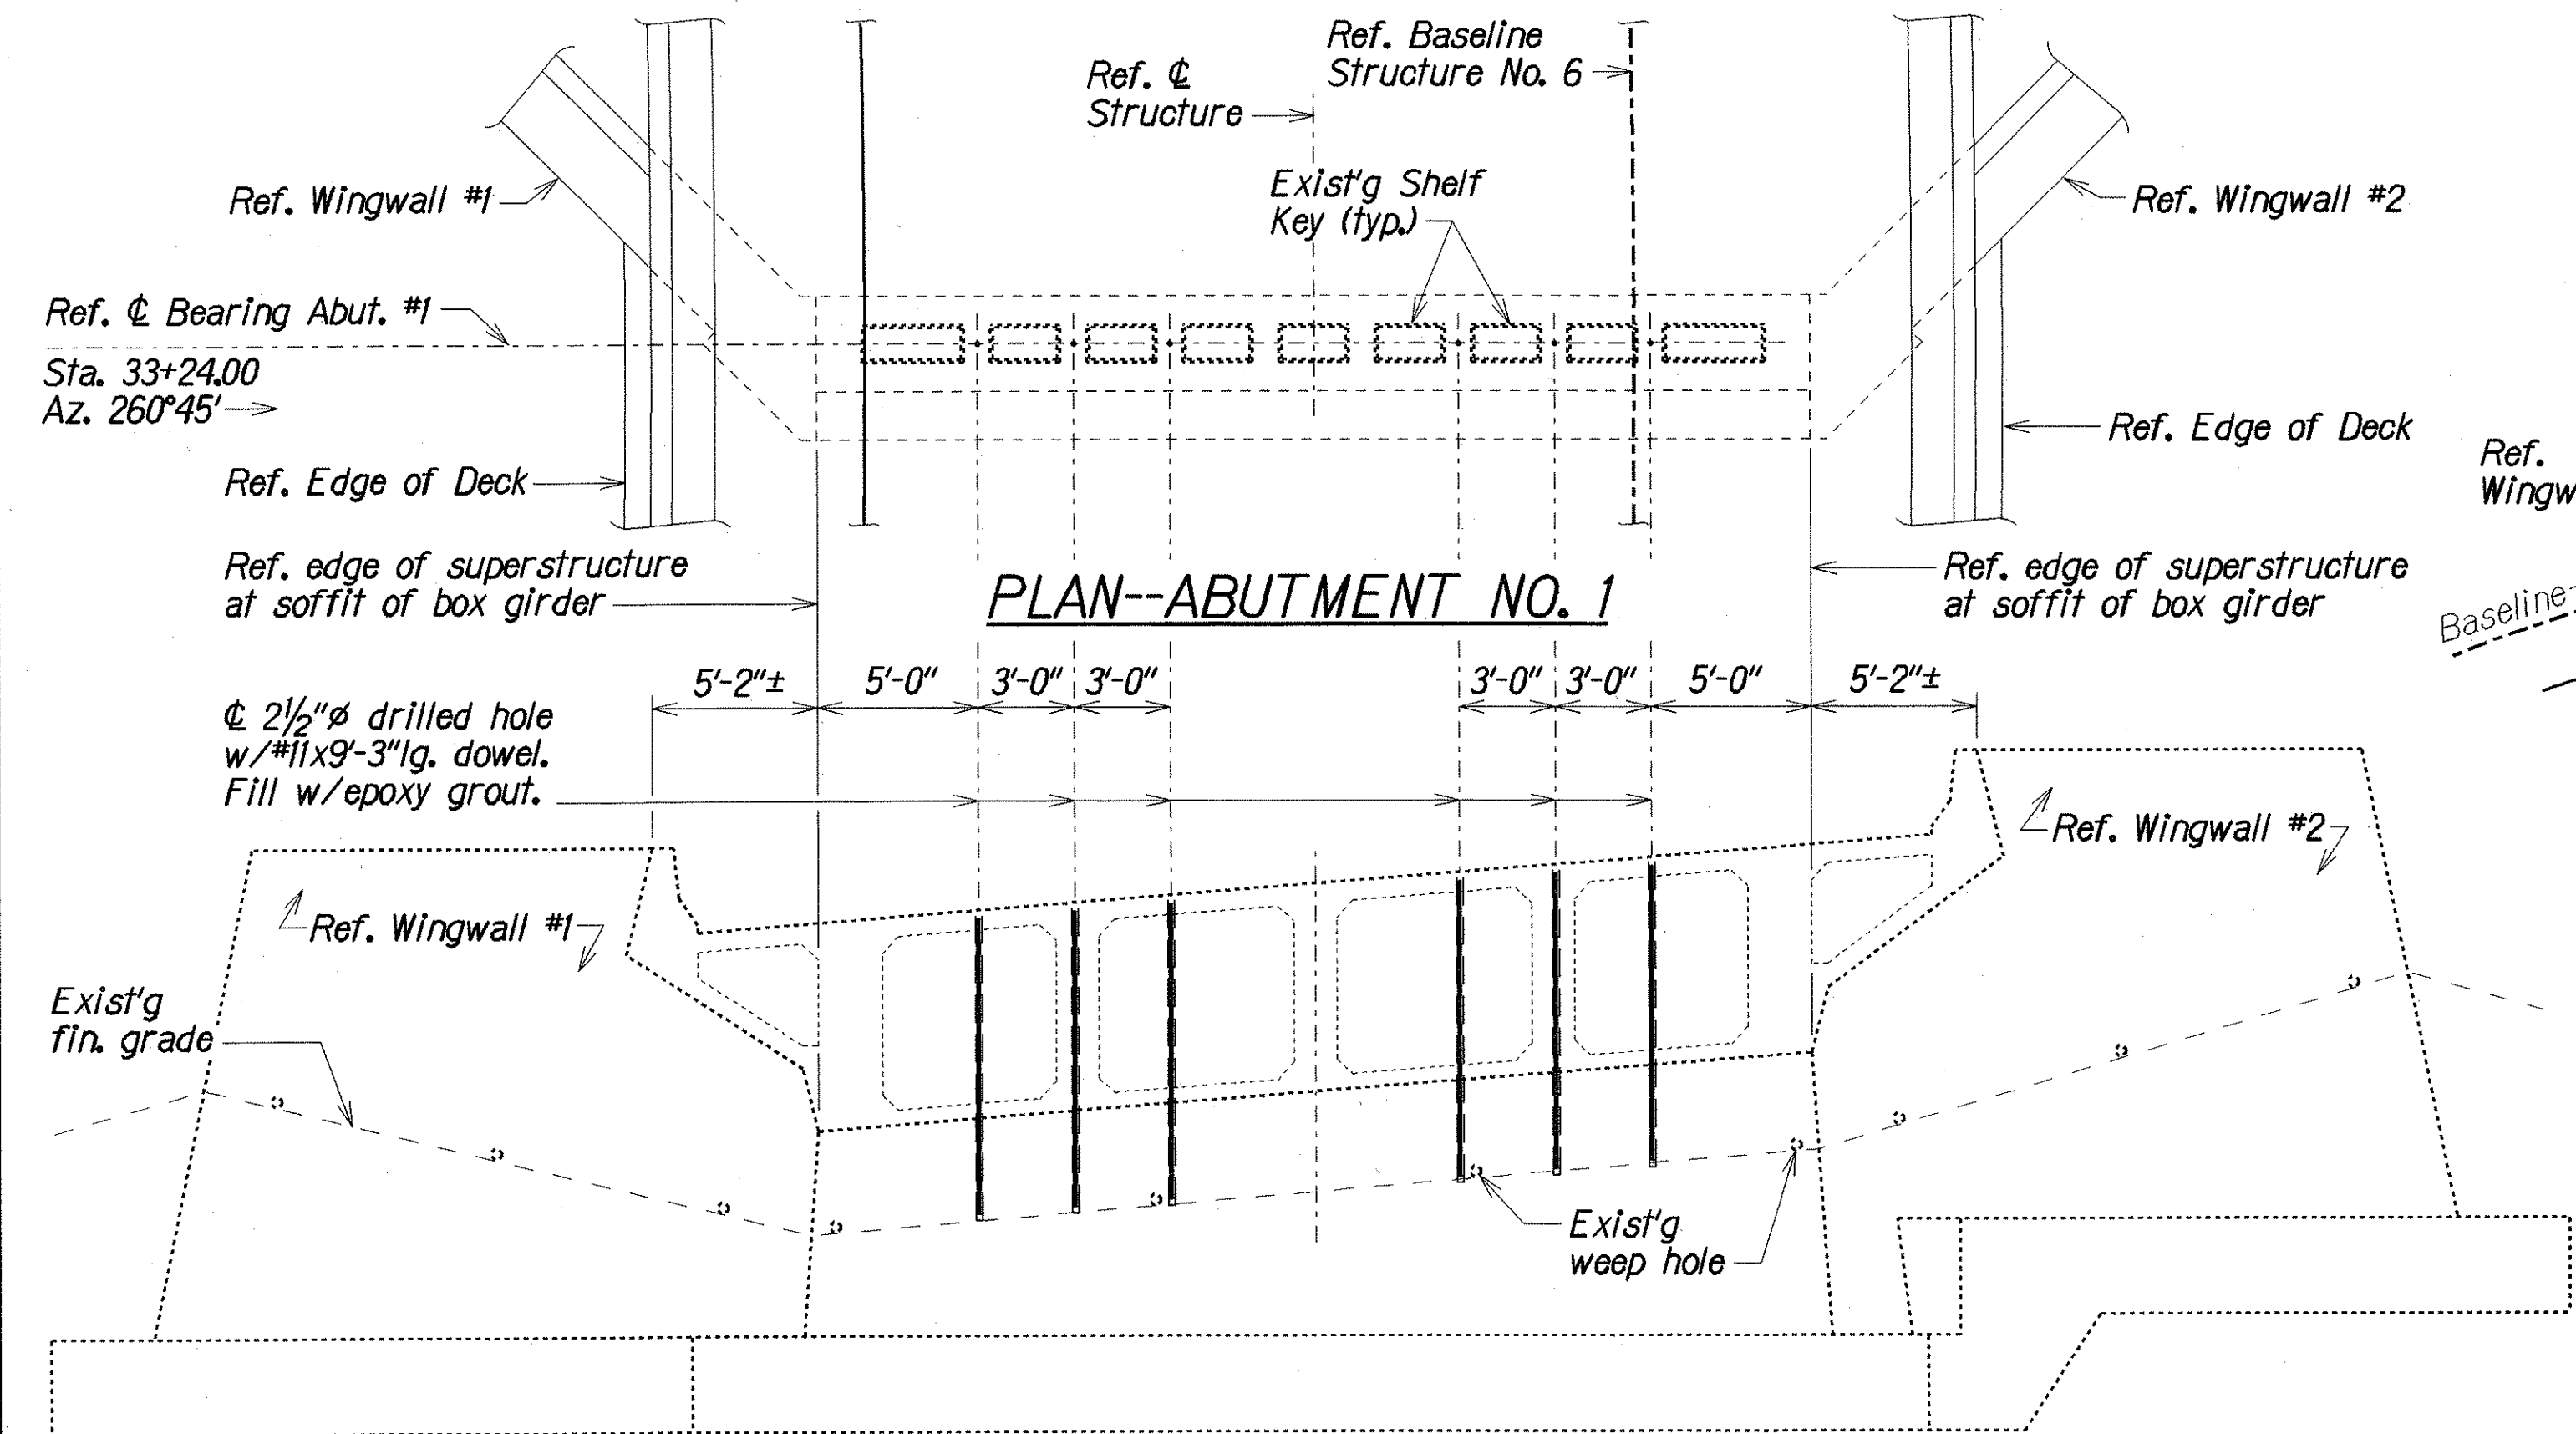


ELEVATION--ABUTMENT NO. 1

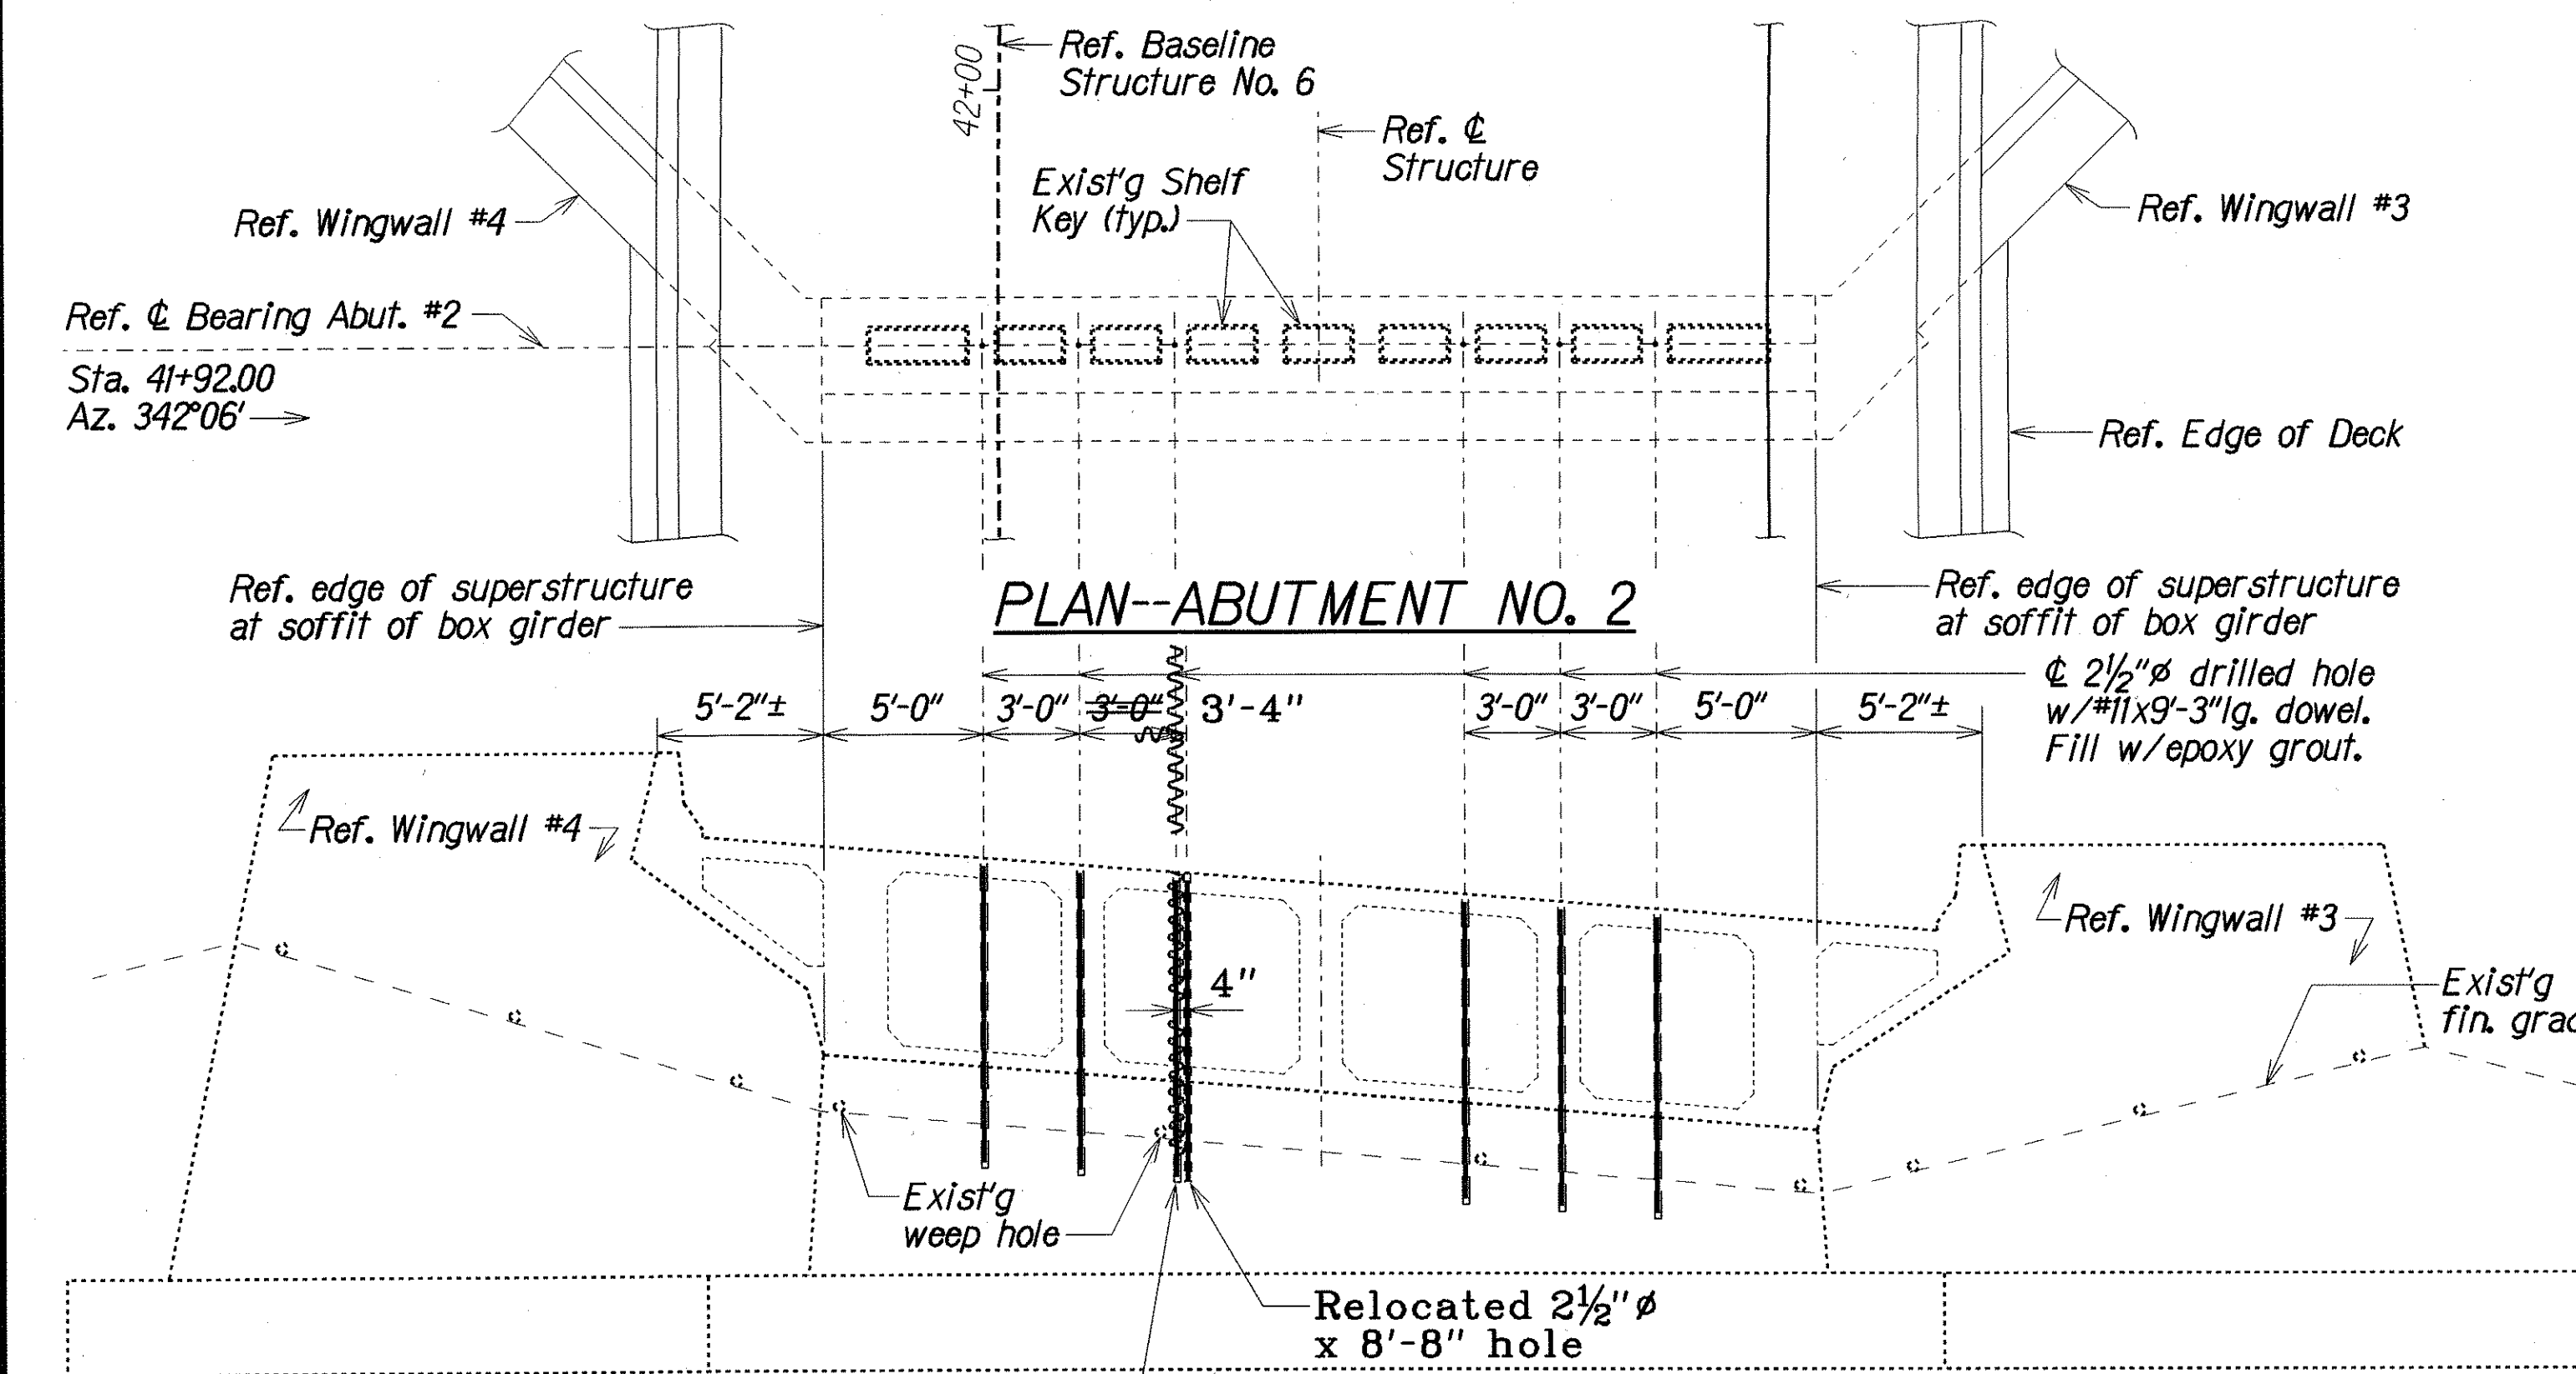

ELEVATION--ABUTMENT NO. 2

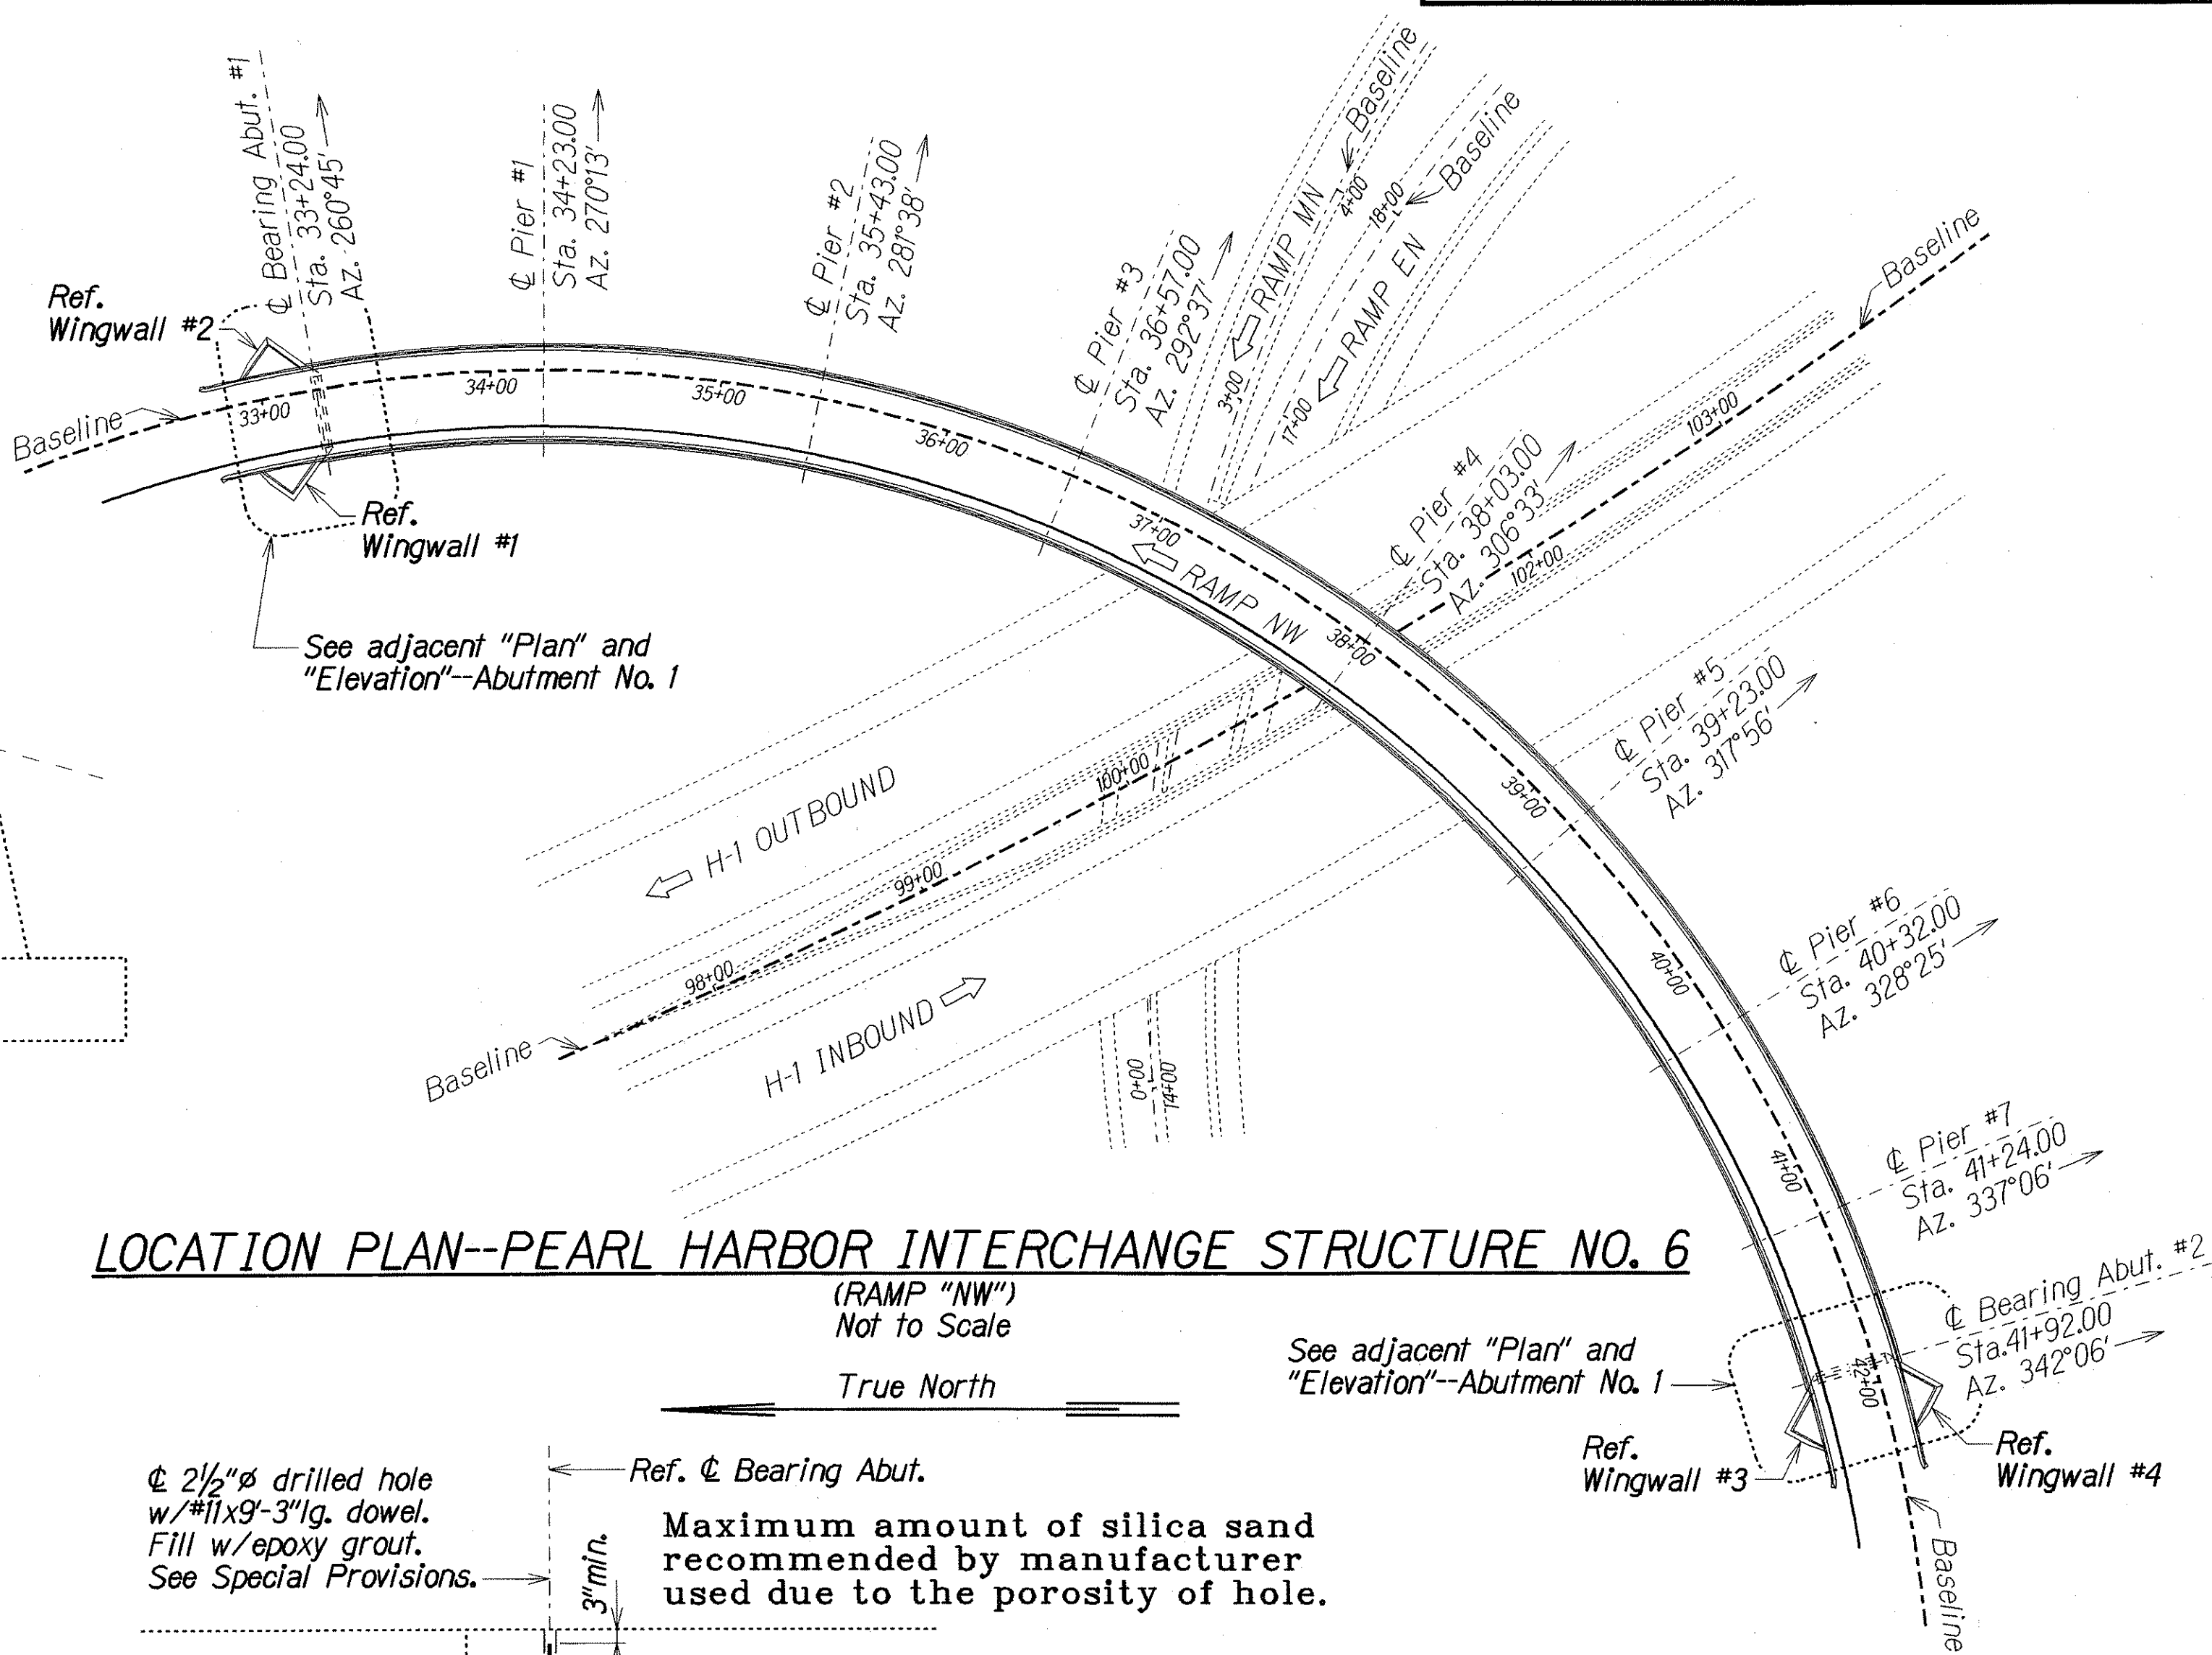

LOCATION PLAN--PEARL HARBOR INTERCHANGE STRUCTURE NO. 6

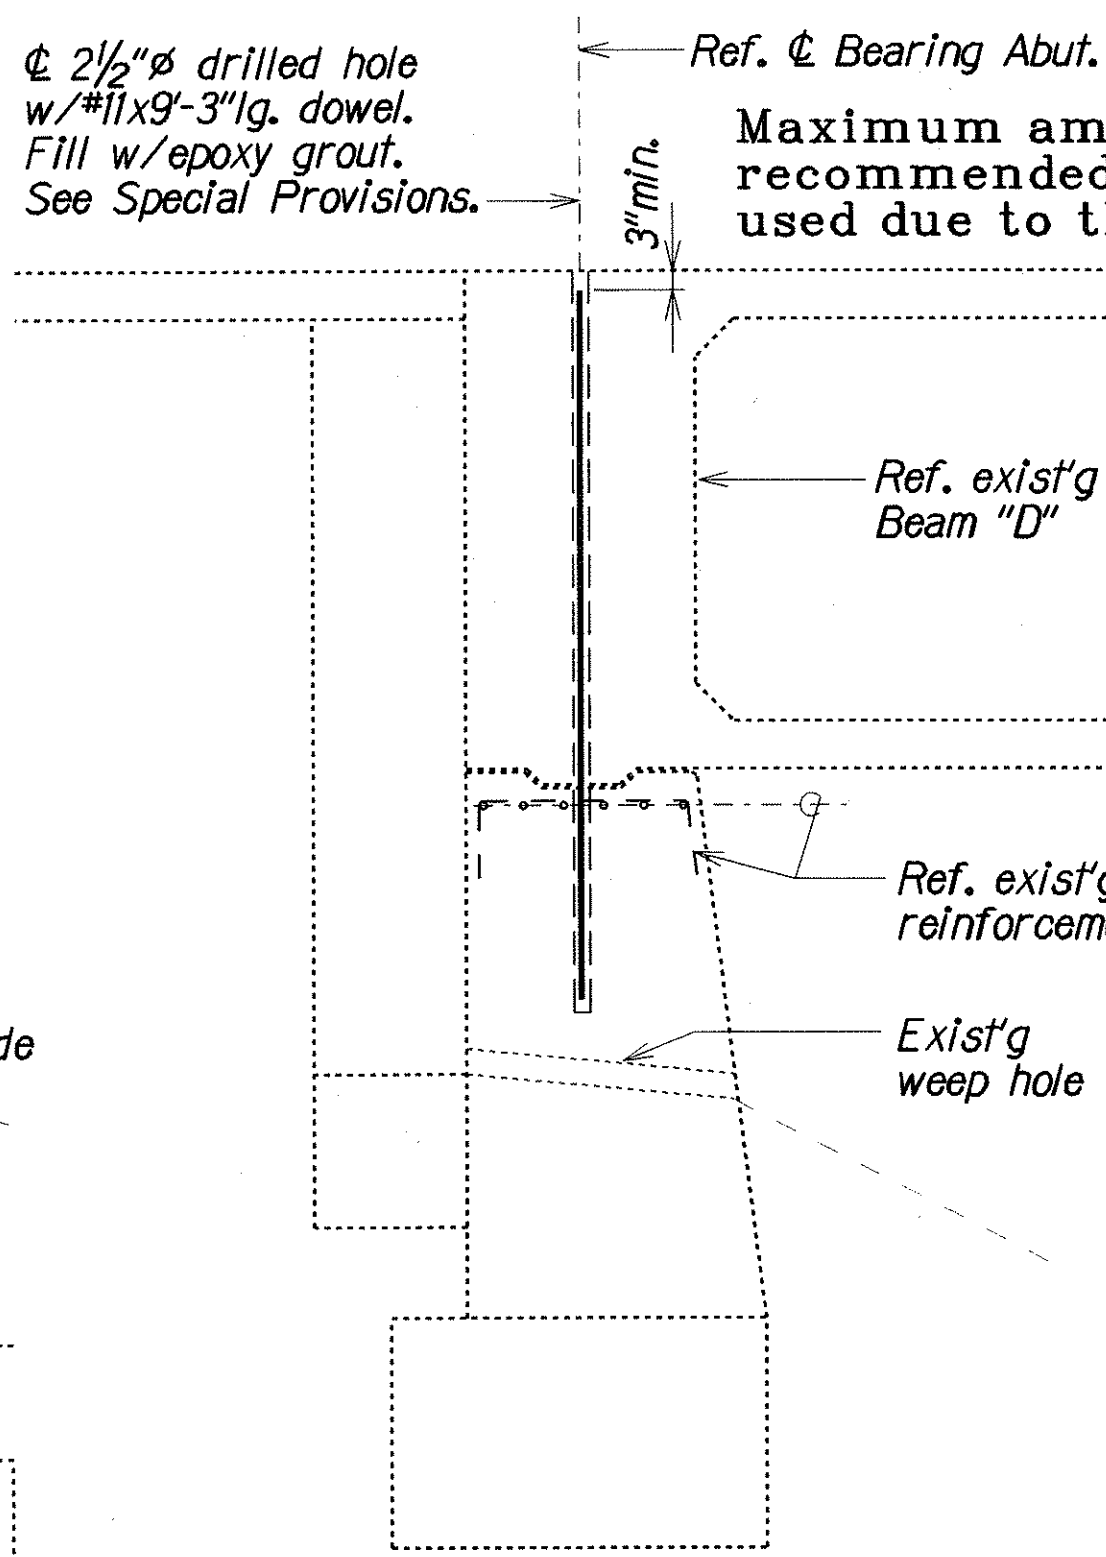

TYPICAL ABUTMENT SECTION

ESTIMATED QUANTITIES			
ITEM NO.	ITEM	QUANTITY	UNIT
653J000	Drilling Holes and Installing Reinforcing Bars	12	Ea.

LEGEND FOR AS-BUILT POSTINGS	
	Squiggly line for as-built deletion
	Double line for as-built deletion
Roadway	Text for as-built posting

STATE OF HAWAII
DEPARTMENT OF TRANSPORTATION
HIGHWAYS DIVISION

**LOCATION PLAN, ESTIMATED QUANTITIES
AND RETROFIT DETAILS**

INTERSTATE ROUTE H-1
SEISMIC RETROFIT FOR PEARL HARBOR I.C. STRUCTURE NO. 6
AND HALAWA I.C. STRUCTURE NO. 2
Project No. BR-0300(42)

Scale: As Noted Date: Apr. 1997