



FED. ROAD DIST. NO.	STATE	PROJ. NO.	FISCAL YEAR	SHEET NO.	TOTAL SHEETS
HAWAII	HAW.	HIEFG-01-96	1998	164	344

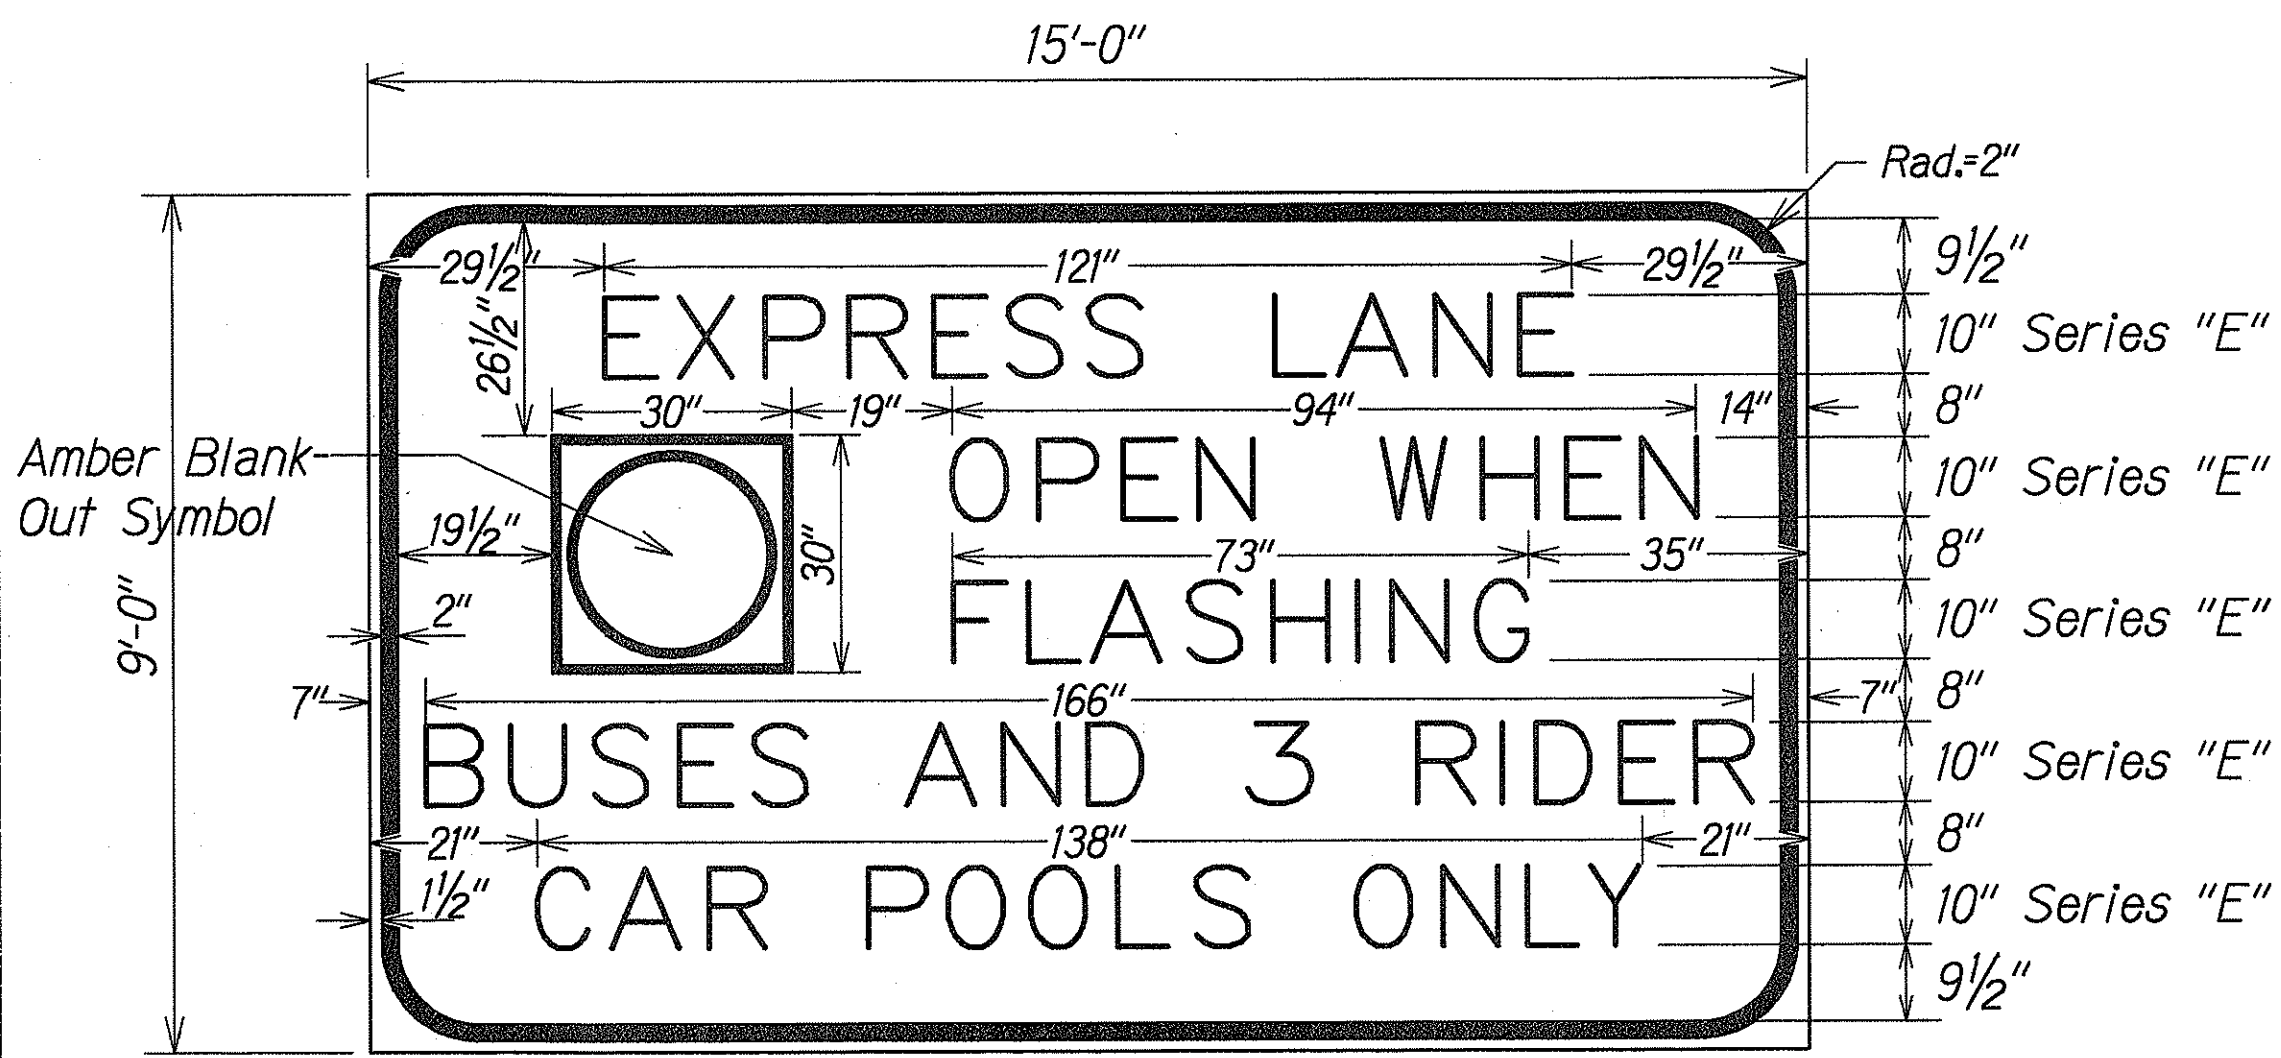


Colors
 Legend: Black (Non-Ref.)
 Background: White (Ref.)
 Border: Black


DS-1

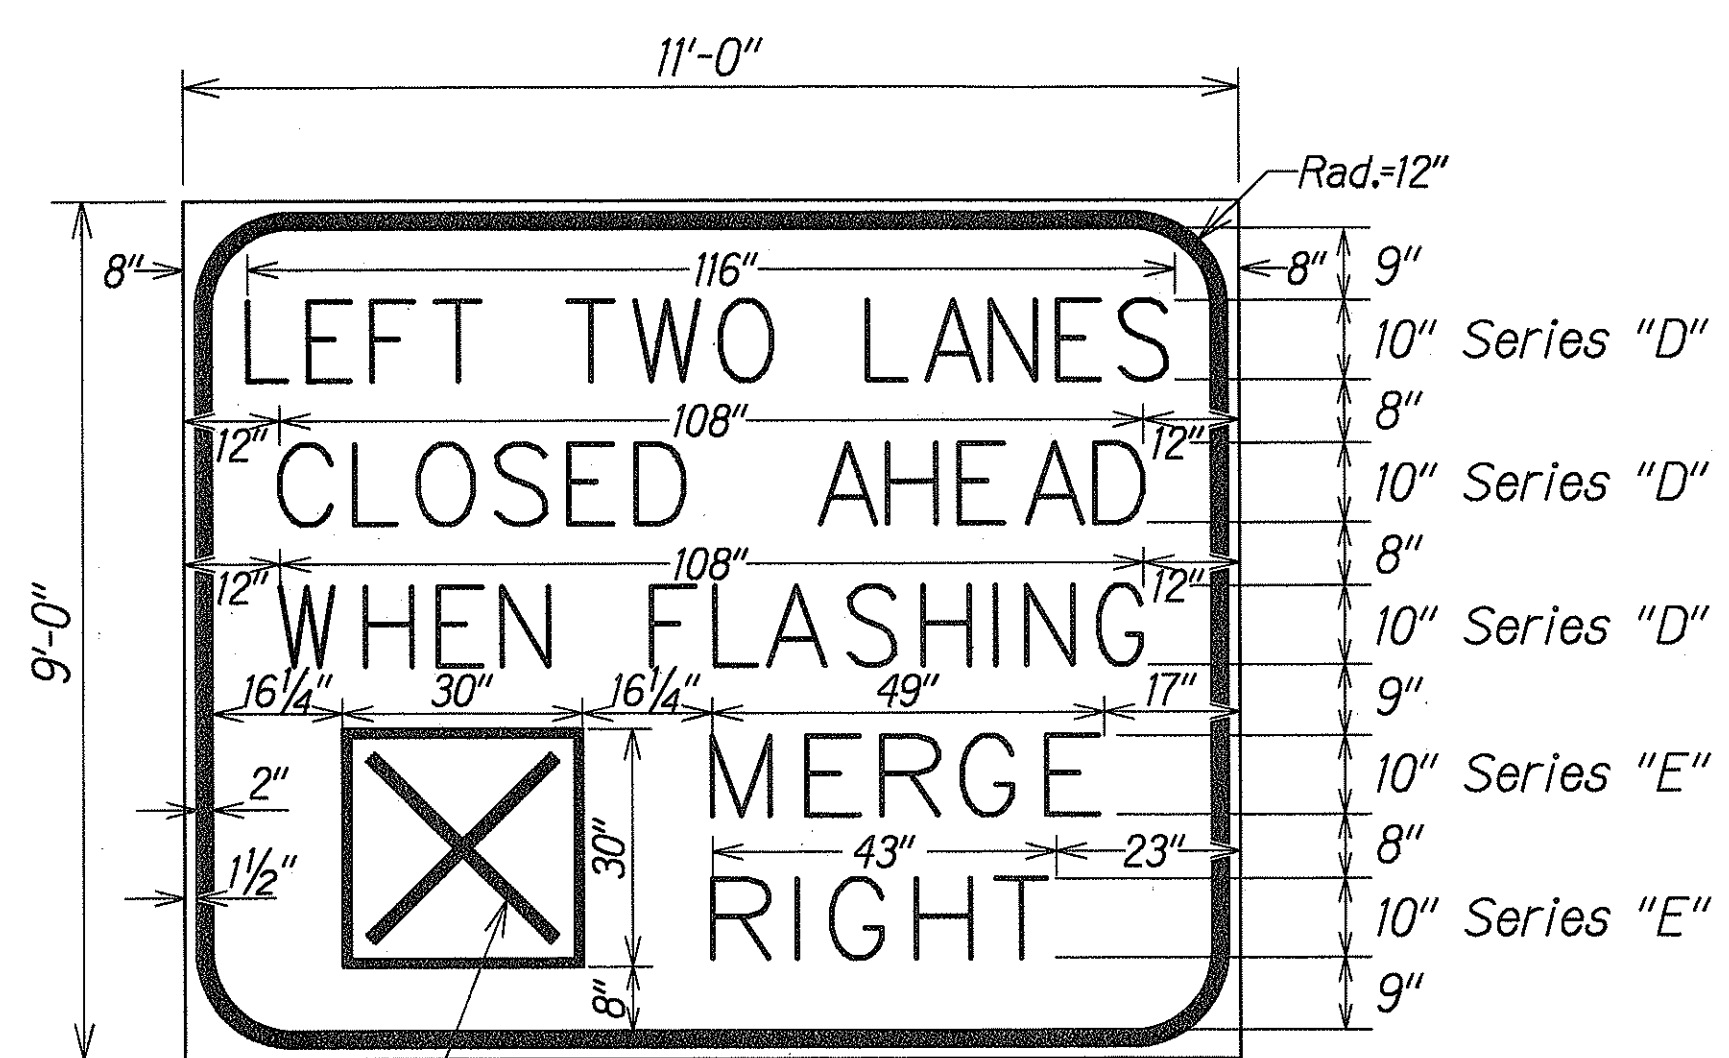


Red Blank-Out Symbol
WS-1

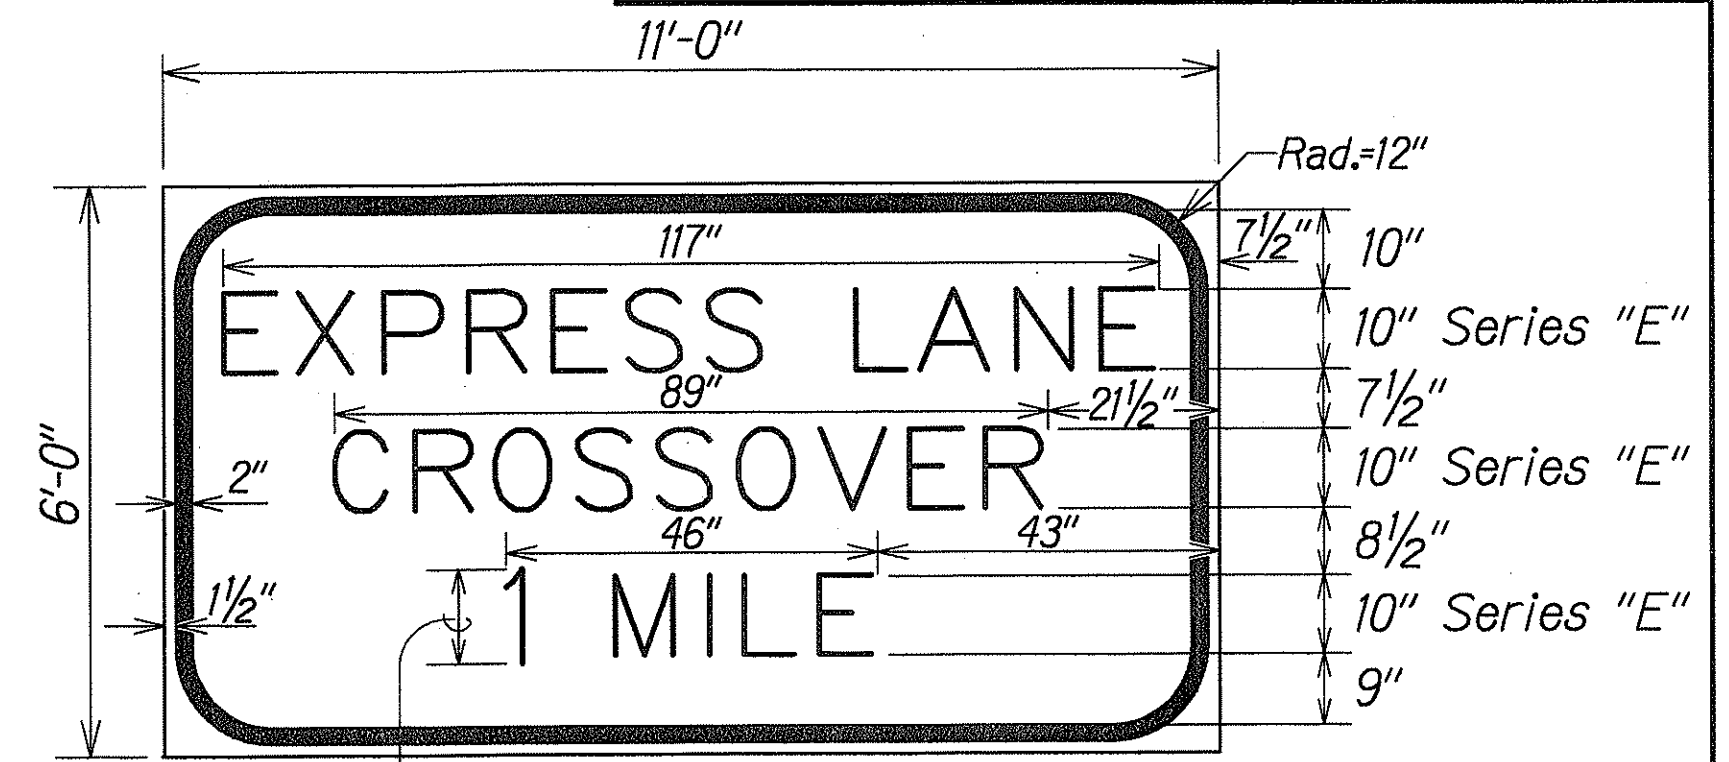


Series "E" **WS-4**
 Colors
 Legend: Black (Non-Ref.)
 Background: Yellow (Ref.)
 Border: Black

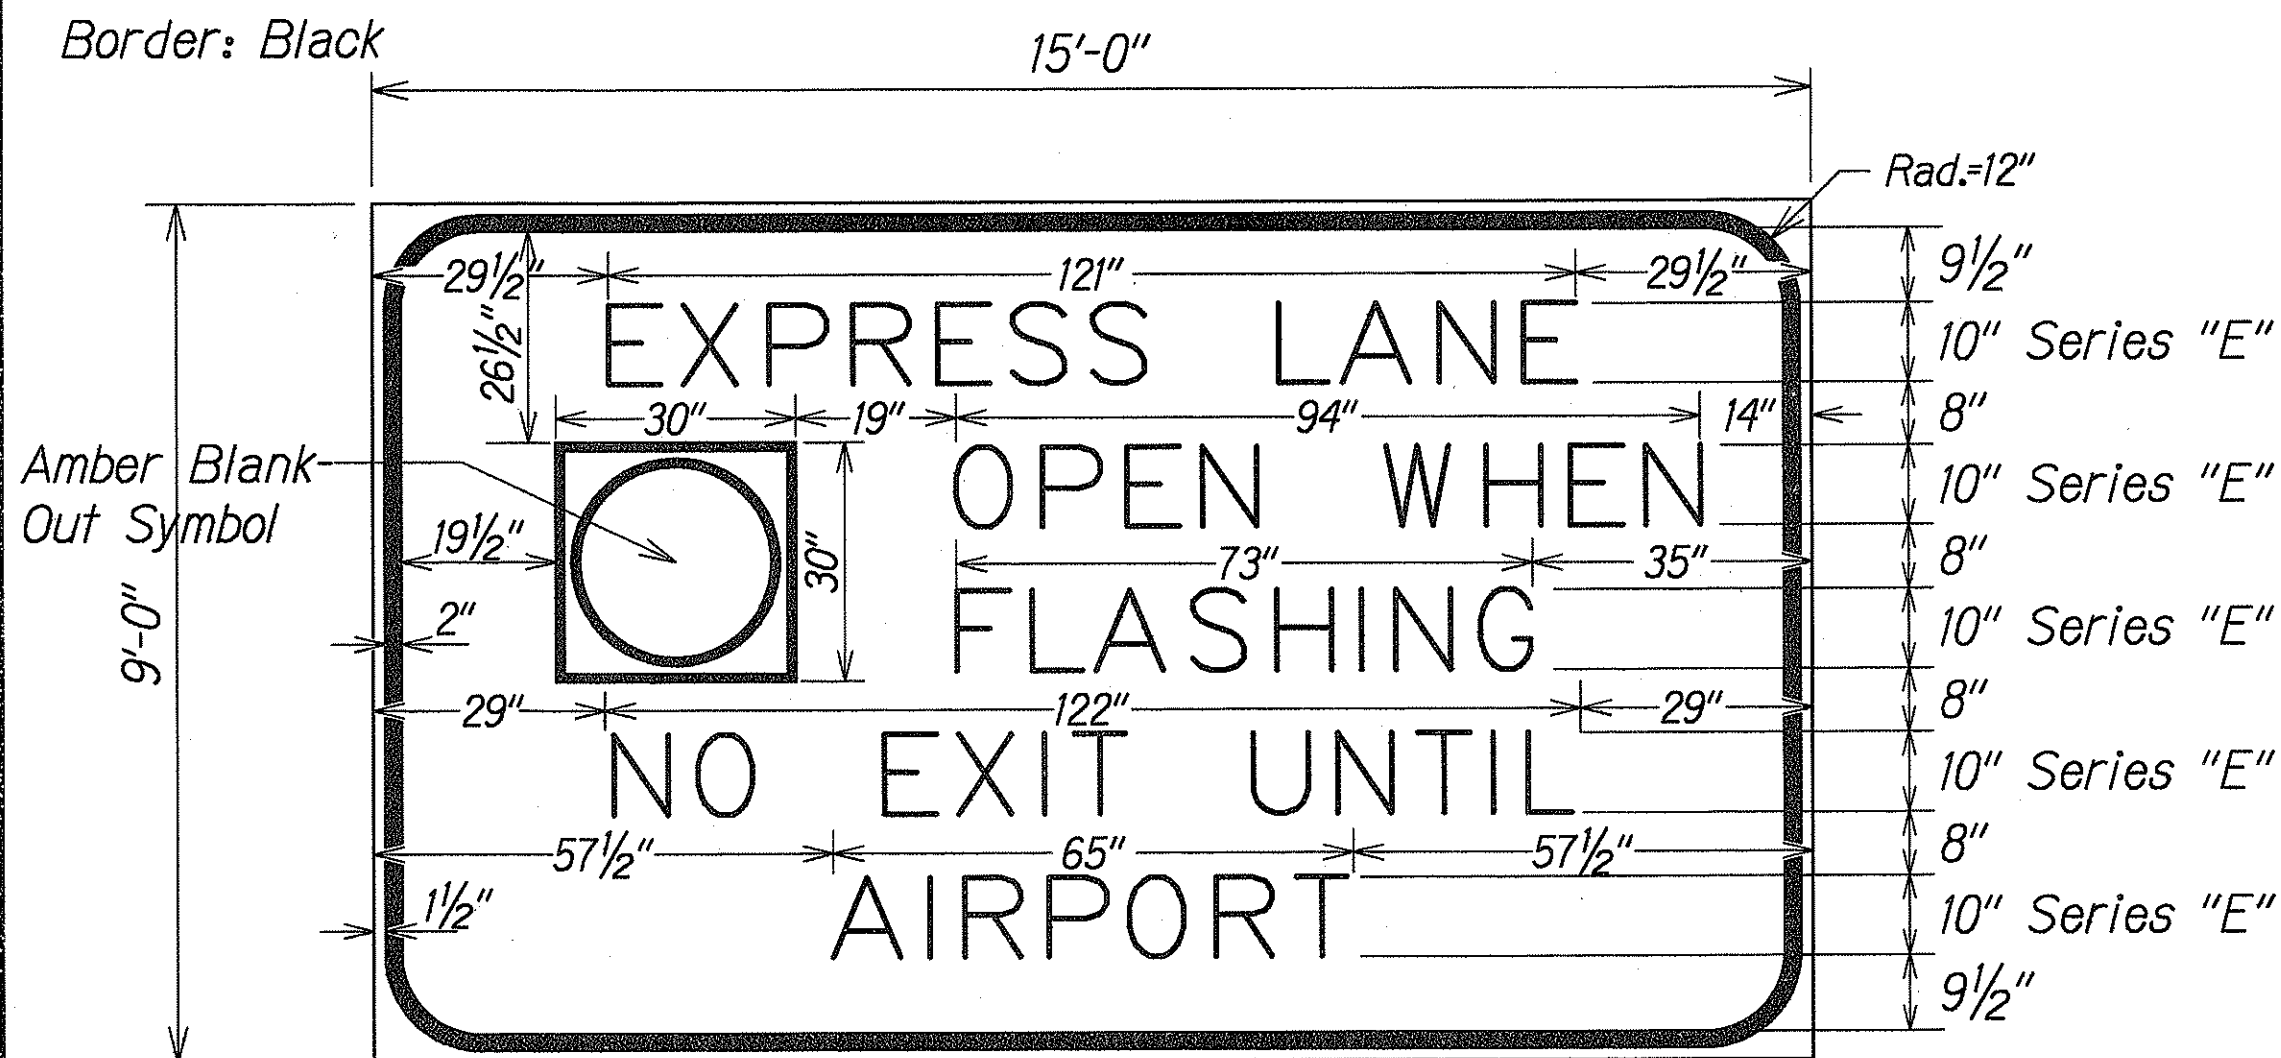


DS-2

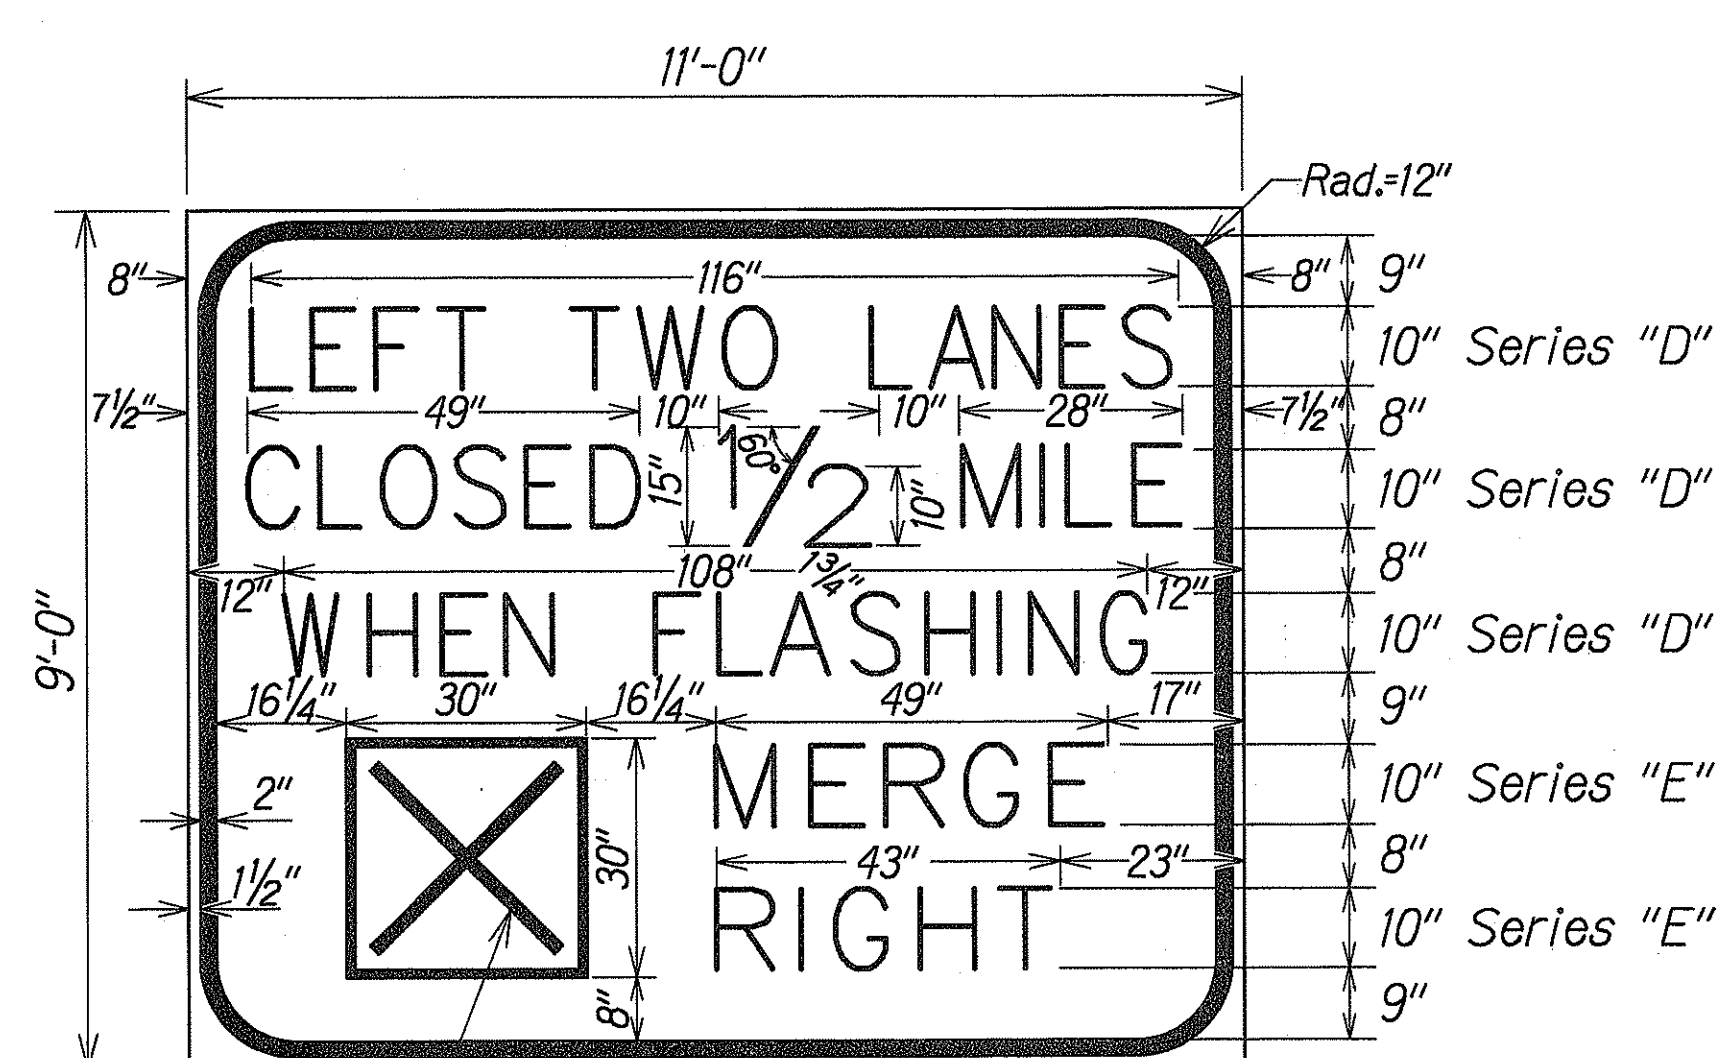

Red Blank-Out Symbol
WS-2
 Colors
 Legend: Black (Non-Ref.)
 Background: Yellow (Ref.)
 Border: Black

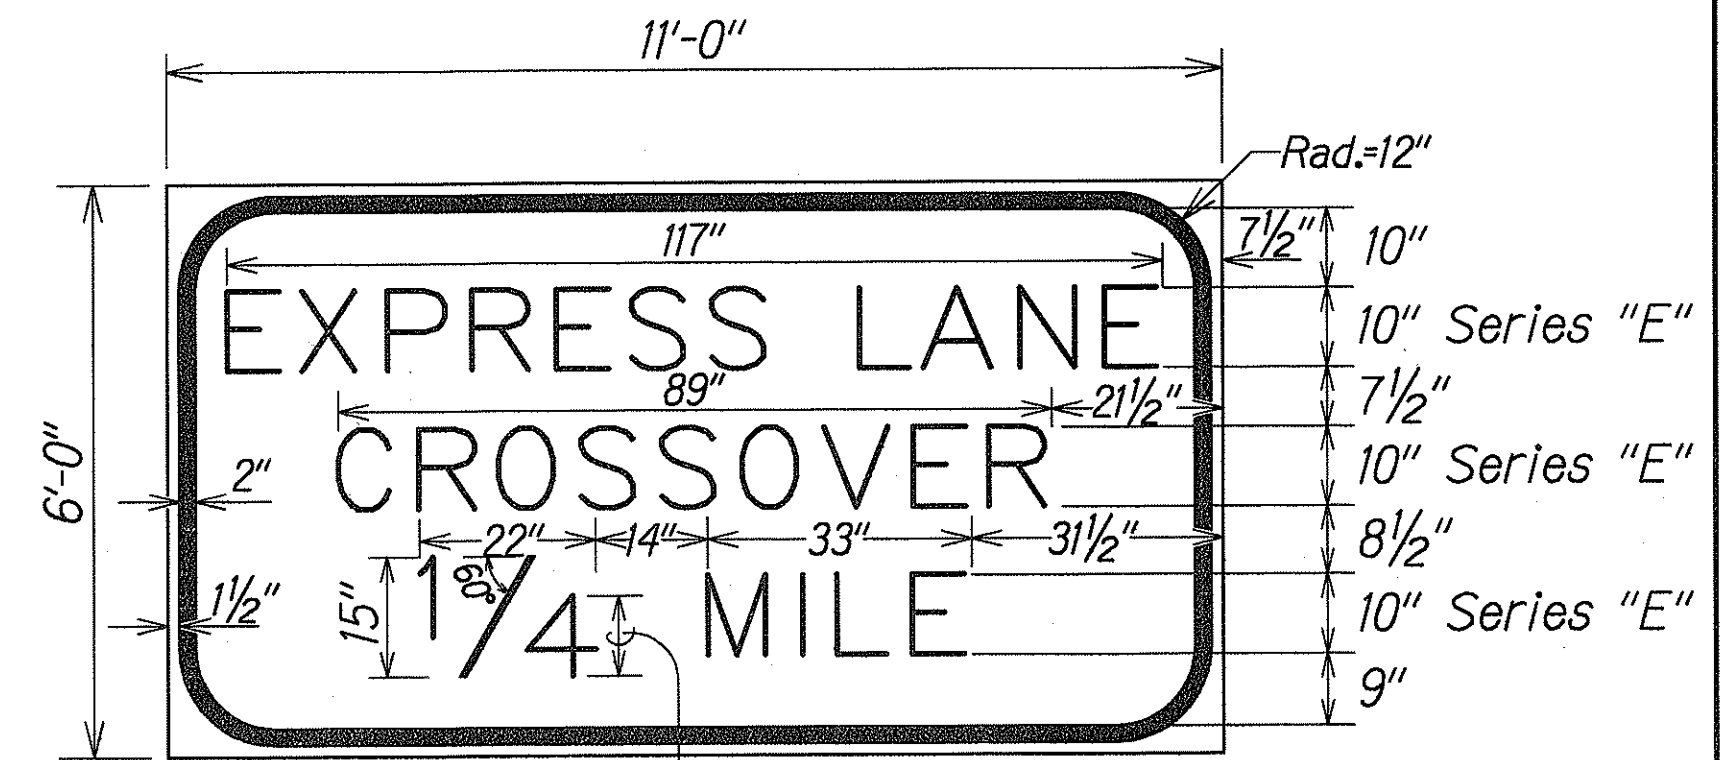


WS-5


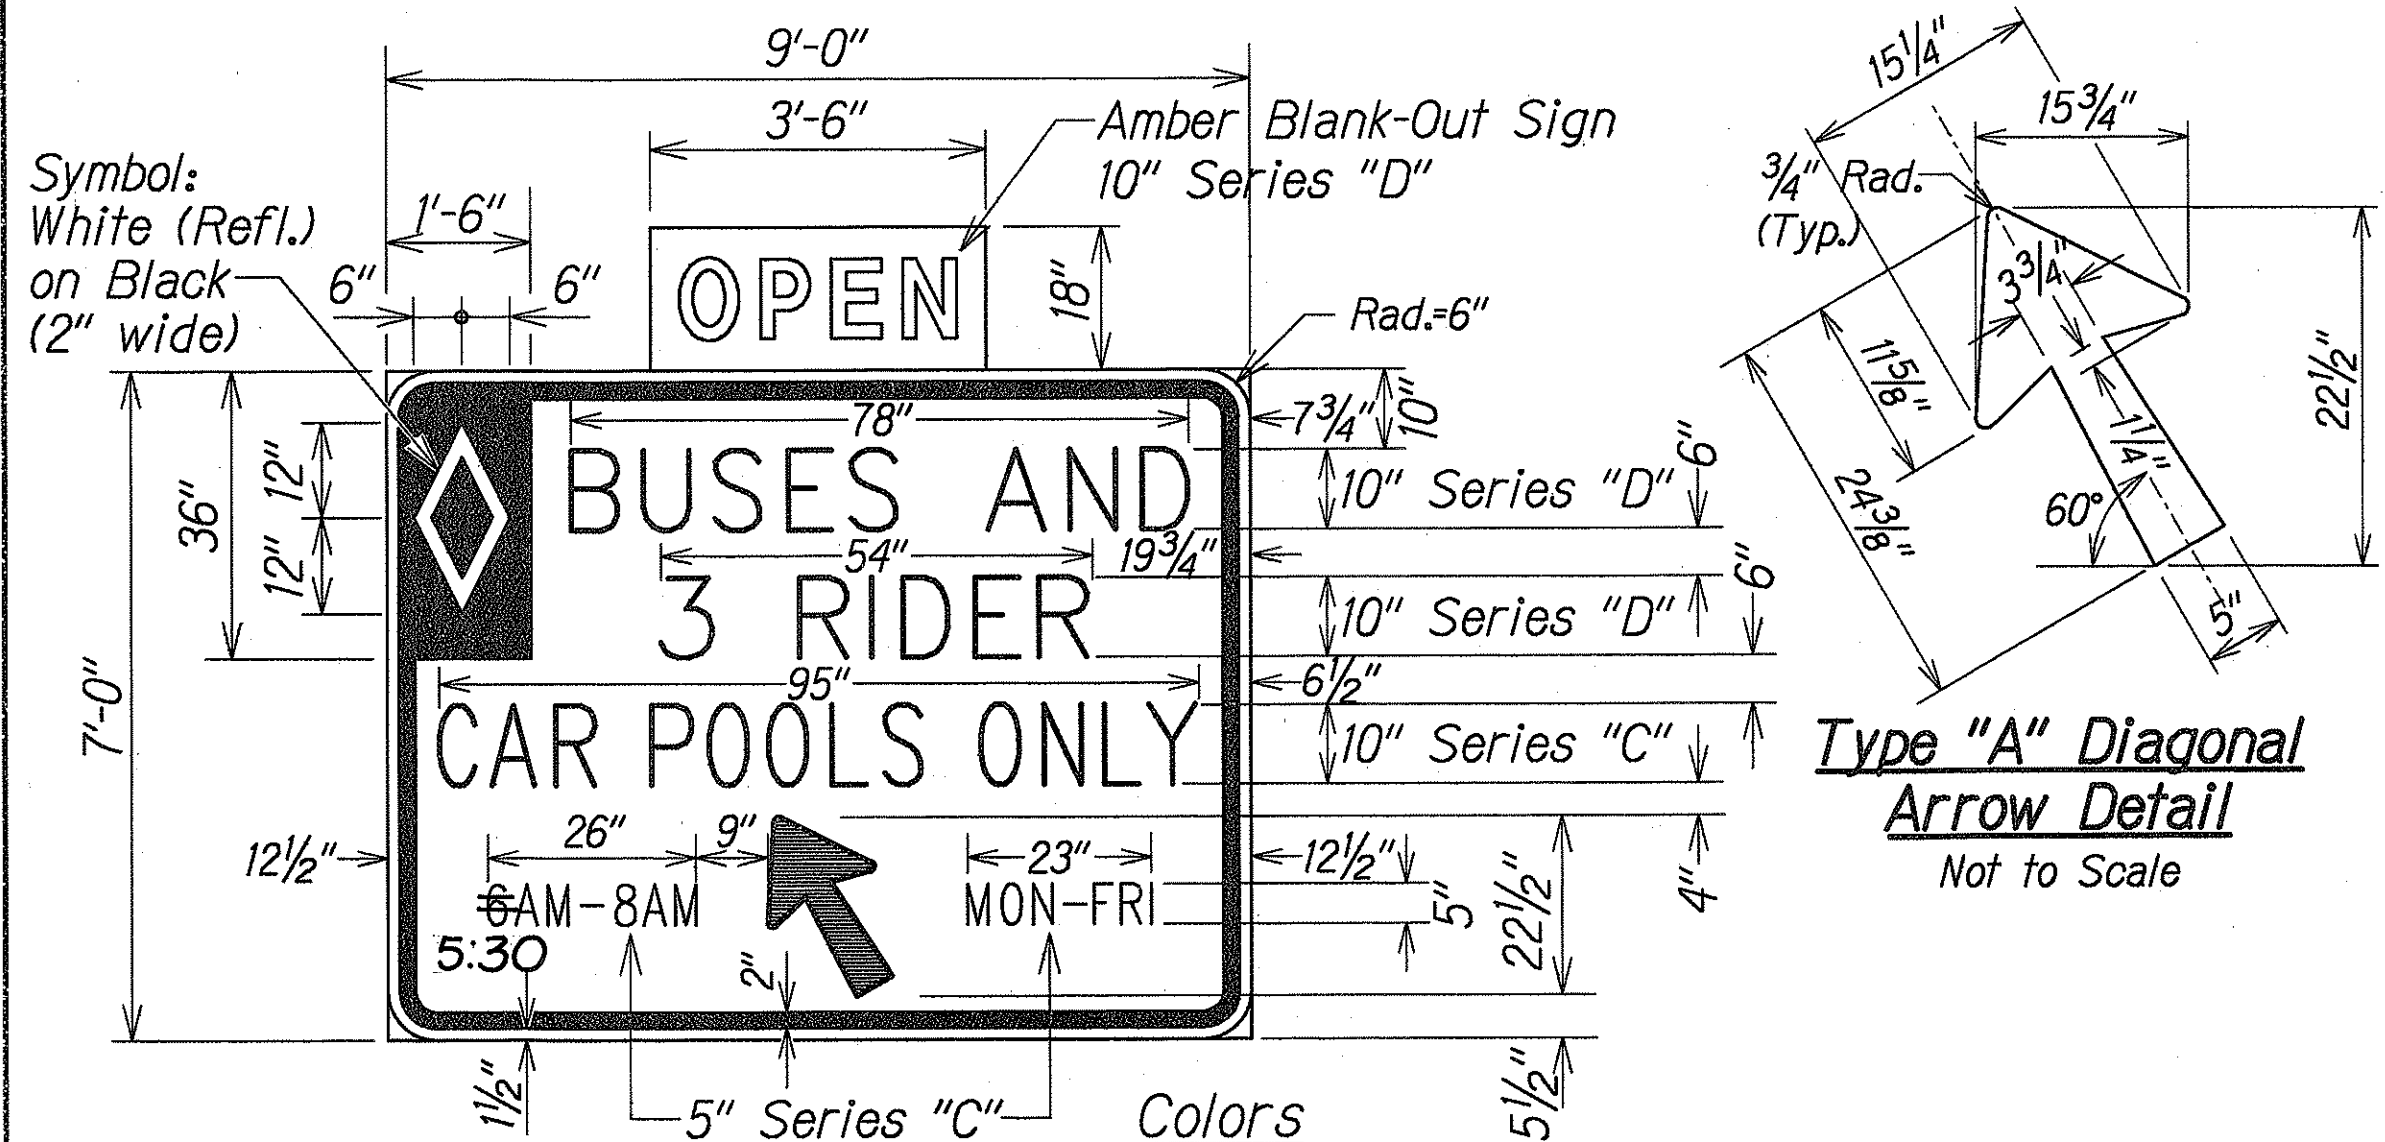


Colors
 Legend: Black (Non-Ref.)
 Background: White (Ref.)
 Border: Black

R-7

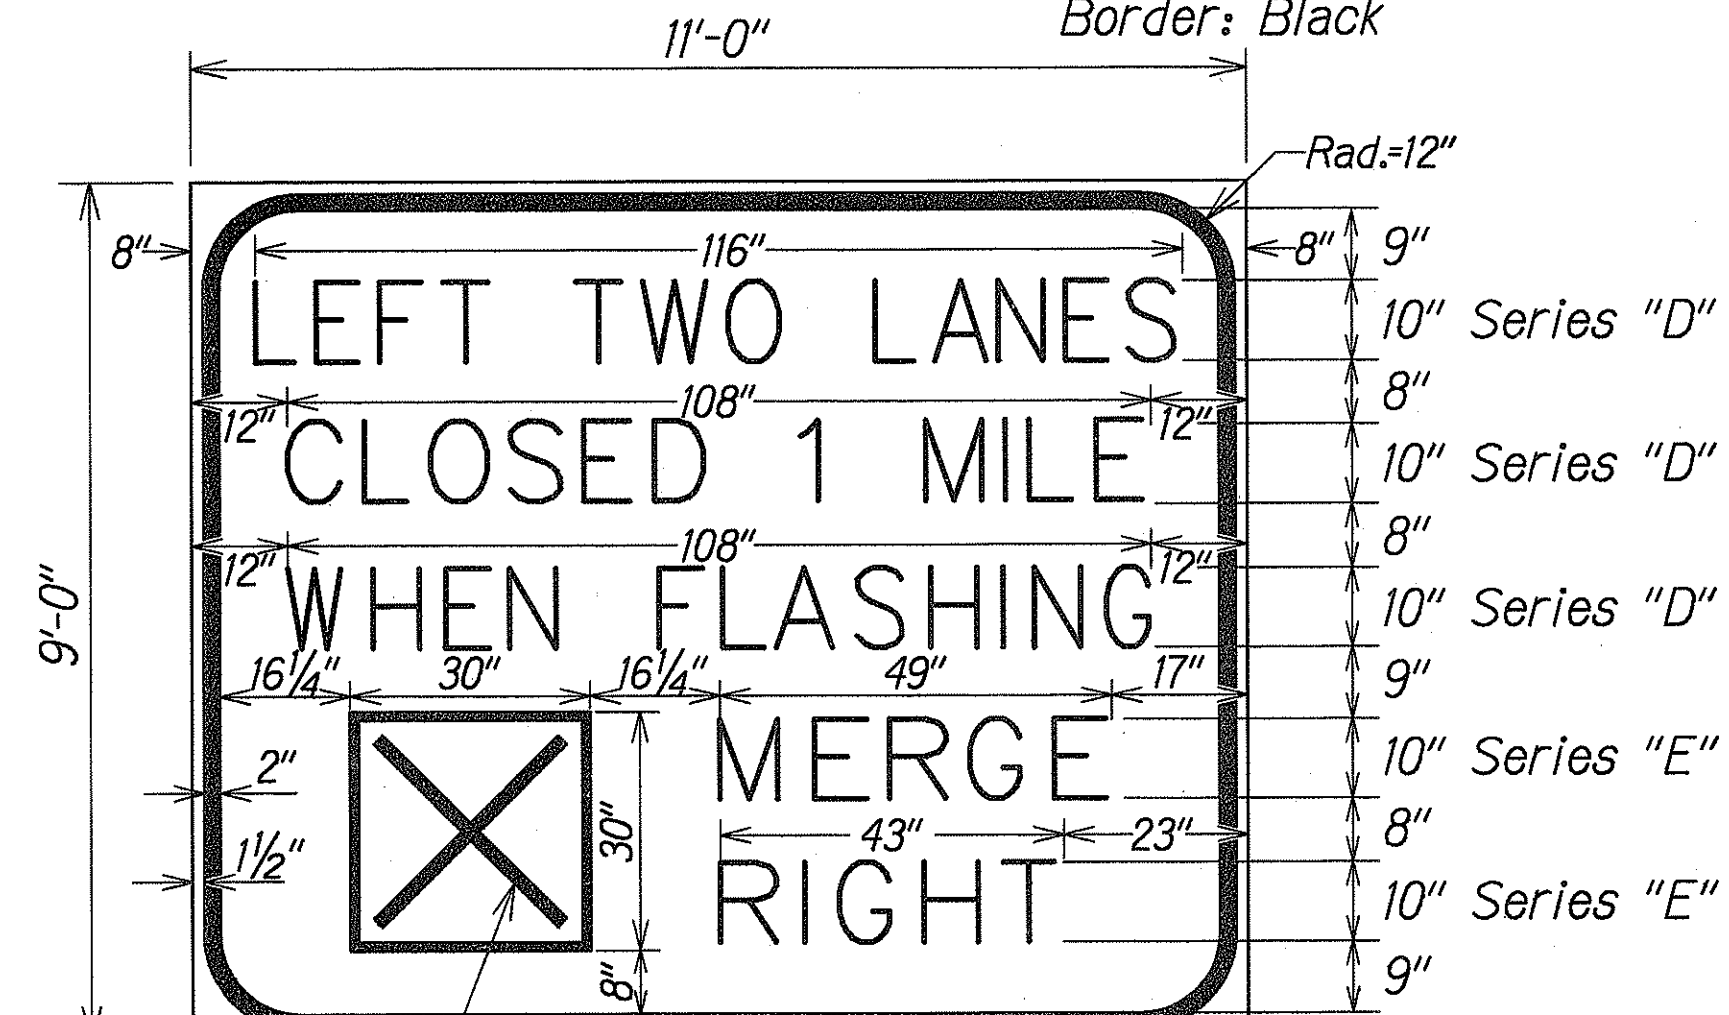

Red Blank-Out Symbol
WS-3

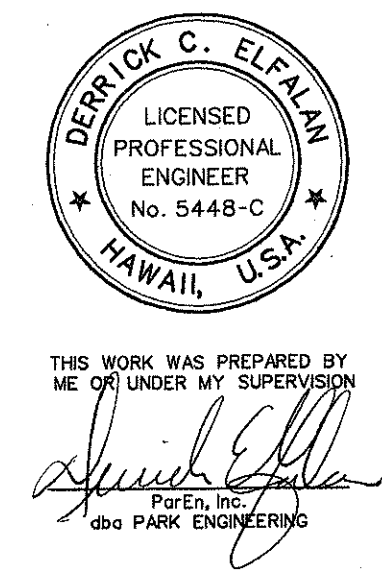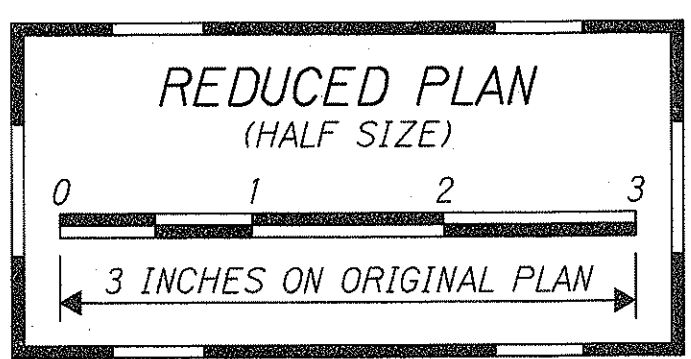

STATE OF HAWAII
 DEPARTMENT OF TRANSPORTATION
 HIGHWAYS DIVISION

PANEL LAYOUT DETAILS


INTERSTATE ROUTE H-1
 CONTRAFLOW AND SHOULDER LANE
 Waiawa Interchange to Keolu Interchange
 PROJECT NO. HIEFG-01-96

Scale: 1/2" = 1'-0" Date: October, 1997

SHEET No. **W2** OF **4** SHEETS


SURVEY PLOTTED BY	DATE
DRAWN BY	
CHECKED BY	
NOTED BY	
QUANTITIES BY	
CHECKED BY	

FED. ROAD DIST. NO.	STATE	PROJ. NO.	FISCAL YEAR	SHEET NO.	TOTAL SHEETS
HAWAII	HAW.	HIEFG-01-96	1998	ADD. 165	344

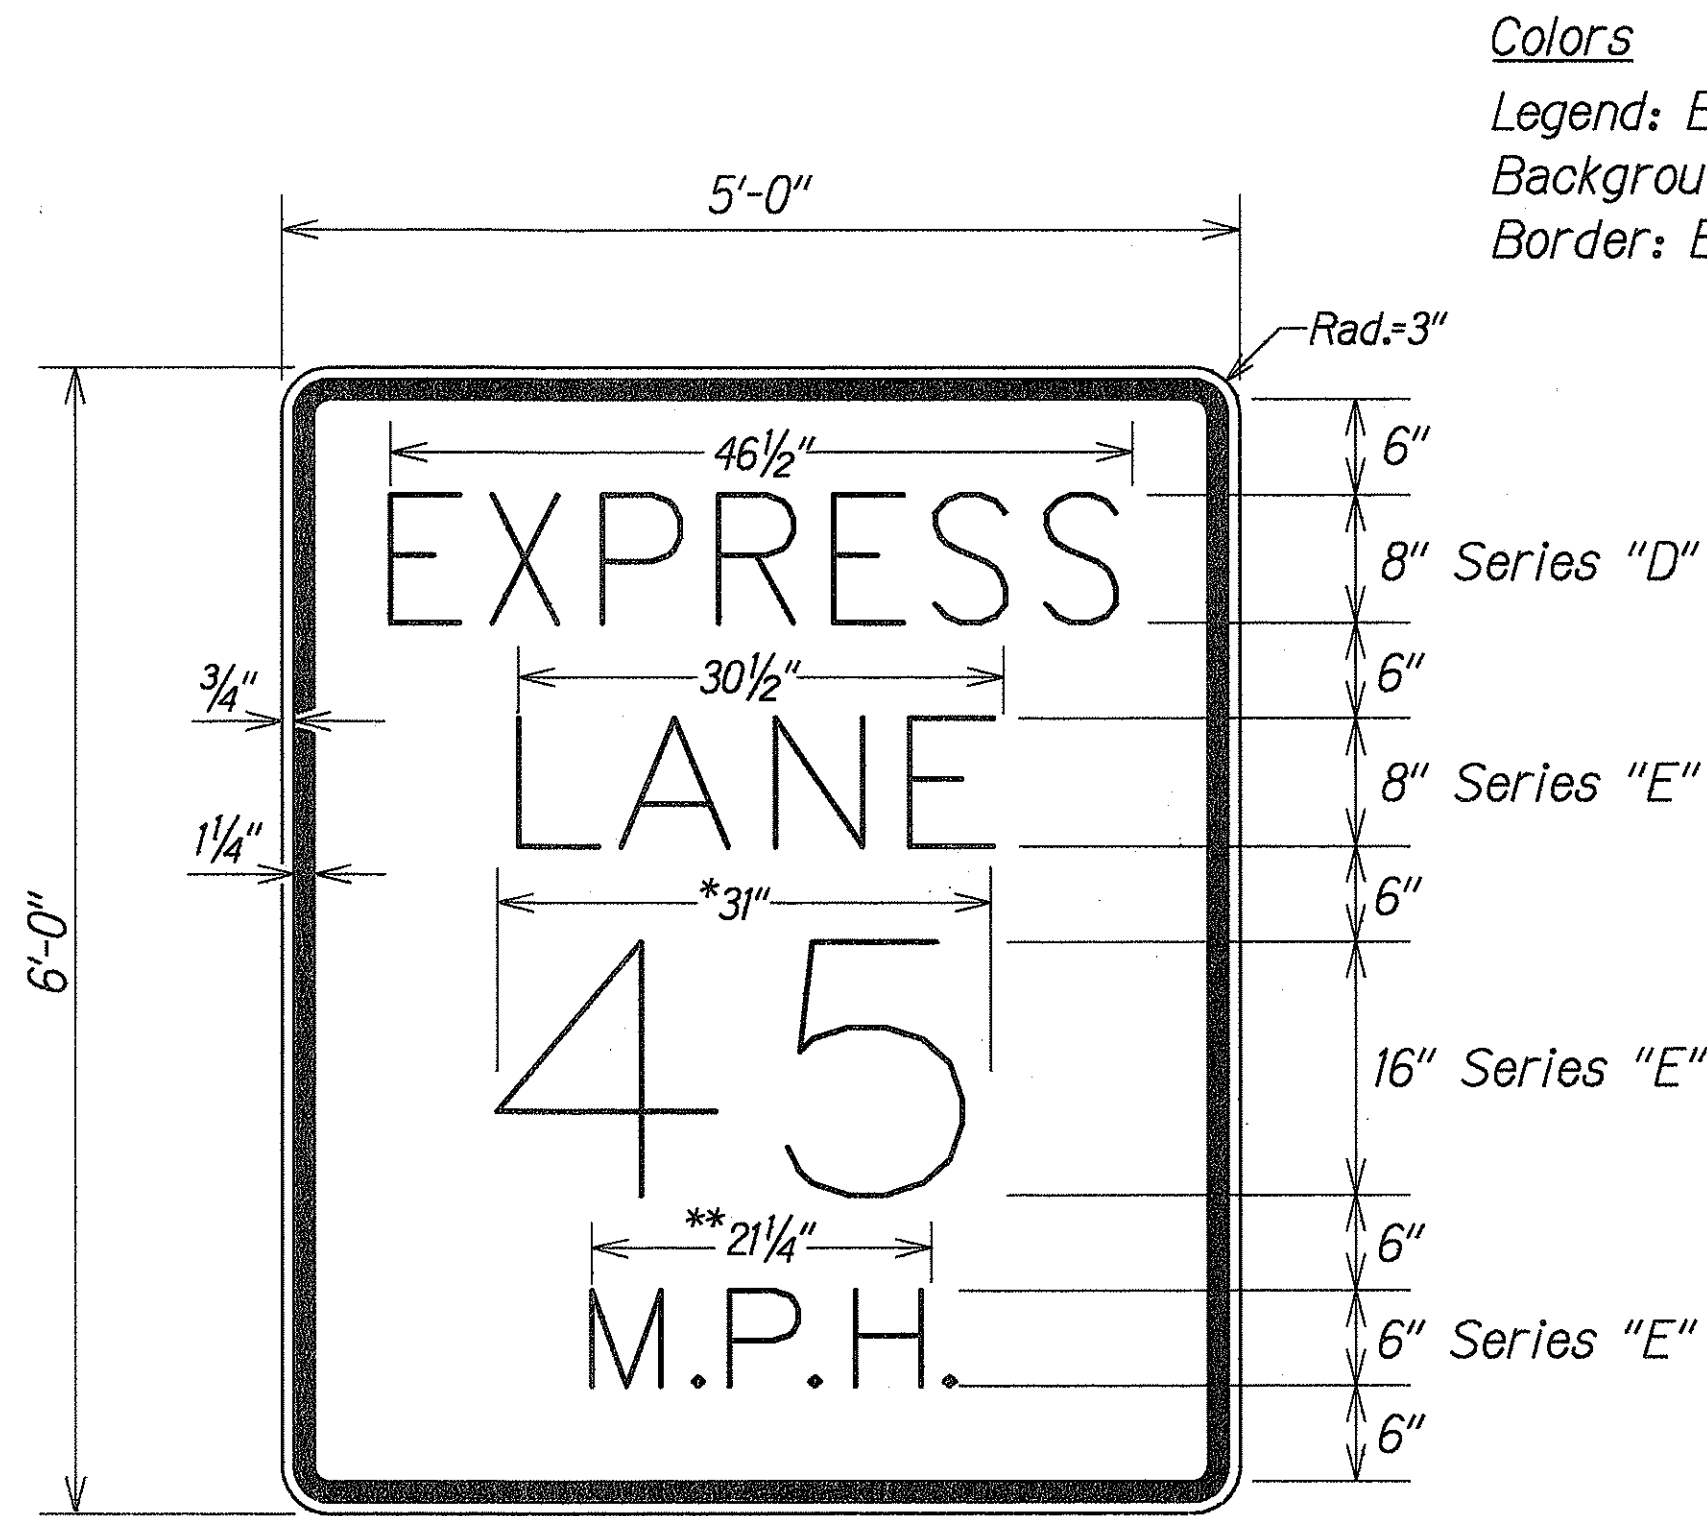


R-8


Colors
Legend: Black (Non-Ref.)
Background: White (Ref.)
Border: Black

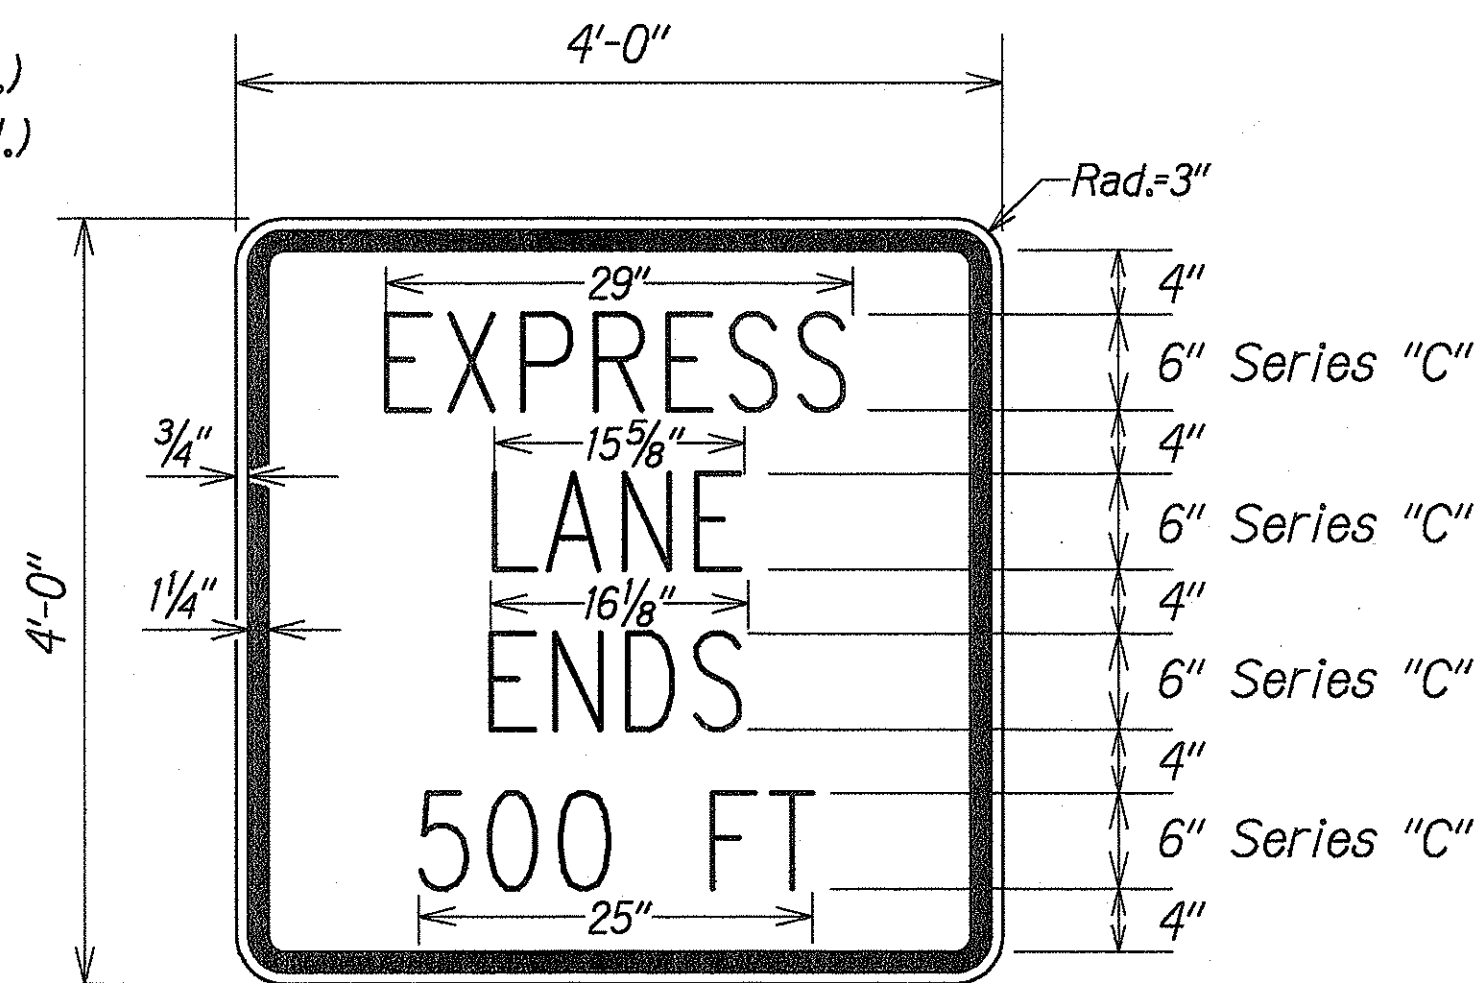

R-9

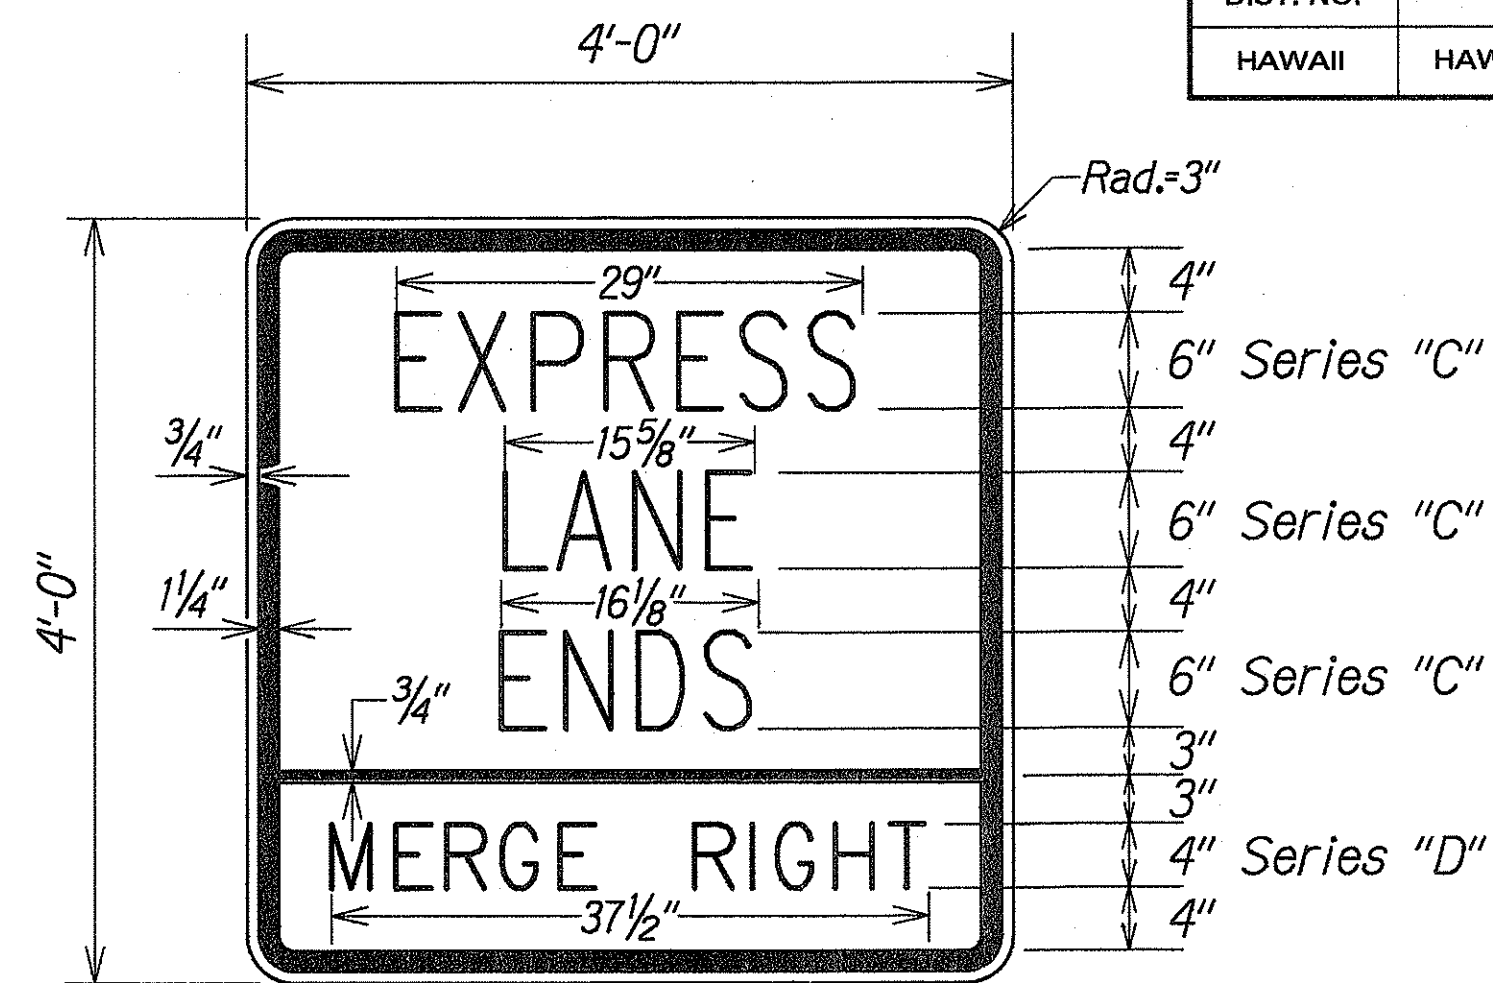


R-10

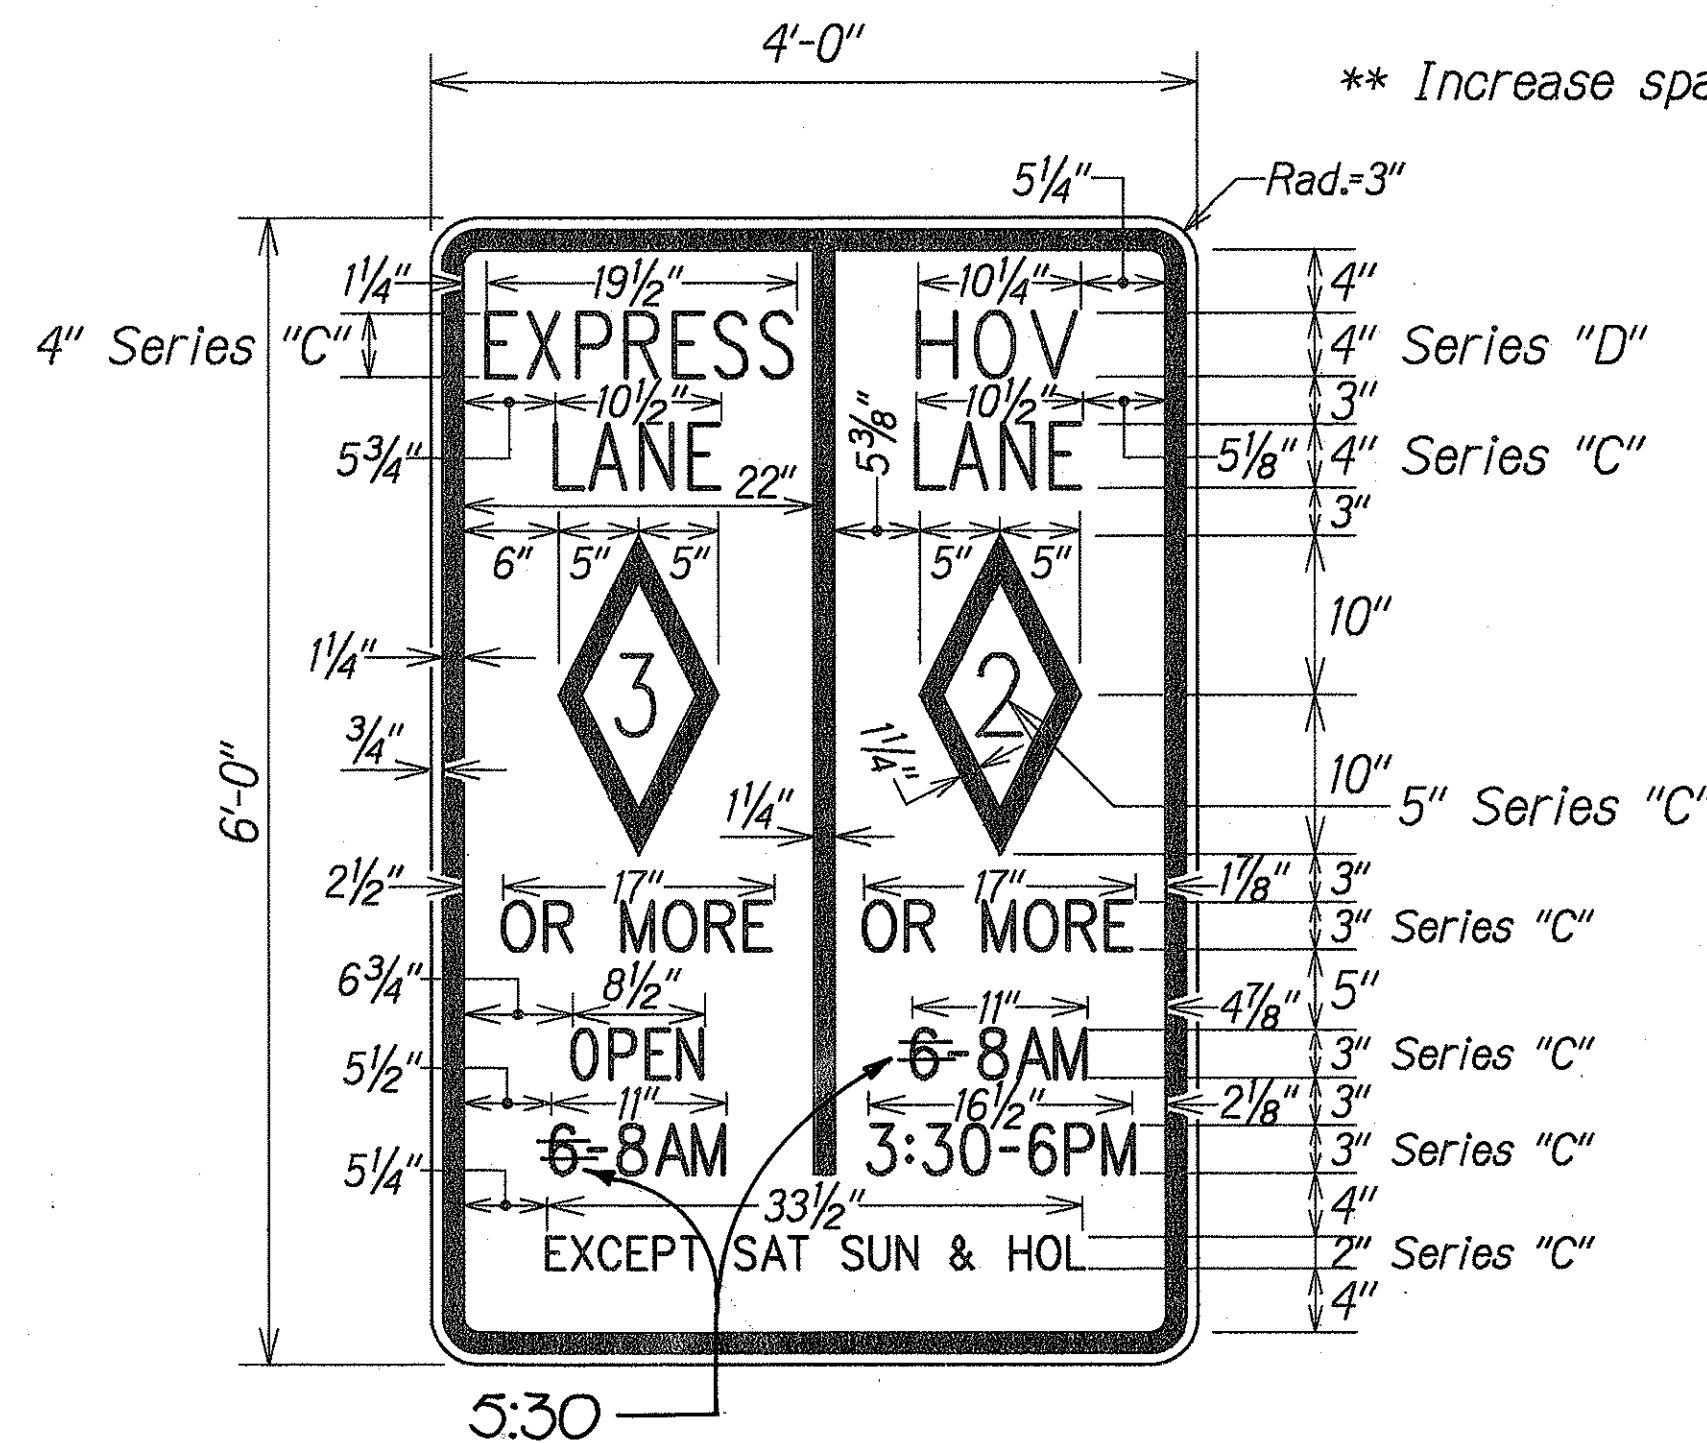


R-11

Colors
Legend: Black (Non-Ref.)
Background: White (Ref.)
Border: Black


Note:
* Optically space numerals about vertical centerline.
** Increase spacing 100%.

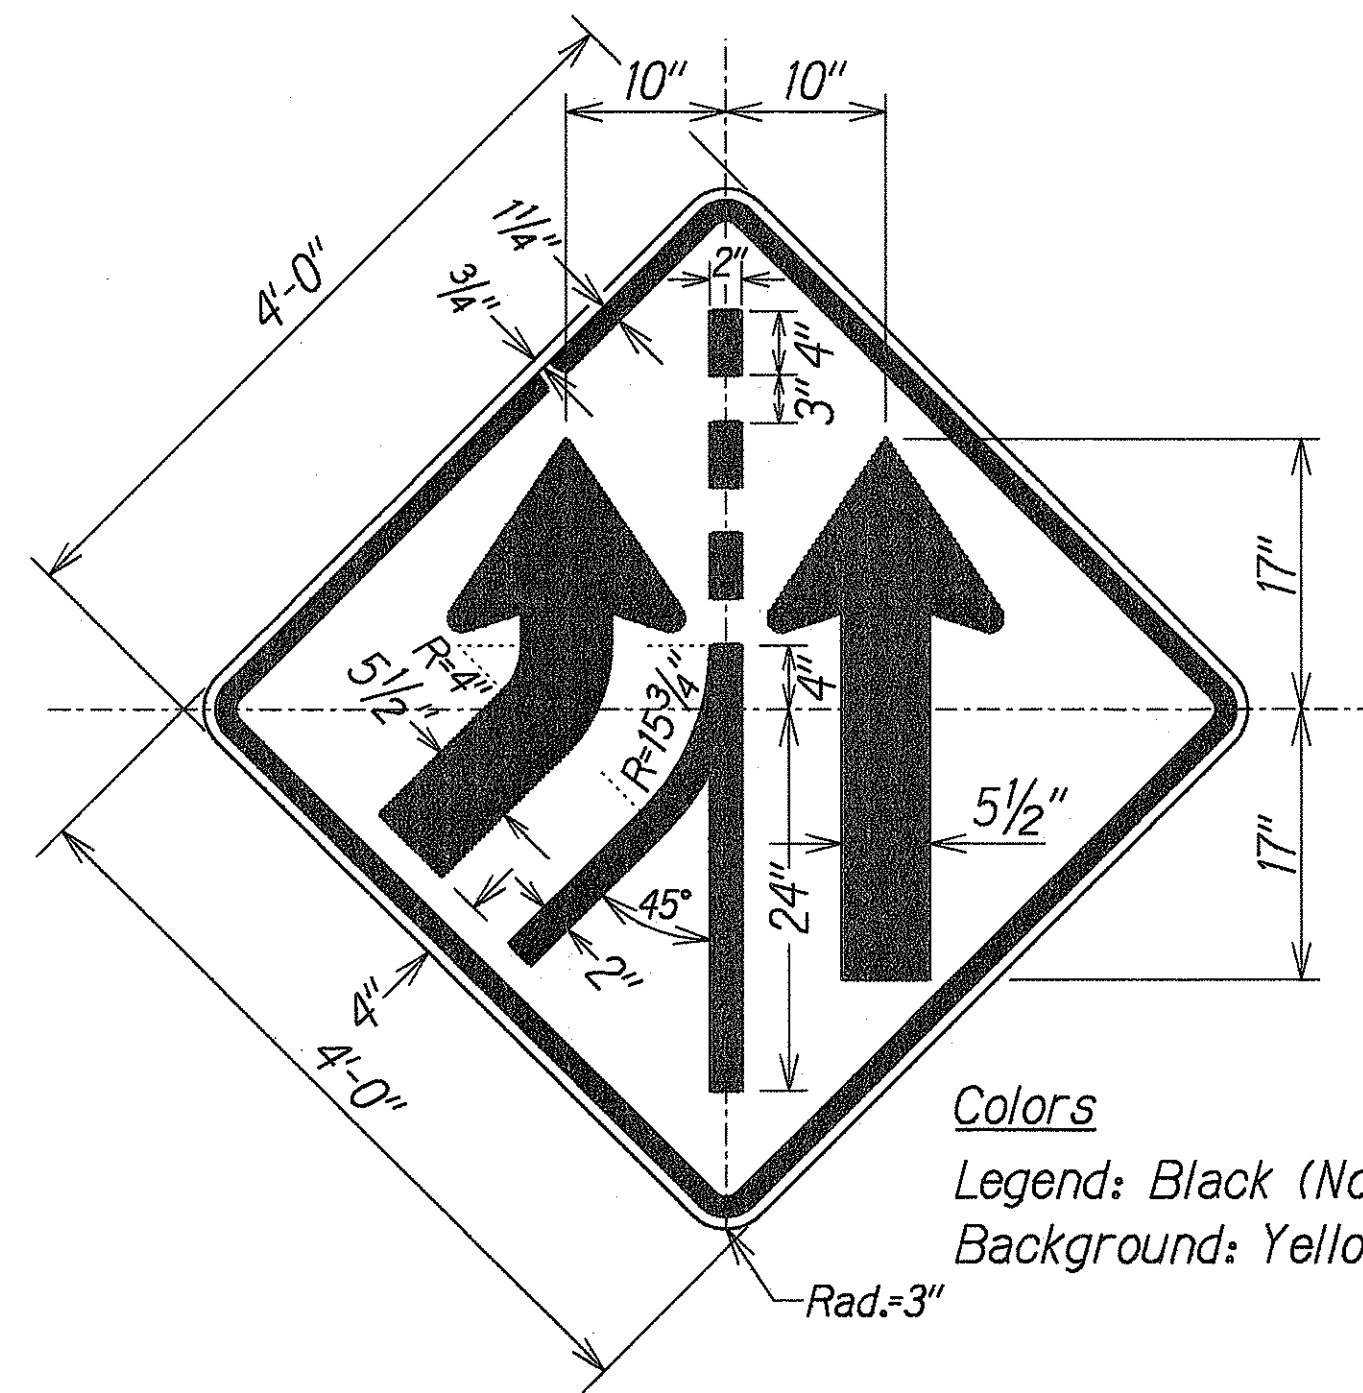

Colors
Legend: Black (Non-Ref.)
Background: Yellow (Ref.)

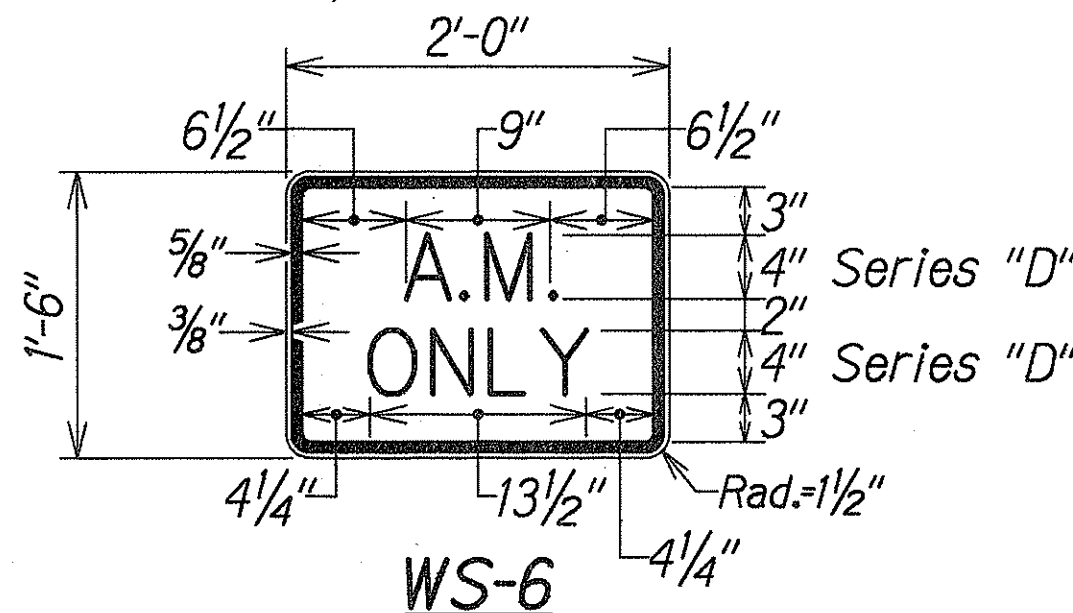

WS-6

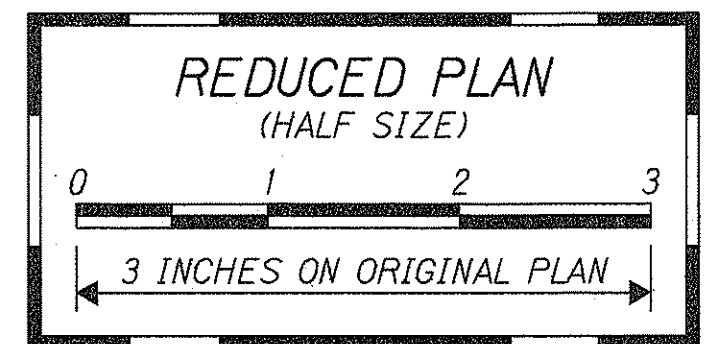

THIS WORK WAS PREPARED BY ME OR UNDER MY SUPERVISION
[Signature]
Derrick C. Elfaian
Professional Engineer
No. 5448-C
HAWAII, U.S.A.

STATE OF HAWAII
DEPARTMENT OF TRANSPORTATION
HIGHWAYS DIVISION

PANEL LAYOUT DETAILS

INTERSTATE ROUTE H-1
CONTRAFLOW AND SHOULDER LANE
Waiawa Interchange to Keolu Interchange
PROJECT NO. HIEFG-01-96

Scale: 1" = 1'-0" Date: October, 1997

SHEET No. W3 OF 4 SHEETS


11/17/97	Deleted Sign R-12
DATE	REVISION

"AS-BUILT"


ADD. 165

SURVEY PLOTTED BY	DATE
DRAWN BY	
CHECKED BY	
NOTE BOOK	
QUANTITIES BY	
CHECKED BY	


FED. ROAD DIST. NO.	STATE	PROJ. NO.	FISCAL YEAR	SHEET NO.	TOTAL SHEETS
HAWAII	HAW.	HIEFG-01-96	1998	166	344

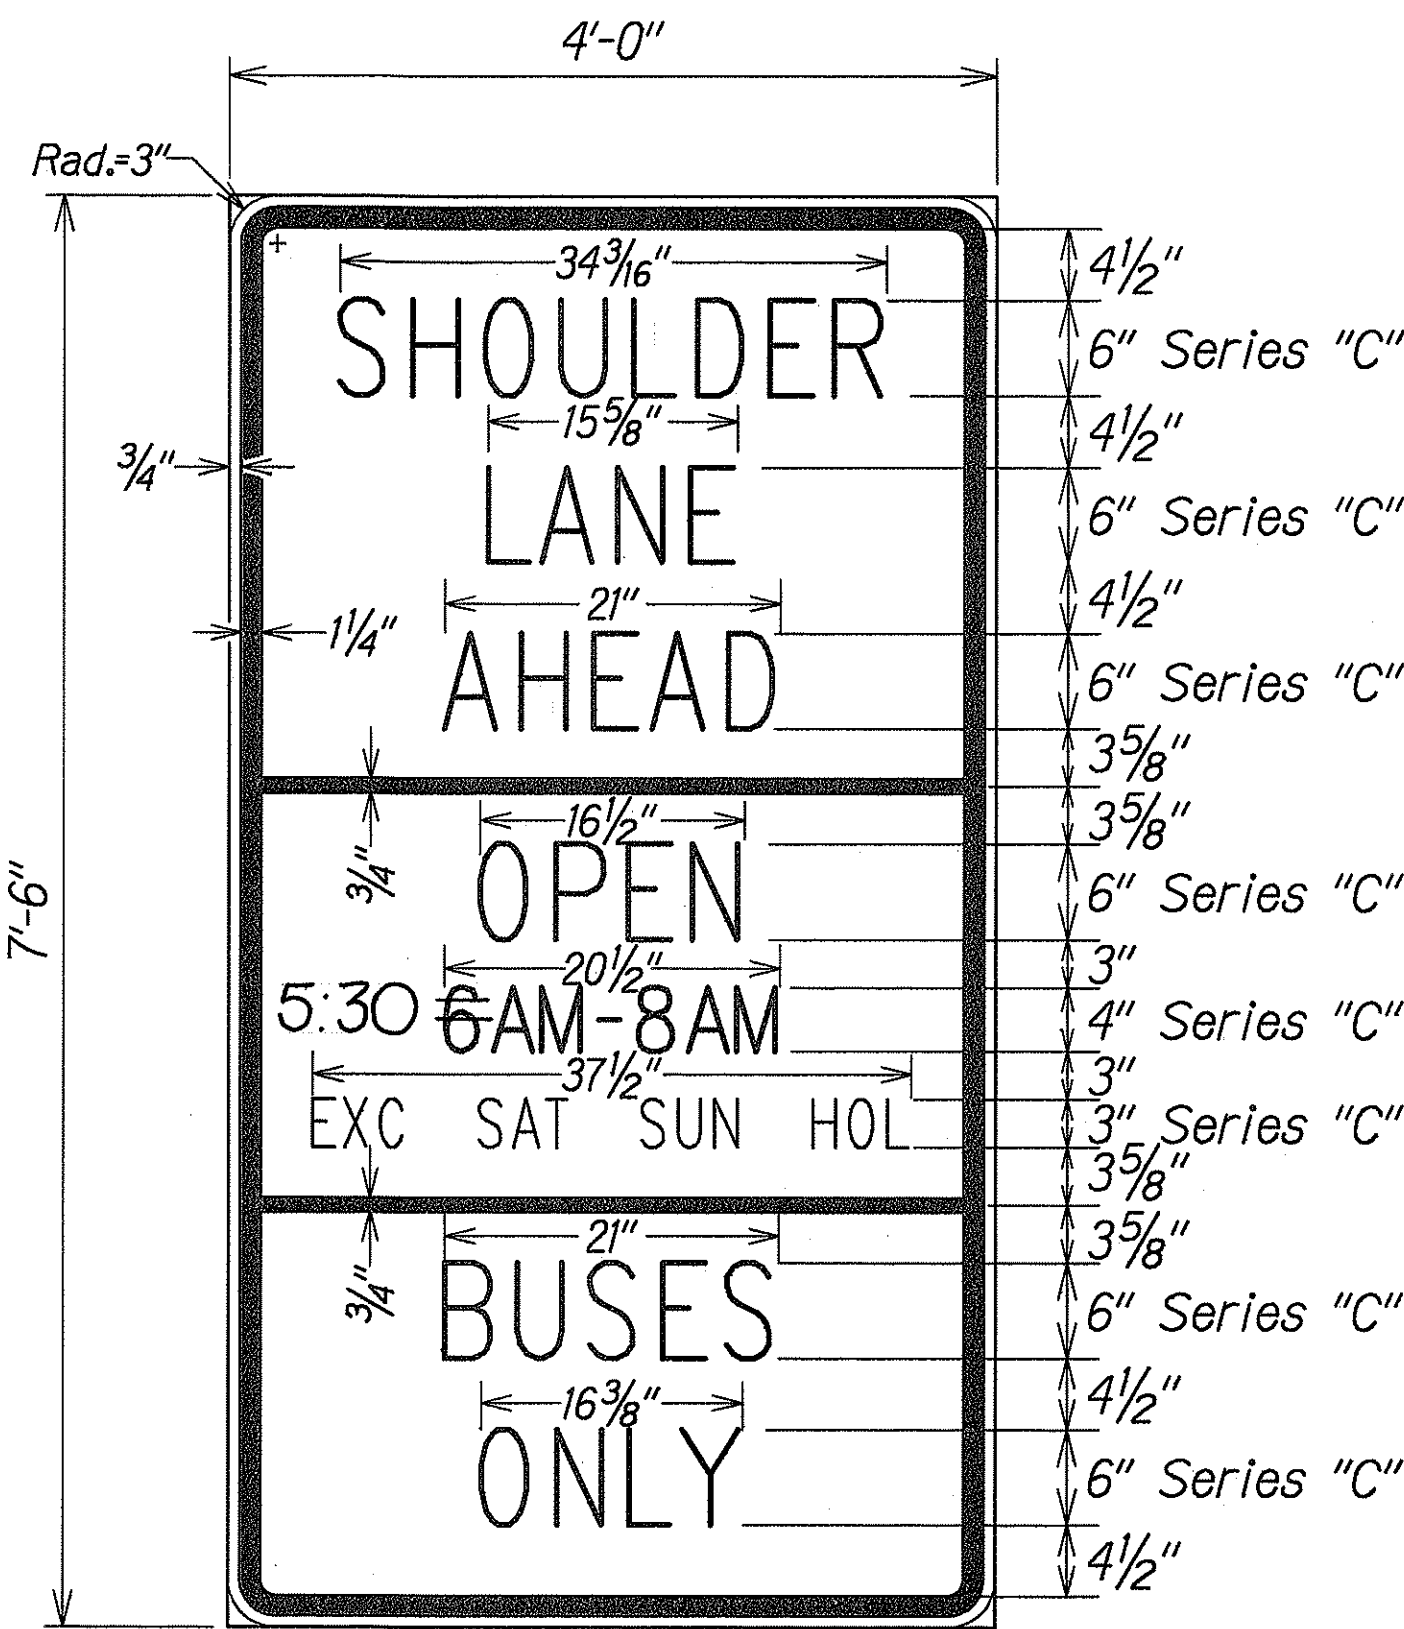

R-1

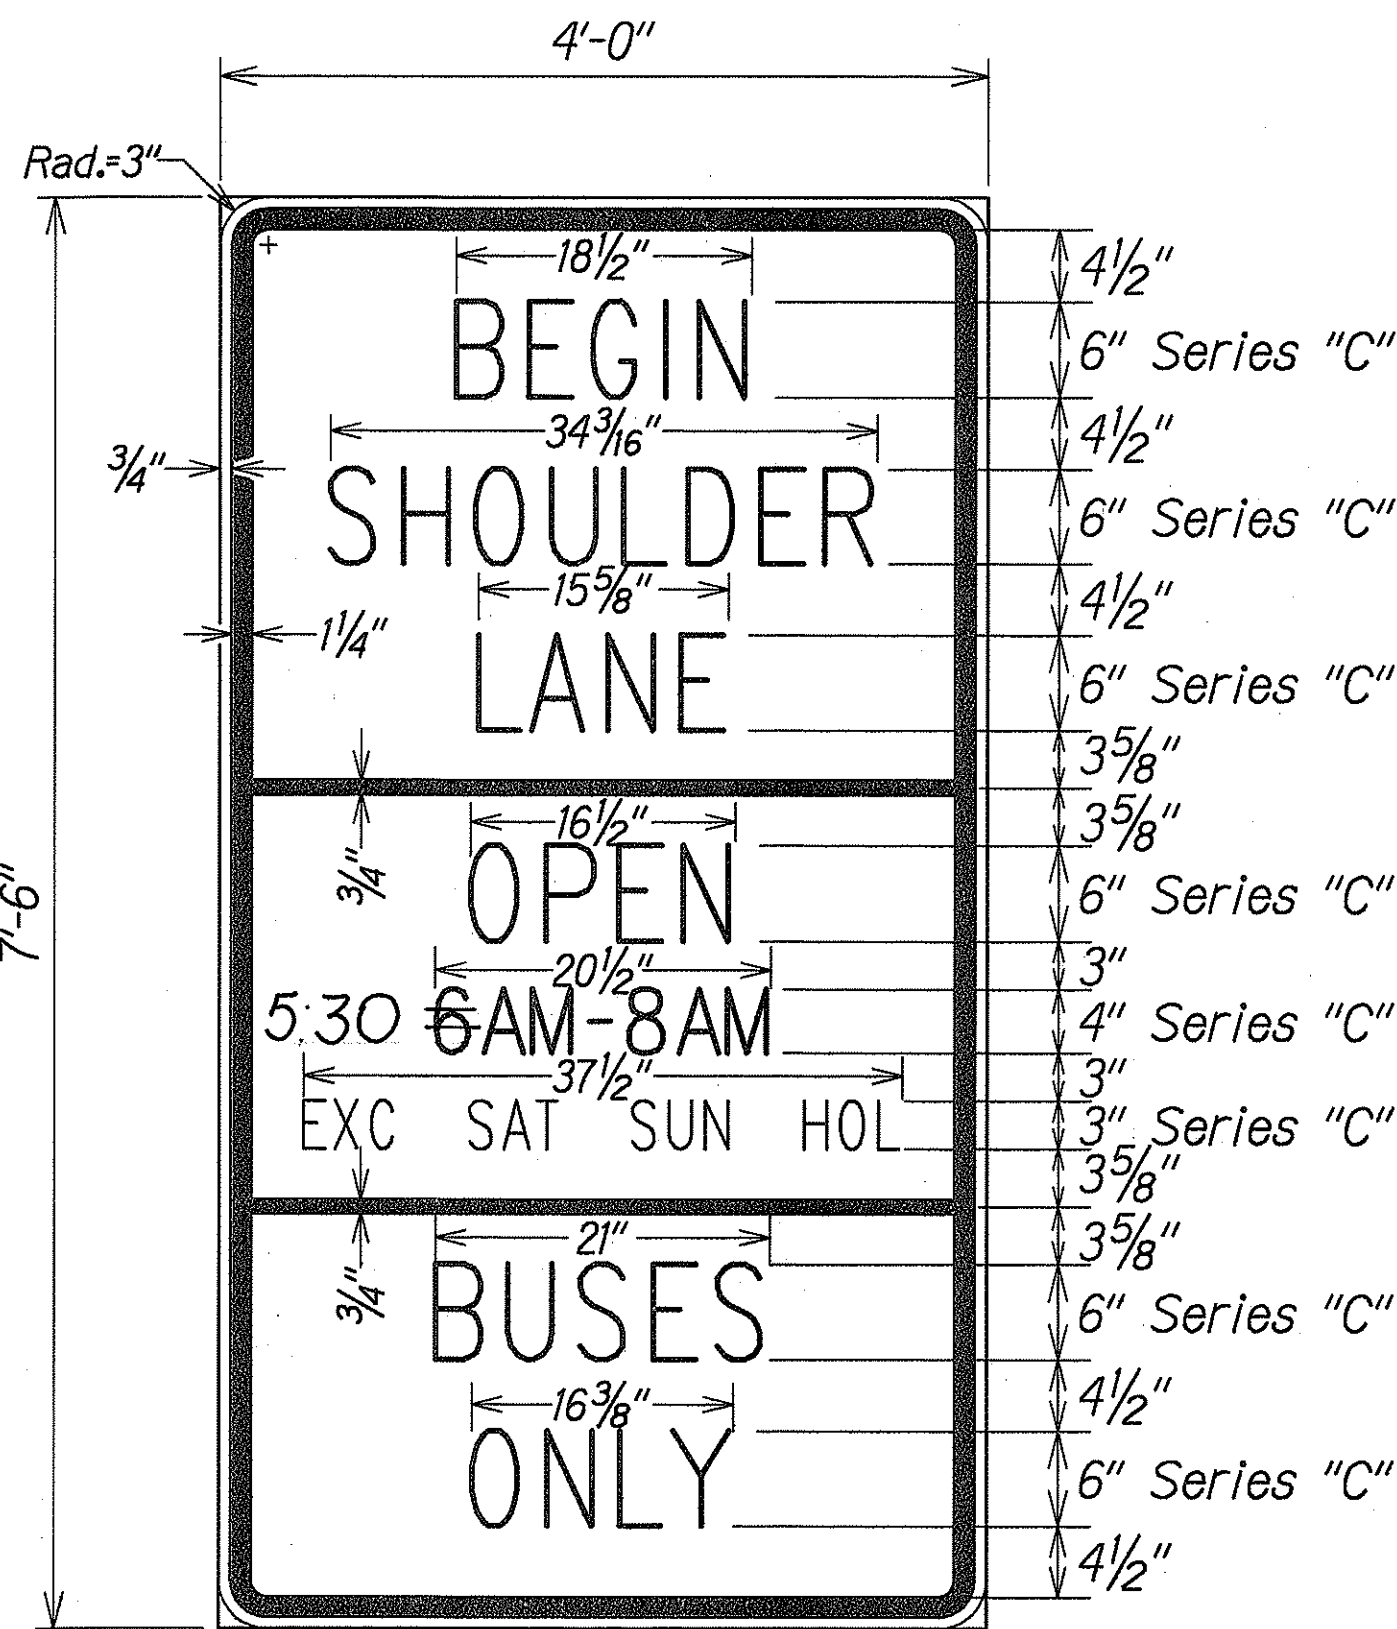

R-2

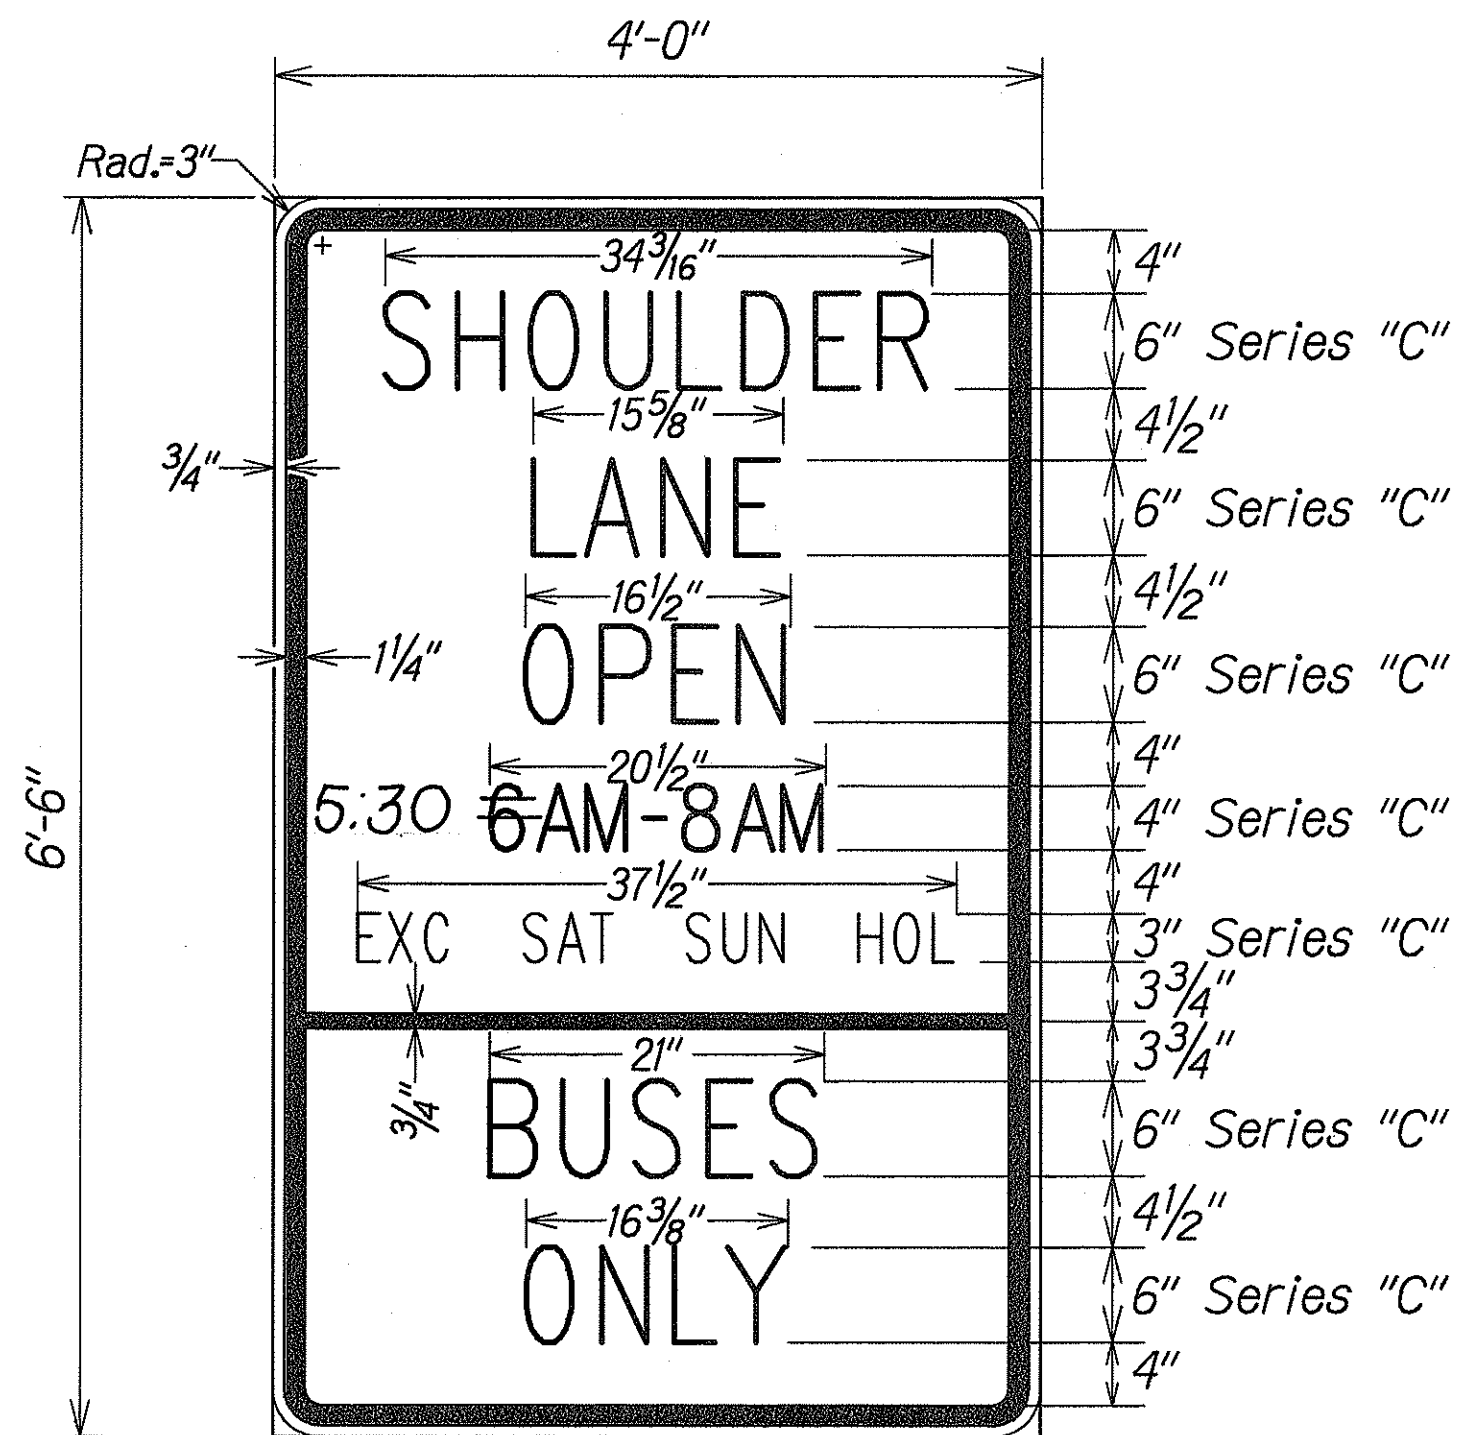


R-3

Colors


Legend: Black (Non-Ref.)

Background: White (Ref.)


Border: Black

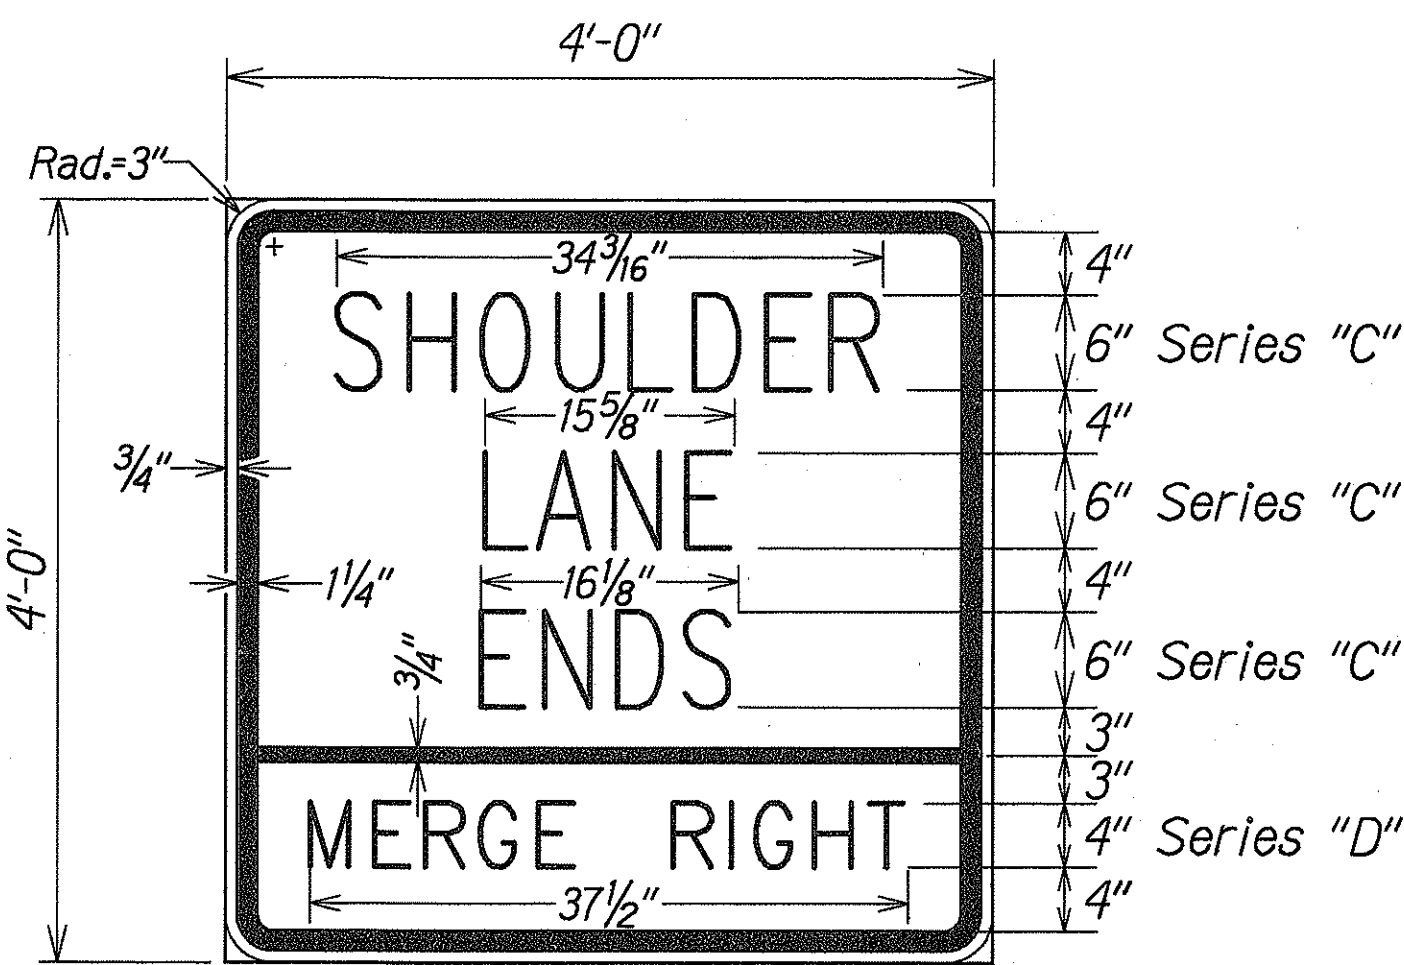

R-4

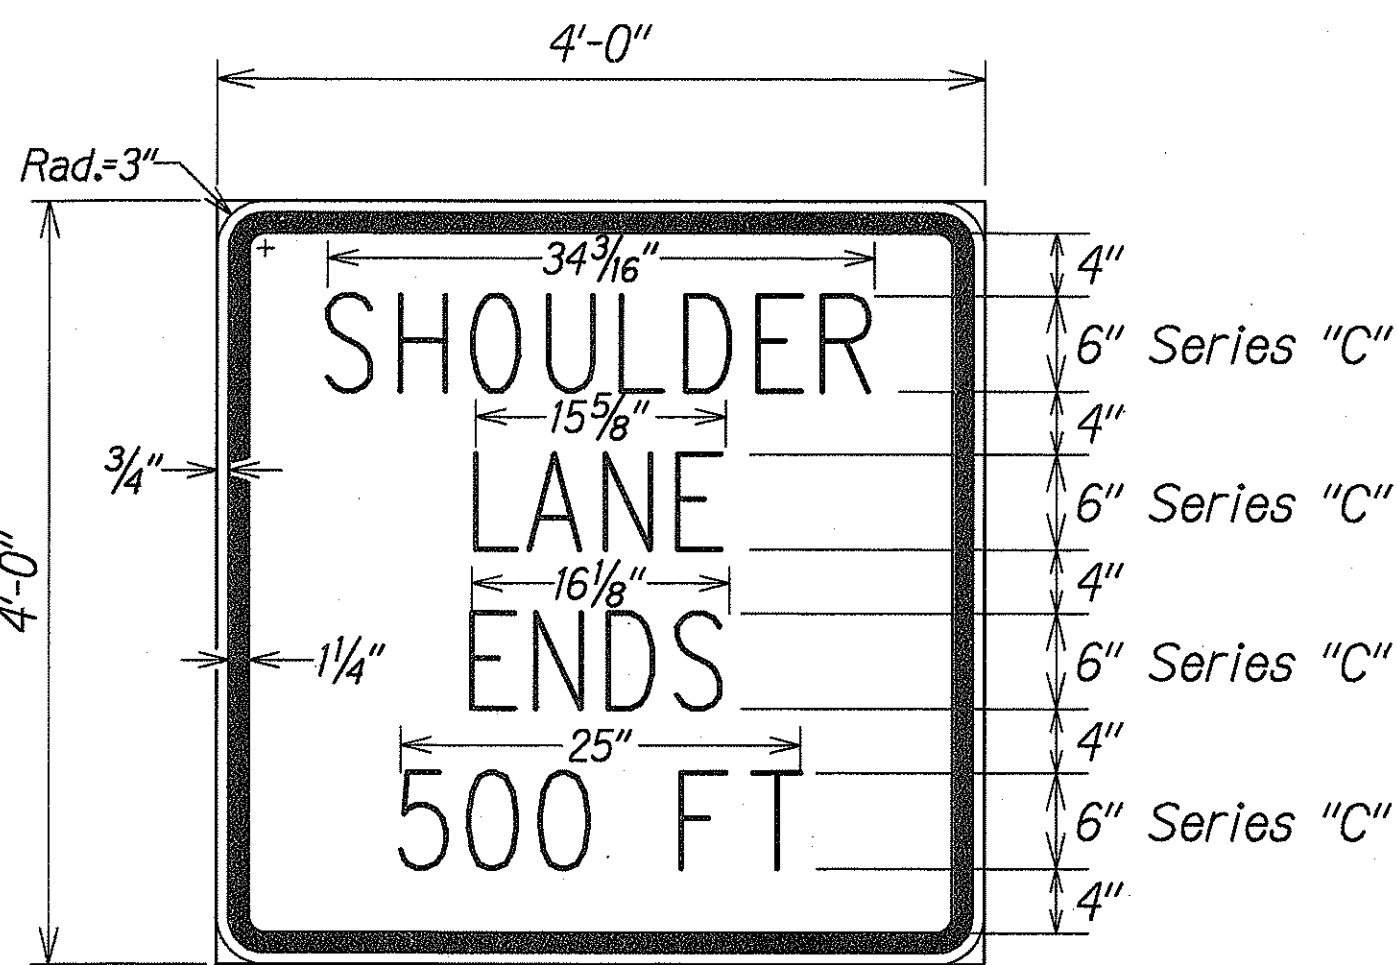


R-5

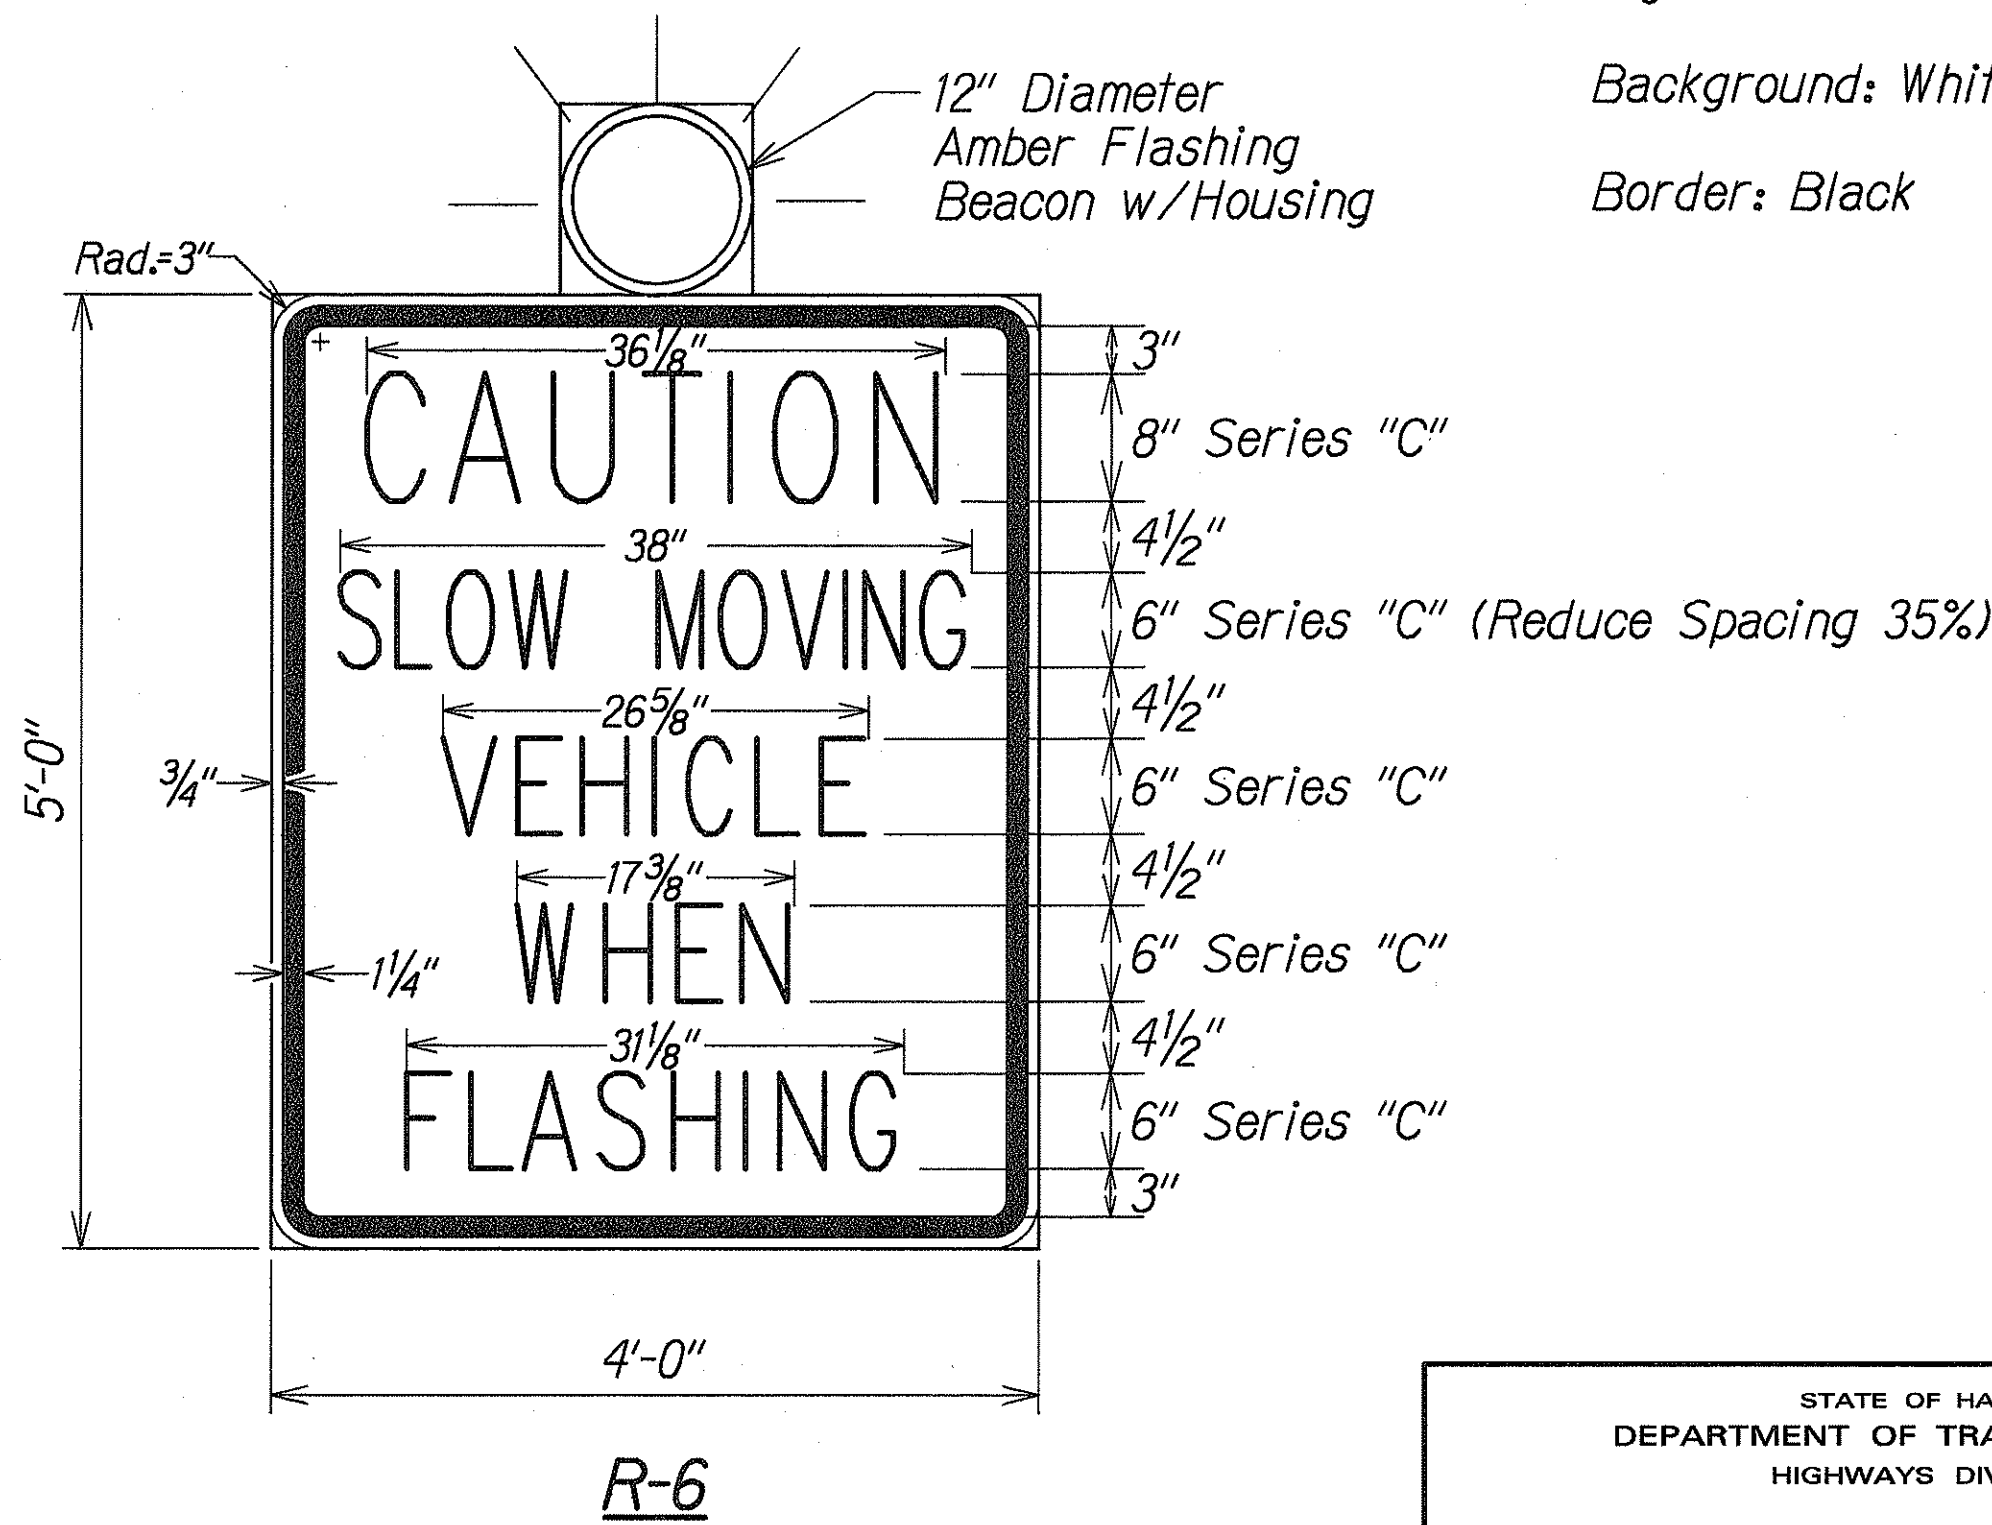

R-6

Note:
Sign Legend shall be centered about vertical centerline
axis of Sign Panel, unless otherwise noted.

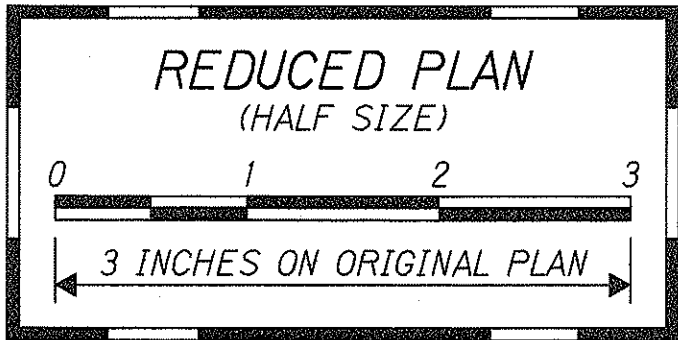

PANEL LAYOUT DETAILS

INTERSTATE ROUTE H-1
CONTRAFLOW AND SHOULDER LANE
Waialae Interchange to Keolu Interchange
PROJECT NO. HIEFG-01-96

Scale: 1" = 1'-0" Date: October, 1997

SHEET No. W4 OF 4 SHEETS

"AS-BUILT"